

**Eugene School District 4J
ROOSEVELT MIDDLE SCHOOL**
680 East 24th Avenue
Eugene, OR 97405
CIP No. 410.566.001

Mahlum Architects
1231 NW Hoyt, Suite 120
Portland Oregon 97209

Robertson/Sherwood/Architects pc
132 East Broadway - Suite 540
Eugene, Oregon 97401



ADDENDUM NO. 6

This Addendum forms a part of the Contract Documents and modifies the original Bidding Documents dated February 18, 2015 and subsequent addenda as noted below. Acknowledge receipt of this Addendum in the space provided on the Bid Form. Failure to do so may subject the Bidder to disqualification.

ADDENDUM NO. 5

1. ITEM - 17 SECTION 31 62 16 19 - DRIVEN STEEL PIPE PILES

- A. Replace Section with attached revised Section 31 62 16 19: Change ASTM reference from ASTM A950 to ASTM A972 which is for pipe piles. Note that ASTM 972 requires a minimum of 12 mil epoxy thickness. Note also that ASTM A123 requires grade 75 coating with a thickness of 3.0 mils for structural pipe.

SPECIFICATIONS

2. DOCUMENT 00 41 13 – BID FORM

- A. Replace Section with attached revised Section 00 41 13 Add to list of Alternates for pricing the following: Alternate No A6: Ceiling Tile AP-1 as a deductive alternate.

3. DOCUMENT 00 73 00 – SUPPLEMENTARY CONDITIONS

- A. Article 1.13: Add the following new Paragraph 5:

"5. 13.5 TESTS AND INSPECTIONS

Revise 13.5.1 to read:

13.5.1 The Owner shall hire and pay for an independent testing and inspection agency to perform all tests and inspections required by Contract Documents and by applicable laws, statutes, ordinances, codes, rules and regulations or lawful orders of public authorities. The Contractor shall make arrangements for such tests, inspections and approvals with Owner selected independent testing agency. The Contractor shall give the Architect timely notice of when and where tests and inspections are to be made so that the Architect may be present for such procedures."

4. DOCUMENT 01 10 00 – SUMMARY

- A. Paragraph 1.03.A: Change the last sentence to read: "The subcontractor noted below and their cost of \$350,000 for the owner negotiated HVAC controls work is assigned to this contract and shall be included in the general contractor's bid.
- B. Article 1.04.C: Add the following paragraphs listing Owner Furnished Owner Installed (OFOI) items:
1. Refrigerators
 2. Microwave Ovens
 3. Performance sound system for gym, commons, drama/platform and media room.
- C. Article 1.04D.1: Add the following paragraphs listing Owner Furnished Contractor Installed (OFCI) items:
- f. Ranges and ovens
 - g. Dishwashers
 - i. Kitchen cooking exhaust hoods

5. SECTION 01 23 00 ALTERNATES

- A. Article 1.05: Add Alternate A6 as follows:
"E, Alternate A6 - Ceiling tile AP-1 (refer to 09 51 00 Acoustic Ceilings and Addendum #3 Item 5)
1. Base Bid Item: Ultima Lay-In Square edge lay in acoustic ceiling tile by Armstrong
 2. Alternate Bid Item: Radar Clima Plus High-NRC Square edge, lay-in acoustic ceiling tile by USG

6. SECTION 05 51 00 METAL STAIRS AND HANDRAILS

- A. Add new Article 3.05 Item A as follow: .

"A. Design Build: Portions of the work has been engineered and portions are to be design built as follows:

Stair 1

Concrete plinth engineered
Landing engineered
Metal treads and risers design build
Structural estimated the size the stringers, but the connections etc need to calculated

Stair 2

Metal treads and risers design build
Structural estimated the size the stringers, but the connections etc need to calculated
Landing and support design build

Forum stair

Engineered

Handrails and guardrails

Design build"

7. SECTION 08 71 01 DOOR HARDWARE SCHEDULE

- A. HW SET 01: Add doors 181E, 181B, 181C, M301A, M301B, M301C, M301D, M301E, M301F and M301G to group. Delete doors 150A-2, 150A.1, 180F, 180G, 180H, 281B-B and M301M from group.
- B. HW SET 12: Delete door 123A-A from group.
- C. HW SET 32: Delete door 166B-A from group.
- D. HW SET 33: Delete door 168C-A from group.
- E. HW SET 66: Add door 202B-B to group. Delete door M265A.1 from group.
- F. HW SET 69: Delete door 166E from group.
- G. HW SET 71: Add door 181A to group.
- H. HW SET 78: Delete Hardware Group 78.

8. SECTION 10 21 13 16 – SOLID PHENOLIC TOILET AND SHOWER COMPARTMENTS

- A. Article 202D. Change: Item 2 to read: "2. Height; field verify."

9. SECTION 10 26 00 – WALL AND CORNER GUARDS

- A. Article 2.02: Add Paragraph B: "B. Quantity: Provide and install 35 corner guards at corners where directed by architect."

10. SECTION 11 52 13 – PROJECTION SCREENS

- A. Article 3.05: Add Item E as follows: "E. Note that dimensions on drawings indicate projected size of image and not size of screen. Final location of Screens in Choral Rm186 and Drama/Platform to be determined."

11. SECTION 12 93 00 – SITE FURNISHINGS

- A. Replace Section with attached revised Section 12 93 00. Add Article 1.01E PICNIC TABLE. Add Article 2.06 PICNIC TABLE.

12. SECTION 22 35 15 SOLAR WATER HEATING SYSTEM

- A. Replace Section with attached revised Section 22 35 15 Clarification: Specification number corrected from 23 35 15 to 22 35 15.

13. SECTION 22 40 00 PLUMBING FIXTURES

- A. Replace Section with attached revised Section 22 40 00.

14. SECTION 23 05 14 VARIABLE FREQUENCY DRIVES FOR HVAC EQUIPMENT

- A. Replace Section with attached revised Section 23 05 14. Clarification: See attached for select revisions.

15. SECTION 23 05 48 VIBRATION AND SEISMIC CONTROLS FOR HVAC PIPING AND EQUIPMENT

- A. Replace Section with attached revised Section 23 05 48. Clarification: See attached for select revisions.

16. SECTION 23 07 00 INSULATION FOR HVAC

- A. Replace Section with attached revised Section 23 07 00. Clarification: See attached for select revisions.

17. SECTION 23 20 14 PREFABRICATED PIPING SYSTEMS FOR HVAC

- A. Replace Section with attached revised Section 23 20 14. Clarification: See attached for select revisions.

18. SECTION 23 33 00 AIR DUCT ACCESSORIES

- A. Replace Section with attached revised Section 23 33 00. Clarification: See attached for select revisions.

19. SECTION 26 05 19 LOW VOLTAGE ELECTRICAL POWER CONDUCTORS AND CABLES

- A. Replace Section with attached revised Section 26 05 19. Clarification: See attached for select revisions.

20. SECTION 32 90 00 – PLANTING

- A. Replace Section with attached revised Section 32 90 00. Article 2.05, Paragraph C: Change Item 2a to PT 705 Xeriscape by Hobbs and Hopkins, Portland, Oregon. Article 3.11, Paragraph A.1.a: Change to 87 lbs. per acre. Refer to attached updated Section. Article 3.11, Paragraph A.1.a: Change to 87 lbs. per acre. Refer to attached updated Section.

PACKAGE 1 - DRAWING SHEETS

21. SHEET C-201 – UTILITY PLAN

- A. Replace Sheet with revised Sheet C-201: Change landscape area

22. SHEET C203 – UTILITY PLAN

- A. Replace Sheet with revised Sheet C-203: Change invert elevations

23. SHEET L101.0 – OVERALL SITE PLAN

- A. Replace Sheet with revised Sheet L101.0: Adjust grassy swale and area drain north of bus drop off area. Add concrete mowstrip at grassy swale north of bus drop off area. Add trees along north edge of parking lot per the City of Eugene Land Use Review Comments.

24. SHEET L101.1 – WEST SITE PLAN

- A. Replace Sheet with revised Sheet L101.1: Adjust grassy swale and area drain north of bus drop off area. Add concrete mowstrip at grassy swale north of bus drop off area. Change Eco Lawn legend item to be Non-irrigated.

25. SHEET L101.2 – CENTRAL SITE PLAN

- A. Replace Sheet with revised Sheet L101.2: Change Eco Lawn legend item to be Non-irrigated. Add trees along north edge of parking lot per the City of Eugene Land Use Review Comments.

26. SHEET L102.1 – WEST LAYOUT PLAN

- A. Replace Sheet with revised Sheet L102.1: Change northing and easting point of Area Drain Rim at grassy swale north of bus drop off area. Add northing and easting points to concrete mowstrip at grassy swale north of bus drop off area.

27. SHEET L103.1 – WEST GRADING PLAN

- A. Replace Sheet with revised Sheet L103.1: Change elevation of Area Drain Rim at grassy swale north of bus drop off area. Add elevations to concrete mowstrip at grassy swale north of bus drop off area.

28. SHEET L104.0 – MAINLINE & IRRIGATION NOTES

- A. Replace Sheet with revised Sheet L104.0: Adjust irrigation heads and change zone calculations at zones #3, #4 and #7. Upsize zone #15 valve to a 1 ½" valve from a 1" valve. Add tree bubblers to zone #56 and update zone calculation. Update zone calculations for zone #59. Update zone #3 and zone #7 in Special Note.

29. SHEET L104.1 – WEST IRRIGATION PLAN

- A. Replace Sheet with revised Sheet L104.1: Adjust irrigation heads and change zone calculations at zones #3, #4 and #7. Update zone #15 zone calculations and upsize zone valve to a 1 ½" valve from a 1" valve. Update zone calculation for zone #59.

30. SHEET L104.2 – CENTRAL IRRIGATION PLAN

- A. Replace Sheet with revised Sheet L104.2: Add tree bubblers to zone #56 and update zone calculation.

31. SHEET L105.0 – GENERAL NOTES & PLANT LIST

- A. Replace Sheet with revised Sheet L-105.0: Add Cercidiphyllum japonicum and Cercis Canadensis 'Merlot' tree species.

32. SHEET L105.1 – WEST LANDSCAPE PLAN

- A. Replace Sheet with revised Sheet L105.1: Adjust grassy swale area north of bus drop off area. Add landscape plantings between the entrance and exit of the bus drive per the City of Eugene Land Use Review Comments.

33. SHEET L105.2 – CENTRAL LANDSCAPE PLAN

- A. Replace Sheet with revised Sheet L-105.2: Add landscape plantings at the landscape area between the street and the parking lot per the City of Eugene Land Use Review Comments.

34. SHEET S-001 – DRAWING INDEX AND LIST OF ABBREVIATIONS

- A. Replace Sheet with revised Sheet S-001: Add Addendum 6 to Drawing Index

35. SHEET S- S-002 – GENERAL STRUCTURAL NOTES

- A. Replace Sheet with revised Sheet S-002: Add note regarding non-contact lap splices under MASONRY REINFORCING STEEL

36. SHEET S-121E – FIRST FLOOR PLAN – ZONE E

- A. Replace Sheet with revised Sheet S-121E: Change the Addendum 3 bubbles by adding the correct deltas.

37. SHEET S-123A – EQUIPMENT PLATFORM PLAN – ZONE A

- A. Replace Sheet with revised Sheet S-123A: Delete the roof tie offs.

38. SHEET S-123B – EQUIPMENT PLATFORM PLAN – ZONE B

- A. Replace Sheet with revised Sheet S-123B: Delete the roof tie offs.

39. SHEET S-123C – MID-ROOF PLAN – ZONE C

- A. Replace Sheet with revised Sheet S-123C: Delete the roof tie offs.

40. SHEET S--124A – HIGH ROOF PLAN – ZONE A

- A. Replace Sheet with revised Sheet S-124A: Delete the roof tie offs.

41. SHEET S-124B – HIGH ROOF PLAN – ZONE B

- A. Replace Sheet with revised Sheet S-124B: Delete the roof tie offs. Delete roof access hatch associated framing.

42. SHEET S-124C – HIGH ROOF PLAN – ZONE C

- A. Replace Sheet with revised Sheet S-124C: Delete the roof tie offs.

43. SHEET S-401 – CMU DETAILS

- A. Replace Sheet with revised Sheet S-401: Revise horizontal bar hooks from vertical to horizontal around jamb bar in Detail 3

44. SHEET S-402 – CMU DETAILS

- A. Replace Sheet with revised Sheet S-402: Revise Detail 4

45. SHEET S-403 – CMU DETAILS

- A. Replace Sheet with revised Sheet S-403: Add note to Detail 5 regarding non-contact lap splice. Revise Detail 12

46. SHEET S-603 – STEEL DETAILS

- A. Replace Sheet with revised Sheet S-603: Add vertical truss members in Elevation 1. Add thru-bolts at truss bottom chord in Elevation 1. Revise truss diagonal member sizes in Elevation 2.

47. SHEET S-604 – STEEL DETAILS

- A. Replace Sheet with revised Sheet S-604: Delete steel roof tie-off Details 11 and 12

48. SHEET S-605 – STEEL DETAILS

- A. Replace Sheet with revised Sheet S-605: Add new sheet.

49. SHEET S-802 - PRIMARY LIGHT GAUGE METAL FRAMING DETAILS

- A. Replace Sheet with revised Sheet S-802: Revise holdown schedule in Detail 3. Revise holdown schedule in Detail 4. Revise end stud size in Detail 8. Add Detail 9.

50. SHEET P-120D - UNDERGROUND PLAN - ZONE D - PLUMBING

- A. Replace Sheet with revised Sheet P-120D: Add below grade stormwater piping, which connects to Civil on both sides of the building. Note this piping was previously shown on Civil plans.

51. SHEET P-120E - UNDERGROUND PLAN - ZONE E - PLUMBING

- A. Replace Sheet with revised Sheet P-120E: Revise below grade stormwater piping, which connects to Civil on both sides of the building.

52. SHEET E-110 - UNDERGROUND OVERALL - ELECTRICAL

- A. Replace Sheet with revised Sheet E-110: Relocate electrical panels at Kitchen

PACKAGE 2 - DRAWING SHEETS

53. SHEET S-223- ENLARGED EXTERIOR CLADDING ELEVATIONS

- A. Replace Sheet with revised Sheet S-223: Add framing callouts on Elevation 1 between grids 2 and 3 and 6 and 7. Add framing callouts for header and jamb at opening near grid 5 on Elevation 1. Revise section callout for jambs on Elevation 2

54. SHEET S-903 – EXTERIOR CLADDING DETAILS

- A. Replace Sheet with revised Sheet S-903: Add Detail 1. Add note in Detail 2. Revise connections in Detail 3. Revise connections in Detail 4. Add note in Detail 5. Revise connections and framing in Detail 6. Revise connections and framing in Detail 6

55. SHEET A-121C FIRST FLOOR PLAN - ZONE C

- A. Replace Sheet with revised Sheet A-121C: A1/A-121C: Add wall tags to existing wall and add detail bugs.

56. SHEET A-121D FIRST FLOOR PLAN - ZONE D

- A. Replace Sheet with revised Sheet A-121D: A1/A-121E: Change wall type of west wall of Chair/Table Storage 169. Add floor drains and slope to drain note in Kitchen 180

57. SHEET A-121E FIRST FLOOR PLAN ZONE E

- A. Replace Sheet with revised Sheet A-121E: A1/A-121E: Change wall type of west wall of costume Storage 180. Relocated shaft in SE corner of Drama/Platform 184. Change width of east concrete stairs into the Drama/Platform. Add door 1888B-A to Practice 1888B

58. SHEET A-122B FIRST FLOOR PLAN ZONE B

- A. Replace Sheet with revised Sheet A-122B: A1/A-122B: Change west wall type of Text Book Work Room 202B

59. SHEET A-141 – ROOF PLAN

- A. Replace Sheet with attached revised Sheet A-141. Clarification: The fall protection anchors are removed from roofs at Zones A, B, and C. The layout of roof equipment in Zone D was revised.

60. SHEET A221 – ENLARGED EXTERIOR ELEVATIONS

- A. B1/A221 Enlarged North elevation – West End (Zone A): Delete Door M301H between Grids 4.5 and 5.

61. SHEET A222 – ENLARGED EXTERIOR ELEVATIONS

- A. D1/A222 Enlarge Courtyard elevation Looking North (Zone A): Delete Door M301J between Grids 1.5 and 2. Delete Door M301I between Grids 3 and 3.5.

62. SHEET A161-B – FIRST FLOOR REFLECTED CEILING PLAN – ZONE B

- A. RCP General Notes: Add General Note F to read as follows:
“F. Provide a gypsum board enclosure around all exterior soffit light fixtures to allow for 3” clearance between the batt insulation and the top and sides of the light fixture.”

63. SHEET A161-C – FIRST FLOOR REFLECTED CEILING PLAN – ZONE C

- A. RCP General Notes: Add General Note F to read as follows:
“F. Provide a gypsum board enclosure around all exterior soffit light fixtures to allow for 3” clearance between the batt insulation and the top and sides of the light fixture.”

64. SHEET A161-D – FIRST FLOOR REFLECTED CEILING PLAN – ZONE D

- A. RCP General Notes: Add General Note F to read as follows:
“F. Provide a gypsum board enclosure around all exterior soffit light fixtures to allow for 3” clearance between the batt insulation and the top and sides of the light fixture.”

65. SHEET A-325 – WALL SECTIONS

- A. Revise Wall Section A1/A325 with attached Drawing ADD-A-325-01. Clarification: Added wall tag for the gypsum board finish furred over CMU wall in Vestibule 165A.

66. SHEET 421 STAIR 1 – ENLARGED PLANS

- A. Replace Sheet with attached revised Sheet A-421: B6/ A-421 Add description to stringer.

67. SHEET A-422 STAIR 1 –SECTIONS

- A. Replace Sheet with attached revised Sheet A-422: C1, C4, A2,A4/ A-422: Add description to stringer. Add additional information to concrete landing

68. SHEET A-423 STAIR 2 –ENLARGED PLANS & SECTIONS

- A. Replace Sheet with attached revised Sheet A-423: C5 / A-423: Add description to stringer. A1, A3/ A-423: Add description to stringer. Add additional information to concrete landing support

69. SHEET A-424 STAIR 2 –SECTIONS

- A. Replace Sheet with attached revised Sheet A-424: A2, A4 / A-424: Add description to stringer. Add additional information for landing support

70. SHEET A- A-430 STAIR DETAILS

- A. Replace Sheet with attached revised Sheet A-430: D2/A-424, B2/A-424 and B3/A-424: Add tread reinforcement information

71. SHEET A-511 – EXTERIOR DETAILS – FOUNDATION

- A. Replace Sheet with attached revised Sheet A-511. Clarification: Deletes the landscape concrete header at base of wall along concrete bench and revised notes as shown on Detail A2/A511. Clarified description of concrete masonry unit at Detail D5/A-511. Revised sheet metal flashing and weather barrier assemblies at Details A4/A-511, A4/A-511, B4/A-511, and B5/A-511.

72. SHEET A-540 – EXTERIOR WINDOW DETAILS

- A. Details C1/A540: Add storefront deflection framing at storefront window head.
- B. Details C3/A540 and C5/A540: Add general note to read as follows: “Note: Provide storefront deflection head at storefront windows at load bearing walls where occurs.”

73. SHEET A-541 – EXTERIOR DOOR AND LOUVER DETAILS

- A. Replace Sheet with attached revised Sheet A-541. Clarification: Added Detail B1/A-541. Deleted Details B4/A-541 and B5/A-541. Revised all other details.

74. SHEET A-547 – EXTERIOR ENTRY DOOR AND WINDOW DETAILS

- A. Replace Sheet with attached Sheet A-547. Clarification: Revised window anchorage at Details A3/A-547 and A5/A-547. Removed concrete header at Detail A5/A-547. Revised membrane flashing configurations at Details B1/A-547, C1/A-547, and C3/A-547.

75. SHEET A-555 INTERIOR DOOR DETAILS

- A. A6/A-555: Added outlet location Clarified location of column per attached Drawing ADD-A555-01

76. SHEET A-558 INTERIOR 3 HOUR DOOR DETAILS

- A. Replace Sheet with revised Sheet A-558: A3/A-558: Add dimension to centerline of column. Add corner guards. Modify wall alignment

77. SHEET A- A-559 INTERIOR WALL DETAILS

- A. C4/A-559 and C5/A-599: Added retro plate finish on bench per attached Drawing ADD-A559-01

78. SHEET A-582 CASEWORK DETAILS

- A. C4/A-582: Clarified height and depth of microwave opening per attached Drawing ADD-A582-01

79. SHEET A-602 INTERIOR WALL ASSEMBLY TYPES

- A. Add wall type 17-9-0 per attached Drawing ADD-A602-01

80. SHEET A-611 – DOOR SCHEDULE & TYPES

- A. Delete Doors M301H, M301J, and M301I. Clarification: The doors providing access to the low classroom roofs have been removed.
- B. Door A173A: Change door type from "D-F" to "D-N"
- C. Door L001: Change hardware group from 01 to 79

81. SHEET P-001 -SYMBOLS LEDGEND AND ABBREVIATIONS - PLUMBING

- A. Replace Sheet with revised Sheet P-001: Add "CTG" to plumbing abbreviations..

82. SHEET P-002 - EQUIPMENT SCHEDULE - PLUMBING

- A. Replace Sheet with revised Sheet P-002: Revise Plumbing Fixture Schedule and Plumbing Equipment Schedule.

83. SHEET P-121A FIRST FLOOR PLAN - ZONE A - PLUMBING

- A. Replace Sheet with revised Sheet P-121A: Add isolation valves and balancing valves

84. SHEET P-121B FIRST FLOOR PLAN - ZONE B - PLUMBING

- A. Replace Sheet with revised Sheet P-121B: Add isolation valves and balancing valves

85. SHEET P-121C FIRST FLOOR PLAN - ZONE C - PLUMBING

- A. Replace Sheet with revised Sheet P-121C: Add isolation valves and balancing valves

86. SHEET P-121D FIRST FLOOR PLAN - ZONE D - PLUMBING

- A. Replace Sheet with revised Sheet P-121D: Add isolation valves and balancing valves. Add capped connection for emergency propane tank.

87. SHEET P-121E FIRST FLOOR PLAN - ZONE E - PLUMBING

- A. Replace Sheet with revised Sheet P-121E: Add isolation valves and balancing valves. Add notes clarifying pipe locations. Add vent piping to band room and hallway 182 sinks.

88. SHEET P-122A SECOND FLOOR PLAN - ZONE A - PLUMBING

- A. Replace Sheet with revised Sheet P-122A: Add dishwasher connection at Lounge 209

89. SHEET P-131 - ROOF PLAN - PLUMBING

- A. Replace Sheet with revised Sheet P-131: Revise VTRs. Clarifyies solar thermal water heating panel size as 48"x98" per panel, in key note #1

90. SHEET P-401A MECHANICAL EQUIPMENT PLATFORM - ZONE A - PLUMBING

A. Replace Sheet with revised Sheet P-401A: Update tag on floor sinks.

91. SHEET P-401C MECHANICAL EQUIPMENT PLATFORM - ZONE C - PLUMBING

A. Replace Sheet with revised Sheet P-401C: Update tag on floor sinks.

92. SHEET P-401D MECHANICAL EQUIPMENT PLATFORM - ZONE D - PLUMBING

A. Replace Sheet with revised Sheet P-401D: Update tag on floor sinks Add floor sinks. Add vent piping Add vent and waste piping in kitchen ceiling

93. SHEET P-401E MECHANICAL EQUIPMENT PLATFORM - ZONE E - PLUMBING

A. Replace Sheet with revised Sheet P-401E: Update tag on floor sinks. Tag piping

94. SHEET P-601 FLOW DIAGRAMS - PLUMBING

A. Replace Sheet with revised Sheet P-601: Update solar thermal drainback diagram. Update rainwater harvesting system diagram.

95. SHEET P-606 RISER DIAGRAM - GAS

A. Replace Sheet with revised Sheet P-606: Update gas piping diagram to include emergency propane connections.

96. SHEET M-001 -SYMBOLS LEDGEND AND ABBREVIATIONS - MECHANICAL

A. Replace Sheet with revised Sheet M-001: Revise legend. Add controls clarification note.

97. SHEET M-002 EQUIPMENT SCHEDULE - MECHANICAL

A. Replace Sheet with revised Sheet M-002: Boiler schedule: Revise minimum flowrate, change one to dual fuel (gas/propane)

98. SHEET M-003 EQUIPMENT SCHEDULE - MECHANICAL

A. Replace Sheet with revised Sheet M-003: Clarify fan type. Clarify VFD and EC motor connections.

99. SHEET M-004 EQUIPMENT SCHEDULE - MECHANICAL

A. Replace Sheet with revised Sheet M-004: Roof Ventilator schedule: Delete damper requirement at intake ventilators. Fan schedule: Add EF-PREP. Add VFD to EF-HALL-E.

100. SHEET M-121A FIRST FLOOR PLAN - ZONE A - MECHANICAL

- A. Replace Sheet with revised Sheet M-121A: Add radiation damper to exhaust grille serving janitor's room. Add smoke detector to AH-HALL1-A return duct.

101. SHEET M-121B FIRST FLOOR PLAN - ZONE B - MECHANICAL

- A. Replace Sheet with revised Sheet M-121B: Add radiation damper to exhaust grille serving janitor's room. Note location of seismic joint Revise fire/smoke dampers to fire dampers at 3 hour fire walls.

102. SHEET M-121C FIRST FLOOR PLAN - ZONE C - MECHANICAL

- A. Replace Sheet with revised Sheet M-121C: Add radiation damper to exhaust grille serving janitor's room. Revise fire/smoke dampers to fire dampers at 3 hour fire walls.

103. SHEET M-121D FIRST FLOOR PLAN - ZONE D - MECHANICAL

- A. Replace Sheet with revised Sheet M-121D: Delete sizes shown on DTS and DTR (see hydronic diagram for sizes). Revise supply and return at Electrical Room 179A to include ceiling mount grilles with radiation dampers.

104. SHEET M-121E FIRST FLOOR PLAN - ZONE E - MECHANICAL

- A. Replace Sheet with revised Sheet M-121E: Add EF-PREP. Clarify Science Room return grille cfm. Delete requirement for undercut doors at Prep Rooms. Add smoke detector to Choral Room relief duct.

105. SHEET M-122A FIRST FLOOR PLAN - ZONE A - MECHANICAL

- A. Replace Sheet with revised Sheet M-122A: Add smoke detector to AH-HALL2-A return duct.

106. SHEET M-401A1 MECHANICAL EQUIPMENT PLATFORM PLAN- ZONE A WEST - MECHANICAL

- A. Replace Sheet with revised Sheet M-401A1: Delete osa intake plenum and ductwork at west and north walls. Clarify relief damper requirements at RF-A. Add auto damper to exhaust plenum at south wall. Revise exhaust duct routing from IDF room. Add relief dampers to AH-HALL1-A. Revise osa duct size and add smoke detector at AH-HALL2-A. Add general note regarding walking path width and head room requirement.

107. SHEET M-401A2 MECHANICAL EQUIPMENT PLATFORM PLAN- ZONE A EAST - MECHANICAL

- A. Replace Sheet with revised Sheet M-401A2: Revise osa duct size. Add general note regarding walking path width and head room requirement.

108. SHEET M-401C MECHANICAL EQUIPMENT PLATFORM PLAN- ZONE C - MECHANICAL
- A. Replace Sheet with revised Sheet M-401C: Add general note regarding walking path width and head room requirement. Add smoke detector to AH-GYM-N return duct. Clarify clothes dryer duct and add roof jack. Add roof jack for EF-KILN Revise damper sizing.
109. SHEET M-401D MECHANICAL EQUIPMENT PLATFORM PLAN- ZONE D - MECHANICAL
- A. Replace Sheet with revised Sheet M-401D: Add general note regarding walking path width and head room requirement. Add smoke detector to AH-BAND return duct. Revise floor drain locations. Delete auto damper at AH-COMM relief duct. Delete auto dampers at intake roof ventilators.
110. SHEET M-401E1 MECHANICAL EQUIPMENT PLATFORM PLAN- ZONE E NORTH-
MECHANICAL
- A. Replace Sheet with revised Sheet M-401E1: Add general note regarding walking path width and head room requirement. Delete general note regarding relief dampers.
111. SHEET M-401E2 MECHANICAL EQUIPMENT PLATFORM PLAN- ZONE E SOUTH-
MECHANICAL
- A. Replace Sheet with revised Sheet M-401E2: Delete general note regarding relief dampers. Add general note regarding walking path width and head room requirement. Add smoke detector to AH-BAND relief duct.
112. SHEET M-501 DETAILS - MECHANICAL
- A. Replace Sheet with revised Sheet M-501: Delete reference to OFCI
113. SHEET M-502 DETAILS - MECHANICAL
- A. Replace Sheet with revised Sheet M-502: Delete reference to OFCI Correct detail reference at Detail C1
114. SHEET M-601 DIAGRAMS - MECHANICAL
- A. Replace Sheet with revised Sheet M-601: Revise location of units and pipe sizes.
115. SHEET E-002 LUMINAIRE SCHEDULE
- A. Replace Sheet with revised Sheet E-002: Revise luminaire types.
116. SHEET E-101 SITE PLAN – ELECTRICAL
- A. Replace Sheet with revised Sheet E-101: Relocate exit signs in gated plaza. Relocate luminaires, type S6 as shown. Add Keyed notes 20 and 21. Add spare conduit for future car charger power.

117. SHEET E-121A FIRST FLOOR PLAN - ZONE A - LIGHTING

- A. Replace Sheet with revised Sheet E-121A: Remove relays for interior lighting loads tied to the DDC. Circuitry indicated. Provide UL 924 shunt relay for egress lighting in these locations as shown.

118. SHEET E-121B FIRST FLOOR PLAN - ZONE B - LIGHTING

- A. Replace Sheet with revised Sheet E-121B: Remove relays for interior lighting loads tied to the DDC. Circuitry indicated. Provide UL 924 shunt relay for egress lighting in these locations as shown.

119. SHEET E-121C FIRST FLOOR PLAN ZONE C - LIGHTING

- A. Replace Sheet with revised Sheet E-121C: Remove relays for interior lighting loads tied to the DDC. Circuitry indicated. Provide UL 924 shunt relay for egress lighting in these locations as shown.

120. SHEET E-121D FIRST FLOOR PLAN - ZONE D - LIGHTING

- A. Replace Sheet with revised Sheet E-121D: Remove relays for interior lighting loads tied to the DDC. Circuitry indicated. Provide UL 924 shunt relay for egress lighting in these locations as shown.

121. SHEET E-121E FIRST FLOOR PLAN - ZONE E - LIGHTING

- A. Replace Sheet with revised Sheet E-121E: Remove relays for interior lighting loads tied to the DDC. Circuitry indicated. Provide UL 924 shunt relay for egress lighting in these locations as shown.

122. SHEET E-122A SECOND FLOOR PLAN - ZONE A - LIGHTING

- A. Replace Sheet with revised Sheet E-122A: Remove relays for interior lighting loads tied to the DDC. Circuitry indicated. Provide UL 924 shunt relay for egress lighting in these locations as shown. Revise lighting in Hallways 182 and 187

123. SHEET E-122B SECOND FLOOR PLAN - ZONE B - LIGHTING

- A. Replace Sheet with revised Sheet E-122B: Remove relays for interior lighting loads tied to the DDC. Circuitry indicated. Provide UL 924 shunt relay for egress lighting in these locations as shown. Control Media stacks via occupancy sensors and local wall switches. Provide local control for color changing RGB luminaire, type L9A.

124. SHEET E-222A SECOND FLOOR PLAN - ZONE A - POWER

- A. Replace Sheet with revised Sheet E-222A: Add power for microwaves and dishwasher at Lounge.

125. SHEET E-502 ENLARGED KITCHEN PLANS - ELECTRICAL
- A. Replace Sheet with revised Sheet E-502: Relocate outlets and panels. Add aluminum pedestal requirements for select outlets.
126. SHEET E-602 DETAILS LIGHTING CONTROLS
- A. Replace Sheet with revised Sheet E-602 Add control detail.
- B. Revise Detail C4
127. SHEET E-701 DIAGRAMS - ELECTRICAL ONE-LINE DIGRAM - NORMAL POWER
- A. Replace Sheet with revised Sheet E-701: Revise MDP rating 1200A and related feeder/spares.
128. SHEET E-801 MECHANICAL COORDINATION SCHEDULE
- A. Replace Sheet with revised Sheet E-801: Revise and add circuiting and starter requirement for select units.
129. SHEET E-802 MECHANICAL COORDINATION SCHEDULE
- A. Replace Sheet with revised Sheet E-802: Revise and add circuiting and starter requirement for select units.
130. SHEET E-900 PANEL SCHEDULES
- A. Replace Sheet with revised Sheet E-900: Revise ratings in MDP schedule, added revised load calculation. Add circuiting for select mechanical units.
131. SHEET E-901 PANEL SCHEDULES
- A. Replace Sheet with revised Sheet E-901: Add circuiting for select mechanical units.
132. SHEET E-902 PANEL SCHEDULES
- A. Replace Sheet with revised Sheet E-902: Add circuiting for select mechanical units.
133. SHEET E-903 PANEL SCHEDULES
- A. Replace Sheet with revised Sheet E-903: Revise branch circuit loads for microwaves and dishwasher at Lounge. Add circuiting for select mechanical units.
134. SHEET E-905 LIGHTING RELAY SCHEDULES
- A. Replace Sheet with revised Sheet E-905: Remove panels and associated schedules

APPROVALS

The following are approved based on information submitted to the Architect. Approval does not alter requirements of the Contract Documents. Contractor shall coordinate installation of approved products which the Contractor elects to use, making such changes as may be required for the Work to be complete in all respects.

<u>SECTION</u>	<u>ITEM</u>	<u>MANUFACTURERS/PRODUCT</u>
07 41 13	Metal Roof Panel	MS200 Metal Roof Panel by Taylor Metal Prod
08 71 00	Ball Bearing and Continuous Hinges	Ives
09 51 00	Acoustical Panel, Type A	Symphony M by CertainTeed
	Acoustical Panel, Type B	Vinyl Shield A by CertainTeed
09 83 11	Tackable Acoustic Wall Panels	Conweb
	Non-tackable Wall Panels	Conweb
23 33 00	Automatic Damper	Nailor Industries Model 1010
		Nailor Industries Model 1020
23 70 00	Indoor Air Handler	Dalkin Applied Model LAH
23 81 00	Split System Air Conditioning	Fujitsu
24 40 00	Mop Sink, MS-1	Acorn Terrazzo TCR-28

26 50 00 Light Fixture Manufacturers: The following manufacturers are approved for the fixtures noted. Fixture performance shall meet specified/scheduled requirements and will be reviewed upon award of contract and as noted below. Fixtures not meeting performance requirements will be rejected:

- L2 Lightolier
- L2A Lightolier
- L3 Metalux 22GR LED series
- L6 Nulite
- L7 Focal Point Seem 2 FSM2L series
- L8 Nulite
- L9 Lumenpulse
- L9 Focal Point Seem 2 FSM2LS series
- L11 Lithonia Lighting
- L12 Nulite
- L12 Prudential Bionic LED Wall Wash
- L14 Mark Lighting
- L17 V2 Lighting
- L17A V2 Lighting
 - LED driver must meet dimming performance criteria, as specified.
- L18 Focal Point Seem 2 FSM2LS series
- L22 Insight Lighting
- L20 LF Illumination
 - Provide sample to evaluate lighting quality.

- L22 Elliptipar
 - Note, specified lumen output and wattage performance to be met.
- S1 McGraw-Edison Galleon Series
- S2 McGraw-Edison Galleon Series
- S4 Louis Poulsen
 - Contractor to verify egress lighting levels in plaza, and architect to approve aesthetics prior to final approval.
- S5 Ligman Legend U40020 series
- S5A Ligman Legend U40020 series
- S6 Winona Lighting
- S7 Bega
- S9 Lithonia Lighting
- S10 WE-EF Lighting USA

END OF ADDENDUM NO. 5

BID FORM

BID FOR: Roosevelt Middle School Replacement CIP Number: 410.566.001
 Submitted to: Facilities Management Bid Deadline: 2:00 PM, March 19, 2015
 Eugene School District 4J
 715 West Fourth Avenue3
 Eugene, Oregon 97402

Submitted by: _____
 (Company Name)

BASE BID

The undersigned proposes to furnish all material, equipment, and labor required for the complete project, and to perform all work in strict accordance with the Contract Documents for the lump sum prices indicated below with completion occurring on or prior to the dates indicated:

BASE BID:

Bid: _____ \$ _____
 (Words) (Figures)

ALTERNATES

The undersigned proposes to furnish all material, equipment, and labor required for the following alternates as described in Section 01 23 00 - Alternates:

Alternate No. A1: Standing Seam Metal Roofing	Add	\$ _____
Alternate No. A2: Sports Field Upgrade	Add	\$ _____
Alternate No. A3: Covered Bike Storage	Add	\$ _____
Alternate No. A4: Multi-Modal Sidewalk at 24 th Avenue	Add	\$ _____
Alternate No. A5: Rainwater Harvesting System	Add	\$ _____
Alternate No. A6: Ceiling Tile AP-1	Deduct	\$ _____

The Owner reserves the right to exercise any or all alternates as its sole discretion within 60 days of the date of receipt of bids.

UNIT PRICES

The following Unit Prices as described in Section 01 22 00 are submitted by the Undersigned as a proposed basis for additive or deductive adjustments to the Bid Amount in the event quantity changes are required for the items listed. It is understood and agreed that these Unit Prices are separately subject to acceptance by the Owner and will thereafter be entered into the Agreement. The Unit Prices are to include all labor, travel and material costs.

Item 1: Over-Excavation and Back-Fill	\$ _____ / Cubic Yard
Item 2: Additional Length of Piles	\$ _____ / Foot of Pile Length

The Unit Prices are submitted as a proposed basis for additive or deductive adjustments to the Bid Amount in the event quantity changes are required for the items listed. It is understood and agreed that these Unit Prices are separately subject to acceptance by the Owner and may thereafter be entered into the Agreement.

TIME

The undersigned agrees, if awarded the Contract, to substantially complete all Base Bid work and accepted Alternates on or before the dates specified in Section 01 10 00.

BID SECURITY

Accompanying herewith is Bid Security, which is not less than ten percent (10%) of the total amount of the Base Bid.

STIPULATIONS

The undersigned acknowledges the liquidated damages provision included in the Supplementary Conditions.

The undersigned agrees, if awarded the contract, to comply with the provisions of Oregon Revised Statutes 279C.800 through 279C.870 pertaining to the payment of prevailing rates of wage

The undersigned agrees, if awarded the Contract, to execute and deliver to the Owner within ten (10) working days after receiving contract forms, an Agreement and a satisfactory Performance Bond and Payment Bond each in an amount equal to 100 percent (100%) of the Contract Sum.

For every bid \$100,000 or greater, all Contractors and Subcontractors shall have a public works bond, in the amount of \$30,000, filed with the Construction Contractors' Board (CCB), before starting work on the project, unless exempt. Contractor agrees to provide a copy of the Contractor's BOLI Public Works bond with the signed Agreement as Specified in the Supplementary Conditions.

The undersigned agrees that the Bid Security accompanying this proposal is the measure of liquidated damages which the Owner will sustain by the failure of the undersigned to execute and deliver the above named agreement and bonds; and that if the undersigned defaults in executing that agreement within ten (10) days after forms are provided or providing the bonds, then the Bid Security shall become the property of the Owner; but if this proposal is not accepted within sixty (60) days of the time set for the opening of bids, or if the undersigned executes and delivers said agreement and bonds, the Bid Security shall be returned.

By submitting this Bid, the Bidder certifies that the Bidder:

- a) has available the appropriate financial, material, equipment, facility and personnel resources and expertise, or the ability to obtain the resources and expertise, necessary to meet all contractual responsibilities;
- b) has a satisfactory record of past performance;
- c) has a satisfactory record of integrity, and is not disqualified under ORS 279C.440;
- d) is qualified legally to contract with the Owner; and
- e) will promptly supply all necessary information in connection with any inquiry the Owner may make concerning the responsibility of the Bidder.

Prior to award of a Contract, the Bidder shall submit appropriate documentation to allow the Owner to determine whether or not the Bidder is "responsible" according to the above criteria.

The contractor agrees with the provisions of Oregon Revised Statutes 279C.505, which requires that the contractor shall demonstrate it has established a drug-testing program for employees and will require each subcontractor providing labor for the Project to do the same.

The undersigned has received addenda numbers _____ to _____ inclusive and has included their provisions in the above Bid amounts.

The undersigned has visited the site to become familiar with conditions under which the Work is to be performed and has correlated the Bidder's personal observations with the requirements of the proposed Contract Documents.

The undersigned certifies that the Bidder is a _____ Bidder under ORS. ("Resident" or "Non-resident", to be filled in by Bidder)

Names of Firm:

Street Address:

_____ (City) (State) (Zip)

Telephone Number: _____ FAX Number: _____

Email Address: _____

Signed By: _____
(Signature of Authorized Official. If bid is from a partnership, one of the partners must sign bid).

Printed Name: _____

Date Signed: _____

Official Capacity: _____

If corporation, attest: _____ Date: _____
(Secretary of Corporation)

SEAL (If Corporate)

_____ Corporation
_____ Partnership
_____ Individual

Enclosed: Bid Security, Non-Discrimination Requirement, Non-Collusion Affidavit, First-Tier Subcontractor Disclosure Form

NON-DISCRIMINATION REQUIREMENT

Contractor certifies that the Contractor has not discriminated against minorities, women or emerging small business enterprises in obtaining any required subcontracts.

The Contractor agrees not to discriminate against any client, employee, or applicant for employment or for services, because of race, color, religion, sex, national origin, physical or mental handicap, sexual orientation or age, unless based upon bona fide occupational qualifications, and that they are otherwise in compliance with all federal, state and local laws prohibiting discrimination, with regard to, but not limited to, the following: Employment upgrading, demotion or transfer; Recruitment or recruitment advertising; Layoffs or termination; Rates of pay or other forms of compensation; Selection for training; Rendition of services. It is further understood that any vendor who is in violation of this clause shall be barred forthwith from receiving awards of any purchase order from the School District, unless a satisfactory showing is made that discriminatory practices have terminated and that a recurrence of such acts is unlikely.

FIRM NAME _____

ADDRESS _____

TELEPHONE _____

BY _____
(Company or Firm Officer)

BY _____
(Type or Print Name)

NON-COLLUSION AFFIDAVIT

STATE OF _____)

County of _____)

I state that I am _____ of _____
(Title) (Name of Firm)

and that I am authorized to make this affidavit on behalf of my firm, and its owners, directors, and officers. I am the person responsible in my firm for the price(s) and the amount of this bid.

I state that:

(1) The price(s) and amount of this bid have been arrived at independently and without consultation, communication or agreement with any other contractor, bidder or potential bidder, except as disclosed on the attached appendix.

(2) That neither the price(s) nor the amount of this bid, and neither the approximate price(s) nor approximate amount of this bid, have been disclosed to any other firm or person who is a bidder or potential bidder, and they will not be disclosed before bid opening.

(3) No attempt has been made or will be made to induce any firm or person to refrain from bidding on this contract, or to submit a bid higher than this bid, or to submit any intentionally high or noncompetitive bid or other form of complementary bid.

(4) The bid of my firm is made in good faith and not pursuant to any agreement or discussion with, or inducement from, any firm or person to submit a complementary or noncompetitive bid.

(5) _____, its affiliates, subsidiaries, officers, directors and
(Name of my Firm)
employees are not currently under investigation by any governmental agency and have not in the last four years been convicted of or found liable for any act prohibited by State or Federal law in any jurisdiction, involving conspiracy or collusion with respect to bidding on any public contract, except as described on the attached appendix.

I state that _____ understands and acknowledges that the above
(Name of my Firm)
representations are material and important, and will be relied on by School District 4J in awarding the contract(s) for which this bid is submitted. I understand and my firm understands that any misstatement in this affidavit is and shall be treated as fraudulent concealment from School District 4J of the true facts relating to the submission of bids for this contract.

(Authorized Signature)

Sworn to and subscribed before me this ____ day of _____, 2015

(Notary Public for Oregon)

My Commission Expires: _____

END OF BID FORM

DRIVEN STEEL PIPE PILES**PART 1 GENERAL****1.01 SECTION INCLUDES**

- A. Steel pipe piles driven by both hammering and vibration.
 - 1. Drive piles in accordance with the Geotechnical Report to provide the required pile capacity.
 - 2. Piles shall be driven to bedrock using impact systems or by vibration method at the option of the Contractor.
 - 3. Drive and seat all piles into bedrock using an impact hammer. The final set of the piles (used to calculate pile capacity) shall be based on an impact hammer.
 - 4. "Driving Piles" refers to both installation by vibratory hammers and traditional methods using impact hammers. "Driving Piles" as used in this Section refers to both methods unless the context clearly refers to one method only.

1.02 SUBMITTALS

- A. At least two weeks prior to mobilization at the site, submit data fully describing all proposed pile installation equipment including hammers, rams, driving cushions, pile caps and cap blocks to Engineer.
- B. Provide certification of yield strength and weldability of steel products by process acceptable to Engineer; mill certificates of chemical and physical properties, or equivalent.
- C. Installation Records:
 - 1. Prepare and submit to the Architect full-length installation records for each pile installed. The records shall be submitted within 2 days after installation is completed for the pile. The records shall include the following minimum information:
 - a. Project name and number.
 - b. Name of Contractor.
 - c. Pile location in pile group and designation of pile group.
 - d. Sequence of driving in pile group.
 - e. Pile dimensions.
 - f. Ground elevation.
 - g. Elevation of tip after driving.
 - h. Final tip and cutoff elevations of pile after driving pile group.
 - i. Records of re-driving.
 - j. Elevation of splices.
 - k. Type, make, model, and rated energy of hammer.
 - l. Weight and stroke of hammer.
 - m. Type of pile-driving cap used.
 - n. Cushion material and thickness.
 - o. Actual stroke and blow rate of hammer.
 - p. Pile-driving start and finish time; and total driving time.
 - q. Time, pile-tip elevation, and reason for interruptions.
 - r. Record of number of blows for each 12 inches of penetration, and number of blows per 1 inch for the last 6 inches of driving.
 - s. Pile deviations from location and plumb.
 - t. Record any special procedures used or occurrences during pile driving.
- D. Welding Certificates: Copies of certificates for welding procedures and personnel.
- E. Qualification Data: For firms and persons specified in "Quality Assurance" Article to demonstrate their capabilities and experience. Include lists of seven (minimum) completed projects within the last five years with project names and addresses, names and addresses of architects and owners, and other information specified.

- F. Mill test reports signed by manufacturer certifying that each of the following complies with requirements:
 1. Steel pipe piles.
 2. Steel castings.
 3. Steel plate.
- G. Pile-Driving Equipment: Include type, make, maximum rated energy, and rated energy per blow of hammer; weight of striking part of hammer; weight of drive cap; details, type, and structural properties of hammer cushion; and details of follower and jetting equipment.

1.03 QUALITY ASSURANCE

- A. Installer Qualifications: An experienced installer who has specialized in installing piling similar in material, design, and extent to that indicated for this Project.
- B. Survey Work: Surveys, layouts, and measurements related to pile driving shall be prepared by a surveyor or professional engineer who is legally qualified in jurisdiction where Project is located to perform these kinds of services.
- C. Professional Engineer Qualifications: A professional engineer who is legally qualified to practice in the State of Oregon and who is experienced in providing engineering services for piles that are similar to those indicated for this Project in material, design, and extent.
- D. Testing Agency Qualifications: An independent testing agency, acceptable to authorities having jurisdiction, qualified according to ASTM E 329 to conduct the testing indicated, as documented according to ASTM E 548.
- E. Comply with requirements of the following publications:
 1. AISC's "Load and Resistance Factor Design (LRFD) Specification for Structural Steel Buildings."
 2. AISC's "Specification for Structural Steel Buildings--Allowable Stress Design and Plastic Design."
- F. Welding Standards: Qualify welding procedures and personnel according to AWS D1.1, "Structural Welding Code--Steel."

1.04 DELIVERY, STORAGE, AND HANDLING

- A. Deliver materials to the project site in such quantities and at such times to assure the continuity of pile driving operations to the project schedule.
- B. Store piles in orderly groups above ground and blocked during storage to minimize possible distortion of members. Piles exhibiting variations beyond tolerance limits will be considered distorted and may not be used in the work.

1.05 PROJECT CONDITIONS

- A. Protect structures, underground utilities and other construction from damage caused by pile driving operations. Pre-excavate for piles as required and as specified.

PART 2 PRODUCTS

2.01 STEEL PIPE PILES

- A. Steel Piling: Provide Corrosion Resistant or Non-corrosion Resistant Steel Piling as follows:
 1. Corrosion Resistant Steel Piling: Reference General Structural Notes.
 - a. Provide painted, ASTM A123 galvanized or ASTM A972 epoxy coated.
 - b. Paint, galvanization and epoxy not required at head of piling where embedded in pile caps.
 2. Non-corrosion Resistant Steel Piling: Reference General Structural Notes and provide wall thickness 1/8" greater than specified.
 - a. Provide plain.

Formatted: Font: (Default) Arial, 10 pt

Deleted: for

Formatted: PR2, Space Before: 0 pt

Deleted: .

Formatted: PR3, Space Before: 0 pt

Formatted: Font: (Default) Arial, 10 pt

Formatted: Font: (Default) Arial, 10 pt

Formatted: PR2, Space Before: 0 pt

Formatted: PR3, Space Before: 0 pt

- B. Fabrication: Provide splice plates, pile cap plates of the same steel as piling. Fasten to piles with welded connections as shown on drawings.
 - 1. Piles: Open ended.

2.02 PAINT

- A. Paint: SSPC-Paint 16; self-priming, two-component, coal-tar epoxy polyamide.
 - 1. Color: Black or red.

2.03 DRIVING EQUIPMENT

- A. General: Furnish pile driving equipment of a type generally used in standard pile driving practice, operate equipment at manufacturer’s specified rate to develop the required rated energy. Drop hammers will not be allowed.
- B. Equipment:
 - 1. Provide equipment of adequate size and capacity to handle, place and hold the piles to the designed alignment. This equipment shall be able to maintain the alignment of pile with driving equipment, without damage to either.
 - 2. Maintain all pile driving equipment in safe operating condition at all times.
 - 3. Driving equipment shall be in good repair and operating condition and shall be capable of being operated as recommended by the manufacturer.
 - 4. Any equipment or methods which result in regular or repeated damage to the piles during driving, or is detrimental to the bearing capacity of piling already driven, will be rejected by the Engineer.
 - 5. Impact hammers shall be steam, air, or diesel driven that develop a rated energy of at least 5,000 ft-lbs per blow and no more than 17,000 ft-lbs per blow or as required to achieve the required pile tip penetration without overstressing the pile. Contractor is responsible for selecting driving equipment that will not cause damage to the piling or adjacent structures during driving.
 - 6. Vibratory hammers (if used) shall be of sufficient size and energy to install piles to the bedrock surface.
- C. Driving Caps: Provide driving caps capable of protecting pile head and providing uniform distribution of energy to pile head.
- D. Leads: Use fixed rigid type pile driver leads that will hold the pile firmly in position and alignment, and in axial alignment with the driving equipment. Free-swinging leads will not be permitted. Extend leads to within 2 feet of the elevation at which the pile enters the ground.

PART 3 EXECUTION

3.01 EXAMINATION

- A. Examine areas and conditions under which piles are to be installed, and correct conditions detrimental to the proper and timely completion of the work. Proceed with work only after unsatisfactory conditions have been corrected in a manner acceptable to the installer.

3.02 PRE-DRIVING WORK

- A. Site Conditions: Do not drive piles until the earthwork in the area which piles are to occupy has been completed, as follows:
 - 1. Excavations: Earth excavation will be stopped at an elevation of 6 inches to 12 inches above the bottom of the footing before piles are driven. Final excavation of the required elevation of footing bottoms will be done as part of the earthwork, after the piles have been driven.
 - 2. Fills: Fills will be constructed and compacted to the elevation of the grade indicated.
 - 3. Mobility of the Contractor’s equipment in the excavation is the Contractor’s responsibility.

- B. Pile Length Markings: Mark each pile with horizontal lines at 1'-0" intervals, and the number of feet from pile point at 5'-0" intervals. In order to be able to measure the driving resistance, mark the last 60 inches at one-inch intervals.
- C. Welding:
 - 1. Perform manual arc-welding using shielded metal arc or submerged arc method, complying with AWS Standards and requirements of the City.
 - 2. Use oxygen-gas or oxygen arc methods for field cutting of steel, complying with AWS recommendations.
- D. Welded Splices: Clean surfaces to be welded of rust, scale, oil, paint, and foreign material. Use only pile members with identical cross-sections for splicing.
 - 1. Only one splice per pile will be permitted, unless otherwise authorized by the Engineer. Make splices before starting driving operations wherever possible. If a welded splice is required during driving operation, make splice when top of drive pile portion is at least 3'-0" above ground, to permit inspection of welded connection during welding and during subsequent driving.
 - 2. Splices shall be 100% butt welded, producing straight pile alignment through splice and developing full strength of pile in both bearing and bending.

3.03 DRIVING PILES

- A. General:
 - 1. Drive each pile at the locations indicated, to satisfactory embedment and driving resistance directed by the Geotechnical Engineer.
 - a. Pile Lengths: Conform to recommendations of Geotechnical Report as stated on Drawings to provide piles of sufficient length to embed into bedrock and develop the capacity indicated on the Drawings.
 - b. Engineer reserves the right to modify driving criteria depending on the equipment used, field conditions encountered and observations made during pile installation.
 - 2. Carefully maintain the center of gravity for each group or cluster of piles to conform to the locations shown on the drawings.
 - 3. Carefully plumb the leads and the pile before driving. Take care during driving to prevent and to correct any tendency of piles to twist or rotate.
 - 4. Avoid excessive driving as established by the Geotechnical Engineer.
- B. Driving Tolerances: Drive piles within the following maximum tolerances:
 - 1. Location: 3 inches from location indicated for center of gravity of each single pile or pile groups; 2 inches for piles under walls.
 - 2. Plumbness: Maintain 1 inch in 10'-0" from the vertical, or a maximum of 4 inches, measured when the pile is above ground, in the leads.
 - 3. Batter Angle: Maximum 1 inch in 10 feet from required angle, measured when pile is above ground in leads.
- C. Heaved Piles: Compile recorded instrument observations made during pile driving to determine whether a driven pile has lifted from its original seat during the driving of adjacent piles. If uplift occurs, re-drive the affected piles to a point elevation at least as deep as the original point elevation with a driving resistance at least as great as the original driving resistance.
- D. Damaged or Misdriven Piles:
 - 1. Damaged piles, and piles driven outside the required driving tolerances, will not be accepted.
 - 2. Withdraw piles rejected after driving, and replace with new piles.
 - 3. Drive additional pile or piles where the centerline deviation exceeds 3 inches and an analytical determination indicates a load on any pile exceeding 110% of the design load. Modify to suit project or choose 4 or 5.
 - 4. Fill holes left by withdrawn piles that will not be filled by new piles using flowable cementitious fill.

- E. Cutting-Off:
 - 1. Cut-off tops of driven piles, square with pile axis and at elevations indicated.
- F. Pile Caps: After pile is cut-off, weld steel plates in place, square and level on top of pile as shown on the structural drawings. Provide steel reinforcing on top of piles as shown on the structural drawings.

3.04 FIELD QUALITY CONTROL

- A. Install a minimum of four indicator piles as directed by the Geotechnical Engineer, in order to verify design pile lengths.
- B. Indicator piles, furnished and driven by Contractor to determine lengths of piles, may become part of foundation system provided they conform to the contract requirements.
- C. Driving Indicator Piles:
 - 1. Use piles of the same diameters and lengths as those to be used in the work and drive with the appropriate pile driving equipment operating at the rated driving energy proposed to be used for the balance of the work.
 - 2. Drive indicator piles at locations selected by the Geotechnical Engineer to the specified driving resistance and capacity.
- D. Survey: Employ independent Professional Land Surveyor or Registered Civil Engineer to make field survey of completed piling. Show actual pile locations with respect to planned pile locations; and plumbness.
- E. Weld Testing: In addition to visual inspection, welds will be inspected and tested according to AWS D1.1 and the inspection procedures listed below, at testing agency's option. Correct deficiencies in and retest welds to determine compliance with requirements.
 - 1. Liquid Penetrant Inspection: ASTM E 165.
 - 2. Magnetic Particle Inspection: ASTM E 709; performed on root pass and on finished weld. Cracks or zones of incomplete fusion or penetration will not be accepted.
 - 3. Radiographic Inspection: ASTM E 94 and ASTM E 142; minimum quality level "2-2T."
 - 4. Ultrasonic Inspection: ASTM E 164.

3.05 TOUCHUP PAINTING

- A. Clean field welds, splices, and abraded painted areas and field-apply paint according to SSPC-PA 1. Use same paint and apply same number of coats as specified for shop painting.
 - 1. Apply touchup paint before driving piles to surfaces that will be immersed or inaccessible after driving.

3.06 DISPOSAL

- A. Remove withdrawn piles and cutoff sections of piles from site and legally dispose of them off Owner's property.

END OF SECTION

SECTION 12 93 00
SITE FURNISHINGS

PART 1 GENERAL

1.01 SECTION INCLUDES

- A. Benches.
- B. Trash and Recycling Receptacles.
- C. Bollards.
- D. Bike/Skate Deterrent.
- E. Picnic Table.

1.02 RELATED REQUIREMENTS

- A. Section 03 30 00 - Cast-in-Place Concrete:
- B. Section 05 50 00 - Metal Fabrications: Custom metal outdoor furnishings.

1.03 REFERENCE STANDARDS

- A. ASTM A36/A36M - Standard Specification for Carbon Structural Steel; 2008.
- B. ASTM A269 - Standard Specification for Seamless and Welded Austenitic Stainless Steel Tubing for General Service; 2008.
- C. ASTM A500/A500M - Standard Specification for Cold-Formed Welded and Seamless Carbon Steel Structural Tubing in Rounds and Shapes; 2010.
- D. ASTM A615/A615M - Standard Specification for Deformed and Plain Billet-Steel Bars for Concrete Reinforcement; 2009b.
- E. ASTM A666 - Standard Specification for Annealed or Cold-Worked Austenitic Stainless Steel Sheet, Strip, Plate, and Flat Bar; 2003.
- F. ASTM C33 - Standard Specification for Concrete Aggregates; 2008.

1.04 SUBMITTALS

- A. See Section 01 30 00 - Administrative Requirements, for submittal procedures.
- B. Product Data: Manufacturer's data sheets on each product to be used, including:
 - 1. Preparation instructions and recommendations.
 - 2. Storage and handling requirements and recommendations.
 - 3. Installation methods and details.
 - 4. Maintenance and cleaning recommendations.
 - 5. Warranty information.
- C. Shop Drawings: Indicate size, shape, and dimensions, including clearances from adjacent obstructions.
- D. Selection Samples: For each finish product specified, submit color chips for review and approval.

1.05 COORDINATION

- A. Coordinate with other trades affecting and affected by work of this Section.

1.06 DELIVERY, STORAGE, AND HANDLING

- A. Store products in manufacturer's unopened packaging with legible manufacturer's identification until ready for installation.
- B. Use all means necessary to protect materials of this Section before, during and after installation and to protect installed work and materials of other trades.

- C. In event of damage, immediately make all repairs and replacements necessary to approval of Owner's Representative.
- D. Store and handle materials in accordance with manufacturer's recommendations.

PART 2 PRODUCTS

2.01 BENCH

- A. Steel Bench: Install per manufacturer's recommendations.
 - 1. Material/Size: Solid steel rod and tubular steel, 6 foot length.
 - 2. Make/Model: Victor Stanley Model FS-53, Streetsites Collection, or approved.
 - 3. Finish: Metal components powder coated silver from manufacturer's standard finishes.
 - 4. Mounting: Surface mounted.
- B. Substitutions: Refer to Section 01 60 00 - Product Requirements.

2.02 TRASH AND RECYCLING RECEPTACLE

- A. Steel Receptacles: Install per manufacturer's recommendation.
 - 1. Material/Size: Recycled solid steel bar, 36-gal.
 - 2. Make/Model: Victor Stanley Model T-32, Streetsites Collection, or approved.
 - 3. Lid: Domed Lid
 - 4. Finish: Powder coated silver from manufacturer's standard finishes.
- B. Substitutions: Refer to Section 01 60 00 - Product Requirements.

2.03 BUILDING PROTECTION BOLLARD

- A. Steel Mechanical Square Tublar Steel Bollard.
 - 1. Make/Model: CBSQ-44-E-P-D by Creative Pipe, Inc. Rancho Mirage, CA, Tel. (800) 644-8467, or approved.
 - 2. Height: 36-inches
 - 3. Finish: Powder coat silver
 - 4. Mounting: Embedded 24-inches
 - 5. Cap: Domed Top Cap
- B. Substitutions: Refer to Section 01 60 00 - Product Requirements.

2.04 REMOVABLE BOLLARD

- A. Powder coated steel pipe bollard with cap and ground sleeve to allow for removing.
 - 1. Make/Model: CBSQ-44-RE-P-D by Creative Pipe, Inc. Rancho Mirage, CA, Tel. (800) 644-8467, or approved.
 - 2. Height: 36-inches
 - 3. Finish: Powder coat silver
 - 4. Mounting: Removable Embedded, Pad lockable.
 - 5. Cap: Domed Steel Top Cap
 - 6. Accessories: Pad lockable hole cover
- B. Substitutions: See Section 01 60 00 - Product Requirements.

2.05 BIKE/SKATE DETERRENT

- A. Material: 6061-T6 Aluminum
 - 1. Make/Model: FR 012-SS by Skatestoppers, El Cajon, CA (619) 447-6374, or approved.
 - 2. Finish: Type II Clear Anodize
 - 3. Mounting: Follow Manufacturer's recommendations.

- B. Substitutions: See Section 01 60 00 - Product Requirements.

2.06 PICNIC TABLE

- A. Picnic Table: Install per manufacturer's recommendations.
 - 1. Material: Solid steel rod and tublar steel, standard 6 foot length.
 - 2. Make/Model: Victor Stanley Model FBF-56, Streetsites Collection, or approved.
 - 3. Finish: Metal components powder coated silver from manufacturer's standard finishes.
 - 4. Mounting: Surface mounted.
- B. Substitutions: Refer to Section 01 60 00 - Product Requirements.

PART 3 EXECUTION

3.01 EXAMINATION

- A. Verify that mounting surfaces, preinstalled anchor bolts, or other mounting devices are properly installed; and ready to recieve site furnishing items.
- B. Do not begin installation until unsatisfactory substrates have been properly repaired.

3.02 PREPARATION

- A. Ensure surfaces to receive site furnishings are clean, flat, and level.
- B. Notify Owner' Representative for approval of Site Furnishing location prior to installation.

3.03 INSTALLATION

- A. Install in accordance with manufacturer's instructions.
- B. Install furnishings level, plumb, square, and correctly located as indicated on the drawings.
- C. Layout site furnishings for Owner's Representative to review location prior to installation.

3.04 CLEANING

- A. Clean installed work to like-new condition. Do not use cleaning materials or methods that could damage finish.

3.05 PROTECTION

- A. Protect installed products until completion of project.
- B. Touch-up, repair or replace damaged products before Substantial Completion.

END OF SECTION

SOLAR WATER HEATING SYSTEM**PART 1 - GENERAL****1.1 RELATED DOCUMENTS**

- A. Drawings and general provisions of the Contract, including General and Supplementary Conditions and Division 1 Specification Sections, apply to this Section.
- B. The provisions of Section 22 05 00, Common Work Results for Plumbing apply to work specified in this Section.

1.2 SUMMARY

- A. This Section includes: Solar heating water system equipment including solar collector panels and mounting, flow meter, heat exchanger, and storage tank.
- B. Related Sections include:
 - 1. Section 22 05 23 General Duty Valves and Specialties for Plumbing.
 - 2. Section 22 05 29 Hangers, Supports and Anchors for Plumbing.
 - 3. Section 22 05 53 Identification for Plumbing Piping and Equipment.
 - 4. Section 22 07 00 Insulation for Plumbing.
 - 5. Section 22 21 13 Pipe and Pipe Fittings Plumbing.
 - 6. Section 22 21 23 Pumps for Plumbing.
 - 7. Section 22 25 00 Plumbing Water Treatment.

1.3 SUBMITTALS

- A. Shop Drawings:
 - 1. Solar Collector Mounting Details: Provide layout and details of the solar collector mounting brackets and the connections to the roof system. Coordinate mounting bracket connections with roof system manufacturer. Provide certification from the roof system manufacturer that the solar collector mounting system is compatible with the roof system and will not affect the roof system warranty.
- B. Product Data:
 - 1. Solar Collectors.
 - 2. Storage Tank.
 - 3. Drainback Tank.
 - 4. Heat Exchangers.
 - 5. Flow Meter.
 - 6. Controller.
 - 7. Solar Collector Mounting Brackets.
- C. Operation and Maintenance Data.

1.4 INCENTIVES

- A. Qualifications:
 - 1. The installing contractor shall be an approved Solar Trade Ally with the Energy Trust of Oregon.
- B. Incentive Documentation:
 - 1. The installing contractor shall assist the owner in obtaining financial incentives by performing the calculations and the paperwork required for the following programs.
 - a. Energy Trust of Oregon (ETO) solar incentives program.
 - b. Oregon Business Energy Tax Credit (BETC) solar thermal program.
 - c. Federal Incentives will be obtained by pass thru documentation due to Non Profit Status of Building.

2. Application paperwork shall be prepared and submittal with adequate time for project incentive approval prior to purchasing any solar equipment.

PART 2 - PRODUCTS

2.1 SOLAR COLLECTOR PANEL

- A. Acceptable Manufacturers:
 1. Radco, Heliodyne, and SunEarth
 2. Other Manufacturers: Submit Substitution Request.
- B. Description: Solar collectors with extruded aluminum frame with bronze anodized finish .008" roll formed copper sheet absorber plate, absorber with black chrome selective coating over nickel plate or 3/4-inch internal copper manifolds with 1/2-inch waterway tubes, EPDM inserts at manifold seals, 1/8-inch low iron tempered glass glazing, foil faced insulation board and fiberglass blanket, bronze painted and embossed 0.014-inch minimum aluminum backing sheet. Collector shall have IAMPO listing and be SRCC certified.

2.2 STORAGE TANK

- A. Acceptable Manufacturers:
 1. Niles, Lochinvar, A.O. Smith, PVI, Roy E. Hanson Jr. Mfg.
 2. Other Manufacturers: Submit Substitution Request.
- B. Description:
 1. Construct tank of heavy gauge steel with glass lining, , and 150 psi working pressure
 2. Equip tank with sacrificial magnesium anodes and brass drain valve.
 3. Pre-Insulated tank with 2-inch minimum foam insulation that meets or exceeds ASHRAE 90.1b (current standard), with a baked enamel steel jacket.
 4. Temperature and pressure relief valve and drain valve.
 5. See Drawings for size, capacities and other details.

2.3 SOLAR DRAINBACK RESERVOIR

- A. Acceptable Manufacturers:
 1. SunEarth, A.O. Smith.
 2. Other Manufacturers: Submit Substitution Request.
- B. Description
 1. Construct tank of type 304 0.047 minimum gauge stainless steel, and 50 psi maximum working pressure.
 2. Pre-Insulated tank with foam insulation, 1" minimum on sides and 1-1/2" minimum on ends, with ABS plastic or heavy gauge jacket and end caps.
 3. Tank shall have a convenient filling access with location for pressure relief valve, a return line dip tube for question operation, and a sight glass. Dip tube shall have at least one hole towards the top to allow air to return to collectors with solar loop pump(s) off.
 4. See Drawings for size, capacities, and other details.

2.4 BRAZED PLATE TYPE WATER-TO-WATER HEAT EXCHANGER

- A. Acceptable Manufacturers:
 1. Alpha-Laval, Mueller, APV, Bell & Gosset.
 2. Other Manufacturers: Submit Substitution Request.
- B. Copper brazed plate single wall heat exchanger (suitable for use in domestic water system) shall consist of the specific number of Type 316 L stainless steel heat transfer plates as required to provide the total square footage of effective heat transfer area to meet the operating conditions specified.
- C. Each heat transfer plate shall be of "M" and "W" shaped herring boned corrugations to optimize heat transfer with nominal pressure losses.

- D. The complete assembly shall be factory assembled and tested in accordance with the ASME Code, Section VIII, Division 1, and furnished with ASME Code certification (U-1 Form) and stamp for a design pressure of 435 psig at 450°F for both circuits.

2.5 FLOW METER

- A. Acceptable Manufacturers: Bell & Gossett, Caleffi Blue-White, Letro or approved.
- B. Solar Loop Model Description: Visual flow meter and non-ferrous balance valve, cast iron or brass body, 125psi operating pressure, 240°F operating temperature, PSU or stainless steel indicating device, 2-5 GPM.
- C. Potable Loop Model Description: Visual flow meter, balance and check valve, low-lead brass body, 125 psi operating pressure, 230°F operating temperature, PSU or stainless steel indicating device, 2-5 GPM.

2.6 SOLAR COLLECTOR PANEL MOUNTING SYSTEM

- A. Acceptable Manufacturers:
 1. SunEarth Solar Strut, Heliodyne.
 2. Other Manufacturers: Submit Substitution Request.
- B. Mounting hardware:
 1. Collector mounting shall be achieved without roof penetrations.
 2. Collector mounting hardware shall be comprised of a collector manufacturer supplied aluminum clip system attached directly to the collector's mounting flange.
 3. Collector racks used to raise collectors tilt shall be fastened to structural members provided on the roof and able to sustain a wind load of not less than site loading requirements.
 4. Solar collector rack kits shall include:
 - a. Extruded aluminum channeled rails.
 - b. Front and back mount legs.
 - c. Mounting feet or other hanger bolt connection configuration.
 - d. Mounting clips, stainless steel 304 bolts, nuts and washers to assemble and attach to the collector mounting flange.
- C. Mounting Approval.
 1. Structural and wind loading calculations shall be stamped and signed by a licensed engineer in the state of site construction for the collector metal framing supports and collector anchorage.

PART 3 - EXECUTION

3.1 GENERAL:

- A. Install work in strict accordance with applicable codes, regulatory agencies, approved layout, and the Contract Documents, and in such a manner as to achieve required design criteria with components accurately placed and operating correctly.
- B. All work shall comply with requirements for available incentive programs such as BETC and ETO.

3.2 SOLAR COLLECTOR PANEL AND MOUNTING SYSTEM

- A. Install per manufacturer's instructions.
- B. Connect to structural locations indicated on the drawings.
- C. Each group of panels shall have its own support structure.

3.3 STORAGE TANK

- A. Install per manufacturer's instructions.
- B. Support on 4-inch housekeeping pad.
- C. Connect piping as indicated on the Drawings.

3.4 SOLAR DRAINBACK RESERVOIR

- A. Install per manufacturer's instructions.
- B. Support on 4-inch housekeeping pad.
- C. Connect piping as indicated on the Drawings.

3.5 BRAZED PLATE TYPE WATER-TO-WATER HEAT EXCHANGER

- A. Install per manufacturer's instructions.
- B. Connect piping as indicated on the Drawings.

3.6 FLOW METER

- A. Install according to manufacturer's instructions.
- B. Connect piping as indicated on the Drawings.
- C. Locate to ensure that the meter is visually accessible from a permanent walking surface.

END OF SECTION

PLUMBING FIXTURES

PART 1 - GENERAL

1.1 RELATED DOCUMENTS

- A. Drawings and general provisions of the Contract, including General and Supplementary Conditions and Division 1 Specification Sections, apply to this Section.
- B. The provisions of Section 22 05 00, Common Work Results for Plumbing HVAC apply to work specified in this Section.

1.2 SUMMARY

- A. This Section includes:
 - 1. Plumbing fixtures.
 - 2. Fixture trim.
 - 3. Drainage products.
 - 4. Miscellaneous plumbing items.

1.3 QUALITY ASSURANCE

- A. Water closets shall have Maximum Performance (MaP) score of no less than 800.
- B. Faucets shall be certified to NSF/ANSI 61.

1.4 SUBMITTALS

- A. Submit the following:
 - 1. Product data for each item specified.
 - 2. Operating and Maintenance Data:
 - a. Sensor operated flush valves.
 - 3. Mounting heights for all fixtures.

PART 2 - PRODUCTS

2.1 ACCEPTABLE MANUFACTURERS

- A. Manufacturers are stated for each fixture specified. The following manufacturers are also acceptable, except when indicated "only".
- B. Drainage Products and Carrier Products: J.R. Smith, Josam, Sioux Chief, Zurn, Wade, Watts Drainage, Woodford, Mifab.
- C. Fixtures: American Standard, Kohler, Sloan, Toto.
- D. Seats: Olsonite, Church, Beneke, Bemis.
- E. Mixing Valves: Powers, Leonard, Symmons, Chicago, Acorn SV16.
- F. Stainless Steel Products: Elkay, Just, Franke.
- G. Mop Sinks: Fiat, Williams, Mustee.
- H. Wash Stations: Bradley, SloanStone.
- I. Drinking Fountains: Elkay, Acorn.
- J. Showers: Moen, Delta.
- K. Faucets: Chicago, Elkay, Delta Commercial, Kohler, Moen Commercial, Sloan.
- L. Shock Arrestors: PPP, J.R. Smith.

- M. Trap Primer Stations: PPP, J.R. Smith.
- N. Exposed Waste and Supply Piping Insulation Kits: Truebro, McGuire.
- O. Other Manufacturers: Submit Substitution Request.

2.2 FIXTURE TRIM

- A. Supply Stops: Chicago cast brass rigid riser supplies with loose key angle stops, wall flanges, NPT female inlet, all chrome plate finish; equivalent NPT McGuire (LK series), Brasscraft (SCR series) or NPT stops by fixture supplier.
- B. Traps:
 1. For floor drains, provide coated cast iron P-trap; recessed, screw jointed or bell and spigot.
 2. For other fixtures, provide 17 gauge, chrome plated cast brass P-Traps with solder bushings, and clean-out.
- C. Support Rims: Hudee stainless steel rims, if sink not furnished with integral rim.
- D. Vacuum Breakers: Chicago Faucet, A.W. Cash or Febco chrome plated.

2.3 PLUMBING FIXTURES

- A. WC-1 Water Closet:
 1. Kohler "Kingston", vitreous china, wall hung, elongated bowl, siphon jet action, 1-1/2-inch top spud, white color finish. Complete with Sloan Regal 111-1.28 battery powered sensor flushometer, with vandal-proof cap.
 2. Bemis 1600 series white open-front seat, less cover with external check hinge including 300 series stainless steel post and pintles to stop seat at 11 degrees beyond vertical.
 3. J.R. Smith Series 200 chair carrier.
- B. WC-2 Water Closet(Adult ADA):
 1. Kohler "Kingston", vitreous china, wall hung, elongated bowl, siphon jet action, 1-1/2-inch top spud, white color finish. Complete with Sloan Regal 111-1.28 battery powered sensor flushometer with vandal-proof cap.
 2. Bemis 1600 series white open-front seat, less cover with external check hinge including 300 series stainless steel post and pintles to stop seat at 11 degrees beyond vertical.
 3. J.R. Smith Series 200 chair carrier.
- C. U-1 Urinal:
 1. Kohler Bardon, vitreous china, wall mounted wash down urinal with 3/4-inch top spud, white color finish. Complete with Sloan Optima 186-0.5 XL SMO sensor activated valve with dual filtered fixed bypass diaphragm, battery powered, with vandal proof cap (0.5 GPF).
 2. J. R. Smith Series 600 floor mounted urinal support.
- D. L-1 Lavatory :
 1. Kohler Kingston K-2005 21-1/4 x 18-1/8-inch, vitreous china, self-draining deck, backsplash, 4-inch centers, wall hung, concealed arm support, grid drain, white color finish.
 2. Chicago 802 series faucet with polished chrome plated solid brass body construction, 4-inch spout, vandal proof metering push handle, 1/2 GPM pressure compensating aerator, adjustable cycle time closure cartridge, vandal resistant complete.
- E. WS-1 Wash Station (ADA):
 1. Bradley, model LVRD2 series, wall hung, Mojave finish, equipped with Chicago MVP 3500 faucet, 0.5 gpm, manual push button metering faucet with single supply for tempered water service, and Chicago ECAST thermostatic mixing valve.

- F. WS-2 Wash Station (ADA):
- Bradley, model EXD-3N and EDN-2N series wall-hung, Mojave finish with grey trap cover, equipped with Chicago MVP 3500 faucet, 0.5 gpm, manual push button metering faucet with single supply for tempered water service, and Chicago ECAST thermostatic mixing valve.
- G. S-1 Sink:
- Elkay model ELUHAD series A.D.A. compliant, 21.5"x18.5"x5", gourmet undermount sink. ADA compliant, single compartment, 18 gauge, Type 304, ~~1-hole center~~ **2 hole configuration for single hole faucet with side valve.**, self-rimming, stainless steel sink; LK-18 grid strainer.
 - Chicago 748 series deck mounted, single hole drinking fountain chrome plated solid brass body construction, vandal proof metering push handle, anti-microbial flexible mouth guard.
 - ~~Elkay model LKDVR (208513C), single hole mixing sink faucet, 12-1/2" rigid solid brass spout, single handle, 2.2 GPM pressure compensating laminar flow outlet, vandal resistant complete.~~
 - Chicago Mechanical Faucet 2302 series gooseneck faucet, single hole with side valve. 5-1/4" Rigid / Swing Gooseneck Spout. 1.5 GPM. 4-5/8" Lever Handle. Ceramic Volume Control and Hot Water Limit Stop Cartridge. 3/8" Compression Flexible Stainless Steel Hoses. ADA compliant. Vandal resistant complete.**
- H. S-2 Sink:
- Elkay **Lustertone** model LRAD series, 25"x21.25"x6", A.D.A. compliant gourmet drop in sink. ADA compliant, single compartment, 18 gauge, Type 304, ~~1-hole center~~ **2 hole configuration for single hole faucet with side valve.**, self-rimming, stainless steel sink; LK-18 grid strainer.
 - ~~Elkay model LKDVR (208513C), single hole mixing sink faucet, 12-1/2" rigid solid brass spout, single handle, 2.2 GPM pressure compensating laminar flow outlet, vandal resistant complete.~~
 - Chicago Mechanical Faucet 2302 series gooseneck faucet, single hole with side valve. 5-1/4" Rigid / Swing Gooseneck Spout. 1.5 GPM. 4-5/8" Lever Handle. Ceramic Volume Control and Hot Water Limit Stop Cartridge. 3/8" Compression Flexible Stainless Steel Hoses. ADA compliant. Vandal resistant complete.**
- I. S-3 Sink:
- Elkay model SE Super Economy Series Sink (SE2C18x18-2-18X) free standing sink. Two compartments, two drain boards, backsplash, 18 gauge, Type 300, 1-hole center (each compartment), self-rimming, stainless steel sink; LK-99 grid strainer .
 - Chicago 640-L8E1-317YAB series, ceramic wall mount 8-inch center commercial faucet, two hole dual handle wall mount faucet with 4-inch wrist blades, 1/2" rigid solid brass spout, single handle, 2.2 GPM pressure compensating laminar flow outlet, vandal resistant complete.
- J. S-4 Sink:
- Elkay **Gourmet Undermount Single Bowl Sink** model ELUH2816 series, 30.5"x18.5"x11.5" undermount sink. Single compartment, 18 gauge, Type 304, ~~1-hole center~~ **2 hole configuration for single hole faucet with side valve.**, self-rimming, stainless steel sink; LK-99 grid strainer.
 - ~~Elkay model LKDVR (208513C), single hole mixing sink faucet, 12-1/2" rigid solid brass spout, single handle, 2.2 GPM pressure compensating laminar flow outlet, vandal resistant complete.~~
 - Chicago Mechanical Faucet 2302 series gooseneck faucet, single hole with side valve. 5-1/4" Rigid / Swing Gooseneck Spout. 1.5 GPM. 4-5/8" Lever Handle. Ceramic Volume Control and Hot Water Limit Stop Cartridge. 3/8" Compression Flexible Stainless Steel Hoses. ADA compliant. Vandal resistant complete.**

- K. S-5 Sink:
1. Elkay **Lustertone** model LRAD series, 25"x21.25"x6", A.D.A. compliant gourmet drop in sink. ADA compliant, single compartment, 18 gauge, Type 304, **1-hole-center 2 hole configuration for single hole faucet with side valve.**, self-rimming, stainless steel sink; LK-18 grid strainer.
 - ~~2. Elkay model LKDVR (208513C), single hole mixing sink faucet, 12-1/2" rigid solid brass spout, single handle, 2.2 GPM pressure compensating laminar flow outlet, vandal resistant complete.~~
 - 2. Chicago Mechanical Faucet 2302 series gooseneck faucet, single hole with side valve. 5-1/4" Rigid / Swing Gooseneck Spout. 1.5 GPM. 4-5/8" Lever Handle. Ceramic Volume Control and Hot Water Limit Stop Cartridge. 3/8" Compression Flexible Stainless Steel Hoses. ADA compliant. Vandal resistant complete.**
 3. Speakman SE-572 series integral countertop mounted emergency eyewash, aerated with flip-top dust caps, stainless steel push handle activation, 1/2" inlet, 3 GPM @ 30 psi.
- L. MS-1 Mop Sink:
1. Fiat TSB series, 28x28x12-inch molded stone mop basin, wall bracket, 5-foot hose, bumper guards & wall guards (two sides).
 2. Chicago 540 series ceramic wall mounted service faucet with polished chrome plated solid brass body construction, lever handles, pail hook, wall brace, vacuum breaker, check stops and hose thread outlet.
- M. SH-1 Shower (ADA):
1. Moen Commercial Shower, Model 8342EP15 assembly with polished chrome finish, pressure balance mixing valve (Acorn SV16), high temperature limit stop, lever handle, 1.5 GPM hand held shower with 2 integral check valves and 69-inch hose and slide bar, 24-inch ADA wall/grab bar and rough in kit.
 2. J.R. Smith 200 series floor drain with nickel bronze grate.
- N. Master Mixing Valve Assembly: Leonard Type TM New Generation High Low, exposed, factory tested and assembled mixing valve assembly consisting of but not limited to: large and small rough bronze finish thermostatic mixing valves, high temperature limit stops, angle checkstops, outlet ball valve shutoffs, built-in spring check valve with pressure gauges, thermometer, inlet piping manifolds with unions. Unit to control discharge temperature to ±1%. Unit shall be mounted in locking stainless steel cabinet. See schedule on drawings for capacities.
- O. DF-1 Drinking Fountain (ADA): Elkay LZWS-EDFPBM117K series dual height wall hung drinking fountain with integral bottle filler.
1. Surface mounted fountain.
 2. Contoured basins.
 3. Push pad operated bubblers.
 4. Vandal resistant bubbler guards.
 5. Surface mounting plate.
 6. 1.5 GPM Bottle Filler.
- P. Exposed Waste and Supply Piping Insulation Kits: McGuire Prowrap insulation kit for exposed supplies and waste piping below ADA lavatories and ADA sinks.

2.4 DRAINAGE PRODUCTS

- A. HB-1 Hose Bibb: Chicago 952 series, chrome-plated, removable key, 3/4-inch hose thread, integral vacuum breaker.
- B. WH-1 Wall Hydrant: J.R. Smith Fig. 5609QT, bronze finish, loose key, 3/4-inch hose thread, integral vacuum breaker, freeze proof.
- C. WSCB-1 Water Supply Control Box (for Garbage Can Wash): J.R. Smith 3380 series, recessed water supply control box in type 304 stainless steel with a No. 4 satin finish, cylinder type key lock, cold and hot water screwdriver stops, flow control valve, and atmospheric vacuum breaker.

- D. RD-1 Roof Drain (Small Area): J.R. Smith 1330 series, 8-1/2-inch low profile diameter dome, cast iron body with combined flashing clamp and gravel stop, no-hub outlet and under deck clamp.
- E. OD-1 Overflow Roof Drain (Small Area Overflow): J.R. Smith 1330 series, 8-1/2-inch low profile diameter dome, 2-inch high solid water dam, cast iron body with combined flashing clamp and gravel stop, no-hub outlet and under deck clamp.
- F. FD-1 Floor Drain: J.R. Smith 2005 series, round nickel bronze vandal resistant grate, cast iron body with flashing collar and adjustable strainer head and no-hub outlet.
- G. FD-2 Floor Drain (Unfinished Areas): J.R. Smith 2110 series, round cast iron grate, cast iron body, no-hub outlet, sediment bucket.
- H. FD-3 Floor Drain (Finished Areas - Kitchens): J.R. Smith 2010 series, vandal-proof, square nickel bronze hinged grate, sediment bucket, cast iron body with flashing collar, adjustable strainer head and no-hub outlet
- I. FD-4 Floor Drain (Garbage Can Wash Drain): J.R. Smith 3370 series, acid resisting coated interior, nickel bronze grate, free standing sediment bucket lined with 1/4-inch stainless steel mesh screen, no-hub outlet and bronze adjustable nozzle assembly. FS-1 Floor Sink (Finished Areas - Kitchens): J.R. Smith 3101-12 series, acid resistant coated floor sink, vandal-proof 8-1/2 x 8-1/2-inch nickel bronze 1/2 grate and sediment bucket, no-hub outlet and flashing collar.
- J. FS-1 Floor Sink (Finished Areas - Kitchens): J.R. Smith 3101-12 series, acid resistant coated floor sink, vandal-proof 8-1/2 x 8-1/2-inch nickel bronze 1/2 grate and sediment bucket, no-hub outlet and flashing collar.
- K. FS-2 Floor Sink (Finished Areas - Kitchens): Same as FS-1, except with 3/4 grate.
- L. FS-3 Floor Sink (Finished Areas - Kitchens): Same as FS-1, except no grate.
- M. FS-4 Floor Sink (mechanical room indirect waste): J.R. Smith 3041 series floor sink with 8-inch deep receptor, basket strainer, 1/2 cast iron grate, no-hub outlet and flashing collar..
- N. WCO Wall Cleanout: J.R. Smith 4530 series, round stainless steel vandal resistant cover and screw.
- O. FCO Floor Cleanout: J.R. Smith 4020 series, round vandal resistant, nickel bronze top.
- P. CTG Cleanout to Grade: J.R. Smith 4220 series, round, extra heavy duty cast iron top set in 12x12x4-inch deep concrete pad, vandal resistant.
- Q. DSB-1 Downspout Boot: J.R. Smith 1787 series, 4-inch round downspout connection.
- R. DSB-2 Downspout Boot: J.R. Smith 1785 series, 4x3-inch rectangular downspout connection.
- S. Trap Priming Valves: Precision Plumbing Products Prime-time electronic trap priming manifold including but not limited to: atmospheric vacuum breaker, pre-set 24 hour clock, manual over ride, 120V solenoid valve, calibrated manifold for equal water distribution, 3/4-inch water hammer arrester. Components pre-installed in recessed steel cabinet with SS access door.
- T. Water Hammer Arrester: J.R. Smith 5005 – 5050 series, Precision Plumbing Products Model SC (Maintenance-Free).

PART 3 - EXECUTION

3.1 FIXTURE TRIM

- A. Provide plumbing fixture trim where applicable on fixtures, including but not limited to supply stops, traps, support rims, flush valve, and vacuum breakers.

- B. Provide rough-in and final piping connection to fixtures. Carefully review all construction documents to assure that all fixtures are provided with necessary services for a complete operating system.
- C. Rigidly secure rough-in piping, carriers and supports, and other service piping to structure.

3.2 PLUMBING FIXTURES

- A. Americans with Disabilities Act:
 - 1. Those fixtures indicated by "ADA" shall comply with and be installed in accordance with Americans with Disabilities Act Guidelines (ADAAG). Where applicable building code requirements are more stringent than ADAAG guidelines, building code requirements shall be followed.
 - 2. Water Closets:
 - a. Mounting height of ADA water closet shall be 17 to 19 inches from floor to top of the toilet seat.
 - b. Mount flush valve for ADA water closets on wide side of enclosure.
 - 3. Lavatories:
 - a. Mounting height of ADA lavatories shall be at a maximum height of 34 inches from floor to rim.
 - b. Provide insulation kits on exposed hot water and waste piping beneath ADA lavatories.
 - 4. Sinks: Provide insulation kits on exposed hot water and waste piping beneath ADA sinks.
 - 5. Urinals:
 - a. Mounting height of ADA water closet shall be at a maximum height of 17 inches from floor to rim.
- B. Fixture Mounting Heights: All fixtures standard rough-in catalogued heights unless shown otherwise on the Architectural Drawings.
- C. Showers:
 - 1. Piping from shower mixing valve to shower head shall be rigid pipe. PEX piping not allowed.
 - 2. Shower Head Mounting Heights: Mount so that face of head is at 6'-6" above finished floor and shall not conflict with shower enclosure.
- D. Water Supplies: When both hot and cold water to a fixture is required, connect the hot on the left and the cold on the right.
- E. Lavatories:
 - 1. Public toilet room lavatories shall have grid strainers.
 - 2. Those lavatories indicated as "ADA" are ADA compatible. Coordinate with Architect to verify if all wall hung lavatories are to be installed at ADA height.
- F. Floor Drain and Floor Sinks:
 - 1. Set top flush with finished floor.
 - 2. Provide flashing clamp for all drain bodies installed in floors provided with waterproof membranes.
- G. Cleanout:
 - 1. Where shown or required.
 - 2. Cover set flush with finished surface.
- H. Roof and Area Drains: Provide sump receivers for all drains except poured in place installations. Provide extension section as required to compensate for the specified insulation thickness above the roof slab or deck.
- I. Water Hammer Arresters: Provide where shown and where recommended by Plumbing Drainage Institute (PDI).
- J. Drinking Fountains:

1. All water-bearing materials shall comply with the Safe Drinking Water Act of 1986 and the Lead Contamination Control Act of 1988. The waterway system of the unit shall be manufactured of copper components and other completely lead-free materials.
2. Provide fixture manufacturer's wall mounting plate or floor mounted support for all wall-hung drinking fountains.

K. Mixing Valves: Provide piping connections per manufacturer's installation instructions.

L. Wall hung lavatories with pop-up waste assemblies: Contractor shall verify there is no vertical pull rod assembly conflict with lavatory backsplash prior to submitting product data.

3.3 PRIMING VALVES

A. All floor drains, floor sinks and similar traps shall be primed. Use minimum 3/8-inch type K annealed copper tubing. Primer line to be continuous and without joints.

B. Where priming valves are installed in finished rooms, conceal in wall and provide access panel.

C. Coordinate locations of electronic trap primer stations with electrical contractor for 120V service.

3.4 KITCHEN EQUIPMENT

A. General: Kitchen equipment is supplied and set in place by Kitchen Supplier, installed in construction contract. Obtain drawings before any rough-in is started. Complete installation and furnish all equipment required or scheduled below to give complete working installation. Symbol numbers are indicated by oval symbol with number inside. See "PLUMBING FIXTURES" for supply types and traps.

END OF SECTION

VARIABLE FREQUENCY DRIVES FOR HVAC EQUIPMENT

PART 1 - GENERAL

1.1 RELATED DOCUMENTS

- A. Drawings and general provisions of the Contract, including General and Supplementary Conditions and Division 1 Specification Sections, apply to this Section.
- B. The provisions of Section 23 05 00, Common Work Results for HVAC apply to work specified in this Section.

1.2 SUMMARY

- A. This Section includes: Variable frequency drives.

1.3 SUBMITTALS

- A. Submit the following:
 - 1. Product data on variable frequency drives and related components.
 - 2. Start up log/check list showing successful operation.
 - 3. Operation and maintenance data.

PART 2 - PRODUCTS

2.1 VARIABLE FREQUENCY DRIVES

- A. Acceptable Manufacturers:
 - 1. Reliance, Toshiba, ABB, Cirrus, Emerson, Yaskawa, Square D, Siemens, Safronics, Allen-Bradley, Danfoss.
 - 2. Other Manufacturers: Submit substitution request.
- B. General Description:
 - 1. Variable frequency AC motor drive (VFD) to be of pulse width modulated (PWM) inverter type. The VFD designed to convert 60 Hz input power to adjustable frequency output power to provide positive speed control to standard induction motors. The VFD to be dedicated variable torque design for specific use with centrifugal loads.
 - 2. Provide completely solid state variable frequency power and logic unit.
 - 3. Speed control to be stepless throughout the range under variable torque load on continuous basis. Speed controlled by remote building energy management system providing 4-20MA input signal to drive and remote start/stop signal. Coordinate with Section 23 09 00.
 - 4. Provide adjustable frequency control with diode bridge/capacity input designed to provide high, constant power factor of 0.95 regardless of load or speed and eliminate SCR line noise.
 - 5. Equipment will be designed and manufactured in accordance with applicable current NEMA and IEEE recommendations and be designed for installation per NEC. Equipment will be UL listed and bear the UL label.
 - 6. Control shall be suitable for operation in ambient temperatures of 0 to 40°C.
 - 7. Every VFD shall be factory tested with an AC induction motor 100% loaded and temperature cycled within an environmental chamber at 104°F.
- C. Self Protection and Reliability Features:
 - 1. Adjustable current limit to 60 to 110% of drive rating.
 - 2. Adjustable instantaneous overcurrent trip.
 - 3. Under voltage trip.
 - 4. Over temperature trip.
 - 5. Short circuit protection phase to phase and phase to ground faults phase rotation insensitive.
 - 6. Momentary power loss, more than 17 milliseconds.
 - 7. Transient protection against all normal transients and surges in incoming power line.

8. Orderly shutdown in event of any of above conditions, drive shall be designed to shut down safely without component failure.
 9. Provide visual indication and manual reset.
- D. Standard Features:
1. Drive logic shall be microprocessor based. Control logic shall be isolated from power circuitry.
 2. Stand alone operation to facilitate start up and troubleshooting procedures.
 3. VFD shall be UL 508C listed for drives serving a single motor or UL 508A listed for drives serving multiple motors, for use on distribution systems with 22,000 AIC.
 4. Output voltages shall be equal to applied input voltage.
 5. Isolated signal inputs.
 6. Frequency Stability. Output frequency will be held to +0.1% of maximum frequency regardless of load, +10% input voltage change or temperature changes within ambient specification.
 7. Built-in digital display shall indicate output frequency, voltage and current and shall provide indication of over current, over voltage, current limit, ground fault, over temperature, input power on, minimum or maximum speed adjustment, power on, fault condition. Display shall be on panel face.
 8. Start/Stop Control - Controlled decelerated stop.
 9. Primary and secondary fused for a control circuit transformer.
 10. Minimum and maximum speed control.
 11. Adjustable Accel/Decel - independently adjustable 10-100 second.
 12. Hand-Off auto switches.
 13. Programmable Auto Restart - after power outage.
 14. Provide fused **safety disconnect switch and NEMA enclosure suitable for installed location and environment.** ~~Disconnect shall include including~~ auxiliary contacts to isolate control circuit when disconnect is in "off" position. ~~except f~~ Fused disconnects **shall not be** required where packaged equipment is provided with a single point connection with single point **integral** disconnect and internal overcurrent protection for VFD and motors. **Refer to Section 26 29 00 Motor Controllers for additional requirements pertaining to safety disconnect switches.**
 15. Remote contacts for fault, and on/off status.
 16. Adjustable motor output voltage.
 17. Analog output voltage of 0-10 VDC, -20 MA proportional to control output frequency.
 18. Provide a NEMA 1 enclosure for indoor applications and NEMA 3R enclosure for outdoor applications to isolate each motor starter and control section with its associated disconnect switch.
 19. Manual speed control for each motor.
 20. Manual bypass (3 contactor) to provide ability to service control while motor is operational.
 21. Provide RF, and EMI, noise suppression network to limit RF and EM interference.
 22. Provide isolated analog output signals for volts, amps, and frequency, from each VFD for connection to the building energy management system.
 23. Provide line (input) reactors.
 24. Provide output filters for all VFD's located more than 25 conductor feet from the motor they serve. Output reactors shall permit VFD's to be located up to 350' from the motors they serve.
 25. VFD shall be designed to catch a spinning load in forward and reverse direction.
 26. Harmonic calculations shall be performed on a manufacturer supplied Harmonic Analysis program to provide conformance with IEEE 519-1992.
 27. Automatic Bypass option.
- E. Communications:
1. Provide factory installed communication chip for direct network connection to DDC Control System specified in Section 23 09 93. Interface shall allow for all control and interface functions specified herein and in Section 23 09 93. Interface control functions and information shall include, but not be limited to the following:
 - a. Start/Stop

- b. Change Directions
 - c. Drive Fault
 - d. Drive Fault Codes
 - e. Reset Drive
 - f. Percent Output
 - g. Speed
 - h. Power
 - i. Drive Temp
 - j. KWH
 - k. Run Time
- 2. Provide isolated analog output signals for volts, amps and frequency from each VFD for connection to the DDC Control System specified in Section 23 09 93.
 - 3. Provide RS485 communications port and programming software capability.

PART 3 - EXECUTION

3.1 VARIABLE FREQUENCY DRIVE INSTALLATION

- A. Install VFD in accordance with manufacturer's written installation instructions.
- B. Install on strut support stand.
- C. Provide one drive for each motor as scheduled.

3.2 START UP

- A. General: Comply with manufacturer's instructions for startup.
- B. Startup shall be provided under the direct supervision of the manufacturer's representative with factory trained personnel.

3.3 FIELD QUALITY CONTROL

- A. Prior to installation, manufacturer's representative shall coordinate variable speed drive control interface with the controls contractor and verify that intended installation (controls, wiring, etc.) complies with the manufacturer's recommendations.
- B. Field Test: Except where initial variable speed drive operation clearly shows the performance meets or exceeds the requirements, test to show compliance. Tests performed by the manufacturer's representative in the presence of the Engineer.

END OF SECTION

VIBRATION AND SEISMIC CONTROLS FOR HVAC PIPING AND EQUIPMENT

PART 1 - GENERAL

1.1 RELATED DOCUMENTS

- A. Drawings and general provisions of the Contract, including General and Supplementary Conditions and Division 1 Specification Sections, apply to this Section.
- B. The provisions of Section 23 05 00, Common Work Results for HVAC apply to work specified in this Section.

1.2 SUMMARY

- A. This Section includes:
 - 1. Isolation of mechanical equipment as indicated on the Drawings and specified herein.
 - 2. Seismic restraint of equipment, piping and ductwork.
- B. Related Sections include:
 - 1. Section 23 05 18 HVAC Expansion Compensation.
 - 2. Section 23 05 29 Hangers, Supports and Anchors for HVAC.
 - 3. Section 23 31 01 HVAC Ducts and Casing-Low Pressure.

1.3 QUALITY ASSURANCE

- A. A single manufacturer shall select and furnish all isolation required, except packaged equipment with integral isolators meeting all the isolation and seismic requirements of this specification.
- B. The system of vibration isolators and seismic controls shall be designed, detailed, and bear the seal of a professional engineer registered in the State having jurisdiction.
- C. Isolation performance requirements are indicated in the specifications. All deflections indicated are nominal static deflections for specific equipment supported.
- D. Isolator Stability and Rated Capacity:
 - 1. Spring diameters not less than 0.8 of the compressed height of the spring at rated load.
 - 2. Springs shall have a minimum additional travel to solid equal to 50% of the rated deflection.
- E. Seismic Restraints:
 - 1. Restraint of equipment, piping and ductwork to be in accordance with the current state and local Building Code.
 - 2. All calculations shall be in accordance with current state and local Building Code.

1.4 SUBMITTALS

- A. Submit the following:
 - 1. Submit Shop Drawings showing complete details of construction for steel and concrete bases including:
 - a. Equipment mounting holes.
 - b. Dimensions.
 - c. Isolation selected for each support point.
 - d. Details of mounting brackets for isolator.
 - e. Weight distribution for each isolator.
 - f. Code number assigned to each isolator.
 - 2. Submit product data and calculation sheets for isolators, showing:
 - a. Size, type, load rating and rated deflection of each required isolator.
 - b. Percent of vibration transmitted based on the lowest disturbing frequency of the equipment.
 - 3. Structural Details and Calculations: Submit structural details and calculations substantiating that building structure, anchorages, and fabricated steel braces can safely withstand maximum calculated loads.

- B. Installation report as specified in Part 3 of this section.
- C. Operation and maintenance data.

1.5 EQUIPMENT VIBRATION ISOLATION

- A. Provide a balanced set of vibration isolators for each piece of equipment listed in the Equipment Schedules.
- B. Isolation work to include, but not necessarily be limited to, the following:
 - 1. Isolation support of motor-driven equipment.
 - 2. Inertia base frames in conjunction with isolation.
 - 3. Isolation support of air-handling housings.
 - 4. Isolation support of piping, piping risers, and ductwork.
 - 5. Penetration isolation of pipework, ductwork, and conduits through walls, floors or ceilings.
 - 6. Flexible connections of ductwork and piping to equipment.
- C. Each piece of rotating equipment must meet a reasonable criterion for maximum vibration levels at each bearing, while in operation. The criteria for varying operating speeds are given as follows:
 - 1. Rotating equipment operating peak vibration velocities must not exceed 0.08 in./sec.
 - 2. If it is discovered that the operating vibration velocities exceed this criteria, the equipment shall be repaired or replaced at no expense to the owner until approval of the equipment is given by the engineer.
- D. Any components or materials not specially mentioned herein, but necessary to the proper vibration isolation of the equipment, shall be provided.

1.6 ACCEPTABLE MANUFACTURERS

- A. Amber Booth.
- B. Mason Industries, Inc.
- C. Kinetics Corporation.
- D. Vibrex.
- E. Vibro-Acoustics
- F. Approved equal, meeting all of the conditions and requirements specified herein.

1.7 CONTRACTOR RESPONSIBILITY

- A. All vibration isolation devices, including auxiliary steel bases and pouring forms, shall be designed and furnished by a single manufacturer or suppliers.
- B. Adequately restrain all equipment, piping, and ductwork to resist seismic forces. Design and select restraint devices to meet seismic requirements as defined in the latest issue of the International Building Code under Earthquake Design and applicable state and local codes.
- C. In addition, the contractor shall have the following responsibilities:
 - 1. Selection, installation, adjustment and performance of vibration isolators which will meet the requirements given on the plans or in the specifications.
 - 2. Provide Engineering drawings, details, supervision, and instruction to assure proper installation and performance.
 - 3. Provide whatever assistance necessary to ensure correct installation and adjustment of the isolators.

PART 2 - PRODUCTS

2.1 TYPE 1 - NEOPRENE WAFFLE PAD

- A. 3/4-inch thick neoprene waffle pads with pattern repeating on 1/2-inch centers.
- B. Select Duro rating for maximum deflection at average load rating.
- C. Include load distribution steel plate as required.
- D. Include anchor bolt grommet as required.
- E. Acceptable Manufacturer: Mason Type "Super W" or "Super WM" and "HG Grommet"; Similar Amber-Booth, Kinetics Corporation.

2.2 TYPE 2 - RESTRAINED NEOPRENE MOUNT

- A. Bridge-bearing neoprene mountings shall have all directional seismic capability.
- B. Provide minimum deflection of 0.2-inch.
- C. The mount shall consist of a ductile iron casting containing two separated and opposing molded neoprene elements.
- D. The elements shall prevent the central threaded sleeve and attachment bolt from contacting the casting during normal operation.
- E. The shock absorbing neoprene materials shall be compounded to bridge-bearing specifications.
- F. Manufacturer: Mason type BR.

2.3 TYPE 3 - SPRINGS

- A. Free standing springs without housings.
- B. 1/4-inch thick molded neoprene cup with steel reinforcement washer or neoprene acoustical friction pads between base plate and support.
- C. All mounting shall have leveling bolts with height saving brackets.
- D. Springs mounted outboard of channels.
- E. Attach baseplate screws using neoprene bushings and washers.
- F. Spring diameters not less than 0.8 of the compressed height of the spring at rated load.
- G. Manufacturer: Mason type SLF, Amber-Booth type SW, Kinetics Corporation, Vibrex.

2.4 TYPE 4 - SPRINGS WITH RESTRAINTS

- A. Same as springs except housing with seismic restraints to be added.
- B. Seismic restraint with molded all directional neoprene bushings an integral part of isolator.
- C. Seismic restraint selected for minimum safety factor of 2 from ultimate seismic capacity.
- D. Spring mount must have neoprene cup or pad inside the seismic housing to allow anchoring of the housing baseplate without short circuiting pad.
- E. Manufacturer: Mason type SSLR or SLRS with seismic restraints; similar Amber-Booth, Kinetics Corporation Model FYS, Vibrex.

2.5 TYPE 5 - BASE WITH SPRINGS

- A. Steel Isolating Frame: Mason WFSL with WF steel beams with a minimum depth of 10% of the span between supports. Provide external height saving brackets.
- B. Manufacturer: Mason as indicated, similar Amber-Booth, Kinetics Corporation, Vibrex.

2.6 TYPE 6 – INERTIA BASE WITH SPRINGS

- A. Inertia Bases: Mason BMK or KSL with 1/2-inch square bar reinforcing, integral height saving brackets and steel templates with anchor bolts sleeves. Bases must be sized to fit stanchions for pump elbows or suction diffusers. Depth of base equal to 8% of the span between supports, 6-inch minimum.
- B. Manufacturer: Mason as indicated, similar Amber-Booth, Kinetics Corporation, Vibrex.

2.7 TYPE 7 - ISOLATING SPRING HANGERS

- A. Combination rubber-in shear and steel spring isolators installed on the hanger rods.
- B. Isolators shall have the proper deflection to allow the piping to deflect as a unit with the pump isolators.
- C. Hangers designed for 30 degree angular movement.
- D. Minimum deflection shall be one inch.
- E. Manufacturer: Mason 30N, similar Amber-Booth, Consolidated Kinetics, Vibrex.

2.8 TYPE 8 – ISOLATING NEOPRENE HANGERS

- A. Double deflection neoprene hangers.
- B. Provide minimum static deflection of 0.5-inches.
- C. Provide projecting bushing to prevent steel to steel contact.
- D. Manufacturer: Mason HD, similar Amber-Booth, Consolidated Kinetics, Vibrex.

2.9 ISOLATING SLEEVES

- A. Provided for all piping through walls and floors of penthouses and chiller room. Size for piping as required.
- B. Manufacturers: Potter-Roemer PR isolators or Grinnell Semco Trisolators.

2.10 SEISMIC RESTRAINTS

- A. General Requirements:
 - 1. Seismic restraints shall be provided for all equipment, piping and ductwork, both supported and suspended.
 - 2. Bracing of piping and ductwork shall be in accordance with the code and with the provisions set forth in the SMACNA seismic restraint manual.
 - 3. The structural requirements for the restraints, including their attachment to the building structure, shall be reviewed and approved by the structural engineer.
 - 4. Attachments to supported or suspended equipment must be coordinated with the equipment manufacturer.
- B. Supported Equipment:
 - 1. All-directional seismic snubbers shall consist of interlocking steel members restrained by a one-piece molded neoprene bushing of bridge bearing neoprene.
 - 2. Bushing shall be replaceable and a minimum of 1/4-inch thick. Rated loadings shall not exceed 1000 psi.
 - 3. An air gap of 1/4-inch shall be incorporated in the snubber design in all directions before contact is made between the rigid and resilient surfaces.
 - 4. Snubber end caps shall be removable to allow inspection of internal clearances. Neoprene bushings shall be rotated to ensure no short circuits exist before systems are activated.
 - 5. Snubber shall be type Z-1225 as manufactured by Mason Industries, Inc.

C. Bracing of Pipes:

1. Provide seismic bracing of all piping as detailed below to meet the building code requirements:
 - a. Exception: Piping suspended by individual hanger's 12-inches or less in length, as measured from the top of the pipe to the bottom of the support where the hanger is attached, need not be braced where the following criteria are met.
 - 1) Seismic braces are not required on high deformability piping when the $I_p=1.0$ and provisions are made to avoid impact with larger pipe or mechanical components or to protect the pipe in the event of such impact and the nominal pipe size is 3-inches diameter or less.
 - 2) Seismic braces are not required on high deformability piping when the $I_p=1.5$ and provisions are made to avoid impact with larger pipe or mechanical components or to protect the pipe in the event of such impact and the nominal pipe size is 1-inch diameter or less.
 2. Seismic braces for pipes on trapeze hangers may be used.
 3. Provide flexibility in joints where pipes pass through building seismic joints or expansion joints, or where pipes connect to equipment.
 4. Cast iron pipe of all types, glass pipe, and any other pipe jointed with a shield and clamp assembly, where the top of the pipe is 12-inches or more from the supporting structure, shall be braced on each side of a change in direction of 90 degrees or more. Riser joints on unsupported sections of piping shall be braced or stabilized between floors.
 5. Vertical risers shall be laterally supported with a riser clamp at each floor. For buildings greater than six stories high or for piping subject to thermal change all risers shall be engineered individually.

D. Bracing of Ductwork:

1. Brace rectangular ducts with cross sectional areas of 6 square feet and larger. Brace flat oval ducts in the same manner as rectangular ducts. Brace round ducts with diameters of 28 inches and larger. Brace flat oval ducts the same as rectangular ducts of the same nominal size.
2. Exception: No bracing is required if the duct is suspended by hangers 12 inches or less in length, as measured from the top of the duct to the bottom of the support where the hanger is attached, and the $I_p=1.0$.
3. Transverse bracing shall occur at the interval specified in the SMACNA tables or at both ends if the duct run is less than the specified interval. Transverse bracing shall be installed at each duct turn and at each end of a duct run, with a minimum of one brace at each end.
4. Longitudinal bracing shall occur at the interval specified in the SMACNA tables with at least one brace per duct run. Transverse bracing for one duct section may also act as longitudinal bracing for a duct section connected perpendicular to it if the bracing is installed within four feet of the intersection of the ducts and if the bracing is sized for the larger duct. Duct joints shall conform to SMACNA duct construction standards.
5. Install duct flex connections at equipment connections to accept expected differential displacement and protect the equipment connection from damage.

E. Suspended Equipment and Piping and Ductwork:

1. Seismic cable restraints shall consist of galvanized steel aircraft cables sized to resist seismic loads with a minimum safety factor of two and arranged to provide all-directional restraint.
2. Cable must be pre-stretched to achieve a certified minimum modulus of elasticity. Cable end connections shall be steel assemblies that swivel to final installation angle and utilize two clamping bolts to provide proper cable engagement.
3. Cable assemblies shall be type SCB at the ceiling and at the clevis bolt, SCBH between the hanger rod and the clevis or SCBV if clamped to a beam, all as manufactured by Mason Industries, Inc.

4. Steel angles, sized to prevent buckling, shall be clamped to pipe or equipment rods utilizing a minimum of three ductile iron clamps at each restraint location when required. Welding of a minimum of three ductile iron clamps at each restraint location when required. Welding of support rods is not acceptable. Rod clamp assemblies shall be type SRC or UC as manufactured by Mason Industries, Inc.
5. Pipe clevis cross-bolt braces are required in all restraint locations. They shall be special purpose preformed channels deep enough to be held in place by bolts passing over the cross bolt. Clevis cross brace shall be type CCB as manufactured by Mason Industries, Inc.

2.11 FLEXIBLE SPHERE CONNECTOR

- A. Flexible EPDM pipe connectors shall be manufactured of multiple plies of Kevlar tire cord fabric and EPDM; both molded and cured in hydraulic rubber presses. No steel wire or rings shall be used as pressure reinforcement.
- B. Connectors up to and including 2-inch diameter may have a single sphere and threaded ends. Connectors 2-1/2-inch and larger shall be manufactured with twin spheres up to 12-inches and a single sphere on larger sizes and floating steel flanges recessed to lock the connectors raised face EPDM flanges.
- C. All connectors shall be rated a minimum of 150 psi at 220°F. All connections shall be pre-extended as recommended by the manufacturer to prevent additional elongation under pressure.
- D. Mason type SFU, SFDEJ or SFEJ.

2.12 FLEXIBLE HOSE CONNECTOR

- A. Flexible stainless steel hoses shall be manufactured using type 304 stainless steel hose and braid with one fixed and one floating raised face carbon steel plate flange.
- B. Sizes 2-1/2-inch (65mm) and smaller may have threaded male nipples or copper sweat ends. Grooved ends are acceptable in all sizes in grooved piping systems. Weld ends are not acceptable. Copper sweat end hoses for water service shall be all copper or bronze construction.
- C. Hose shall have close pitch annular corrugations for maximum flexibility and low stiffness. Tested hose stiffness at various pressures must be included in the submittals.
- D. Hose shall be capable of continuous operation at 150 psi and system test pressure when installed in piping systems.
- E. Hose shall be the same size as the pipe it connects and have pipe thread connectors on both ends with male or female end adapters as required.
- F. Mason type BSS, FFL, MN, CPS or CPSB, similar HCi, Metraflex.

PART 3 - EXECUTION

3.1 GENERAL

- A. Do not install any equipment or pipe which makes rigid contact with the building. "Building" includes slabs, beams, studs, walls, etc.
- B. The installation or use of vibration isolators must not cause any change of position of equipment or piping which would result in stresses in piping connections or misalignment of shafts or bearings. In order to meet this objective, equipment and piping shall be maintained in a rigid position during installation. The load shall not be transferred to the isolator until the installation is complete and under full operational load.
- C. Correct, at no additional cost, all installations which are defective in workmanship or materials.

3.2 PREPARATION

- A. Treat all isolators, including springs, hardware and housing, with a corrosion protective coating of epoxy powder or electro galvanizing.
- B. Coat steel frames exposed to weather with a rustproof metal primer.
- C. Provide hot dipped galvanizing on steel frames as indicated on the plans for corrosion protection in severe conditions.

3.3 INSTALLATION

- A. General:
 1. Install isolation where indicated on the Drawings by type and location and where indicated below.
 2. The assigned code number shall be marked on the isolators and bases to assure placement in the proper location.
 3. Anchor isolator seismic housing baseplate to floor.
 4. Rubber grommets and washers shall be provided to isolate the bolt from the building structure. Under no circumstances shall the isolation efficiency be destroyed when bolting the isolators to the building structure.
- B. Type 1 – Neoprene Waffle Pad
 1. Service:
 - a. Roof-mounted exhaust fans
 - b. Air Handlers and Fan Coil Units with Motors two horsepower and less.

C. Type 2 – Restrained Neoprene Mount

1. Service:
 - a. Condensing units

D. Type 4 – Springs with Restraints

1. Service:
 - a. Exhaust fans where floor mounted – ½” deflection.
 - b. Air Handlers fans with Motors greater than 2 horsepower – one inch static deflection

E. Type 6 – Inertia Base with Springs

1. Service:
 - a. Centrifugal Pumps
 - 1) Fill with concrete to provide base weight equal to 2 times supported weight, including equipment, piping, and fluid.
 - 2) Support heels of pump suction and discharge elbows from base.
 - 3) Secure pump and heel supports with inserts and grout.
 - 4) Springs to have min 1” deflection

F. Type 7 – Isolating Spring Hangers

1. Service:
 - a. Propeller Fans – 2 inch deflection.
 - b. Exhaust fans with motors larger than ½ horsepower - 1/2” deflection.

G. Type 8 – Isolating Neoprene Hanger

1. Service:
 - a. In-Line Circulating Pumps
 - b. Split-System Air Conditioning Units
 - c. Exhaust fans with motors ½ horsepower and smaller – 0.2” deflection.

H. Flexible Connectors:

1. Mechanical Couplings: Provide three or more flexible couplings as vibration isolation as indicated on the drawings and for the following services:
2. Flexible Sphere Connectors: Provide as indicated on the drawings and for the following services: Base-mounted pumps, deflection as scheduled.

3. Flexible Hose Connectors: Provide as indicated on the drawings and for the following services: Air handling unit coil connections.

3.4 SEISMIC RESTRAINTS

- A. General:
 1. Install and adjust seismic restraints so that the equipment, piping, and ductwork support is not degraded by the restraints.
 2. Restraints must not short circuit vibration isolation systems or transmit objectionable vibration or noise.
- B. Supported Equipment:
 1. Each vibration isolation frame for supported equipment shall have a minimum of four seismic snubbers mounted as close as possible to the vibration isolators and/or the frame extremities.
 2. Care must be taken so that the 1/4-inch air gap in the seismic restraint snubber is preserved on all sides in order that the vibration isolation potential of the isolator is not compromised. This requires that the final snubber adjustment be completed after the vibration isolators are properly installed and the installation approved.
- C. Bracing of Pipes:
 1. Branch lines may not be used to brace main lines.
 2. Transverse bracing shall be at 40 feet maximum, except where a lesser spacing is indicated in the SMACNA tables for bracing of pipes
 3. Longitudinal bracing shall be at 80 feet maximum except where a lesser spacing is indicated in the tables. In pipes where thermal expansion is a consideration, an anchor point may be used as the specified longitudinal brace provided that it has a capacity to resist both the seismic load and the additional force induced by expansion and contraction.
 4. A rigid piping system shall not be braced to dissimilar parts of the building or to two dissimilar building systems that may respond differently during an earthquake.
 5. Transverse bracing for one pipe section may also act as longitudinal bracing for a pipe section of the same size connected perpendicular to it if the bracing is installed within 24 inches of the elbow or tee.
 6. Subject to confirmation by field inspection, seismic bracing is not required on piping when the piping is supported by rod hangers and the hangers in the entire run are 12-inches or less in length from the top of the pipe to the supporting structure, hangers are detailed to avoid bending of the hangers and their attachments and provisions are made for piping to accommodate expected deflections.
- D. Bracing of Ductwork:
 1. Hanger straps must be positively attached to the duct within 2 inches of the top of the duct with a minimum of two #10 sheetmetal screws.
 2. A group of ducts may be combined in a larger frame so that the combined weights and dimensions of the ducts are less than or equal to the maximum weight and dimensions of the duct for which bracing details are selected.
 3. Walls, including gypsum board nonbearing partitions, which have ducts running through them, may replace a typical transverse brace. Provide solid blocking around duct penetrations at stud wall construction.
 4. Unbraced ducts shall be installed with a 6-inch minimum clearance to vertical ceiling hanger wires.
- E. Suspended Equipment, Piping, and Ductwork Cable Method:
 1. The cables shall be adjusted to a degree of slackness approved by the Structural Engineer.
 2. The uplift and downward restraint nuts and Mason type RW neoprene covered steel rebound washers for the Type 6 hangers shall be adjusted so that there is a maximum 1/4-inch clearance.

3.5 FIELD QUALITY CONTROL

- A. Installation Report: Isolation manufacturer's representative shall confirm that all isolation is installed correctly and submit report stating that isolators are installed as shown on Shop Drawings, isolators are free to work properly, and that installed deflections are as scheduled and as specified.

END OF SECTION

INSULATION FOR HVAC

PART 1 - GENERAL

1.1 RELATED DOCUMENTS

- A. Drawings and general provisions of the Contract, including General and Supplementary Conditions and Division 1 Specification Sections, apply to this Section.
- B. The provisions of Section 23 05 00, Common Work Results for HVAC apply to work specified in this Section.

1.2 SUMMARY

- A. This Section includes: Insulation for piping, ductwork (external), ductwork (internal), and equipment.
- B. Related Sections include:
 - 1. Section 23 05 29 Hangers, Supports and Anchors for HVAC.
 - 2. Section 23 31 01 HVAC Ducts and Casing – Low Pressure.

1.3 QUALITY ASSURANCE

- A. Regulatory Requirements:
 - 1. All insulating products shall comply with the Oregon Revised Statute (ORS) 453.005(7)(e) prohibiting pentabrominated, octabrominated and decabrominated diphenyl ethers. Where products within this specification contain these banned substances, provide complying products from approved manufacturers with equal performance characteristics.
 - 2. Flame and Smoke Ratings: Installed composite flame spread not to exceed 25 and smoke developed not to exceed 50 as tested by UL 723.
 - 3. Energy Codes: Local Building and Energy Codes shall govern where insulation performance requirements for thickness exceeds thickness specified.
- B. Protection: Protect against dirt, water, chemical, or mechanical damage before, during, and after installation. Repair or replace damaged insulation at no additional cost.
- C. Source Quality Control:
 - 1. Service: Use insulation specifically manufactured for service specified.
 - 2. Labeling: Insulation labeled or stamped with brand name and number.
 - 3. Insulation and accessories shall not provide any nutritional or bodily use to fungi, bacteria, insects, rats, mice, or other vermin, shall not react corrosively with equipment, piping, or ductwork, and shall be asbestos free.

1.4 SUBMITTALS

- A. Submit the following.
 - 1. Product Data: For each type including density, conductivity, thickness, jacket, vapor barrier, and flame spread and smoke developed indices.

PART 2 - PRODUCTS

2.1 ACCEPTABLE MANUFACTURERS

- A. Equivalent products by Johns Manville, Knauf, Owens Corning, and CertainTeed are acceptable.
- B. All such insulation shall be of one manufacturer.
- C. Other Manufacturers: Submit Substitution Request.

2.2 PIPE INSULATION

- A. Fiberglass: Split sectional or snap-on type with 0.23 per inch maximum thermal conductivity (K-factor) at 75°F mean temperature, 850°F maximum service rating and white, vapor barrier jacket with pressure sensitive closure system. Johns Manville Microlok HP.
- B. Elastomeric: Expanded closed cell, 0.27 per inch maximum K-factor at 75°F mean temperature, 220°F maximum service rating with fitting covers and paintable surface. ArmacellAP Armaflex, Rubatex.
- C. Polyolefin: Semi-rigid polyolefin form snap-on or slip over type with 0.24 per inch maximum thermal conductivity (K-factor) at 75°F mean temperature -165°F to 210°F service factor and paintable surface. End joints in insulation on piping with fluid temperatures normally below 65°F fuse sealed in accordance with the manufacturer's instructions. Joints longitudinal joints and other end joints made with manufacturer's approval contact adhesive in accordance with the manufacturer's instructions. Joints may be pre-glued or pre-coated with adhesive where applicable.

2.3 BLOCK INSULATION

- A. Fiberglass: 1-1/2-inch thick unless specified or shown otherwise with 3 pcf nominal density, 0.23 per inch maximum K-factor at 75°F mean temperature and 450°F minimum operating temperature limit. Johns Manville 1000 Series.

2.4 DUCTWORK BLANKET INSULATION

- A. Fiberglass: 1.0 pcf nominal density, 0.25 per inch maximum K-factor at 75°F mean temperature, 250°F minimum operating temperature limit. Johns Manville Microlite Type 100 with facing as follows:
 - 1. Exposed: FSK facing (foil scrim Kraft) or vinyl - white appearance.
 - 2. Concealed with Vapor Barrier: FSK reinforced foil and paper.
 - 3. Concealed without Vapor Barrier: Facing not required.
- B. Semi-Rigid Fiberglass: 2.5 pcf nominal density, 0.24 per inch maximum K-factor, at 75°F mean temperature, 250°F minimum operating temperature limit. Johns Manville Micro-Flex with facing as follows:
 - 1. Exposed: FSK facing (foil scrim kraft) or vinyl-white appearance.
 - 2. Concealed with Vapor Barrier: FSK reinforced foil and paper.
 - 3. Concealed without Vapor Barrier: Facing not required.
- C. Elastomeric: Expanded closed cell sheets, 0.27 per inch maximum K-factor at 75°F mean temperature and 220°F minimum operating temperature limit. ArmacellArmaflex.

2.5 DUCTWORK BOARD INSULATION

- A. Semi-Rigid Fiberglass: 0.23 per inch maximum K-factor at 75°F mean temperature, 250°F minimum operating temperature limit and all-purpose vapor barrier facing with white Kraft paper finish. Micro-Aire Duct Board Type LP.
- B. Rigid Fiberglass: Same as semi-rigid except with 4.0 pcf density and 0.23 per inch maximum K-factor. Johns Manville Diffuser Board.

2.6 DUCT INSULATION, INTERNAL

- A. Description: Fiberglass with airstream surface protected with a glass mat facing that contains an EPA registered anti-microbial agent proven to resist microbial growth as determined by ASTM G21 and G22, 1-inch thick unless indicated otherwise. 2-inch thick insulation shall have 0.24 per inch maximum K-Factor at 75°F mean temperature. Johns Manville Duct Liner PM for rectangular ductwork.

- B. Acoustical Absorption Coefficients: With minimum NRC of 0.70 for 1-inch and 0.90 for 2-inch as tested in accordance with ASTM C-423-90, type A mounting.
- C. Liner must meet ASTM C1071.

2.7 DUCT ENCLOSURE, FIRE RATED

- A. Johns Manville:
 - 1. Material:
 - a. 2-hour Rated: Johns Manville "Super Firetemp M", minimum 3-inch thickness, ASTM E2336, 2-hour rated assembly.
 - b. 1-hour Rated: Johns Manville "Super Firetemp L", minimum 2-1/4-inch thickness, ASTM E2336, 1-hour rated assembly.
 - 2. Joint: Johns Manville "Super Calstik" adhesive, modified sodium silicate adhesive.
- B. Firemaster:
 - 1. Material: Thermal Ceramics "Firemaster" duct wrap ceramic fiber blanket, minimum 3-inch total thickness, ASTM E2336, 2-hour rated assembly.
- C. Fyrewrap:
 - 1. Material: Unifrax "Fyrewrap" duct wrap fiberglass blanket, 1.5-inch thickness for 1-hour rated assembly, 3-inch thickness for 2-hour rated assembly. ASTM E2336.

2.8 ACCESSORIES PIPING

- A. Adhesives:
 - 1. Fiberglass: Zeston Z-Glu.
 - 2. Elastomeric: Armacell 520.
 - 3. Polyolefin: As approved by the insulation manufacturer.
- B. Cements:
 - 1. Insulating: Ryder.
 - 2. Heat Transfer: Zeston Z-20.
- C. Wire Mesh: 1-inch mesh with 20 gauge annealed steel wire.
- D. Pipe Fitting Covers: One piece PVC insulated pipe fitting covers. Zeston, Ceel-Co.
- E. Grooved Coupling Insulation: One piece PVC insulated fitting cover. Zeston, Ceel-Co.
- F. Metal Pipe Jacket: 0.016-inch thick aluminum jacket with formed fitting covers, aluminum snap straps and sealant.
- G. Cloth Facing: Presized fiberglass cloth.
- H. Tapes: Pressure sensitive, weather resistant, and for temperatures up to 150°F. Zeston Z-tape.
- I. Paint: Ultraviolet resistant latex paint with special adherence capabilities to the PVC fitting covers, elastomeric, aluminum facing, Kraft paper, tapes and adhesives.

2.9 ACCESSORIES DUCTWORK

- A. Adhesives:
 - 1. Fiberglass: Zeston Z-Glu.
 - 2. Duct Insulation, Internal: Benjamin Foster 85-20.
- B. Weld Pins: Duro-Dyne with NC-1 nylon stop clips.
- C. Cements:
 - 1. Insulating: Ryder.
 - 2. Heat Transfer: Zeston Z-20.
- D. Wire Mesh: 1-inch mesh with 20 gauge annealed steel wire.

- E. Mastic: Chicago Mastic:
 1. Vapor Barrier: 17-475.
 2. Outdoor Mastic: 16-110 white.
- F. Cloth Facing: Presized fiberglass cloth.
- G. Tapes: Pressure sensitive, weather resistant, and for temperatures up to 150°F. Zeston Z-tape.
- H. Paint: Ultraviolet resistant latex paint with special adherence capabilities to the PVC fitting covers, elastomeric, aluminum facing, Kraft paper, tapes and adhesives.

PART 3 - EXECUTION

3.1 GENERAL

- A. Workmanship:
 1. Installation: Insulation installed in first class, neat professional manner.
 2. Applicators: Applicators shall be employed by firm that specializes in insulation work.
- B. Preparation: Surfaces of piping, ductwork and equipment clean, free of oil or dirt, and dry before insulation is applied.
- C. Stamps: ASME stamps, UL labels, and similar stamps and labels shall not be covered.

3.2 HVAC PIPE AND EQUIPMENT INSULATION APPLIED LOCATIONS

- A. Insulation Applied Locations – HVAC Piping:

System	Pipe Size	Insulation Type	Insulation Thickness	Notes
Heating Water (to 250°F)	1 1/4-inch and smaller	Fiberglass	2-inch	Note 1
	1 1/2-inch to 6-inch	Fiberglass	2 1/2-inch	Note 1
Chilled Water	1 1/4-inch to 6-inch	Fiberglass	1 1/2-inch	Note 1
Pre-Insulated Chilled Water	All	Polyurethane foam	1 1/2-inch	Note 2
Dual Temp Water	1 1/4-inch and smaller	Fiberglass	2-inch	Note 1
	1 1/2-inch to 6- inch.	Fiberglass	2 1/2-inch	Note 1
Refrigerant Suction, Hot Gas	All	Elastomeric or Polyolefin	1 1/2-inch	Note 3
Air Separators and Storage Tanks	All	Fiberglass	3 1/2-inch	
		Elastomeric or Polyolefin	3 1/2-inch	Note 3

Note 1: Cover with metal pipe jacket where exposed to weather and overheat trace cable.

Note 2: Refer to specification 23 20 14 for additional pre-insulated piping systems requirements.

Note 3: Elastomeric or Polyolefin insulation not allowed over heat trace cable.

- B. The following piping is not insulated:
 1. Refrigerant relief valve discharge.
- C. Insulation shall include all fittings, unions, flanges, mechanical couplings, valve bodies, valve bonnets, piping through sleeves.
 1. Hot water heating inside building.

- D. Piping insulation is not required between the control valve and coil on run-outs when the control valve is located within 4 feet of the coils and the pipe size is 1-inch or less.
- E. Valves and irregular fittings shall be insulated with section of pipe insulation and insulating cement, securely fastened, and finished with 6 oz. canvas and Foster 30-36 lagging adhesive. The contractor shall have the option on all flanges, valves, strainers, not requiring a vapor barrier to insulate with removable replaceable pads fabricated of 1-inch layer of Pittsburgh Corning Temp Mat sandwiched between inner and outer layer of 8 oz. glass cloth held together with stainless staples with sufficient stainless lacing hooks to hold pad firmly to flange or valve with minimum 3-inch overlap onto adjacent pipe insulation using 18 gauge S.S. lacing wire.
- F. Expansion Joints and Flexible Connectors: Pipe insulation or block of same material and thickness as adjacent piping.

3.3 PIPING INSTALLATION

- A. General:
 - 1. Joints: Coat both sides of complete joining area with applicable adhesive.
 - a. Longitudinal Joints: Make joints on top or back of pipe to minimize visibility. Except foam plastic, seal with closure system or 3-inch wide tape.
 - b. Butt Joints: Butt lightly together and, except for foam plastic, seal with 3-inch wide tape or butt straps.
 - c. Multiple Layered Insulation: Joints staggered.
 - 2. Access: Strainer and other items requiring service or maintenance with easily removable and replaceable section of insulation to provide access.
 - 3. Voids: Fill all voids, chipped corners and other openings with insulating cement or material compatible with insulating material. In insulation with Heat Tracing: Where piping is shown or specified to be heat traced, bed heat tape into heat transfer cement with insulation over heat tape and cement.
 - 4. Seal joints, seams and fittings of metal watertight jackets at exterior locations.
- B. Fiberglass Insulation: Exterior insulation encased in metal jacket.
- C. Elastomeric and Polyolefin Insulation:
 - 1. Slit full length and snap around pipe.
 - 2. Make cuts perpendicular to insulating surface leaving no cut section exposed.
 - 3. Do not stretch insulation to cover joints or fittings.
 - 4. Seal joints in elastomeric insulation with adhesive.
 - 5. Seal joints in polyolefin as specified hereinbefore.
 - 6. Exterior insulation painted with two coats of specified paint in accordance with the manufacturer's instructions and encase in metal jacket.
 - 7. Sealing joints with tape will not be allowed.
- D. Fittings: Insulation specified with continuous vapor barrier, the vapor barrier must not be violated.
 - 1. On Elastomeric and Polyolefin Insulation: Fittings covered with covers made up of mitered sections of insulation or with formed pipe fitting covers.
 - 2. In Other Insulation: Fittings covered with insulation to the same level of the adjoining insulation or fill with insulating cement. Finish with pipe fitting covers or cloth facing and tape.
- E. Unions, Mechanical Joints, Valves, Etc.:
 - 1. General:
 - a. As specified for fittings.
 - b. Minimum thickness same as specified for piping.
 - 2. Unions: Build up insulation at least 1/2-inch beyond adjoining insulation.
 - 3. Flanges: With square corners. Where flanges are not insulated, terminate adjacent insulation so flange bolts can be removed.
 - 4. Flanged Valves: Insulation with square corners.

- F. Vapor Barrier Insulation:
1. Refer to Section 23 05 29 for support requirements.
 2. Piping which requires vapor barrier protection shall have a continuous vapor barrier, which may not be pierced or broken. The following piping systems require vapor barrier protection:
 - a. Chilled water.
 - b. Refrigerant suction.
 - c. All other piping systems with a nominal operating temperature below 65°F, including dual temperature piping.
 3. Vapor Barrier Insulation.
 - a. Insulation for pipe requiring vapor barrier protection 1-1/4-inch or smaller, insulation continuous through pipe hangers and rollers.
 - b. For pipe 1-1/2-inch and larger, 18-inch section of calcium silicate, same thickness as pipe insulation with continuous vapor barrier jacket at each hanger or roller. Provide pipe shield specified in Section 23 05 29.
- G. Non-Vapor Barrier Insulation:
1. Refer to Section 23 05 29 for support requirements.
 2. At contractor's option, insulation may be interrupted at supports. Butt insulation tight to support.
 3. If contractor elects to continue insulation at supports, installation as specified for piping systems with vapor barrier installation.
 4. Void between saddle and pipe filled with insulation.

3.4 EQUIPMENT INSTALLATION

- A. General: Install true and smooth. Insulation over curved surfaces shall conform to curves of surface.
1. Access: Insulated removable heads, water boxes, pump casings, access, etc., that require service, inspection or maintenance shall be provided with covers or section that are easily removable and replaceable. Reinforce openings in adjacent insulation with metal beading. In vapor barriered insulation, coat joints with vapor barrier mastic.
 2. Voids, Depressions and Cavities: All voids, chipped corners and other openings shall be filled with insulating cement or material compatible with insulating material.
 3. Vapor Barriered Insulation: Where insulation is specified to have a vapor barrier, the barrier shall not be pierced or broken.
 - a. Tears, etc., shall be coated with vapor barrier mastic and patched with insulation facing or tape.
 - b. Staples brush coated with vapor barrier coating.
 - c. All raw edges coated with vapor barrier mastic shall be covered and cover shall be sealed to equipment surface.
 4. Non-Vapor Barriered Insulation:
 - a. Tears, etc., shall be patched with insulation facing or tape.
 - b. All raw edges shall be covered and neatly beveled to the equipment surface.
 5. Multilayered Insulation: With staggered joints.
- B. Calcium Silicate and Fiberglass Block:
1. Anchors: Lug nuts 10 gauge black annealed iron wire welded to metal surfaces.
 2. Banding: Block secured to surface with 1/2-inch wide stainless steel bands maximum 18-inches on center and secured to anchors.
 3. Insulating Cement: Block covered with insulating cement minimum thickness of 1/2-inch with smooth finish.
 4. Vapor Barriered System: On vapor barriered system, apply continuous coat of vapor barrier mastic.
 5. Finish: Finish with cloth facing secured with adhesive and lapped a minimum of 2 inches. Defects touched up with finishing cement.
- C. Elastomeric Blanket: Cut insulation to size, make corners with mitering cuts to preclude raw edges, continuously cement insulation to equipment with adhesive. Cement both surfaces of joints and butt tightly together and cover raw edges with two coats of adhesive.

- D. Expansion Joints: Covered with larger size pipe insulation to allow full movement and be removable, ends turned back to pipe, coat with vapor barrier mastic on joints in vapor barriered system and finished with cloth facing cemented to insulation with adhesive.

3.5 DUCT INSULATION APPLIED LOCATIONS

- A. General:
 - 1. All external insulation with continuous vapor barriers unless specifically noted otherwise.
 - 2. Internally lined shall be lined completely to grille or diffuser or to indicated terminal points. Dimension shown are net inside of liner.
 - 3. Internally lined ductwork need not be externally insulated.
 - 4. In addition to locations described in specification, internally line supply, return and exhaust air ductwork where shown on drawings.
- B. Insulation Applied Location – HVAC Ductwork, per table below and as follows where more stringent:
 - 1.
 - 2. Commons Air Handler AH-COMMONS: Line all return air duct. Line all supply air duct located in mechanical platform.
 - 3. Gym Air Handlers: Line all return air duct. Line all supply air duct located in mechanical platform.
 - 4. Conf Room 119: Line entire return air branch duct.
 - 5. Conf Room 121: Line entire return air branch duct.
 - 6. AH-PRACT: Line all supply and return duct including branches to inlets and outlets.
 - 7. AH-BAND: Line supply ducts 15 feet both sides of east wall of room. Line return duct behind return grill and 30 feet upstream.
 - 8. AH-CHORAL: Line supply and return duct 10 feet both sides of east wall.
 - 9. AH-DRAMA: Line supply duct 10 feet both sides of east wall. Line return duct behind return grille and 20 feet upstream.
 - 10. AH-ENSEMB: Line all supply and return duct except branches to Storage and Hallway.
 - 11. TU-PRIN: Line main supply duct downstream of duct coil all the way to Room 110.
 - 12. TU-VP: Line all supply duct downstream of duct coil.
 - 13. TU-COUN: Line supply duct between Room 112 supply diffuser flex duct and Room 114 flex duct.
 - 14. Remaining Terminal Units: Line a minimum of five feet downstream of duct coil
 - 15. AH-8, AH-28, AH-9, AH-29, AH-7, AH-27, AH-6, AH-26, AH-5, AH-25, AH-HALL2A: Line all return air duct.
 - 14.16. Remaining air handlers in Zone A Platform: Line return air duct a minimum of 10 feet from the relief air damper toward the space served by the unit. Liner required in table below may be shifted upstream to satisfy this requirement.

System	Location	Duct Type	Insulation Type	Thickness	Notes
Low Pressure Supply*	Exposed or Visible (Including above a cloud ceiling)	Rectangular	Internally Lined	1 1/2-inch	
		Round	Internally Lined	1 1/2-inch	Note-5
	Concealed or in mechanical rooms	All	Fiberglass Blanket	1 1/2-inch	
	15 ft downstream of fans	All	Internally Lined	1-inch unless otherwise indicated	Note-5 Note 7
Return Air* (Not insulated except:)	Concealed Outside Building Envelope	All	Externally insulated without vapor barrier	2-inch	

System	Location	Duct Type	Insulation Type	Thickness	Notes
	Exposed Outside Building Envelope	All	Internally Lined	2-inch	Note 5
	15 ft upstream and downstream of fans	All	Internally Lined	1-inch unless otherwise indicated	Note 5
Exhaust Air* (Not insulated except:)	15 ft upstream and downstream of fans	All	Internally Lined	1-inch unless otherwise indicated	Note 5
	In Toilet Rooms, 10 ft downstream of exhaust grilles	All	Internally Lined	1-inch	Note 5
Outside Air (Untempered)	Exposed or Visible (Including above a cloud ceiling)	Rectangular	Internally Lined	2-inch	
		Round	Internally Lined	2-inch	Note 5
	Concealed or in mechanical rooms	All	Fiberglass Blanket	2-inch	
Supply and Return Plenums	All	All	Internally Lined	2-inch	Note 2
Grease Hood Exhaust	All	All	Duct Enclosure, Fire Rated	As Indicated	
Transfer Air	All	All	Internally Lined	1-inch	Note 5
OSA and Relief Plenums at Louvers	All	All	Fiberglass Blanket or Board	R-20 Equiv	Note 6

* In addition to applied locations listed in this table, provide internally lined ductwork where indicated on drawings.

Note 2: Insulation not required on factory fabricated insulated housings and plenums (AHP).

Note 3: Where round or oval ductwork is indicated, provide double walled as specified in 23 31 02.

Note 4: Use semi-rigid blanket for galvanized sheet metal duct and use semi-rigid board for stainless steel duct.

~~Note 5: Where round or oval ductwork is indicated, provide double walled round/oval ductwork as specified in 23 31 02, or provide internally lined rectangular ductwork with equivalent free area.~~

Note 6: Plenums at louvers shall be insulated where extending beyond control damper.

Note 7: Where liner is used to meet Energy Code, thickness shall be 1-1/2-inches.

3.6 DUCTWORK INSTALLATION

A. General:

1. Install in accordance with manufacturer's instruction.
2. The vapor barrier shall be continuous. Tears, holes, staples, etc. shall be coated with vapor barrier mastic and patch with facing or tape. Joints between insulation and access with vapor barrier mastic.
3. Insulation at access panels to be removable or attached to panel with edges of panel and opening reinforced with metal beading.

- B. External Blanket Insulation:
 1. Insulation secured to ductwork with 20-gauge snap wires 24 inches on center and at all joints.
 2. Joints and seams lapped a minimum of 3 inches and sealed with jacket tape.
- C. Board Insulation:
 1. Rectangular ducts with weld pins spaced a maximum of 18 inches on center in both directions.
 2. All corners made with joints, bending insulation around corners not allowed.
 3. All joints and seams butted tight together.
 4. Butt joints with 3-inch wide tape.
 5. Corners finished with 3-inch wide tape.
- D. Internal Duct Liner:
 1. The coated surface shall face air stream.
 2. Weld pins spaced maximum of 15-inch on center in both directions and within 2 inches of all corners and joints. Weld pins flush with liner surface.
 3. Complete duct surface coated with adhesive and insulation pressed tightly thereto.
 4. Edges at terminal points shall be provided with metal beading and heavily coated with adhesive.
 5. All joints and corners shall be heavily coated with adhesive.
 6. Damaged areas replaced or heavily coated with adhesive.
- E. Duct Enclosure - Fire Rated:
 1. Installation: Per manufacturer's instructions.
 2. Joints:
 - a. Attached boards shall be cemented and attached to one another. Mating surfaces shall be "battered" with a 1/8-inch layer adhesive.
 - b. Secure fiberglass type material with stainless steel banding (type 304).
 3. Support: The duct enclosure may be hung from a conventional "trapeze" arrangement. Adequate support shall be provided at the bottom of vertical runs. On multi-story vertical runs, the Firetemp enclosure shall be supported at each story penetration with an angle iron collar attached to the Firetemp.
 4. Expansion: Adequate clearance shall be provided at the end of all straight runs to allow for expansion of the metal duct inside the enclosure.
- F. Plenums: Insulation on floors protected by wire mesh.
- G. Blank Off Panels: Insulation, enclosed with sheet metal on all sides. All joints with vapor barrier mastic and taped.
- H. Volume Dampers: Where volume dampers do not allow for continuous insulation, terminate insulation clear of handle sweep and finish edges to maintain vapor barrier and to prevent damage to the insulation.

3.7 DUCT, PIPE AND TERMINAL UNIT ACOUSTICAL WRAP

- A. Installed in accordance with the manufacturer's instructions.
- B. Applied locations for piping and duct systems:
 1. Where specified or indicated on drawings.

3.8 DUCT ENCLOSURE - FIRE RATED:

1. Installation: Per manufacturer's instructions.
2. Joints:
 - a. Attached boards shall be cemented and attached to one another. Mating surfaces shall be "battered" with a 1/8-inch layer adhesive.
 - b. Secure fiberglass type material with stainless steel banding (type 304).

3. Support: The duct enclosure may be hung from a conventional "trapeze" arrangement. Adequate support shall be provided at the bottom of vertical runs. On multi-story vertical runs, the Firetemp enclosure shall be supported at each story penetration with an angle iron collar attached to the Firetemp.
4. Expansion: Adequate clearance shall be provided at the end of all straight runs to allow for expansion of the metal duct inside the enclosure.
5. Provide continuous duct enclosure from point of ceiling penetration to termination per OMSC 506.3.10.2.

3.9 FIELD QUALITY CONTROL

- A. Field Test: All systems shall be tested and approved prior to installation of insulation.

END OF SECTION

PREFABRICATED PIPING SYSTEMS FOR HVAC

PART 1 - GENERAL

1.1 RELATED DOCUMENTS

- A. Drawings and general provisions of the Contract, including General and Supplementary Conditions and Division 1 Specification Sections, apply to this Section.
- B. The provisions of Section 23 05 00, Common Work Results for HVAC apply to work specified in this Section.

1.2 SUMMARY

- A. This Section includes: Direct buried prefabricated piping systems for chilled water.
- B. Related Sections include:
 - 1. Section 23 05 90 Pressure Testing for HVAC Systems.
 - 2. Section 23 07 00 Insulation for HVAC.
 - 3. Section 23 21 13 Pipe and Pipe Fittings HVAC.

1.3 SUBMITTALS

- A. Submit the following:
 - 1. Product Data.
 - 2. Installation Manuals.
 - 3. Complete shop drawings for piping systems including elbows, tees, flanges, coupling locations, and anchors. Include cutting lengths and thrust block sizes.
 - 4. Report on field piping tests with signatures of Architect and manufacturer's representative witnessing.

1.4 QUALITY ASSURANCE

- A. Provide the services of a qualified manufacturer's representative to instruct the contractor on the installation procedures for piping, and to be present on site to assist during critical stages of installation and testing.
- B. Include a report consisting of the installation log indicating actual installed conditions and test certification signed by the manufacturer's representative above, the contractor, and the Architect's representative. Include certification by manufacturer's representative that the installation is in conformance with the manufacturer's recommendations.

PART 2 - PRODUCTS

2.1 PREFABRICATED PEX OR HDPE CHILLED AND HEATING WATER PIPING

- A. Acceptable Manufacturers:
 - 1. Rovanco, Thermacore, Perma-Pipe, Thermal Pipe, and Insul-pipe.
 - 2. Other Manufacturers: Submit Substitution Request.
- B. General: Provide complete prefabricated underground chilled water piping system suitable for direct burial as indicated on Drawings and as specified herein. Factory prefabricated HDPE jacketed system of factory pre-insulated pipe with all necessary fittings, seals, and accessories.
- C. Pipe: Carrier pipe shall be Cross-linked PEX pipe 100 psi minimum working pressure for temperatures up to 180°F and or High Density Polyethylene pipe DR-17, 100 psiminimum working pressure for temperatures up to 110°F.
- D. Expansion: All components of carrier pipe, insulation, and jacket must be able to expand and contract as a unit without overstressing or adversely affecting any of the materials. The piping system supplier shall be responsible for the overall design of the expansion and contraction compensation.

- E. End Seals: All direct-buried ends of insulated pipe with exposed insulation will be sealed with polyethylene end seals.
- F. Insulation: Insulation shall be as specified in Section 23 07 00 Insulation for HVAC.
- G. Jacket: The outer protective jacket shall be corrugated seamless polyethylene completely encompassing and protecting the insulation from moisture and damage, designed for H-20 loading at a burial depth of 2-ft minimum.
- H. Joints: Straight run joints shall be field-insulated per the manufacturer's instructions, using polyurethane foam poured in an HDPE sleeve and sealed with a heat shrink sleeve. All joint closures and insulation shall occur at straight sections of pipe. All insulation and jacketing materials shall be furnished by piping system supplier.
- I. Fittings: Fittings shall be standard component factory prefabricated and pre-insulated to the thickness specified.
- J. Accessories: Provide all required accessories including wall sleeves, and miscellaneous materials as required for attachment to steel or copper pipe at ends and as required and detailed to a complete and total installation.
- K. Service:
 - 1. Chilled Water **and heating water below grade.**

PART 3 - EXECUTION

3.1 PREPARATION

- A. Measurements, Lines and Levels:
 - 1. Check dimension at the building site and establish lines and levels for the work specified in this Section.
 - 2. Establish all inverts, slopes, and manhole elevations by instrument, working from an established datum point. Provide elevation markers for use in determining slopes and elevations in accordance with Drawings and Specifications.
 - 3. Use established grid and area lines for locating trenches in relation to building and boundaries.

3.2 EXCAVATION AND BACKFILL

- A. General: Perform all necessary excavation and backfill required for the installation of mechanical work in accord with Division 2. Repair pipelines or other work damaged during excavation and backfilling.
- B. Excavation: Excavate trenches to the necessary depth and width, removing rocks, roots, and stumps. Include additional excavation to facilitate utility crossovers, additional offsets, etc. Excavation material is unclassified. Width of trench shall be adequate for proper installation of piping. The trench shall be widened if not wide enough for a proper installation.
- C. Bedding: All piping shall be full bedded on sand. Place a minimum 4-inch deep layer on the leveled trench bottom for this purpose.
- D. Backfill:
 - 1. Immediately after all piping is installed in the ditch, make a partial backfill in the middle of each pipe length leaving the joints exposed for inspection prior to the hydrostatic tests.
 - 2. Place in layers not exceeding 8 inches deep and compact to 95% of standard proctor maximum density at optimum moisture content. Earth backfill shall be free of rocks over 2 inches in diameter and foreign matter. Disposal of excess material as directed.
 - 3. Interior: All backfill under interior slabs shall be bank sand or pea gravel.
 - 4. Exterior: Excavated material may be used outside of buildings at the contractor's option. The first 4 inches shall be sand, and final 12-inch layer course shall be soil in any event.

3.3 ADJUSTING AND CLEANING

- A. General:
 - 1. Clean interior of all piping before installation.
 - 2. Flush sediment out of all installed piping systems.

3.4 INSTALLATION OF PEX AND HDPE CHILLED AND HEATING WATER PIPING

- A. Install piping in accordance with the Manufacturer's recommendations and installation Drawings.
- B. Install all piping as to vent and drain to building.
- C. The system shall be installed in a manner that will not require expansion loops or compensators of any type.
- D. The system shall be installed with the fewest number of underground joints possible.
- E. Make connection between PEX or HDPE and Copper or Steel pipe according to manufacturer's recommendations.
- F. Slope piping uniformly. Record exact location and depth with respect to established datum points.
- G. Test piping prior to sealing of conduits and before backfilling. Seal all leaks and retest until tight.
- H. Utility Marking: Installed over the entire length of the underground piping utilities. Install plastic tape along both sides and the center line of the trenches at the elevation of approximately 12 inches above the top of utility.
- I. Trace Wire: Install 16 gauge insulated copper tracer wire (green in color) above all buried nonmetallic piping. Tracer wire to run entire length of pipe.

END OF SECTION

AIR DUCT ACCESSORIES

PART 1 - GENERAL

1.1 RELATED DOCUMENTS

- A. Drawings and general provisions of the Contract, including General and Supplementary Conditions and Division 1 Specification Sections, apply to this Section.
- B. The provisions of Section 23 05 00, Common Work Results for HVAC apply to work specified in this Section.

1.2 SUMMARY

- A. This Section includes: Low pressure duct accessories, sealants and tapes, flexible connectors, fire dampers, combination smoke and fire dampers, access doors, spin-in, extractors, automatic dampers, drain pans, back draft dampers.
- B. Related Sections include:
 - 1. Section 23 31 01 HVAC Ducts and Casing-Low Pressure.
 - 2. Section 23 09 00 Instrumentation and Controls for HVAC.

1.3 QUALITY ASSURANCE

- A. Work performed by qualified, experienced mechanics in accordance with the manual of Duct and Sheet Metal Construction of the National Association of Sheet Metal and Air Conditioning Contractors and these Specifications.
- B. Install entire ductwork system, including materials and installation, in accordance with NFPA 90A.
- C. Flexible connectors, flexible equipment connections, tapes and sealants listed as UL 181, Class I air duct. Flame spread rating not to exceed 25 and smoke developed rating not to exceed 50.

1.4 SUBMITTALS

- A. Submit the following: Product data for Duct Accessories.
 - 1. Low Pressure Duct Accessories:
 - a. Access Doors
 - b. Backdraft Dampers
 - c. Roof Jack
 - d. Automatic Dampers
 - e. Duct Sealer
 - 2. Fire and Smoke Dampers:
 - a. Fire Dampers
 - b. Combination Smoke and Fire Dampers
- B. Operation and Maintenance Data: Automatic dampers, fire dampers. Combination smoke and fire dampers.

PART 2 - PRODUCTS

2.1 LOW PRESSURE DUCT ACCESSORIES

- A. Acceptable Manufacturers:
 - 1. As indicated.
 - 2. Other Manufacturers: Submit Substitution Request.

- B. Damper Regulators:
1. Ventlok model numbers used, similar products by Young, Durodyne or approved equal are acceptable.
 2. Dial Regulator: Concealed or exposed duct in unfinished spaces, blade lengths 18-inch and less, 3/8-inch, Ventlok 635 or 638 for insulated duct. For blade lengths, 19 inches and above, similar except 1/2-inch shafts.
 3. Dial Regulator: Exposed duct finished space, 3/8-inch, Ventlok 640.
 4. Dial Regulator: Concealed, not accessible, blade lengths 18-inch and less, 3/8-inch Ventlok 666 regulator with 680 mitered gear assembly where right angle turn is necessary. Blade lengths 19 inches and above, similar except 1/2-inch shafts.
 5. End Bearings: For ducts rated to 1 inch WG, open end, Ventlok 607. For ducts rated above 1 inch WG, closed end, Ventlok 609. Exposed ductwork, finished spaces, Ventlock 609. Spring end bearings not allowed.
- C. Volume Damper Fabrication:
1. Single blade dampers reinforced or crimped for rigidity, with pivot rod extending through duct. Dampers over 12 inches high use multiple opposed blade damper. Single blade damper no larger than 12 inches x 48 inches. Multiple blade damper factory fabricated, Ruskin MD-35 or equal.
 2. Minimum gauge and duct construction in accordance with SMACNA "HVAC Duct Construction Standards", latest edition.
 3. Splitter and butterfly dampers fabricated of 18 gauge galvanized steel.
 4. Dampers of length suitable to close branch ducts without damper flutter.
 5. Damper blade must be aligned with handle and index pointer.
- D. Flexible Equipment Connections: 30 oz. Ventfabrics Ventglas or Duro Dyne neoprene coated fire retardant glass fabric or approved equal.
- E. Duct Sealer:
1. Based On: McGill Airseal Zero.
 2. Description: Suitable for indoor/outdoor use, rated to 10-inch WG, Maximum Flame Spread/Smoke Developed Rating of 25/50, maximum VOC of 30 g/L less water. SCAQMD Rule 1158 compliant.
- F. Duct Tape for Sheet Metal: ARNO C520 duct tape similar United, Duro Dyne, Nashua, Polymer Adhesive.
- G. Tape and Adhesive/Activator System for Sheet Metal: Hardcast, Polymer Adhesive.
- H. Turning Vane Assemblies:
1. Sheet Metal Vanes: Multiple radius hollow vane air foil type 2-inch (small vane) or 4-1/2-inch (large vane) inside radius, galvanized steel construction.
 2. Runners: Push-on type.
 3. Acoustical Vanes: Multiple radius air foil type, perforated steel construction with fiberglass fill. AirSan Acoustiturn or as approved.
- I. Access Doors:
1. Manufacturer: Air Balance, Ruskin, Metco, Durodyne, Cesco, Nailor-Hart or approved equal.
 2. Doors complete with steel frame, steel door with backing plate, cam latches (two on units 14-inch x 14-inch and larger), hinge and gasketing. Doors on insulated or lined ducts shall be insulated.
 3. Grease Duct Access Door: Construct of metal thickness equal to metal duct, doors air and grease tight with hinge and hand operable latches. Ductmate.

4. Size:

Duct Width or Duct Diameter	Net Access Door Opening
Up to 8"	6" x 6"
9" to 12"	8" x 8"
13" to 20"	12" x 12"
21" to 30"	16" x 14"
31" to 42"	18" x 14"
Over 42"	Two 16" x 14"

- J. Backdraft Dampers:
 1. Manufacturer: Air Balance, Ruskin, Cesco, Advanced Air, Nailor-Hart, Pottorff, or approved equal.
 2. Description: Gravity operated, vinyl edged, metal bladed backdraft dampers.
- K. Drip Pans: Provide Type 304 stainless steel drip pans for cooling coils and exhaust heat recovery coils on built-up units as indicated.
- L. Louver Blank-off Panels: At air intake or exhaust louvers which are only partially active area, blank off inactive area with sheet metal closure panels caulked airtight, secured to louver frame and insulated with 2" rigid fiberglass insulation per Section 23 07 00 Insulation for HVAC.
- M. Roof Jack: Enamel finish steel with back draft damper and bird screen. Broan 636, or equal.
- N. Automatic Dampers:
 1. Description: Multi-blade air foil type, except where either dimension is less than 10 inches a single blade may be used. Maximum blade length to be 48 inches. Provide parallel blades for positive or modulating mixing service and opposed blades for throttling service. Blades to be interlocking, minimum 16 gauge galvanized steel.
 2. Dampers shall have compression type edge seals and side seating stops. Damper blades shall be reinforced, have continuous full length axle shafts, axle to axle linkage and/or operating "jackshafts" as required to provide coordinated tracking of all blades. Dampers over 25 square feet in area to be in two or more sections, with interconnected blades. Dampers shall have a maximum air leakage of 3 cfm per square foot at 1 inch wg pressure. Provide all automatic dampers except those specified to be provided with units. Tested in accordance with AMCA Standard No. 500. Based on Ruskin CD-60.
 3. Damper Operators: ~~Refer to Section 23-09-00~~ **By controls contractor, except where furnished with air handlers and fans.**
 4. Manufacturers: Ruskin, Air Balance, Cesco, Pottorff or equal.

2.2 FIRE AND SMOKE DAMPERS

- A. Acceptable Manufacturers: Where Ruskin is the only manufacturer indicated, equivalent products may be furnished.
- B. Static Fire Dampers:
 1. Code Compliance: Provide static fire dampers with a U.L. 555 label for fire rating indicated and in conformance with NFPA 90A.
 2. Dampers shall be integrally hinged, folding blade curtain type, for installation in ductwork complete with 160°F fire link and retainer.
 3. Dampers shall be suitable for horizontal or vertical installation as required. Furnish stainless steel closure springs and cam lock for complete damper closure on dampers to be installed in vertical air flow positions.
 4. Low pressure, 1-1/2-hour: For use in partitions up to 2-hour rating with damper out of air stream for supply.
 - a. Ruskin Model IBD2 Style B for supply.
 - b. Ruskin Model IBD2 Style A for return or exhaust.

5. Low pressure, 3-hour: for use in partitions over 2-hour rating with damper out of air stream for supply.
 - a. Ruskin Model IBD23 Style B for supply.
 - b. Ruskin Model IBD23 Style A for return or exhaust.
6. Transfer grilles, 1-1/2-hour: 7/8-inch deep for use in partitions up to 2-hour rating. Ruskin Model IBDT "Thinline".

7. Ceiling fire dampers with 20 gauge galvanized steel blades, 212°F fusible link, U.L. listed, Ruskin CFD (R) 2 or CFD (2) 3. Provide thermal blanket.

~~6.~~

~~C. Combination Fire and Smoke Dampers:~~

- ~~1. Multiblade damper with linkage, extended control rod and damper operator with UL Fire Damper Label. Provide round or oval duct connections where required. Operator to be factory installed, electric type, 120V with spring return to closed position. Stall type motors are not acceptable.~~
- ~~2. Low pressure, 1-1/2 hour: for use in partitions up to 2-hour rating. Ruskin Model FSD36.~~
- ~~3. Low pressure, 3-hour: for use in partitions over 2-hour rating. Ruskin Model FSD60-3.~~
- ~~4. Provide factory installed and wired U.L. Listed duct smoke detector for 0-3000 fpm flow, Ruskin Model DSDN as part of assembly. Provide contactor from smoke detector to fire alarm system.~~
- ~~5. Actuator: Belimo or approved.~~

PART 3 - EXECUTION

3.1 INSTALLATION

- A. Install all devices as shown on the Contract Drawings and per manufacturer's recommendations.
- B. Low Pressure Duct Accessory installation specified under Section 23 33 01.
- C. Fire Dampers:
 1. Install dampers in accordance with NFPA 90A and manufacturer's written recommendations.
 2. Size and locate dampers as shown on Drawings.
 3. Install dynamic fire dampers in correct position with regards to direction of air.
 4. Where dampers are not accessible for servicing by removing an outlet, provide access doors for servicing. Doors shall be compatible with the duct in which they are installed.

D. Ceiling Fire Dampers:

- 1. Install dampers in accordance with NFPA 90A and manufacturer's written recommendations.**
- 2. Size and locate dampers as shown on Drawings.**

~~D. Combination Fire and Smoke Dampers:~~

- ~~1. Install dampers in accordance with NFPA 90A and manufacturer's written recommendations.~~
- ~~2. Size and locate dampers as shown on Drawings.~~
- ~~3. Where dampers are not accessible for servicing by removing an outlet, provide access doors for servicing. Doors shall be compatible with the duct in which they are installed.~~

- E. Access Doors: Install where indicated and at all duct mounted coils, automatic control dampers, fire dampers, to provide access for cleaning and maintenance.
- F. Kitchen Grease Duct Access Doors: Install every 10 feet and at each change in direction of kitchen exhaust duct per code.
- G. Back Draft Dampers: Install where indicated and at the discharge (or inlet) of exhaust fans where automatic dampers are not indicated.
- H. Automatic Dampers: Install where indicated and are not specified with equipment. Coordinate damper operators with controls subcontractor.

- I. Drip Pans: Install under each cooling coil as indicated. Provide drain connection from each drip pan and pipe to nearest floor drain through trap. Drip pans over 6 feet in length require drain connections from both ends. Pitch drip pans in direction of air flow and to drain.
- J. Louver Blank-off Panels: Install blank-off panels on unused portions of louvers.

END OF SECTION

LOW VOLTAGE ELECTRICAL POWER CONDUCTORS AND CABLES

PART 1 - GENERAL

1.1 RELATED DOCUMENTS

- A. Drawings and general provisions of the Contract, including General and Supplementary Conditions and Division 1 Specification Sections, apply to this Section.
- B. The provisions of Division 26 Section, Common Work Results for Electrical apply to this section.

1.2 SUMMARY

- A. This Section includes:
 - 1. Copper conductors. Indicated sizes shall be considered minimum for ampacities and voltage drop requirements.
 - 2. Conductors for special systems shall be as recommended by the equipment manufacturer except as noted.
 - 3. Deliver conductors to the job site in cartons, protective covers, or on reels.
- B. Related Sections include:
 - 1. Section 26 05 26 Grounding and Bonding for Electrical Systems.
 - 2. Section 26 05 33 Raceways and Boxes for Electrical Systems.
 - 3. Section 26 05 53 Identification for Electrical Systems.
 - 4. Section 26 05 80 Electrical Testing.

1.3 REFERENCED STANDARDS

- A. ASTM: American Society For Testing and Materials:
 - 1. ASTM B 3 – Soft or Annealed Copper Wire.
 - 2. ASTM B 8 – Concentric-Lay-Stranded Copper Conductors, Hard, Medium-Hard, or Soft.
 - 3. ASTM B 33 – Tinned Soft or Annealed Copper Wire for Electrical Purposes.
- B. ICEA: Insulated Cable Engineers Association:
 - 1. S-95-658 – Non-shielded 0-2 kV Cables
- C. IEEE: Institute of Electrical and Electronic Engineers:
 - 1. IEEE 383 – Type Test of Class IE Electric Cables, Field Splices, and Connections.
- D. UL: Underwriters Laboratories:
 - 1. UL 44 – Rubber-Insulated Wires and Cables.
 - 2. UL 83 – Thermoplastic-Insulated Wires and Cables.
 - 3. UL 1277 – Type TC Power and Control Tray Cable.

1.4 SUBMITTALS

- A. Submit product data for the following materials:
 - 1. Single conductor 600-volt power and control conductors.
 - 2. MC cable.
- B. Submittals of the following materials shall consist only of a listing of the manufacturer's name and the applicable catalog numbers of the items to be utilized.
 - 1. Connectors.
 - 2. Branch circuit conductor splices.
 - 3. Splices with compression fitting and heat-shrinkable insulator.
- C. Submit cable test data per testing requirements of Part 3.

PART 2 - PRODUCTS

2.1 CONDUCTORS – 600V

- A. Type:
 - 1. Copper: No. 12 AWG minimum size unless noted otherwise. No. 12 and No. 10, stranded, No. 8 or larger, Class B concentric or compressed stranded.
 - 2. Aluminum is not permitted and shall not be utilized.
- B. Insulation:
 - 1. THHN/THWN-2 for conductors 6 AWG and smaller.
 - 2. XHHW-2 for conductors 4 AWG and larger.
- C. Thru wiring in fluorescent luminaires shall be rated for 90 degree C minimum.
- D. Manufacturers: General, Essex, Southwire, or equivalent.

2.2 POWER LIMITED WIRING

- A. Copper, stranded or solid as recommended by the system manufacturer.
- B. Insulation shall be appropriate for the system and location used.

2.3 MC CABLE

- A. Sheath: Steel, of the interlocking metal type, continuous and close fitting. The sheath shall not be considered a current carrying or grounding conductor.
- B. Conductors: Solid copper, of the same ampacity as the conduit/wire system indicated for the specific location. Provide separate green insulated grounding conductors in circuits where an isolated ground is called for.

2.4 CONNECTORS – 600V AND BELOW

- A. Branch Circuit Conductor Splices:
 - 1. Live spring type, Scotchlok, Ideal Wire Nut, Buchanan B-Cap, or 3M Series 560 self-stripping type.
- B. Cable Splices: Compression tool applied sleeves, Kearney, Burndy, or equivalent with 600V heat shrink insulation. Except where specifically indicated on the plans, all proposed splice locations shall be submitted for review by the Engineer.
- C. Terminator Lugs for Stranded Wire:
 - 1. 10 AWG Wire and Smaller: Spade flared, tool applied.
 - 2. 8 AWG Wire and Larger: Compression tool applied, Burndy, Anderson, or equivalent.
 - 3. Setscrew type terminator lugs furnished as an integral part of switches and circuit breakers will be acceptable.

PART 3 - EXECUTION

3.1 CONDUCTORS

- A. Pulling compounds may be used for pulling all conductors. Clean residue from the conductors and raceway entrances after the pull is made.
- B. Pulleys or blocks shall be used for alignment of the conductors when pulling. Pulling shall be in accordance with manufacturer's specifications regarding pulling tensions, bending radii of the cable, and compounds.
- C. Make up and insulate wiring promptly after installation of conductors. Wire shall not be pulled in until all bushings are installed and raceways terminations are completed. Wire shall not be pulled into conduit embedded in concrete until after the concrete is poured and forms are stripped.
- D. Provide a dedicated neutral conductor with each branch circuit, do not use a shared neutral conductor between phases unless specifically requested or directed.

3.2 MC CABLE

- A. MC cable is allowed only for lighting fixture whips, maximum 6-ft length.
- B. MC cable shall not be used for branch circuit homeruns to branch panelboards. EMT or RMC conduit shall be utilized for all branch circuit homeruns to branch panelboards.
- C. MC cable routing shall be coordinated with other trades and kept clear of and utilities to avoid exposure to damage. MC cable shall be properly supported per NEC Article 330 requirements.

3.3 CONNECTORS

- A. Control and special systems wires shall be terminated with a tool applied spade flared lug when terminating at a screw connection.
- B. All screw and bolt type connectors shall be made up tight and retightened after an eight hour period.
- C. All tool applied compression connectors shall be applied per manufacturer’s recommendations and physically checked for tightness.

3.4 COLOR CODING

- A. Secondary service, feeders, and branch circuit conductors shall be color coded. Phase color code to be consistent at all feeder terminations, A-B-C left-to-right, A-B-C top-to-bottom, or A-B-C front-to-back. ~~Color code shall be as follows:~~

120/240-volt 208Y/120-volt	Phase	480-volt 480Y/277-volt
Black	A	Brown
Red	B	Orange
Blue	C	Yellow
White	Neutral	Gray*
Green	Ground**	Green

~~*or white with colored (other than green) tracer~~
~~**Ground for isolated ground receptacles shall be green with yellow tracer.~~

B. Color code conductors to designate neutral, phase, and ground as follows:

CONDUCTOR	120/208	277/480
Phase A	Black	Brown
Phase B	Red	Orange
Phase C	Blue	Yellow
Neutral	White	Gray
Ground	Green	Green
Switchlegs	Pink or Tan	Pink or Tan
Travelers	Purple	Purple
Fire Alarm	Red	

- C. Wires shall be factory color coded by intergral pigmentation. Colored plastic tape permitted on No. 6 and larger where intergral pigmentation impractical. Apply tape in spiral half-lap over exposed portions in manholes, boxes, panels, switchboards and other enclosures.**

D. All circuit conductors shall be identified with circuit number at all terminals, intermediate outlets, disconnect switches, circuit breakers, motor control centers, etc. Both ends of a given conductor shall be identified alike.

E. DO NOT install wires of different voltage systems in same raceway, box, gutter or other enclosure.

F. Radius of cable bends shall not be less than 10 times the outer diameter of the cable.

~~B.G.~~ Use solid color compound or solid color coating for No. 12 and No. 10 branch circuit conductors and neutral sizes.

~~C.~~ Phase conductors No. 8 and larger color code using one of the following:

~~0.~~ Solid color compound or solid color coating.

~~0.~~ Stripes, bands, or hash marks of color specified above.

~~0.~~ Colored as specified using 3/4 inch wide tape. Apply tape in half overlapping turns for a minimum of three inches for terminal points and in junction boxes, pull boxes, troughs, manholes, and handholes. Apply the last two laps of tape with no tension to prevent possible unwinding. Where cable markings are covered by tape, apply tags to cable stating size and insulation type.

~~G.~~ Switchlegs, travelers, etc., to be consistent with the phases to which connected or a color distinctive from that listed.

~~H.~~ Color-coding of the flexible wiring system conductors and connectors shall be the manufacturer's standard.

~~I.H.~~ For modifications and additions to existing wiring systems, color-coding shall conform to the existing wiring system.

3.5 FIELD TESTING

A. All 600-volt rated conductors shall be tested by the Contractor for continuity. Conductors 100A and over in size shall be meggered after installation and prior to termination. Provide the megger, rated 1,000 volts d.c., and record and maintain the results, in tabular form, clearly identifying each conductor being tested.

1. Replace cables when test value is less than 15 megohms.

2. Cable test submittal shall include results, equipment used, and date.

END OF SECTION

SECTION 32 90 00
PLANTING

PART 1 GENERAL

1.01 SECTION INCLUDES

- A. Preparation of subsoil.
- B. Soil Material placement.
- C. Accent Stones.
- D. Drain rock placement.
- E. New trees, plants, and ground cover.
- F. Mulch and Fertilizer.
- G. Maintenance.

1.02 RELATED REQUIREMENTS

- A. Section 01 56 39 - Temporary Tree and Plant Protection.
- B. Section 01 60 00 - Product Requirements.
- C. Section 01 70 00 - Execution and Closeout Requirements.
- D. Section 31 20 00 - Earth Moving.
- E. Section 32 80 00 - Irrigation.

1.03 DEFINITIONS

- A. Weeds: Any plant life not specified or scheduled. Includes seeds and roots.
- B. Plants: Living trees, plants, and ground cover specified in this Section, and described in ANSI Z60.1.

1.04 REFERENCE STANDARDS

- A. Quality definitions, grading tolerances, root system condition, caliper height, branching, budding: ANSI/ANLA Z60.1 - American Standard for Nursery Stock, latest edition.
- B. ANSI A300 Part 1 - American National Standard for Tree Care Operations -- Tree, Shrub and Other Woody Plant Maintenance -- Standard Practices; 2001.
- C. Nomenclature conforms to "Standardized Plant Names," 1942 Edition, published by J. Horace McFarland Co., or "New Sunset Western Garden Book," listed in these references are those used most commonly in the nursery trade.

1.05 PROTECTION

- A. Protect existing improvements and growth in areas to remain undisturbed until completion of project. Leave in similar condition as found.
- B. Maintain benchmarks, monuments, and other reference points. Replace if disturbed or destroyed.
- C. Contact local utility companies for verification of the location of underground utilities within the project area prior to starting excavation. Protect utilities and maintain in continuous operation or in operational condition during work. Repair damage to known utilities or related facilities in an approved manner at Contractor's expense.
- D. Protect drainage inlets and underground drain lines from infiltration or clogging by soils and mulch during construction until Final Completion.
- E. Protect materials of this Section before, during, and after installation. Protect installed work and materials of other trades. In the event of damage immediately make repairs or replacements as directed by Owner's Representative.

1.06 SUBMITTALS

- A. See Section 01 30 00 - Administrative Requirements, for submittal procedures.
- B. Maintenance Data: Include written instructions covering yearly recommended maintenance and care of plantings including fertilization, pest and disease control, weed control, mulching, and pruning.
- C. Quality Assurance Data: Submit license information and project references including name and location of previous projects, date of installation, square footage of areas with planting work, and Owner's contact information.
- D. Submit list of plant life sources within 14 calendar days of Agreement Date.
 - 1. Submit confirmation from supplier(s) that specified plant materials, meeting the specifications, have been secured.
 - 2. Include plant name, quantity, size, condition, and name of supplier.
 - 3. Submit certification letter from the sod supplier(s) stating the sod has been secured or contracted for delivery. Include the quantity, grass mix, and description.
- E. Product Data: Submit manufacturer's printed data for products and a list of suppliers.
- F. Invoices: Within 2 days of delivery submit invoices, load tickets, and truck measures for Organic Material and Mulch.

1.07 QUALITY ASSURANCE

- A. Valid Oregon Landscape Contractor's license.
- B. Valid Oregon Landscape Business license.
- C. Installer Qualifications: Company specializing in installing and planting the plants with 5 projects of comparable scale successfully completed.
 - 1. Submit names, addresses, and dates of previous projects, owners.

1.08 COORDINATION

- A. Coordinate with other trades affecting and affected by Work of this Section.
- B. Pre-Installation Conference: Attend conference to coordinate Work of this Section and other related Sections.

1.09 DELIVERY, STORAGE, AND HANDLING

- A. Deliver fertilizer in waterproof bags showing weight, chemical analysis, and name of manufacturer.
- B. Protect and maintain plant life until planted.
- C. Deliver plant life materials immediately prior to placement. Keep plants moist.
- D. Deliver products in original unopened packaging with legible manufacturer's identification.
- E. Seed containers shall show manufacturer's guaranteed analysis of seed mixture, percentage of purity, year of production, date and location of packaging, name and trademark, and conformance with governing regulations.
- F. Plants may be rejected if:
 - 1. Ball of earth surrounding roots has been dried out, cracked, or broken.
 - 2. Burlap, staves, wire baskets, or ropes required in connection with transplanting have been displaced.
 - 3. Grower or nursery identification labels have been displaced prior to acceptance.

1.10 ENVIRONMENTAL CONDITIONS

- A. Do not install plant life and seed when ambient temperatures is below 32 degrees F or above 90 degrees F.
- B. Do not install plant life when wind velocity exceeds 30 mph.

- C. Do not install plant life when soil becomes saturated.
- D. Install plant materials and seed during periods which are normal for such work as determined by the following:
 - 1. Biological season
 - 2. Specified environmental conditions
 - 3. Accepted practice
 - 4. After all major construction work has been completed
- E. Planting Seasons:
 - 1. Trees: Bare root trees may be planted only between January 15th and March 15th unless otherwise approved.
 - 2. Seeding: Permitted between April 15 and October 15 unless otherwise approved.
 - 3. Other: Permitted during any period, except when prohibited by other portions of this Section.

1.11 REVIEWS

- A. Request the following reviews by the Owner's Representative 2 days in advance:
 - 1. Subgrade preparation
 - 2. Soil Material placement
 - 3. Organic Material placement
 - 4. Finish grading
 - 5. Accent stone mock-up
 - 6. Accent stone placement review
 - 7. Plant materials
 - 8. Plant material layout
 - 9. Planting mock-up
 - 10. Completion
- B. See Part 3 - Execution for review requirements.
- C. Coordinate all reviews to coincide with regular progress meetings where possible.

1.12 RECORD DOCUMENTS

- A. See Section 01 78 00 - Closeout Submittals
- B. Produce, keep current, and submit legible record documents on a clean set of plans and details supplied by the Owner's Representative. Use white-out and red ink to legibly re-draft actual locations of installed work.

1.13 WARRANTY

- A. See Section 01 78 00 - Closeout Submittals, for additional warranty requirements.
- B. Provide one year warranty following Final Completion or one full growing season following Final Completion, whichever is later.
- C. Replacements: Plants of same size and species as specified, planted in the next growing season, with a new warranty commencing on date of replacement.
- D. Inspection: Visit work at least once a month during warranty period. Notify Owner's Representative and Owner in writing of any observed conditions requiring attention. Failure to provide such notification renders any deficiencies the Contractor's responsibility to rectify.
- E. At the end of the warranty period, as directed by Owner's Representative and at no additional cost to the Owner:
 - 1. Replace work not surviving, in poor condition, or not exhibiting satisfactory growth.
 - 2. Lawns must be healthy, dense, uniform, well sodded, and reasonably weed free as judged by the Owner's Representative.

3. Reset plant materials and stones which have settled or become un-set
 4. Replace plant materials which appear to be a different species or variety than specified.
 5. Provide noxious weed eradication from imported Soil Material, if required and as specified herein.
 6. Complete warranty work within 30 days of warranty review.
- F. Contractor is not responsible for plant loss or damage to work during warranty period which is caused by unusually extreme weather, vandalism, or Owner's lack of maintenance.

PART 2 PRODUCTS

2.01 PLANTS

- A. Plants: Species and size identified in plant schedule, grown in climatic conditions similar to those in locality of the work.
- B. General:
1. Sizes, grades, and conditions are listed on Plant List. Quantities are shown for Contractor's convenience. Contractor is responsible for providing plants drawn on drawings.
 2. Cold storage stock unacceptable.
 3. Free of disease, decay, injury, insects, or indication of strawberry root weevil.
 4. Full foliated when in leaf.
 5. Furnish balled and burlapped (B&B) stock with solid, properly wrapped and secured, natural ball. Stock 2 inch caliper and up to be transported and handled with root ball in wire basket.
 6. Furnish container stock with sufficient roots to insure healthy growth but not root bound. When plant is removed from container soil must hold together and roots must be visible but not encircling.
 7. Free from Weeds.
 8. Field grown trees and shrubs must have been transplanted or root pruned at least once no more than two years prior to this Contract.
 9. Container stock may be substituted for Balled and Burlapped (B&B) stock at any time.
- C. Trees shall have:
1. Single, straight, uniformly tapering trunks which are perpendicular to the ground, unless specified as multi-stemmed or otherwise on Plant List. Trees with co-dominant, damaged, crooked, or topped leaders will be rejected.
 2. Healthy and vigorous overall condition.
 3. Full and even branch distribution; structural scaffold branches at least 4 inches apart where they attach to the main trunk.
 4. Well developed root systems. Trees with more than 2 inches of root ball soil covering root flare will be rejected.
 5. Grafts near ground level.
 6. Minimum/maximum branching heights above the ground unless specified otherwise on Plant List:
 - a. 2 inch caliper tree: 5' - 7'
 - b. 1.5 inch caliper tree: 4' - 6'
 7. Conifers shall also have full, even branching to ground level and intact single leader.
 8. Trees shall be free of:
 - a. Major structural defects including, but not limited to, branches with narrow angle of attachment (less than 40 degrees to the trunk), bark with major branch unions, and trees with co-dominant leaders.

- b. Poor pruning practices including, but not limited to, stubbed branches and topped leader.
 - c. Damage to the trunk, branches, and root system including, but not limited to, bark abrasions, sun scald, and disfiguring knots.
9. Trees shall be freshly dug during the most recent favorable harvest season.

2.02 SOIL MATERIALS

- A. Planting Soil: On-site soil, natural, fertile, friable, with at least 10% humus; free of rock, clay, subsoil, clods, lumps, plants, roots, sticks, weeds, seeds, and other deleterious material, as approved.
- 1. At Plant Beds:
 - a. Excavated from site. Stock piled on-site.
 - 2. At Stormwater Planters:
 - a. See Specification Section 31 20 00 for soil and compost.
 - 3. At Lawns and Eco Lawns:
 - a. Excavated from site. Stock piled on-site.

2.03 SOIL AMENDMENT MATERIALS

- A. Lawn Installation Fertilizer: Uniform composition, dry, and free flowing of proportion necessary to eliminate any deficiencies of topsoil, to the following proportions:.
- 1. Nitrogen: 16 percent. (source of Nitrogen to be methyl-urea based)
 - 2. Phosphoric Acid: 16 percent.
 - 3. Soluble Potash: 16 percent.
 - 4. Do not use within 50 feet of water.
- B. Lawn Maintenance Fertilizer: Uniform composition, dry, and free flowing of proportion necessary to eliminate any deficiencies of topsoil, to the following proportions:.
- 1. Nitrogen: 25 percent. (30% Nitrogen from slow release)
 - 2. Phosphoric Acid: 5 percent.
 - 3. Soluble Potash: 10 percent.
 - 4. Do not use within 50 feet of water.
- C. Plant Bed Maintenance Fertilizer: Uniform composition, dry, and free flowing of proportion necessary to eliminate any deficiencies of topsoil, to the following proportions:.
- 1. Nitrogen: 16 percent. (Source of Nitrogen to be methyl-urea based)
 - 2. Phosphoric Acid: 16 percent.
 - 3. Soluble Potash: 16 percent.
 - 4. Do not use within 50 feet of water.
- D. Planting Tablets:
- 1. Product: Sierra Chemical "Agriform" with 20-10-5 chemical analysis.
 - 2. Substitutions: See Section 01 60 00 - Product Requirements.
- E. Micorrhizal Fungi:
- 1. MycroApply® All Purpose Granular by Micorrhizal Applications Inc, Grants Pass, Oregon (541-476-3985).
 - 2. Substitutions: See Section 01 60 00 - Product Requirements.
- F. Water: Clean, fresh, and free of substances or matter that could inhibit vigorous growth of plants.
- G. Organic Material: 100% organic materials following guidelines and tested to meet the US Composting Council's seal of testing assurance.
- 1. Products: Garden Compost by Rexius Forest Byproducts, Eugene, Oregon.

- H. Top Dressing: Turf Start by Rexius Forest Byproducts, Eugene, Oregon, or approved.

2.04 ACCENT STONES

- A. Basalt stones in 2 distinct sizes:
 - 1. Medium Stone: Length 24"-30" x Width 18"- 24" x Height 12"-18"
 - 2. Small Stone: Length 18"-24" x Width 14"- 18" x Height 10"- 14"
- B. Clean, hard, durable rounded river stones, with no broken fragments, in a range of natural colors. Provide accent stones from a single source in the Willamette Valley. Provide color photo indicating sample of eight accent stones of assorted colors, indicating source of material. Provide accent stones in the following four 4 distinct sizes:
- C. Approved Suppliers:
 - 1. Oakridge Quarry, Berry St. Oakridge, Oregon.
 - 2. Premium Landscape Stone by Mid Valley Gravel Company, Philomath, Oregon (541-929-2200).
 - 3. Substitutions: See Section 01 60 00 - Product Requirements.

2.05 GRASS SEED

- A. Certified Oregon Blue Tag Free of Weed seed with dealer's statement analysis guarantee.
- B. Current or latest season's crop labeled in conformance with State and US Department of Agriculture laws and regulations:
 - 1. Purity: 98% by weight
 - 2. Germination: 90%
- C. Products:
 - 1. Lawn Seed:
 - a. Futura 3000 by Pickseed, Tangent, Oregon
 - 2. Eco Lawn Seed:
 - a. PT 705 Xeriscape by Hobbs and Hopkins, Portland, Oregon.

2.06 MULCH MATERIALS

- A. Mulching Material at Plant Beds Type 1 & Type 2: Hemlock species wood shavings, free of growth or weeds, "sliver free".
 - 1. Products: Hemlock Bark by Rexius Forest Byproducts, Eugene, Oregon, or Lane Forest Products.
- B. Basalt Quarry Rock Mulch at Stormwater Planters:
 - 1. River Rock Mulch at Stormwater Planters:
 - a. Products: 3/4" - 1/4" washed, open quarry rock.

2.07 ACCESSORIES

- A. Wrapping Materials: Burlap.
- B. Stakes: 2 x 2 inch x 8 feet wood stakes, capable of at least 2 years ground burial, stained charcoal or black.
- C. Tree Ties: Chain lock tree ties, 1 inch wide, or approved.

2.08 HERBICIDE

- A. No herbicide use allowed.

2.09 METAL LANDSCAPE EDGE AND STAKE

- A. 3000 Series Landscape Edge by Curv-Rite, Inc., 1-800-366-2878, or approved.
 - 1. Size: 1/8" x 5 1/2" x 16'.

2. Color: Mill Finish.

PART 3 EXECUTION

3.01 EXAMINATION

- A. Prior to installation of Work of this Section, carefully inspect the work of others and verify that such work is complete to the point where this installation may properly commence.
- B. Verify that materials and surfaces to receive work specified herein are accurately sized, shaped, and located; sound, secure, true, complete, and otherwise properly prepared.
- C. Verify subgrades produce positive drainage and allow for placement of Soil Material, Ammendments, and Mulch to specified depths.
- D. Do not install Work of this Section until all unsatisfactory conditions have been corrected. Beginning Work of this Section signifies acceptance of existing conditions.

3.02 TOLERANCES

- A. Perform earthwork true to lines and grades, and to prevent ponding of water, with maximum variation in elevations of +/- 1/2 inch at subgrades and +/- 1/4 inch at finish grades.
- B. Compacted thickness of materials within 1/4 inch of specified thickness.

3.03 PREPARATION OF SUBGRADE

- A. Prepare subsoil to eliminate uneven areas or low spots. Maintain profiles and contours. Make changes in grade gradual. Blend slopes into level areas.
- B. Remove foreign materials, weeds and undesirable plants and their roots, stones, rock, and dirt clods. Remove contaminated subsoil.
- C. Scarify subsoil to a depth of 6 inches where plants are to be placed. Repeat cultivation in areas where equipment, used for hauling and spreading topsoil, has compacted subsoil.
- D. Verify subgrades, whether comprised of subgrade soil or fill drain freely. Test area by flooding with Owner's Representative present. Where water does not drain freely auger a 10 inch hole, minimum 1 per 1,000 square feet, through fill material and into subsoil, or minimum 4 feet deep into subsoil to establish positive drainage.
- E. Verify subgrades allow for placement of Soil Material, Amendments, and Mulch to depths specified.
- F. Notify Owner's Representative for Subgrade Preparation Review prior to placing Soil Material.

3.04 PLACING SOIL MATERIAL

- A. Soil Placement Schedule:
 1. At Plant Beds: 18 inches minimum depth.
 2. At Lawns: 9 inches minimum depth.
 3. Reinforced Lawn at Fire Lane: As detailed.
 4. At Eco Lawn: 9 inches minimum depth.
 5. At Grassy Swales: Refer to Civil.
 6. Place additional Soil Material as required to establish finish grades shown on drawings and to fill in depressions, blend grades, and produce positive drainage.
- B. Place Soil Material during dry weather and on dry unfrozen subgrade. Suspend Soil Material placement if subgrade or Soil Material become saturated.
- C. Phase Soil Material placement so that equipment does not travel over Soil Material already installed.
- D. Place Soil Material in a relatively dry state to depths specified at locations shown on Drawings:
 1. Remove stones, roots, grass, weeds, debris, and foreign material while spreading.
 2. Manually spread around existing trees, paving, and other structures to prevent damage.

3. Establish levels, profiles, slopes, contours, and uniform gradients between given grade points as shown on Drawings.
 4. Eliminate uneven or low spots at lawns and plant beds.
 5. Fine grade Soil Material within specified tolerances.
- E. Notify Owner's Representative for Soil Material Placement Review prior to proceeding with Work.

3.05 INITIAL WEED CONTROL

- A. Inspect plant beds, lawns, and erosion control grass areas for the presence of weeds. If weeds are present manually remove.

3.06 SOIL PREPARATION AND FINISH GRADING

- A. Remove debris, sticks, roots, clods, stones, and soils contaminated by petroleum products at plant beds and lawns. Rake smooth, eliminate uneven areas or low spots in Soil Material, and set grades for positive drainage.
- B. At plant beds:
1. Manually remove weeds as described in Initial Weed Control.
 2. Spread 3 inches Organic Material over entire plant bed. Organic Material must be incorporated immediately into plant beds, no stock piling is permitted.
 3. Notify Owner's Representative for Organic Material Placement Review prior to proceeding with tilling and planting.
 4. Thoroughly rototill Organic Material into the top 6 inches of Soil Material, except within 10 feet of existing trees and Tree Protection zones where plants will be pocket planted.
 5. Rake smooth and reset finish grades eliminating uneven or low spots in plant beds and setting grades for positive drainage. Ensure grades at edges of plant beds allow for placement of Mulch Material to specified depths and as detailed.
- C. At trees:
1. Thoroughly mix 5 parts Soil Material and 1 part Organic Material for backfilling trees.
- D. At lawns and eco lawns:
1. Manually remove weeds as described in Initial Weed Control.
 2. Spread Lawn Installation Fertilizer at the rate of 15 lbs per 1000 square feet. If a Terraseeding method is used for lawn installation do not apply Lawn Installation Fertilizer.
 3. Rototill to a minimum depth of 4 inches, except within 10 feet of existing trees and Tree Protection zones.
 4. Set finish grades to ensure that finish grade of lawn will be flush with surrounding surfaces.
 5. Establish a friable, fine textured seed bed free of bumps and depressions immediately before seeding.
 6. Firm seed bed with a lawn roller making passes in 2 directions.
- E. At reinforced lawn at fire lane:
1. Manually remove weeds as described in Initial Weed Control.
 2. Establish a friable, fine textured seed bed free of bumps and depressions immediately before seeding.
 3. Spread Lawn Installation Fertilizer at the rate of 15 lbs per 1000 square feet. If a Terraseeding method is used for lawn installation do not apply Lawn Installation Fertilizer.
 4. Set finish grades to ensure that finish grade of lawn will be flush with surrounding surfaces.
- F. At lawn repair areas:
1. Manually remove weeds as described in Initial Weed Control.

2. Place additional Soil Material as necessary to fill in depressions and blend grades with surrounding lawns, plant beds, and paving.
 3. Set finish grades to ensure that finish grade of lawn will be flush with surrounding surfaces.
 4. Establish a friable, fine textured seed bed free of bumps and depressions immediately before seeding.
 5. Firm seed bed with a lawn roller making passes in 2 directions.
 6. Spread Lawn Installation Fertilizer at the rate of 15 lbs per 1000 square feet. If a Terraseeding method is used for lawn installation do not apply Lawn Installation Fertilizer.
- G. At renovated lawns in Tree Protection Zones:
1. Strip existing sod and remove from site.
 2. Manually remove weeds as described in Initial Weed Control.
 3. Core aerate with a minimum of 3 passes.
 4. Place additional Soil Material as necessary to fill in depressions and blend grades with surrounding lawns, plant beds, and paving.
 5. Set finish grades to ensure that finish grade of lawn will be flush with surrounding surfaces.
 6. Establish a friable, fine textured seed bed free of bumps and depressions immediately before seeding.
 7. Firm seed bed with a lawn roller making passes in 2 directions.
 8. Spread Lawn Installation Fertilizer at the rate of 15 lbs per 1000 square feet. If a Terraseeding method is used for lawn installation do not apply Lawn Installation Fertilizer.
- H. Notify Landscape Architect for Finish Grading Review prior to proceeding with Work.

3.07 ACCENT STONE PLACEMENT

- A. Install Accent stones where shown on Plans. Make minor adjustments to accommodate irrigation, planting, and other site elements.
- B. Notify Landscape Architect at least 2 days prior to commencement of Accent Stone Placement.
- C. Accent stone mock-up and stone layout review:
 1. Landscape Architect will provide on-site aesthetic direction for stone placement to establish design intent. Acceptable mock-up represents expected quality level of the remaining stone installation and may remain as part of Work.
 2. Stake locations of Stones, using irrigation flags of contrasting colors for each stone size.
- D. Install Accent Stones in the following sequence:
 1. Medium
 2. Small
- E. Nest Accent Stones into Soil Material or Concrete as detailed. In general, stones should be installed based on the following, in order of importance:
 1. Horizontal rather than vertical
 2. Wider at the ground than at the top so the stone appears to grow out of the soil.
 3. Flatter surface on top, positioned for seating opportunity.
- F. Notify Landscape Architect for Accent Stone Placement Review.

3.08 SECOND WEED CONTROL

- A. After completion of Soil Preparation and finish grading commence irrigation of all plant beds, lawns, and erosion control grass areas. If weeds are present manually remove.

3.09 INSTALLATION OF PLANT MATERIAL

- A. Plant Material Review: Notify Landscape Architect prior to the delivery of all trees and plant materials to the site but prior to installing plants. Landscape Architect will review quality of plant materials and reject plant materials not in compliance the the Plant List and Specifications. This review is preliminary. Final approval of plants materials will not be given until Completion Review.
- B. Plant Material Layout Review: Layout plant material (in containers or B&B) at plant beds for review prior to installation. Notify Landscape Architect for review of plant material layout prior to commencement of planting. The plant material layout review may occur concurrently with the planting mock-up review. Adjust plant materials as directed.
- C. Planting Mock-Up Review: Notify Landscape Architect prior to commencement of planting. Install an initial 500 square feet sample of typical plantings for review. Adjust planting procedure as directed.
- D. Tree Planting:
1. Soak container grown, B&B, and BR plants before planting.
 2. Remove extra soil on top of root ball to expose flare of first buttress root. Root flare must be visible at top of root ball.
 3. Dig individual planting holes circular with vertical sides as shown on Planting Detail.
 4. Save and thoroughly loosen soil removed from planting hole and use as backfill around tree. Backfill trees with specified mixture if additional Soil Material is needed.
 5. Sprinkle micorrhizal fungi to surface of planting holes at rate of 2-4 ounces per inch of stem caliper.
 6. Lift trees by wire basket only. Do not lift trees by trunk or use trunk as a lever to position or move tree.
 7. Set B&B trees in the hole with the north marker facing north unless otherwise approved.
 8. Set root crown as shown on Planting Detail not less than 3 inches above surrounding finish grade.
 9. Cut and completely remove twine and other fasteners from root ball. Remove burlap from top half of root ball. Remove all burlap if not biodegradable. Neatly cut off broken or frayed roots.
 10. Remove top half of wire basket after planting.
 11. Stake trees as shown on Planting Detail.
- E. All other Plants:
1. Soak container grown, B&B, and BR plants before planting.
 2. Dig individual planting holes with circular and with vertical sides 1-1/2 inch shallower than depth of root ball.
 3. Dig holes for pocket-planted shrubs 3 times the diameter of the rootball.
 4. Sprinkle micorrhizal fungi to surface of planting holes at the following rates:
 - a. #SP4 container - 1 tablespoon
 - b. #1 container - 2 tablespoons
 - c. #3 container - 3 tablespoons
 - d. #5 container - 5 tablespoons
 5. Install Planting Tablet at shrubs and ground covers at manufacturer's recommended high rate.
 6. Cut circling roots with a sharp knife.
 7. Set root crowns 1-1/2 inch above surrounding grade and as detailed.
- F. Plants set too deeply will be rejected. Reset plants that have settled.
- G. Set Plants plumb and for best appearance.

- H. Carefully tamp soil under and around root balls and bare roots to prevent settlement.
- I. Backfill pocket-planted plants with equal parts Soil Material and Organic Material.
- J. Flood hole when half backfilled and tamp soil between bare roots.
- K. Complete backfilling and tamp soil between bare roots.
- L. Thoroughly water each plant and entire bed immediately after planting.
- M. Remove all tags, labels, strings, etc. from plants.
- N. Prune Plant Material to remove dead, broken, or damaged branches.
- O. Rake plant beds smooth, resetting finish grades for positive drainage and eliminating uneven or low spots.
- P. Bulb Planting:
 - 1. Dig individual holes to the depth, size, and spacing scheduled on the Plant List.
 - 2. Place one teaspoon of Installation Fertilizer and work into soil. Place bulb and backfill soil.
 - 3. Cover entire area shown on Drawing as Mulch Area with Perennial Bulbs with 3 inches Organic Material as a mulch.

3.10 MULCH INSTALLATION

- A. Install mulch within 24 hours after planting at plant beds and trees as shown on drawings and details at the following depths:
 - 1. Hemlock Bark: 3 inches
 - 2. River Rock/Stone Mulch: 3 inches.
- B. Remove excess Mulch from foliage of plant materials and from bark of trees. Mulch must not be placed within 3 inches of tree trunks. Remove mulch from adjacent surfaces and produce edges shown on Details.

3.11 LAWN AND ECO LAWN INSTALLATION

- A. Install lawns and eco lawns using one of the following methods
 - 1. Hand seeding:
 - a. Apply seed evenly at rate of 6 lbs at lawns per 1000 square feet and 87 lbs per acre at eco lawn, meadow, and wet prairie.
 - b. Apply Lawn Installation Fertilizer at a rate of 15 lbs per 1000 square feet.
 - c. Rake lightly to a depth of 1/16 inch.
 - d. Roll seeded area with half full lawn roller.
 - e. Apply approved mulch as necessary to keep areas moist during germination.
 - 2. Terraseeding:
 - a. Apply a 1 inch layer of Top Dressing injected with the following:
 - 1) Seed: 8 lbs per 1000 square feet at lawns or per manufacturer's specifications and 87 lbs per acre at eco lawn.
 - 2) Lawn Installation Fertilizer: 15 lbs per 1000 square feet.
 - b. Do not install Top Dressing within mulch circles at trees.
 - c. Approved Installer: Rexius Forest Byproducts, Eugene, Oregon, or approved.
- B. Apply water with fine spray immediately after each area is sown.

3.12 TREE PRUNING

- A. Perform pruning of trees as recommended in ANSI A300.
- B. Prune newly planted trees as required to remove dead, broken, and split branches.

3.13 MAINTENANCE

- A. At Plant Beds during period between installation and Final Completion:

1. Water, fertilize, weed, reset unstable or disturbed plants, and perform other maintenance necessary to assure healthy growth.
 2. Install Plant Bed Maintenance Fertilizer at a rate of 6 lbs per 1000 square feet 45-60 days after installation. Adjust timing for seasonal requirements of plant materials.
 3. Thoroughly water immediately after applying Plant Bed Maintenance Fertilizer.
 4. Repair and regrade erosion damage .
 5. Provide continued weed control and removal until any weed problem is fully eradicated.
- B. At lawns during period between installation and Final Completion:
1. Water, weed, mow, reseed, top dress, and fertilize as necessary to establish a healthy, dense, uniform, weed free stand of grass; maintain at 2 inches high. This includes unirrigated lawns, unless otherwise noted on drawings.
 2. Conduct first mowing after grass is firmly rooted and secure. Mow grass when it exceeds 2 inches in height, cutting no more than 1/3 of the grass height at a time. Remove all clippings.
 3. Maintain surfaces and supply additional Soil Material and Seed where necessary.
 4. After first mowing apply Lawn Maintenance Fertilizer at a rate of 8 lbs per 1000 square feet. Thoroughly water after application.
 5. Manually remove weeds.
- C. At eco lawn between installation and final completion:
1. Water, weed, mow, reseed, top dress, and fertilize as necessary to establish a healthy, dense, uniform, weed free stand of grass.
 2. Maintain surfaces and supply additional Soil Material and Seed where necessary.
 3. Manually remove weeds.

3.14 CLEANING

- A. Remove excess materials from site. Protect drain inlets and underground piping as necessary and clean improvements soiled by Work of this Section.


3.15 COMPLETION REVIEW

- A. Notify Landscape Architect for Completion Review when Work of this Section is complete.

END OF SECTION

PHASE ONE WORK
See Civil/Erosion Control Plans

PHASE TWO WORK
See Civil/Erosion Control Plans

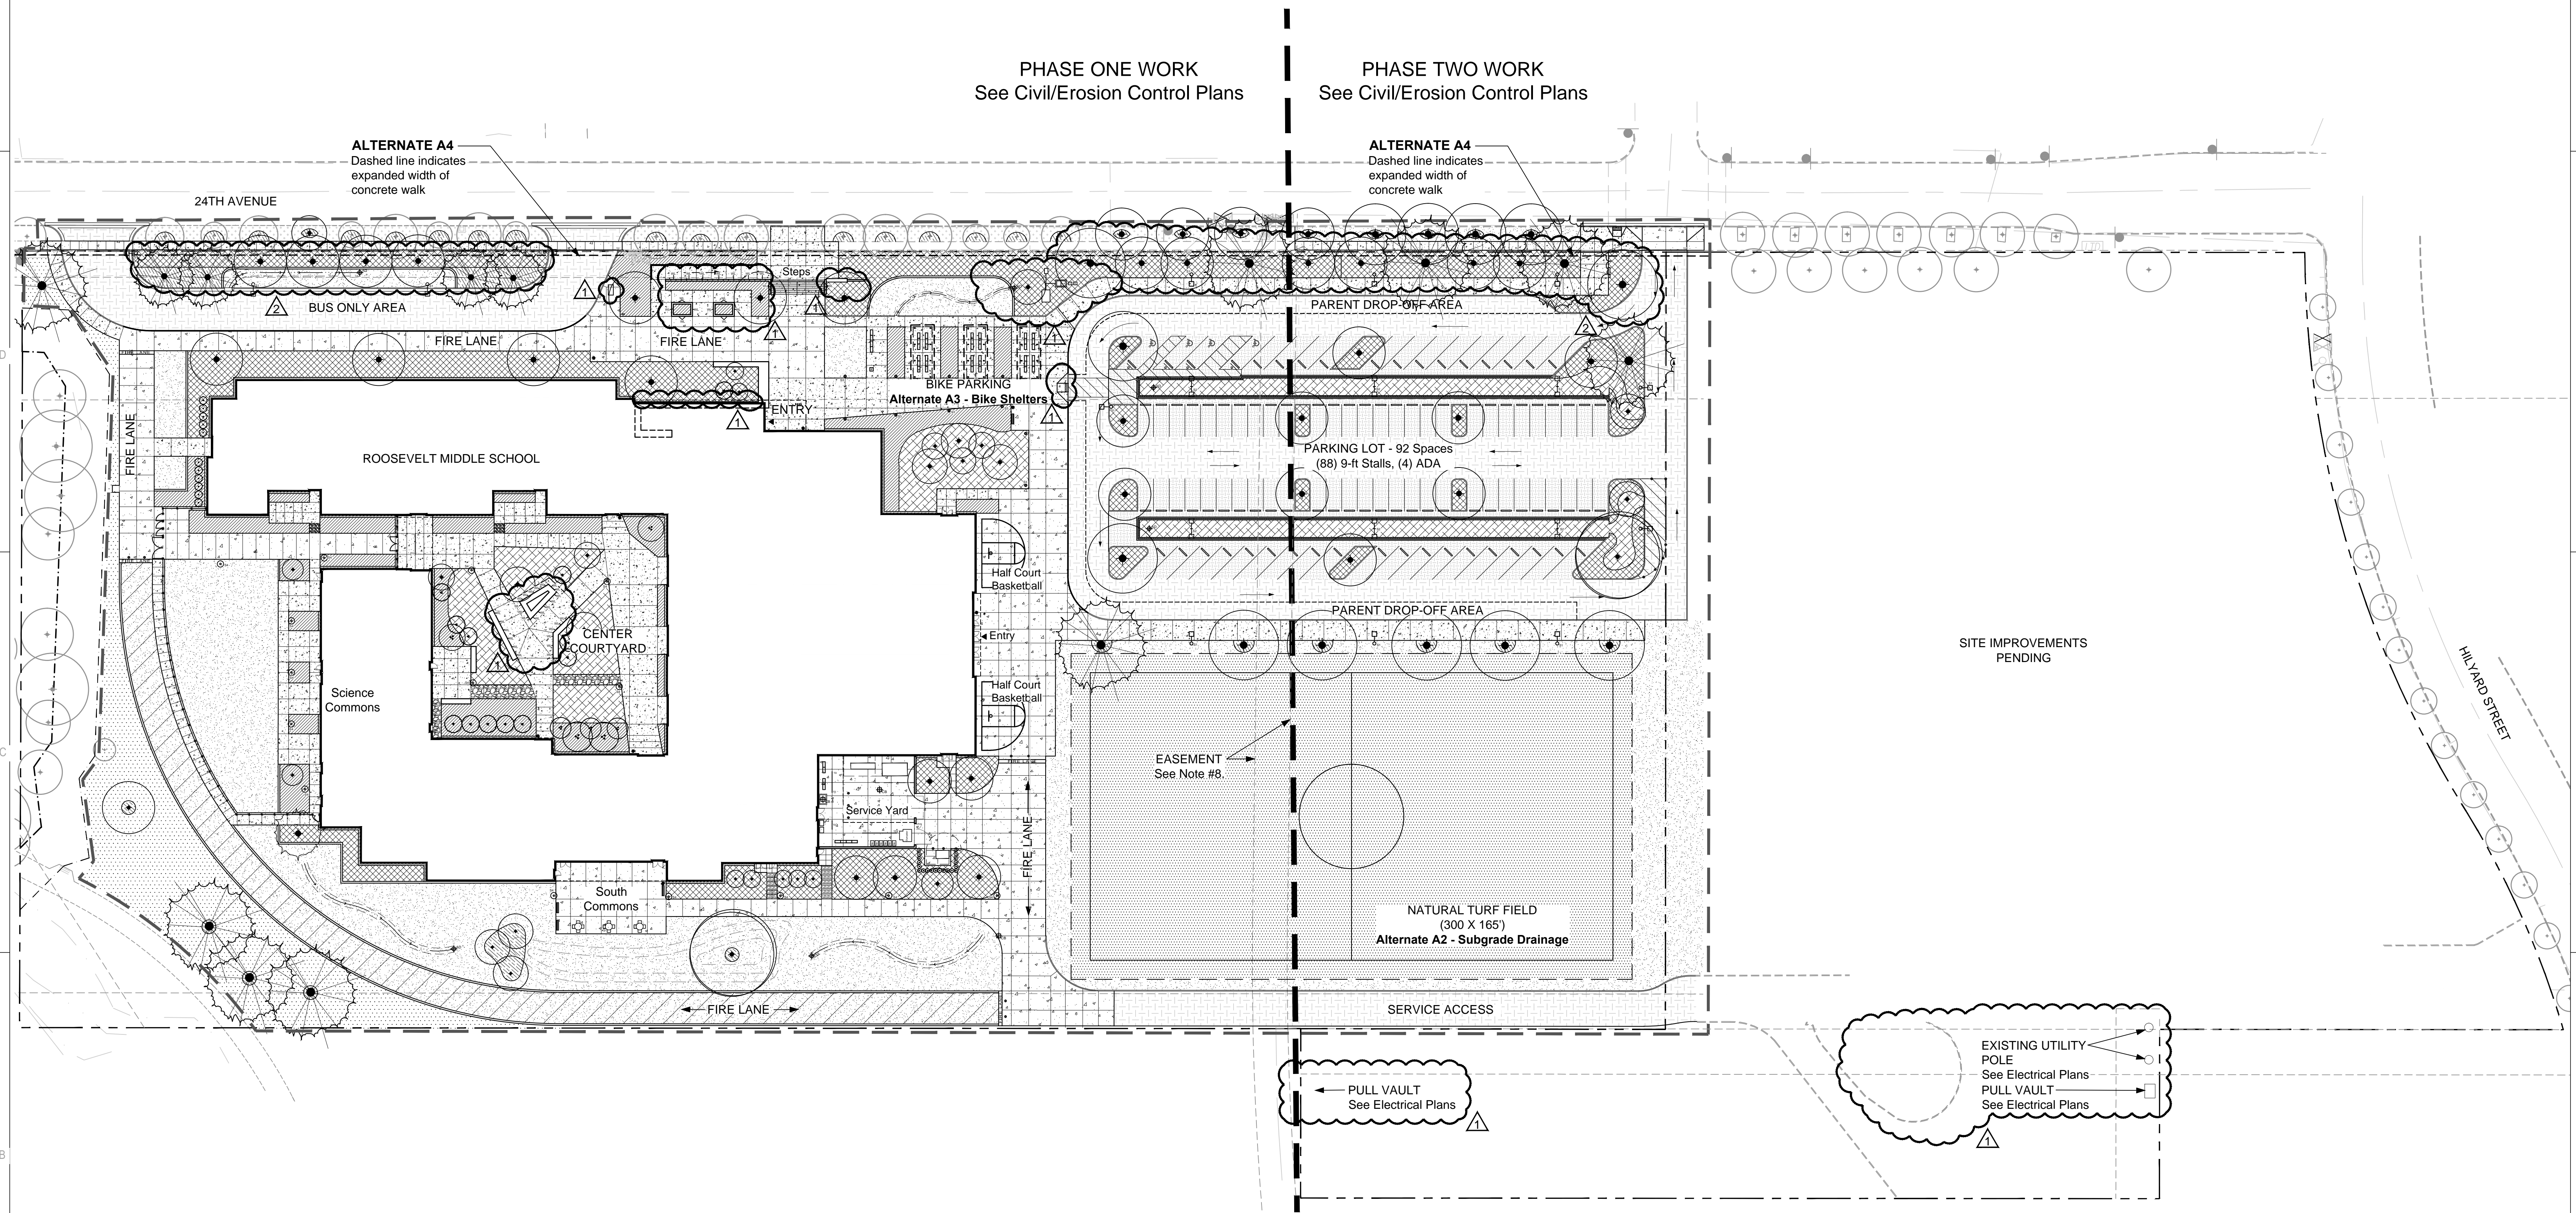

SITE PLAN NOTES:

- All survey information provided by: Branch Engineering Inc. 310 5th Street, Springfield, OR 97477. P: 541.746.0637, F: 541.746.0389, Date: 02.12.2014
- Verify exact locations and routing of existing underground utilities prior to starting excavation. Repair any damage to existing pipes, utilities or related facilities at Contractor's expense in a manner approved by Owner's Representative.
- Barricade and protect trunks, limbs, roots and root zones beyond dripline of existing trees and plant materials to remain as directed by Owner's Representative. Cut no limbs or roots larger than 2" in diameter without approval of Owner's Representative. Notify Owner's Representative prior to performing any excavation within protection areas.
- Install new utilities so that rim elevations are flush with finish grades at pavement, lawn and plant beds. Adjust rim elevations of existing utilities accordingly.
- All accessible components including, but not limited to signs, ramps, tactile warning, markings, etc. shall conform to all Oregon State Standards for parking and access for the disabled. Obtain Owner's Representative approval prior to installing any related work.
- Verify existing elevations where new work abuts existing to remain. Notify Owner's Representative of any discrepancies.
- In addition to improvements shown, repair all areas disturbed or damaged by construction impacts to the condition that existed prior to construction.
- Refer to Civil and Survey Sheets for work within existing Easements. Contact EWEB prior to performing any work, including Grading, within Easement.
- ADA Operator - Door operator at 36-inch with card reader at 42-inch mounted on 48-inch 4x4 painted galvanized HHS post with welded cap set in 12-inch diameter by 30-inch deep concrete footing.


LEGEND:

- See Sheets L101.1 and L101.2 for Notes and Legend information.

SPECIAL NOTE

*** ALTERNATE A4**
Base Bid includes improvements to existing 5-ft sidewalk at locations shown on drawings. Alternate includes demo of existing 5-ft sidewalk and replacing with a new 8-ft concrete sidewalk. If Alternate is selected sidewalk expansion will increase concrete areas and decrease landscaped areas as shown on plans. Concrete and landscaped areas will be increased or reduced by the following quantities:
Concrete: +/- 3920 sf; in addition to the new concrete shown at the 5ft sidewalk included in the base bid.
Base Bid Concrete: +/- 4,593 sf
Plant Beds (Type 1): - 240 sf. Delete 240 sf of plant bed.
See Landscape Plan for additional information
Plant Beds (Type 2): - 1,400 sf. Delete 1400 sf of plant bed.
See Landscape Plan for additional information
Lawn Areas: -720 sf. Delete 720 sf of lawn.
See Landscape Plan for additional information
EcoLawn (Not Irrigated): -70 sf. Delete 70 sf. of Eco Lawn.
See Landscape Plan for additional information

OVERALL SITE PLAN

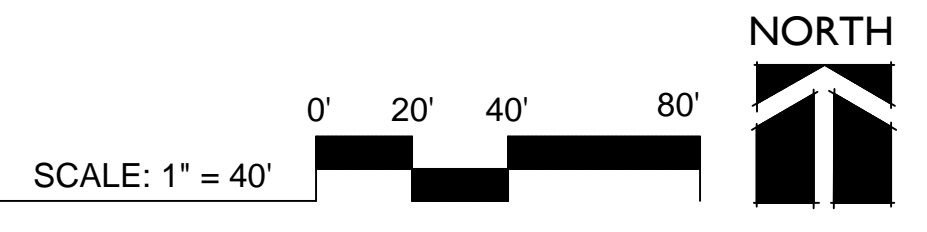


MARK	DATE	DESCRIPTION
1	3-06-2015	ADDENDUM 3
2	3-13-2015	ADDENDUM 6

ISSUE DATE: FEBRUARY 18, 2015
ISSUE: CONSTRUCTION DOCUMENTS
VOLUME: PACKAGE 1
PROJECT NO: 2013912.00
DRAWN BY: NLR / KMK
CHECKED BY: LKG
ORIGINAL SHEET SIZE: 36"x48"

OVERALL SITE PLAN

L-101.0


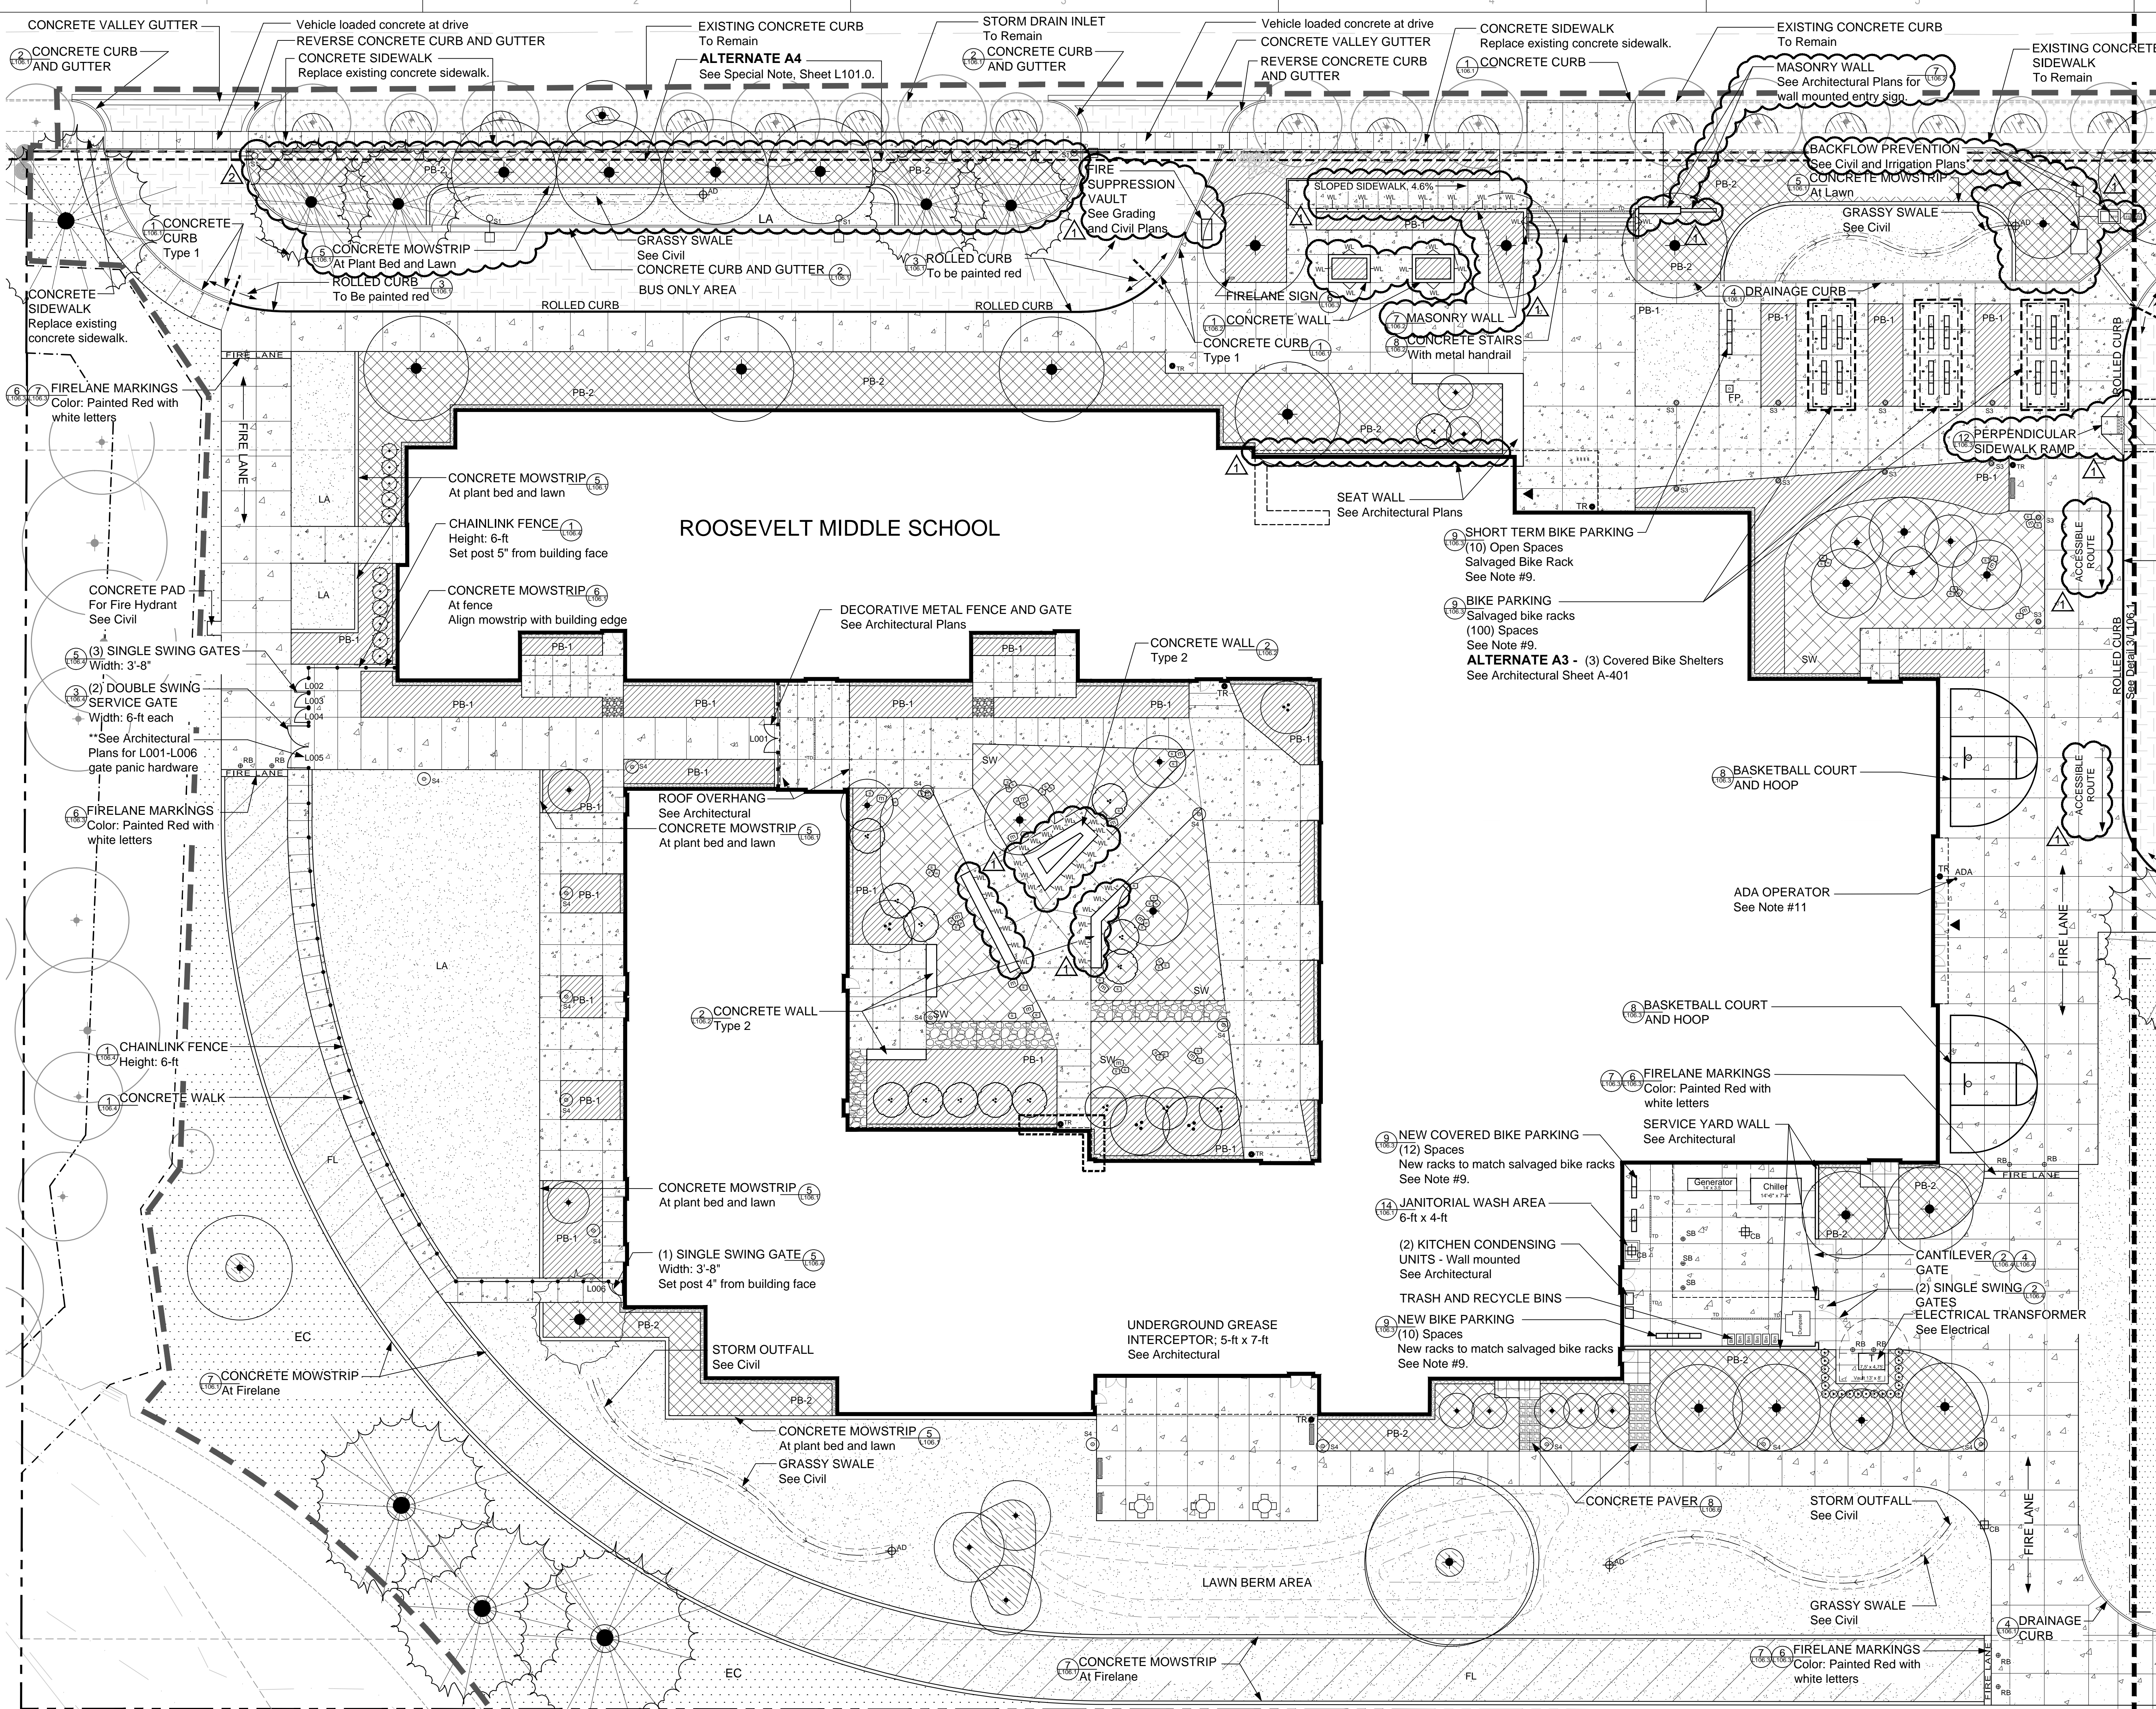


LEGEND:

- LIMIT OF WORK (Approximate)
- - - - - PROPERTY LINE
- - - - - EASEMENT
See Note #10.
- EXISTING TREES
To Remain
- PROPOSED DECIDUOUS TREES
See Planting Plan
- PROPOSED EVERGREEN TREES
See Planting Plan
- - - - - GOAL 5 WATER RESOURCE SITE SETBACK
- - - - - GRASSY SWALE BASIN & FLOW LINE
- - - - - CHAINLINK FENCE
6 inch thick over 6 inch base
- - - - - DECORATIVE METAL FENCE
- CONCRETE PAVING - PEDESTRIAN
6 inch thick over 6 inch base
- CONCRETE PAVING - VEHICLE REINFORCED
8 inch thick over 15 inch base
- AC PAVING - HEAVY
4 inches over 15 inches
See Civil
- AC PAVING - LIGHT
2-1/2 inches over 11 inches
See Civil
- PB-1 PLANT BED - Type 1
At Grade, Bark Mulch
- PB-2 PLANT BED - Type 2
Above Grade, Bark Mulch
- SW STORMWATER PLANTER
Type: Rain Garden
With Stone Mulch
- LA LAWN
See Landscape Plan
- LR LAWN REPAIR
Irrigated
- NT NATURAL TURF FIELD
BASE BID: Irrigated and seeded
ALTERNATE A2: Subgrade Drainage System
See Detail 11/L106.5
- EC ECO LAWN
Non-Irrigated
- FL REINFORCED LAWN AT FIRE LANE
Irrigated
- MULCH AREA
- CONCRETE EDGE
At building exterior
- CONCRETE WALK
Finish: Exposed Aggregate
- DETECTABLE PAVING
- BIKE RACK
Hoop Style
Indicated number of bikes per rack
See Note #9
- TR TRASH RECEPTACLE
See Specifications
- BENCH
See Specifications
- PICNIC TABLE
See Specifications
- FP FLAG POLE
See Specifications
- CONCRETE WHEEL STOP
- DRAINS
See Civil & Grading Plan
- TRENCH DRAIN
See Civil & Grading Plan
- ACCESSIBLE PARKING SIGN
- REMOVABLE BOLLARD
See Specifications
- STEEL BOLLARD
See Specifications
- FLEXIBLE PLASTIC BOLLARD
See Specifications
- BASALT ACCENT STONE
"S" Small, "M" Medium,
See Specifications
- SITE LIGHTING
See Electrical, Lighting Plan and
Layout Plan
See Specifications
- WALL LIGHT/SITE LIGHTING
See Electrical, Lighting Plan and Layout Plan
See Specifications
- BIKE/SKATE STOP

SITE PLAN NOTES:

1. All survey information provided by: Branch Engineering Inc. 310 5th Street Springfield, OR 97477 P: 541.746.0637 F: 541.746.0389 Date: 02.12.2014
2. Verify exact locations and routing of existing underground utilities prior to starting excavation. Repair any damage to existing pipes, utilities or related facilities at Contractor's expense in a manner approved by Owner's Representative.
3. Barricade and protect trunks, limbs, roots and root zones beyond dripline of existing trees and plant materials to remain as directed by Owner's Representative. Cut no limbs or roots larger than 2" in diameter without approval of Owner's Representative. Notify Owner's Representative prior to performing any excavation within protection areas.
4. Install new utilities so that rim elevations are flush with finish grades at pavement, lawn and plant beds. Adjust rim elevations of existing utilities accordingly.
5. All accessible components including, but not limited to signs, ramps, tactile warning, markings, etc. shall conform to all Oregon State Standards for parking and access for the disabled. Obtain Owner's Representative approval prior to installing any related work.
6. Verify existing elevations where new work abuts existing to remain. Notify Owner's Representative of any discrepancies.
7. In addition to improvements shown, repair all areas disturbed or damaged by construction impacts to the condition that existed prior to construction.
8. **ALTERNATE A4:** See Sheet L101.0 for **Special Note**.
9. Salvage existing 14 bike racks (bike parking spaces for 110) for re-installation. Sand blast and prepare racks from new blue powder coating finish per painting Specifications 09 90 00. Verify color with Architect. Provide new anchors.
10. Refer to Civil and Survey Sheets for work within existing Easements. Contact EWEB prior to performing any work, including Grading, within Easement.
11. ADA Operator - Door operator at 36-inch with card reader at 42-inch mounted on 48-inch 4x4 painted galvanized HHS post with welded cap set in 12-inch diameter by 30-inch deep concrete footing.

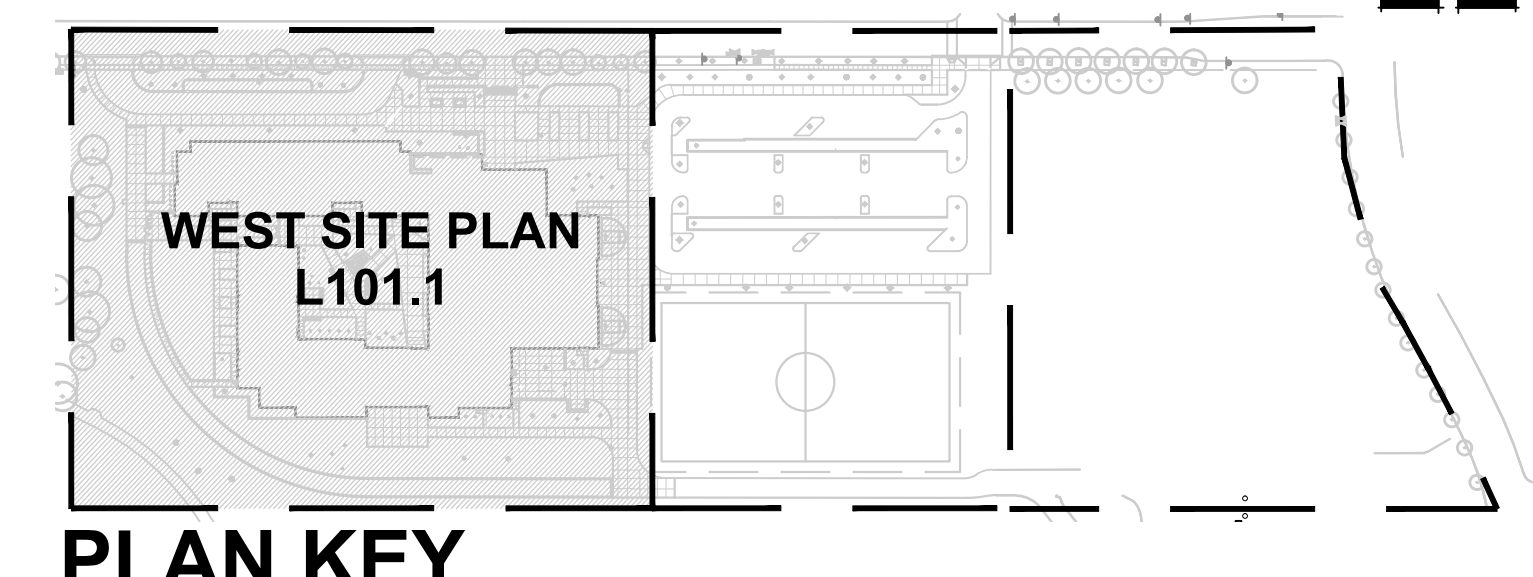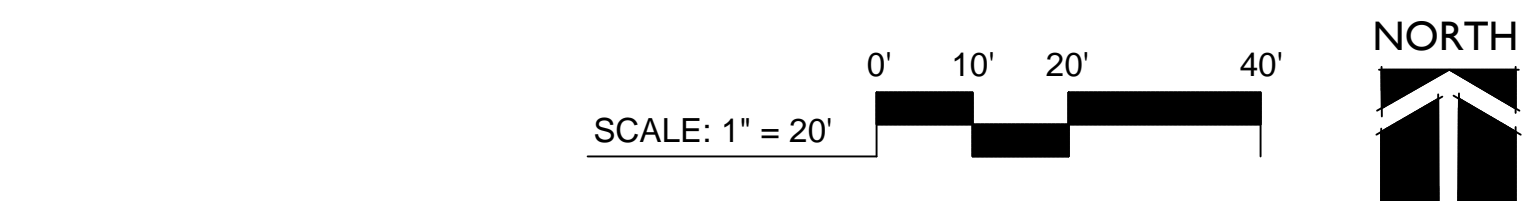

mahlum
ROBERTSON/SHERWOOD/ARCHITECTS PC
132 EAST BROADWAY, SUITE 540
EUGENE, OREGON 97401
541-342-6077
www.robertsonsherwood.com

MAHLUM ARCHITECTS INC
1231 NW HOYT, SUITE 102
PORTLAND, OREGON 97209
503-224-4032

71 COLUMBIA, FLOOR 4
SEATTLE, WASHINGTON 98104
206-441-4151
www.mahlum.com

CAMERON MCCARTHY
LANDSCAPE ARCHITECTURE & PLANNING
160 East Broadway • Eugene Oregon 97401
v 541.485.7385 f 541.485.7389
www.cameronmccarthy.com

REGISTERED
LANDSCAPE ARCHITECT
LARRY K. GILBERT
OREGON

EUGENE SCHOOL DISTRICT 4J

4J


REPLACEMENT ROOSEVELT MIDDLE SCHOOL
680 EAST 24TH AVENUE
EUGENE, OREGON 97405

MARK	DATE	DESCRIPTION
1	3-06-2015	ADDENDUM 3
2	3-13-2015	ADDENDUM 6

ISSUE DATE: FEBRUARY 18, 2015
ISSUE: CONSTRUCTION DOCUMENTS
VOLUME: PACKAGE 1
PROJECT NO: 2013912.00
DRAWN BY: NLR / KMK
CHECKED BY: LKG

WEST SITE PLAN

L-101.1


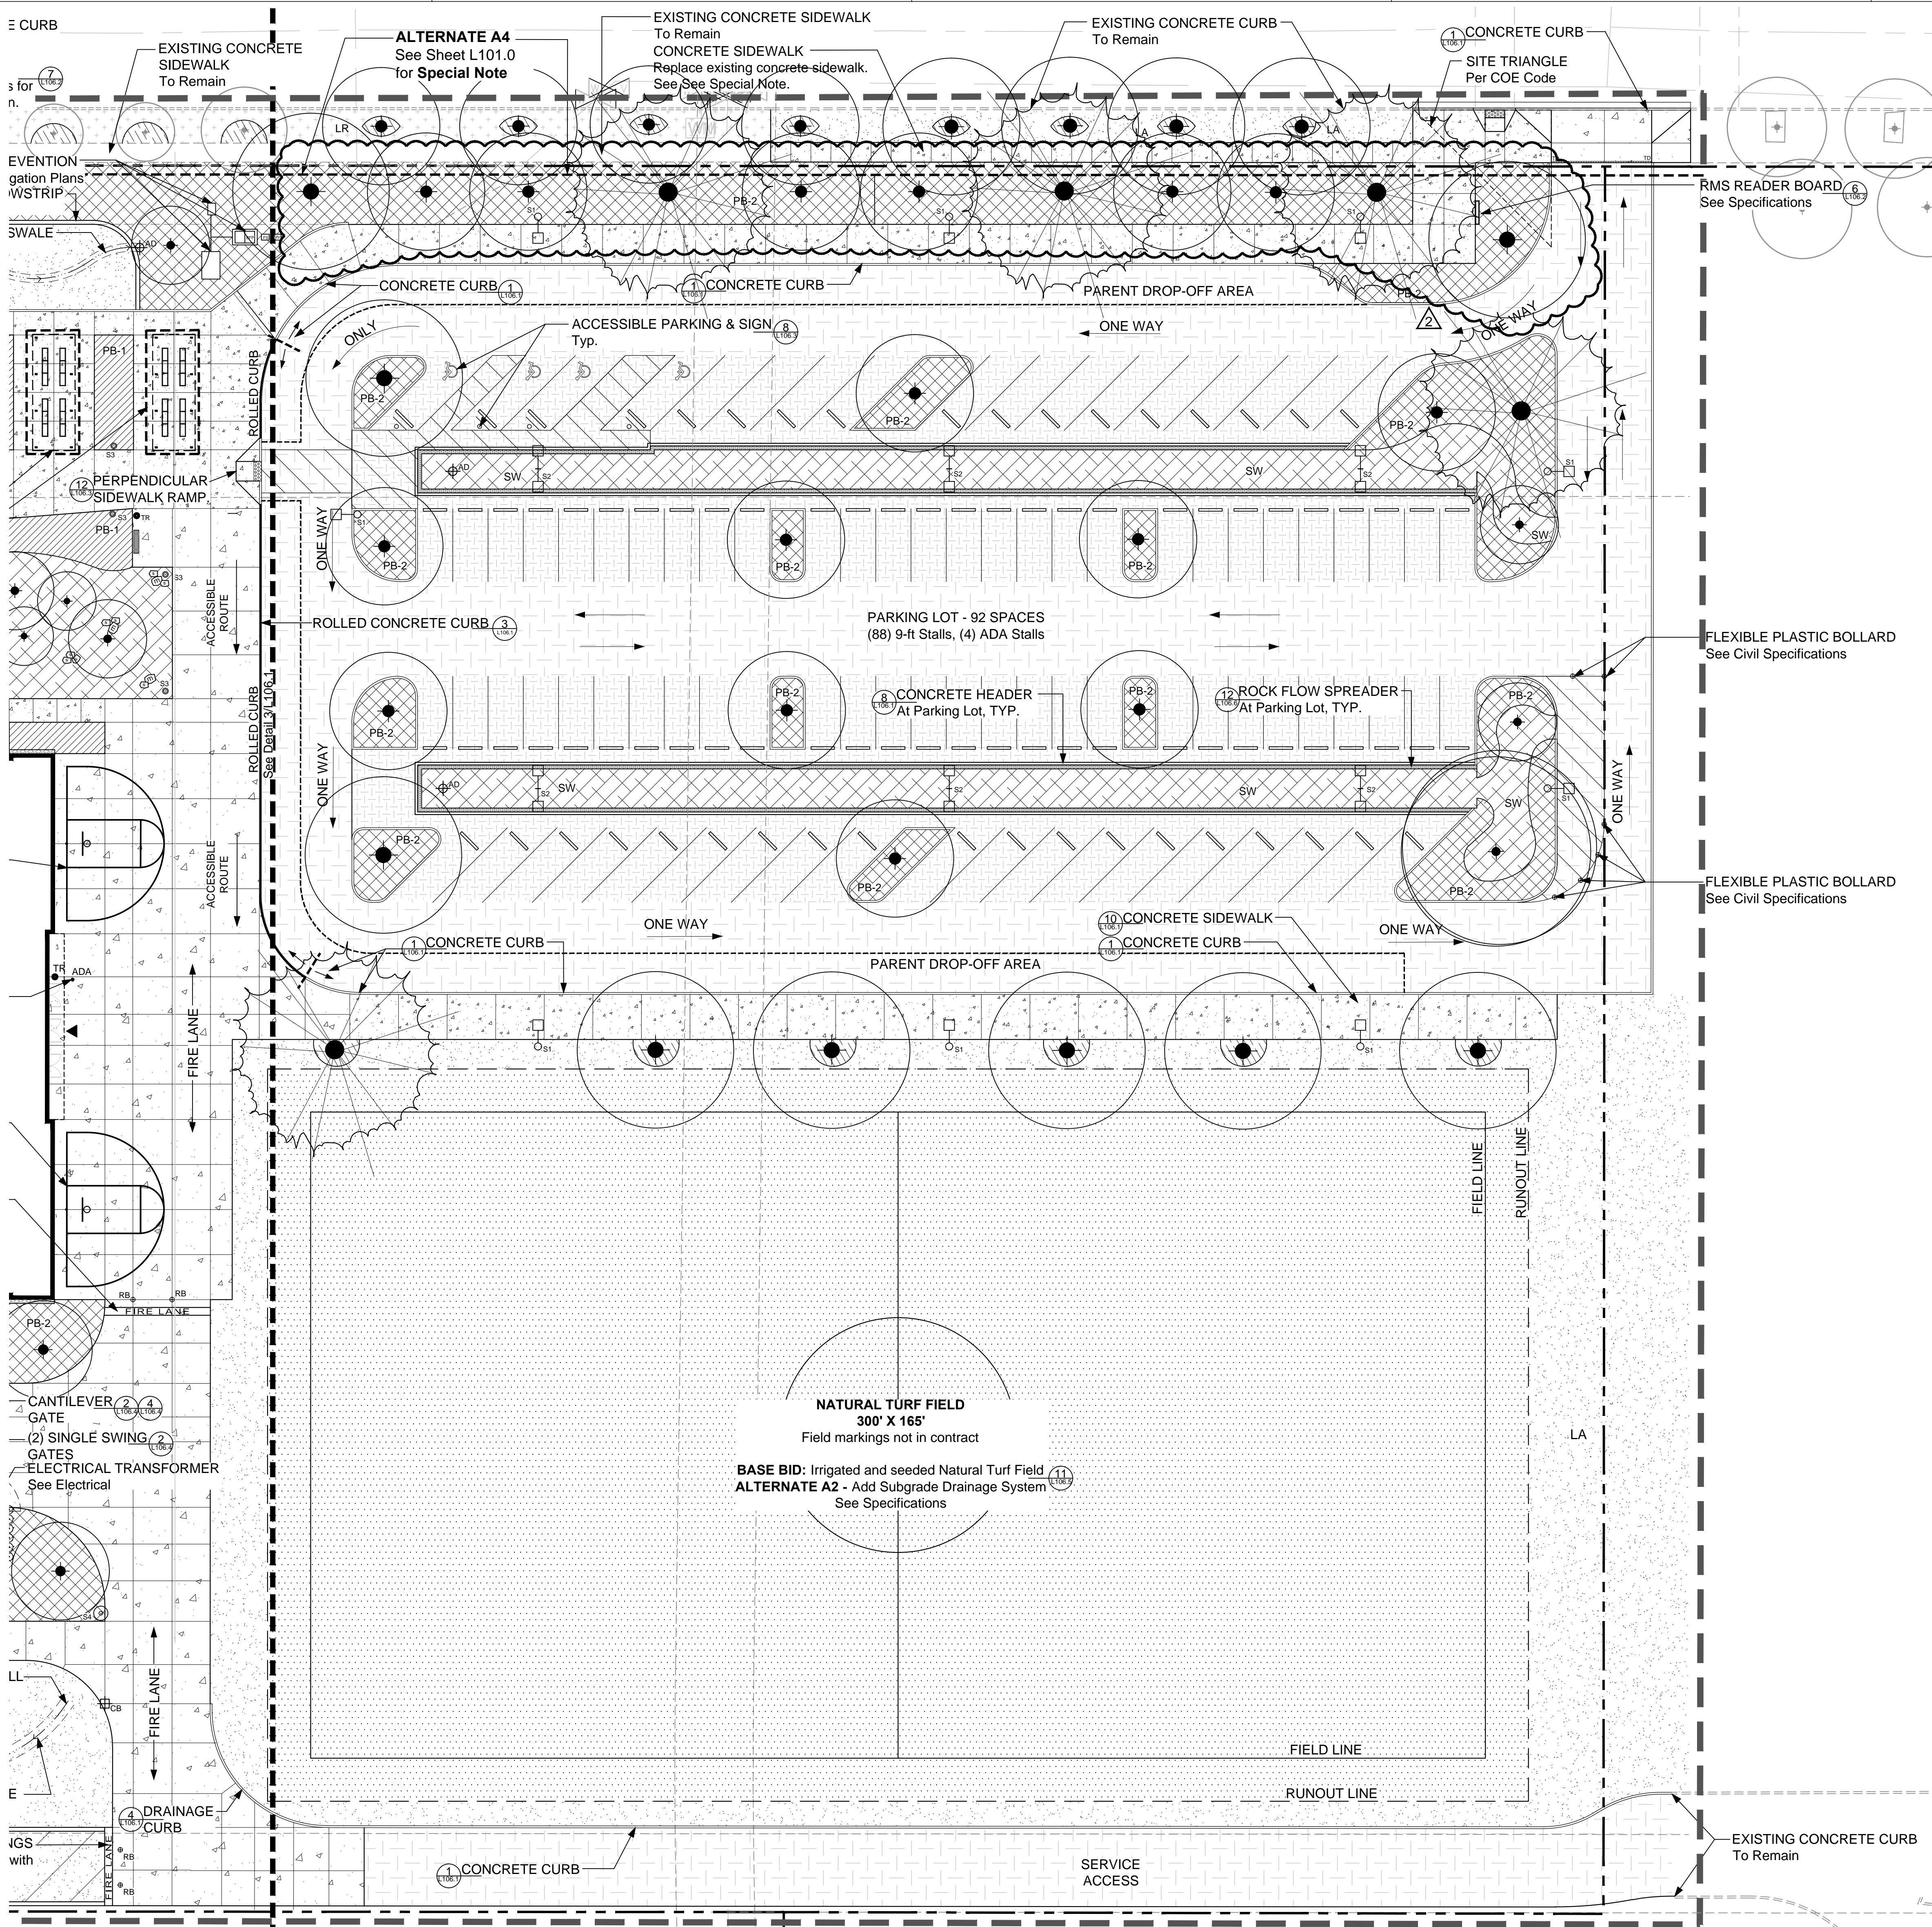


SITE PLAN NOTES:

- All survey information provided by: Branch Engineering Inc. 310 5th Street, Springfield, OR 97477. P: 541.746.0637, F: 541.746.0389, Date: 02.12.2014.
- Verify exact locations and routing of existing underground utilities prior to starting excavation. Repair any damage to existing pipes, utilities or related facilities at Contractor's expense in a manner approved by Owner's Representative.
- Barricade and protect trunks, limbs, roots and root zones beyond dripline of existing trees and plant materials to remain as directed by Owner's Representative. Cut no limbs or roots larger than 2" in diameter without approval of Owner's Representative. Notify Owner's Representative prior to performing any excavation within protection areas.
- Install new utilities so that rim elevations are flush with finish grades at pavement, lawn and plant beds. Adjust rim elevations of existing utilities accordingly.
- All accessible components including, but not limited to signs, ramps, tactile warning, markings, etc. shall conform to all Oregon State Standards for parking and access for the disabled. Obtain Owner's Representative approval prior to installing any related work.
- Verify existing elevations where new work abuts existing to remain. Notify Owner's Representative of any discrepancies.
- In addition to improvements shown, repair all areas disturbed or damaged by construction impacts to the condition that existed prior to construction.
- ALTERNATE A4:** See Sheet L101.0 for **Special Note**.
- Salvage existing 14 bike racks (bike parking spaces for 110) for re-installation. Sand blast and prepare racks from new blue powder coating finish per painting Specifications 09 90 00. Verify color with Architect. Provide new anchors.
- Refer to Civil and Survey Sheets for work within existing Easements. Contact EWEB prior to performing any work, including Grading, within Easement.
- ADA Operator - Door operator at 36-inch with card reader at 42-inch mounted on 48-inch 4x4 painted galvanized HHS post with welded cap set in 12-inch diameter by 30-inch deep concrete footing.

LEGEND:

- LIMIT OF WORK (Approximate)
- PROPERTY LINE
- EASEMENT See Note #10.
- EXISTING TREES To Remain
- PROPOSED DECIDUOUS TREES See Planting Plan
- PROPOSED EVERGREEN TREES See Planting Plan
- GOAL 5 WATER RESOURCE SITE SETBACK
- GRASSY SWALE BASIN & FLOW LINE
- CHAINLINK FENCE
- DECORATIVE METAL FENCE
- CONCRETE PAVING - PEDESTRIAN 6 inch thick over 6 inch base
- CONCRETE PAVING - VEHICLE REINFORCED 8 inch thick over 15 inch base
- AC PAVING - HEAVY 4 inches over 15 inches See Civil
- AC PAVING - LIGHT 2-1/2 inches over 11 inches See Civil
- PLANT BED - Type 1 At Grade, Bark Mulch
- PLANT BED - Type 2 Above Grade, Bark Mulch
- STORMWATER PLANTER Type: Rain Garden With Stone Mulch
- LAWN See Landscape Plan
- LAWN REPAIR Irrigated
- NATURAL TURF FIELD BASE BID: Irrigated and seeded ALTERNATE A2: Subgrade Drainage System See Detail 11/L106.5
- ECO LAWN Non-Irrigated
- REINFORCED LAWN AT FIRE LANE Irrigated
- MULCH AREA
- CONCRETE EDGE At building exterior
- CONCRETE WALK Finish: Exposed Aggregate
- DETECTABLE PAVING
- BIKE RACK Hoop Style # Indicated number of bikes per rack See Note #9
- TRASH RECEPTACLE See Specifications
- BENCH See Specifications
- PICNIC TABLE See Specifications
- FLAG POLE See Specifications
- CONCRETE WHEEL STOP
- DRAINS See Civil & Grading Plan
- TRENCH DRAIN See Civil & Grading Plan
- ACCESSIBLE PARKING SIGN
- REMOVABLE BOLLARD See Specifications
- STEEL BOLLARD See Specifications
- FLEXIBLE PLASTIC BOLLARD See Specifications
- BASALT ACCENT STONE "S" - Small, "M" - Medium, See Specifications
- SITE LIGHTING See Electrical, Lighting Plan and Layout Plan See Specifications
- WALL LIGHT/SITE LIGHTING See Electrical, Lighting Plan and Layout Plan See Specifications
- BIKE/ SKATE STOP

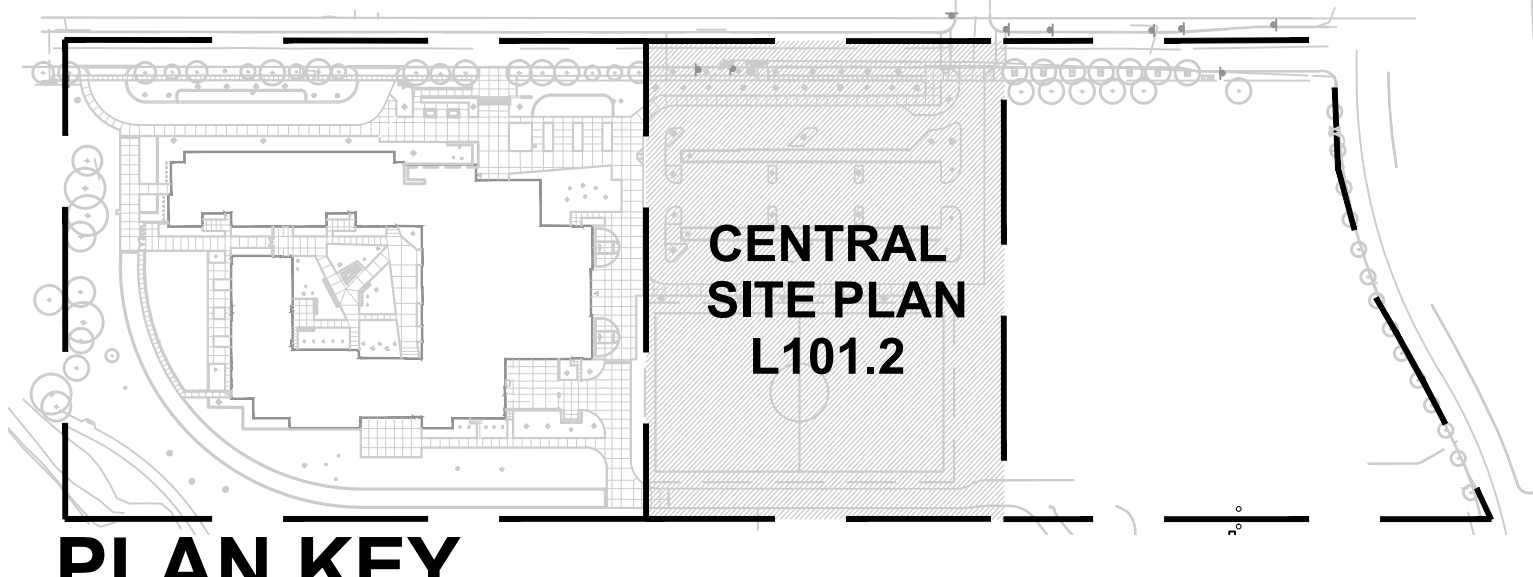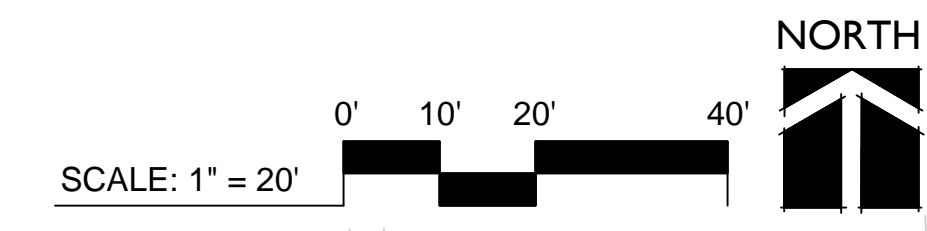

mahlum
ROBERTSON/SHERWOOD/ARCHITECTS PC
132 EAST BROADWAY, SUITE 540
EUGENE, OREGON 97401
541-342-6077
www.robertsonsherwood.com

MAHLUM ARCHITECTS INC
1231 NW HOYT, SUITE 102
PORTLAND, OREGON 97209
503-224-4032

71 COLUMBIA, FLOOR 4
SEATTLE, WASHINGTON 98104
206-441-4151
www.mahlum.com

CAMERON MCCARTHY
LANDSCAPE ARCHITECTURE & PLANNING
160 East Broadway • Eugene Oregon 97401
v 541.485.7385 f 541.485.7389
www.cameronmccarthy.com

REGISTERED
285
LANDSCAPE ARCHITECT
OREGON
LARRY K. BILBERT

EUGENE SCHOOL DISTRICT 4J

4J


REPLACEMENT ROOSEVELT MIDDLE SCHOOL
680 EAST 24TH AVENUE
EUGENE, OREGON 97405

MARK	DATE	DESCRIPTION
1	3-06-2015	ADDENDUM 3
2	3-13-2015	ADDENDUM 6

ISSUE DATE: FEBRUARY 18, 2015
ISSUE: CONSTRUCTION DOCUMENTS
VOLUME: PACKAGE 1
PROJECT NO: 2013912.00
DRAWN BY: NLR / KMK
CHECKED BY: LKG
ORIGINAL SHEET SIZE: 24"X36"

CENTRAL SITE PLAN

L-101.2

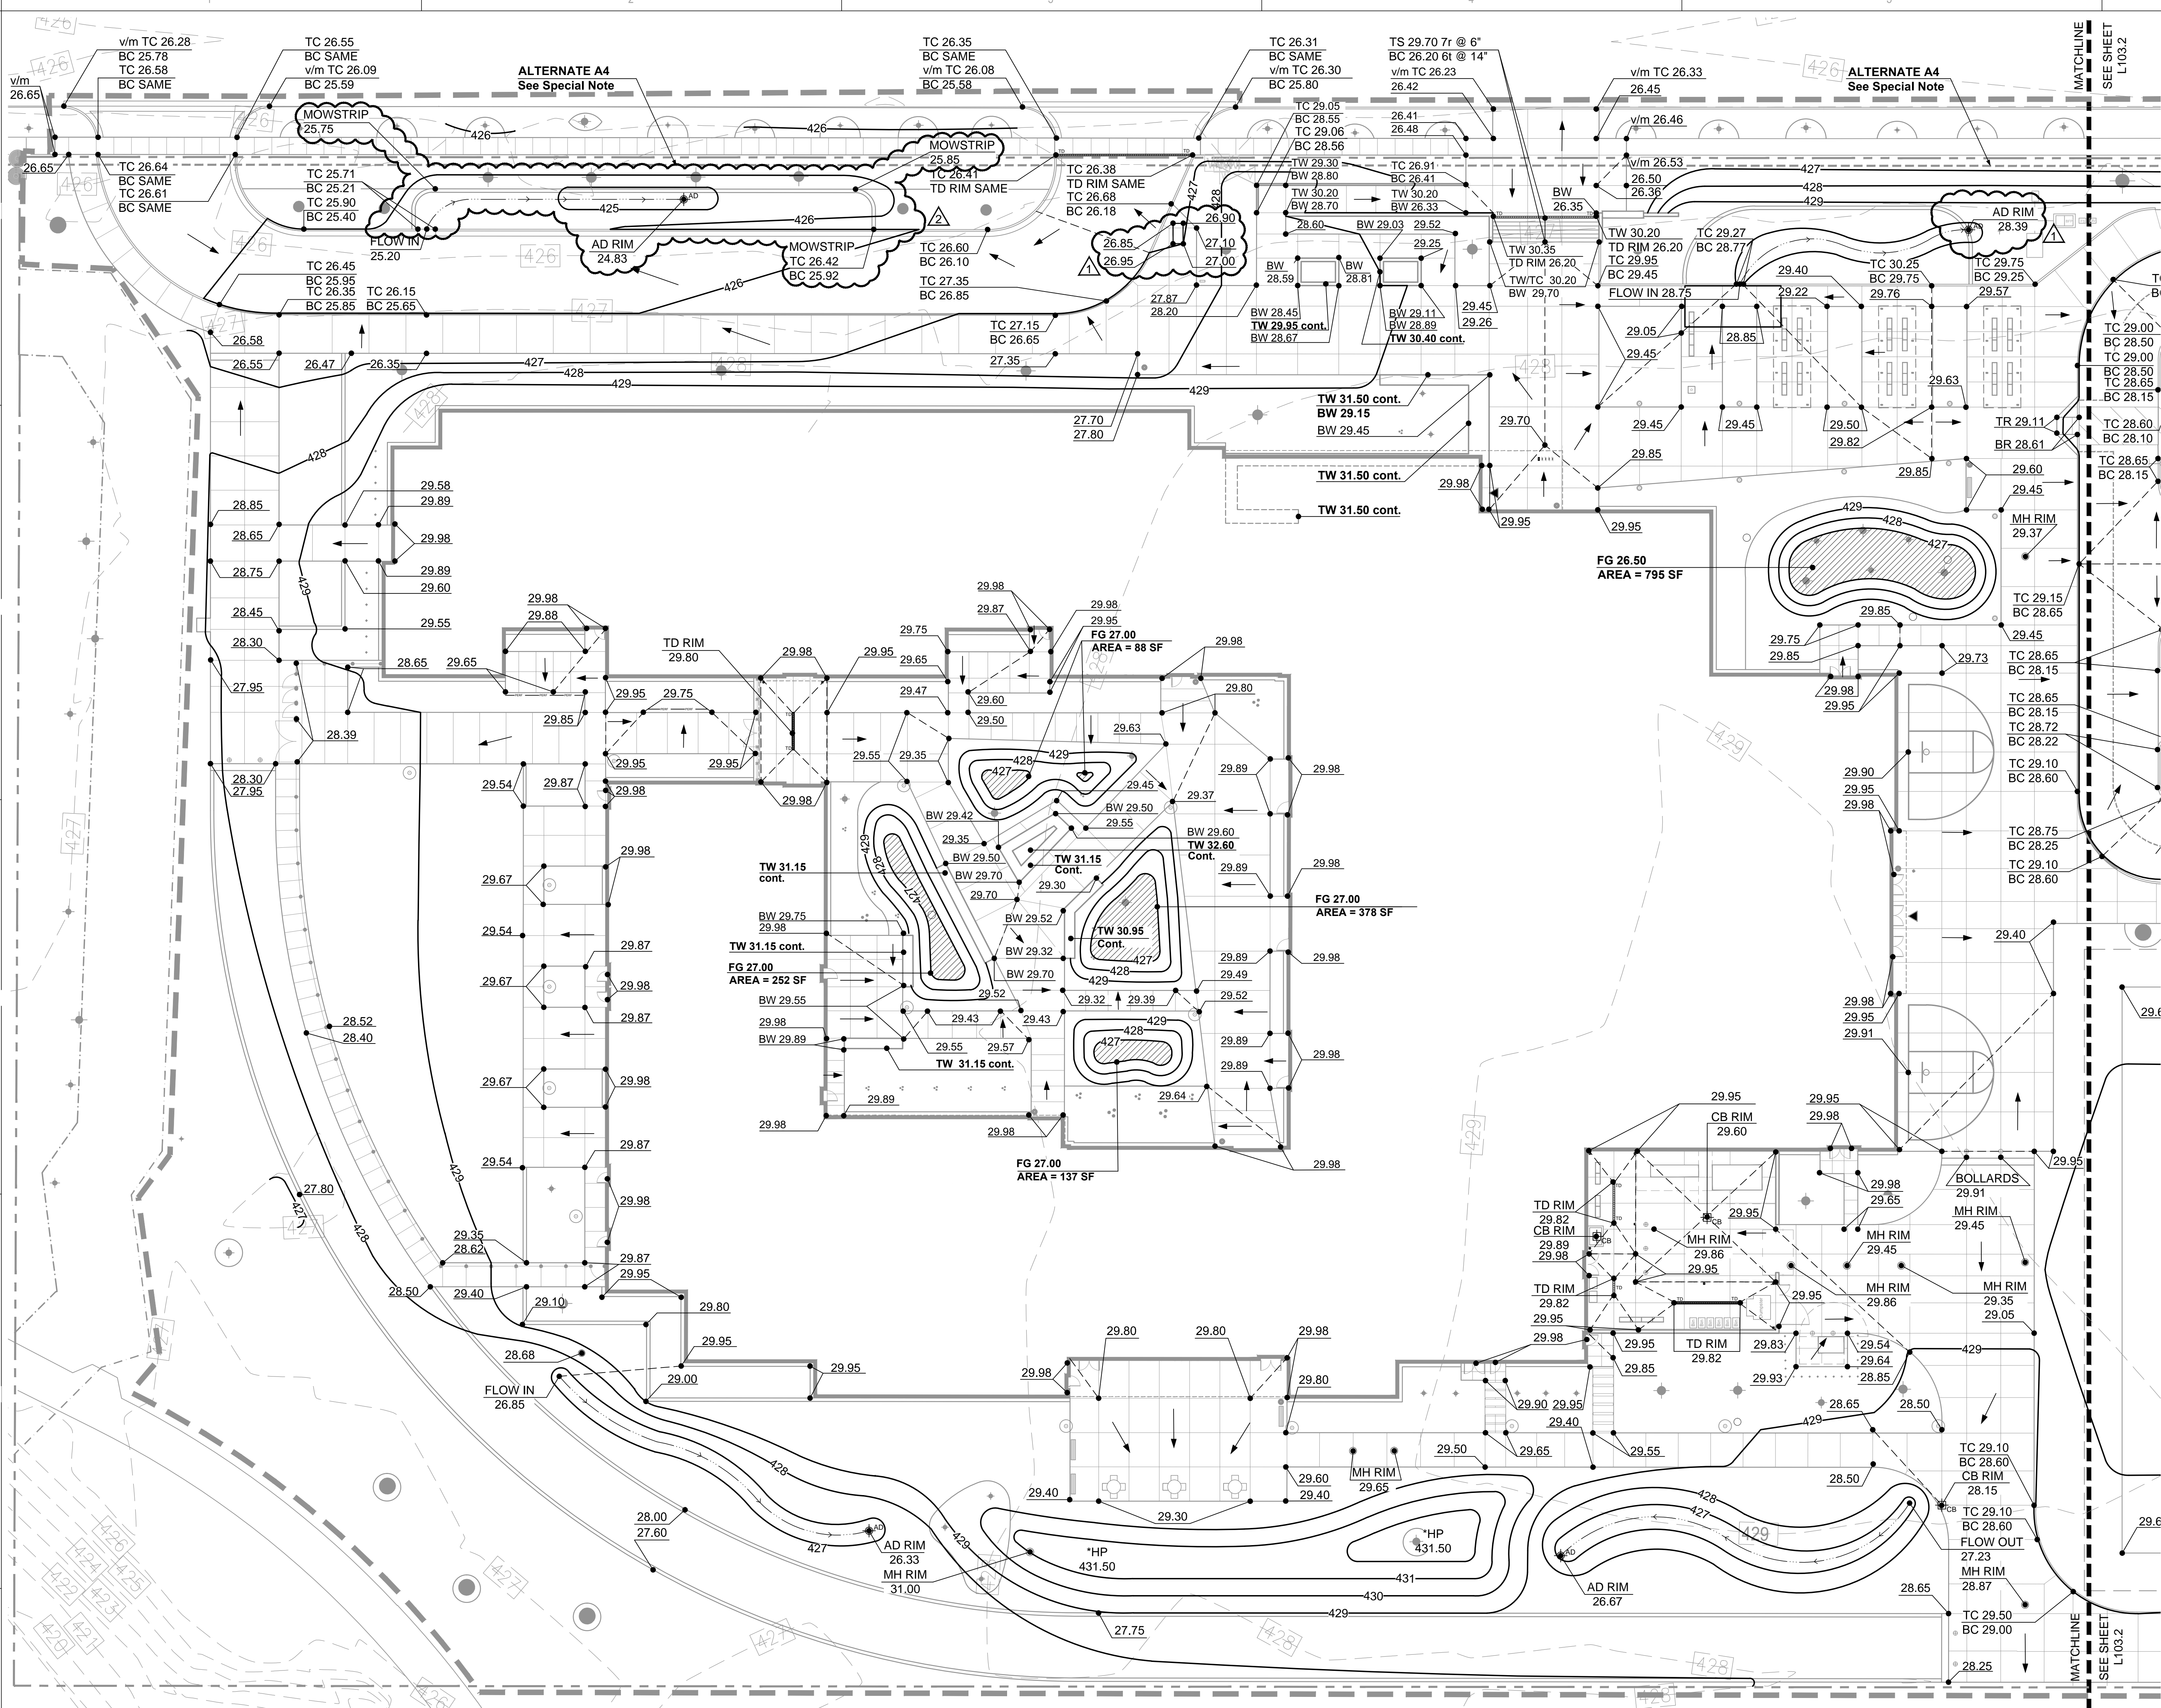

LEGEND:


- LIMIT OF WORK (Approximate)
- - - - - PROPERTY LINE
- - - - - EXISTING CONTOUR
- — — — PROPOSED CONTOUR
- TREE CENTER
- 30.40 SPOT ELEVATION
- TC 30.40
BC 29.90 TOP OF CURB ELEVATION
BOTTOM OF CURB ELEVATION
- TW 30.40
BW 29.90 TOP OF WALL ELEVATION
BOTTOM OF WALL ELEVATION
- TW 30.40 cont. TOP OF WALL ELEVATION
CONTINUOUS
- TS 430.40
BS 429.90 TOP OF STAIR ELEVATION
BOTTOM OF STAIR ELEVATION
- TR 430.40
BR 429.90 TOP OF RAMP ELEVATION
BOTTOM OF RAMP ELEVATION
- v/m 30.40 SPOT ELEVATION
Verify/Match Existing Elevation
Notify Landscape Architect if
match elevation is significant
different from shown.
- CB Rim 29.50 CATCH BASIN RIM ELEVATION
- AD Rim 29.50 AREA DRAIN RIM ELEVATION
- TD Rim 29.50 TRENCH DRAIN RIM
ELEVATION
- HP HIGH POINT
- ↑ BREAK IN PLANE
Arrow indicated direction of flow
- ⊕_{AD} ⊕_{CB} DRAINS
See Civil
- TD TRENCH DRAIN
See Civil
- GRASSY SWALE BASIN &
FLOW LINE
- Stormwater Planter
Basin Area
See Civil for overflow inverts

SPECIAL NOTE


* **ALTERNATE A4**
Base Bid includes improvements to existing 5-ft sidewalk at locations shown on drawings. Alternate includes demo of existing 5-ft sidewalk and replacing with a new 8-ft concrete sidewalk.
See Site Plan L101.0, L101.1 and L101.2 for Base Bid and Alternate work. Contractor will be provided revised plans with horizontal and vertical controls for new improvements if Alternate is selected.

GRADING PLAN NOTES:

1. All survey information provided by: Branch Engineering Inc. 310 5th Street Springfield, OR 97477 P: 541.746.0637 F: 541.746.0389 Date: 02.12.2014
2. Verify exact locations and routing of existing underground utilities prior to starting excavation. Repair any damage to existing pipes, utilities or related facilities at Contractor's expense in a manner approved by Owner's Representative.
3. Barricade and protect trunks, limbs, roots and root zones beyond dripline of existing trees and plant materials to remain as directed by Owner's Representative. Cut no limbs or roots larger than 2" in diameter without approval of Owner's Representative. Notify Owner's Representative prior to performing any excavation within protection areas.
4. All accessible components including, but not limited to signs, ramps, tactile warning markings, etc. shall conform to all Oregon State Standards for parking and access for the disabled. Obtain Owner's Representative approval prior to installing any related work.
5. Install new utilities so that rim elevations are flush with finish grades at pavement, lawn and plant beds. Adjust rim elevations of existing utilities accordingly.
6. Verify existing elevations where new work abuts existing to remain. Notify Owner's Representative of any discrepancies prior to any construction.
7. Adjust rim elevations of existing utilities so that rims are flush with finish grade at new paving and lawns.
8. Blend all new elevations back to existing grade to create a uniform slope. Maximum slope, 4:1.
9. Construct smooth transitions between new paving improvements and existing paving to remain.
10. Add 400 to all proposed spot elevations shown on plan. Elevations shown have been modified for clarity.
11. **Alternate A4: See Special Note.**
12. Refer to Civil and Survey sheets for work within existing easements. Contact EWEB prior to performing any work, including Grading, within Easement.

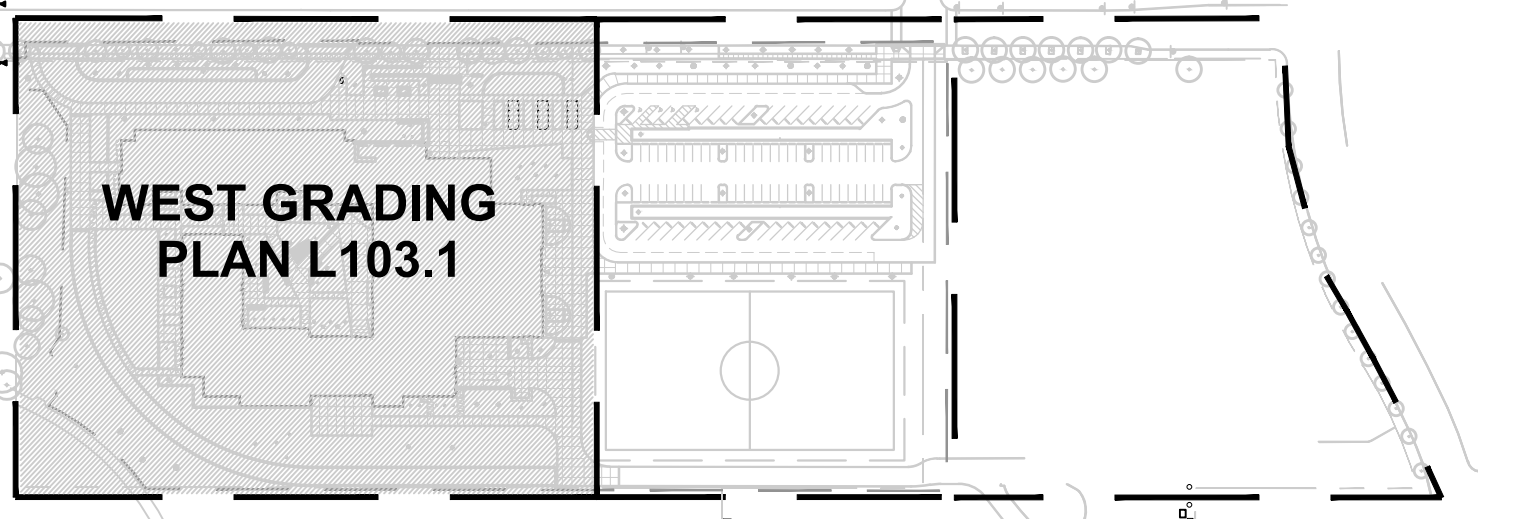

PLAN KEY

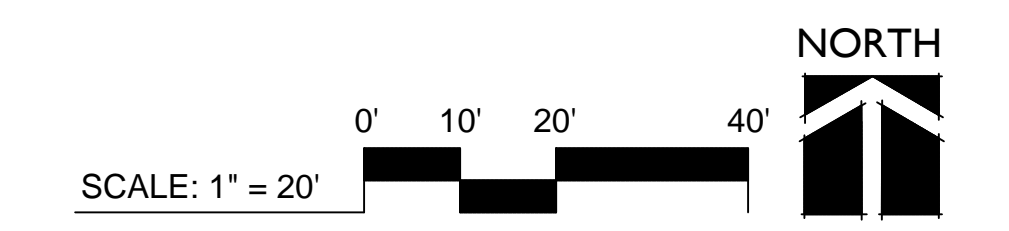


MARK	DATE	DESCRIPTION
1	3-06-2015	ADDENDUM
2	3-13-2015	ADDENDUM

ISSUE DATE: FEBRUARY 18, 2015
 ISSUE: CONSTRUCTION DOCUMENT
 VOLUME: PACKAGING
 PROJECT NO.: 2013912
 DRAWN BY: NLR / KJ
 CHECKED BY: [Signature]

WEST GRADING PLAN

Table with 3 columns: MARK, DATE, DESCRIPTION. Includes dates 3-06-2015, 3-13-2015 and descriptions like ADDENDUM 3, ADDENDUM 6, ISSUE: CONSTRUCTION DOCUMENTS, VOLUME: PACKAGE 1, PROJECT NO: 2013912.00, DRAWN BY: NLR / KMK, CHECKED BY: LKG.

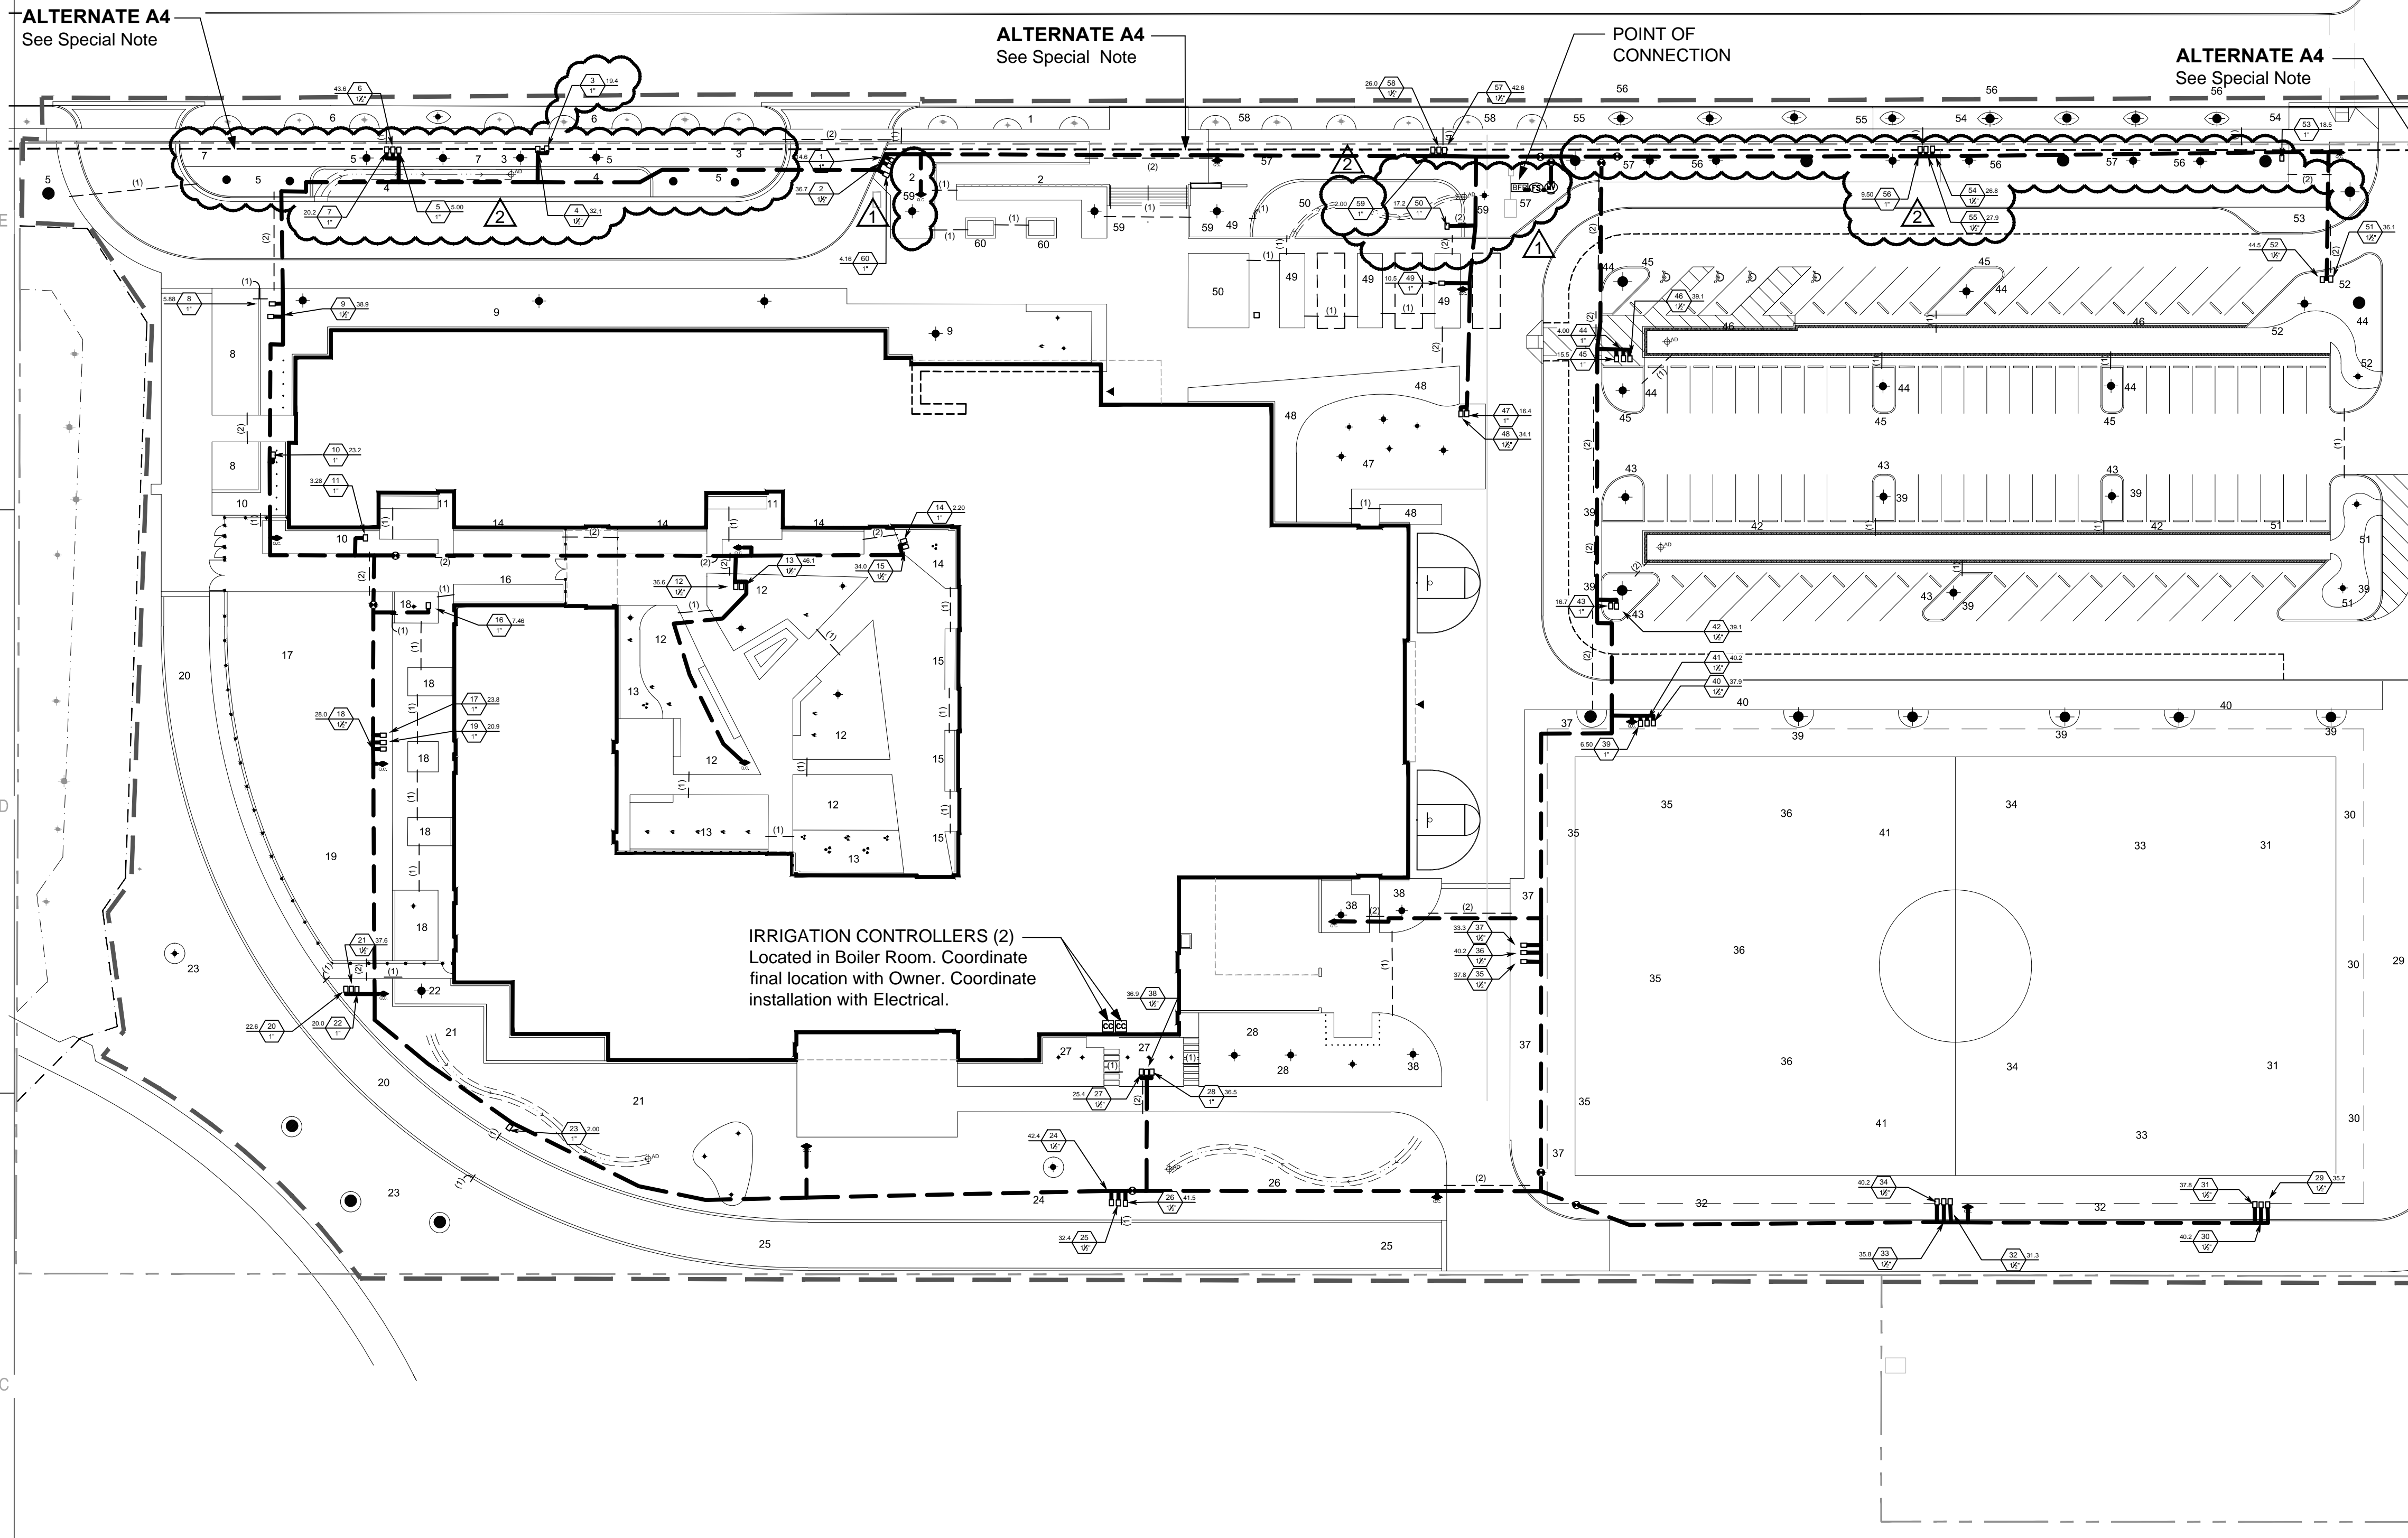

VALVE SCHEDULE

Table with 7 columns: NUMBER, DESCRIPTION, SIZE, TYPE, PSI, GPM, PRECIP. Lists 60 items including Lawn, Plant Bed, and Trees with their respective specifications.

IRRIGATION CONTROLLERS (2)
Located in Boiler Room. Coordinate
final location with Owner. Coordinate
installation with Electrical.

SPECIAL NOTE
***ALTERNATE A4**
Sidewalk expansion will reduce irrigated areas at locations shown on plan. Use smaller radius nozzle to achieve full and even coverage of plant bed. See head schedule for approved nozzle types. Nozzle adjustments will result in additional heads at the following zones:
ZONE 2:
*Reduced plant bed width may require use of Rain Bird MPR nozzles not shown in head schedule.
Total additional heads required = 6
ZONE 3:
Total additional heads required = 4
ZONE 7:
Total additional heads required = 6
ZONE 53:
Total additional heads required = 1
ZONE 57:
Total additional heads required = 18

IRRIGATION HEAD SCHEDULE

Table with 3 columns: SYMBOL, MANUFACTURER/MODEL, PSI. Lists various Rain Bird and Hunter models and their PSI ratings.

Table with 5 columns: SYMBOL, MANUFACTURER/MODEL, PSI, GPM, RADIUS. Lists Rain Bird 5006-PC models and their specifications.


LEGEND:


- PROPERTY LINE
- LIMIT OF WORK (Approximate)
- EXISTING TREES To Remain
- NEW TREE CENTER See Planting Plan
- IRRIGATION CONTROLLER See Specifications
- BACKFLOW PREVENTION DEVICE
- MASTER VALVE
- FLOW SENSOR
- ISOLATION VALVE
- QUICK COUPLER ASSEMBLY
- IRRIGATION MAINLINE Size: 3" throughout, unless noted.
- IRRIGATION SLEEVE 6 inch sleeve at quantity shown in (#)
- ZONE CONTROL VALVE ASSEMBLY
- ZONE NUMBER
- ZONE CONTROL VALVE CALLOUT

IRRIGATION PLAN NOTES:

- All survey information provided by: Branch Engineering Inc. 310 5th Street Springfield, OR 97477 P: 541.746.0637 F: 541.746.0389 Date: 02.12.2014
- Verify exact locations and routing of existing and proposed underground utilities prior to starting any excavation. Any damage to existing pipes, underground utilities or related facilities to be repaired at contractor's expense in a manner approved by Owner's Representative.
- Barricade and protect trunks, limbs, roots and root zones beyond dripline of existing trees and plant materials to remain as directed by Owner's Representative. Cut no limbs or roots larger than 1.5" in diameter without approval of Owner's Representative. Notify Owner's Representative prior to performing any excavation within protection areas.
- Irrigation layout is schematic. It is intended that all irrigation lines will be routed through lawns and plant beds except where noted on drawing. Adjust routing of irrigation lines, heads and sleeves as necessary for any existing or proposed utilities.
- Locate irrigation zone valve assemblies within plant beds where possible. Any irrigation zone valves diagrammatically located in pavement areas are to be installed in plant beds.
- Locate Irrigation mainline, lateral lines, and valve boxes to avoid conflict with tree plantings.
- Install spray heads 3" from adjacent pavement, walls, curbs, and planting edges; 6" from curbs in parking areas (3" if aligned with striping).
- Adjust radius on irrigation heads as necessary to minimize overspray while achieving full and even coverage of planted areas.
- Verify minimum static pressure of 65 psi at point of connection. Notify Owner's Representative prior to any construction if pressure is lower than 60 psi.
- Provide all necessary wiring required to make the irrigation system a fully serviceable and operational controlled installation at the completion of the project.
- Verify all pipe sizing with Schedule 40 Pipe Chart.
- Mainline is intended to be straight segments with 45° elbows and should follow the adjacent walks as shown.
- Install irrigation control, common, and communication wire in underground conduit where routing does not follow new or existing mainline.
- All trenching & excavation within Zone of Protection shown on L100.2 is to be performed with the use of an air spade or by hand. Obtain Owner Representative's approval of trenching & excavation locations and methods prior to performing work.

IRRIGATION NOTES & MAIN LINE PLAN

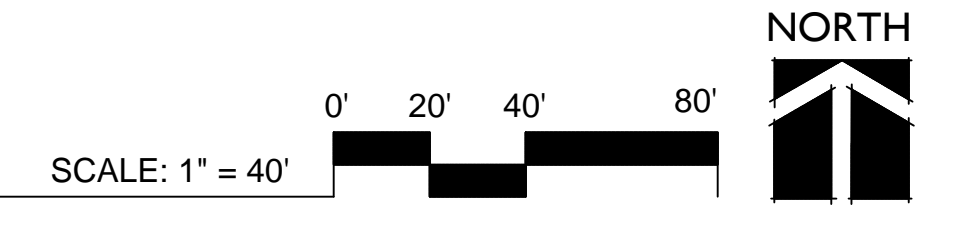

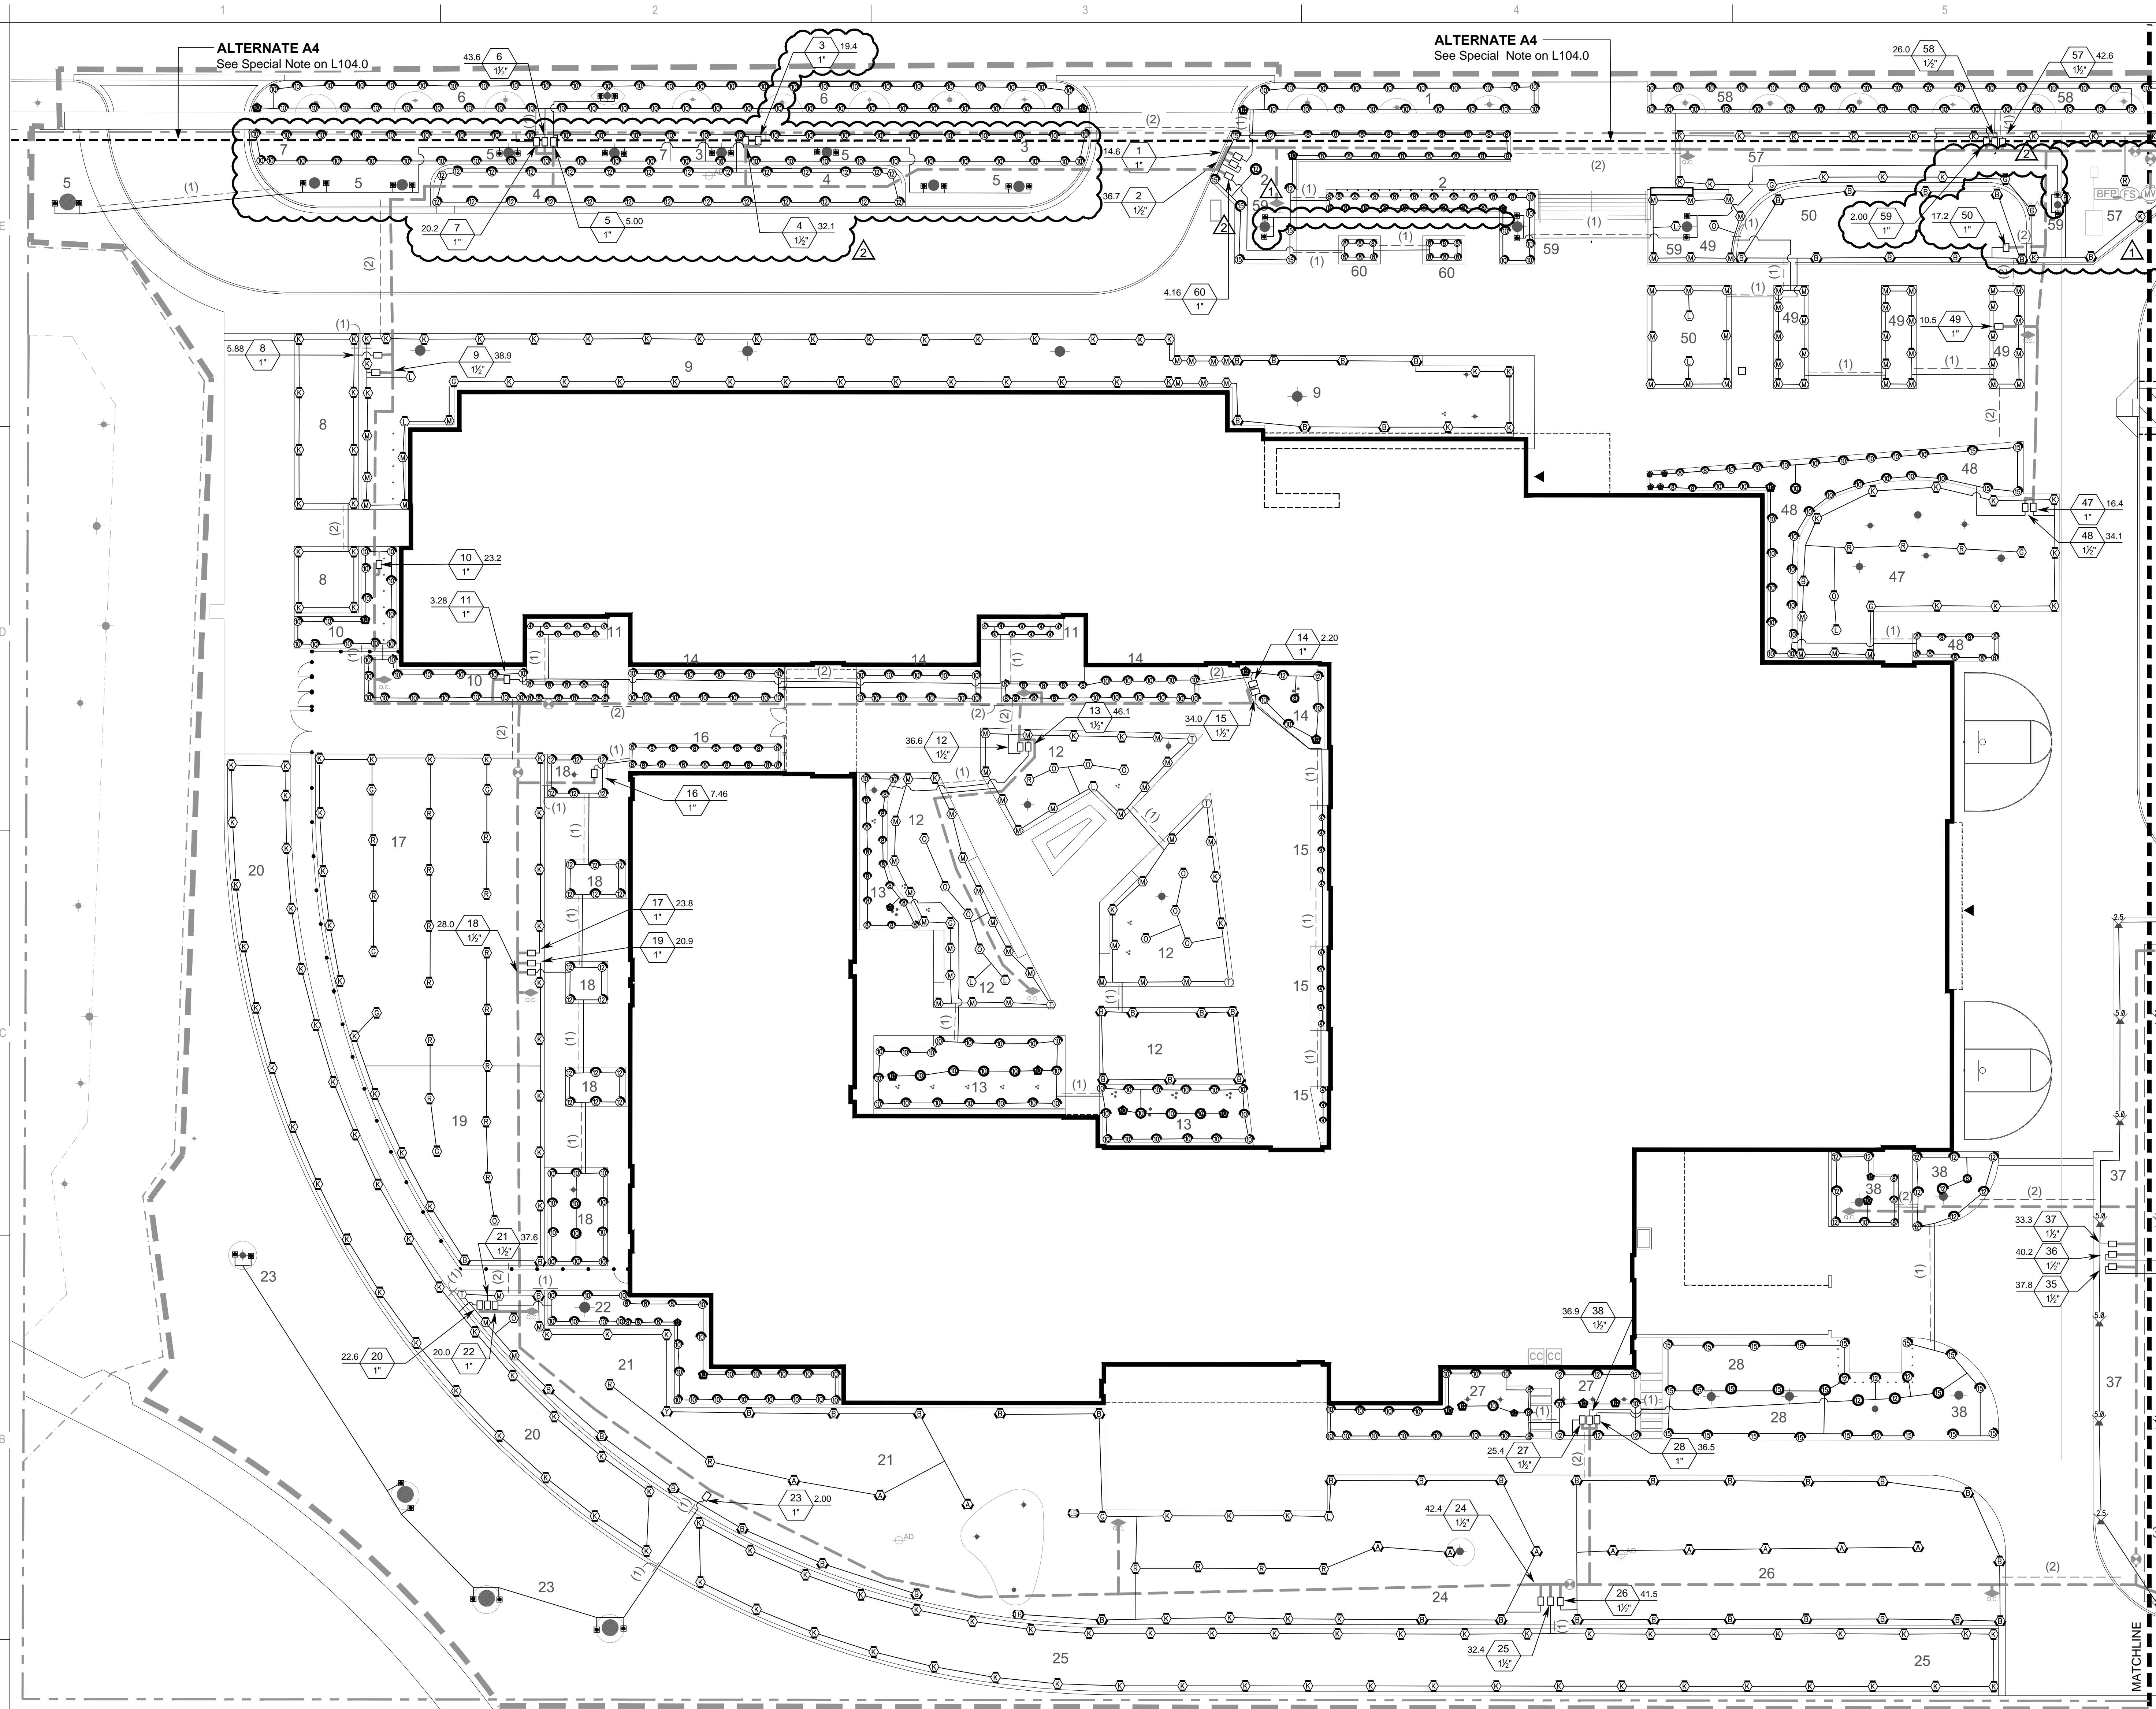

- LEGEND:**
- PROPERTY LINE
 - - - LIMIT OF WORK (Approximate)
 - + EXISTING TREES To Remain
 - NEW TREE CENTER See Planting Plan
 - CC IRRIGATION CONTROLLER See Specifications
 - BFP BACKFLOW PREVENTION DEVICE
 - MV MASTER VALVE
 - FS FLOW SENSOR
 - IV ISOLATION VALVE
 - CA QUICK COUPLER ASSEMBLY
 - IRRIGATION MAINLINE Size: 3" throughout, unless noted.
 - (1) IRRIGATION SLEEVE At quantity shown in (#). See Note 14.
 - ZONE CONTROL VALVE ASSEMBLY
 - 13 ZONE NUMBER
 - Valve Number
 - GPM
 - Valve Size
 - ZONE CONTROL VALVE CALLOUT

VALVE SCHEDULE
1. See Sheet L104.0 for valve schedule

IRRIGATION PLAN NOTES:
1. See Sheet L104.0 for all notes

IRRIGATION HEAD SCHEDULE


SYMBOL	MANUFACTURER/MODEL	PSI
20 2H 2F 40 4H 4F	Rain Bird 1800-U-PRS SQ Series	30
G T H F	Rain Bird 1800-U-PRS U8 Series	30
G T H	Rain Bird 1800-U-PRS U10 Series	30
G T H F	Rain Bird 1800-U-PRS U12 Series	30
G T H F	Rain Bird 1800-U-PRS U15 Series	30
G H F	Rain Bird 1800-PRS 5 Series MPR	30
G H F	Rain Bird 1800-PRS ADJ	30
MP1000	Hunter MP1000 PROS-CV** Series	40
MP2000	Hunter MP2000 PROS-CV** Series	40
MP3000	Hunter MP3000 PROS-CV** Series	40
MP3500	Hunter MP3500 PROS-CV** Series	40
MP Corner	Hunter MP Corner PROS-CV** Series	40
RZWS-36-25CV	Hunter RZWS-36-25CV	30

* Use 1806 at Lawn, 1812 at Shrub Planting
** PROS-06 at Lawn, PROS-12 at Shrub Planting

SYMBOL	MANUFACTURER/MODEL	PSI	GPM	RADIUS
2.5	Rain Bird 5006-PC, FC-SAM-R	35	2.17	37'
5.0	Rain Bird 5006-PC, FC-SAM-R	35	4.47	41'

PIPE SIZE SCHEDULE:

SCHEDULE 40 PIPE	
GPM	SIZE
0-7	3/4"
7-11	1"
11-21	1 1/4"
21-29	1 1/2"
29-49	2"
49-69	2 1/2"
69-110	3"

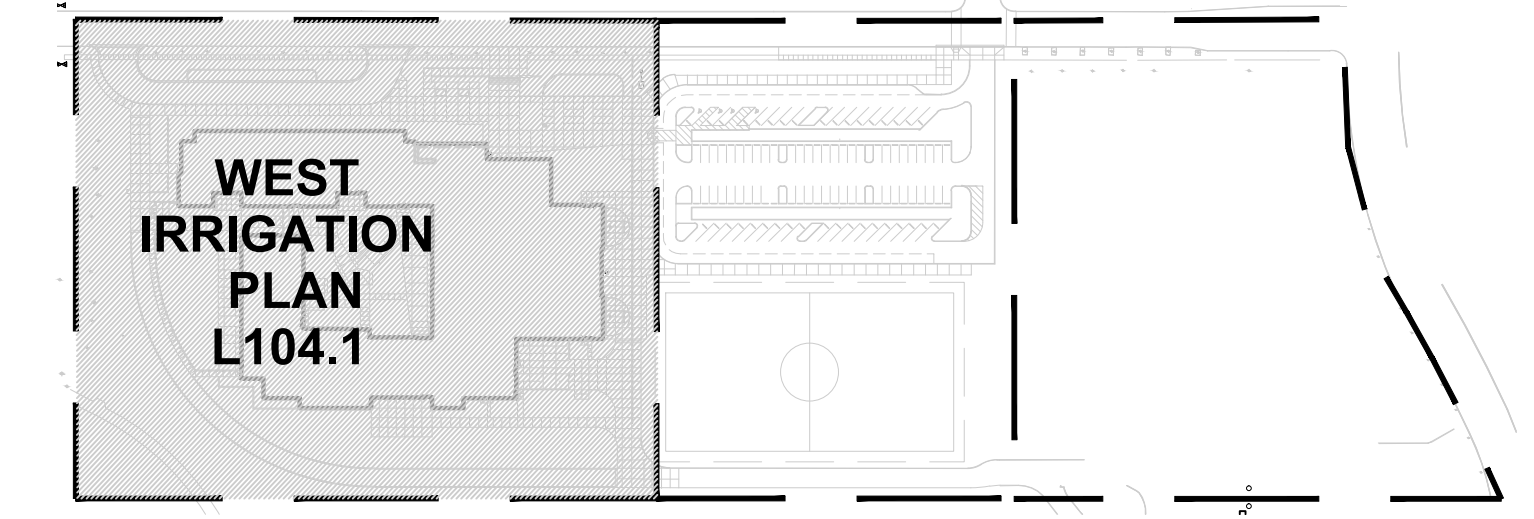

mahlum
ROBERTSON/SHERWOOD/ARCHITECTS PC
132 EAST BROADWAY, SUITE 540
EUGENE, OREGON 97401
541-342-6077
www.robertsonsherwood.com

MAHLUM ARCHITECTS INC
1231 NW HOYT, SUITE 102
PORTLAND, OREGON 97209
503-224-4032

71 COLUMBIA, FLOOR 4
SEATTLE, WASHINGTON 98104
206-441-1511
www.mahlum.com

CAMERON McCARTHY
LANDSCAPE ARCHITECTURE & PLANNING
160 East Broadway • Eugene Oregon 97401
v 541.485.7385 f 541.485.7389
www.cameronmccarthy.com

REGISTERED
285
Larry K. Gilbert
LANDSCAPE ARCHITECT
OREGON

EUGENE SCHOOL DISTRICT 4J


REPLACEMENT ROOSEVELT
MIDDLE SCHOOL
680 EAST 24TH AVENUE
EUGENE, OREGON 97405

MARK	DATE	DESCRIPTION
1	3-06-2015	ADDENDUM 3
2	3-13-2015	ADDENDUM 6

ISSUE DATE: FEBRUARY 18, 2015
ISSUE: CONSTRUCTION DOCUMENTS
VOLUME: PACKAGE 1
PROJECT NO: 2013912.00
DRAWN BY: NLR / KMK
CHECKED BY: LKG
ORIGINAL SHEET SIZE: 36"x48"

WEST IRRIGATION PLAN

L-104.1

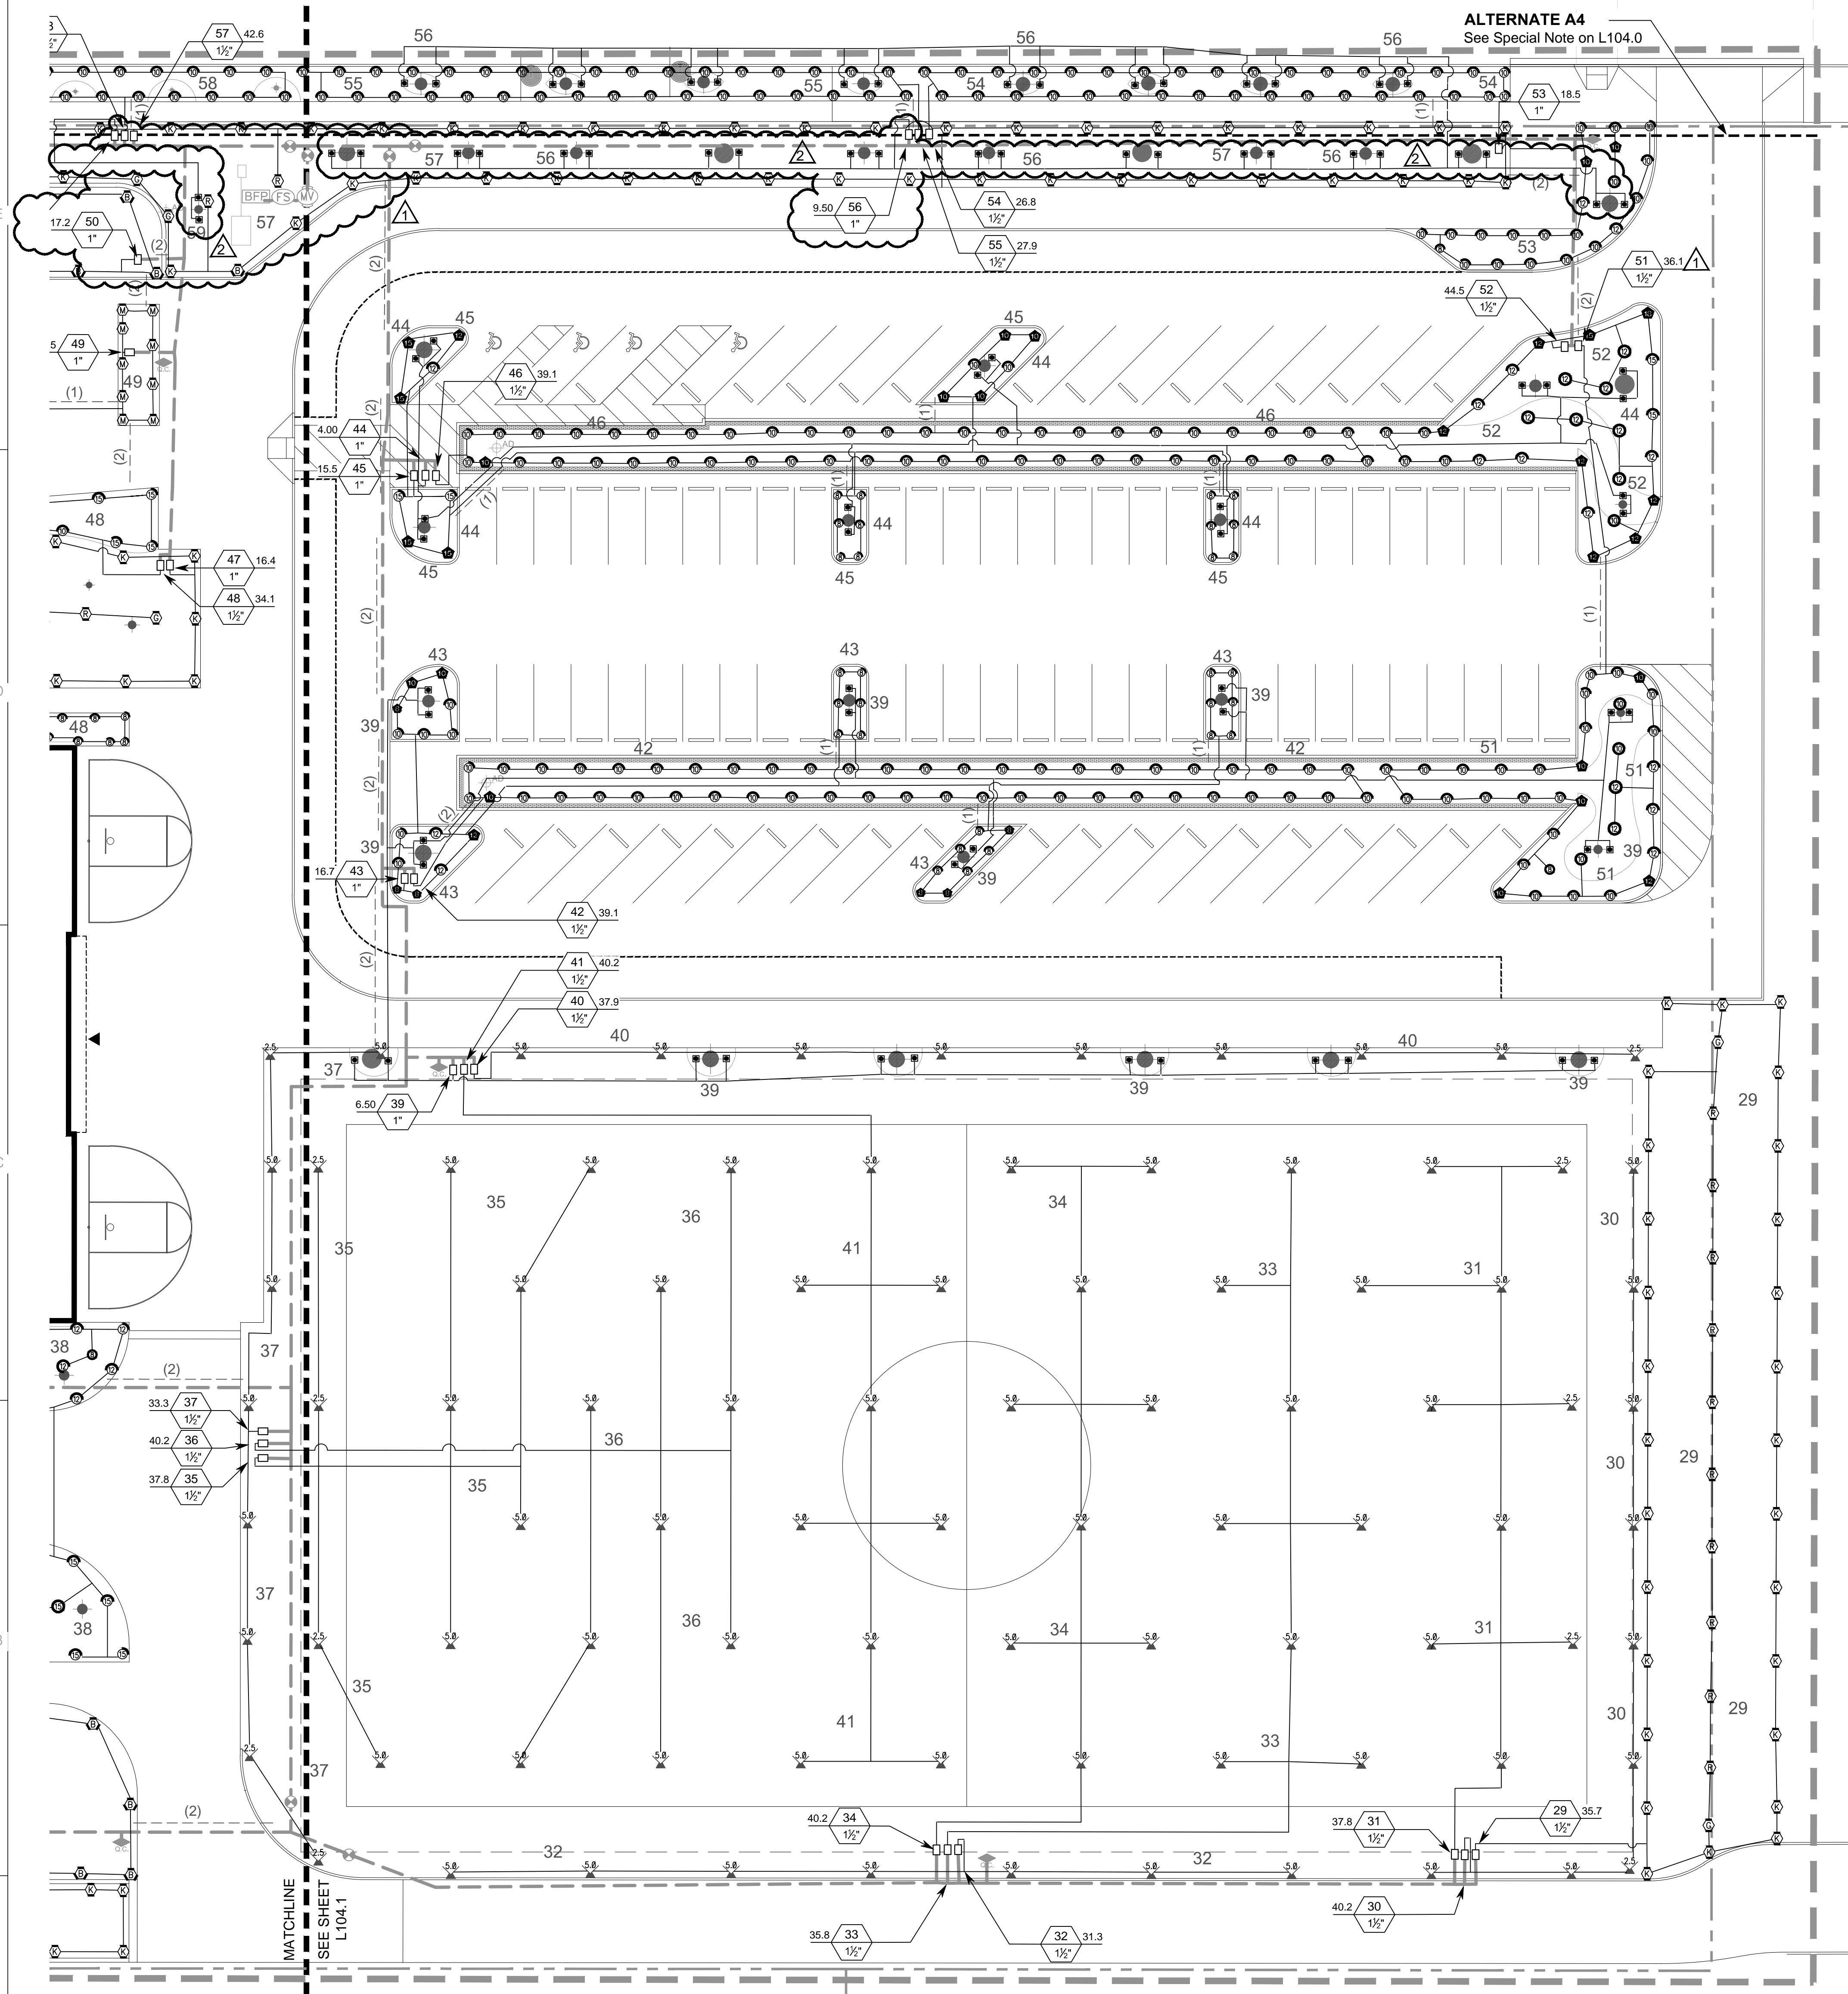

IRRIGATION PLAN NOTES:

1. See Sheet L104.0 for all notes

IRRIGATION HEAD SCHEDULE (7, 8, 10)

SYMBOL	MANUFACTURER/MODEL	PSI
⊙	Rain Bird 1800*U-PRS SQ Series	30
⊙	Rain Bird 1800*U-PRS U8 Series	30
⊙	Rain Bird 1800*U-PRS U10 Series	30
⊙	Rain Bird 1800*U-PRS U12 Series	30
⊙	Rain Bird 1800*U-PRS U15 Series	30
⊙	Rain Bird 1800*-PRS 5 Series MPR	30
⊙	Rain Bird 1800*-PRS ADJ	30
⊙	Hunter MP1000 PROS-CV** Series	40
⊙	Hunter MP2000 PROS-CV** Series	40
⊙	Hunter MP3000 PROS-CV** Series	40
⊙	Hunter MP3500 PROS-CV** Series	40
⊙	Hunter MP Corner PROS-CV** Series	40
⊙	Hunter RZWS-36-25CV	30

* Use 1806 at Lawn, 1812 at Shrub Planting
 ** PROS-06 at Lawn, PROS-12 at Shrub Planting

SYMBOL	MANUFACTURER/MODEL	PSI	GPM	RADIUS
⊙	Rain Bird 5006-PC, FC-SAM-R	35	2.17	37'
⊙	Rain Bird 5006-PC, FC-SAM-R	35	4.47	41'

PIPE SIZE SCHEDULE:

SCHEDULE 40 PIPE	
GPM	SIZE
0-7	3/4"
7-11	1"
11-21	1 1/4"
21-29	1 1/2"
29-49	2"
49-69	2 1/2"
69-110	3"

LEGEND:

- PROPERTY LINE
- LIMIT OF WORK (Approximate)
- ⊙ EXISTING TREES To Remain
- ⊙ NEW TREE CENTER See Planting Plan
- ⊙ IRRIGATION CONTROLLER See Specifications
- ⊙ BACKFLOW PREVENTION DEVICE
- ⊙ MASTER VALVE
- ⊙ FLOW SENSOR
- ⊙ ISOLATION VALVE
- ⊙ QUICK COUPLER ASSEMBLY
- IRRIGATION MAINLINE Size: 3" throughout, unless noted.
- IRRIGATION SLEEVE At quantity shown in (#). See Note 14.
- ⊙ ZONE CONTROL VALVE ASSEMBLY
- 13 ZONE NUMBER
- ⊙ ZONE CONTROL VALVE CALLOUT

VALVE SCHEDULE

NUMBER	DESCRIPTION	SIZE	TYPE	PSI	GPM	PRECIP
1	Lawn	1"	Spray	30	14.56	1.72
2	Lawn	1 1/2"	Spray	30	26.67	1.86
3	Lawn	1 1/2"	Spray	30	24.67	1.55
4	Lawn	1 1/2"	Spray	30	29.9	1.48
5	Trees	1"	Bubbler	30	4	7.66
6	Lawn	1 1/2"	Spray	30	29.9	1.48
7	Lawn	1 1/2"	Spray	30	25.47	1.57
8	Lawn	1"	Rotary	40	5.88	0.43
9	Plant Bed	1 1/2"	Rotary	40	38.86	0.59
10	Plant Bed	1"	Spray	30	23.2	1.9
11	Plant Bed	1"	Spray	30	3.28	1.63
12	Plant Bed	1 1/2"	Rotary	40	36.56	0.65
13	Plant Bed	1 1/2"	Spray	30	46.11	1.9
14	Plant Bed	1 1/2"	Spray	30	2.2	0.92
15	Plant Bed	1"	Spray	30	34.02	2.05
16	Plant Bed	1"	Spray	30	7.46	2.36
17	Lawn	1"	Rotary	40	23.77	0.45
18	Plant Bed	1 1/2"	Spray	30	28.04	1.99
19	Lawn	1"	Rotary	40	20.88	0.46
20	Lawn	1"	Rotary	40	22.57	0.42
21	Lawn	1 1/2"	Rotary	40	37.64	0.48
22	Plant Bed	1"	Spray	30	19.99	1.88
23	Trees	1"	Bubbler	30	2	7.66
24	Lawn	1 1/2"	Rotary	40	42.43	0.45
25	Lawn	1 1/2"	Rotary	40	32.44	0.41
26	Lawn	1 1/2"	Rotary	40	41.51	0.61
27	Plant Bed	1 1/2"	Spray	30	25.35	1.83
28	Plant Bed	1"	Spray	30	36.54	1.71
29	Lawn	1 1/2"	Rotary	40	35.67	0.44
30	Lawn	1 1/2"	Rotor	35	40.23	0.76
31	Lawn	1 1/2"	Rotor	35	37.8	0.31
32	Lawn	1 1/2"	Rotor	35	31.29	0.52
33	Lawn	1 1/2"	Rotor	35	35.76	0.33
34	Lawn	1 1/2"	Rotor	35	40.23	0.34
35	Lawn	1 1/2"	Rotor	35	37.8	0.32
36	Lawn	1 1/2"	Rotor	35	40.23	0.31
37	Lawn	1 1/2"	Rotor	35	33.33	0.54
38	Plant Bed	1 1/2"	Spray	30	36.9	1.68
39	Trees	1"	Bubbler	30	6.5	7.66
40	Lawn	1 1/2"	Rotor	35	37.93	0.56
41	Lawn	1 1/2"	Rotor	35	40.23	0.34
42	Plant Bed	1 1/2"	Spray	30	39.15	1.71
43	Plant Bed	1"	Spray	30	16.74	1.63
44	Trees	1"	Bubbler	30	4	7.66
45	Plant Bed	1"	Spray	30	15.52	1.52
46	Plant Bed	1 1/2"	Spray	30	39.15	1.7
47	Plant Bed	1"	Rotary	40	16.4	0.5
48	Plant Bed	1 1/2"	Spray	30	34.13	1.79
49	Plant Bed	1"	Rotary	40	10.5	0.6
50	Lawn	1"	Rotary	40	17.21	0.50
51	Plant Bed	1 1/2"	Spray	30	36.05	1.79
52	Plant Bed	1 1/2"	Spray	30	44.46	2
53	Plant Bed	1"	Spray	30	18.49	1.84
54	Lawn	1 1/2"	Spray	30	26.79	1.91
55	Lawn	1 1/2"	Spray	30	27.88	1.86
56	Lawn	1 1/2"	Spray	30	6.5	2.48
57	Plant Bed	1 1/2"	Rotor	40	39.14	0.48
58	Lawn	1 1/2"	Spray	30	36.93	1.92
59	Trees	1"	Bubbler	30	1	7.66
60	Plant Bed	1"	Spray	30	4.16	2



ROBERTSON/SHERWOOD/ARCHITECTS PC
 132 EAST BROADWAY, SUITE 540
 EUGENE, OREGON 97401
 541-542-6077
 www.robertsonsherwood.com

MAHLUM ARCHITECTS INC
 1231 NW HOYT, SUITE 102
 PORTLAND, OREGON 97209
 503-224-4032
 71 COLUMBIA, FLOOR 4
 SEATTLE, WASHINGTON 98104
 206-441-4151
 www.mahlum.com



CAMERON MCCARTHY
 LANDSCAPE ARCHITECTURE & PLANNING
 160 East Broadway • Eugene Oregon 97401
 v 541.485.7385 f 541.485.7389
 www.cameronmccarthy.com



EUGENE SCHOOL DISTRICT 4J



REPLACEMENT ROOSEVELT
 MIDDLE SCHOOL
 680 EAST 24TH AVENUE
 EUGENE, OREGON 97405

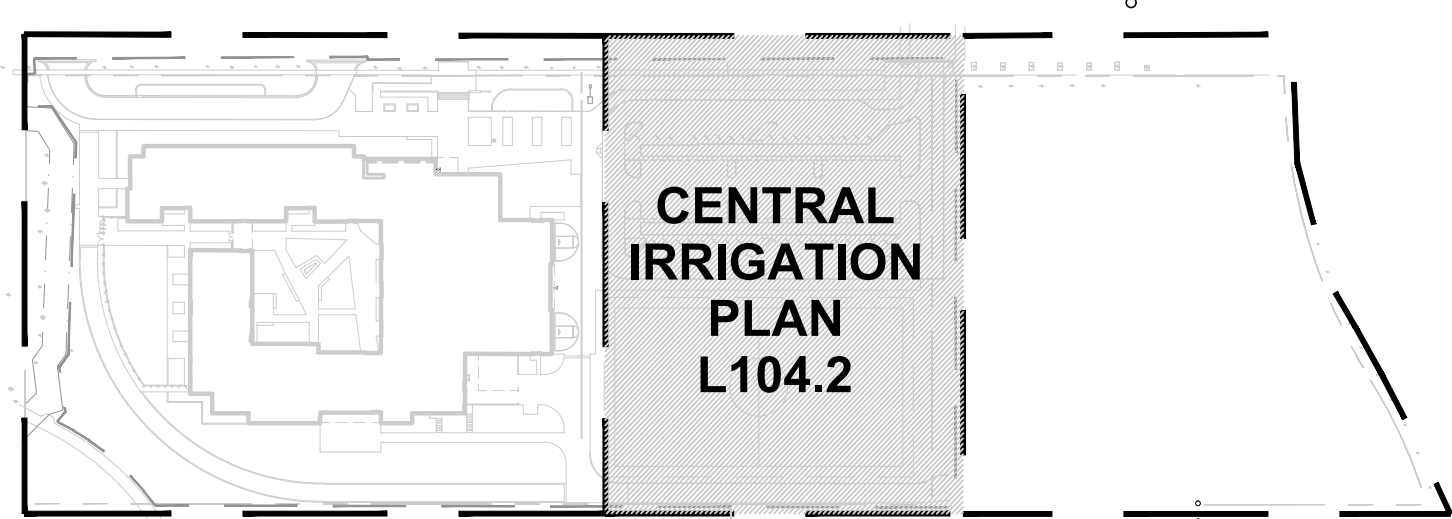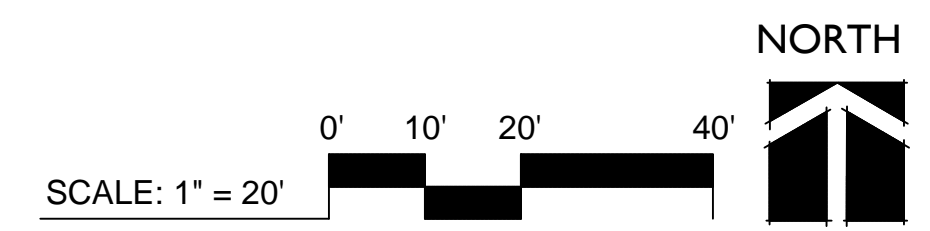


MARK	DATE	DESCRIPTION
1	3-06-2015	ADDENDUM 3
2	3-13-2015	ADDENDUM 6

ISSUE DATE: FEBRUARY 18, 2015
 ISSUE: CONSTRUCTION DOCUMENTS
 VOLUME: PACKAGE 1
 PROJECT NO: 2013912.00
 DRAWN BY: NLR / KMK
 CHECKED BY: LKG
 ORIGINAL SHEET SIZE: 30"x42"

CENTRAL IRRIGATION PLAN

L-104.2

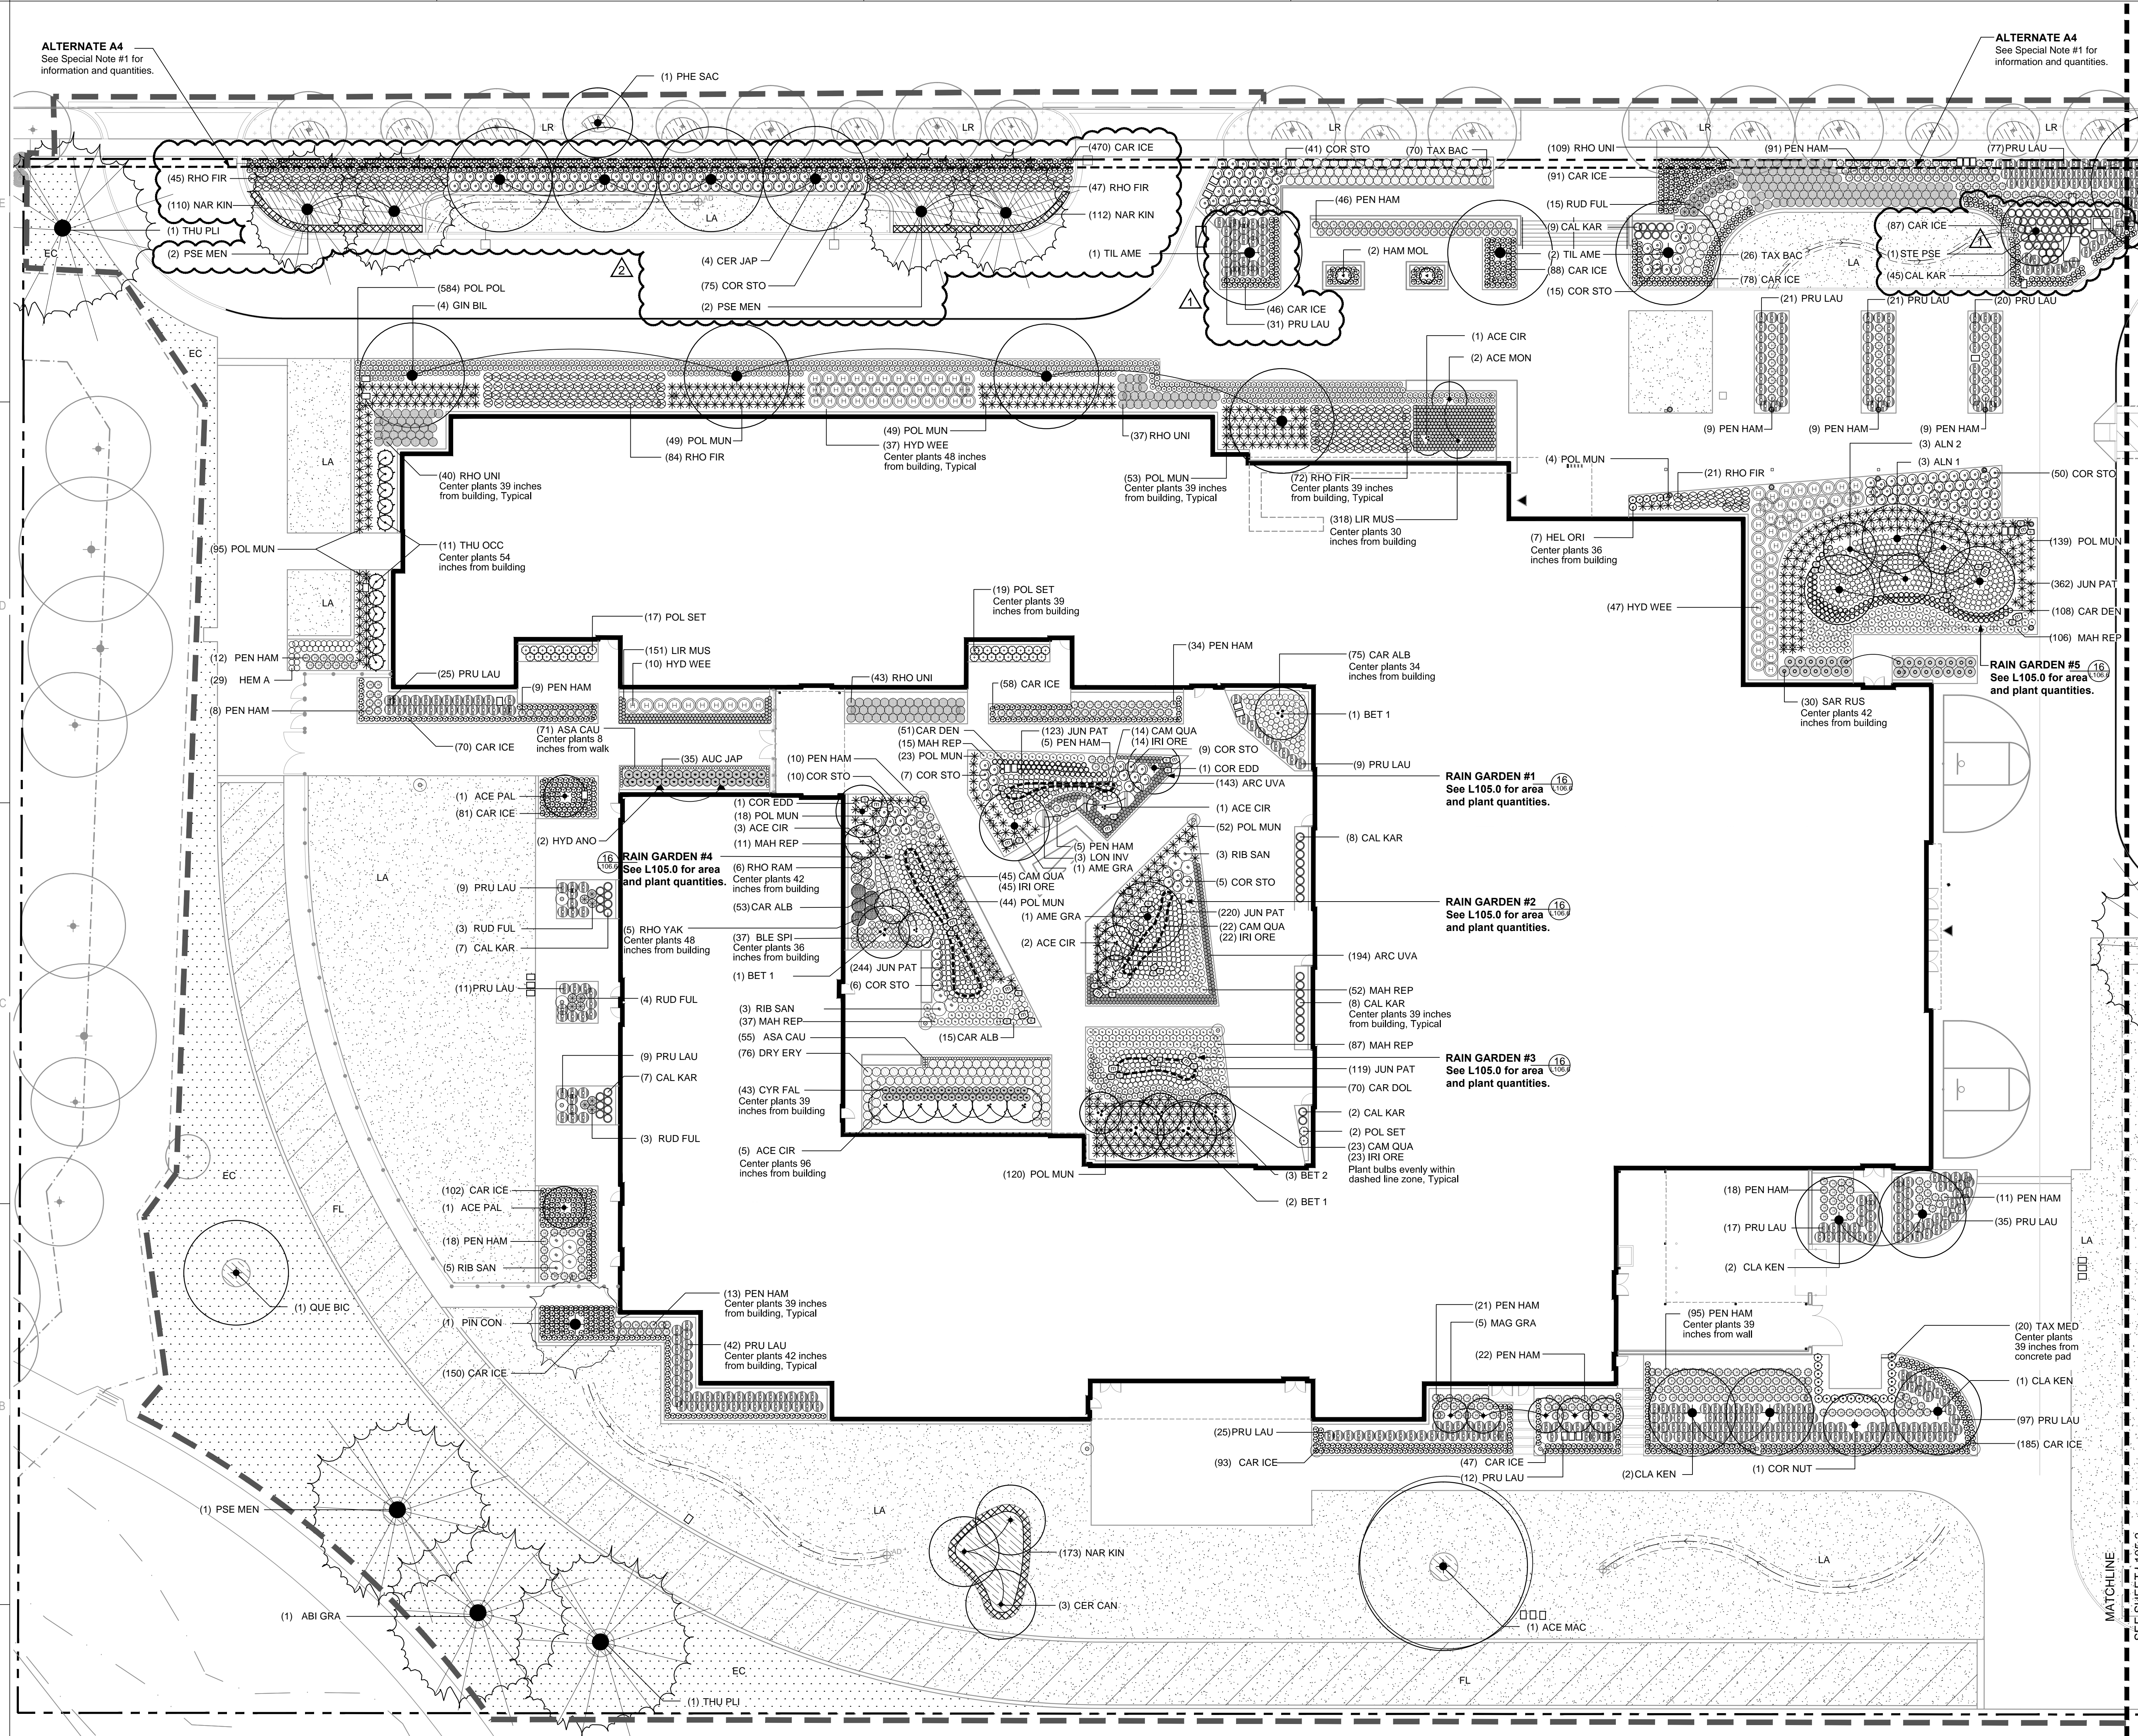

LEGEND:

- PROPERTY LINE
- LIMIT OF WORK (Approximate)
- EXISTING TREES To Remain
- PROPOSED DECIDUOUS TREE See Tree List
- PROPOSED EVERGREEN TREE See Tree List
- LANDSCAPE PLANTINGS See Site Plan for much type
- GRASSY SWALE BASIN & FLOW LINE See Civil
- BULB PLANTING See Plant List for spacing
- LAWN AREA
- REINFORCED LAWN AT FIRE LANE
- LAWN REPAIR
- ECO-LAWN
- MULCH ONLY AREA
- BASALT ACCENT STONE "S" - Small, "M" - Medium, See Specifications
- IRRIGATION VALVE BOX See Irrigation Plan
- SITE LIGHTING See Electrical, Lighting Plan and Layout Plan

SPECIAL NOTE

PLANT SPACING
Hold plantings back at plant bed edges, buildings, walls, and at plant beds in parking lot where car doors swing. Allow 6" unplanted space plus 1/2 the on center spacing from edge of paving to plant center at plant bed edges. At all other locations (buildings, walls, and plant beds in parking lots where car doors will swing) allow 24" unplanted space plus 1/2 the on center spacing from face of building, wall or curb to center of plants along those edges.

SPECIAL NOTE



ALTERNATE A4
Sidewalk expansion will reduce landscaped areas at locations shown on plan. Plant quantities will be reduced by 1 row for all species except for Carex species. Reduce Carex plantings by 2 rows. See drawings for additional notes on 'Alternate A4 Adjustment.' Overall plant quantities will be reduced as follows:

SITE SHRUBS:

- Cornus stolonifera 'Farrow' (COR STO) = -7
- Prunus laurocerasus 'Mt. Vernon' (PRU LAU) = -25
- Rhododendron 'Unique' (RHO UNI) = -12
- Taxus baccata 'Repadens' (TAX BAC) = -23

PERENNIALS / GRASSES / GROUNDCOVERS / BULBS / VINES

- Carex morrowii 'Ice Dance' (CAR MOR) = -665
- Pennisetum alopecuroides 'Hamelin' (PEN HAM) = -16

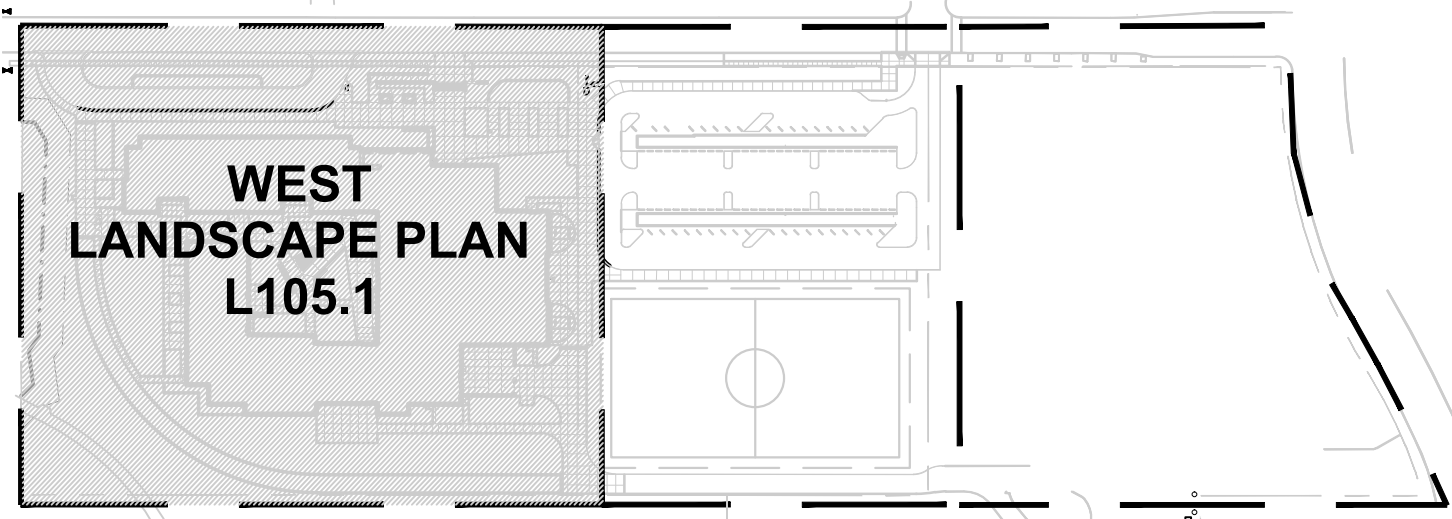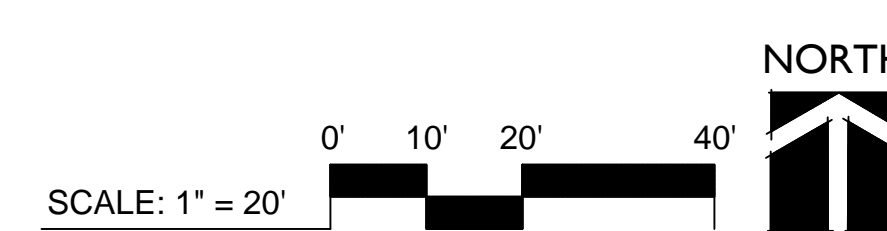

PLAN KEY

mahlum
ROBERTSON/SHERWOOD/ARCHITECTS PC
132 EAST BROADWAY, SUITE 540
EUGENE, OREGON 97401
541-342-6077
www.robertsonsherwood.com

MAHLUM ARCHITECTS INC
1231 NW HOYT, SUITE 102
PORTLAND, OREGON 97209
503-224-4032

71 COLUMBIA, FLOOR 4
SEATTLE, WASHINGTON 98104
206-441-4151
www.mahlum.com

CAMERON MCCARTHY
LANDSCAPE ARCHITECTURE & PLANNING
160 East Broadway • Eugene Oregon 97401
541.485.7385 f 541.485.7389
www.cameronmccarthy.com



EUGENE SCHOOL DISTRICT 4J


REPLACEMENT ROOSEVELT MIDDLE SCHOOL
680 EAST 24TH AVENUE
EUGENE, OREGON 97405

MARK	DATE	DESCRIPTION
1	3-06-2015	ADDENDUM 3
2	3-13-2015	ADDENDUM 6

ISSUE DATE: FEBRUARY 18, 2015
ISSUE: CONSTRUCTION DOCUMENTS
VOLUME: PACKAGE 1
PROJECT NO: 2013912.00
DRAWN BY: NLR / KMK
CHECKED BY: LKG
ORIGINAL SHEET SIZE: 35"x42"

WEST LANDSCAPE PLAN

L-105.1

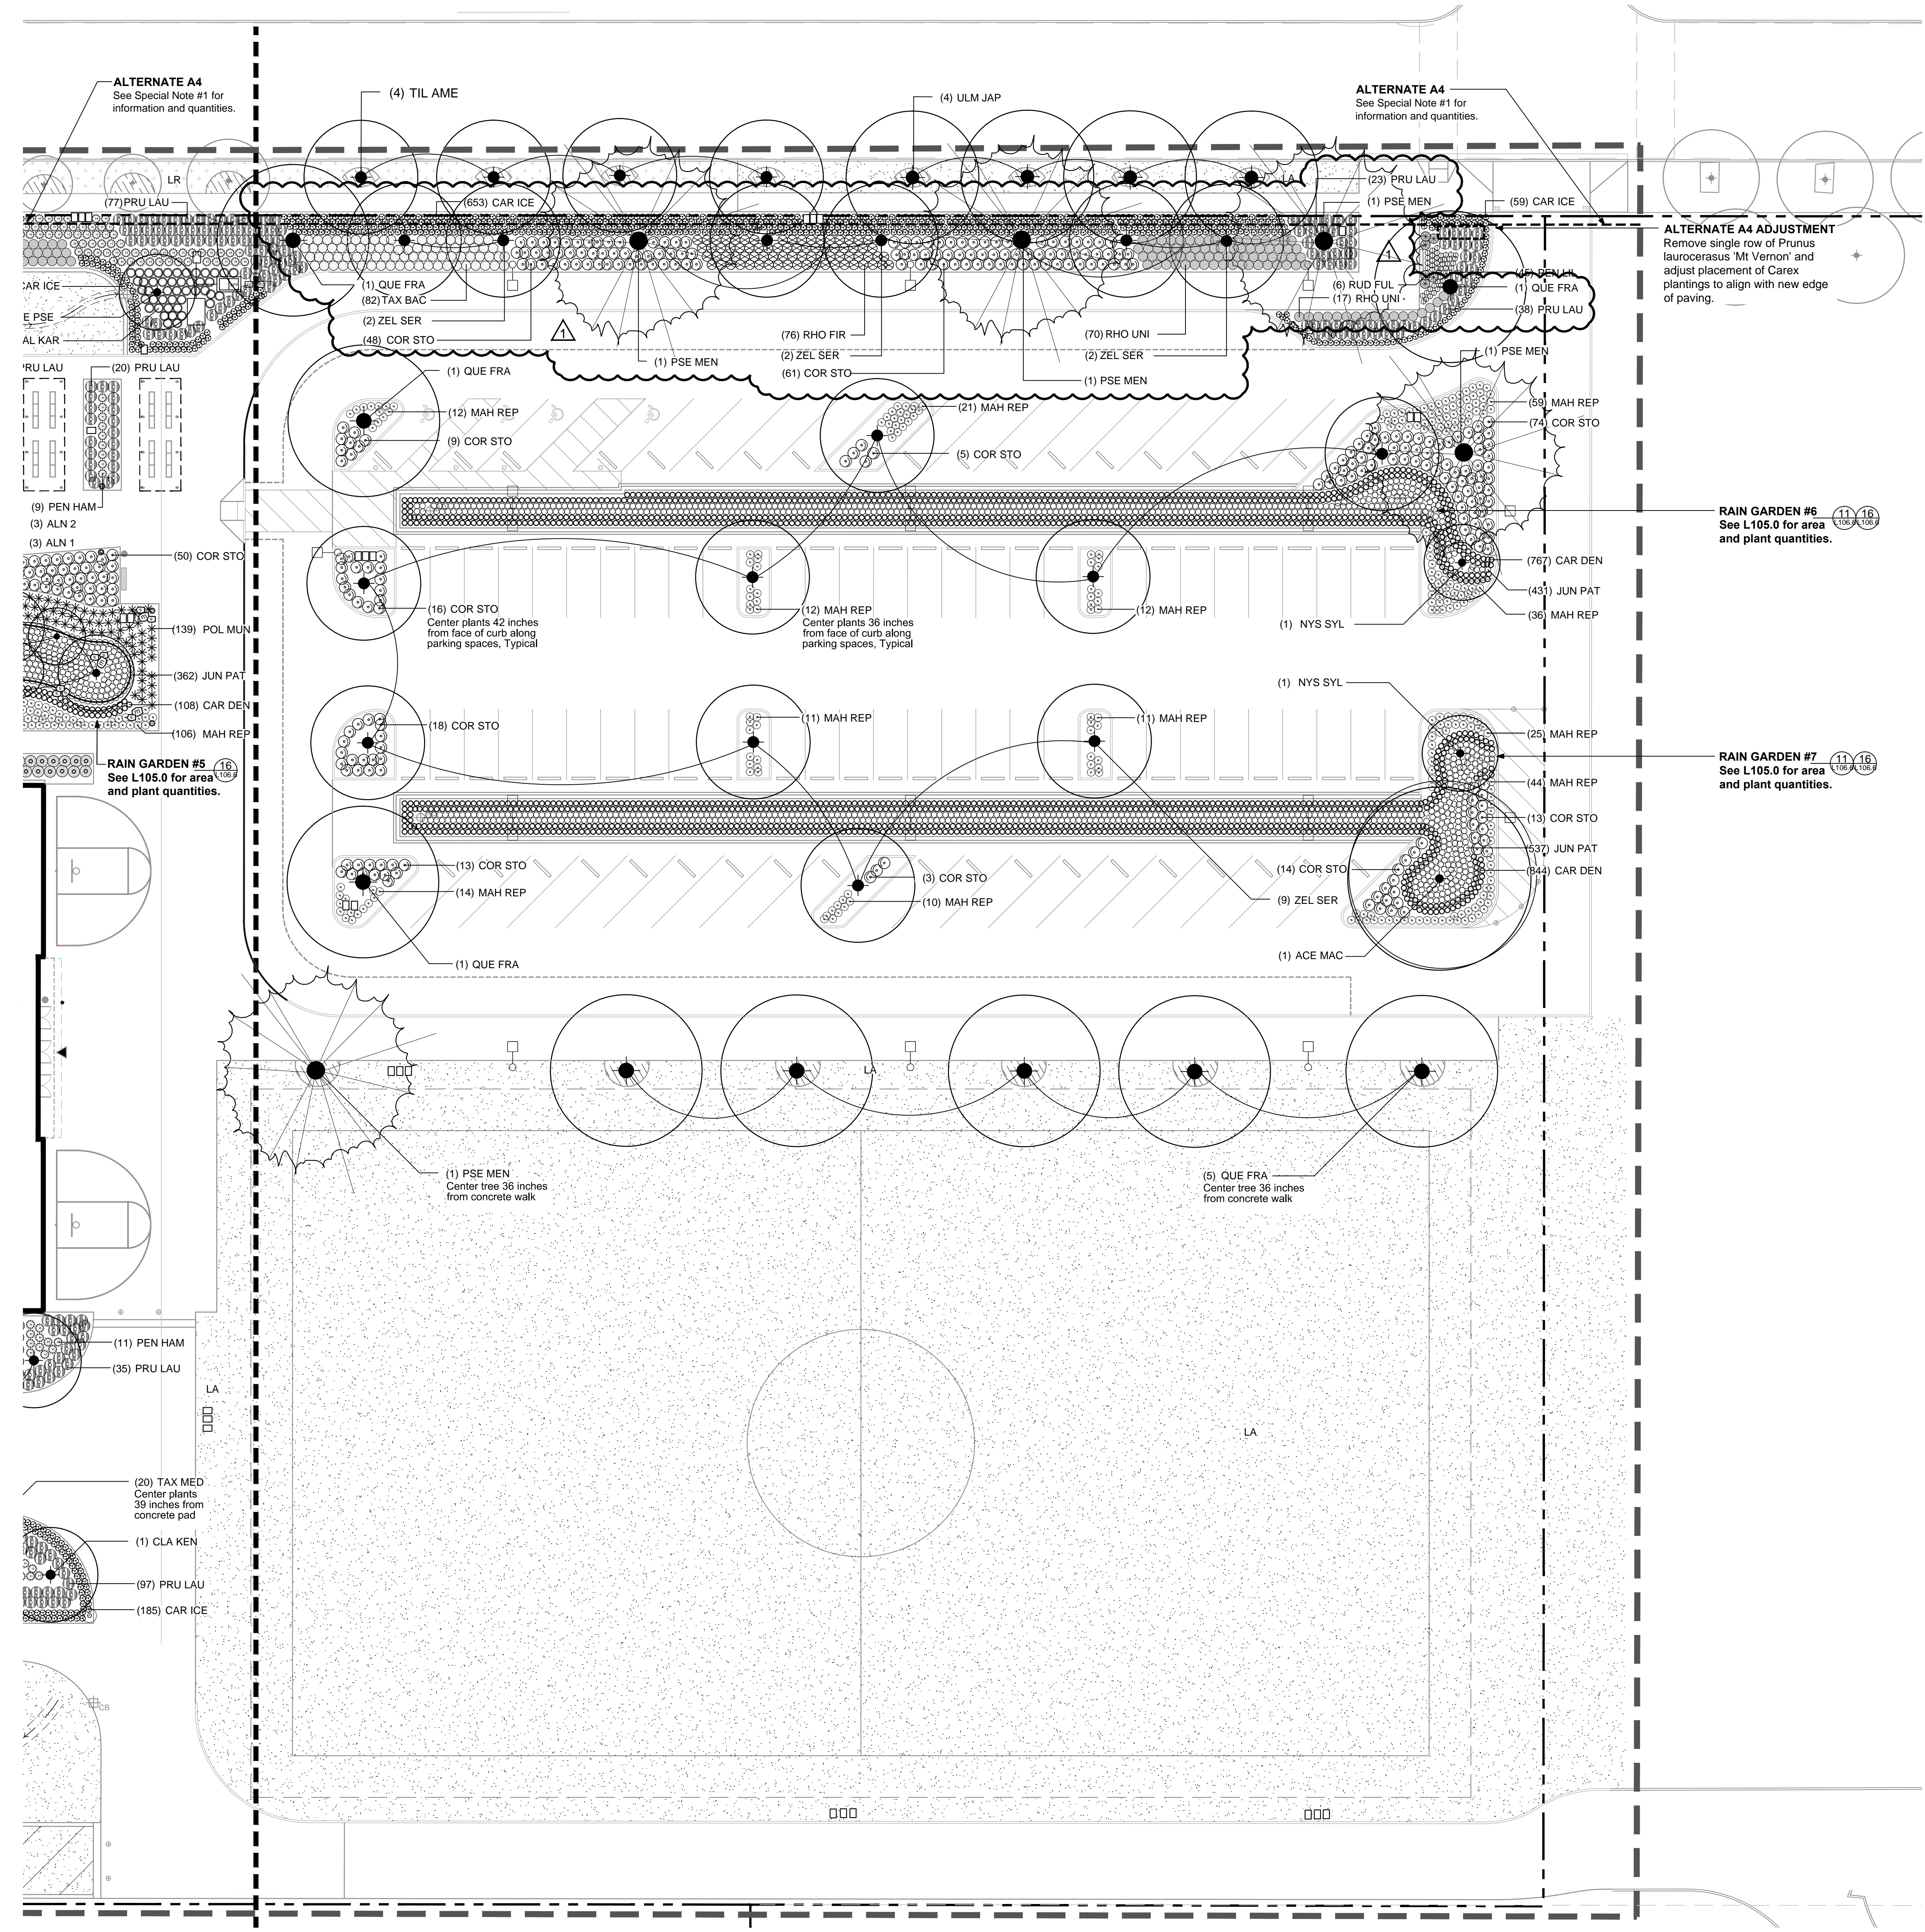

LEGEND:

---	PROPERTY LINE
---	LIMIT OF WORK (Approximate)
⊕	EXISTING TREES To Remain
⊕	PROPOSED DECIDUOUS TREE See Tree List
⊕	PROPOSED EVERGREEN TREE See Tree List
⊕	LANDSCAPE PLANTINGS See Site Plan for mulch type
→	GRASSY SWALE BASIN & FLOW LINE See Civil
⊕	BULB PLANTING See Plant List for spacing
LA	LAWN AREA
FL	REINFORCED LAWN AT FIRE LANE (11, 12) (106, 109)
LR	LAWN REPAIR
EC	ECO-LAWN
⊕	MULCH ONLY AREA
⊕	BASALT ACCENT STONE "S" - Small, "M" - Medium, See Specifications
□	IRRIGATION VALVE BOX See Irrigation Plan
⊕	SITE LIGHTING See Electrical, Lighting Plan and Layout Plan

SPECIAL NOTE

PLANT SPACING
Hold plantings back at plant bed edges, buildings, walls, and at plant beds in parking lot where car doors swing. Allow 6" unplanted space plus 1/2 the on center spacing from edge of paving to plant center at plant bed edges. At all other locations (buildings, walls, and plant beds in parking lots where car doors will swing) allow 24" unplanted space plus 1/2 the on center spacing from face of building, wall or curb to center of plants along those edges.

SPECIAL NOTE



ALTERNATE A4
Sidewalk expansion will reduce landscaped areas at locations shown on plan. Plant quantities will be reduced by 1 row for all species except for Carex species. Reduce Carex plantings by 2 rows. See drawings for additional notes on 'Alternate A4 Adjustment.' Overall plant quantities will be reduced as follows:

SITE SHRUBS:


- Cornus stolonifera 'Farrow' (COR STO) = -7
- Prunus laurocerasus 'Mt. Vernon' (PRU LAU) = -25
- Rhododendron 'Unique' (RHO UNI) = -12
- Taxus baccata 'Repadens' (TAX BAC) = -23

PERENNIALS / GRASSES / GROUNDCOVERS / BULBS / VINES

- Carex morrowii 'Ice Dance' (CAR MOR) = -665
- Pennisetum alopecuroides 'Hameln' (PEN HAM) = -16

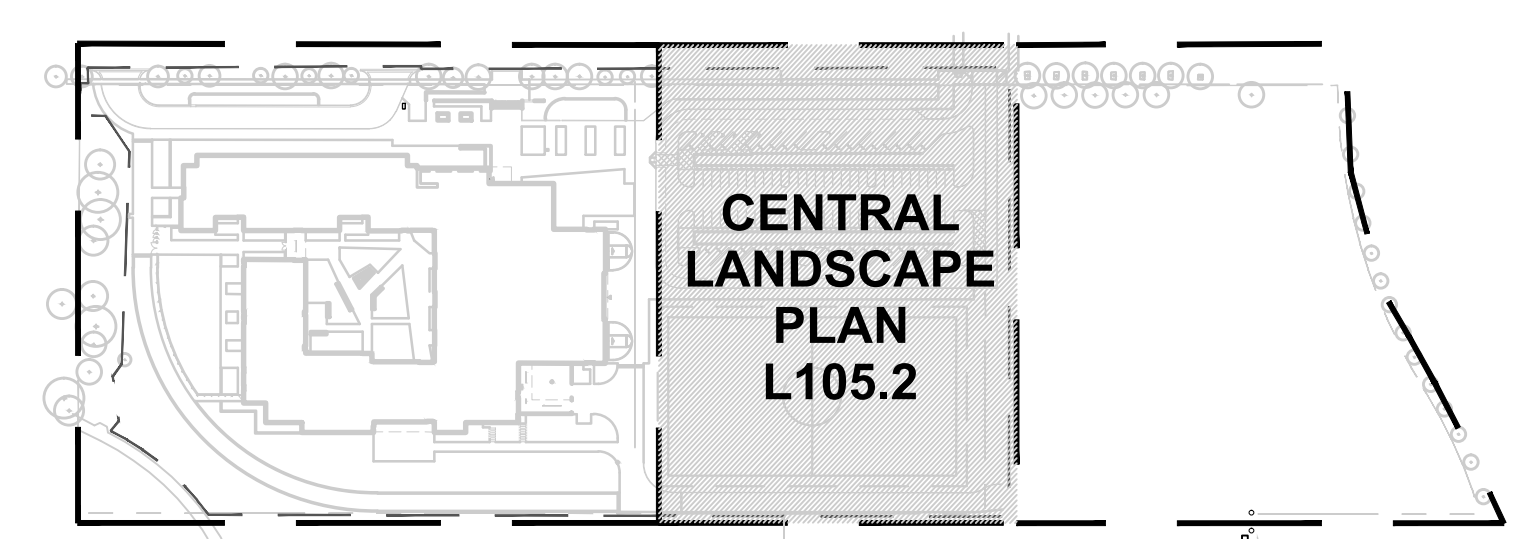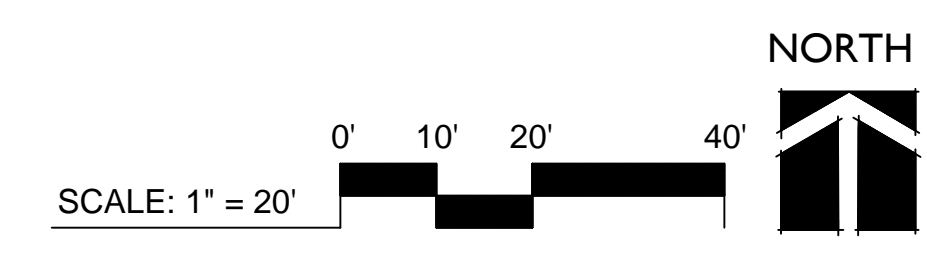


PLAN KEY

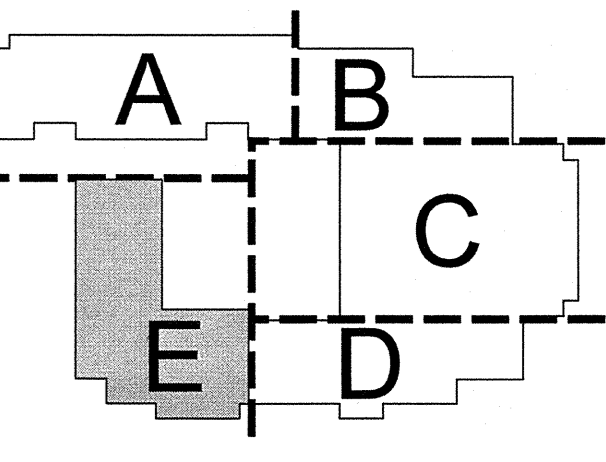

MARK	DATE	DESCRIPTION
3	3-13-2015	ADDENDUM 6
2	3-6-2015	ADDENDUM 3
1	2-18-2015	SUPPLEMENTAL INFO 1


ISSUE DATE: FEBRUARY 18, 2015
ISSUE: CONSTRUCTION DOCUMENTS
VOLUME: PACKAGE 1
PROJECT NO: 213417
DRAWN BY: MF
CHECKED BY: MT
COPYRIGHT MAHLUM ARCHITECTS, INC. 2014 ORIGINAL SHEET SIZE: 30"X42"

FIRST FLOOR PLAN - ZONE E

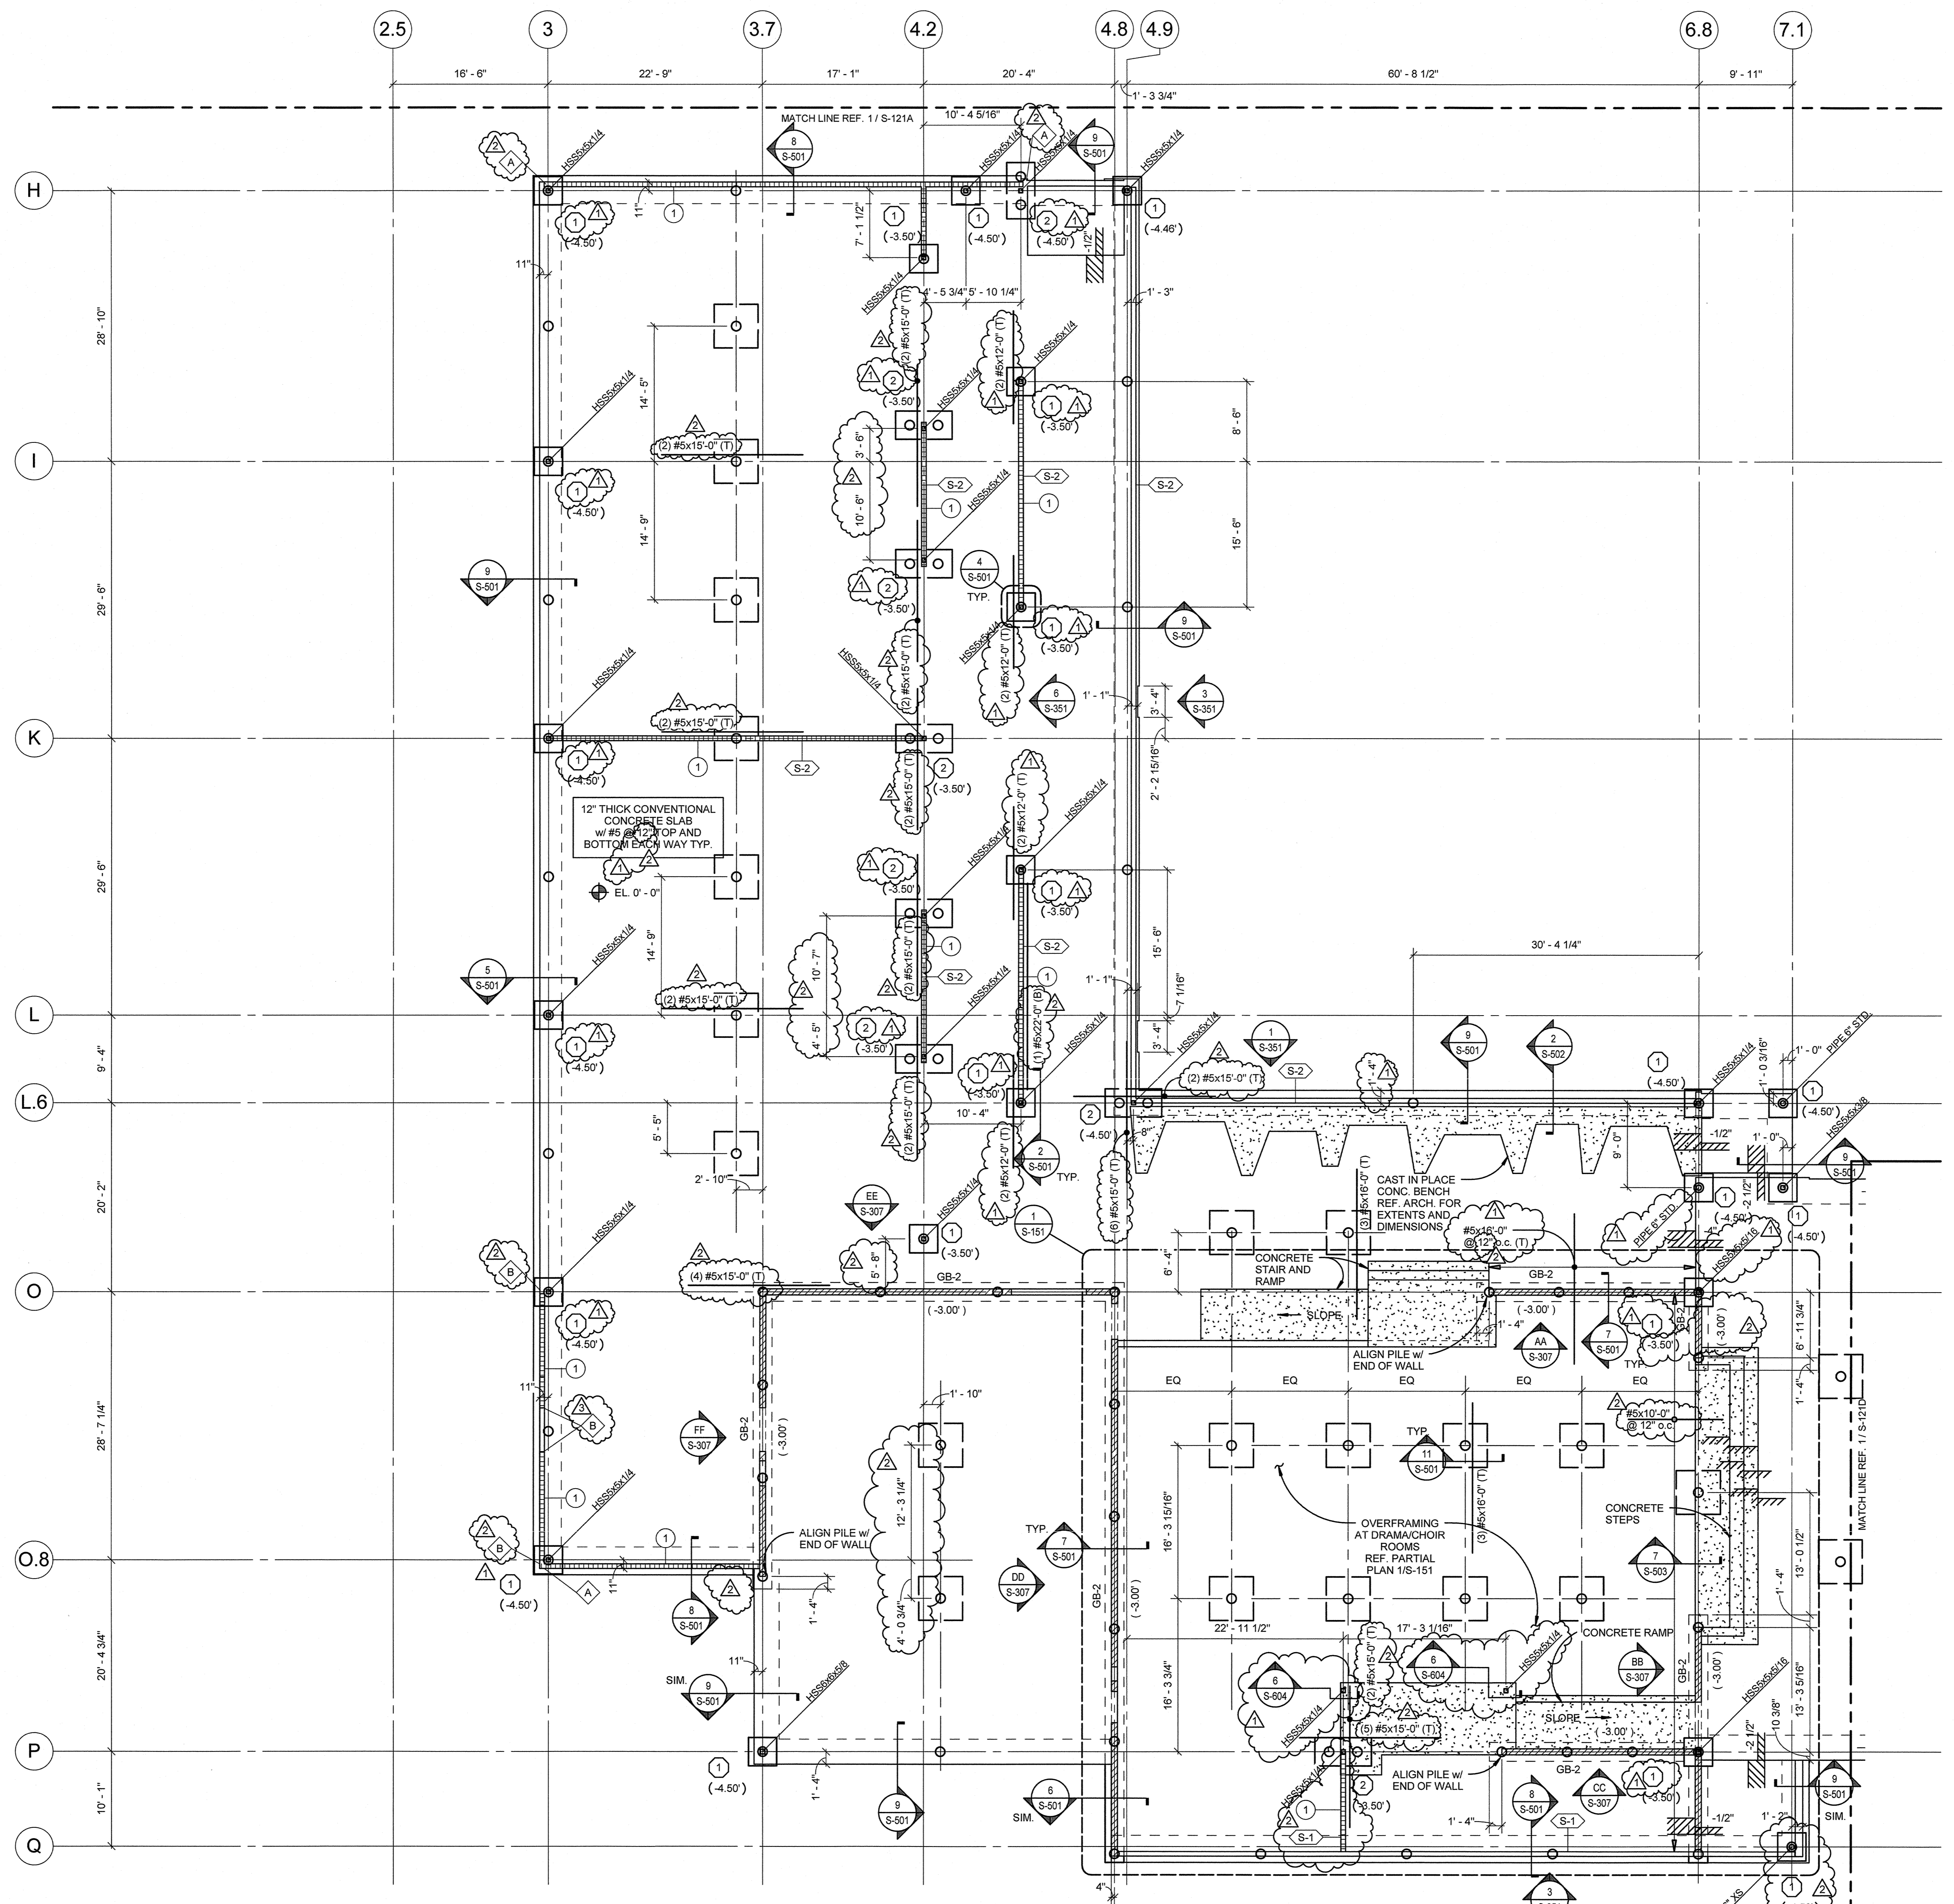


1 FIRST FLOOR PLAN - ZONE E
1/8" = 1'-0"

PLAN NOTES:
REF. SHEET S-120 FOR TYPICAL PLAN NOTES.

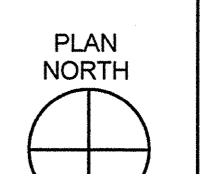

3/1/2015 5:58:07 PM C:\Users\msherman\Documents\213417\213417-213417-213417-213417-213417.dwg

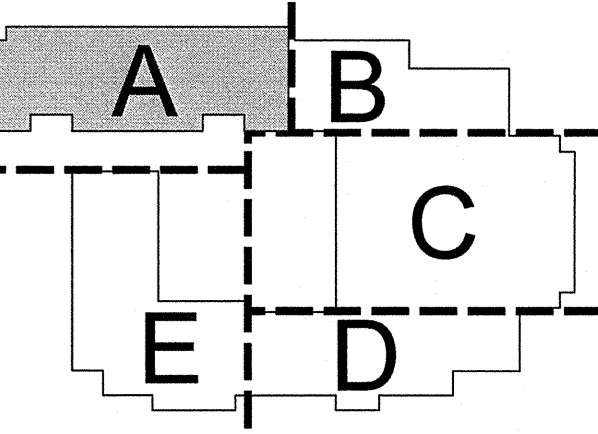

PLAN NOTES:
REF. SHEET S-120 FOR TYPICAL PLAN NOTES.

1 EQUIPMENT PLATFORM PLAN - ZONE A
1/8" = 1'-0"

MARK	DATE	DESCRIPTION
3	3-13-2015	ADDENDUM 6
2	3-6-2015	ADDENDUM 3
1	2-18-2015	SUPPLEMENTAL INFO 1

ISSUE DATE: FEBRUARY 18, 2015

ISSUE: CONSTRUCTION DOCUMENTS

VOLUME: PACKAGE 1



PROJECT NO: 213417



DRAWN BY: MF

CHECKED BY: MT

COPYRIGHT MAHLUM ARCHITECTS, INC. 2014 ORIGINAL SHEET SIZE: 30"x42"

EQUIPMENT PLATFORM PLAN - ZONE A

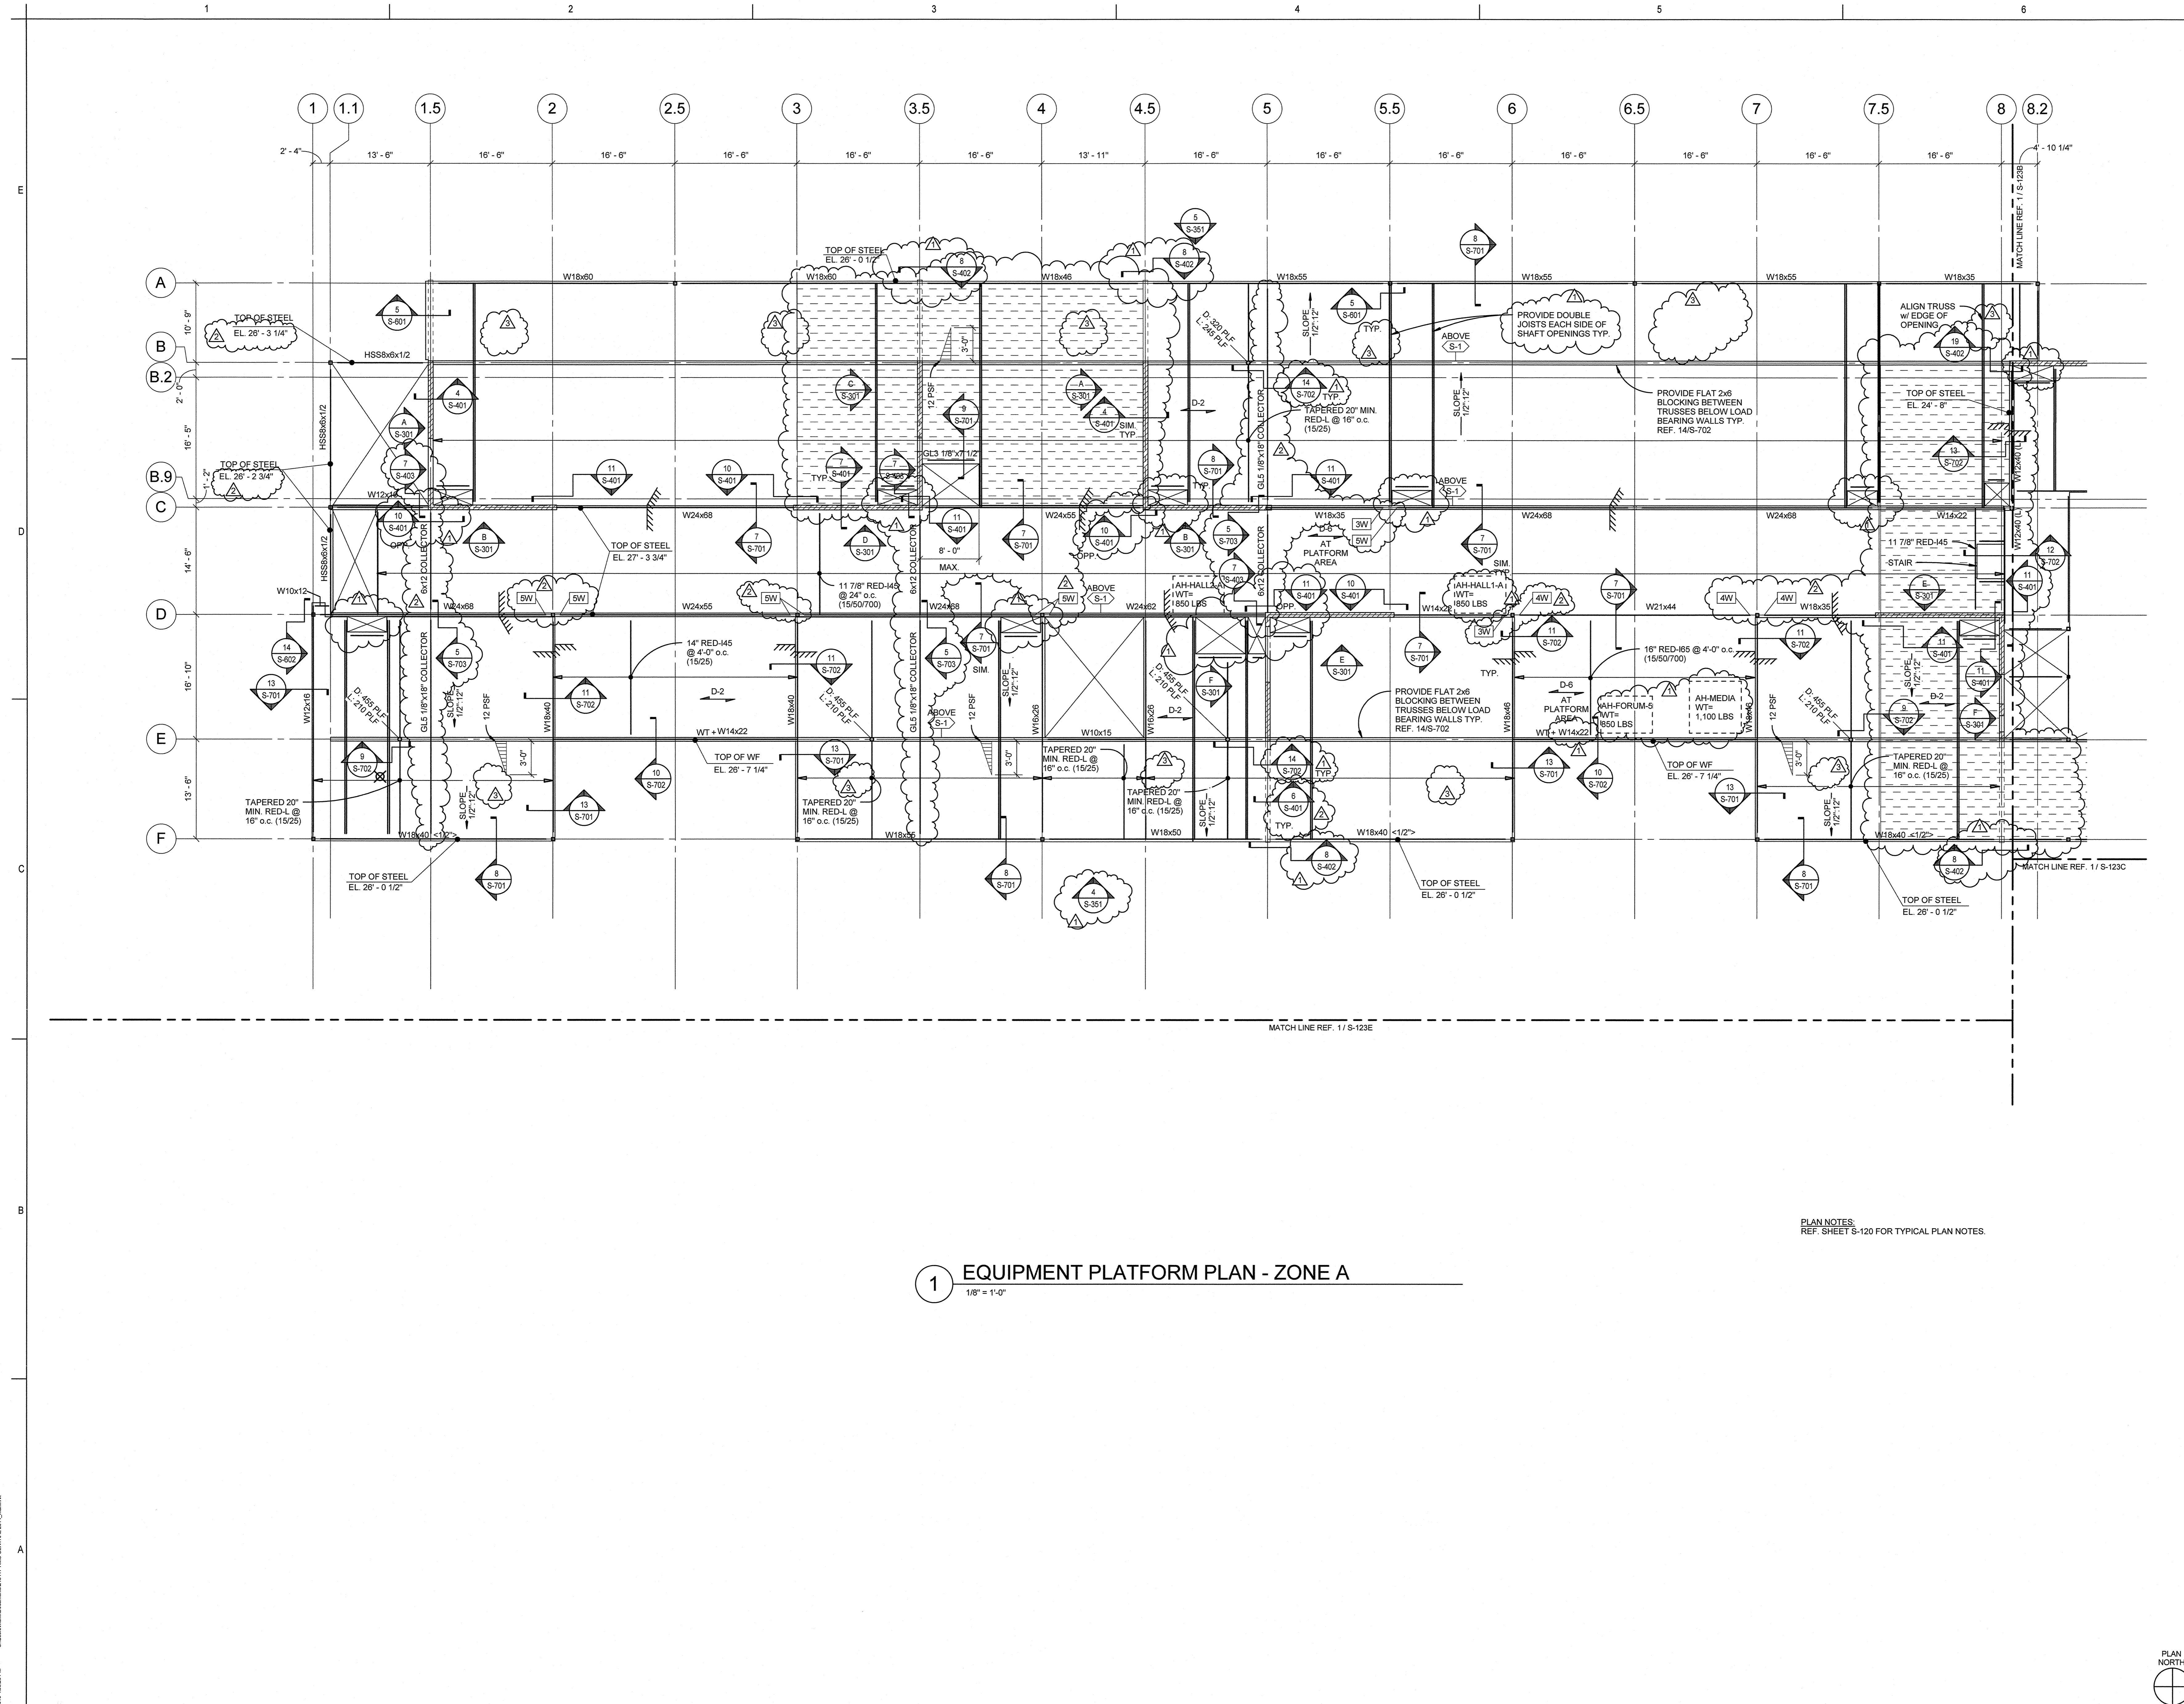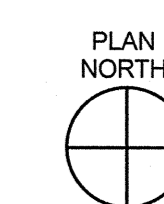

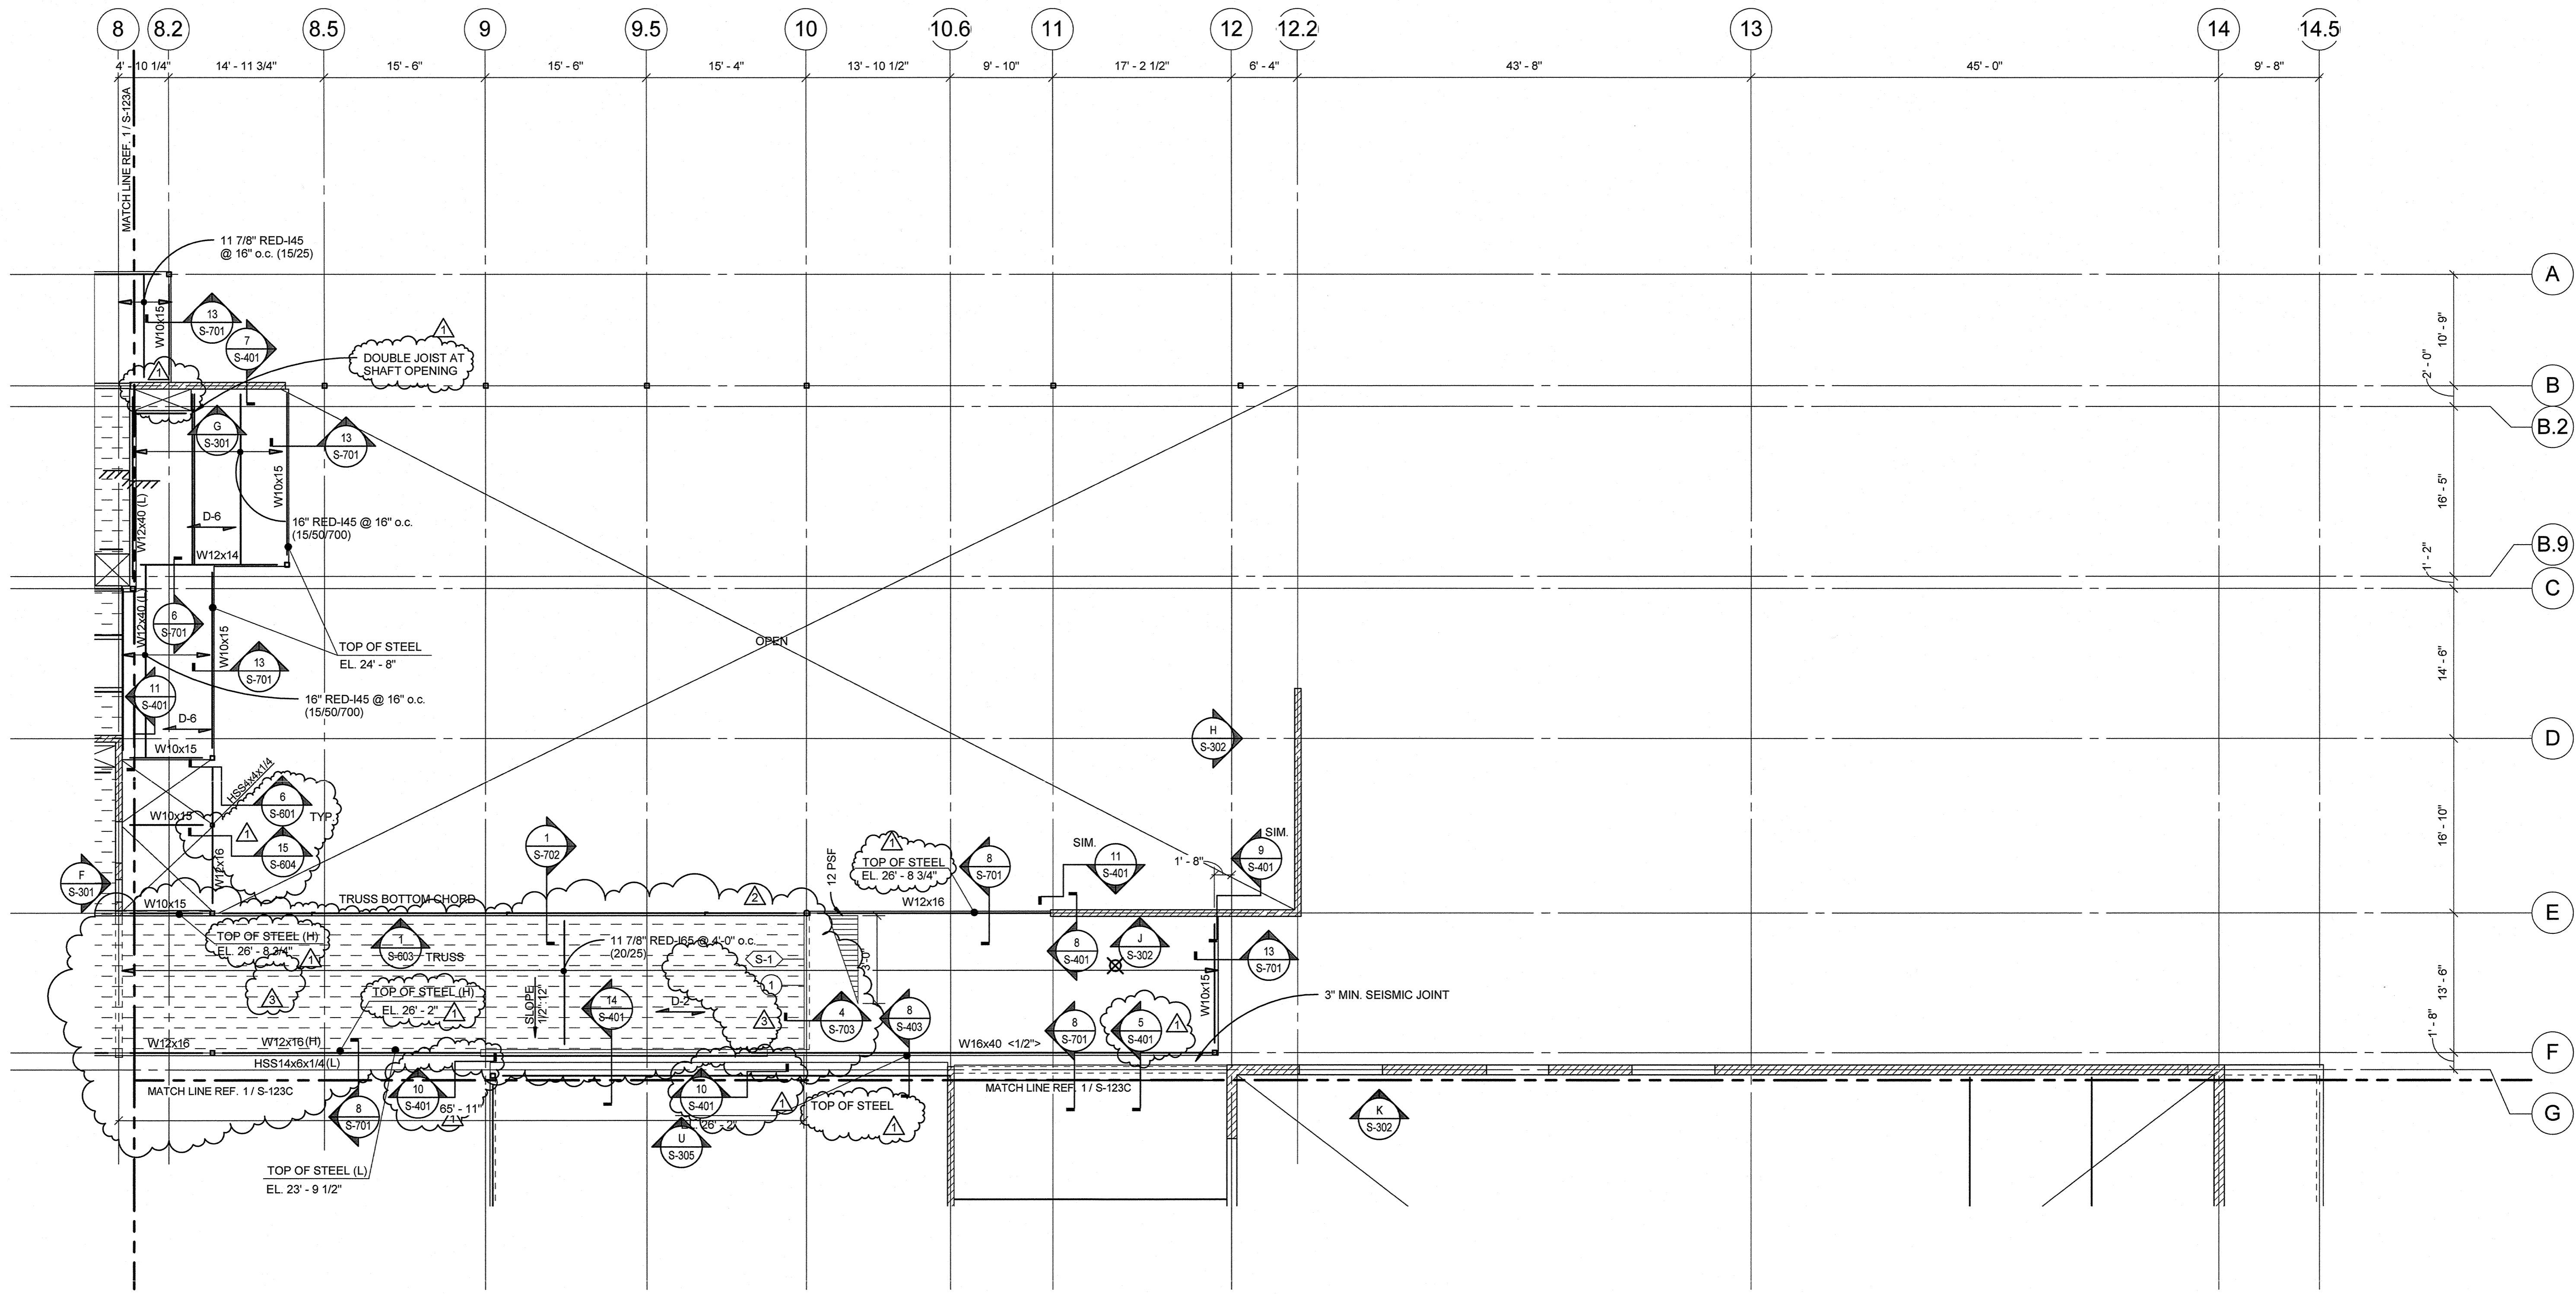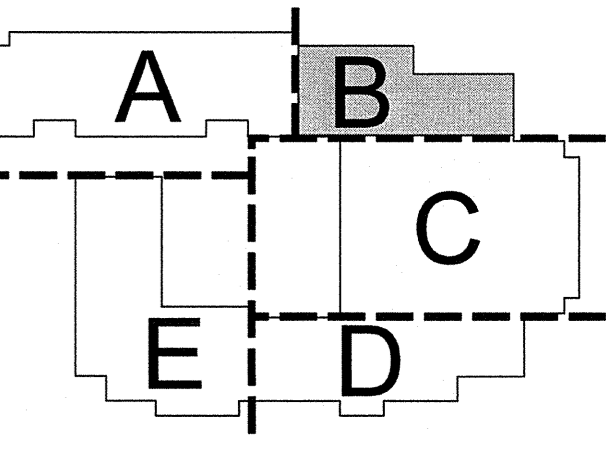


PLAN NOTES:
REF. SHEET S-120 FOR TYPICAL PLAN NOTES.

MARK	DATE	DESCRIPTION
3	3-13-2015	ADDENDUM 6
2	3-6-2015	ADDENDUM 3
1	2-18-2015	SUPPLEMENTAL INFO 1

ISSUE DATE: FEBRUARY 18, 2015
ISSUE: CONSTRUCTION DOCUMENTS
VOLUME: PACKAGE 1
PROJECT NO.: 213417
DRAWN BY: MF
CHECKED BY: MT
COPYRIGHT MAHLUM ARCHITECTS, INC. 2014 ORIGINAL SHEET SIZE: 30x42


EQUIPMENT PLATFORM PLAN - ZONE B

1 EQUIPMENT PLATFORM PLAN - ZONE B
1/8" = 1'-0"

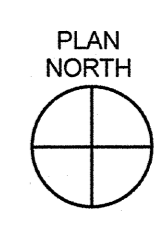

S-123B

3/12/2015 4:58:31 PM C:\Users\msherman\Documents\213417\213417-0001\213417-0001.dwg

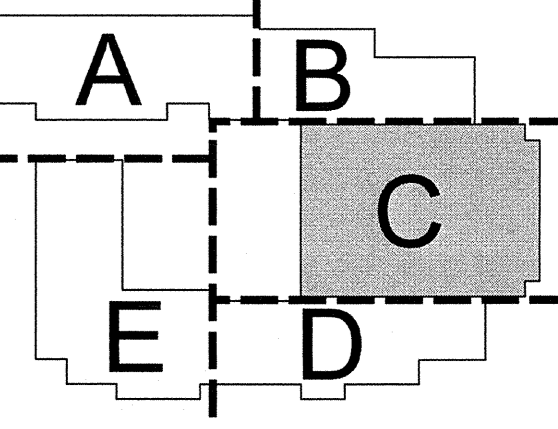

MARK	DATE	DESCRIPTION
3	3-13-2015	ADDENDUM 6
2	3-6-2015	ADDENDUM 3
1	2-18-2015	SUPPLEMENTAL INFO 1

ISSUE DATE: FEBRUARY 18, 2015

ISSUE: CONSTRUCTION DOCUMENTS

VOLUME: PACKAGE 1


PROJECT NO.: 213417

DRAWN BY: MF

CHECKED BY: MT

COPYRIGHT MAHLUM ARCHITECTS, INC. 2014 ORIGINAL SHEET SIZE: 30"X42"


MID-ROOF ATTIC PLAN - ZONE C

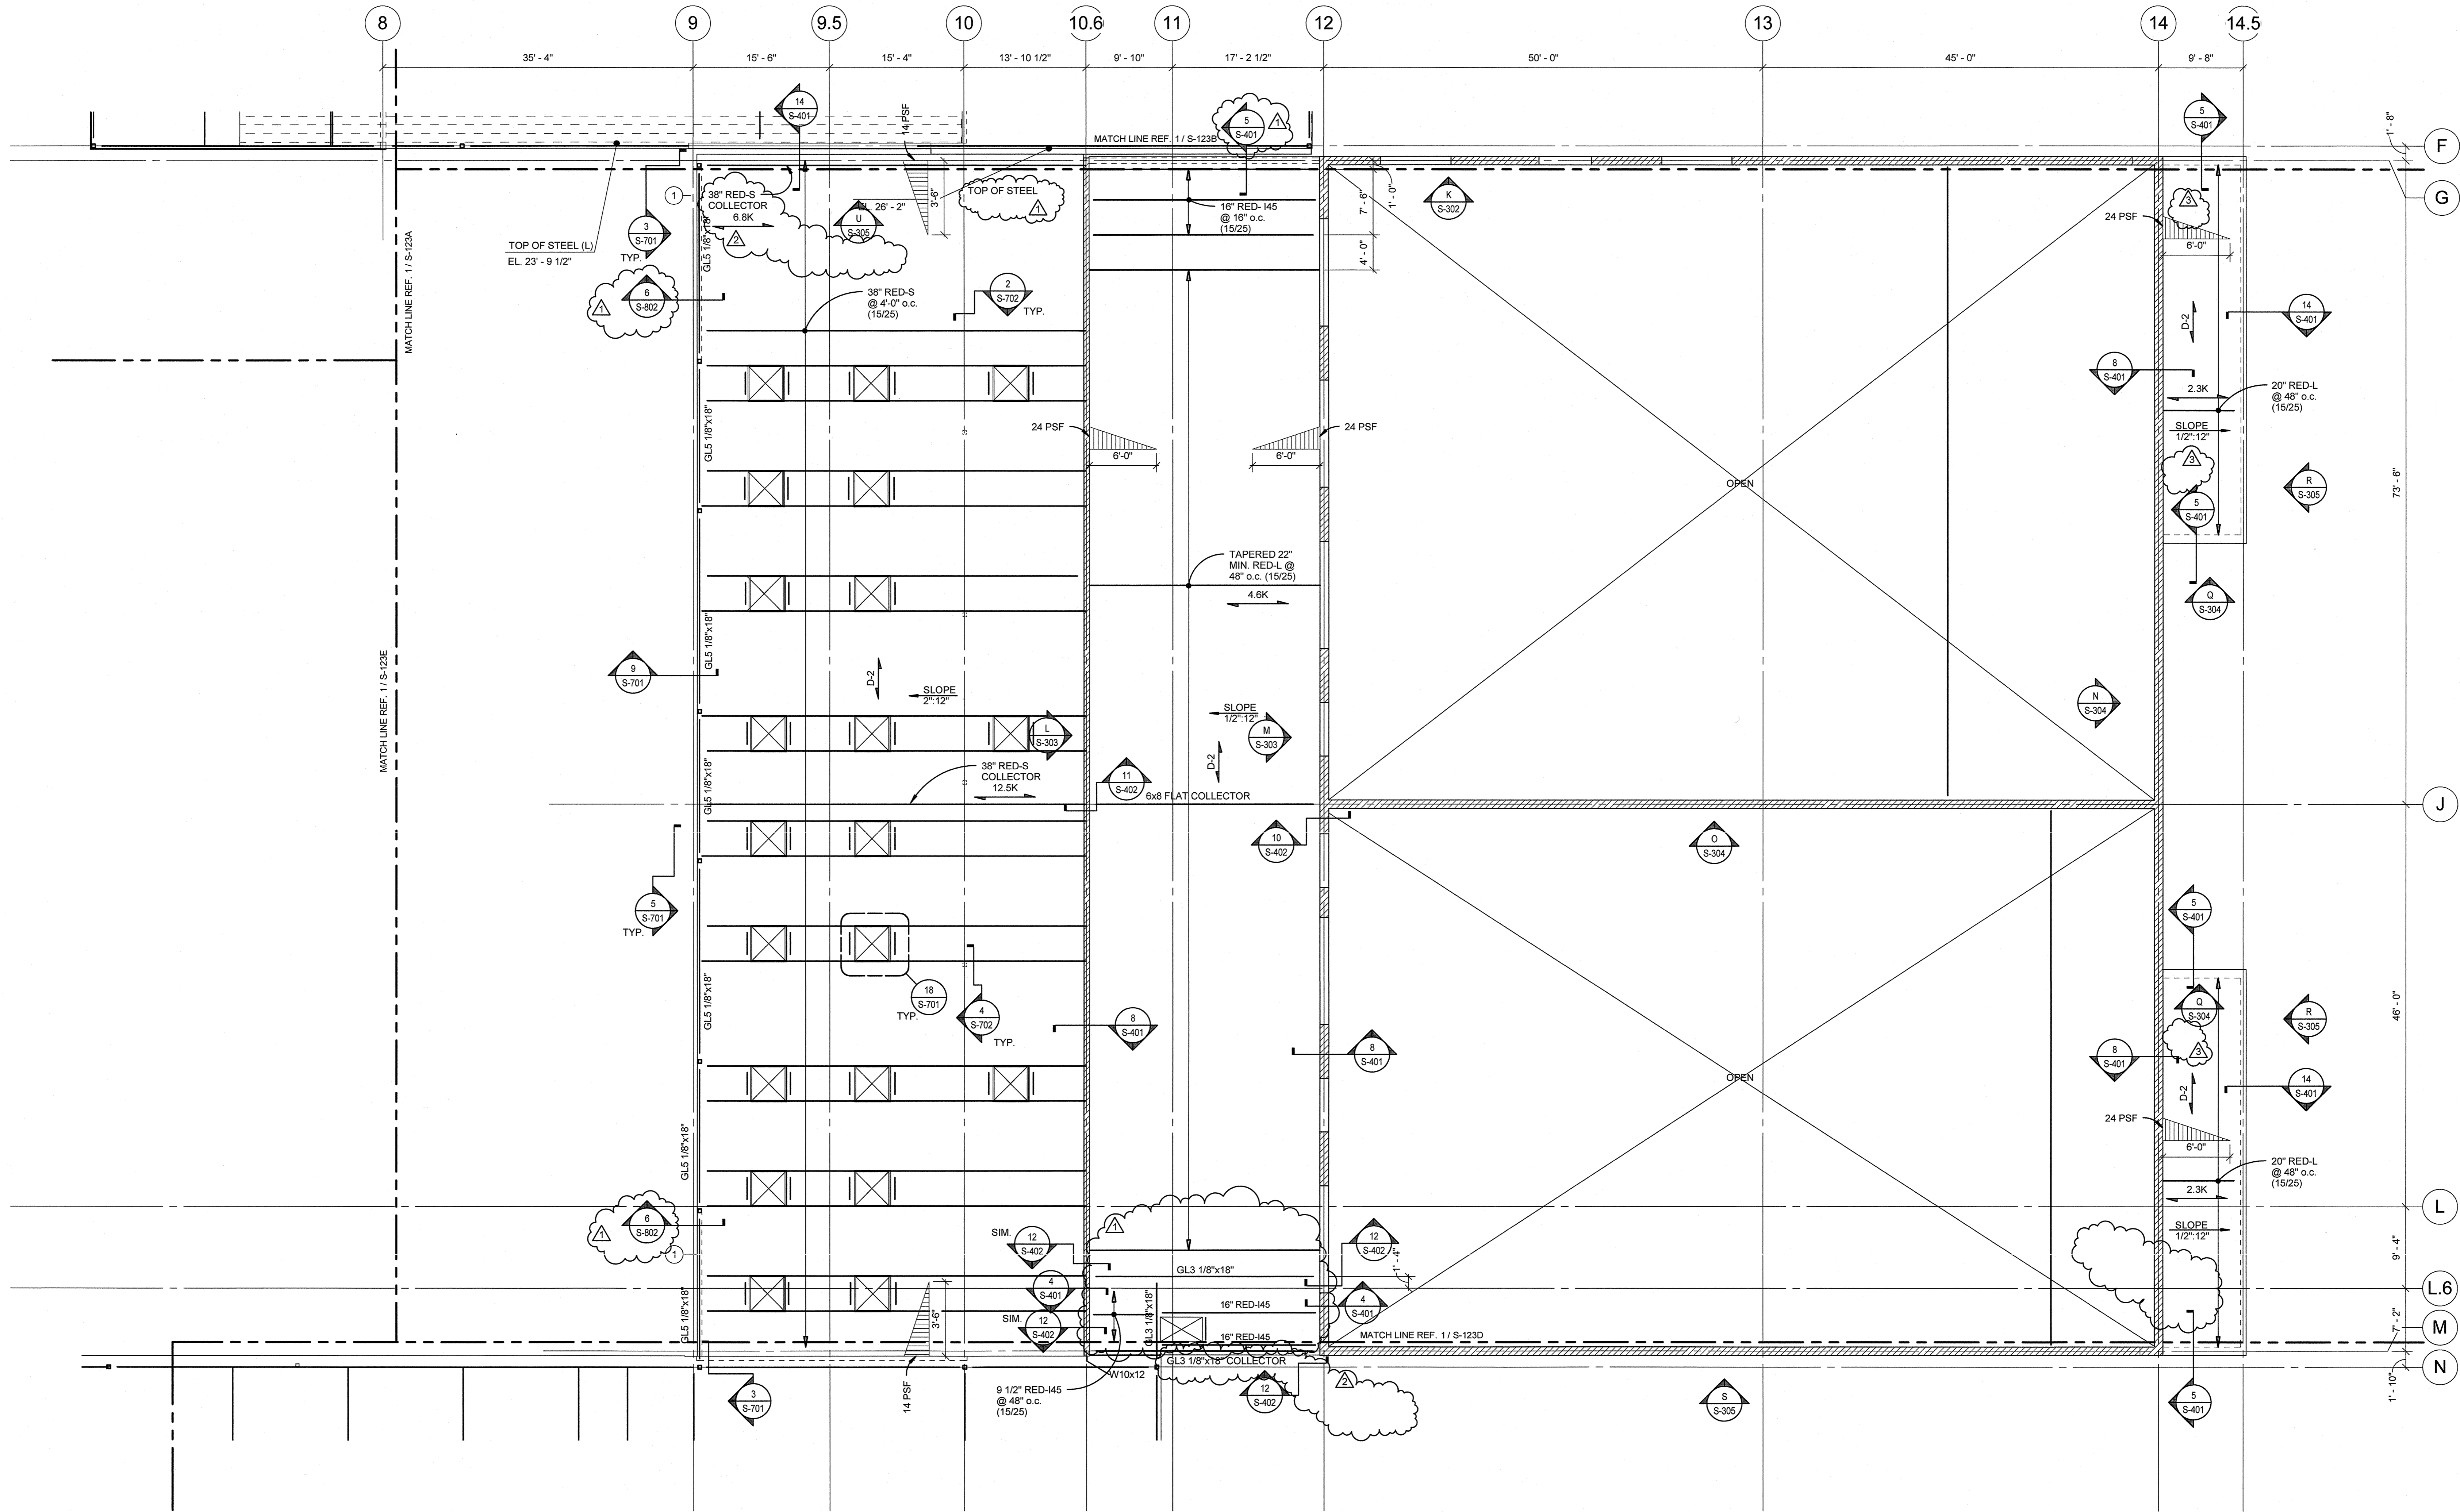

1 MID-ROOF PLAN - ZONE C
1/8" = 1'-0"

PLAN NOTES:
REF. SHEET S-120 FOR TYPICAL PLAN NOTES.




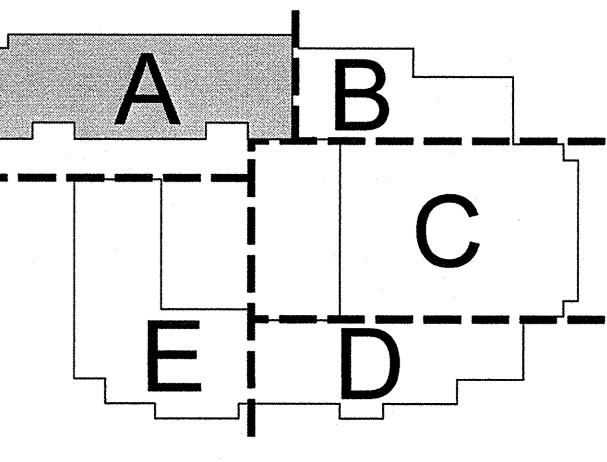

MARK	DATE	DESCRIPTION
3	3-13-2015	ADDENDUM 6
2	3-6-2015	ADDENDUM 3
1	2-18-2015	SUPPLEMENTAL INFO 1

ISSUE DATE: FEBRUARY 18, 2015
ISSUE: CONSTRUCTION DOCUMENTS
VOLUME: PACKAGE 1
PROJECT NO.: 213417
DRAWN BY: MF
CHECKED BY: MT
COPYRIGHT MAHLUM ARCHITECTS, INC. 2014 ORIGINAL SHEET SIZE: 30"x42"

HIGH ROOF PLAN - ZONE A

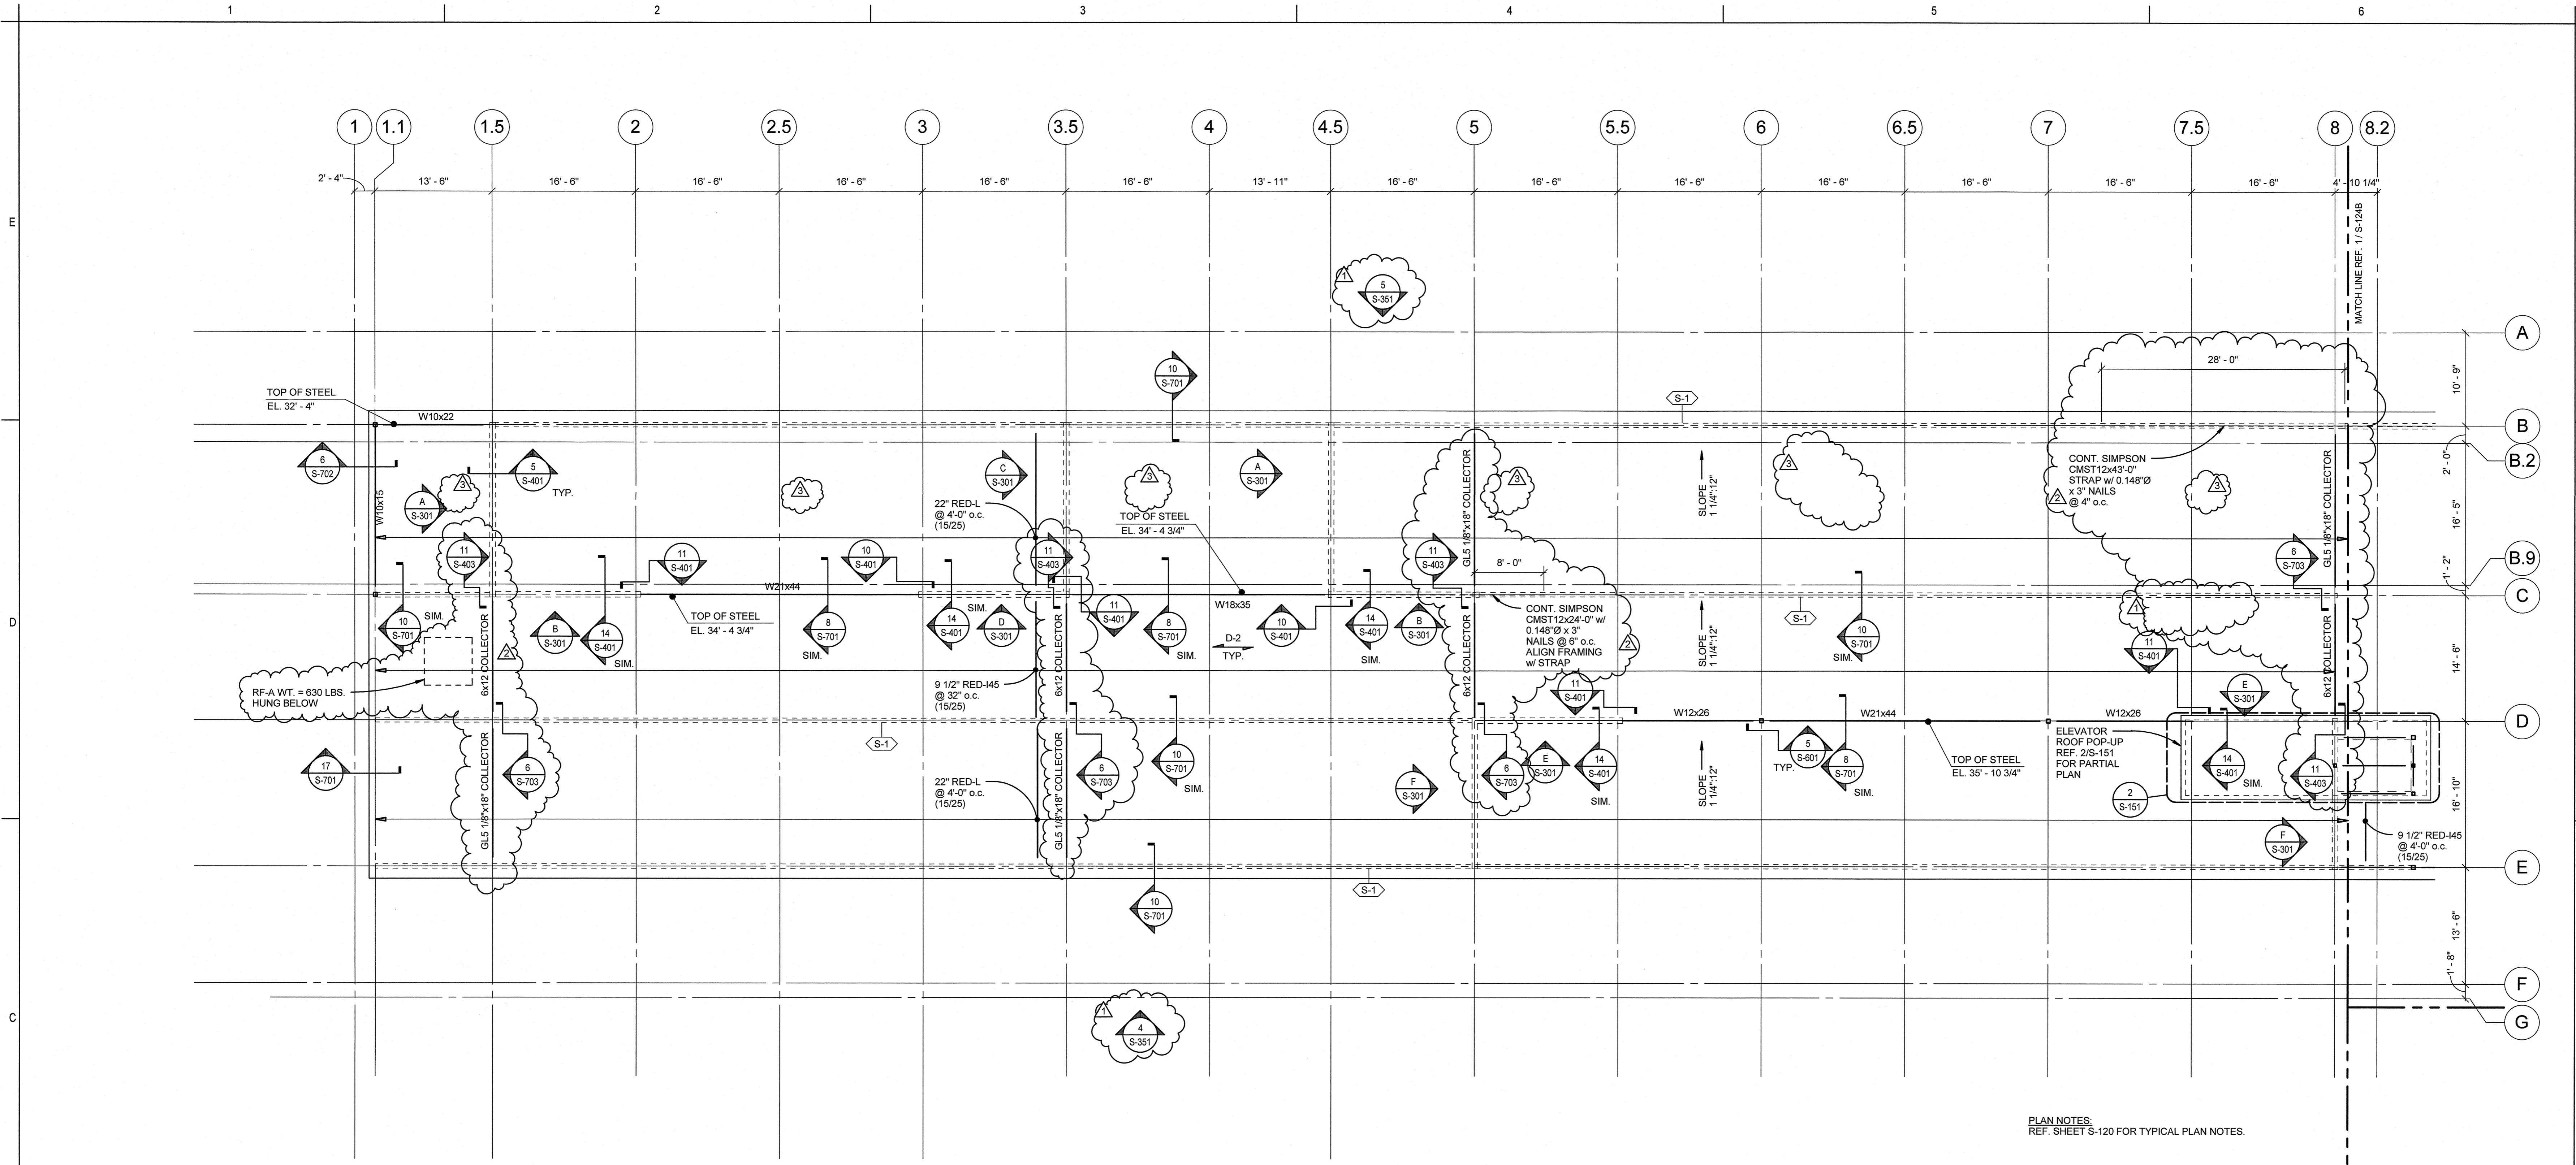

PLAN NOTES:
REF. SHEET S-120 FOR TYPICAL PLAN NOTES.


1 HIGH ROOF PLAN - ZONE A
1/8" = 1'-0"




3/1/2015 4:43:39 PM C:\mahlum\Documents\213417\213417-02\213417-02.dwg



EUGENE SCHOOL DISTRICT 4J

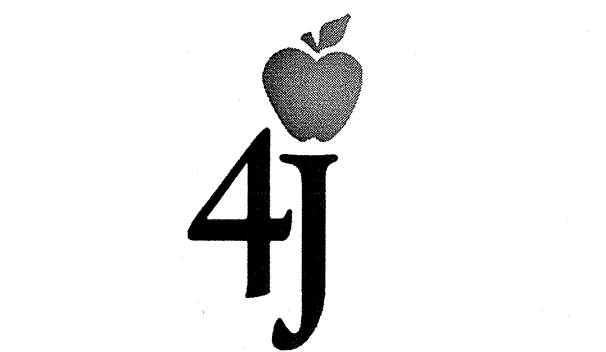


REPLACEMENT ROOSEVELT MIDDLE SCHOOL
CIP NUMBER 410.566.001
680 EAST 24TH AVENUE
EUGENE, OREGON 97405
CIP NO. 410.566.001

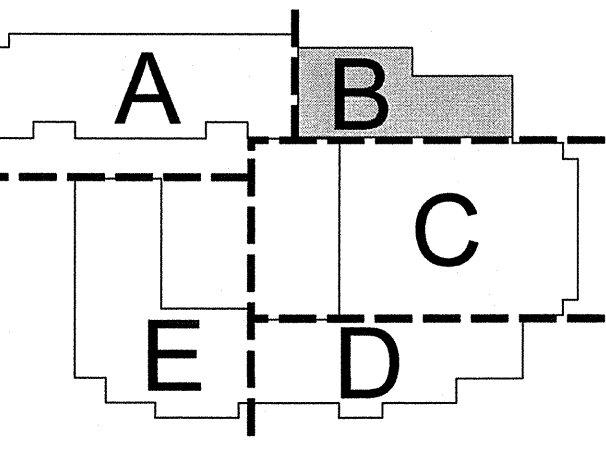

MARK	DATE	DESCRIPTION
3	3-13-2015	ADDENDUM 6
2	3-6-2015	ADDENDUM 3
1	2-18-2015	SUPPLEMENTAL INFO 1


ISSUE DATE: FEBRUARY 18, 2015
ISSUE: CONSTRUCTION DOCUMENTS
VOLUME: PACKAGE 1
PROJECT NO: 213417
DRAWN BY: MF
CHECKED BY: MT
COPYRIGHT MAHLUM ARCHITECTS INC. 2014 ORIGINAL SHEET SIZE: 30"x42"


HIGH ROOF PLAN - ZONE B

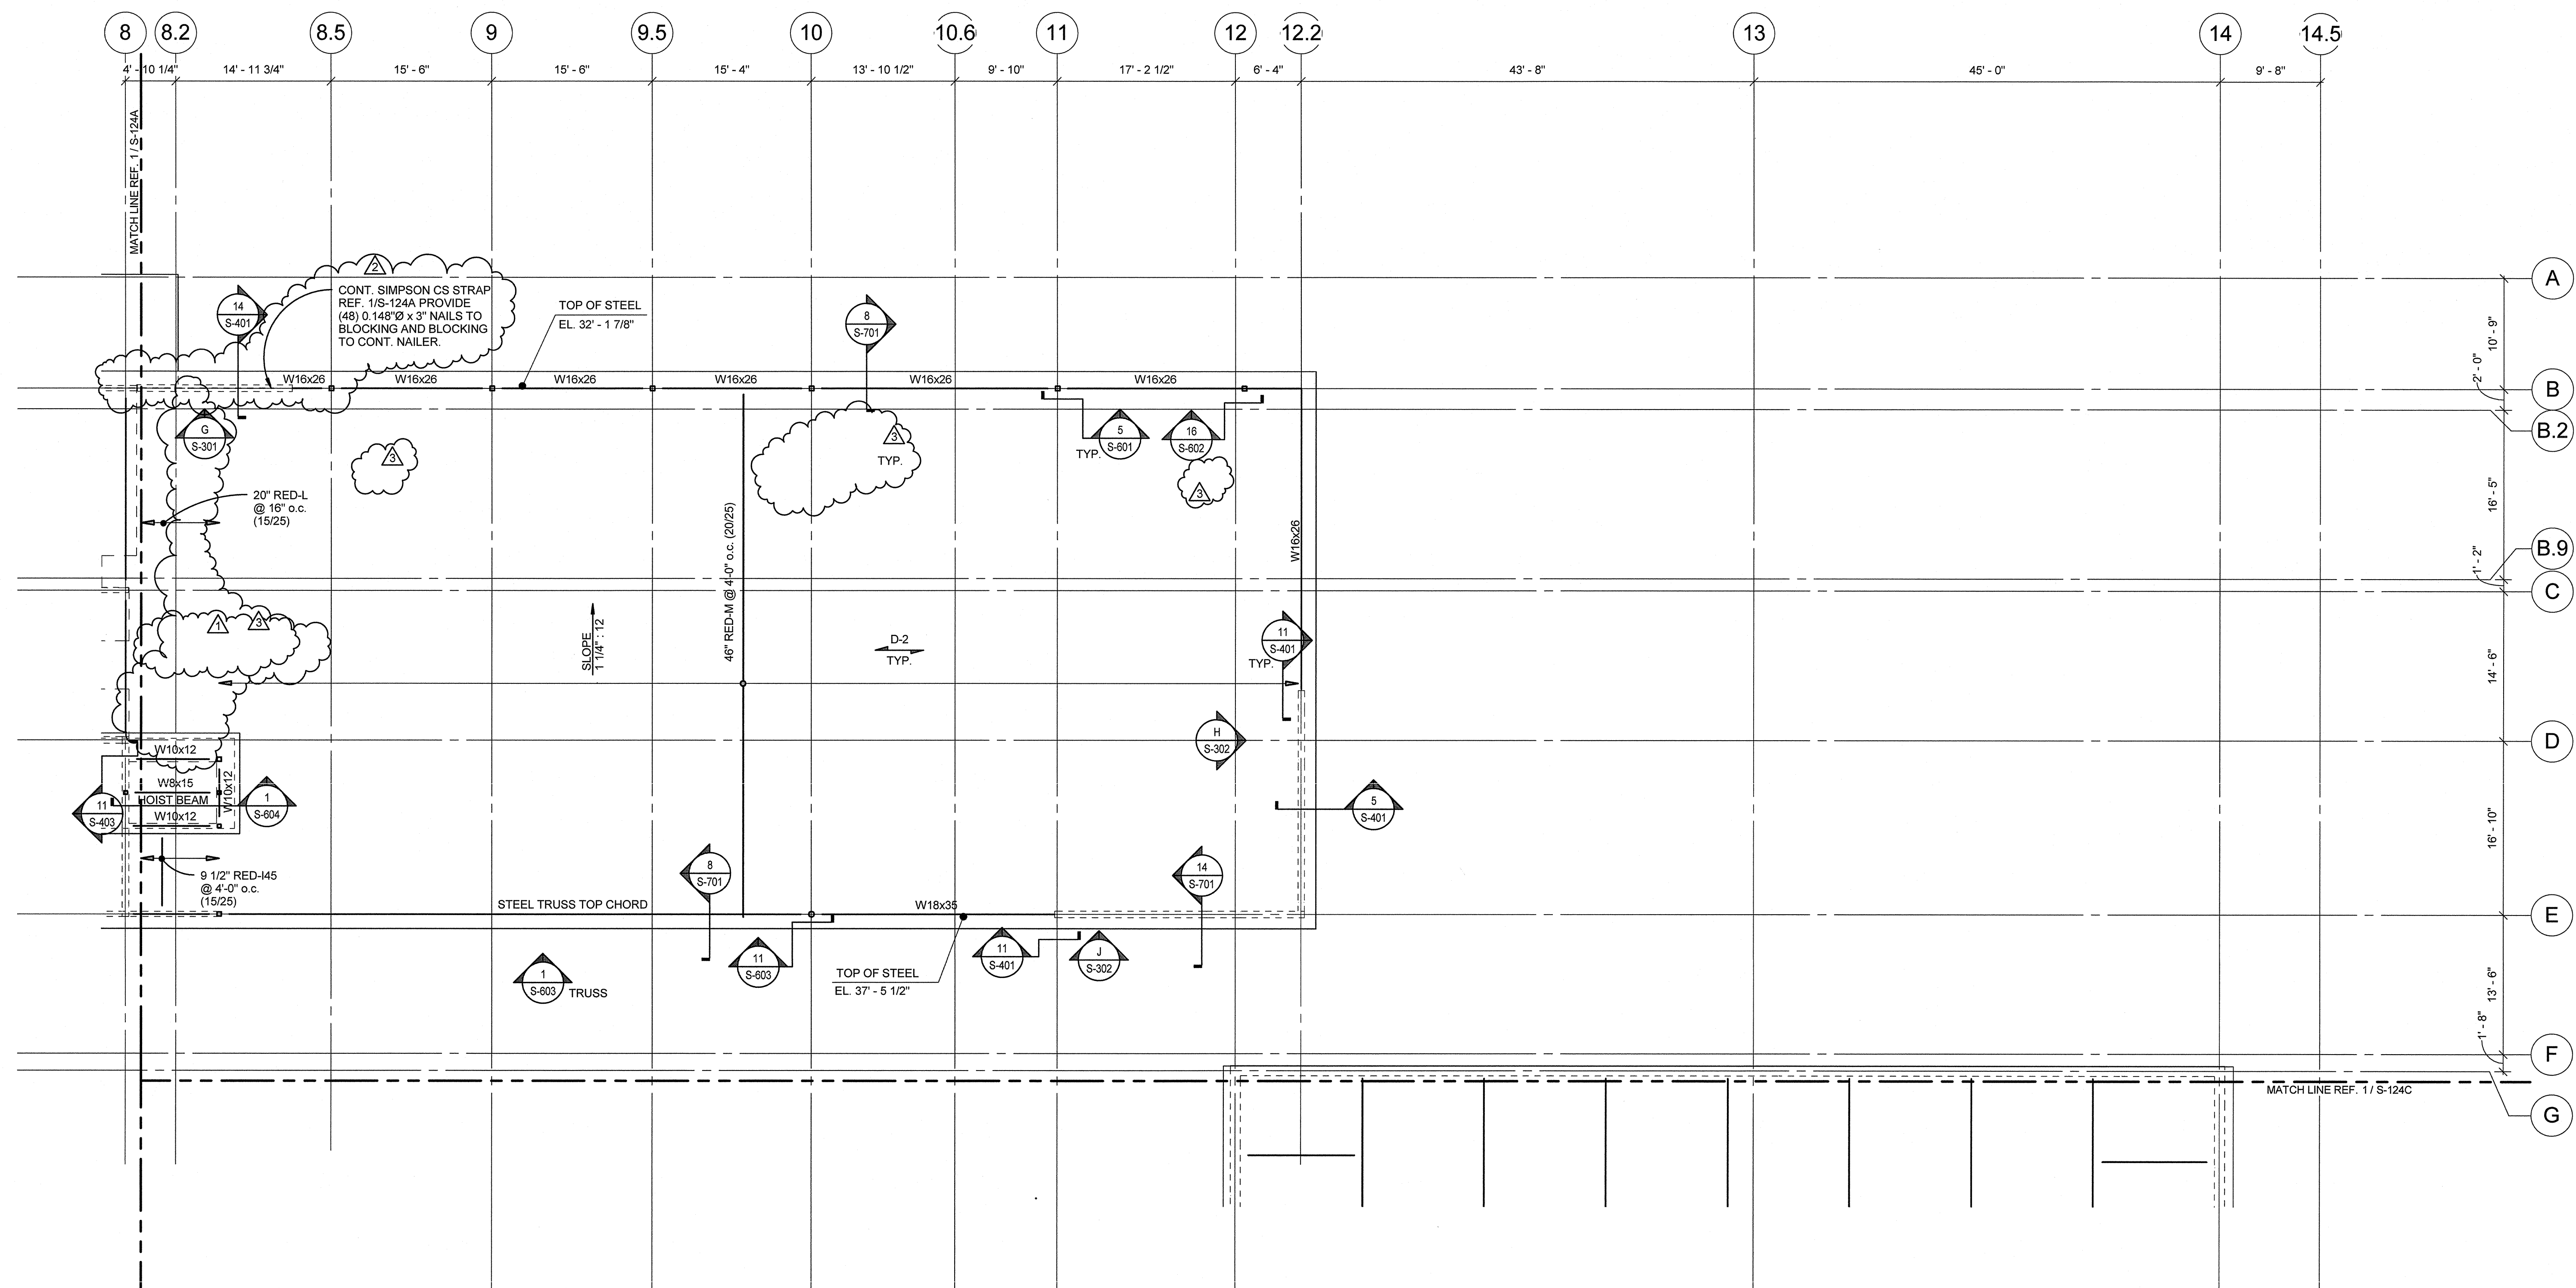

PLAN NOTES:
REF. SHEET S-120 FOR TYPICAL PLAN NOTES.

1 HIGH ROOF PLAN - ZONE B
1/8" = 1'-0"

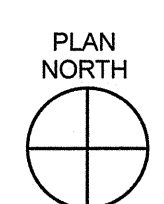


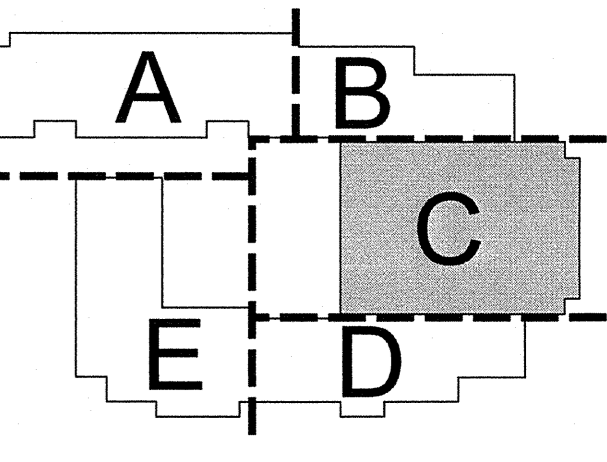


MARK	DATE	DESCRIPTION
2	3-13-2015	ADDENDUM 6
1	2-18-2015	SUPPLEMENTAL INFO 1

ISSUE DATE: FEBRUARY 18, 2015
ISSUE: CONSTRUCTION DOCUMENTS
VOLUME: PACKAGE 1
PROJECT NO: 213417
DRAWN BY: MF
CHECKED BY: MT
COPYRIGHT MAHLUM ARCHITECTS, INC. 2014 ORIGINAL SHEET SIZE: 30"X42"






HIGH ROOF PLAN - ZONE C

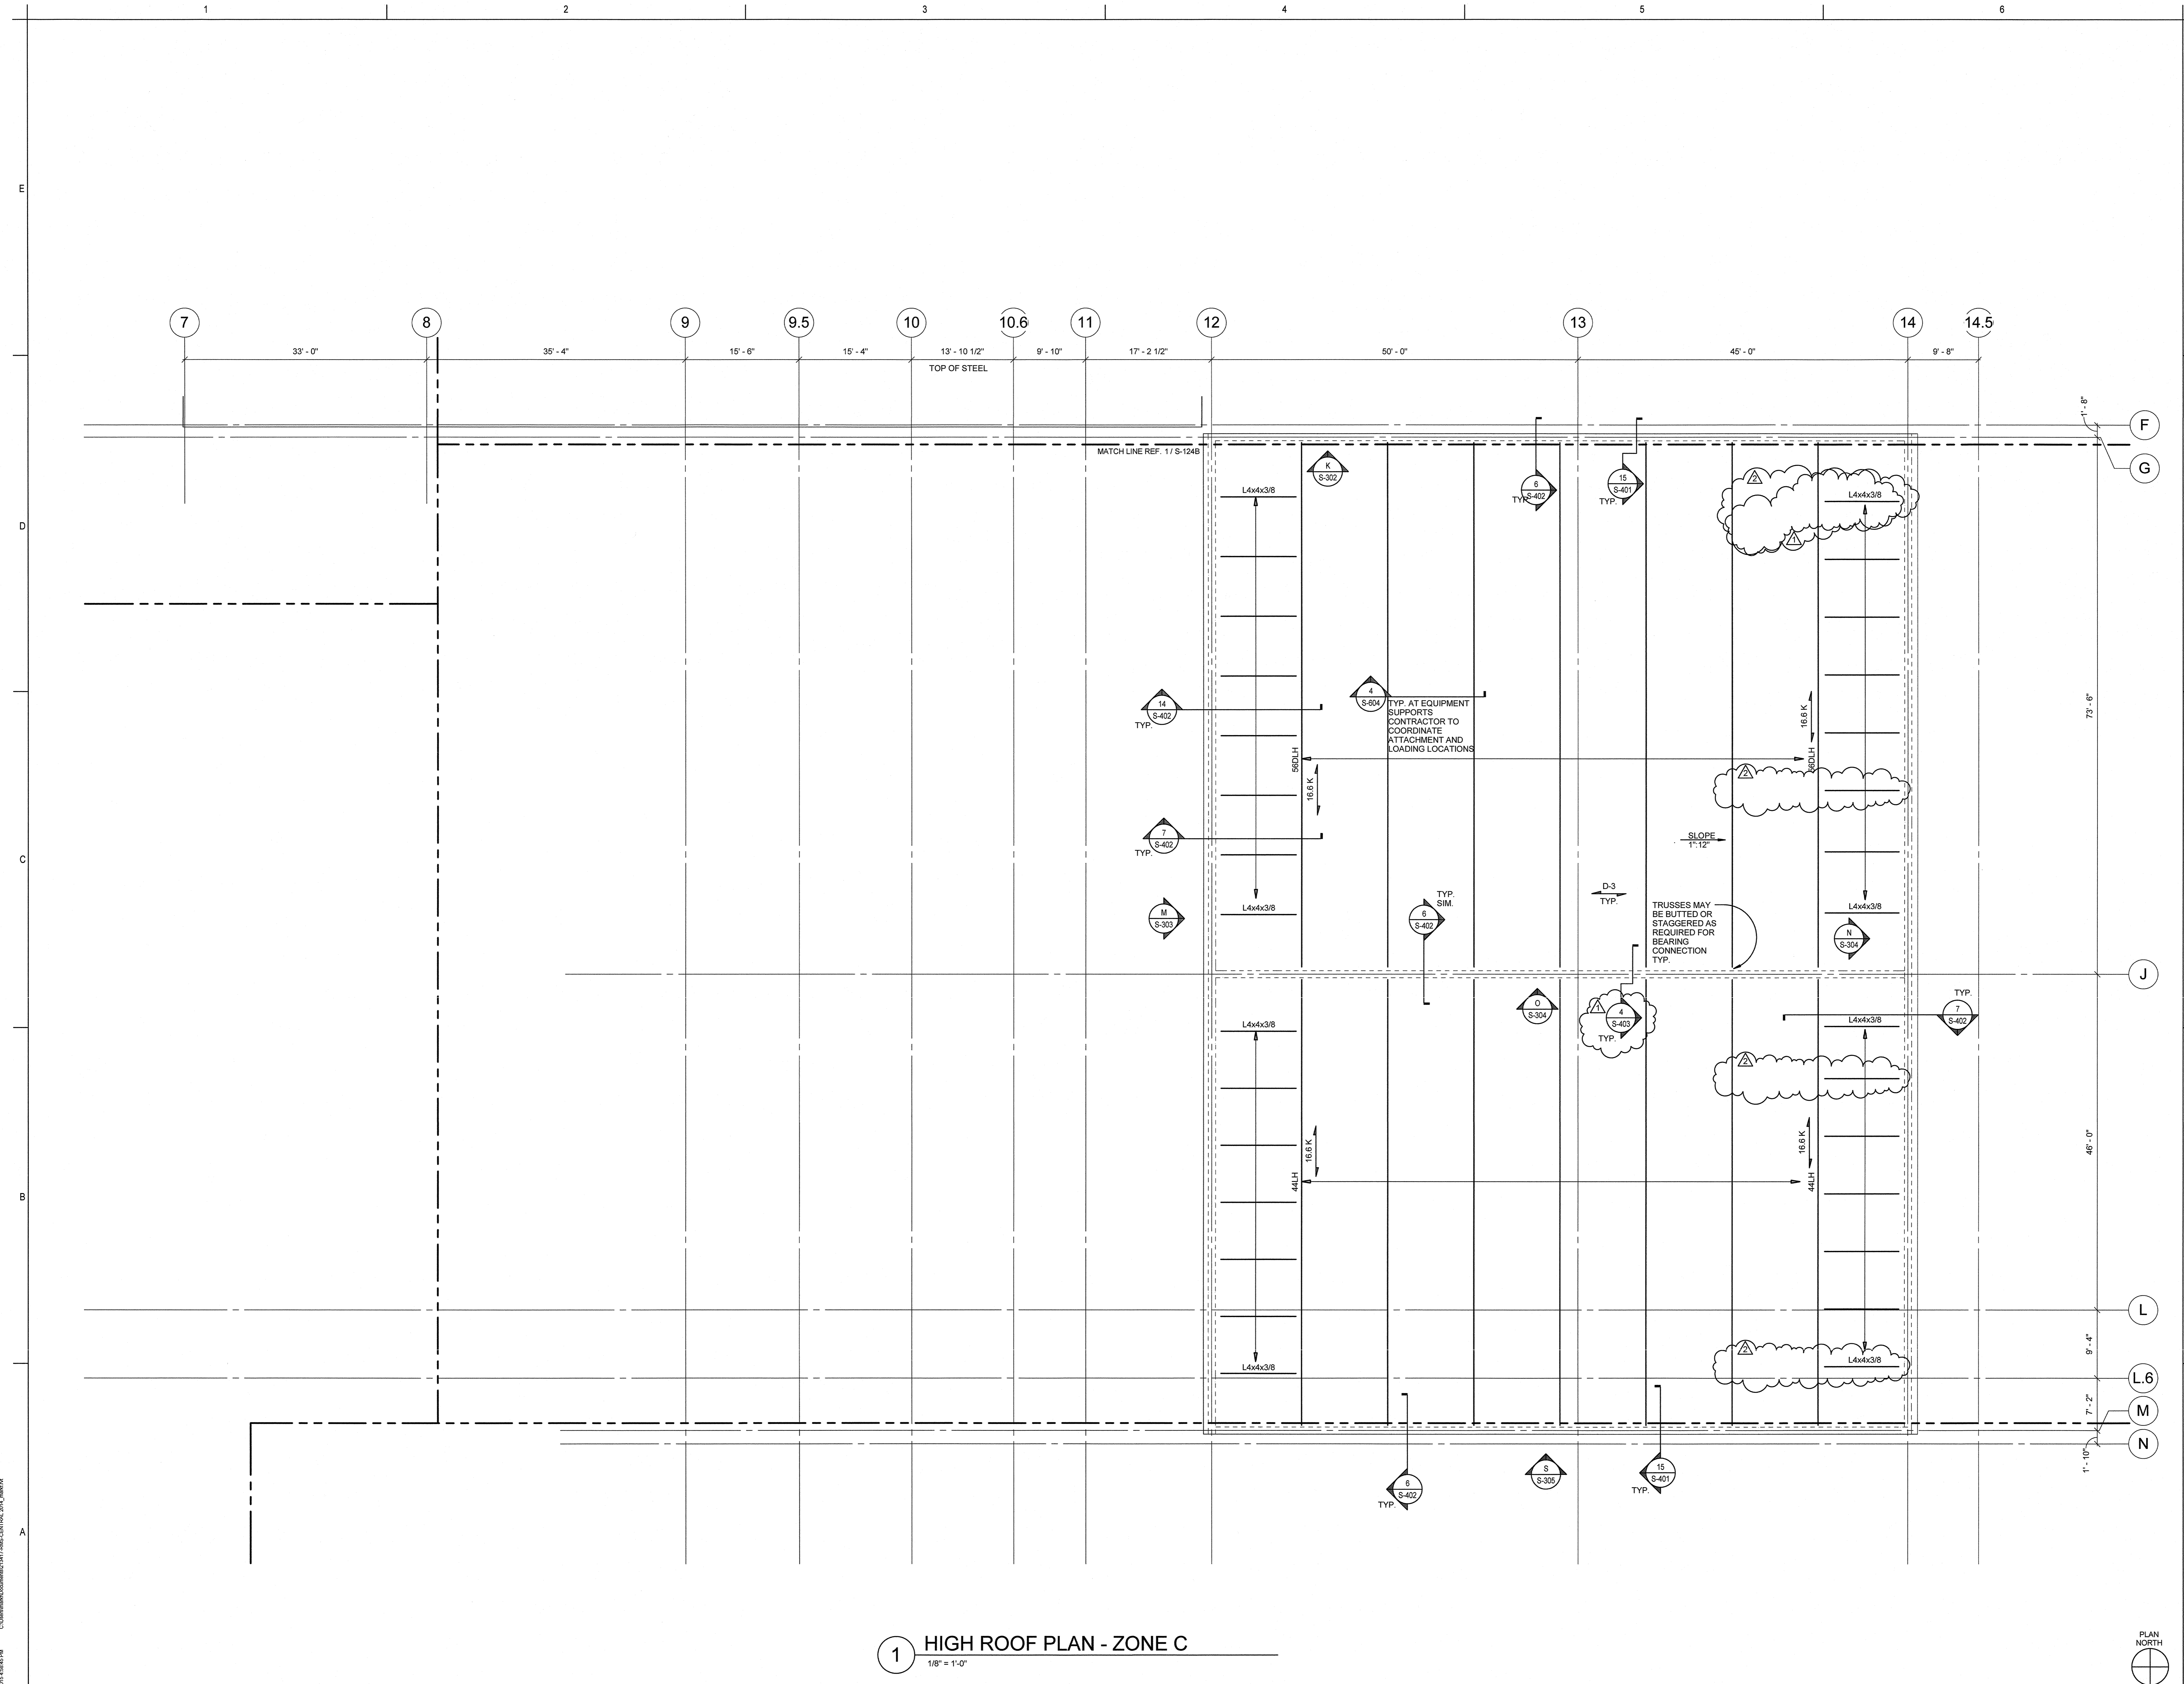




















1 HIGH ROOF PLAN - ZONE C
1/8" = 1'-0"

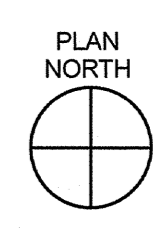

C:\Users\mahlum\Documents\213417\HIGH ROOF PLAN - ZONE C.dwg

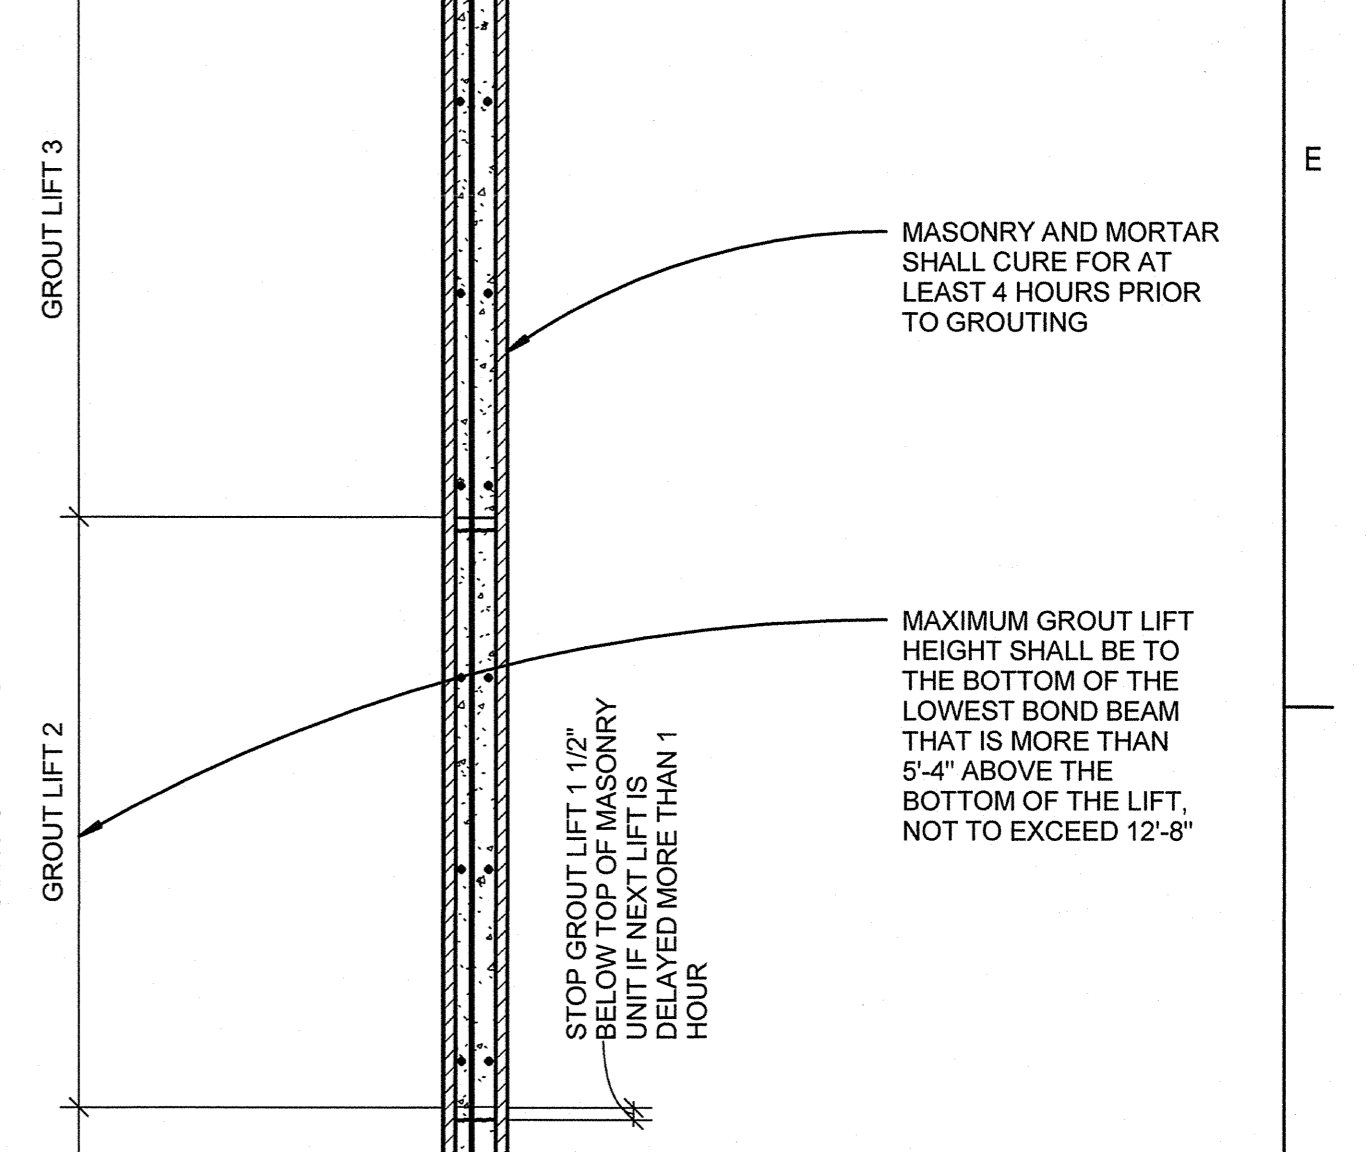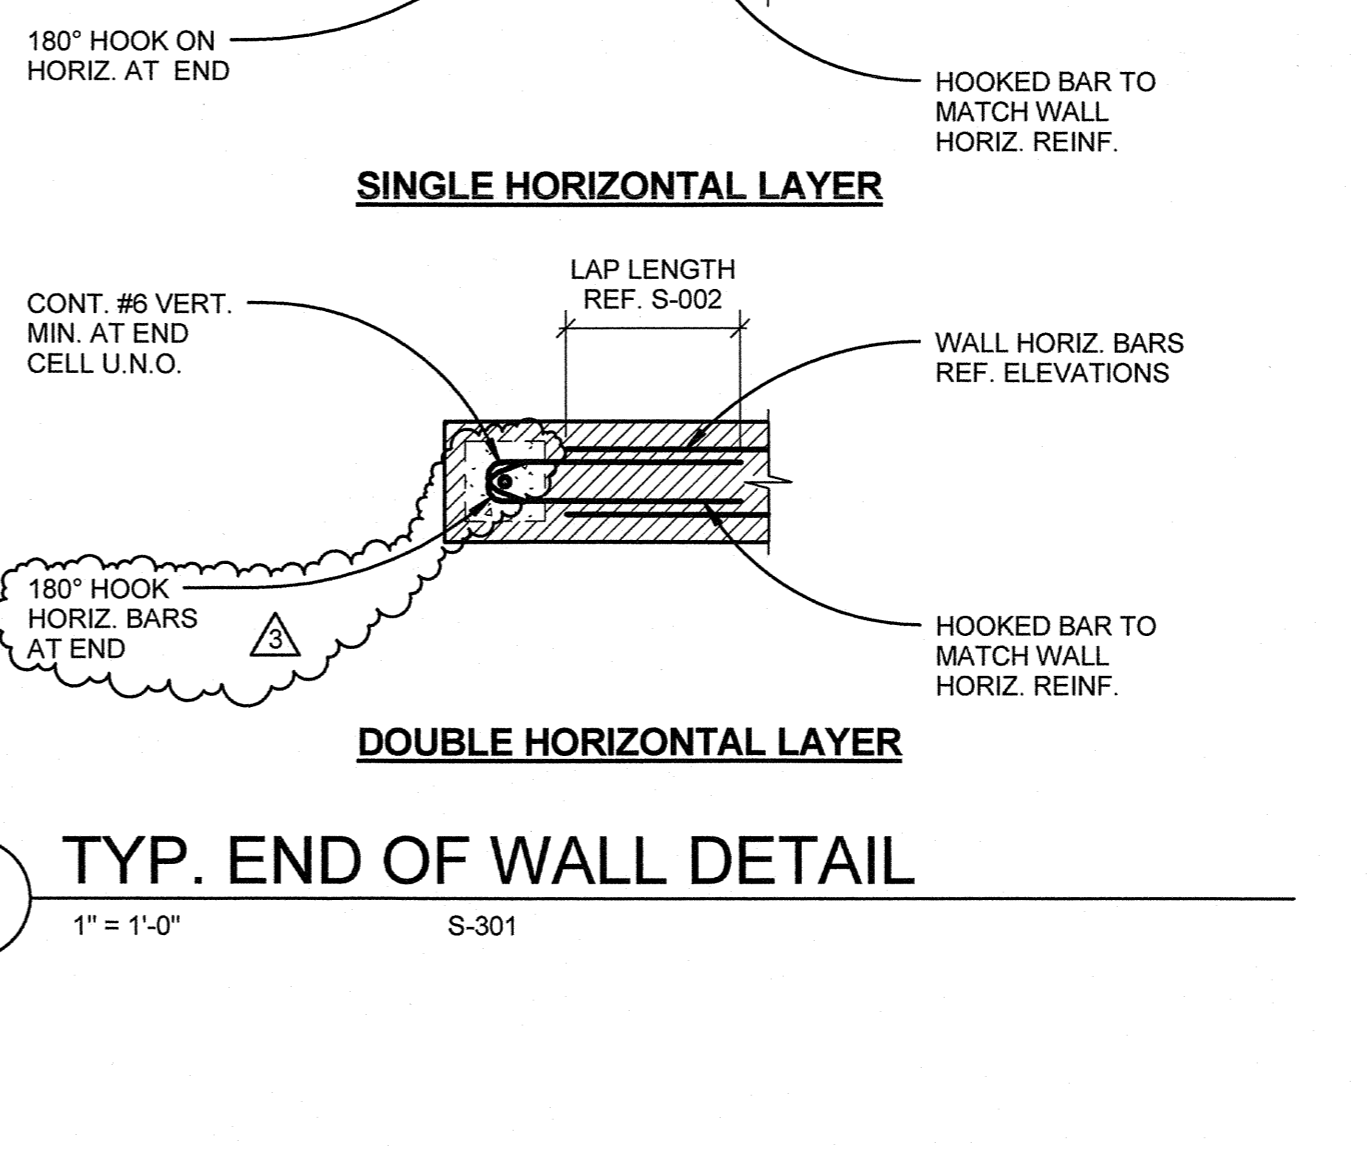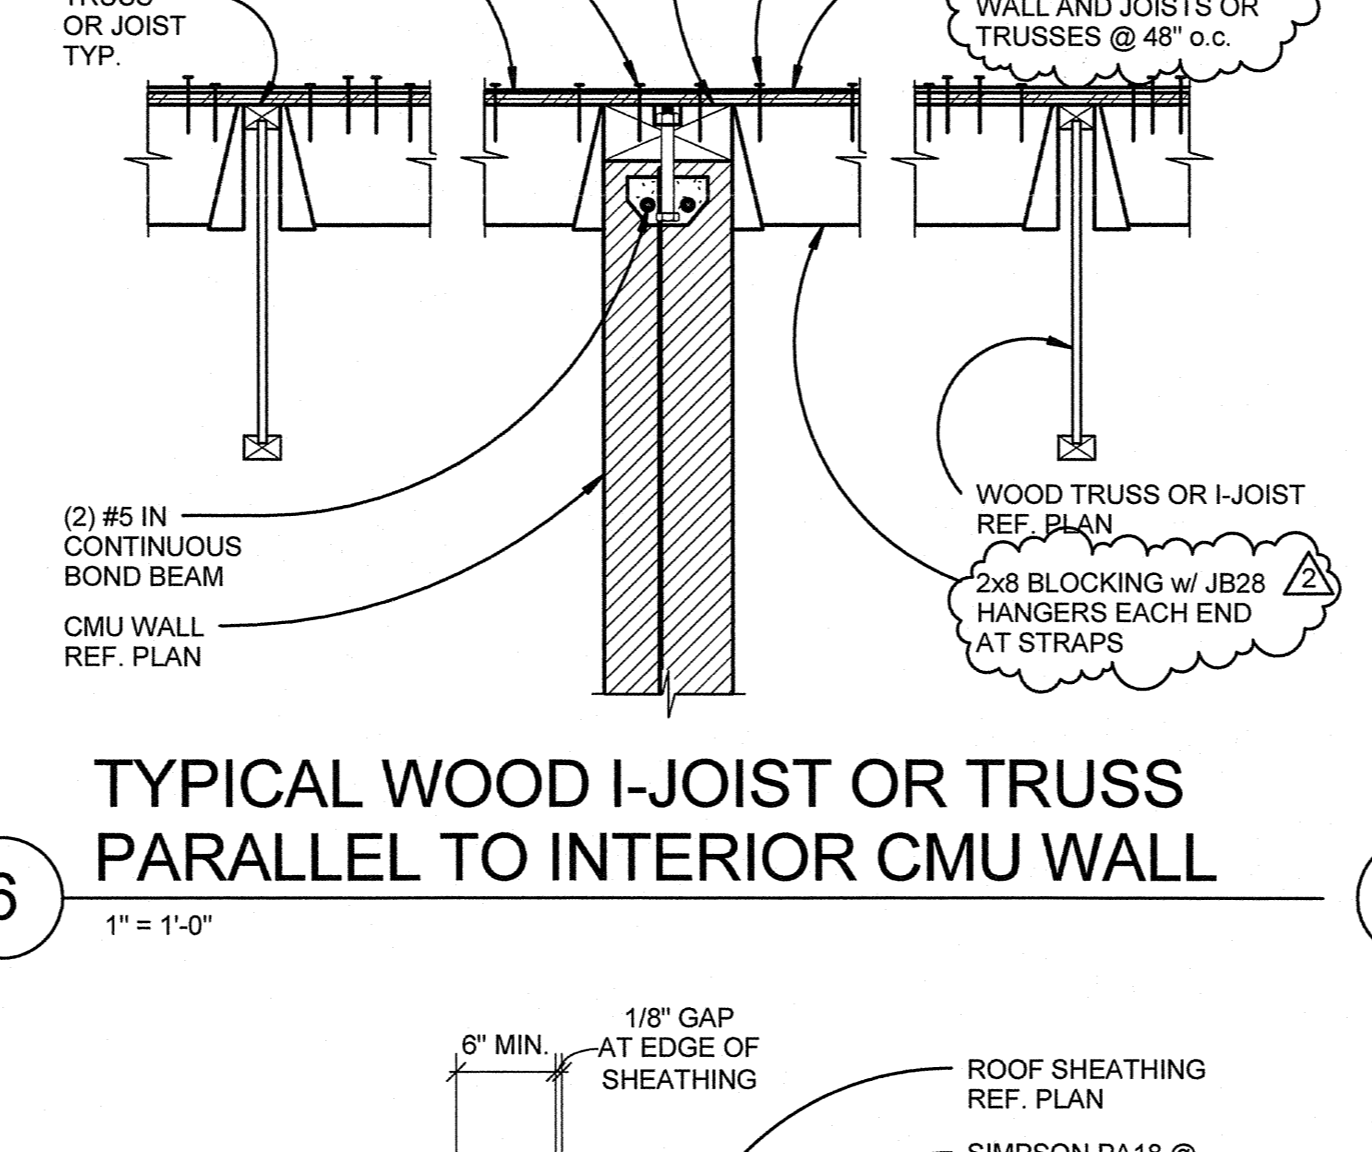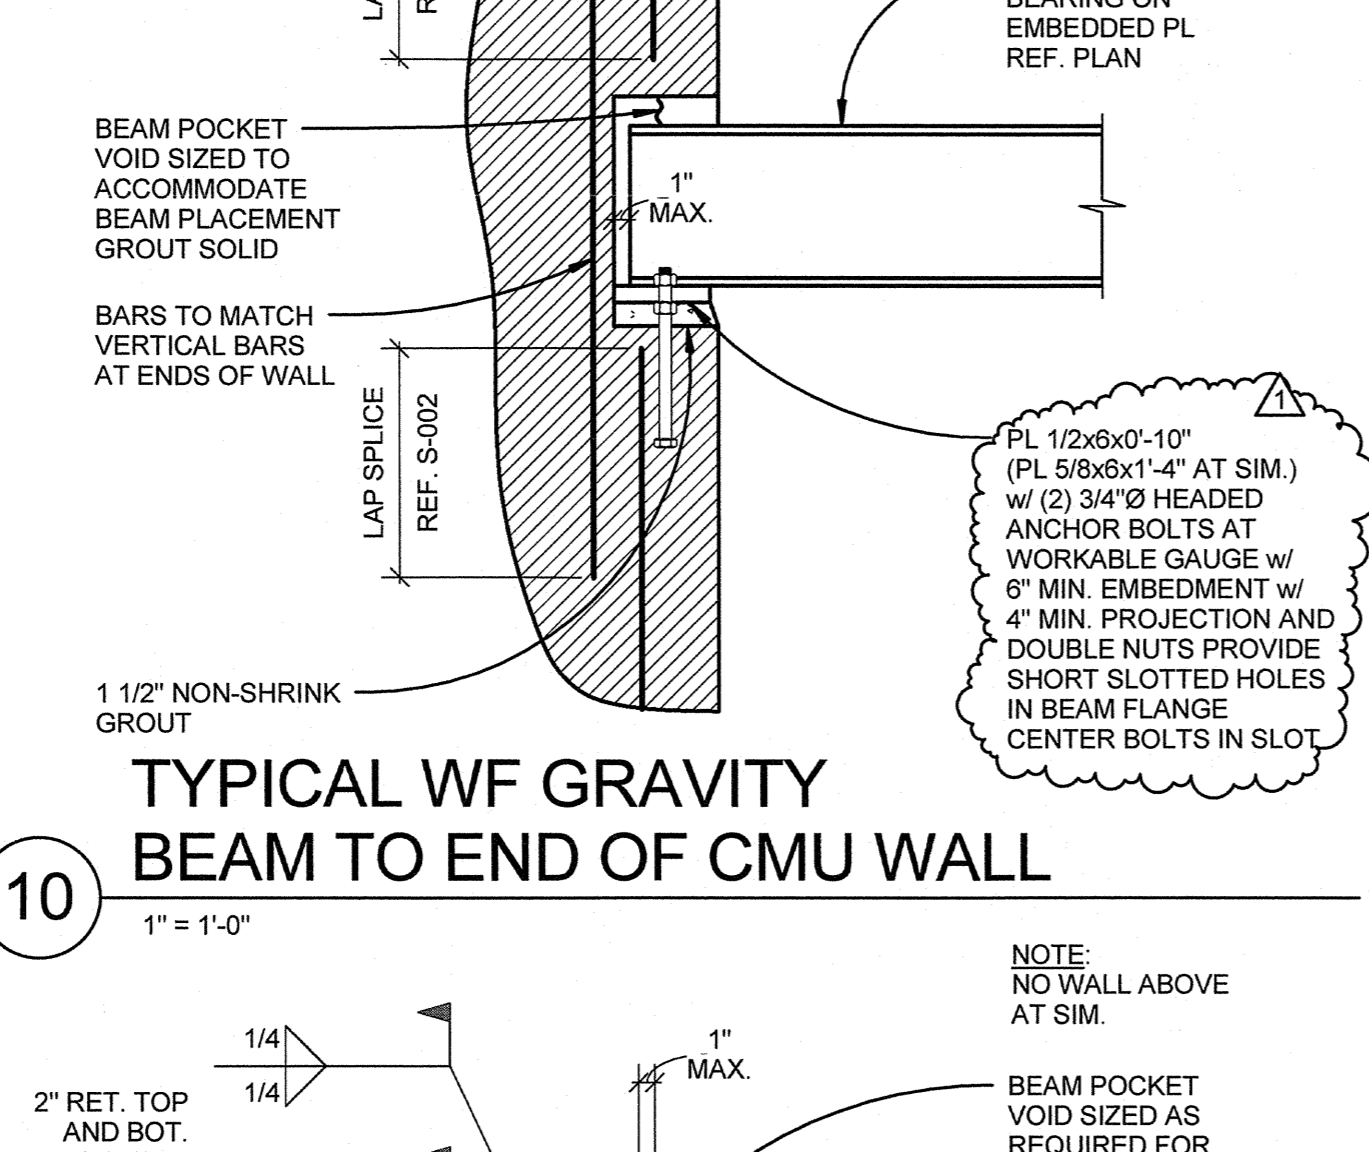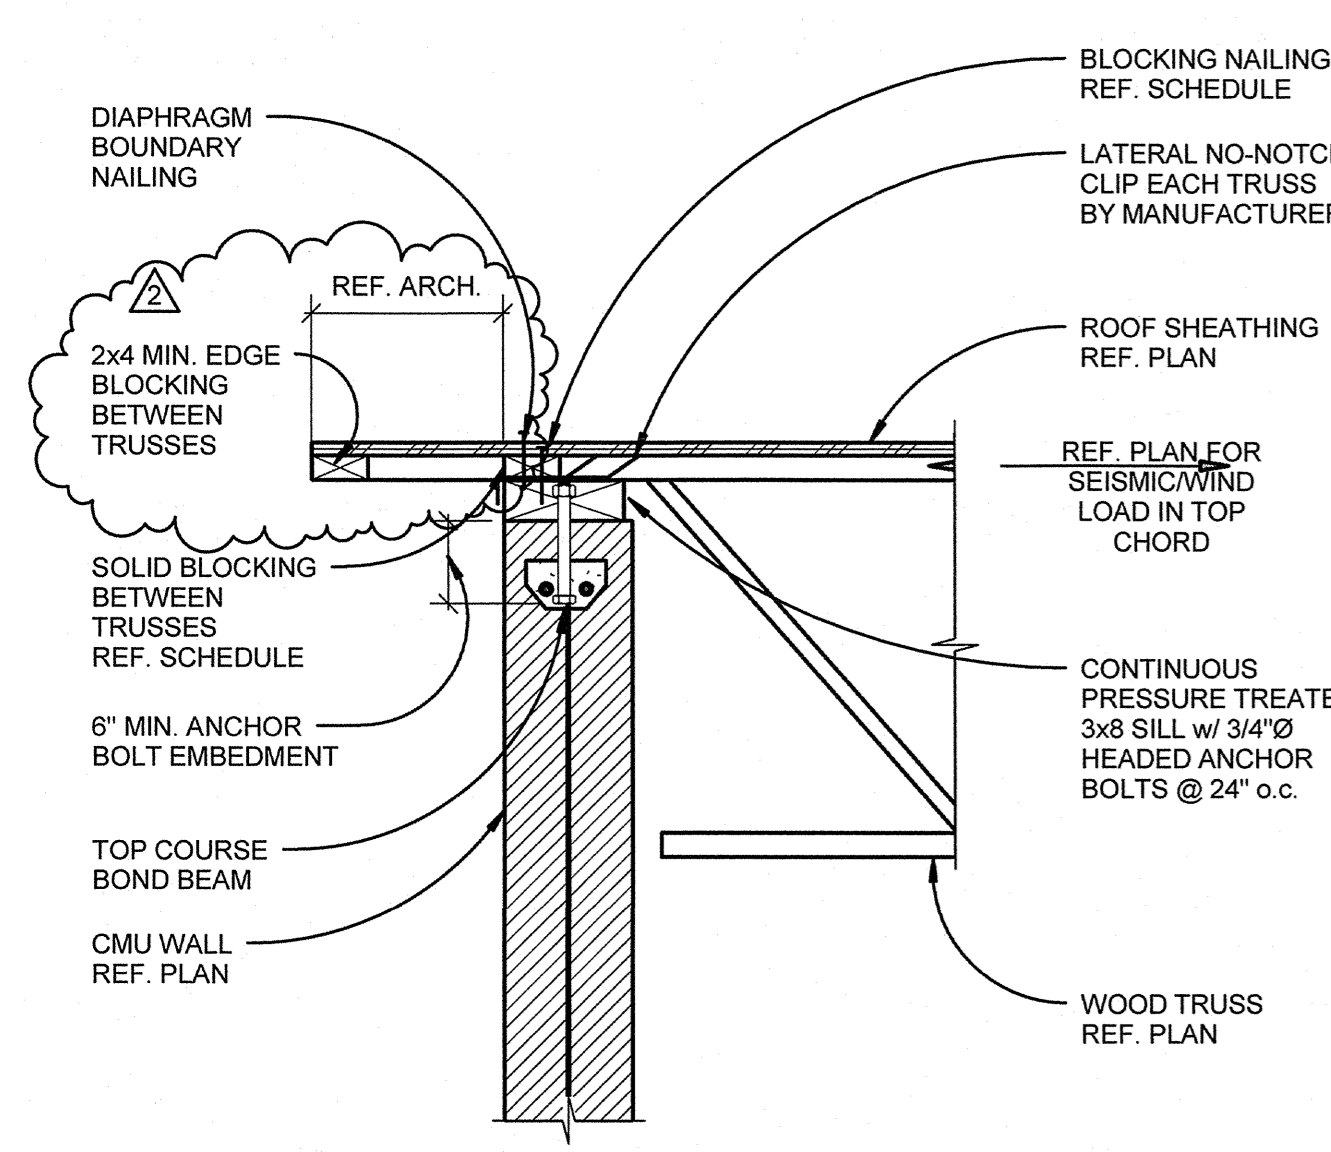

BLOCKING SCHEDULE		
TRUSS TYPE	BLOCKING	NAILING
RED-L RED-LT RED-W	2x4	0.148"Øx3" @ 8" o.c.
RED-S	4x4	0.225"Øx5" @ 12" o.c.
RED-H	4x6	0.225"Øx5" @ 12" o.c.

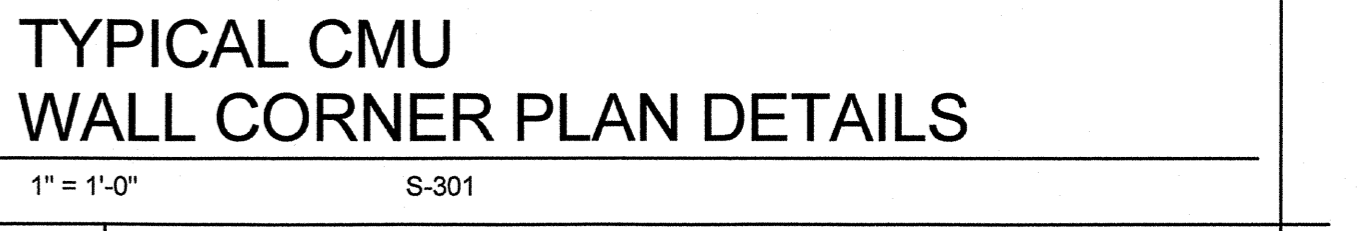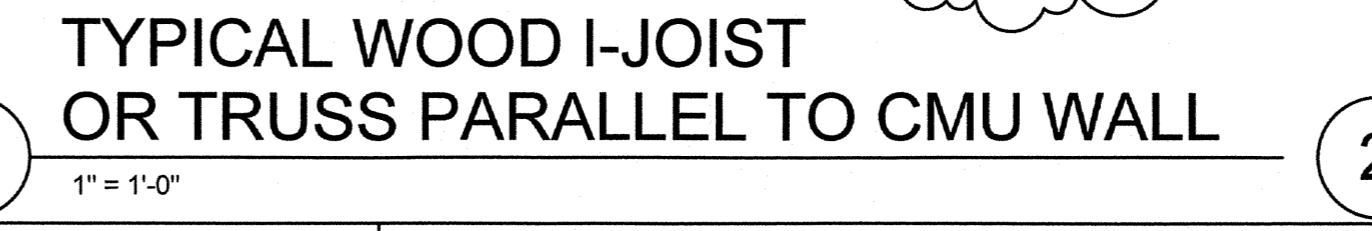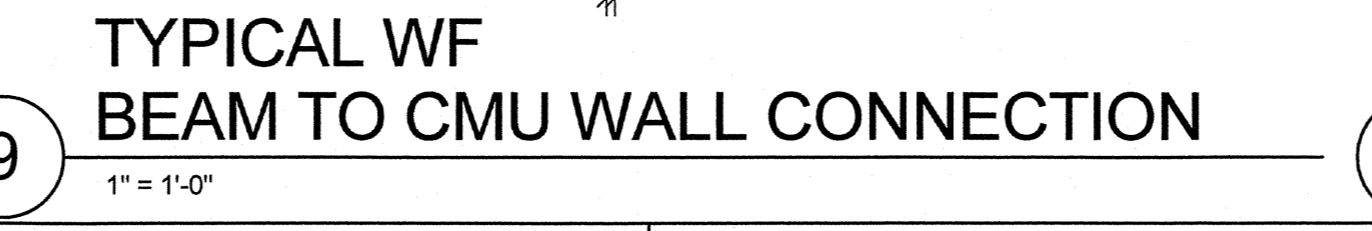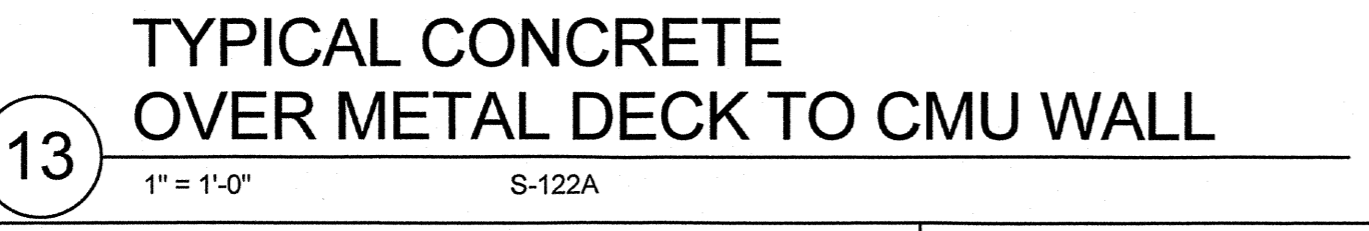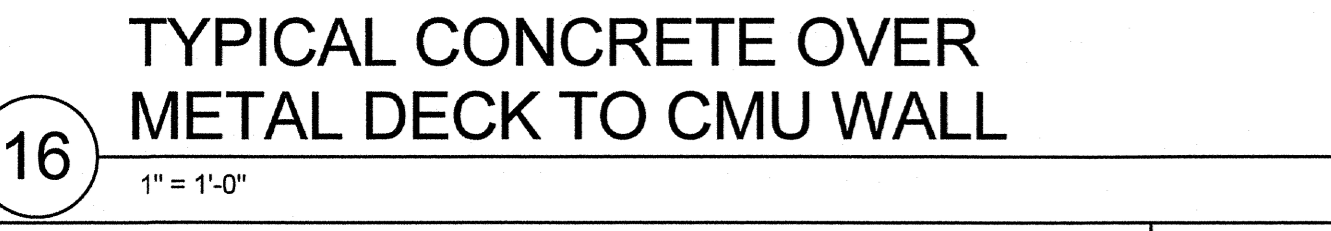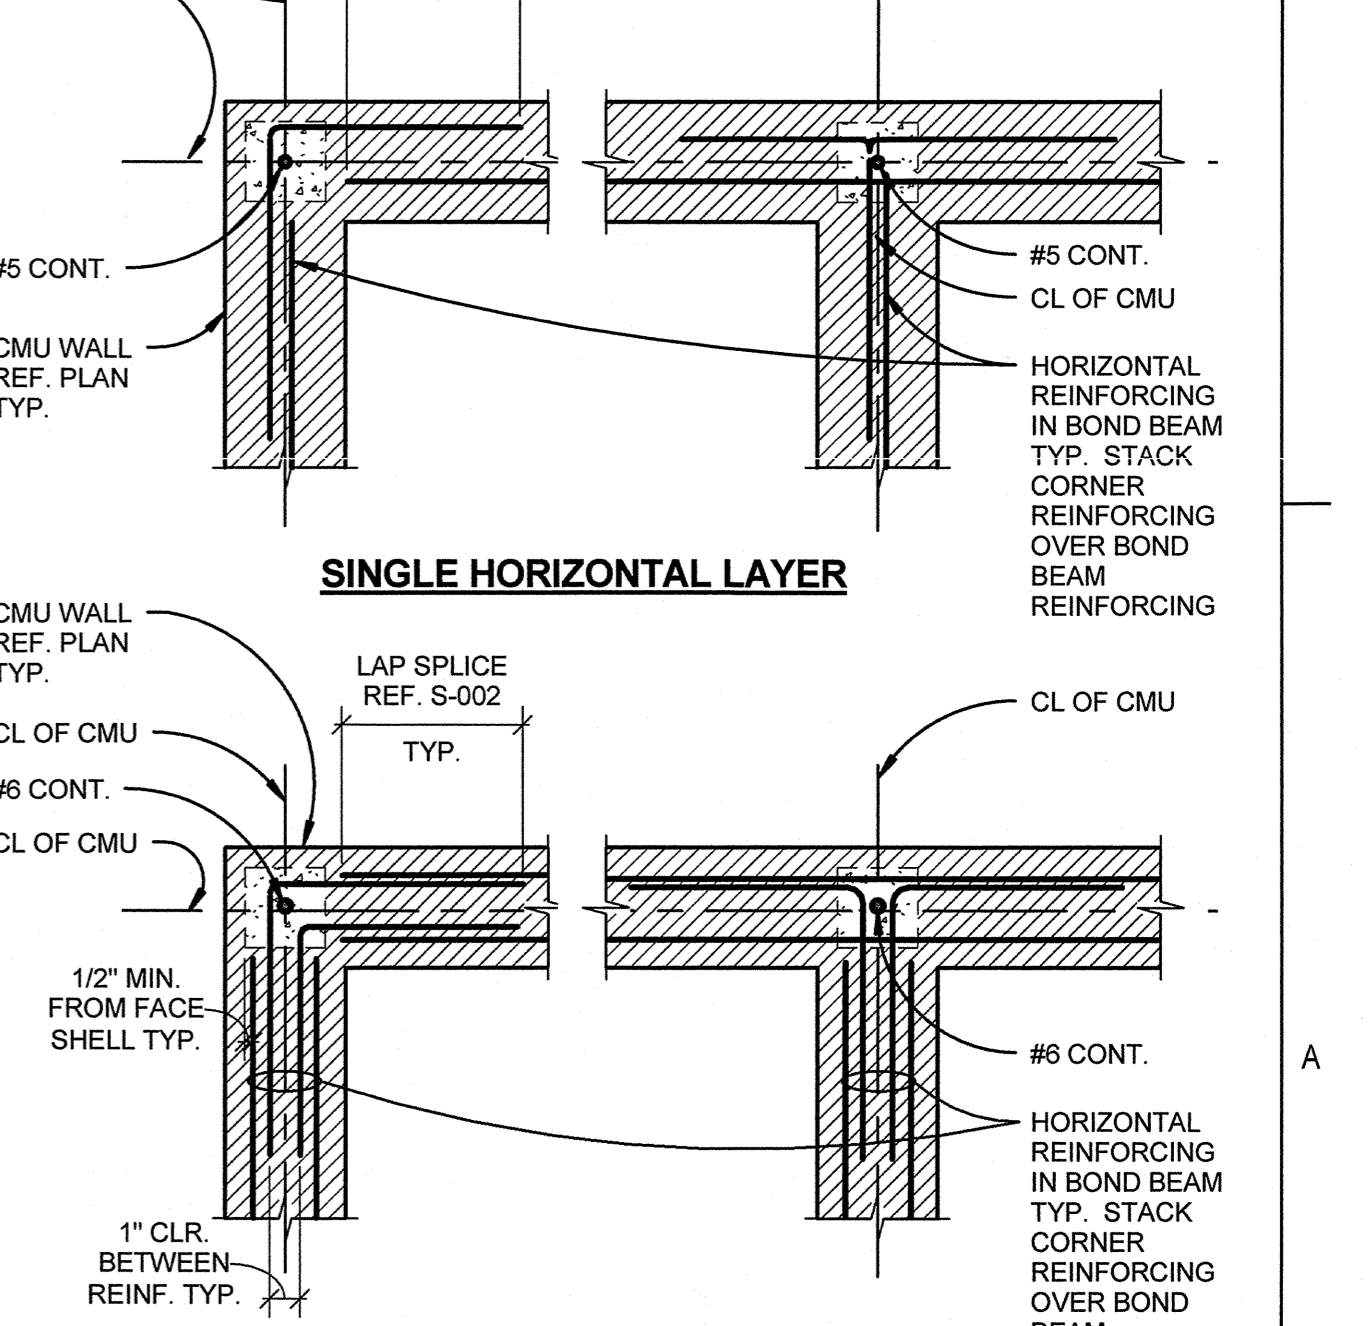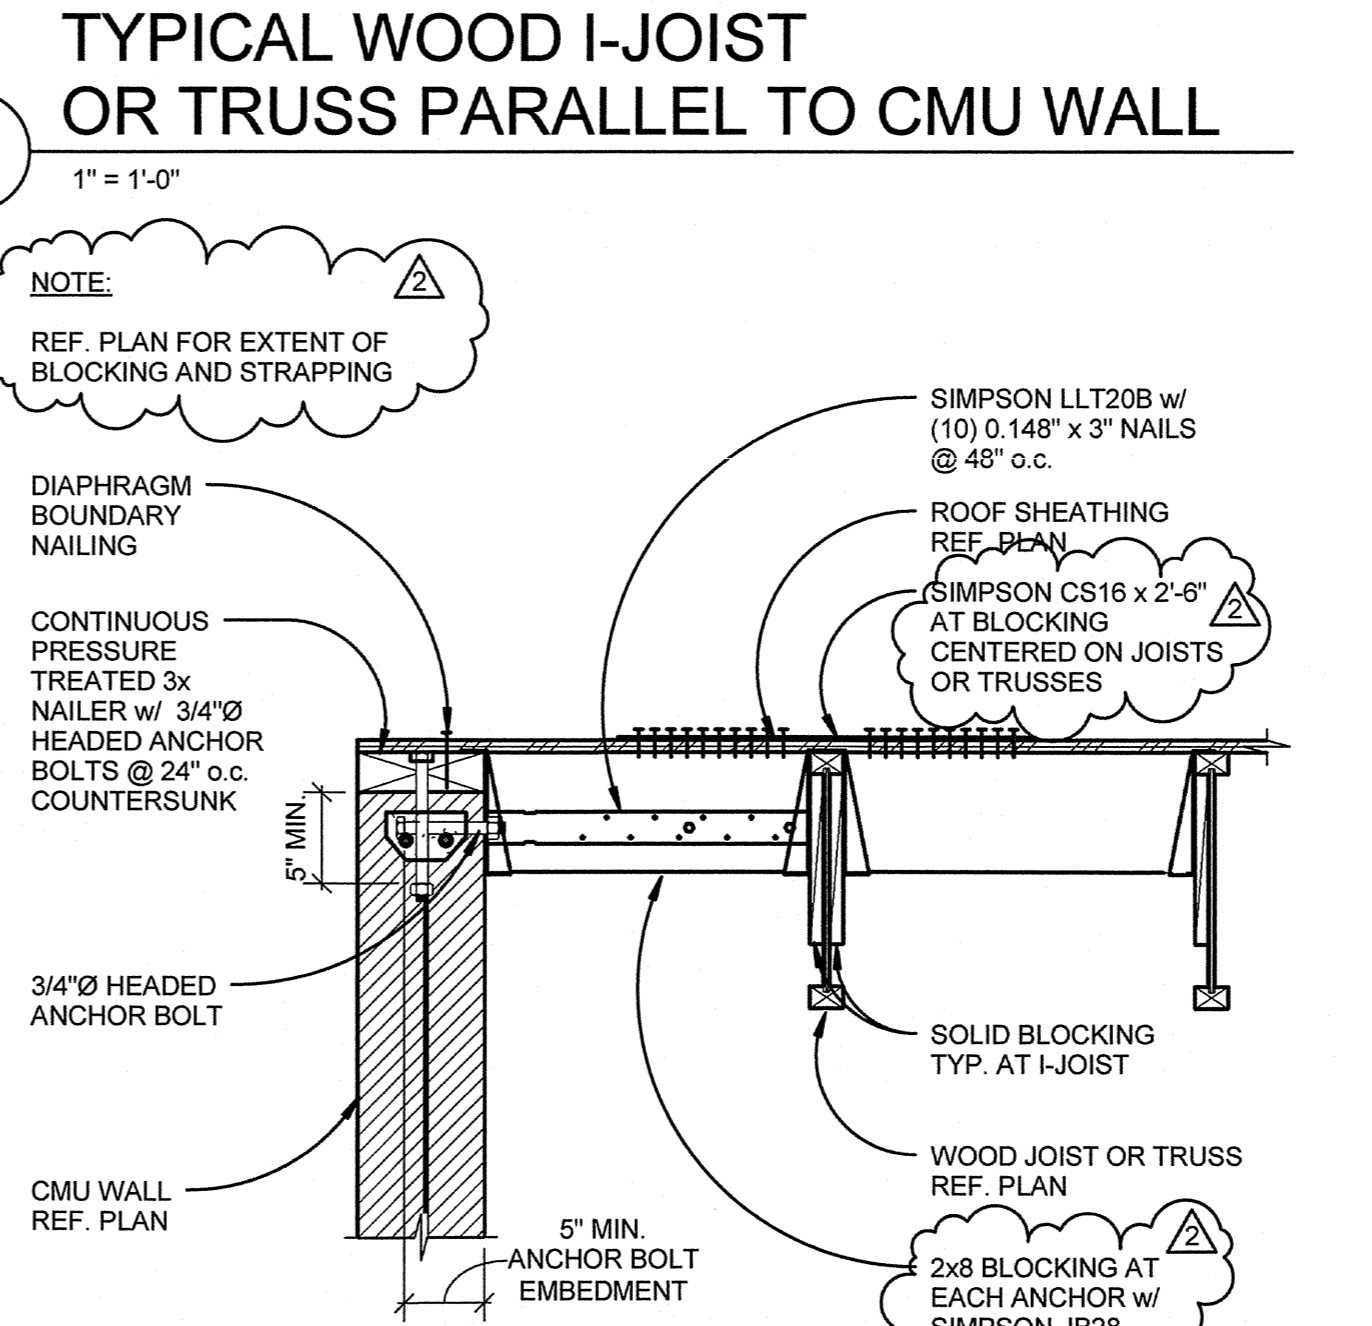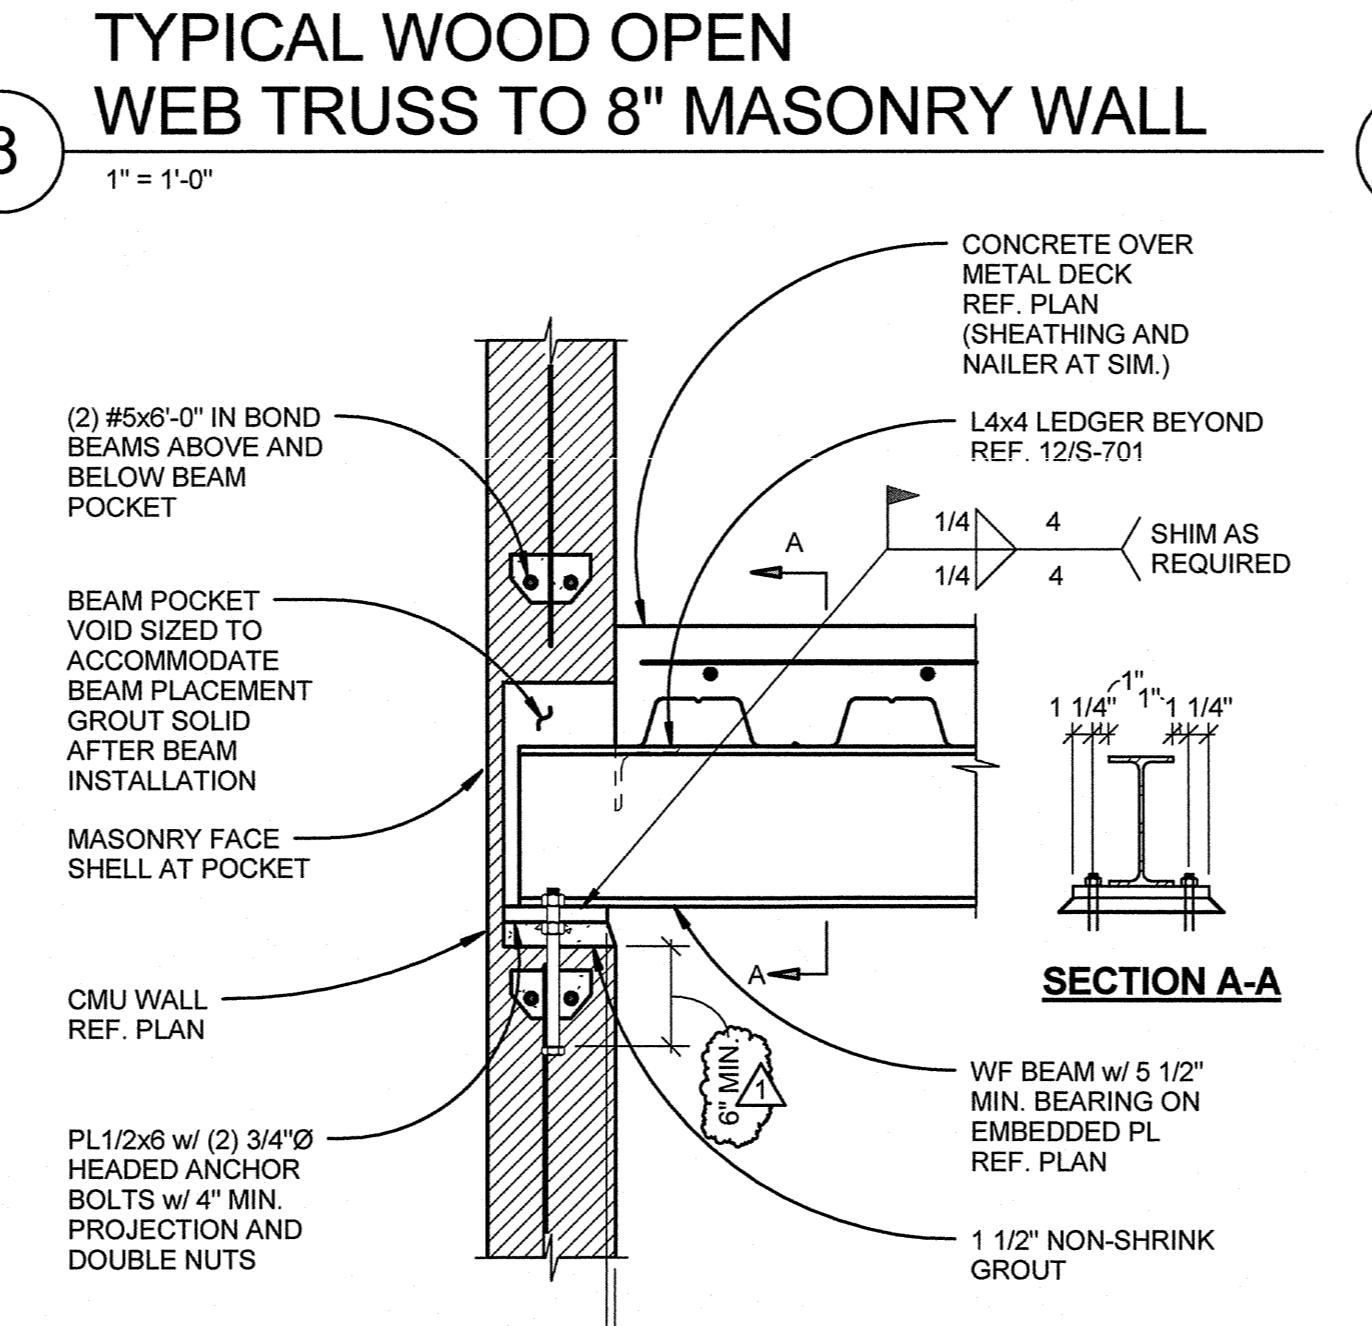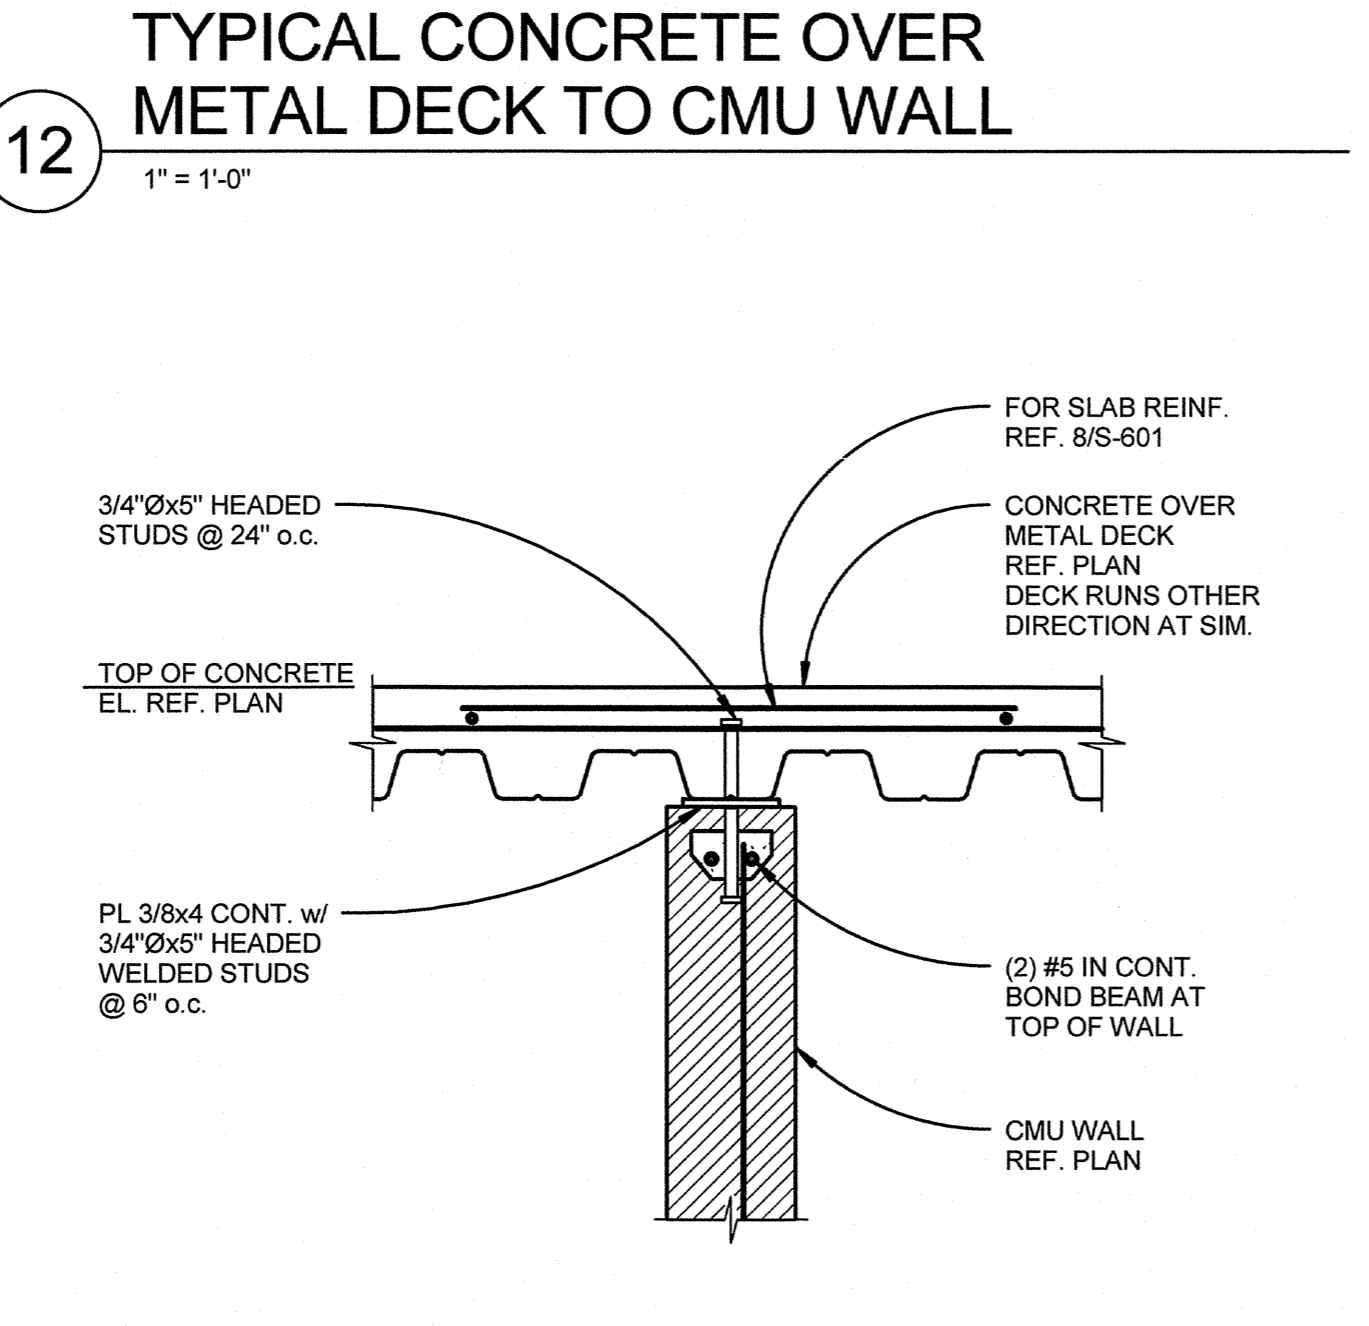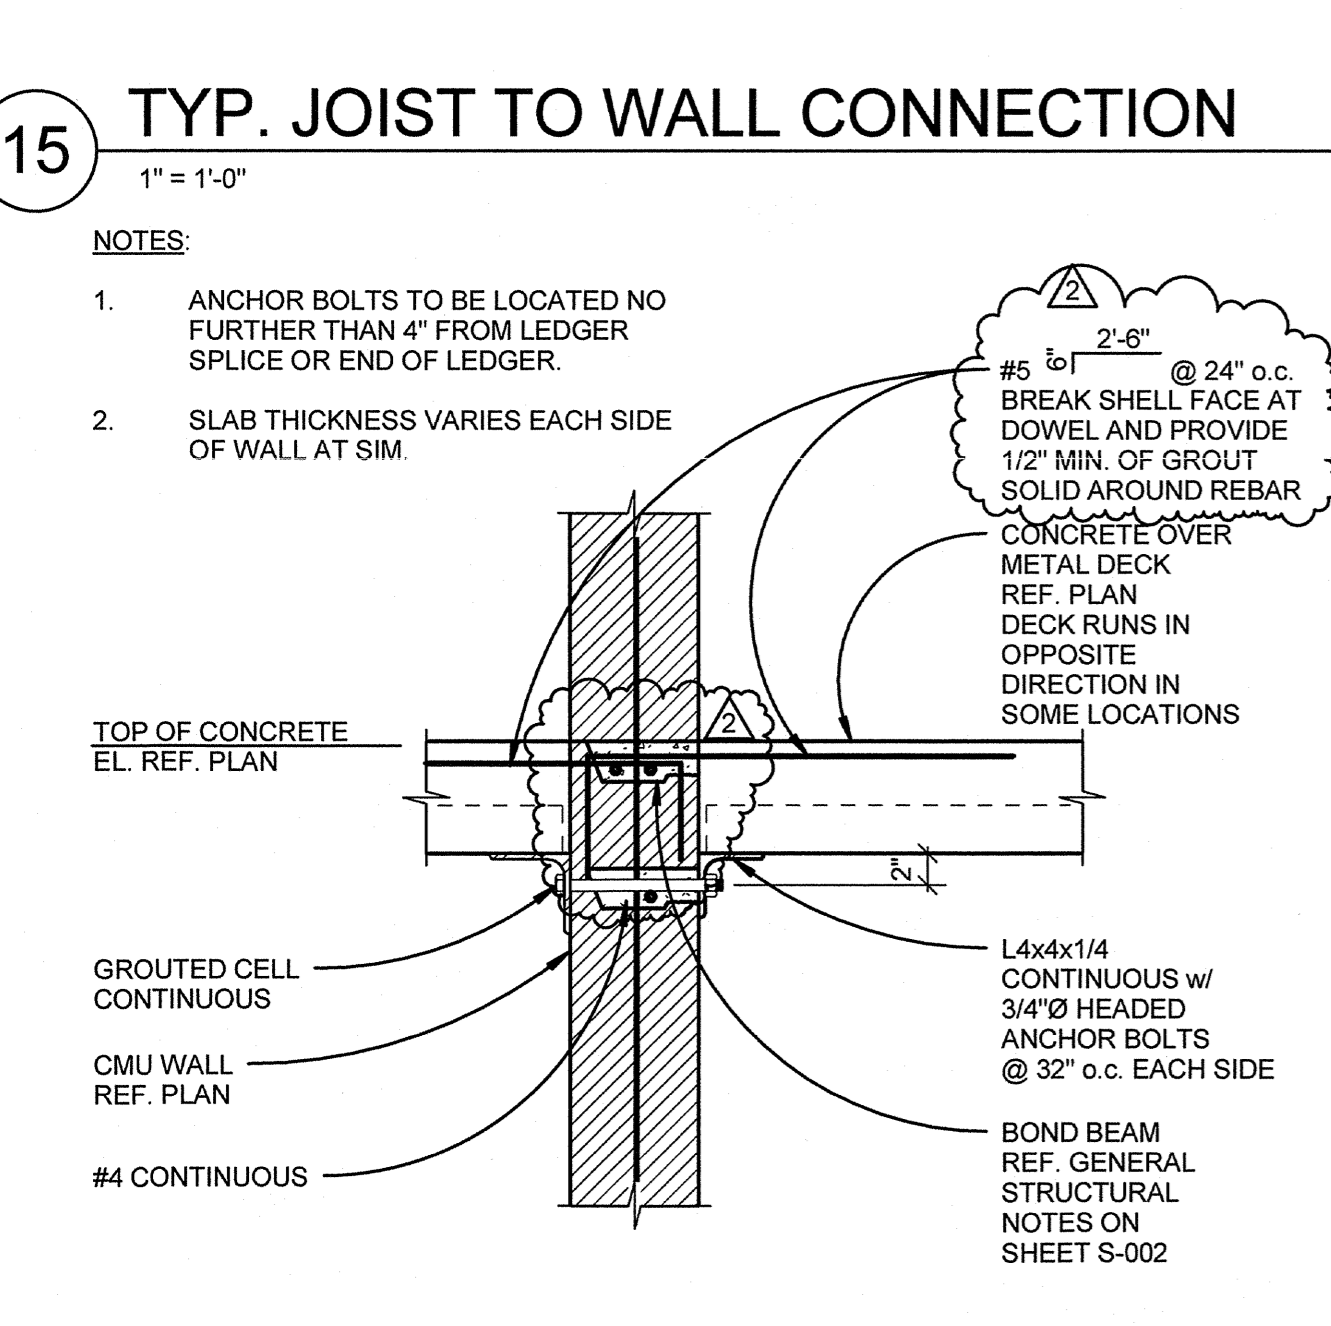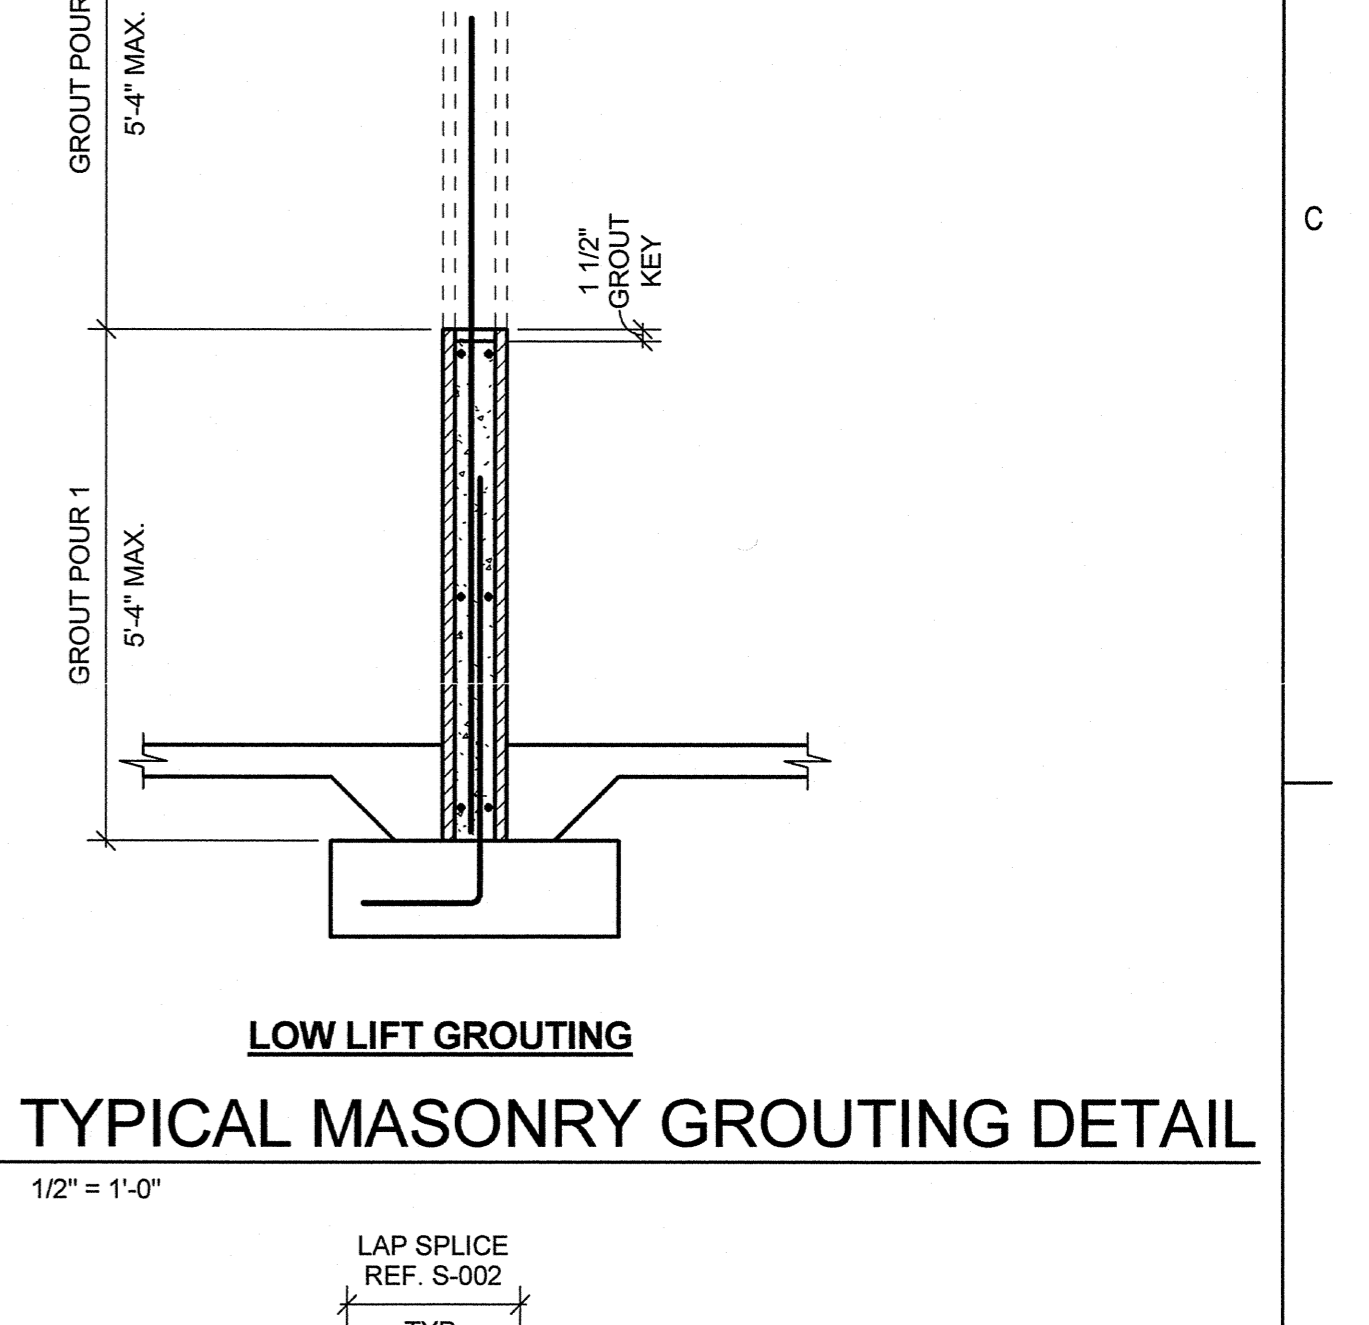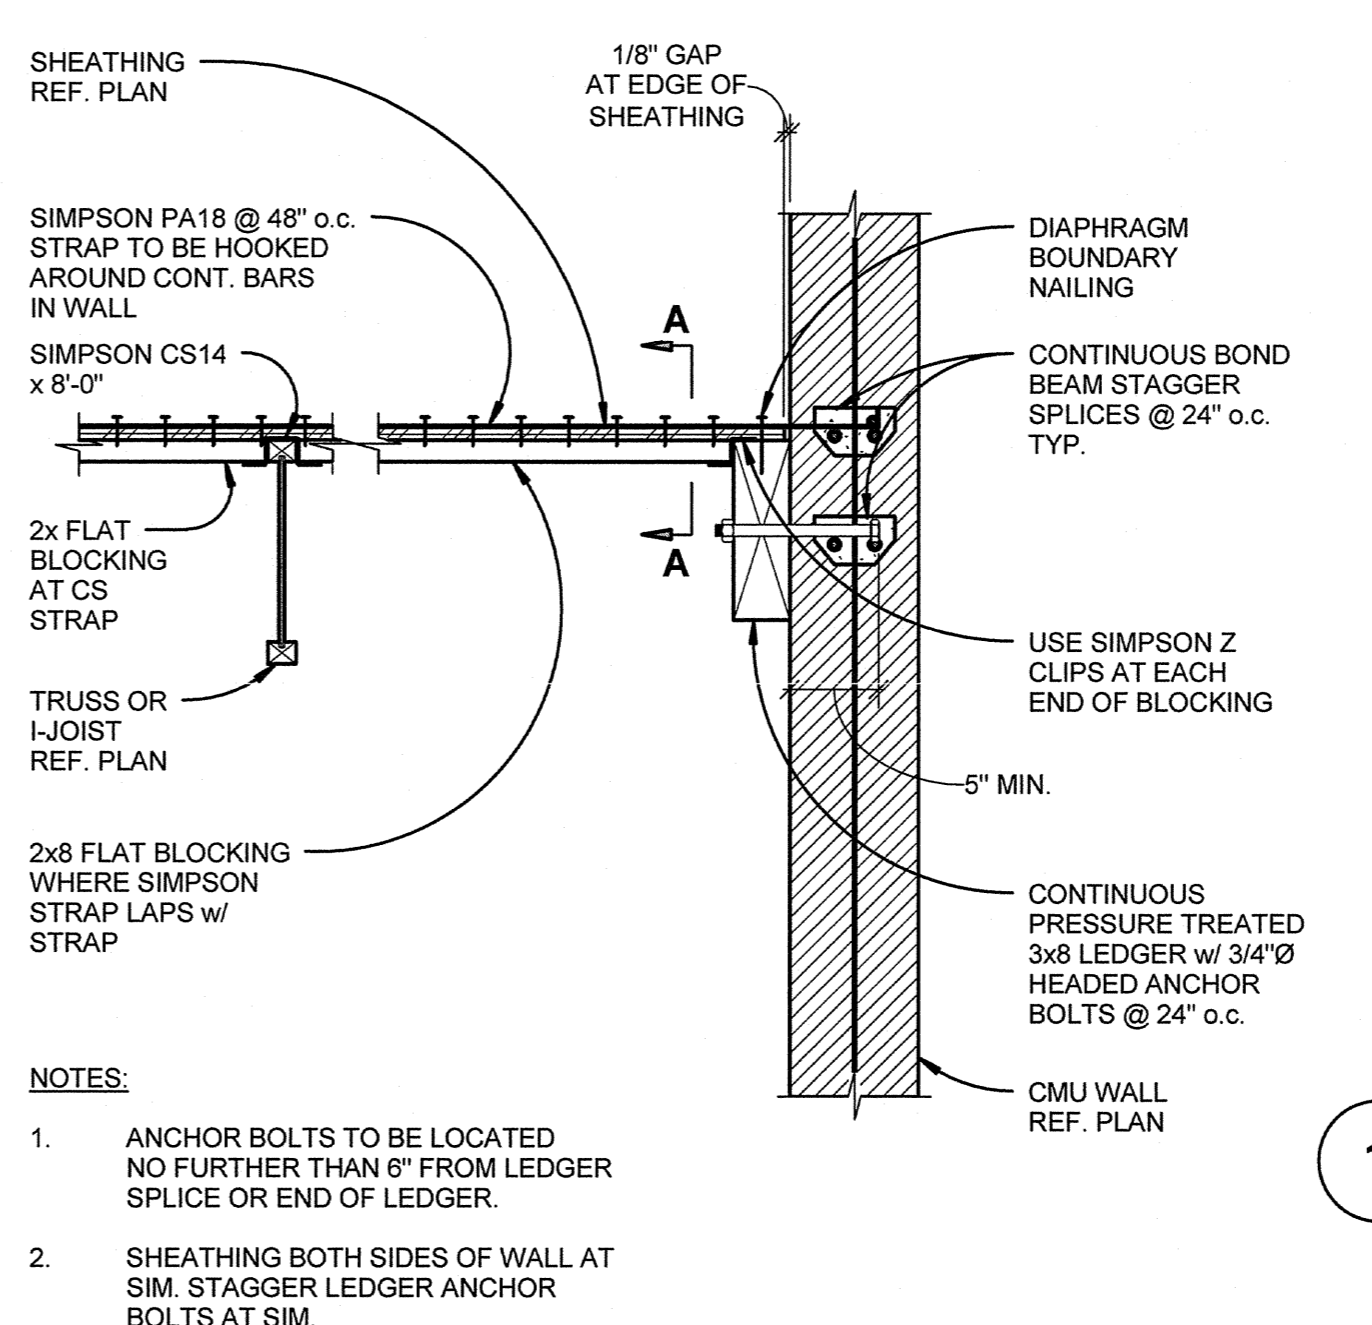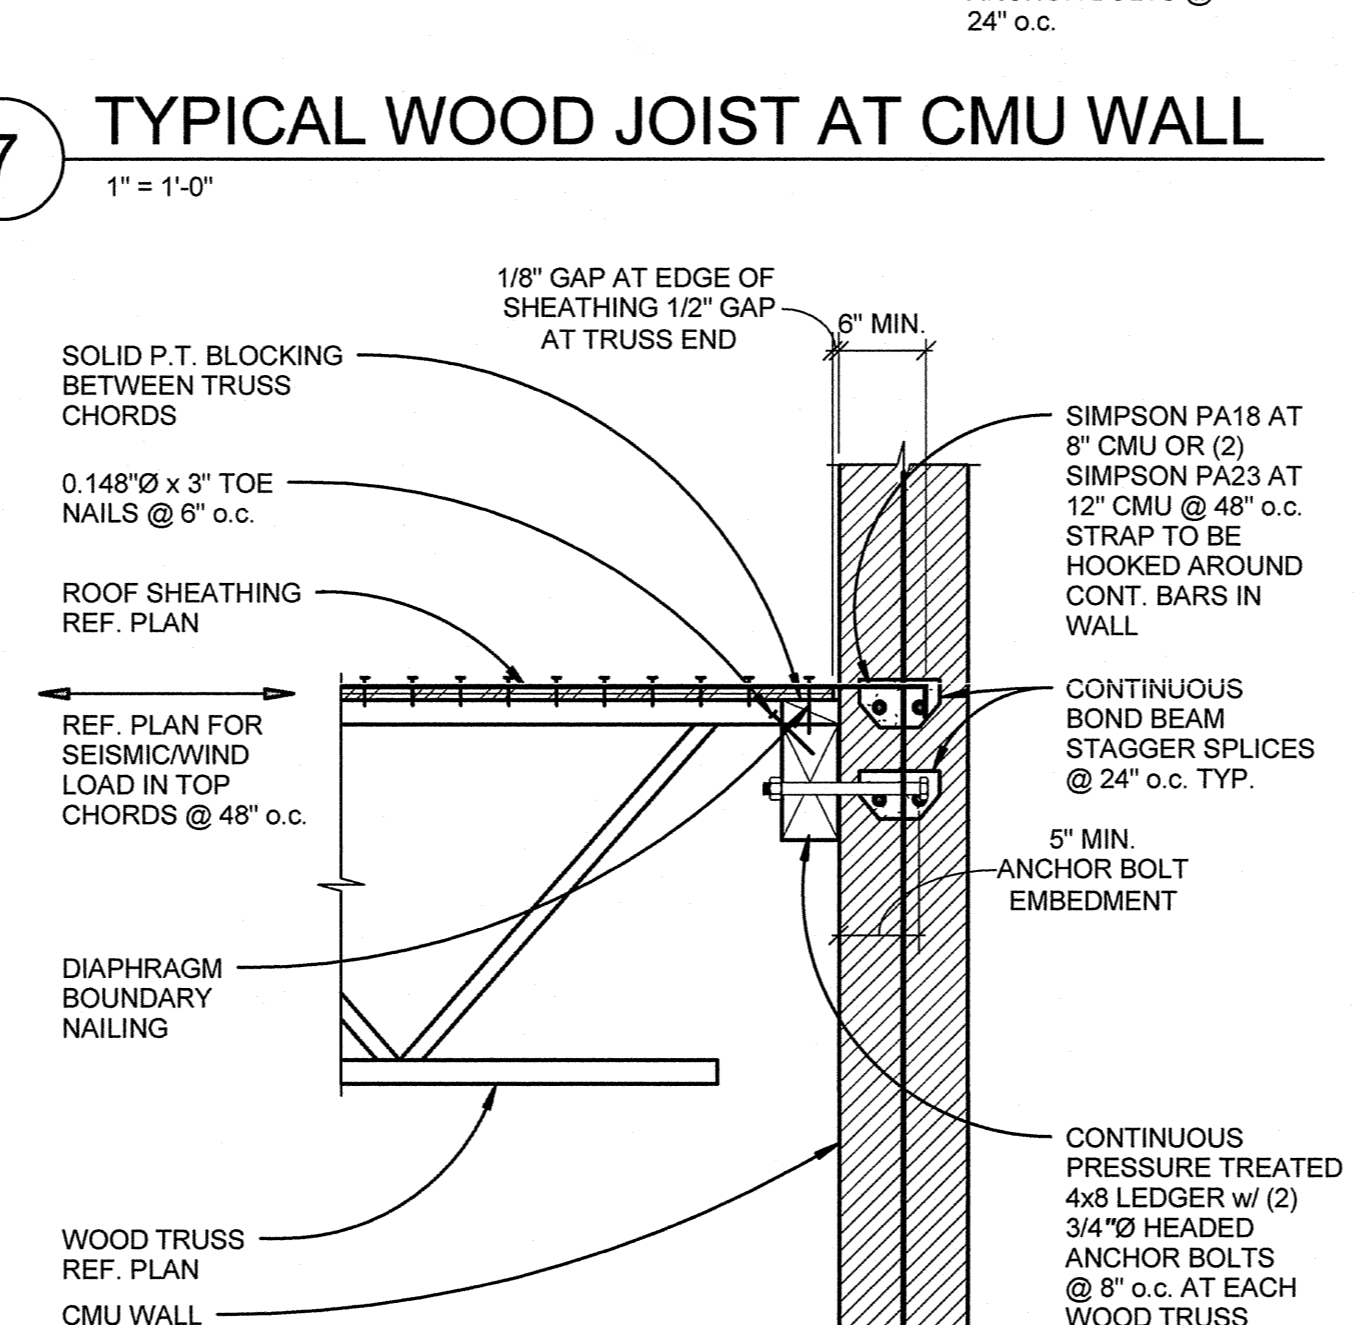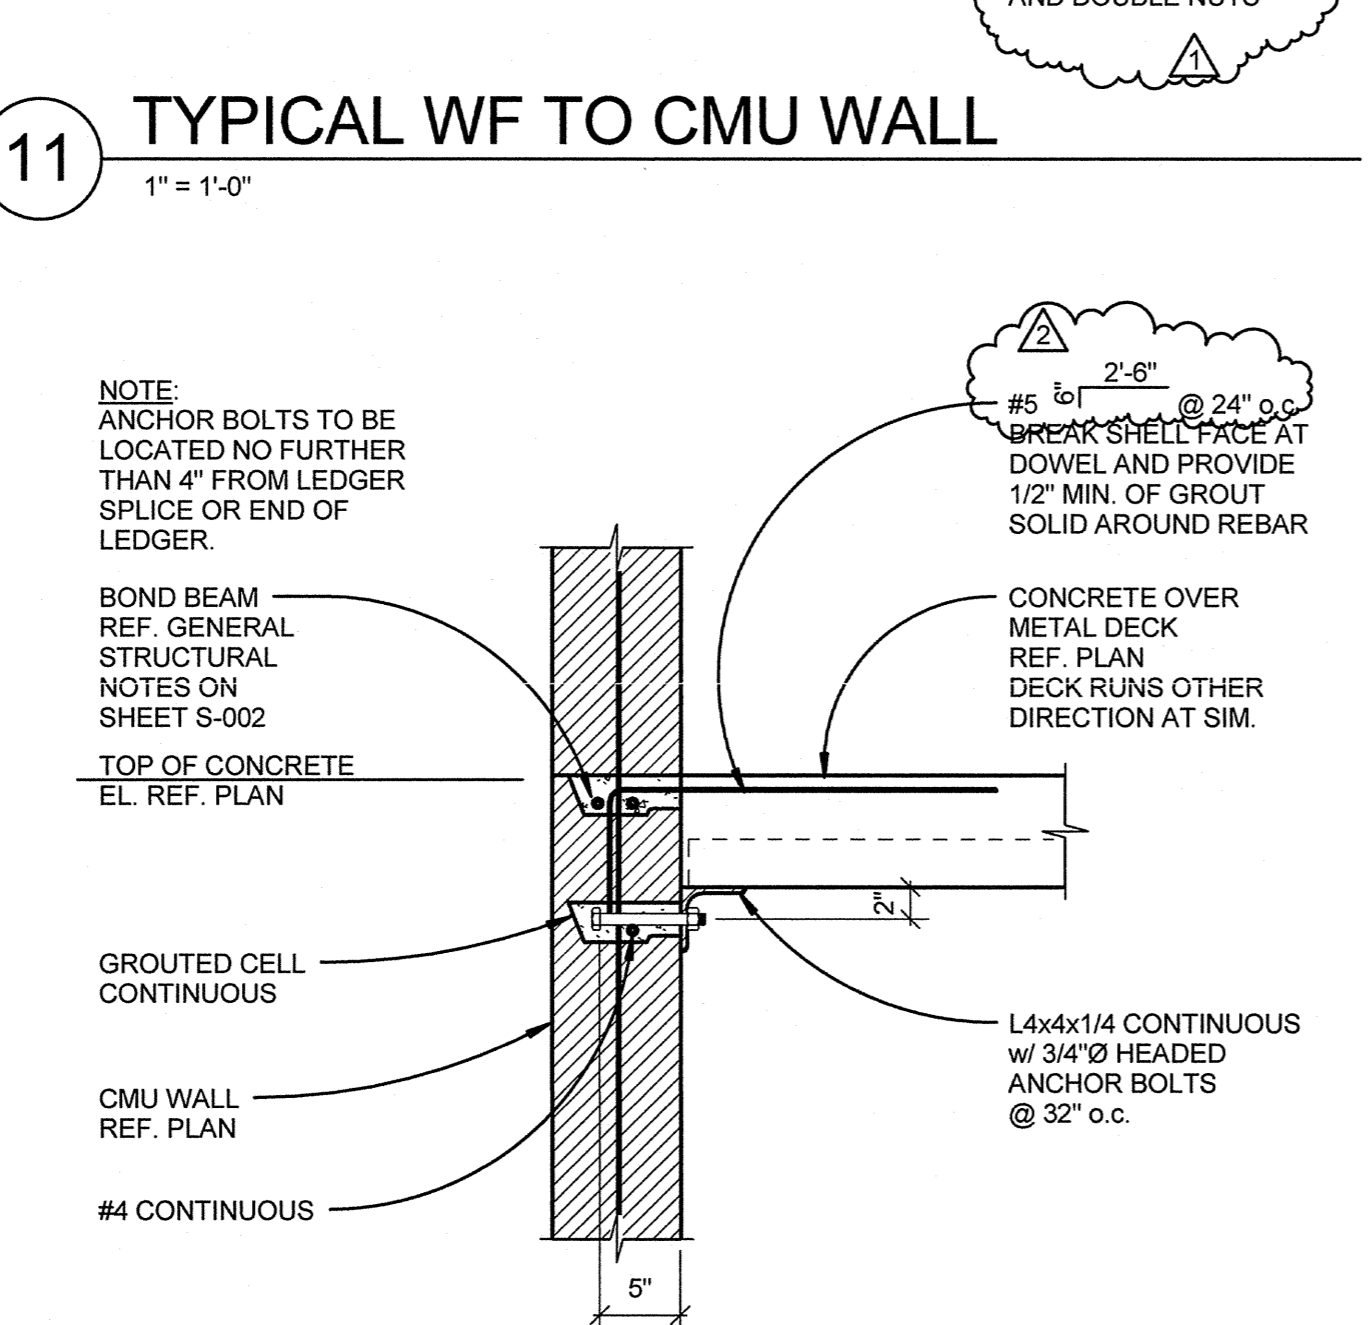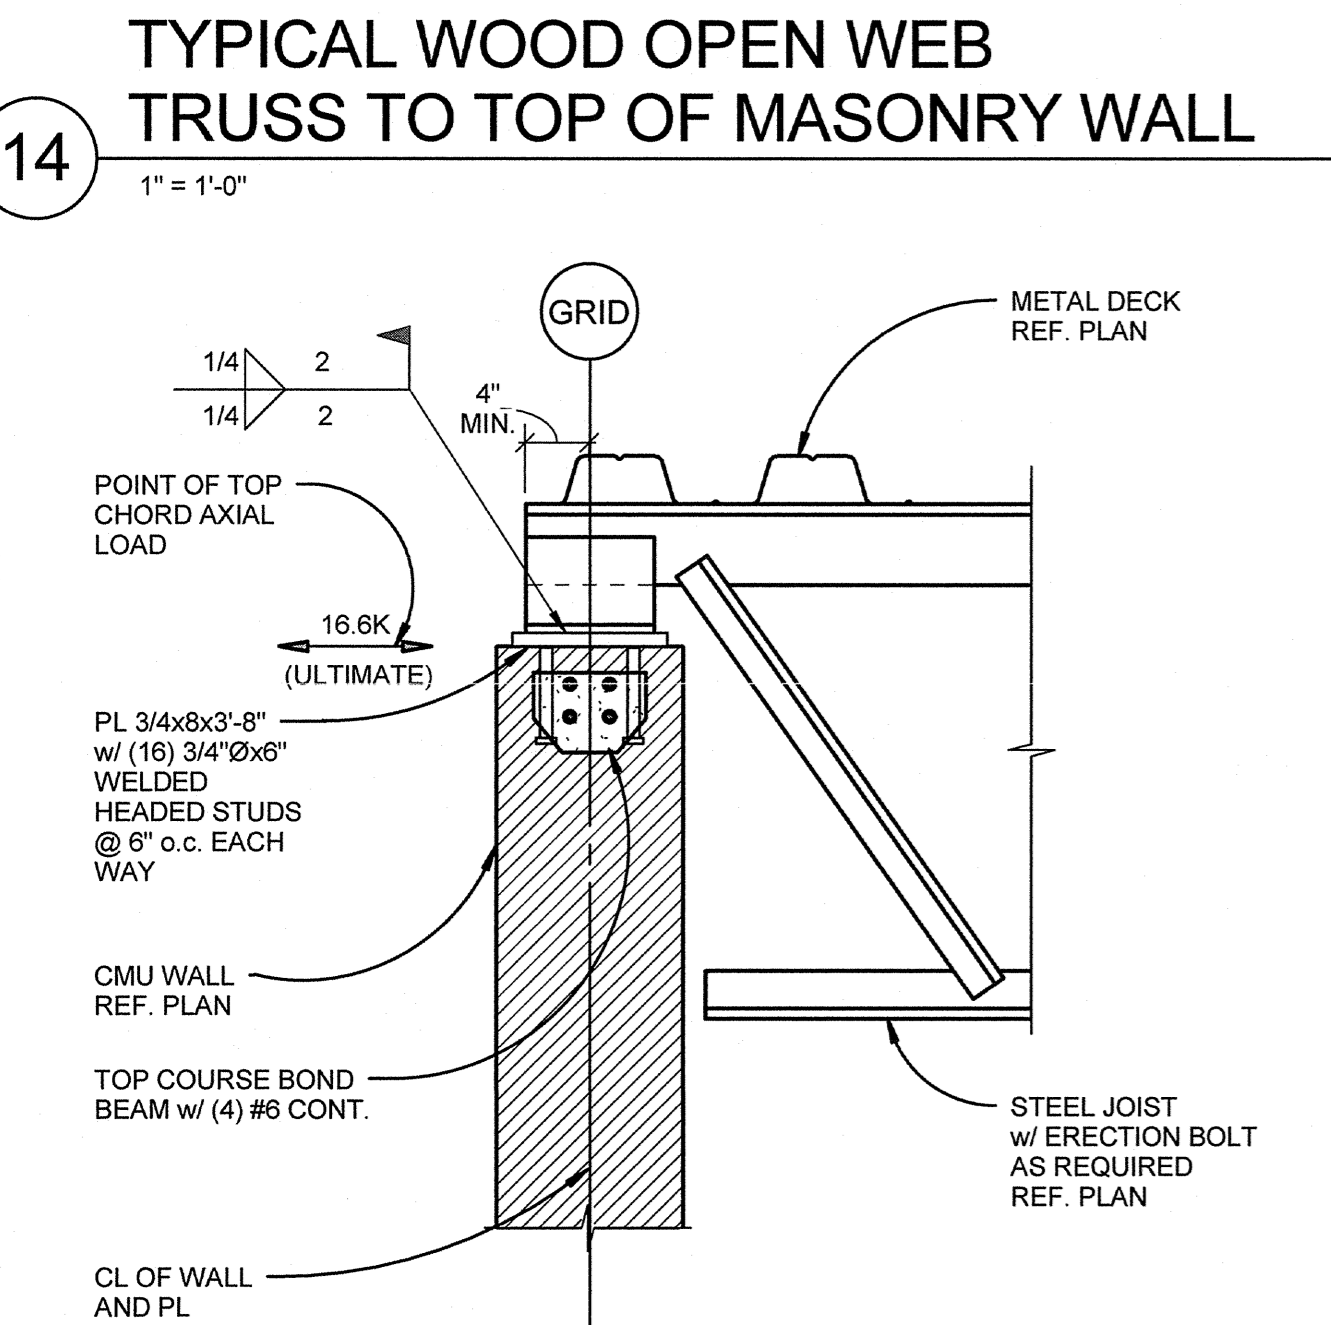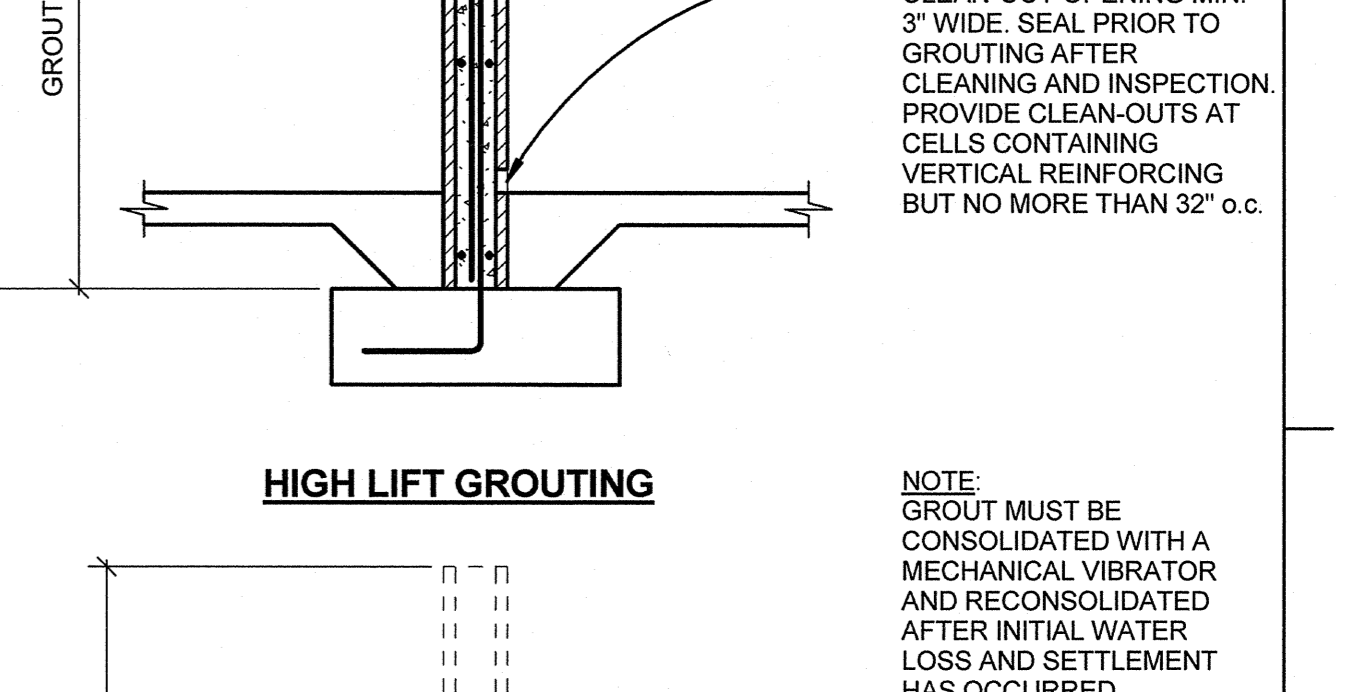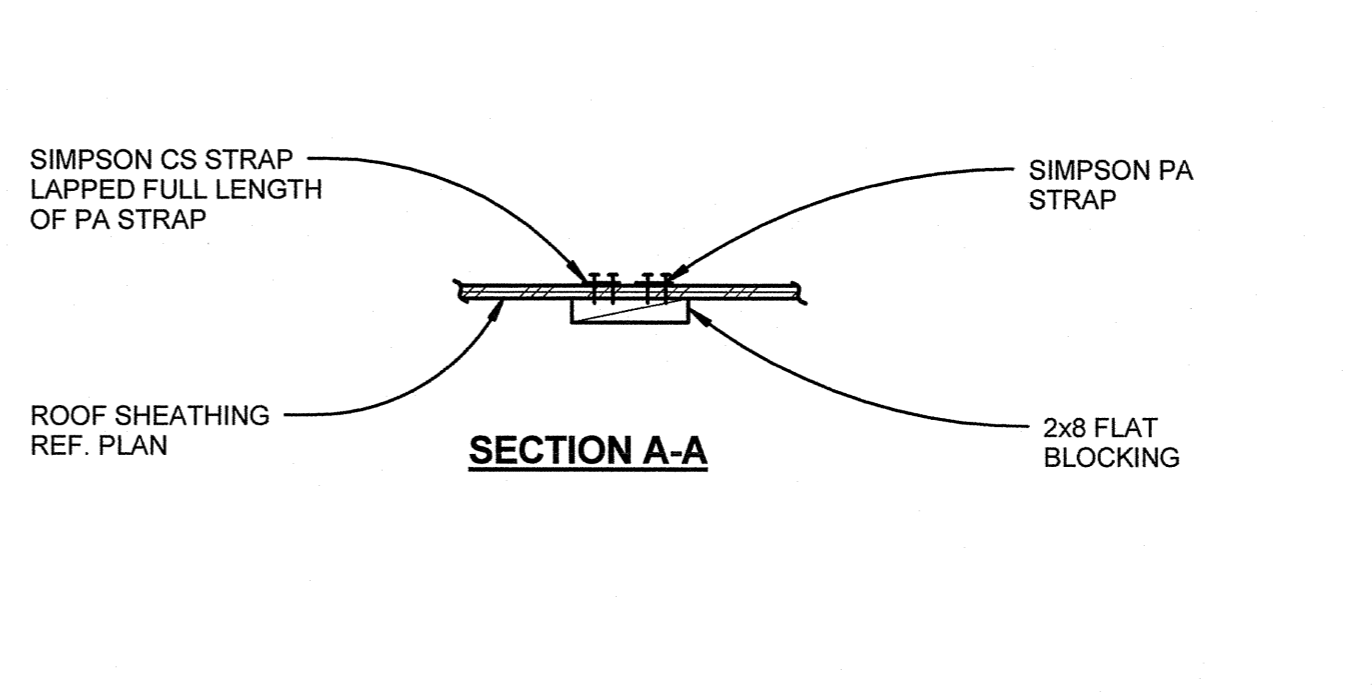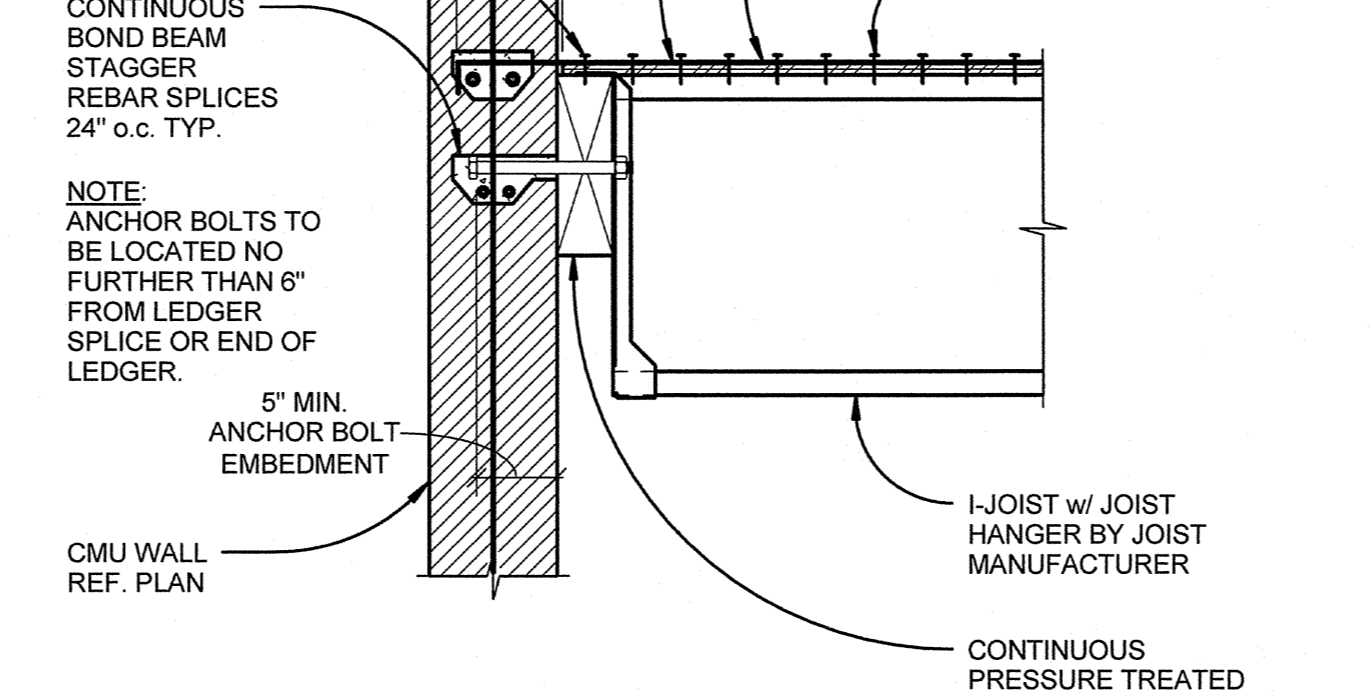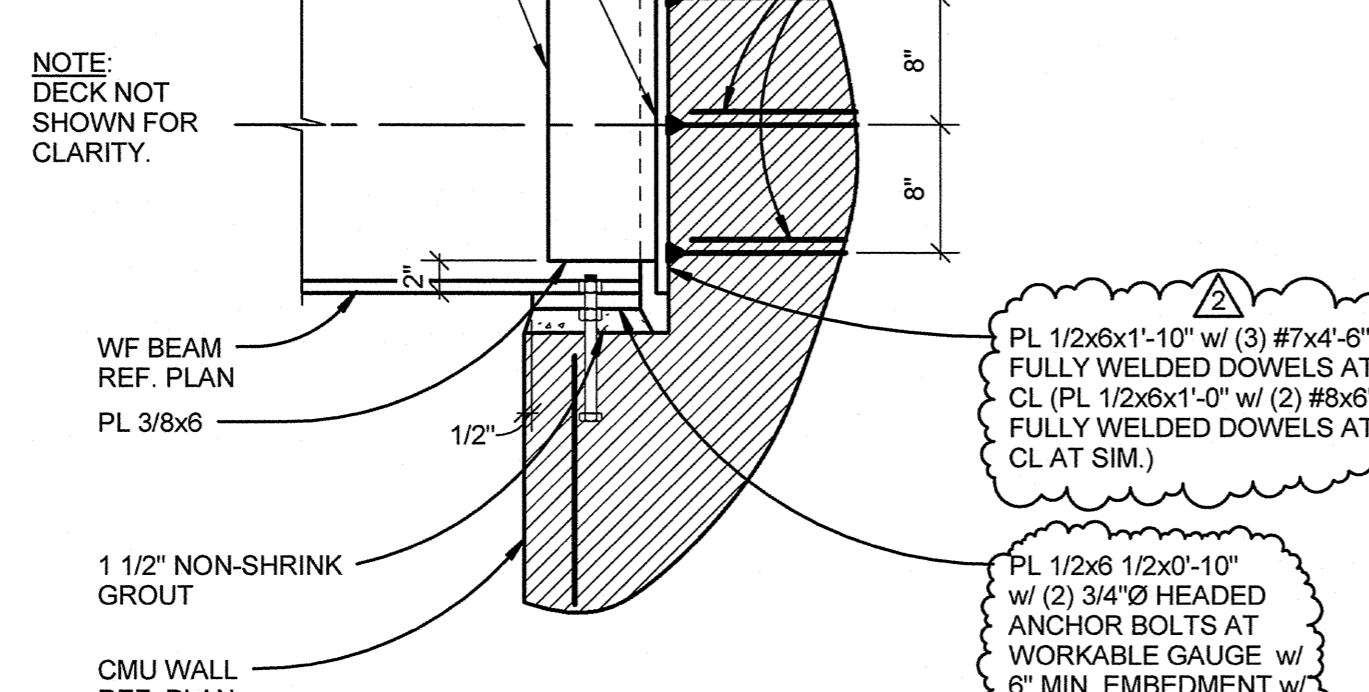

mahlum
ROBERTSON/SHERWOOD ARCHITECTS PC
132 EAST BROADWAY, SUITE 540
EUGENE, OREGON 97401
541-342-8077
www.robertsonsherwood.com

MAHLUM ARCHITECTS INC
1231 NW HOYT, SUITE 102
PORTLAND, OREGON 97209
503-224-4032
71 COLUMBIA, FLOOR 4
SEATTLE, WASHINGTON 98104
206-441-4151
www.mahlum.com

kpff
111 SW Fifth Ave., Suite 2500
Portland, OR 97204
503.227.8251
503.227.7880
www.kpff.com

REGISTERED PROFESSIONAL ENGINEER
STATE OF OREGON
EXPIRES 12-13-16

EUGENE SCHOOL DISTRICT 4J

4J

REPLACEMENT ROOSEVELT MIDDLE SCHOOL
CIP NUMBER 410.566.001
680 EAST 24TH AVENUE
EUGENE, OREGON 97405
CIP NO. 410.566.001


ISSUE DATE: FEBRUARY 18, 2015
ISSUE: CONSTRUCTION DOCUMENTS
VOLUME: PACKAGE 1
PROJECT NO: 213417
DRAWN BY: MF
CHECKED BY: MT
CORPORATE: MAHLUM ARCHITECTS, INC. 2014 ORIGINAL SHEET SIZE: 30"X42"

MARK DATE DESCRIPTION


3	3-13-2015	ADDENDUM 6
2	3-6-2015	ADDENDUM 3
1	2-18-2015	SUPPLEMENTAL INFO 1

ISSUE DATE: FEBRUARY 18, 2015
ISSUE: CONSTRUCTION DOCUMENTS
VOLUME: PACKAGE 1
PROJECT NO: 213417
DRAWN BY: MF
CHECKED BY: MT
CORPORATE: MAHLUM ARCHITECTS, INC. 2014 ORIGINAL SHEET SIZE: 30"X42"


S-401

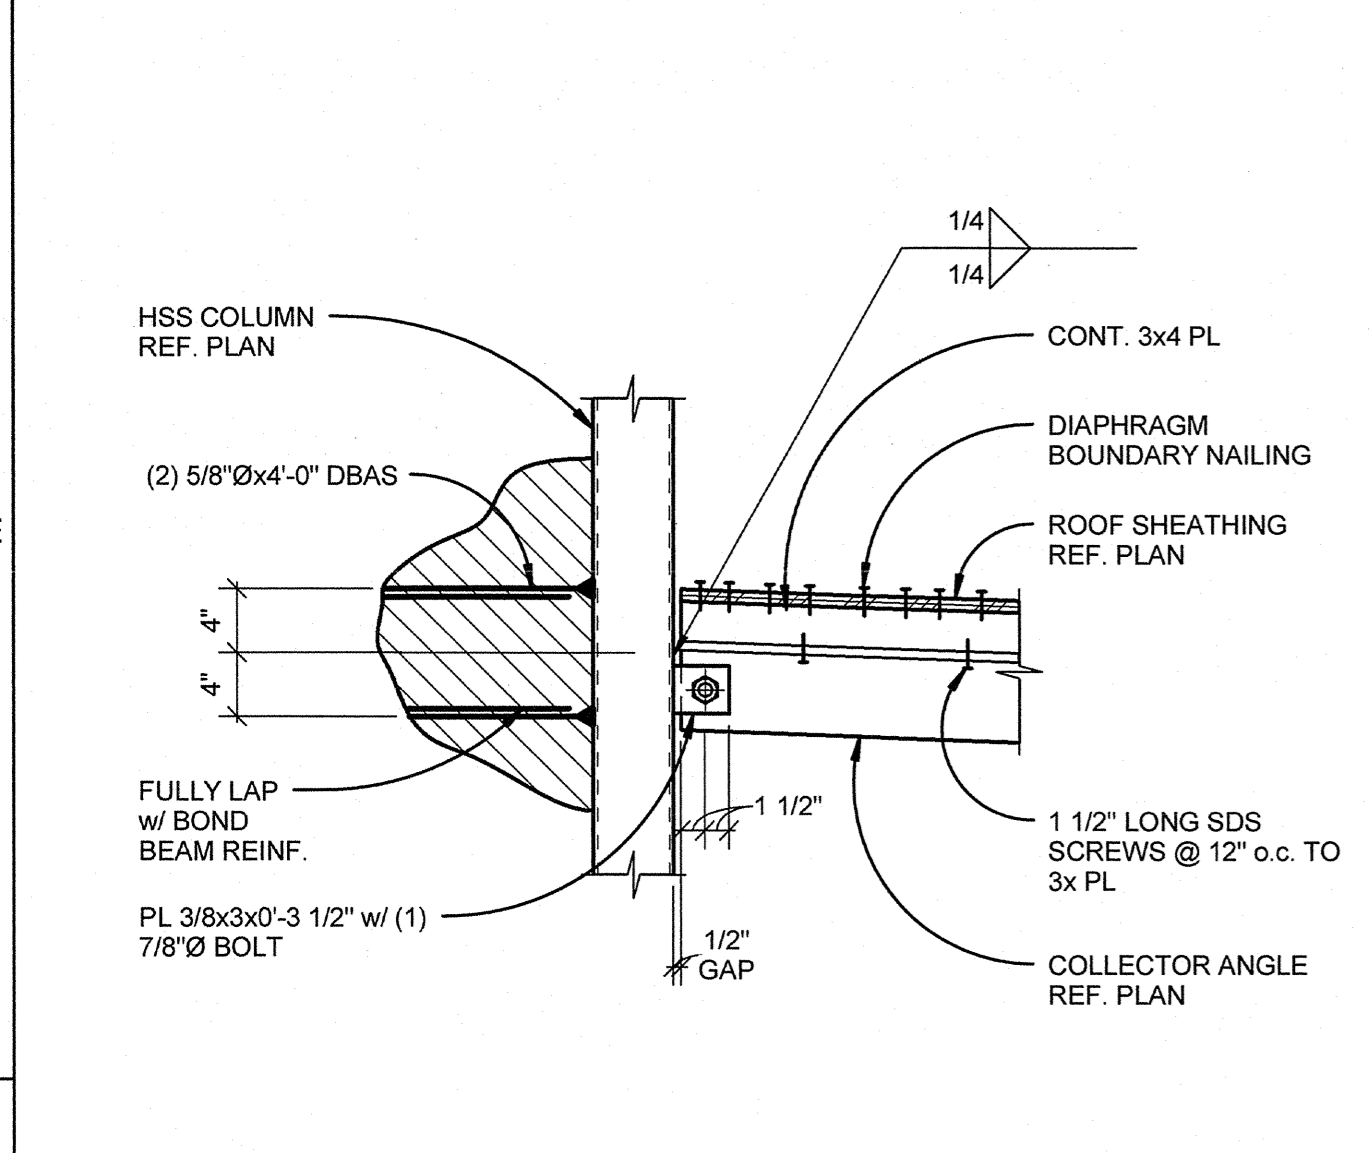


17 COLLECTOR CONNECTION
1" = 1'-0"

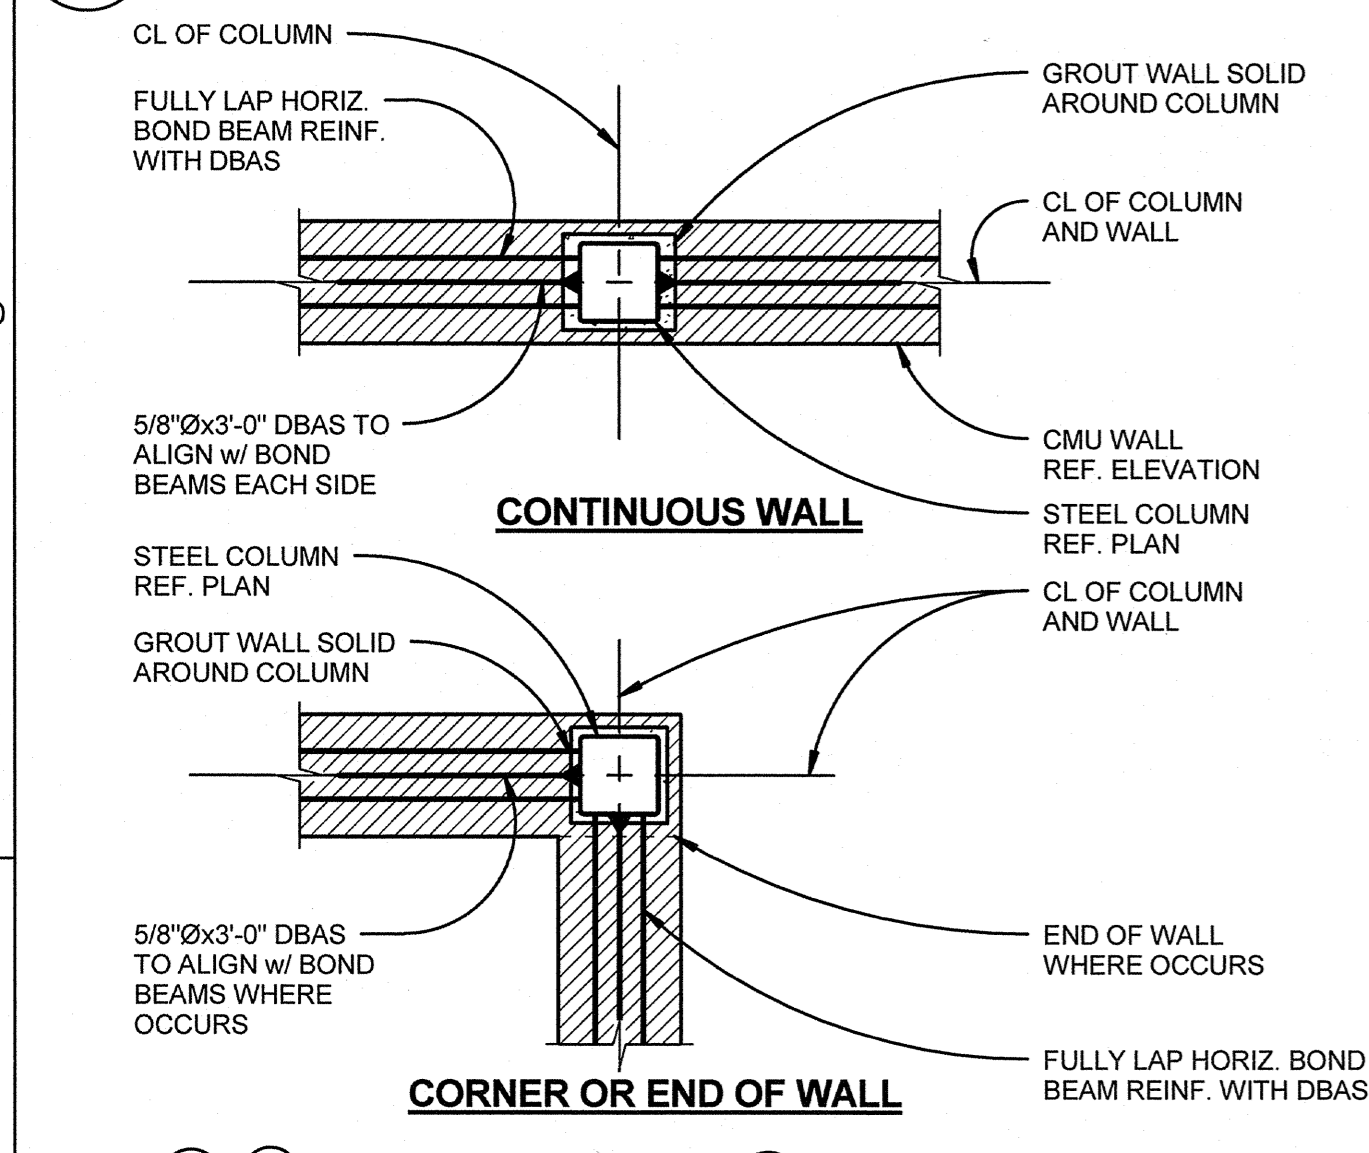

18 TYPICAL HSS COLUMN EMBEDDED IN CMU WALL
1" = 1'-0"

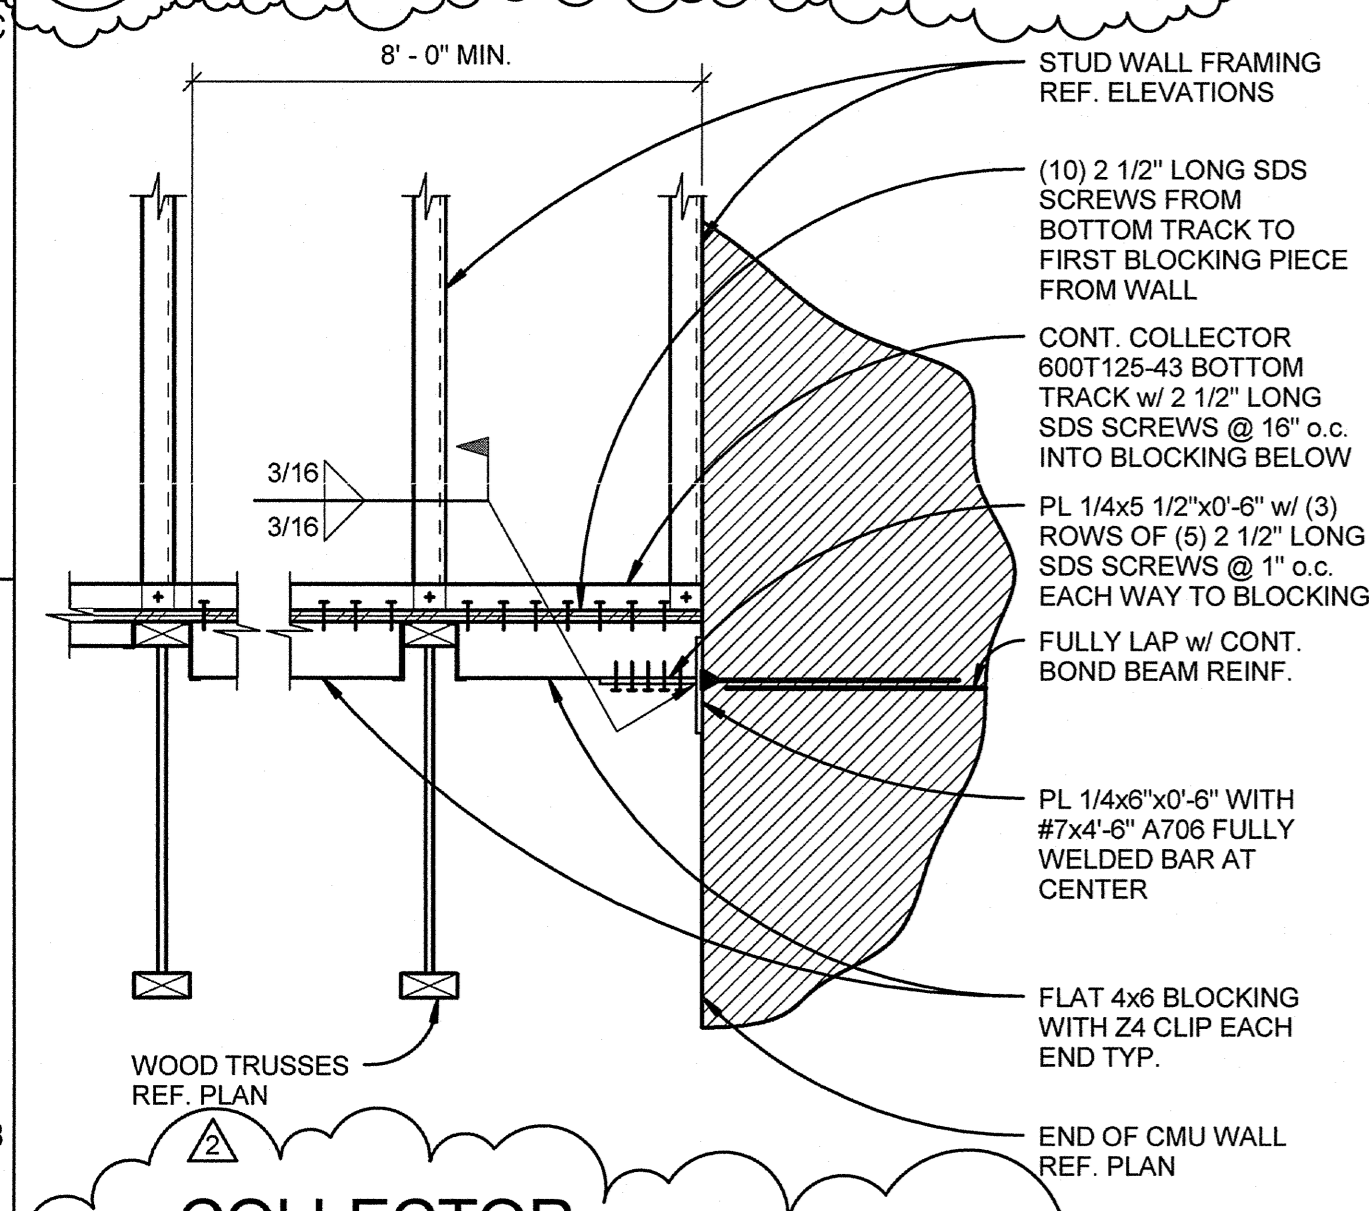


19 COLLECTOR CONNECTION TO CMU WALL
1" = 1'-0"

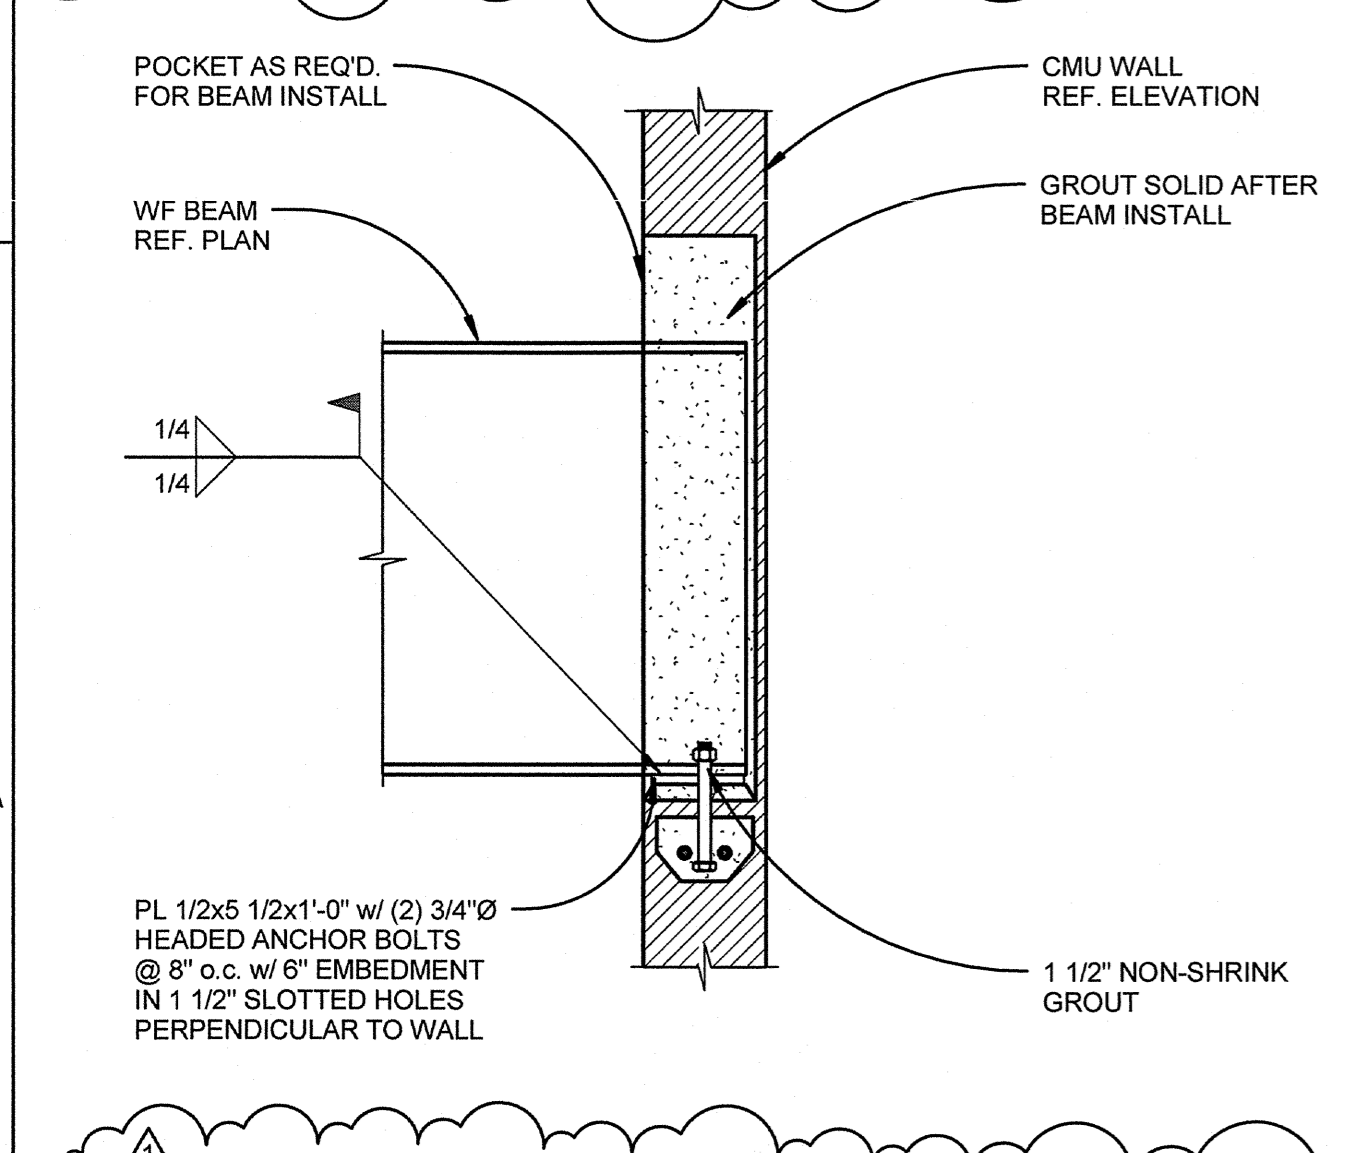


20 W27 TO CMU WALL
1" = 1'-0"


13 NOT USED

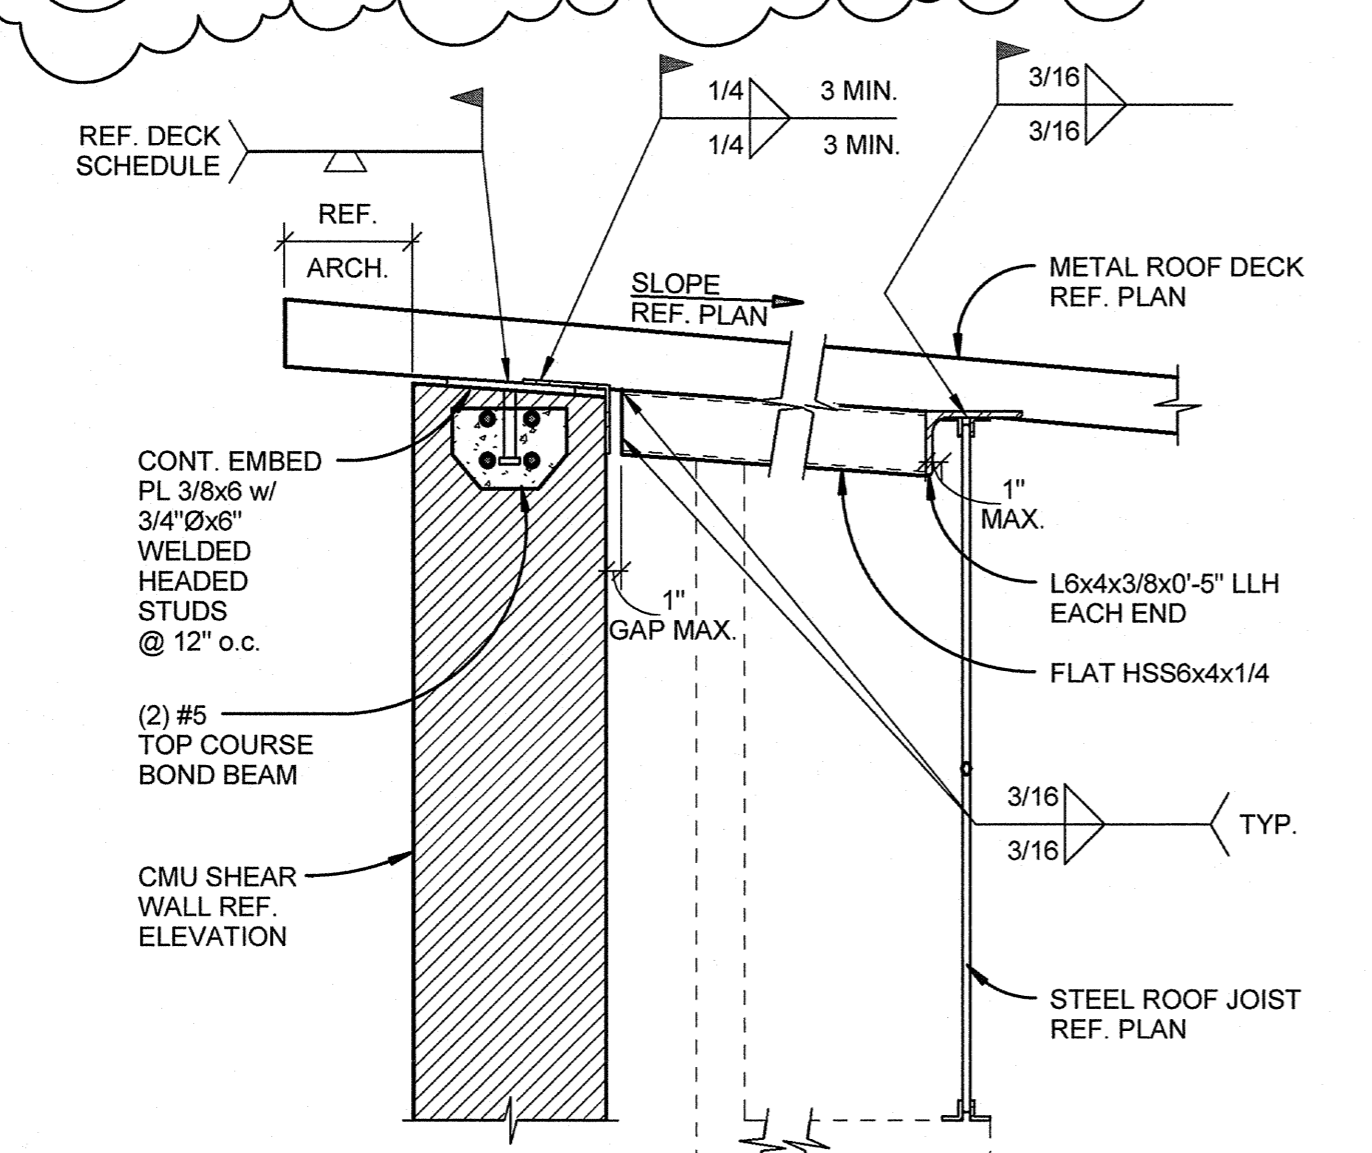


14 HSS AT EQUIPMENT SUPPORT
1" = 1'-0"

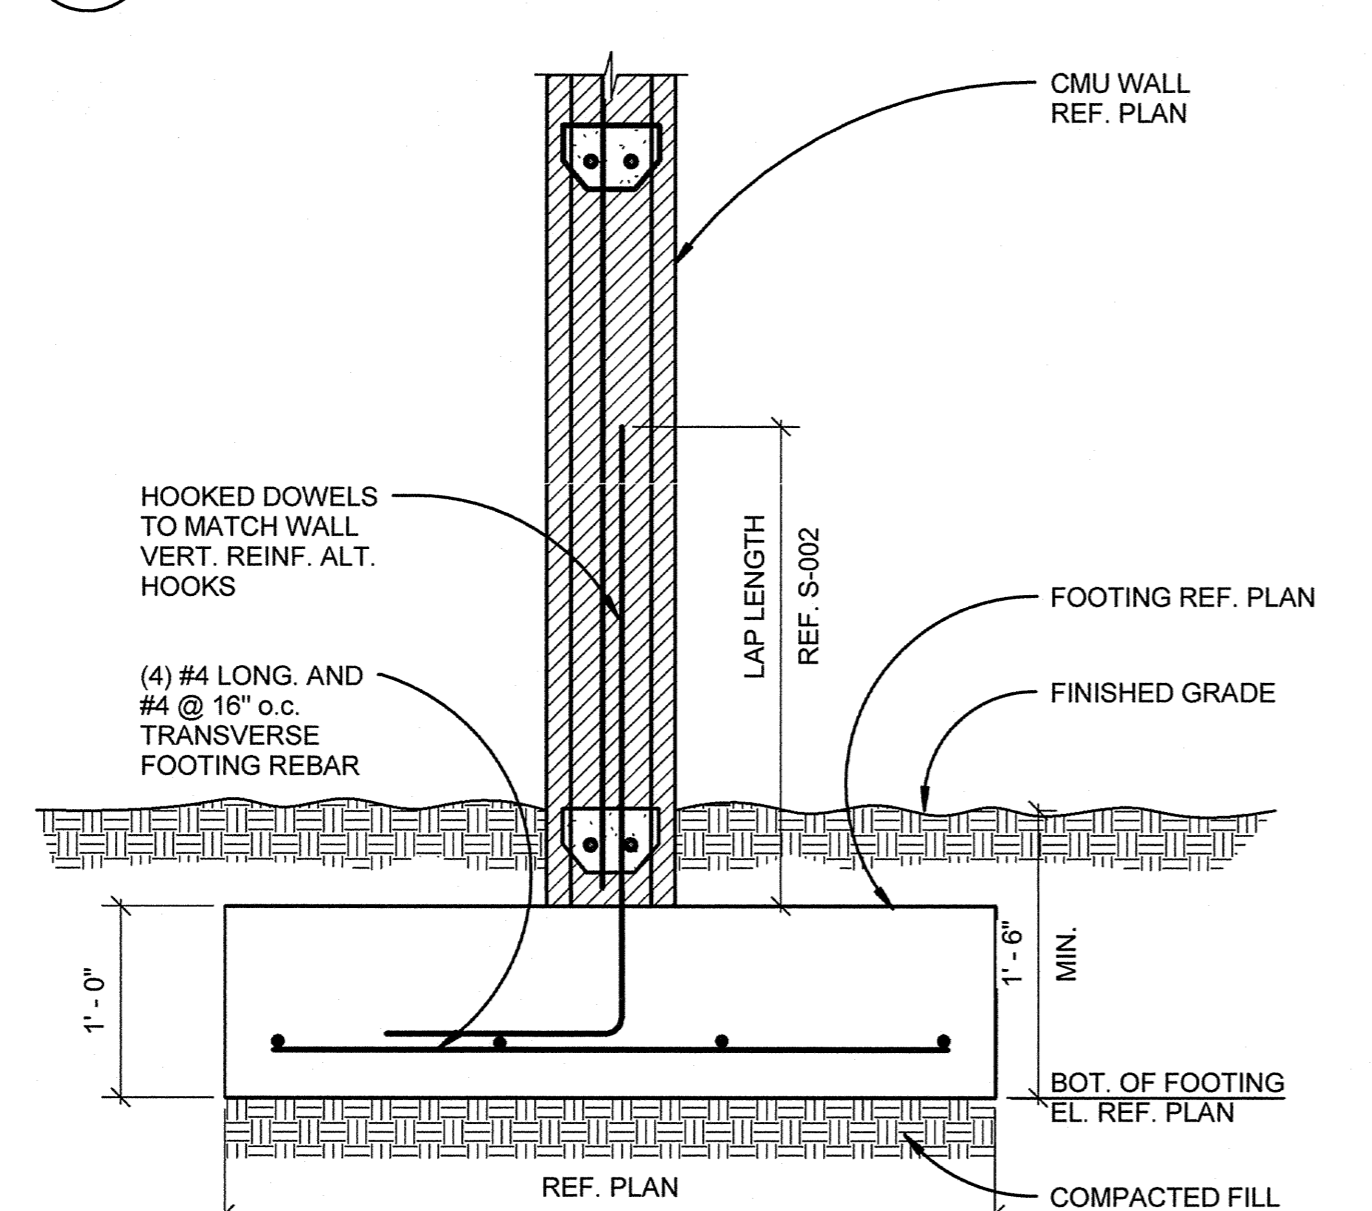


15 SERVICE YARD WALL FOOTING
1" = 1'-0"

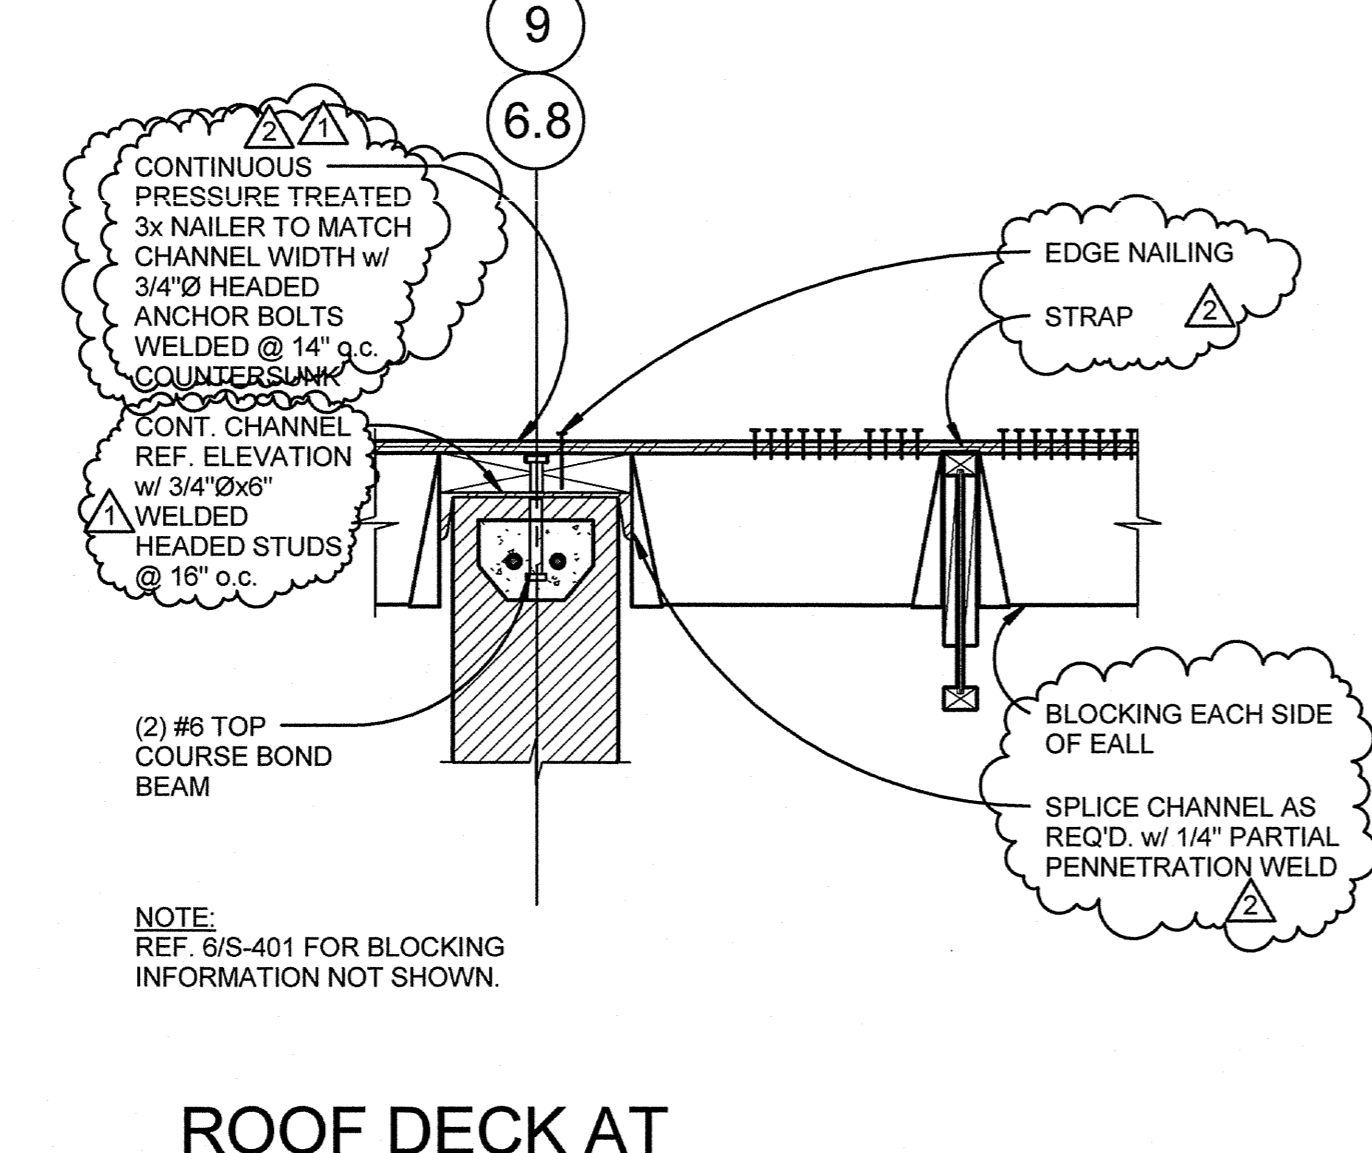


16 ROOF DECK AT CHANNEL COLLECTOR
1" = 1'-0"

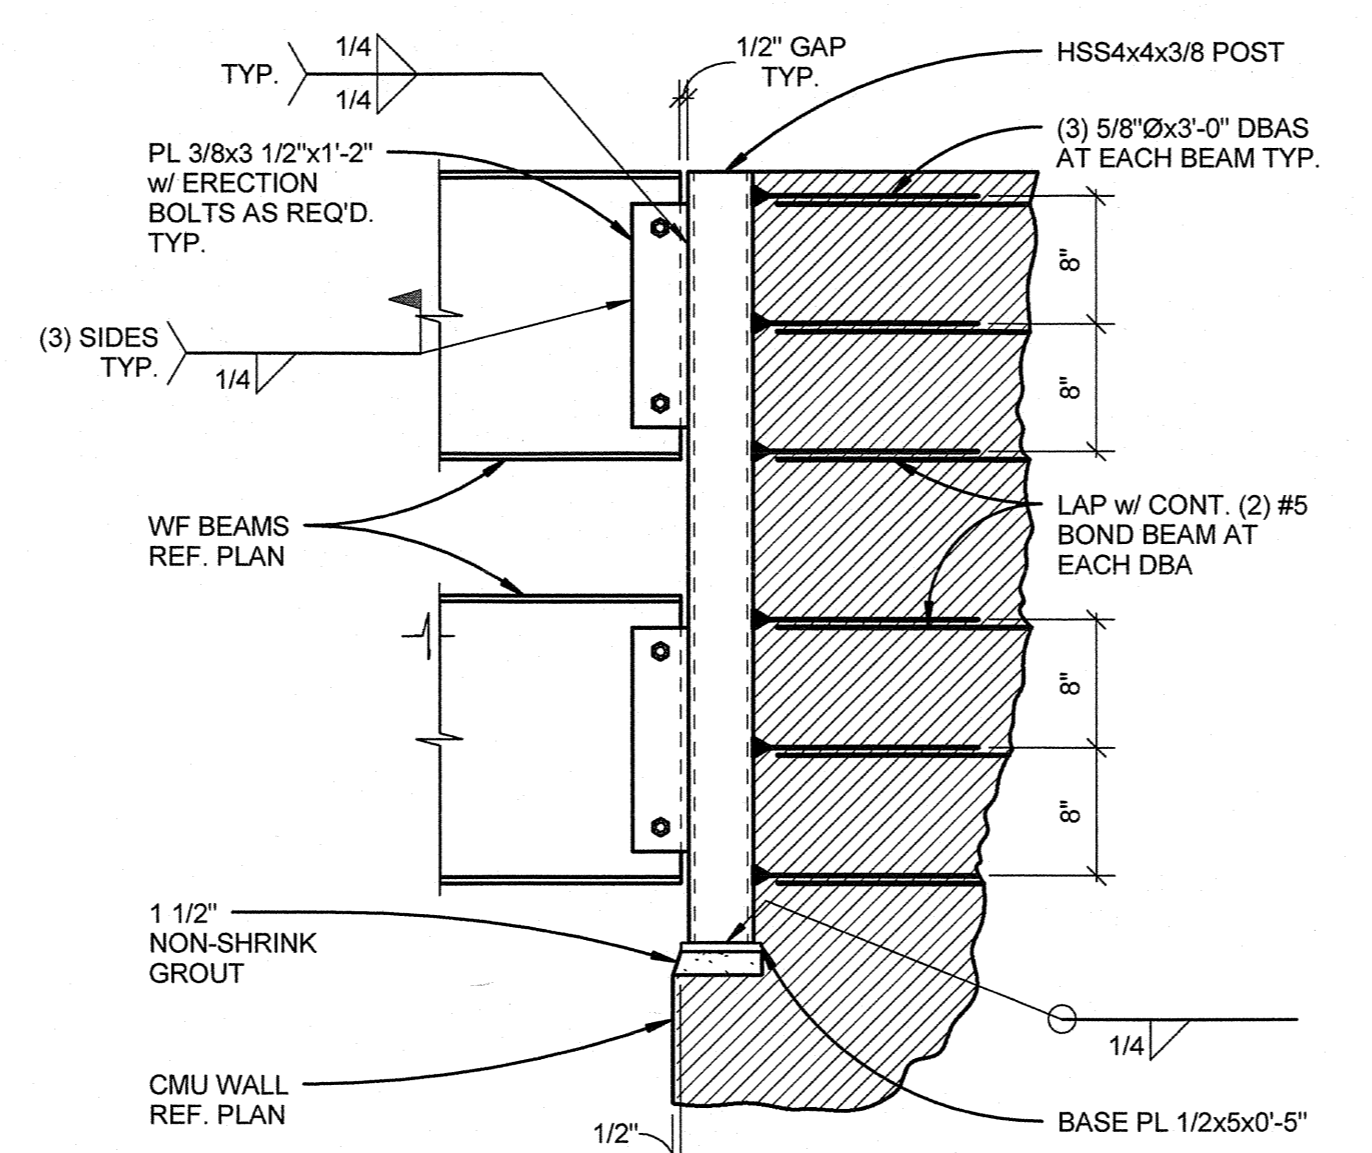


9 MULTIPLE BEAM TO CMU WALL
1" = 1'-0"

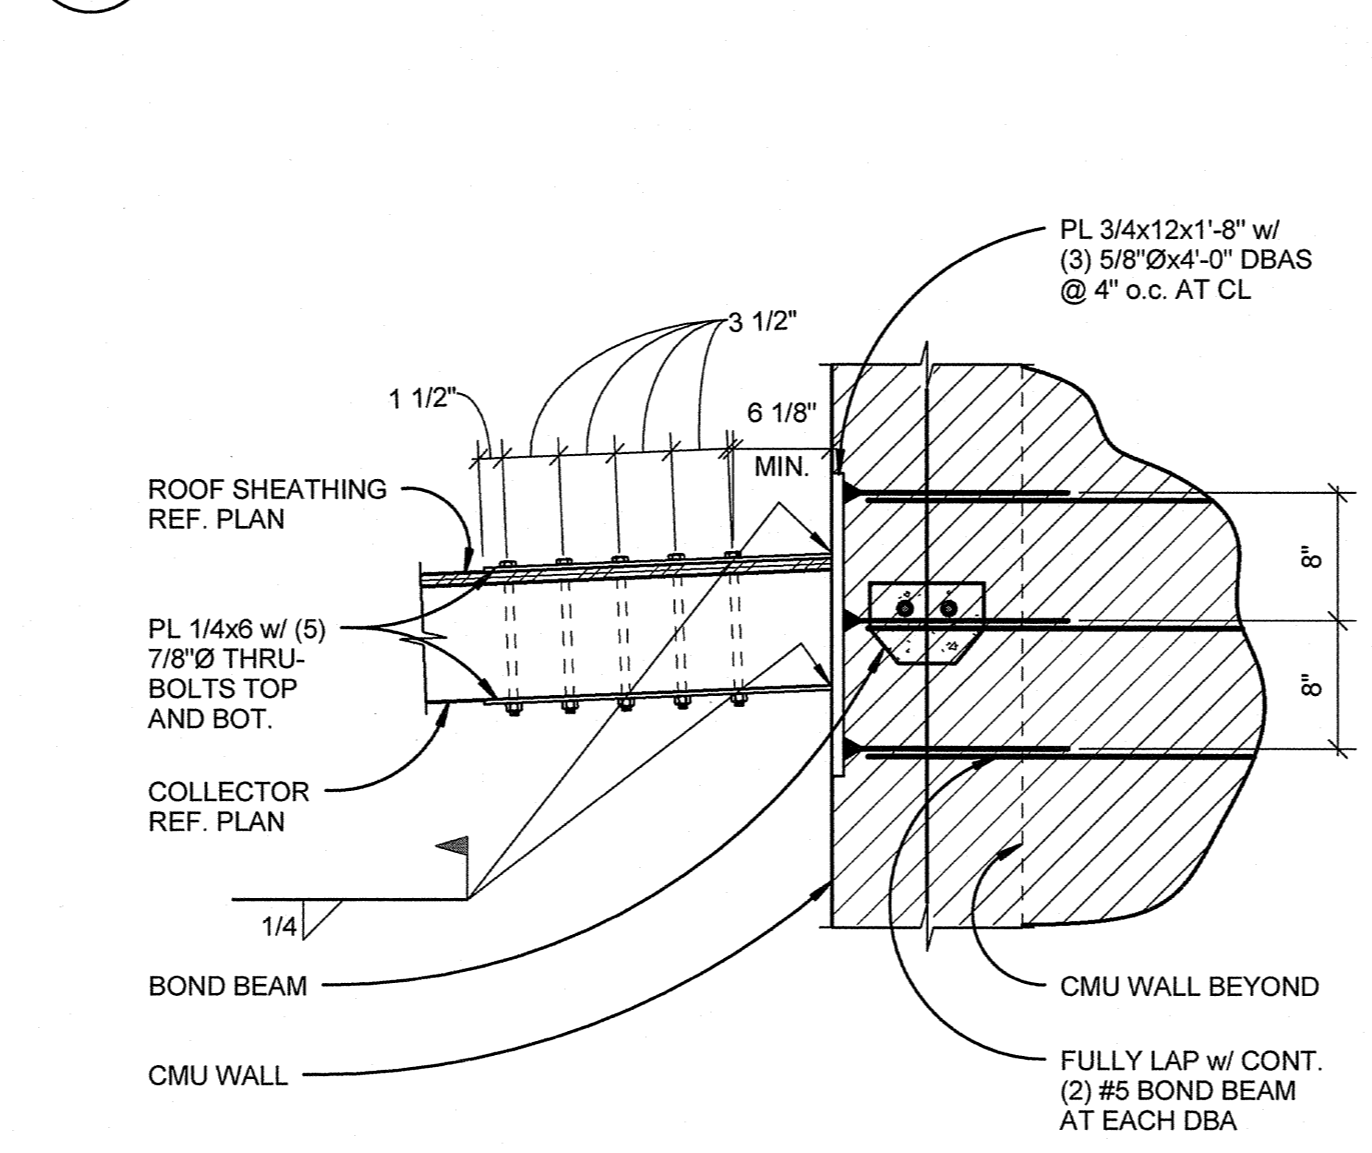


10 COLLECTOR ANCHORAGE
1" = 1'-0"

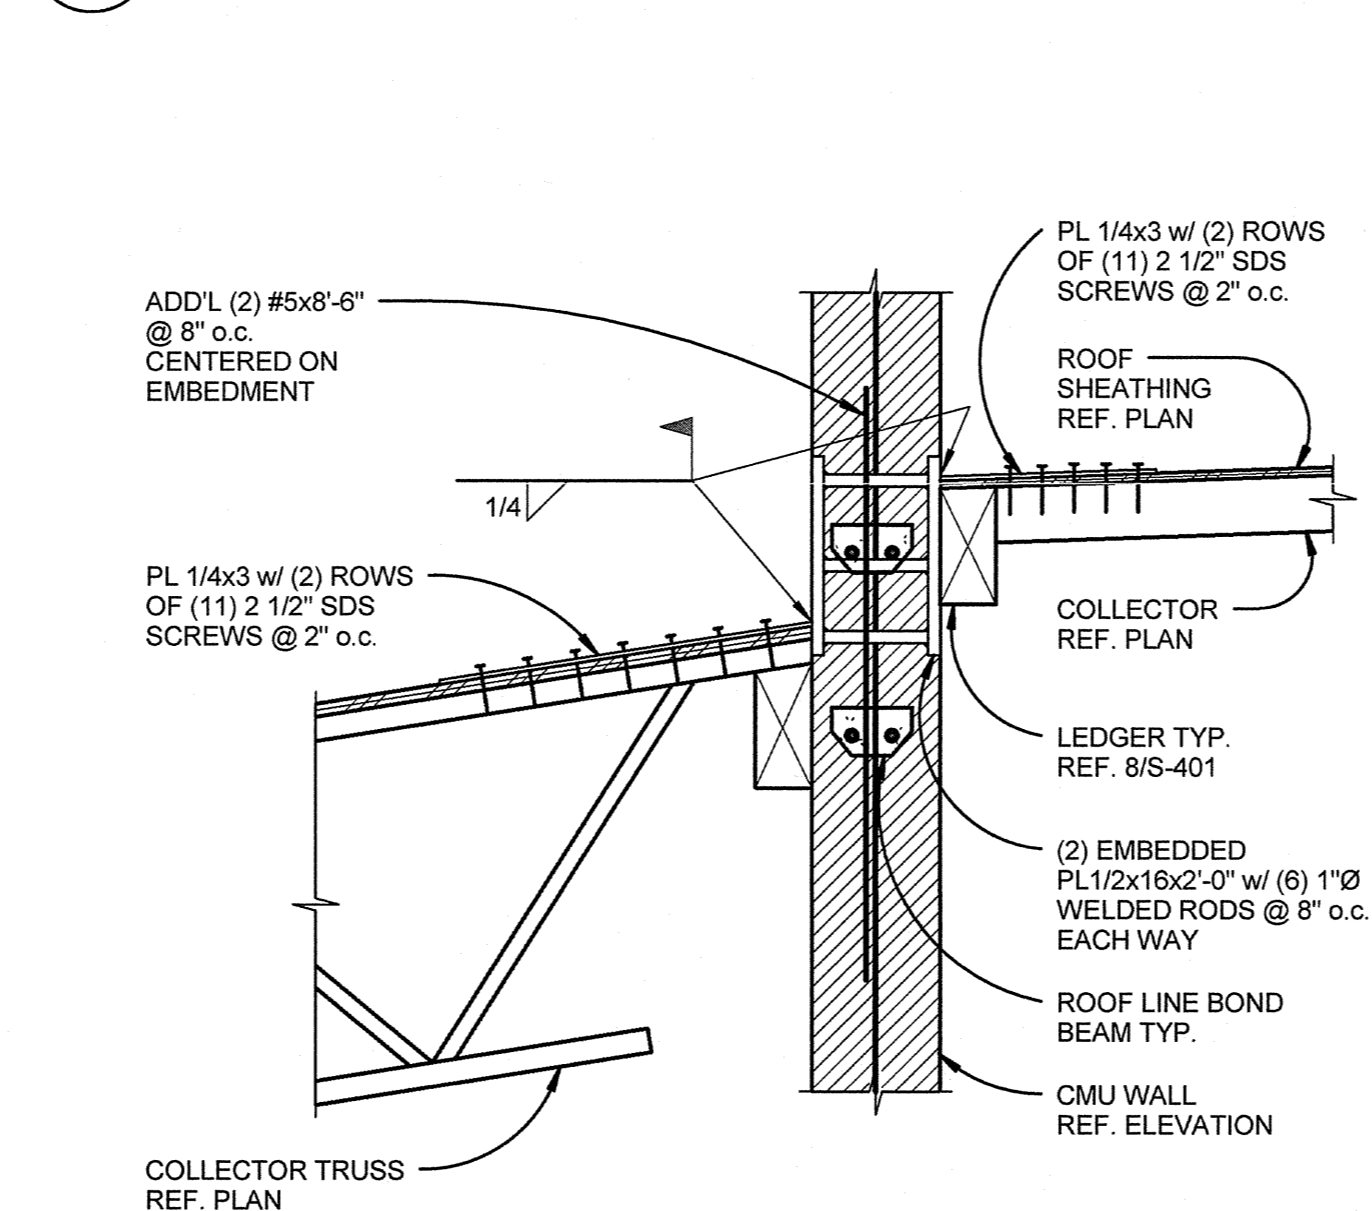


11 COLLECTOR CONNECTION
1" = 1'-0"

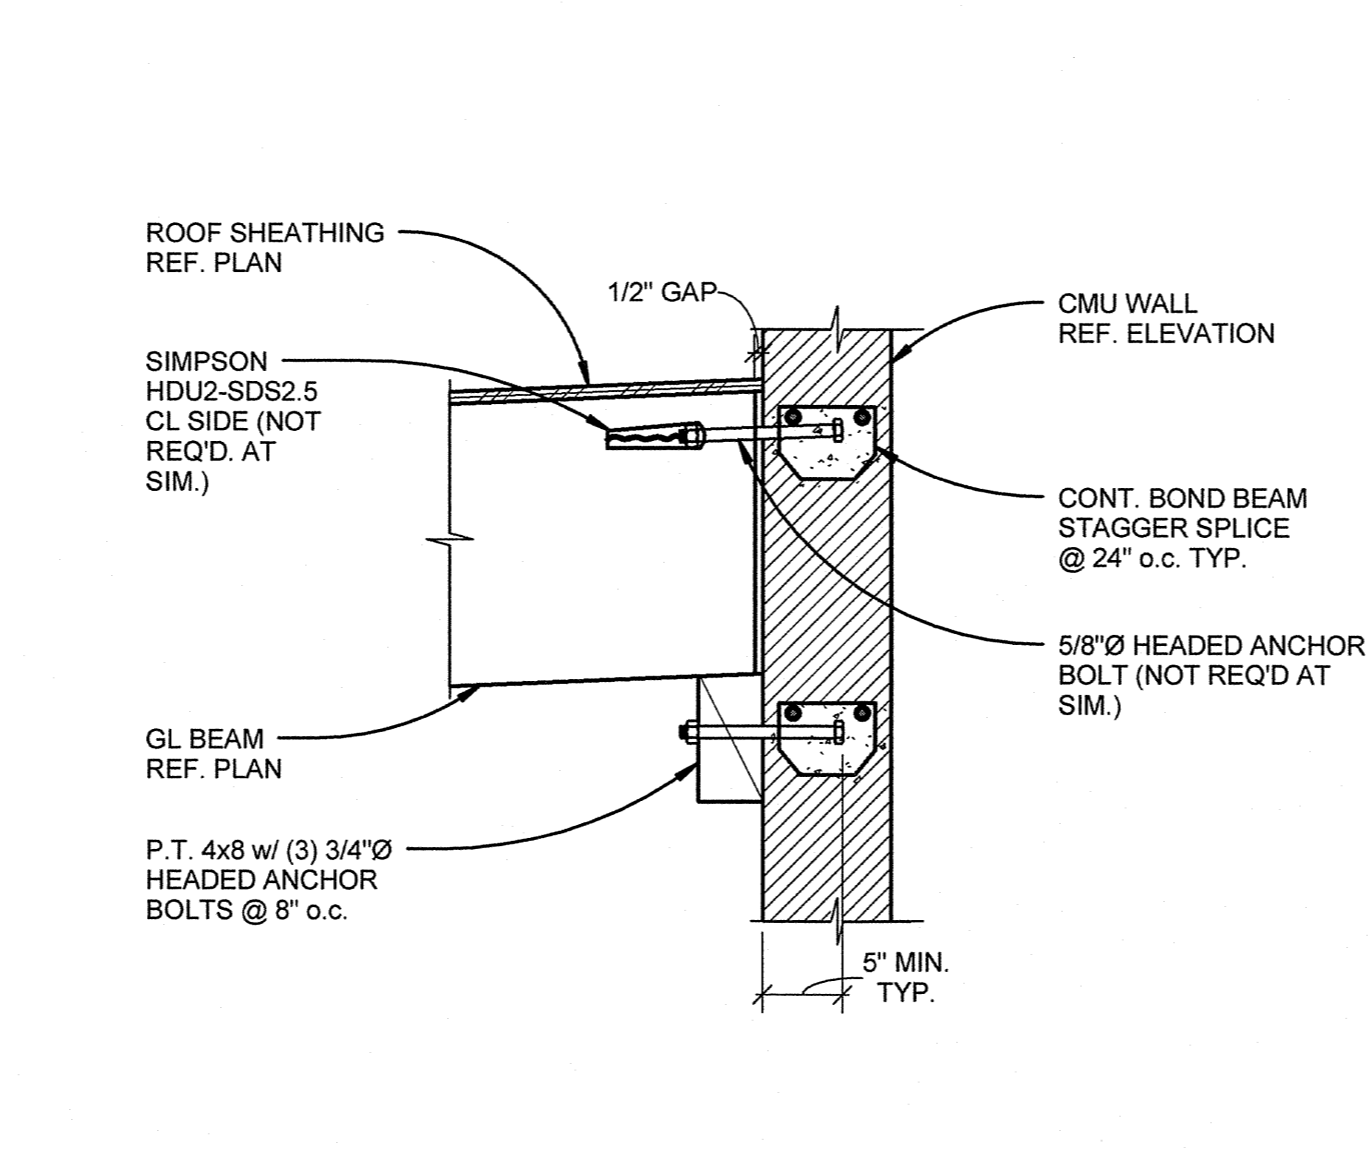


12 GLULAM TO CMU WALL
1" = 1'-0"

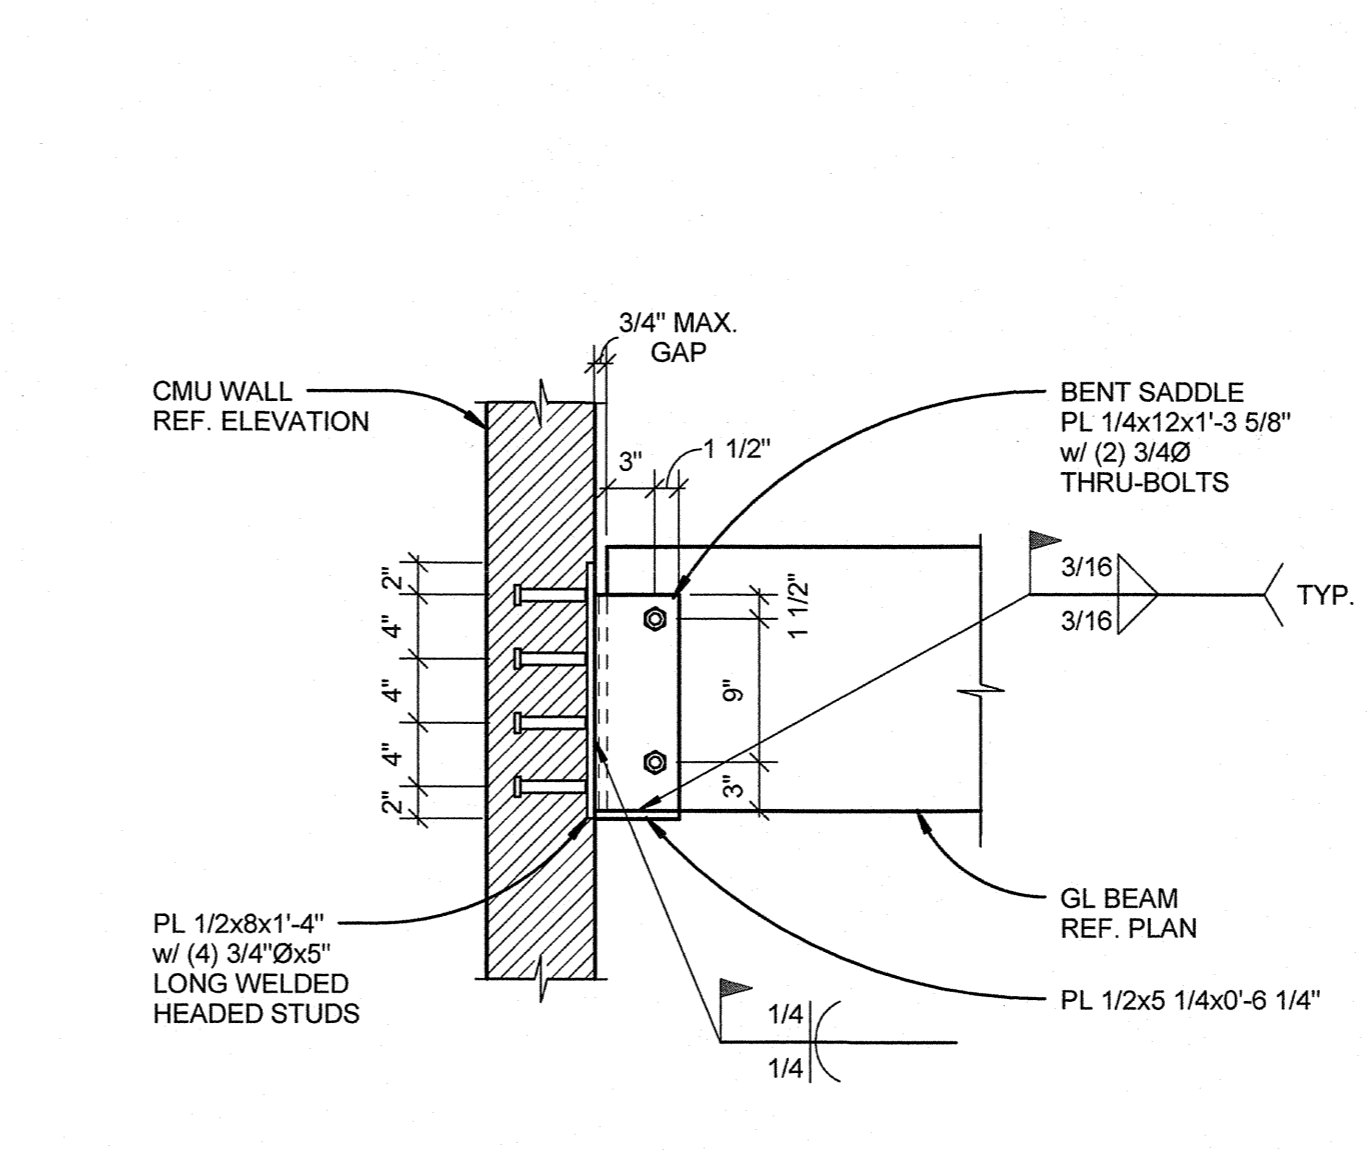


5 GL BEAM TO CMU WALL CONNECTION
1" = 1'-0"

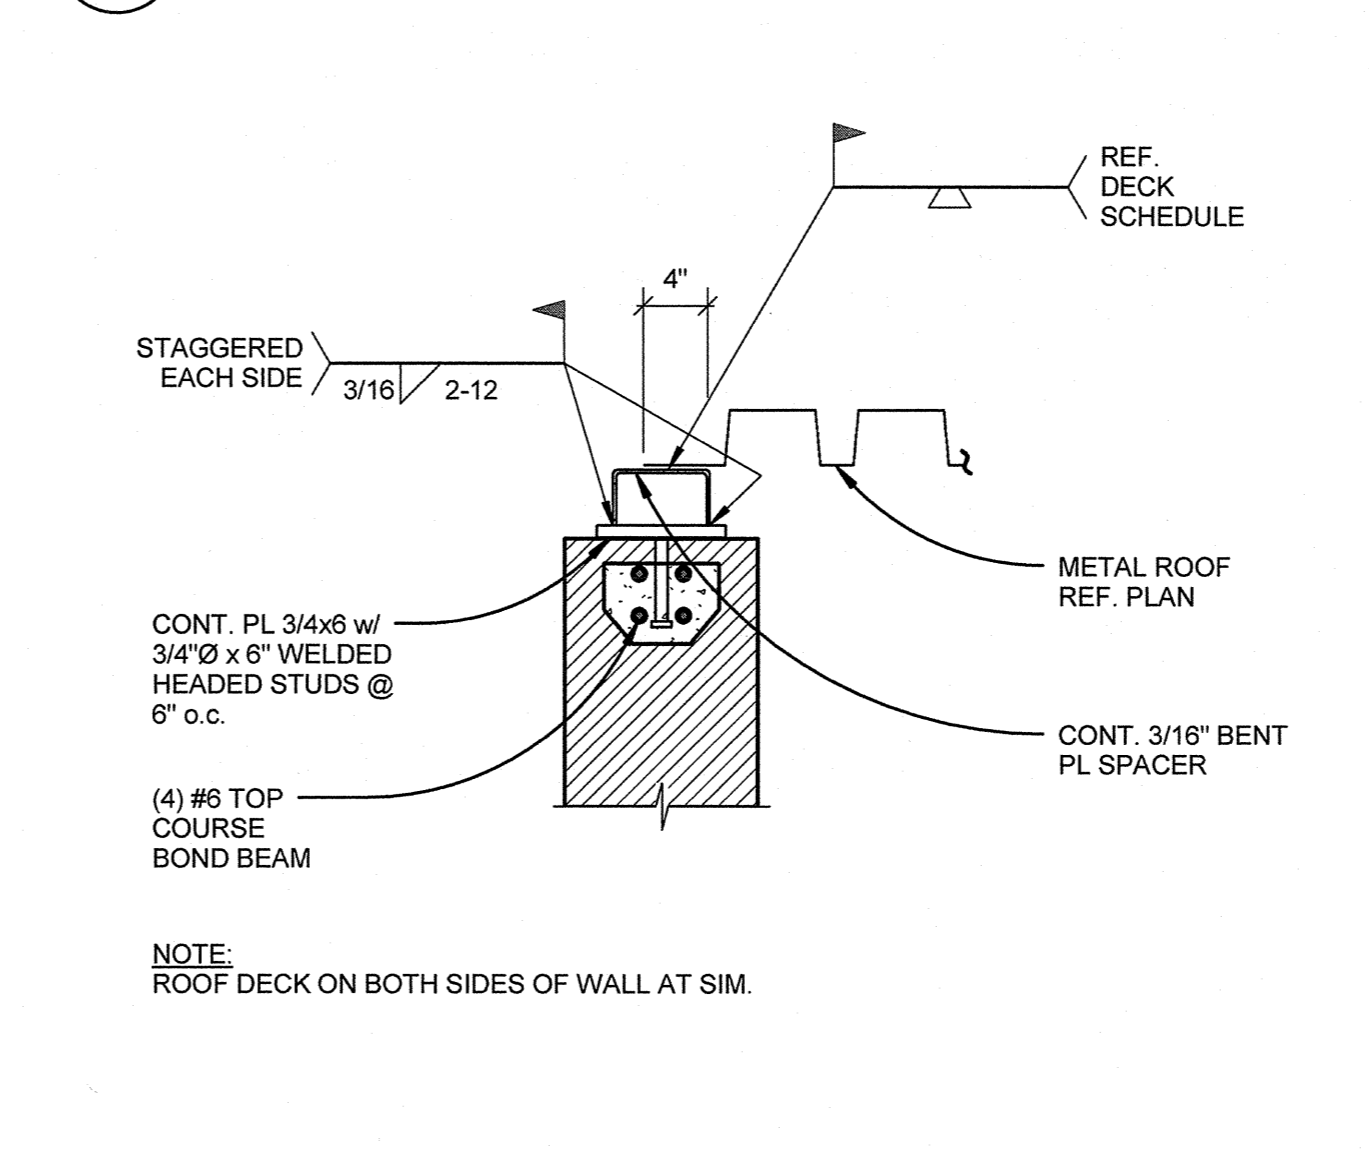


6 GYM ROOF DECK PARALLEL TO CMU WALL
1" = 1'-0"

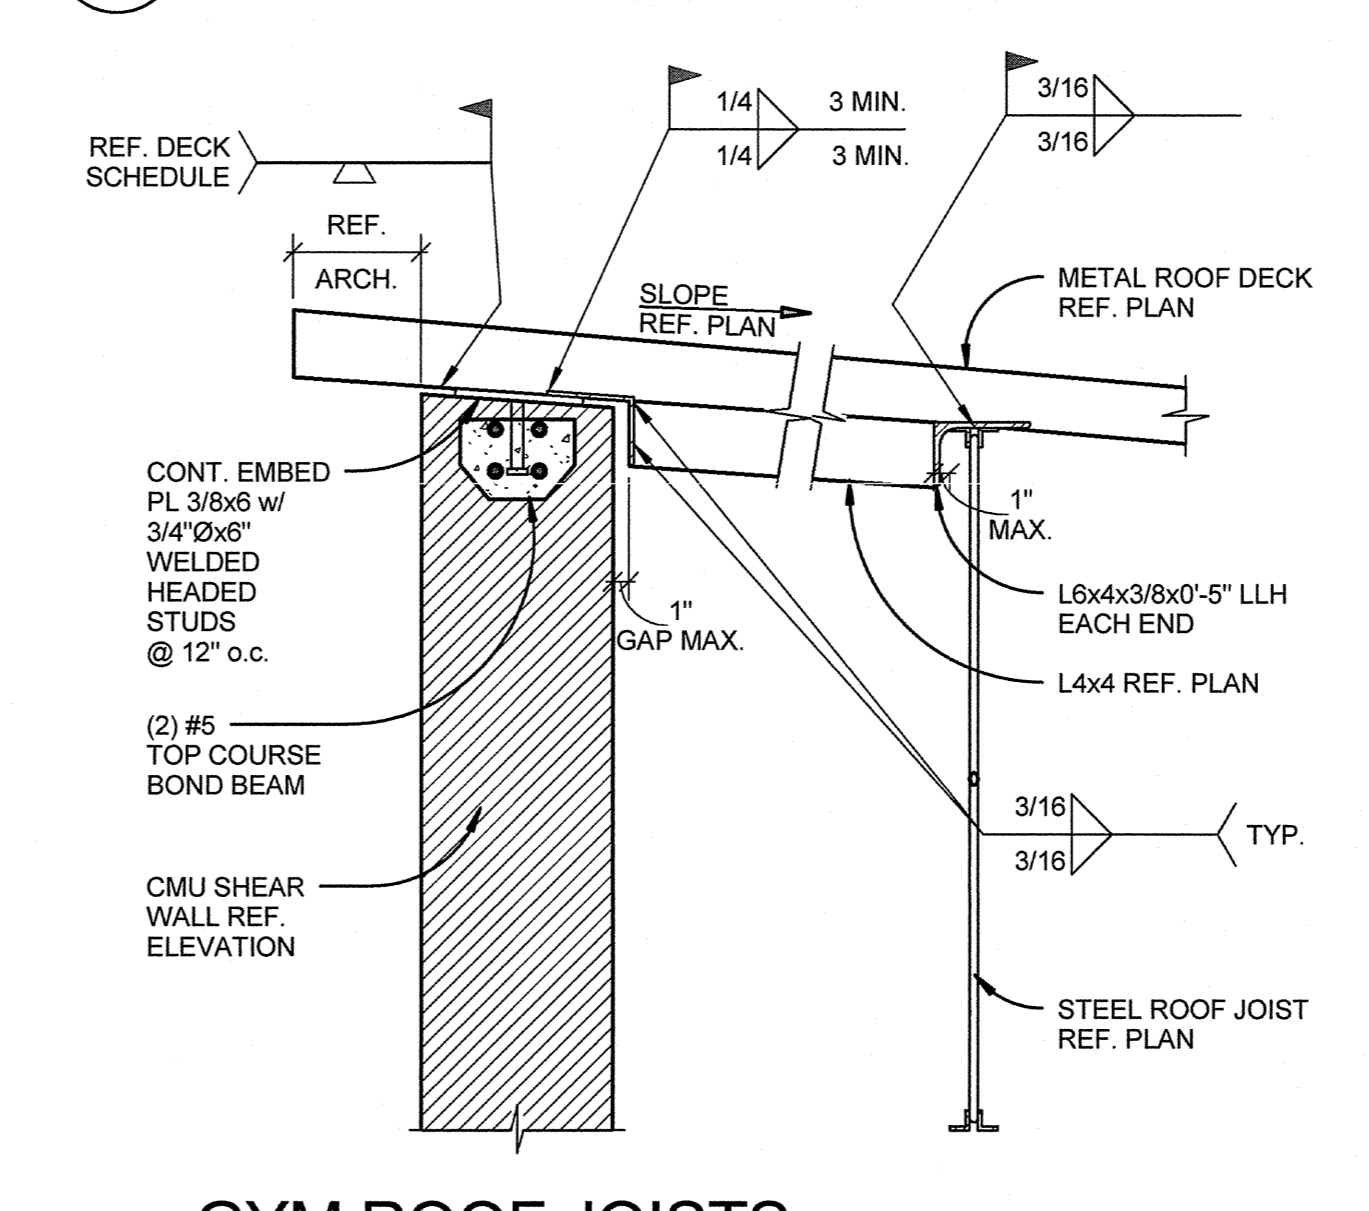


7 GYM ROOF JOISTS PARALLEL TO CMU WALL
1" = 1'-0"

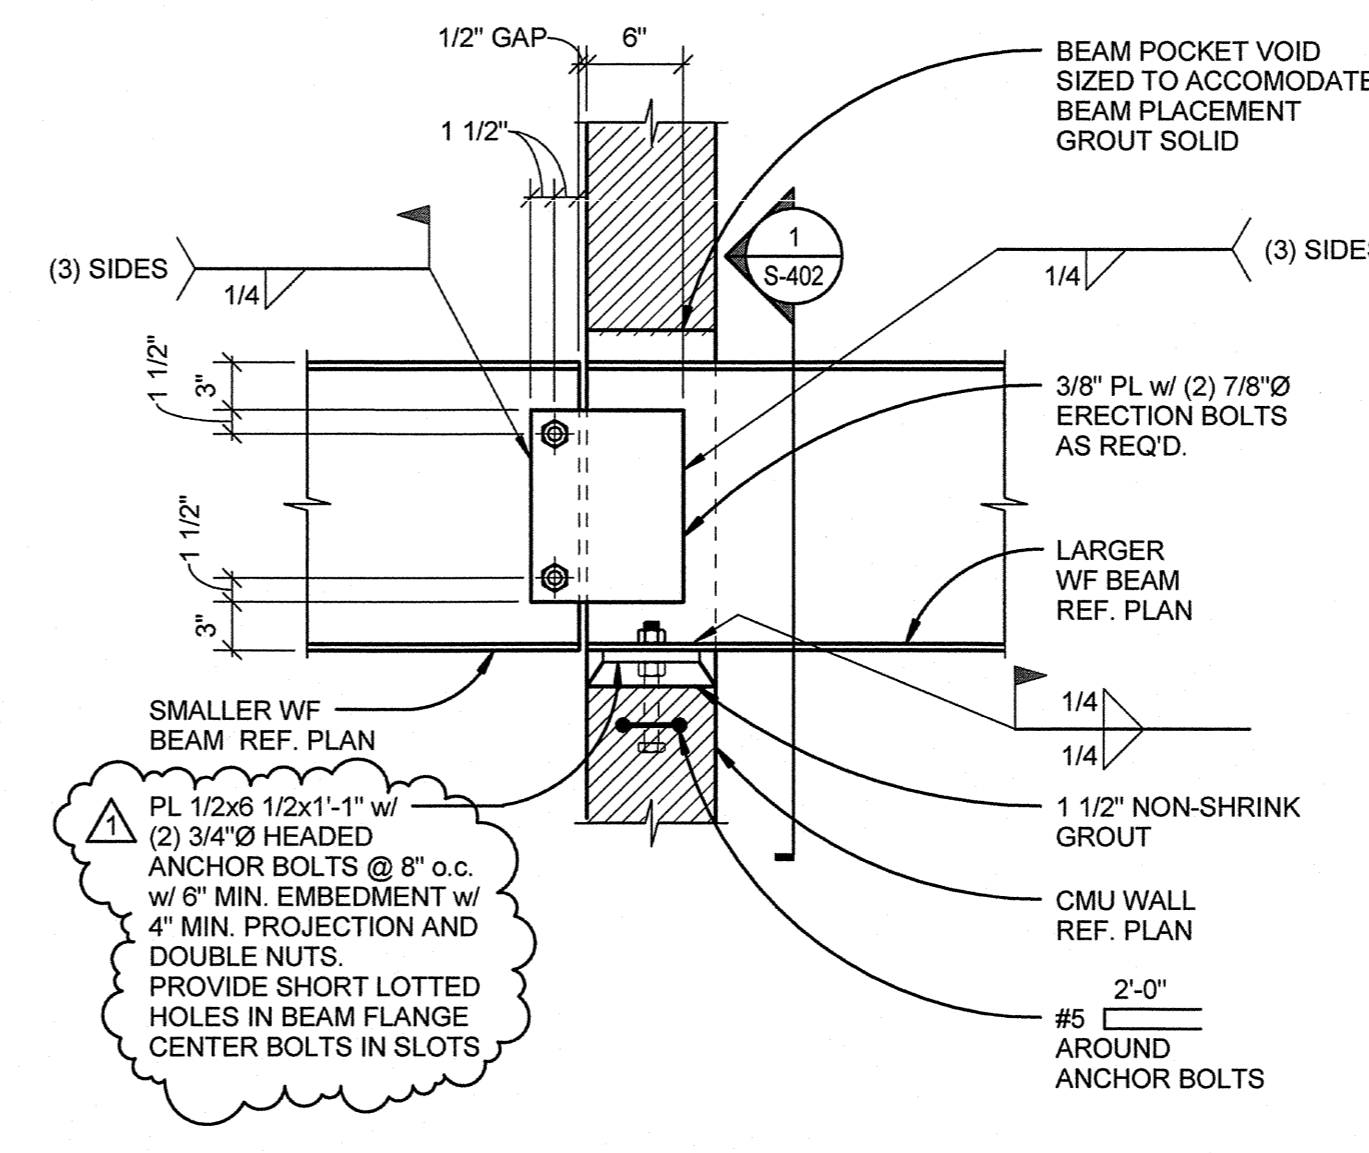


8 BEAM SUPPORT AT CMU WALL
1" = 1'-0"

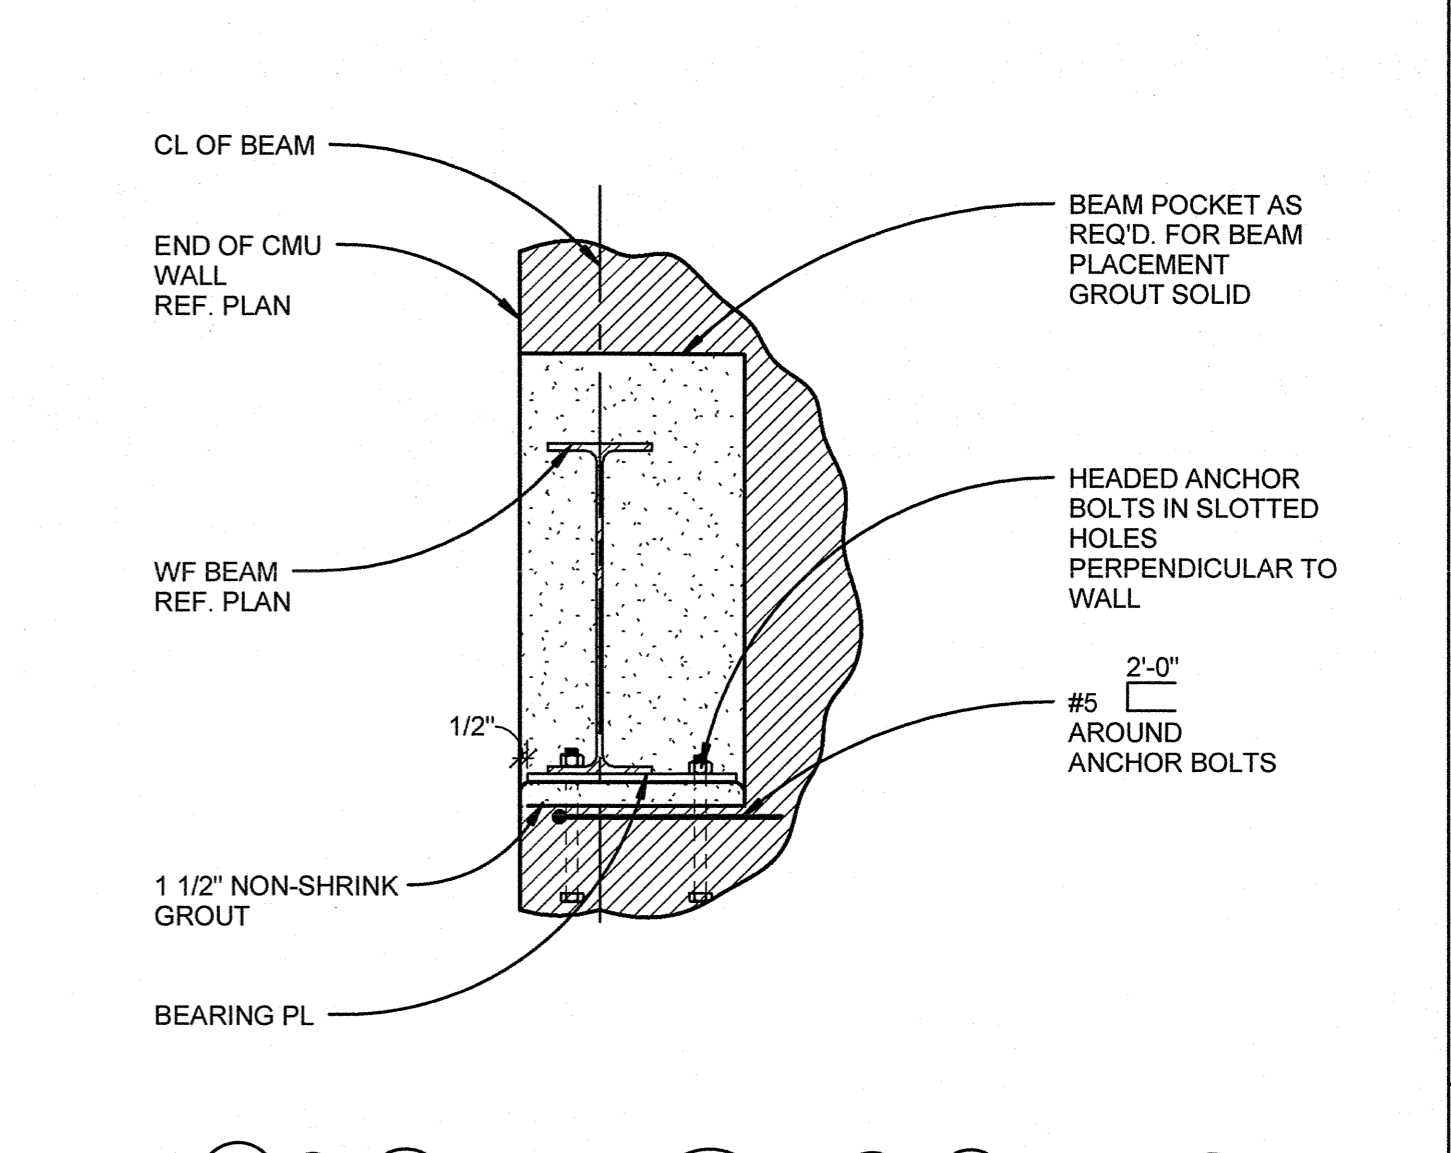


1 BEAM SUPPORT AT CMU WALL
1" = 1'-0"

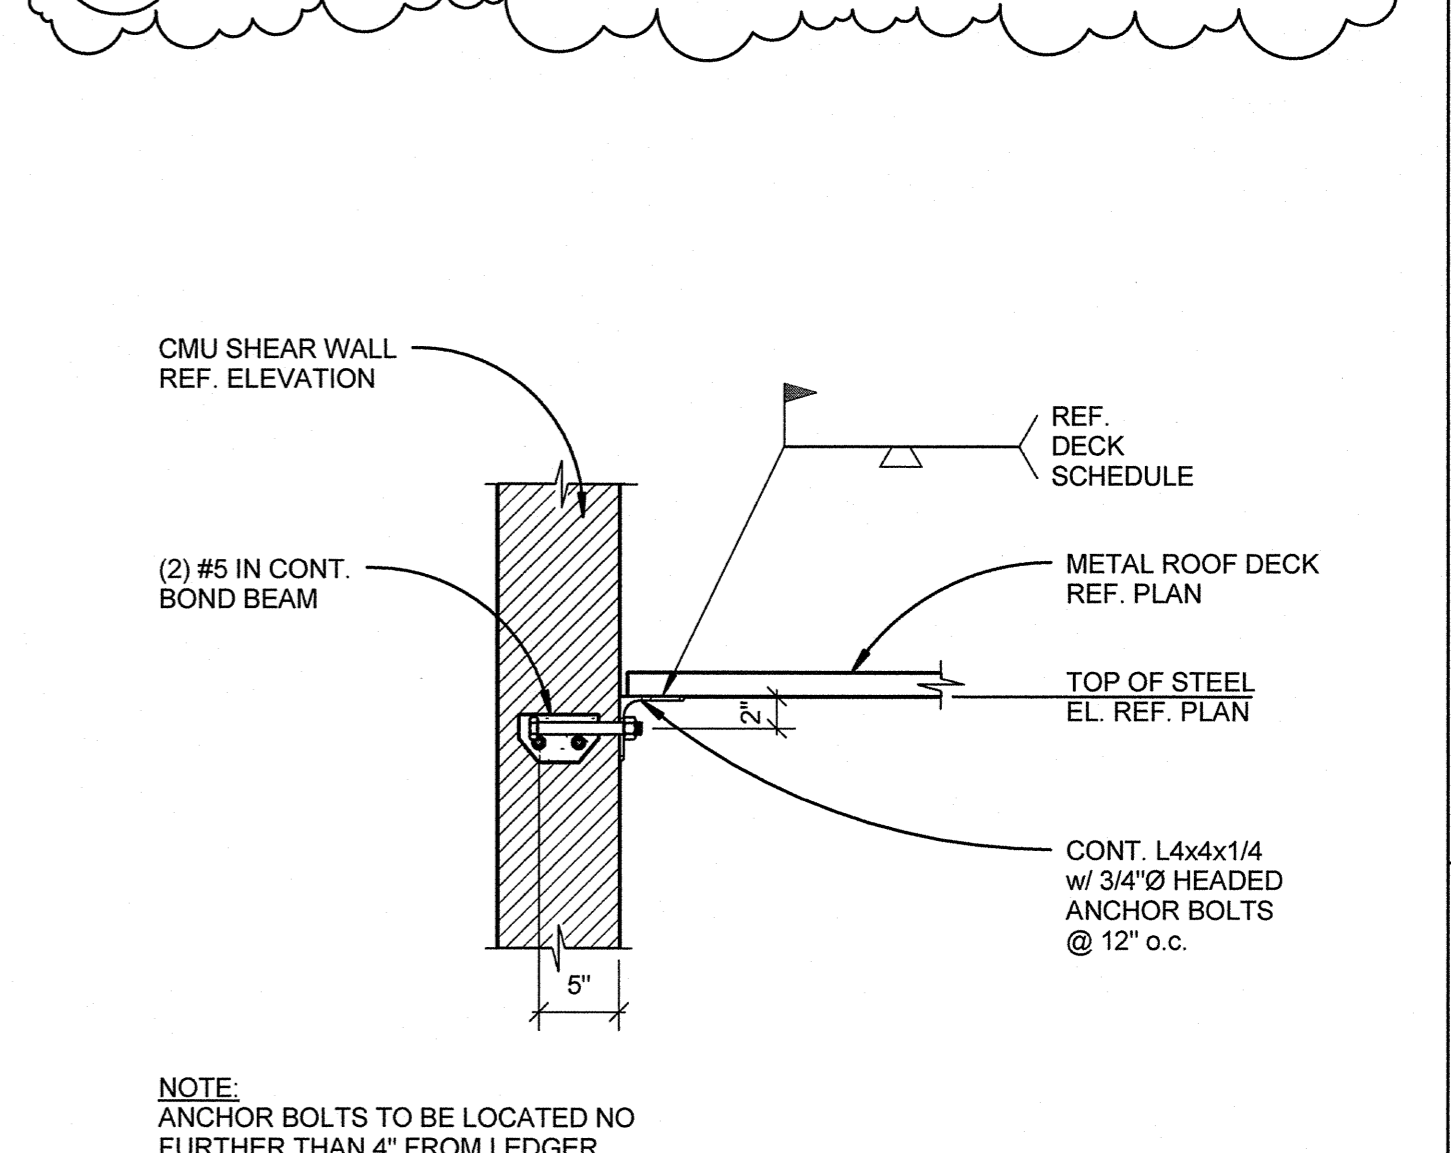


2 ROOF DECK LEDGER TO CMU WALL
1" = 1'-0"

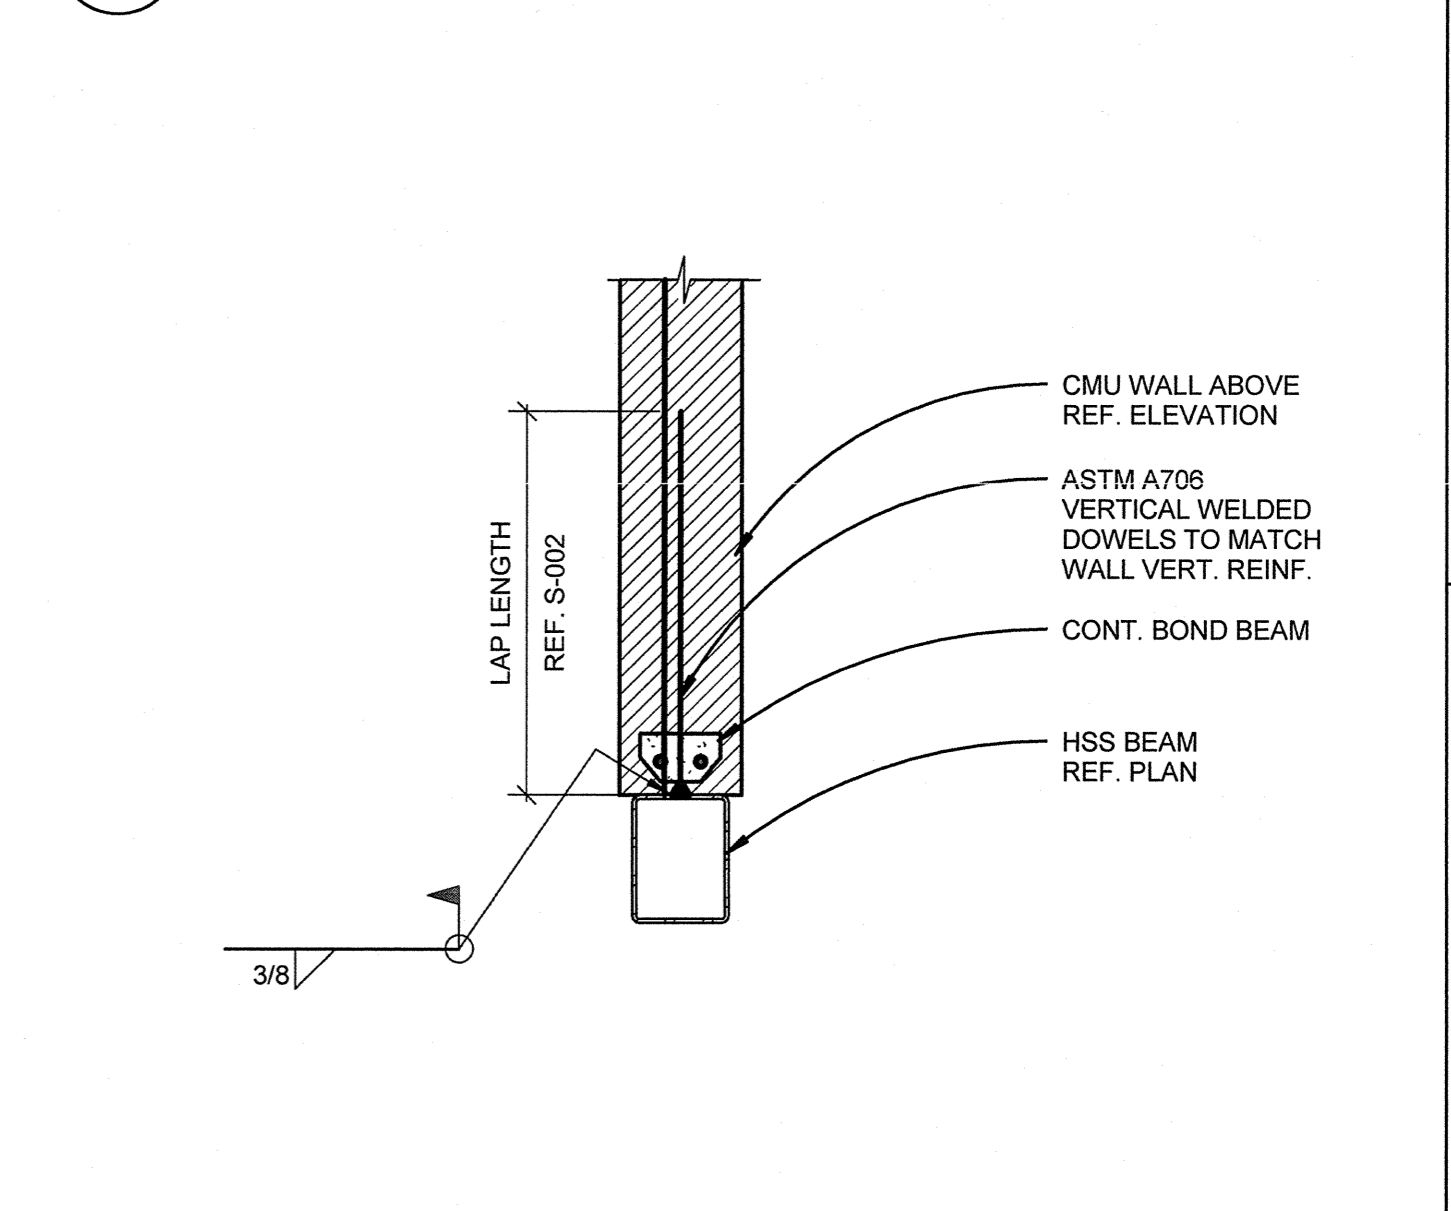

3 CMU DOWELS AT STEEL BEAM
1" = 1'-0"

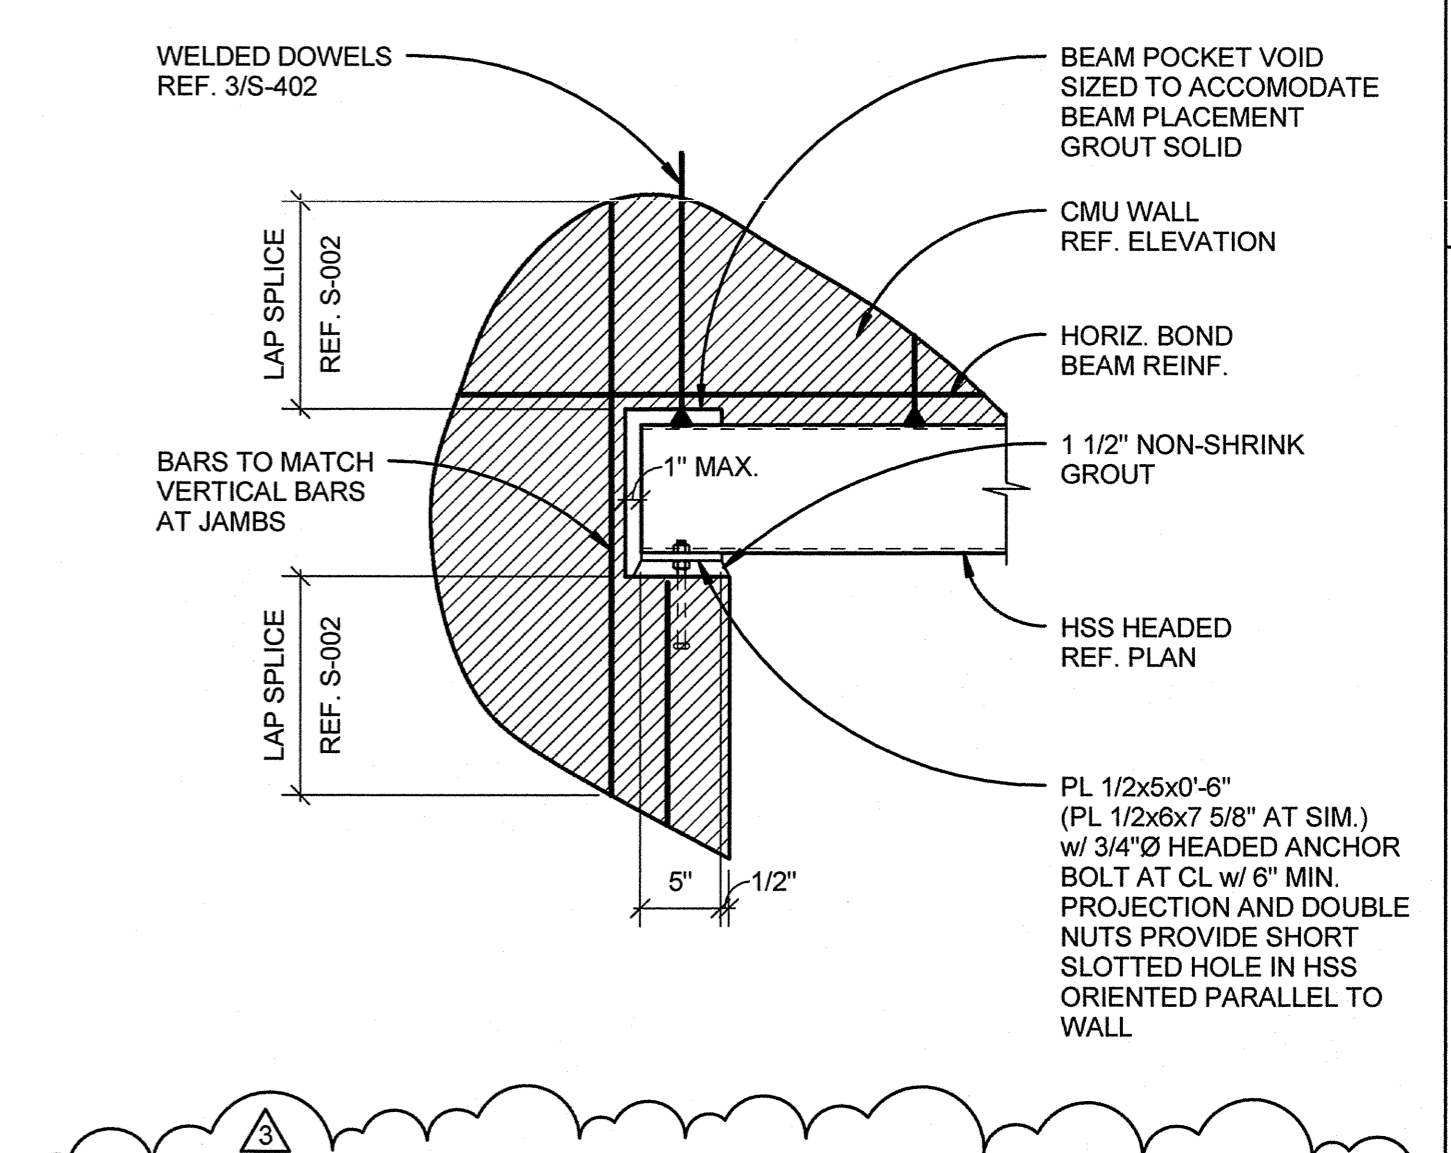


4 HSS CONNECTION AT CMU WALL
1" = 1'-0"

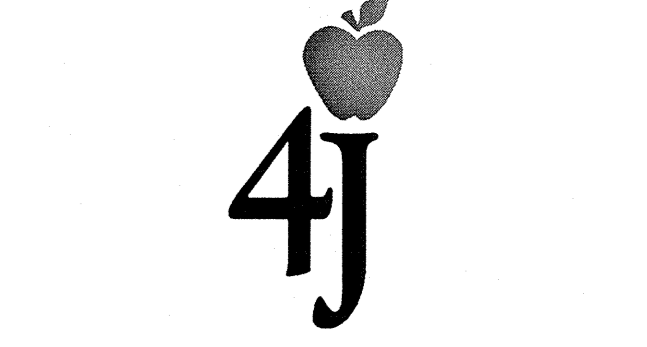

MARK	DATE	DESCRIPTION
3	3-13-2015	ADDENDUM 6
2	3-6-2015	ADDENDUM 3
1	2-18-2015	SUPPLEMENTAL INFO 1


ISSUE DATE: FEBRUARY 18, 2015
ISSUE: CONSTRUCTION DOCUMENTS
VOLUME: PACKAGE 1
PROJECT NO: 213417
DRAWN BY: MF
CHECKED BY: MT
ORIGINAL SHEET SIZE: 30"x42"

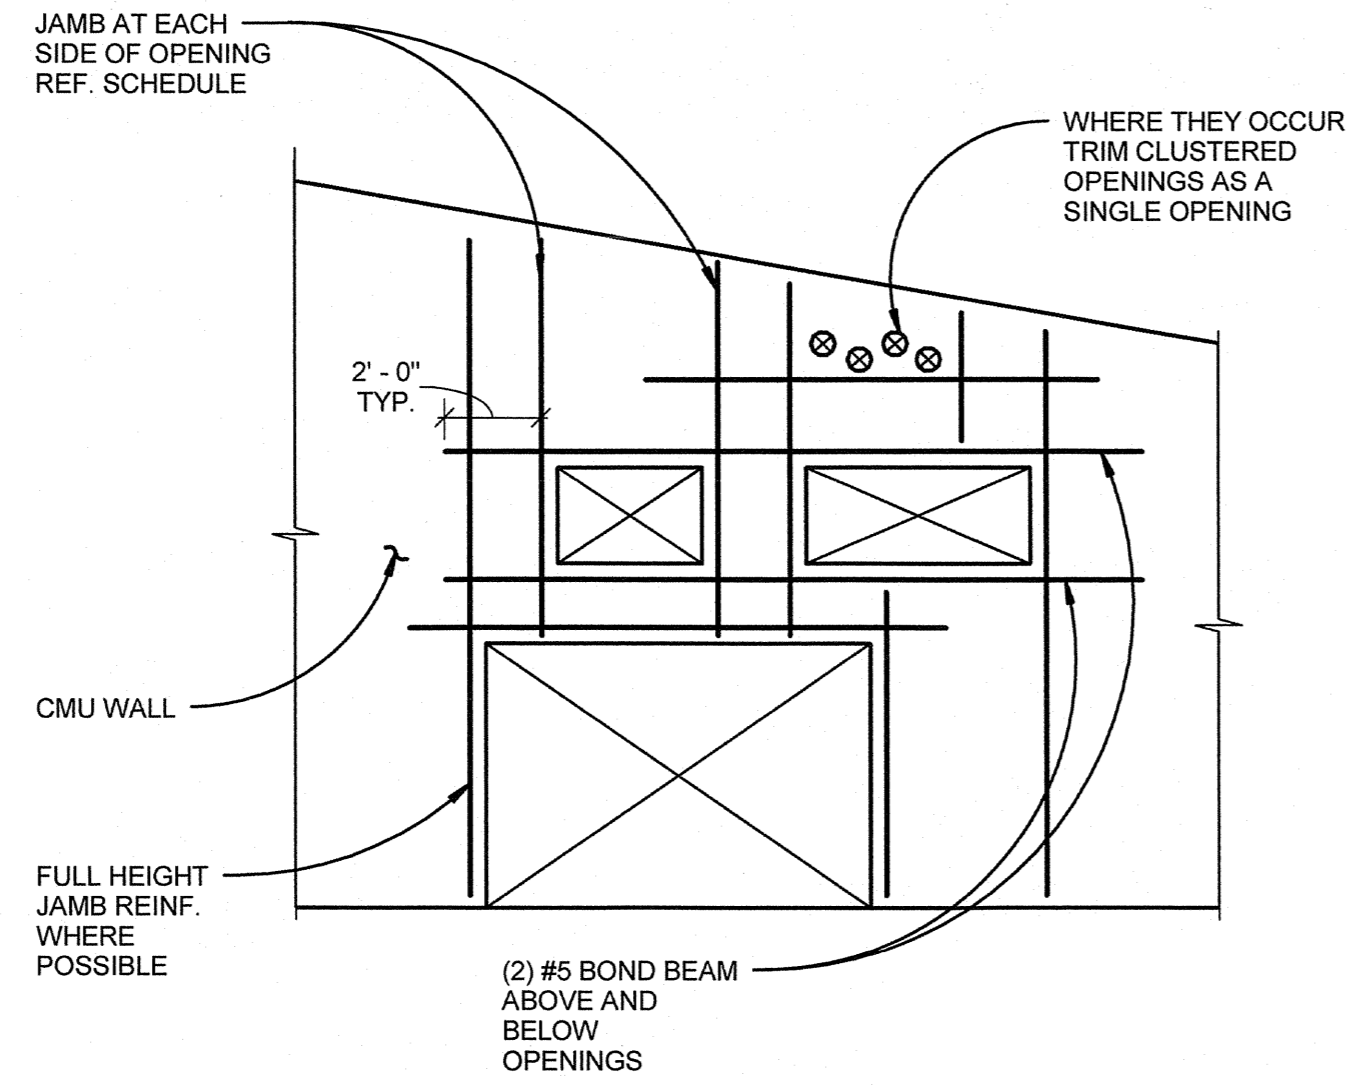


JAMB REINFORCEMENT SCHEDULE		
OPENING WIDTH	8" CMU	12" CMU
Ws4'-0"	(1) #6	(1) #6
4'-0" < Ws8'-0"	(1) #6 FIRST (2) CELLS	#4 EACH FACE FIRST (2) CELLS
8'-0" < W < 13'-0"	(1) #6 FIRST (3) CELLS	#4 EACH FACE FIRST (2) CELLS

12 TYPICAL CMU WALL OPENING REINFORCEMENT
1/4" = 1'-0"


9 NOT USED

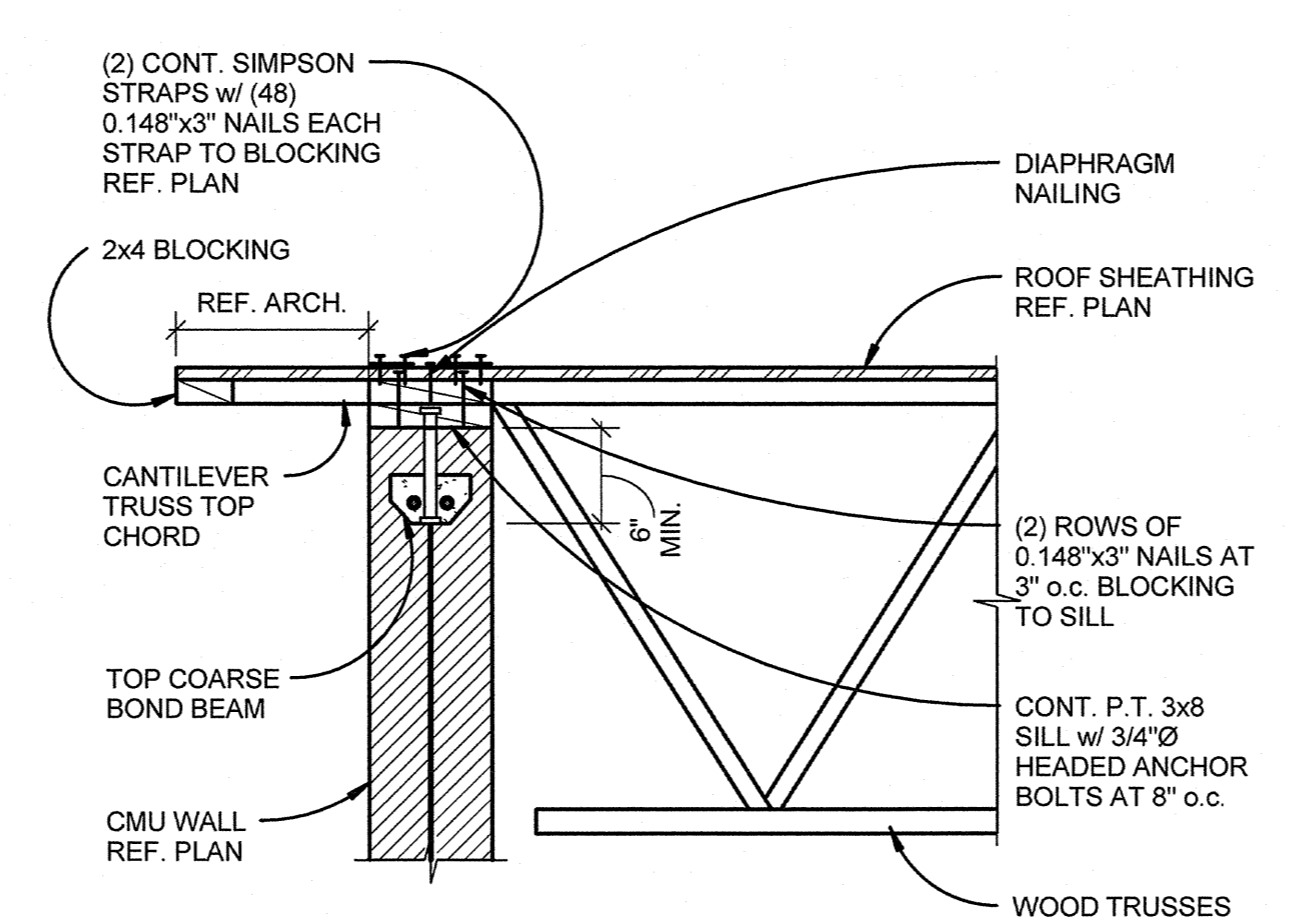


10 COLLECTOR ANCHORAGE TO TOP OF WALL
1" = 1'-0"

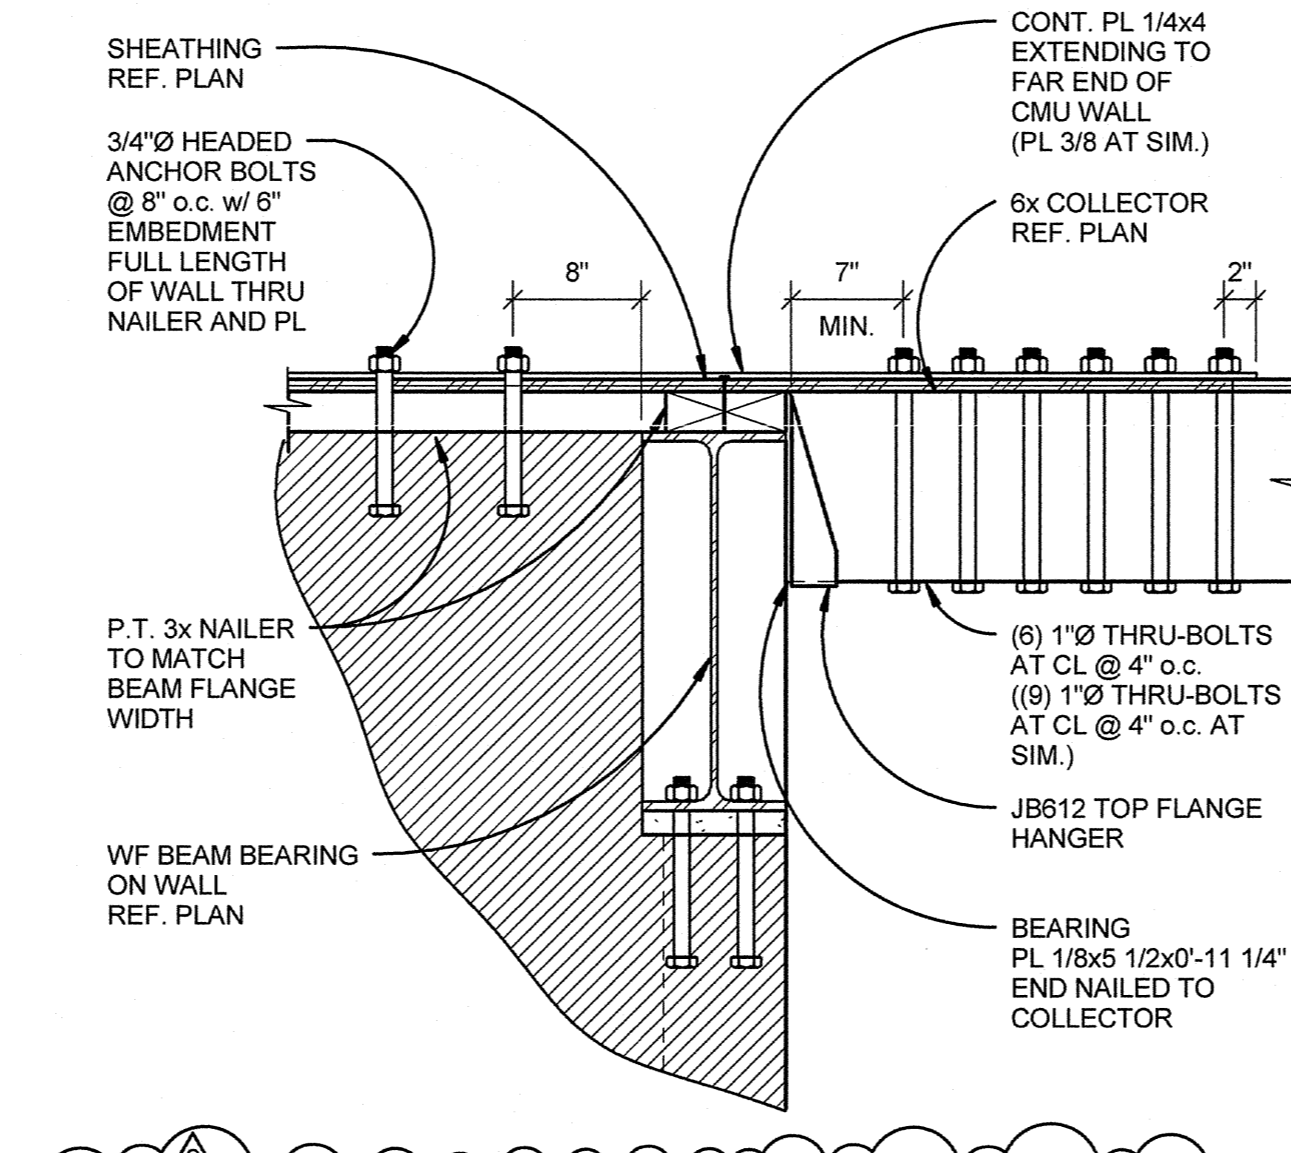


11 COLLECTOR ANCHORAGE DETAIL
1" = 1'-0"

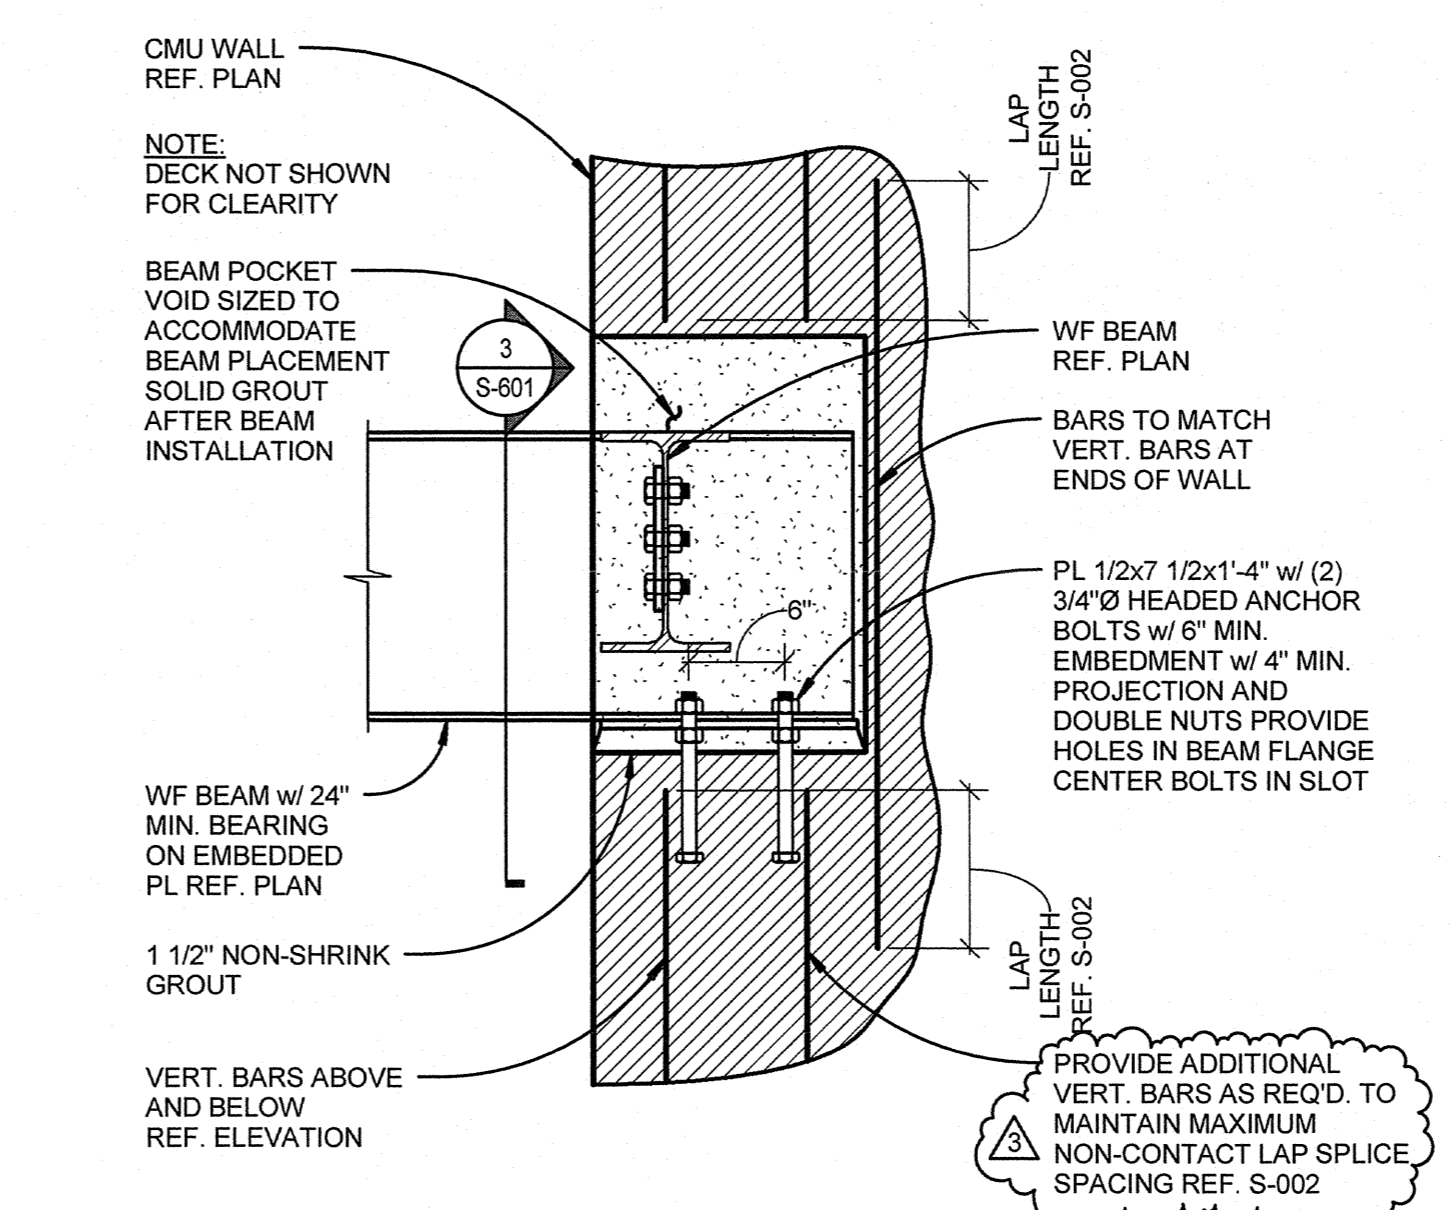


5 WF BEAM TO END OF CMU WALL
1" = 1'-0"

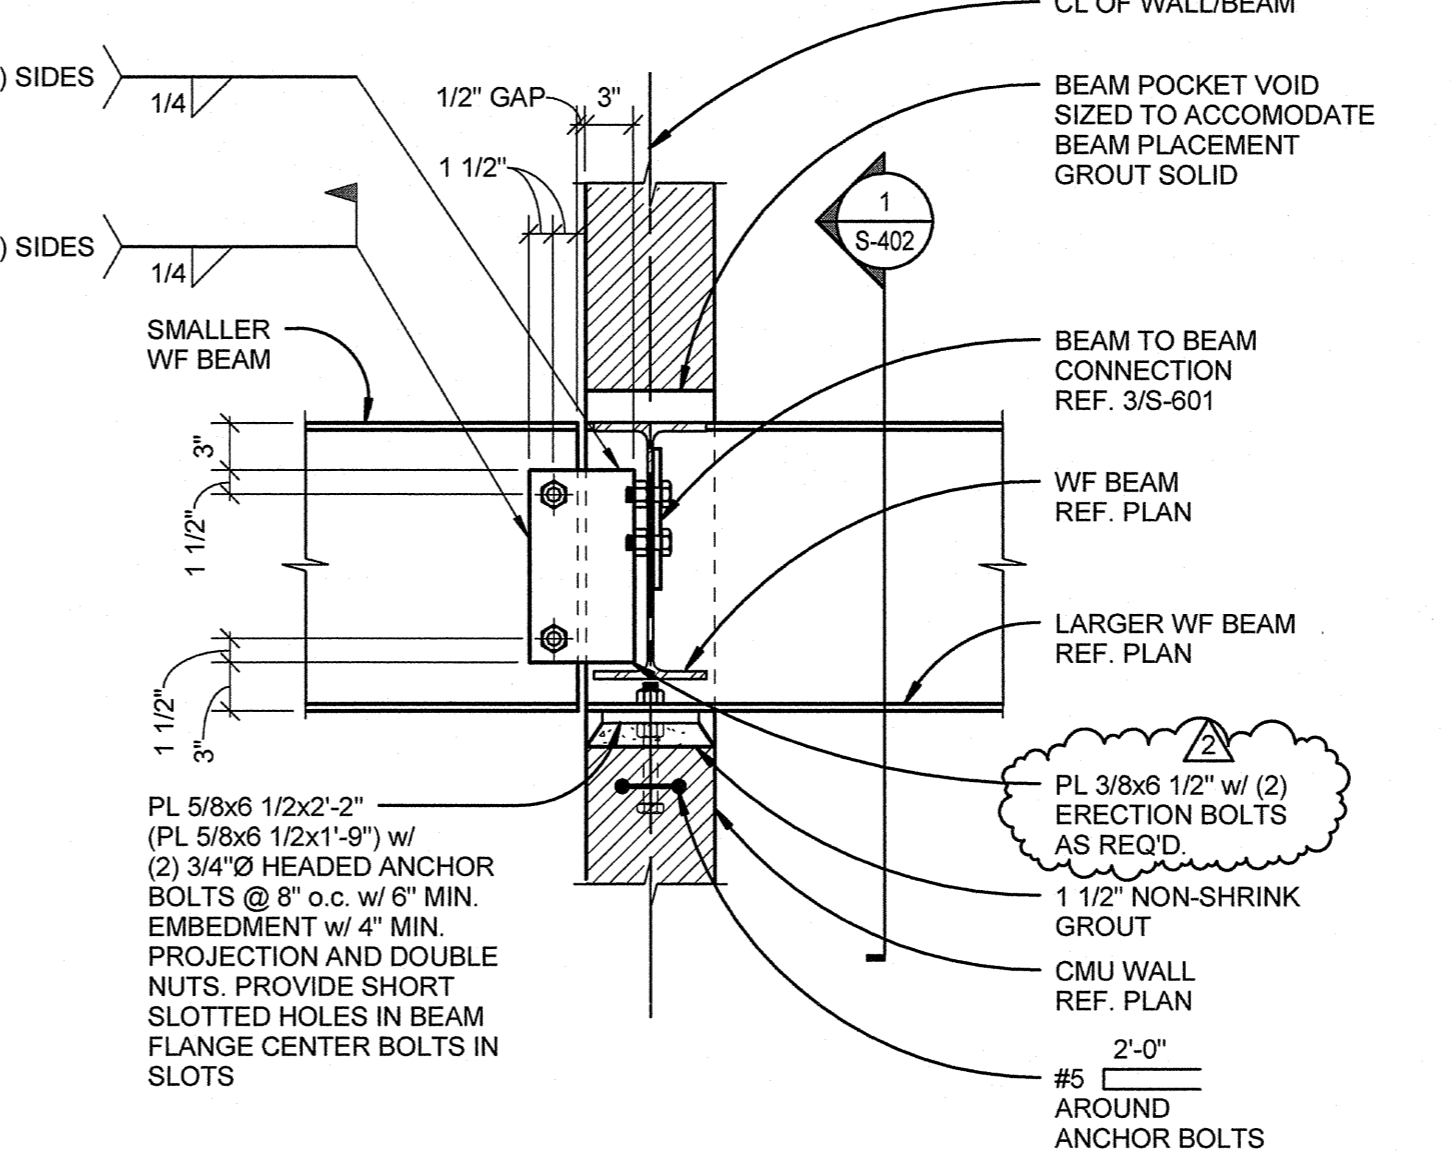


6 BEAM SUPPORT AT CMU WALL
1" = 1'-0"

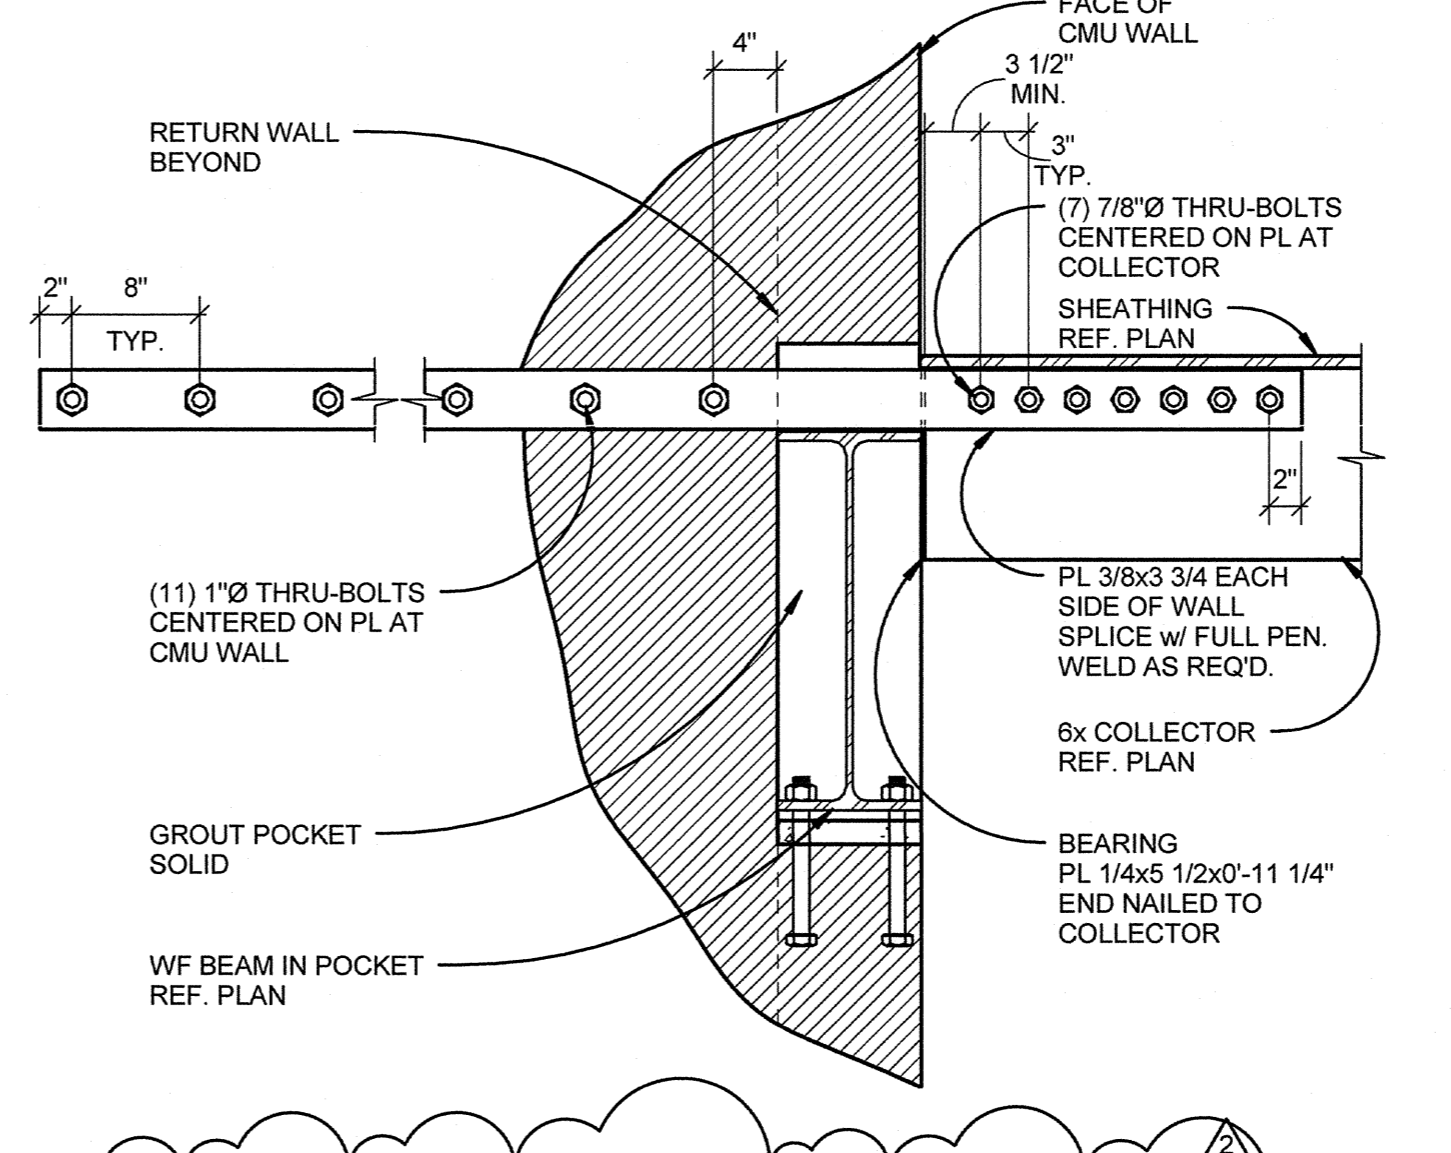


7 COLLECTOR ANCHORAGE DETAIL
1" = 1'-0"

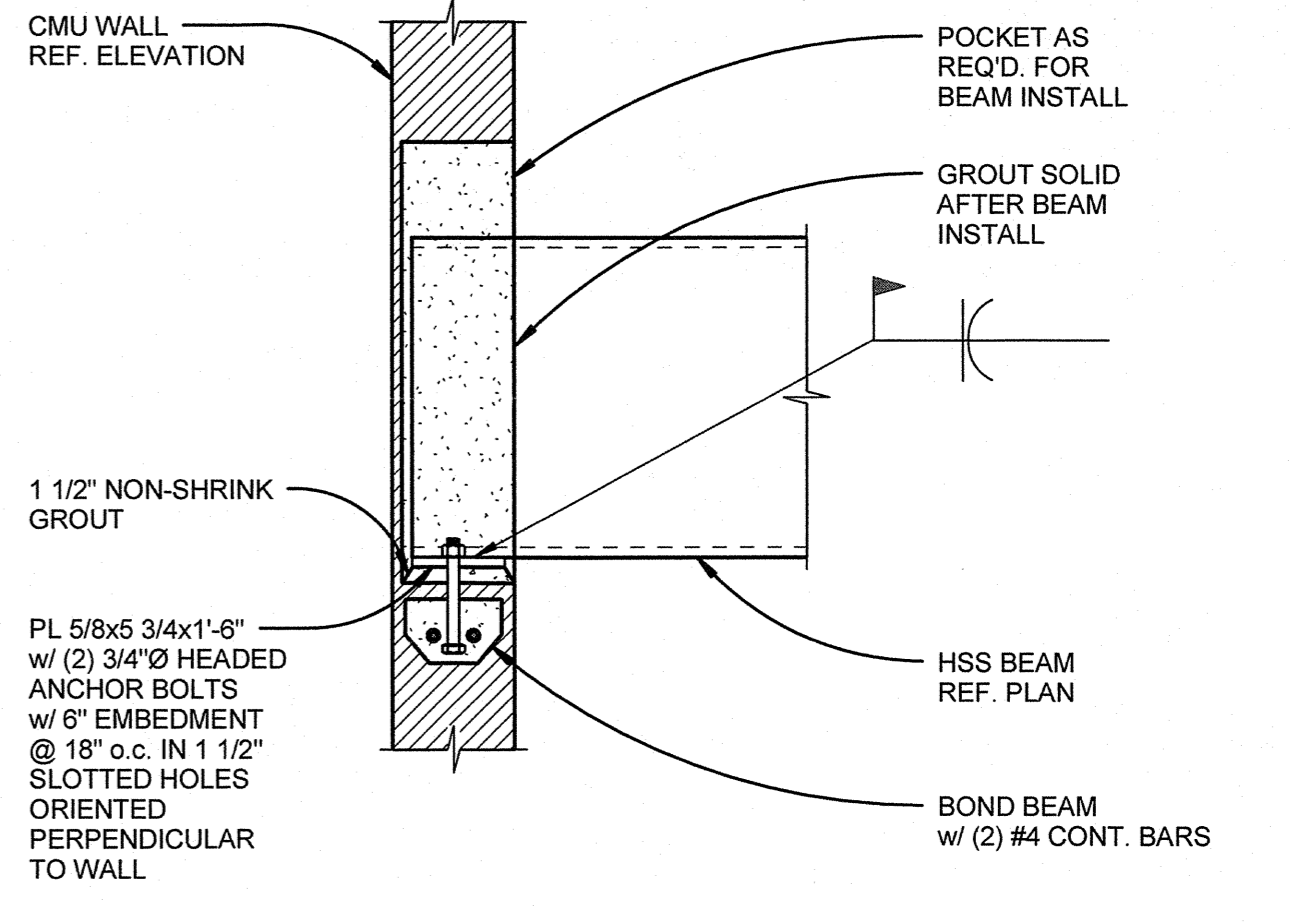


1 HSS TO CMU WALL DETAIL
1" = 1'-0"

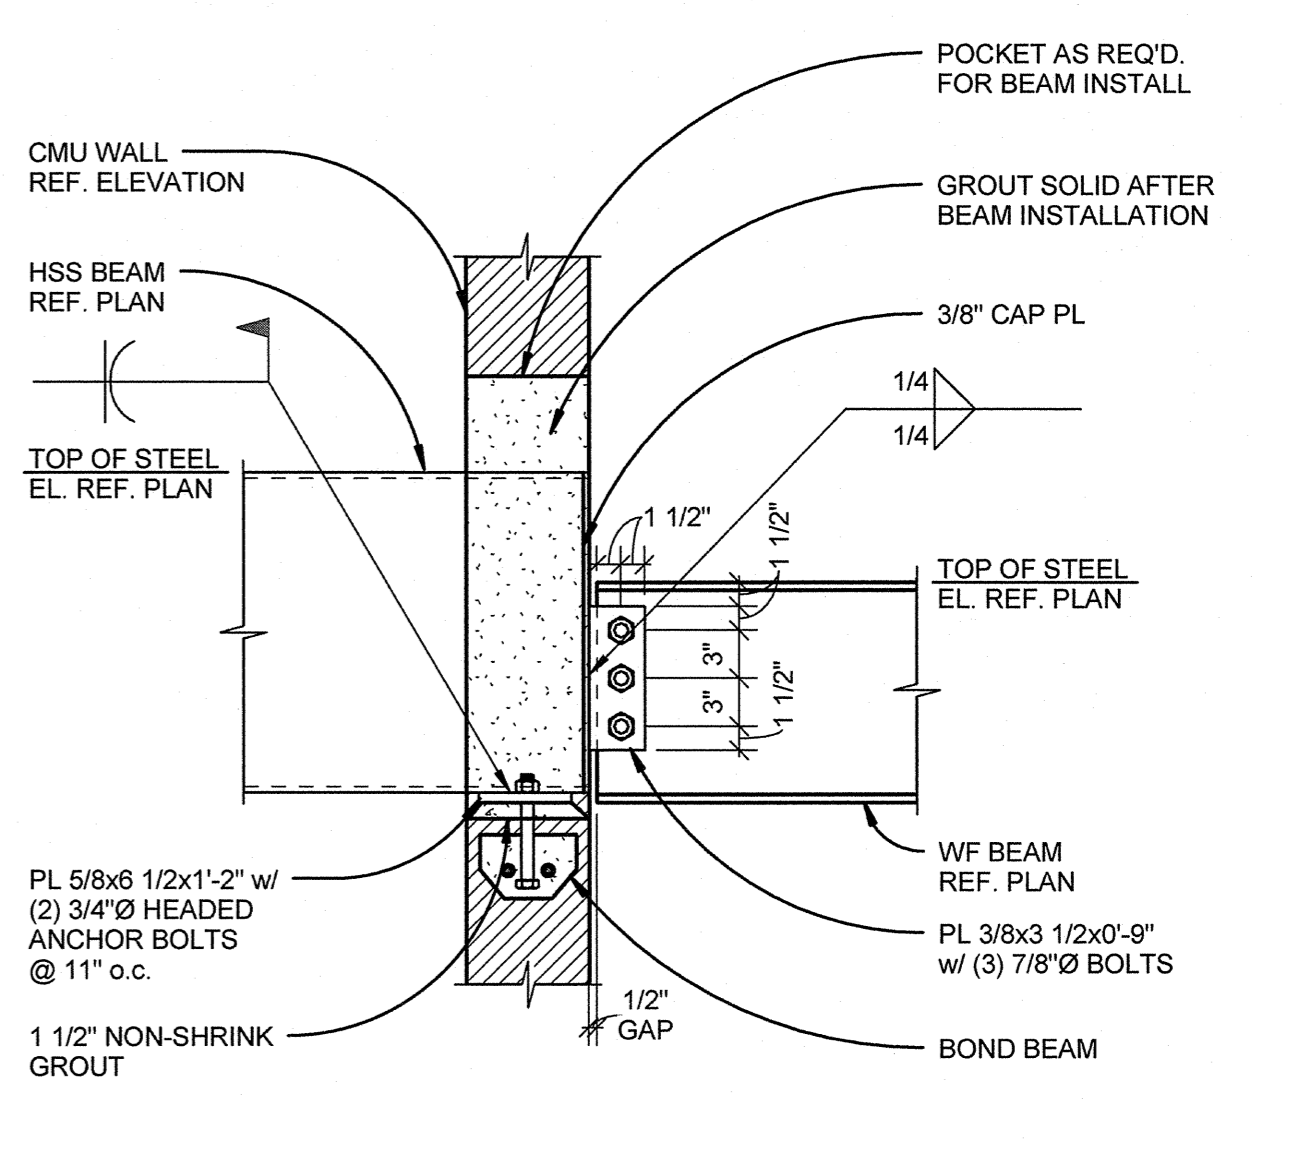


2 HSS/W14 CONN. TO CMU WALL
1" = 1'-0"

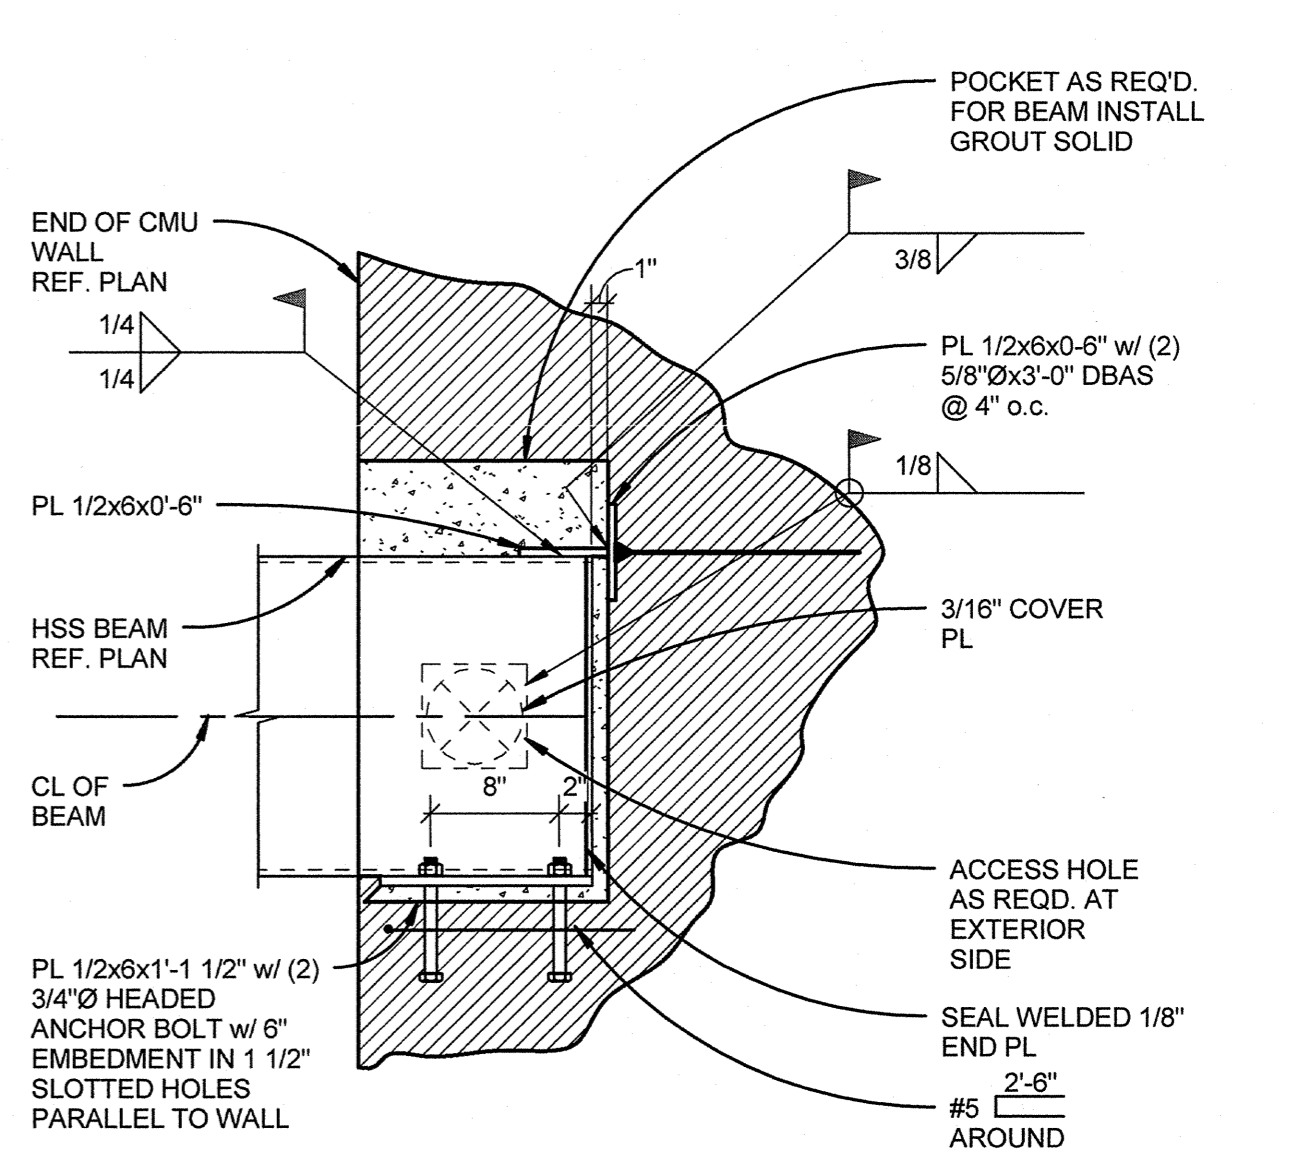

3 HSS TO END OF WALL
1" = 1'-0"

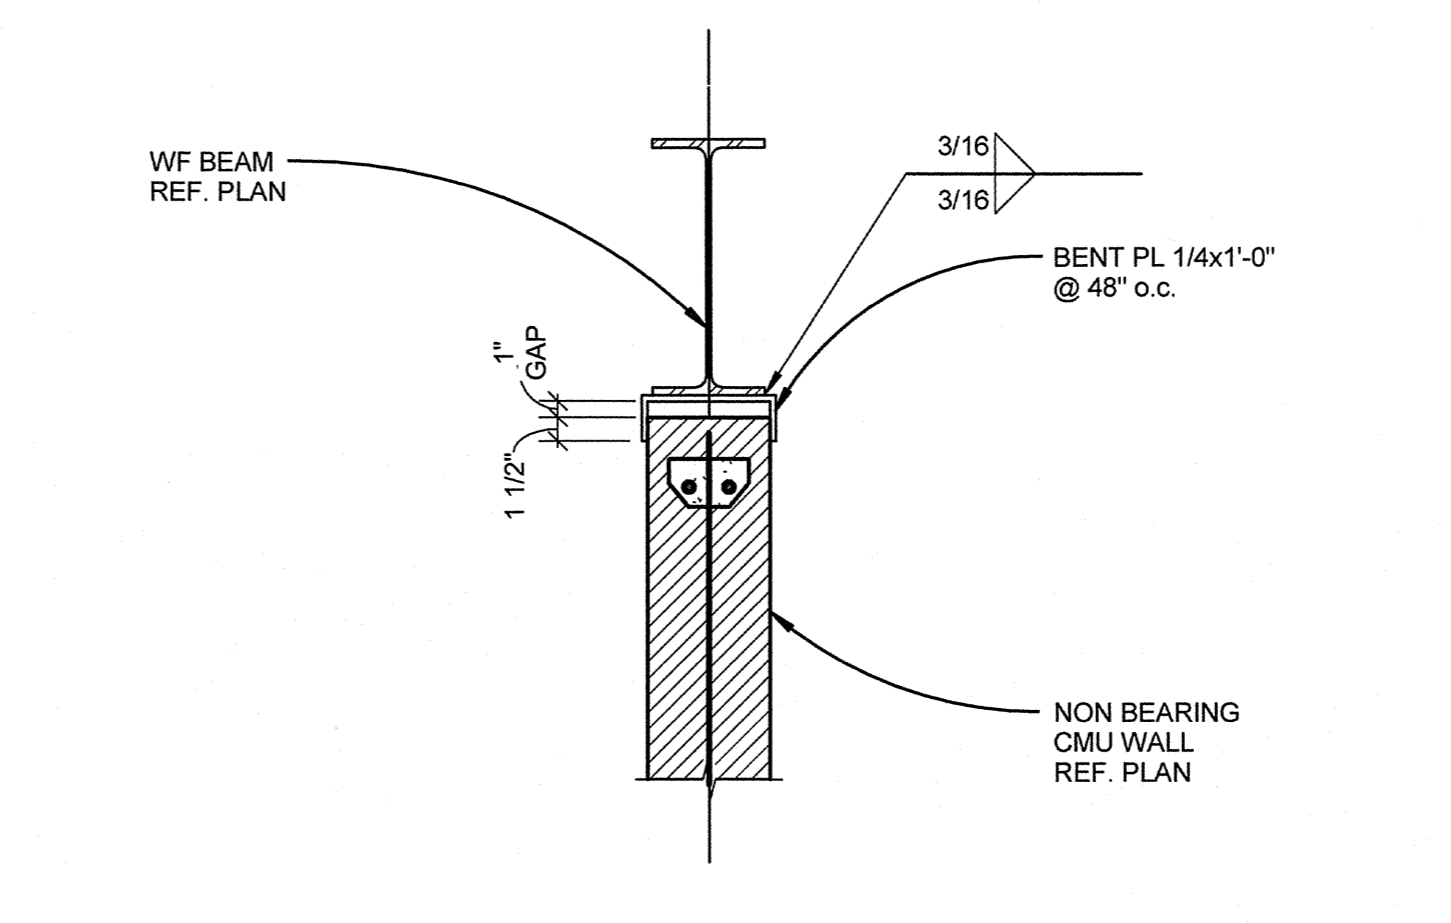

8 TOP OF CMU WALL DETAIL
1" = 1'-0"

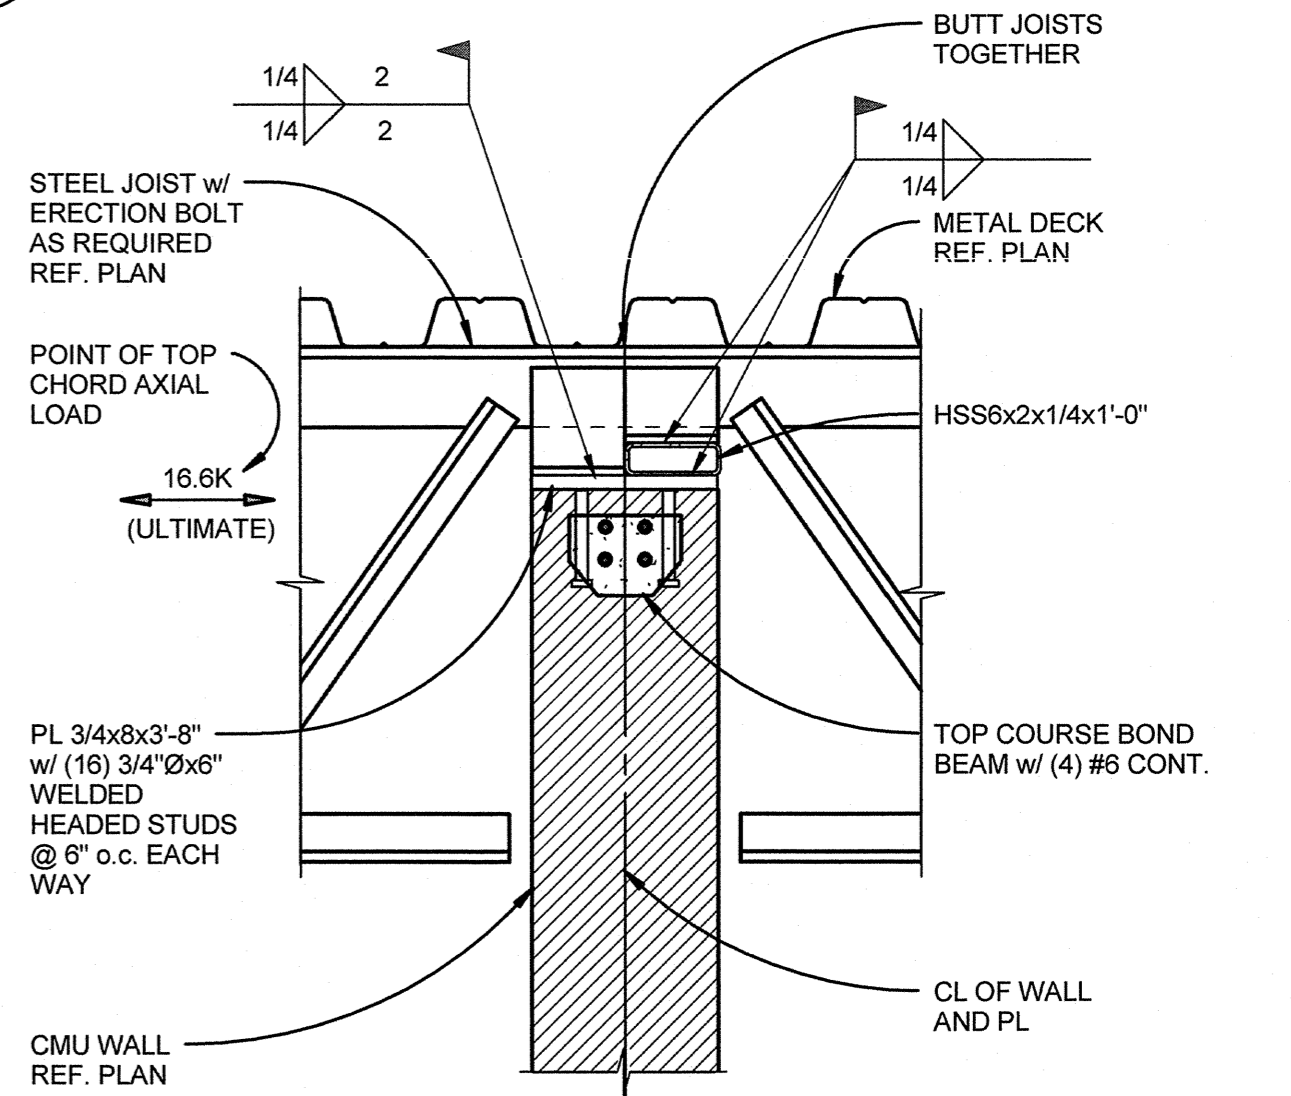


4 JOIST TO CMU WALL EACH SIDE
1" = 1'-0"


MARK	DATE	DESCRIPTION
3	3-13-2015	ADDENDUM 6
2	3-6-2015	ADDENDUM 3
1	2-18-2015	SUPPLEMENTAL INFO 1

ISSUE DATE: FEBRUARY 18, 2015
ISSUE: CONSTRUCTION DOCUMENTS
VOLUME: PACKAGE 1
PROJECT NO: 213417
DRAWN BY: MF
CHECKED BY: MT
COPYRIGHT MAHLUM ARCHITECTS, INC. 2014 ORIGINAL SHEET SIZE: 30"x42"


CMU DETAILS

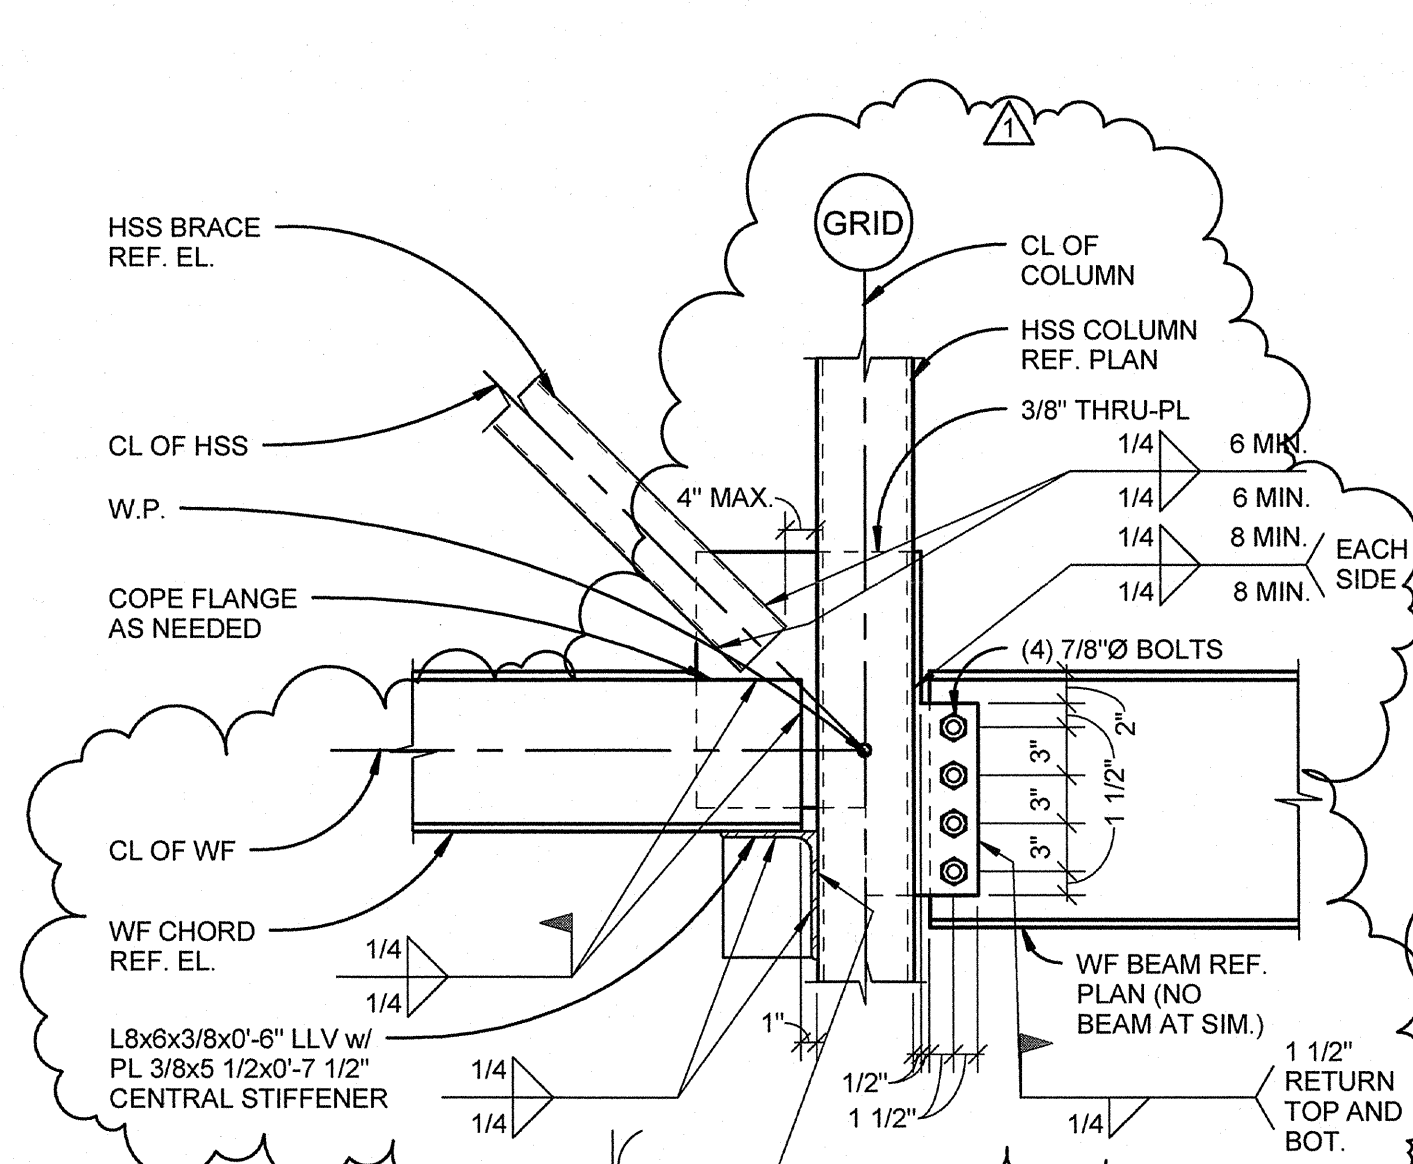


9 TRUSS BOT. CHORD CONNECTION
1" = 1'-0"

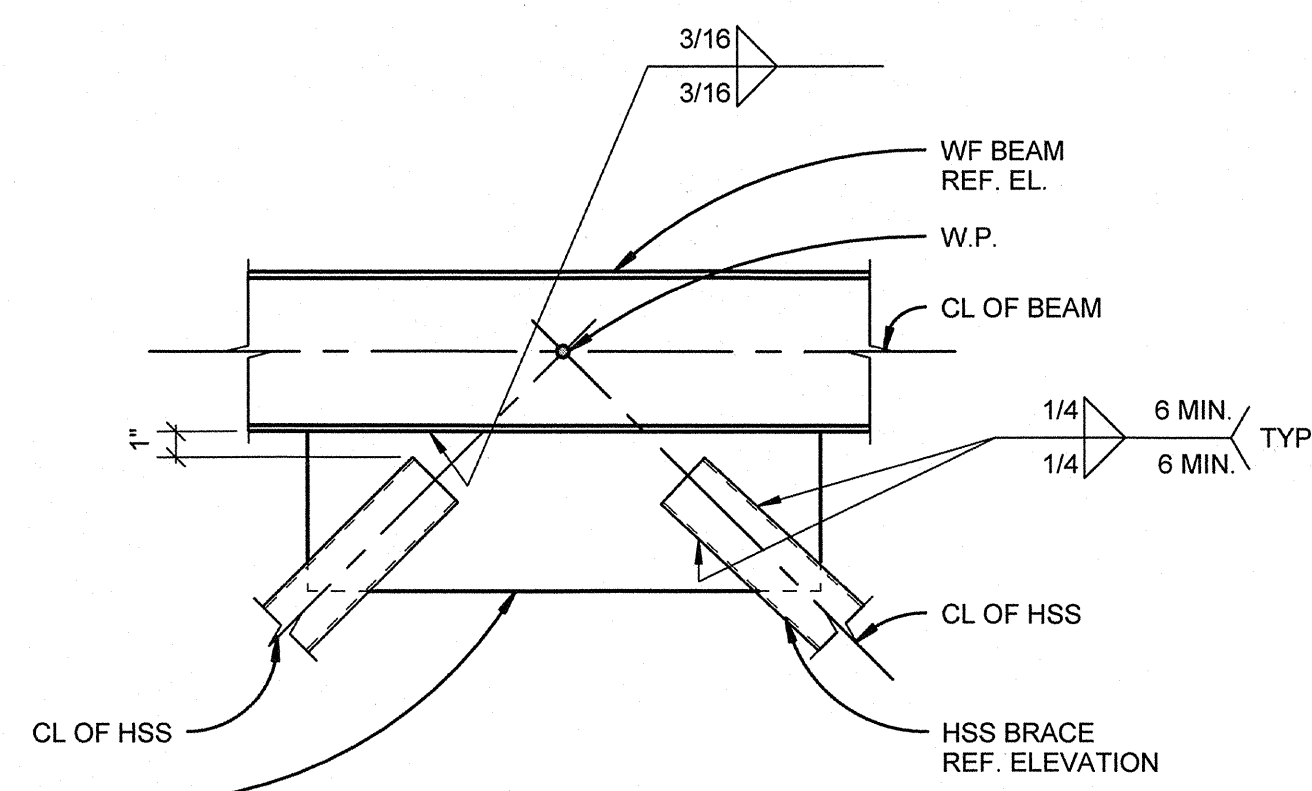


4 TYPICAL TRUSS TOP CONNECTION
1" = 1'-0"

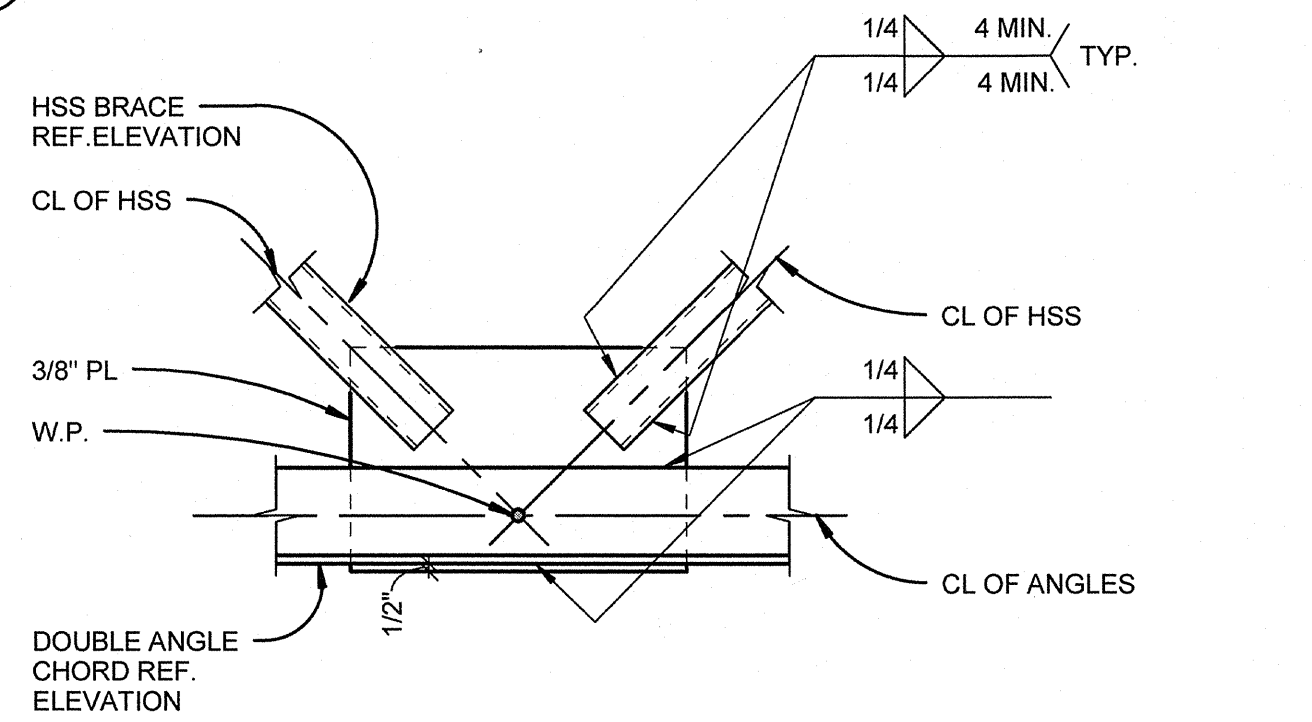


5 TYPICAL TRUSS BOT. CONNECTION
1" = 1'-0"

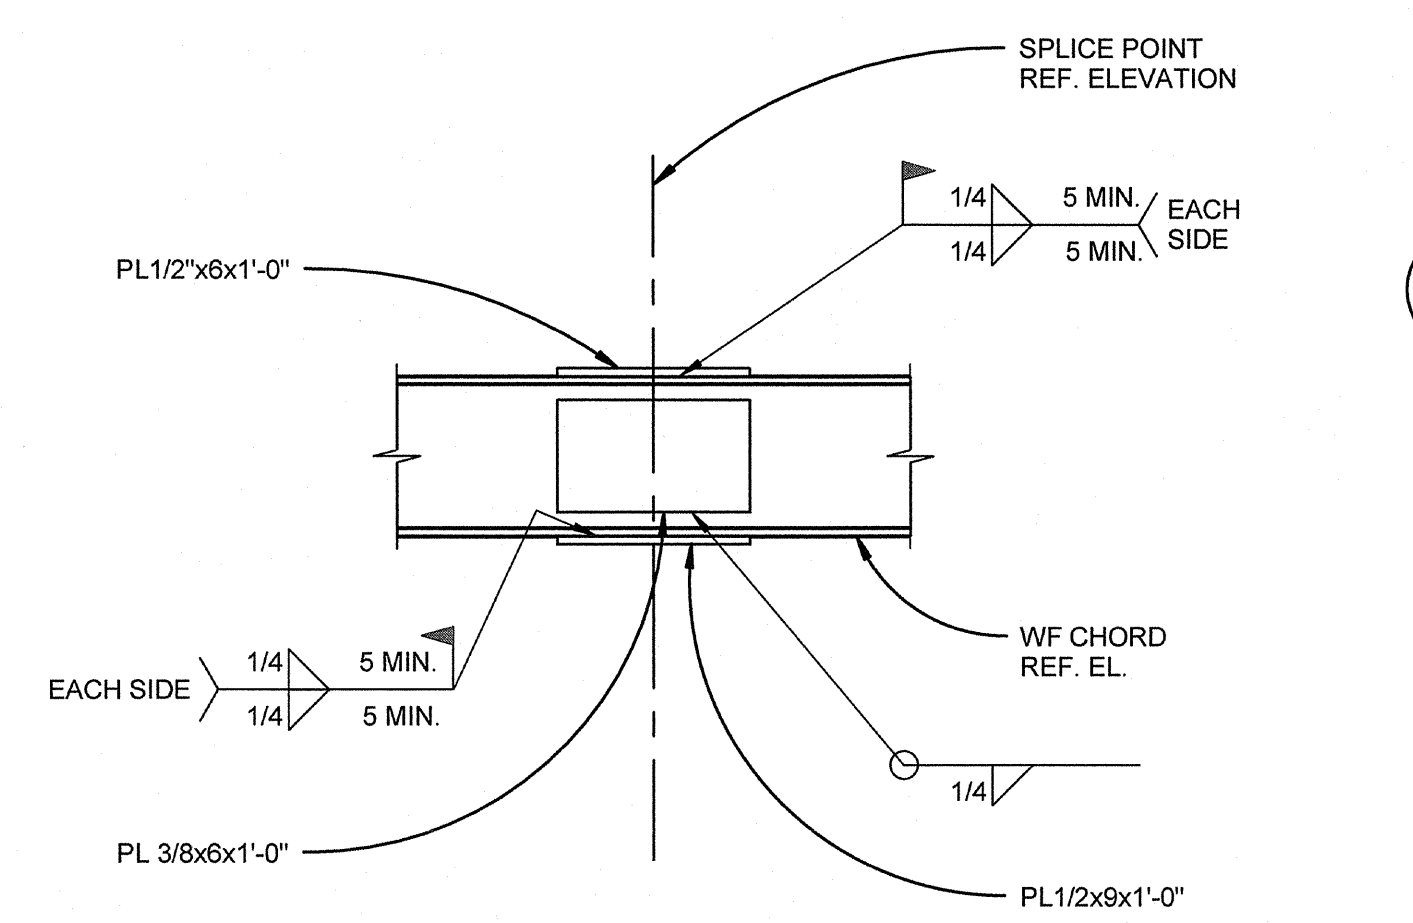


10 SPLICE IN TOP WF CHORD
1" = 1'-0"

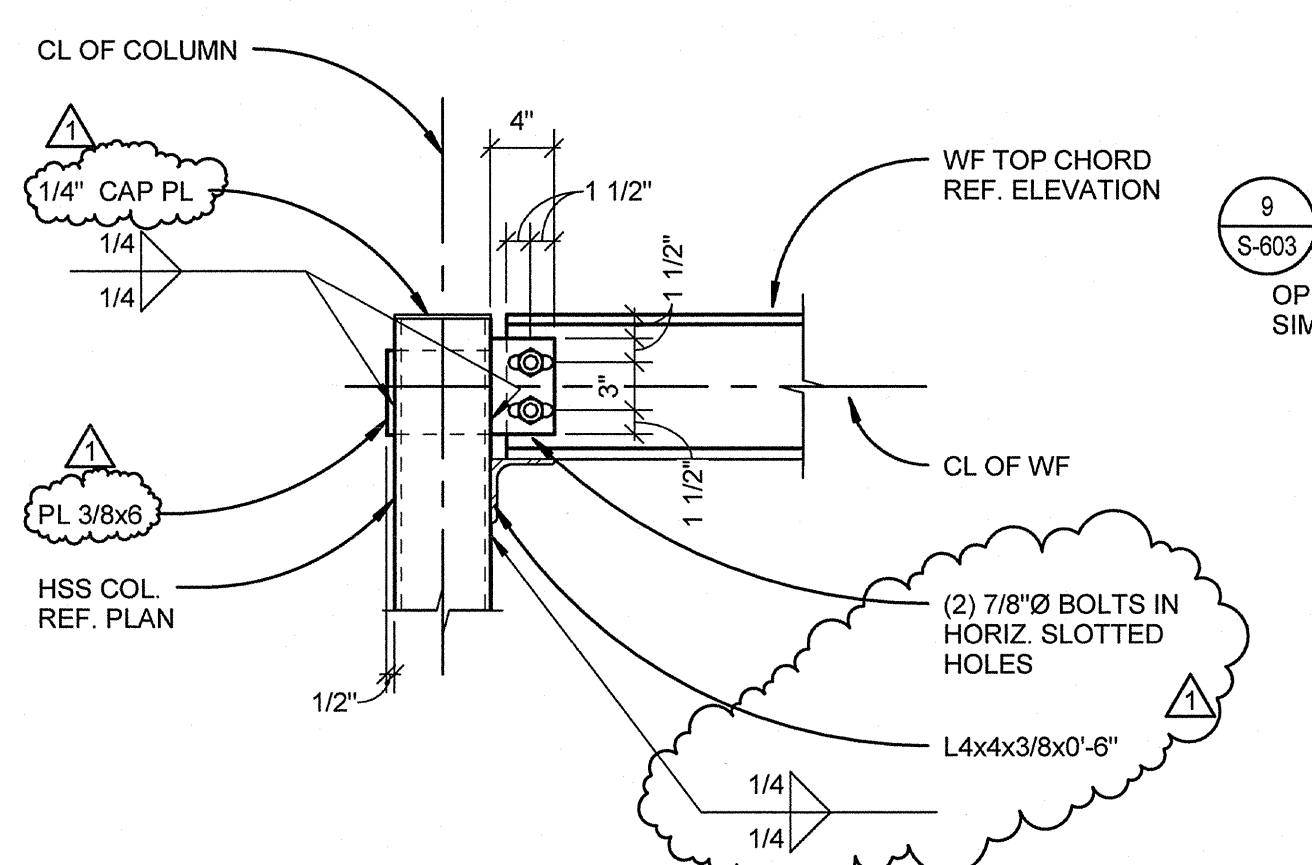


6 TYPICAL TOP CHORD CONNECTION
1" = 1'-0"

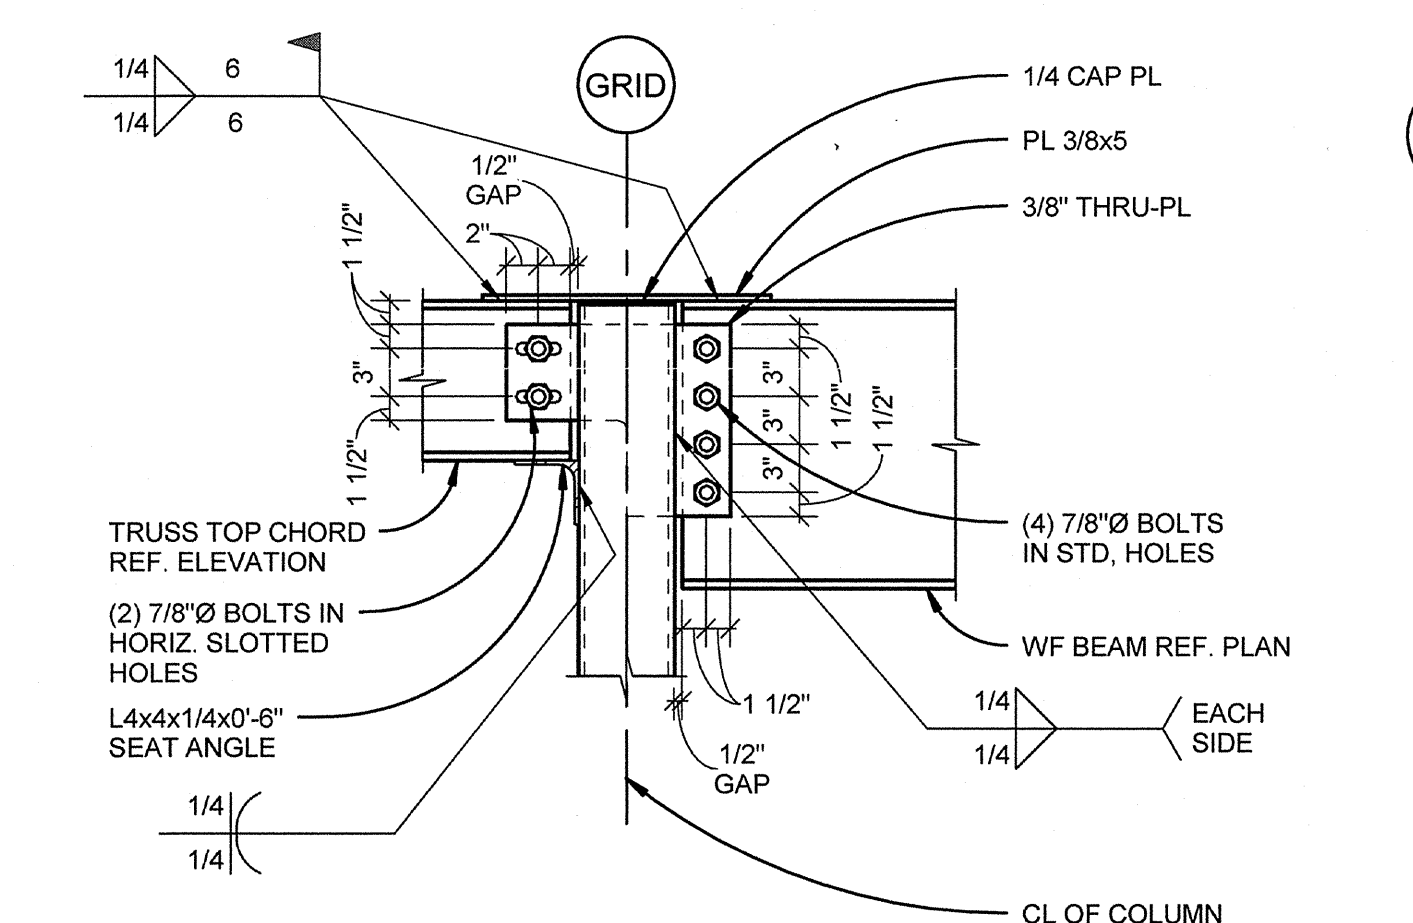


11 TRUSS TOP CHORD COLLECTOR CONNECTION
1" = 1'-0"

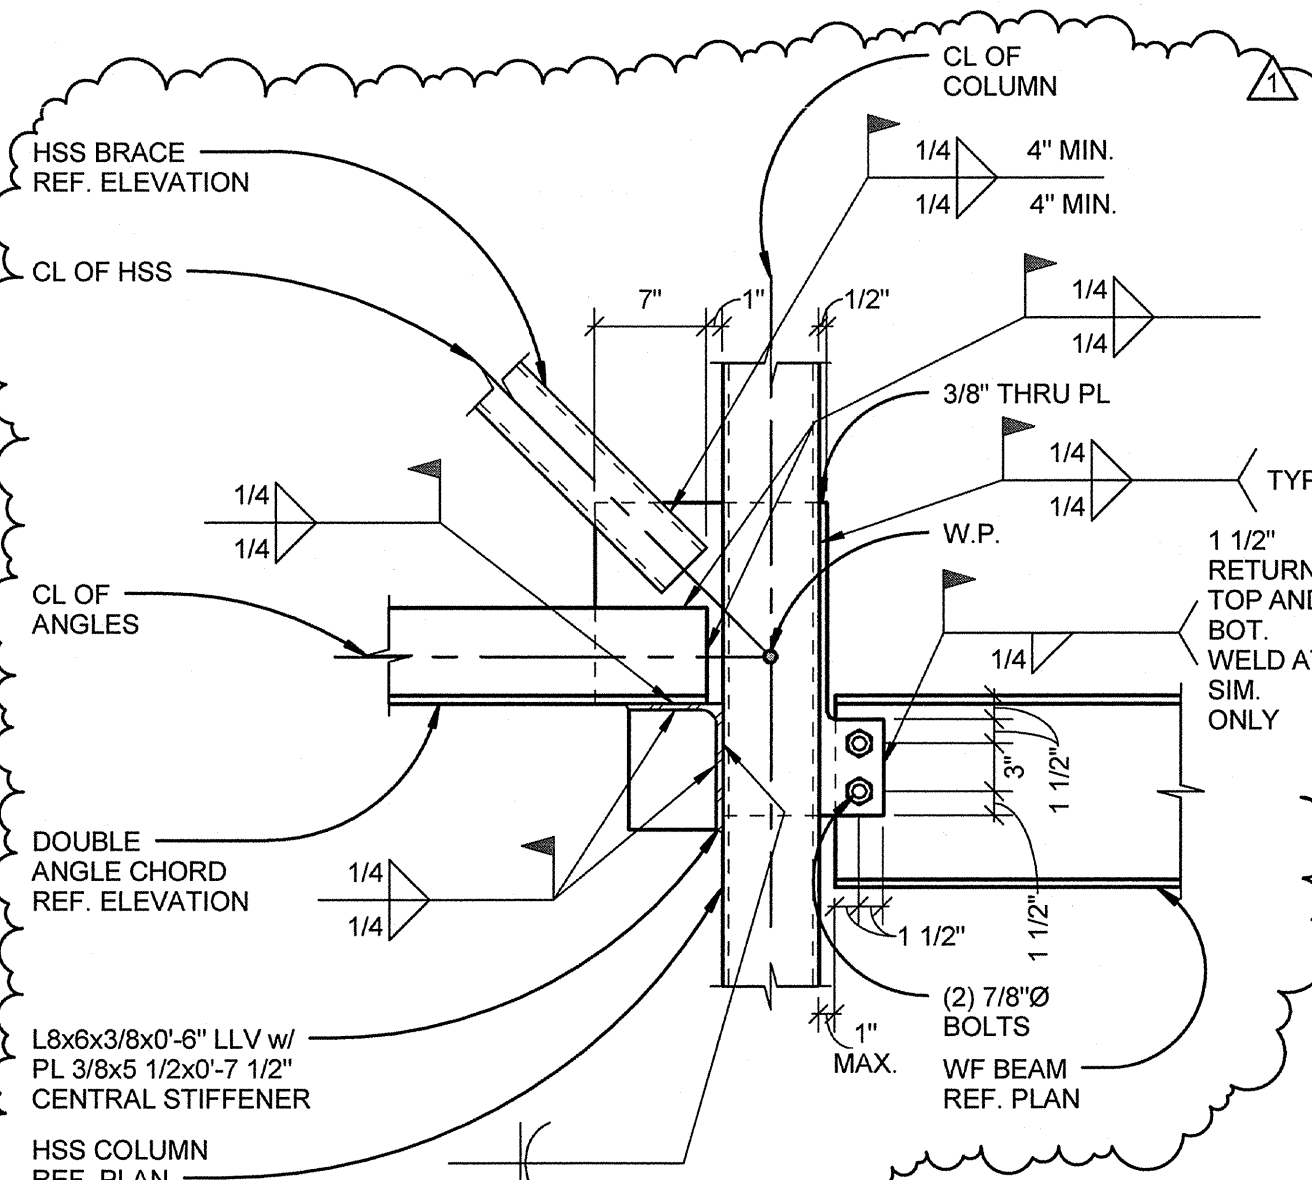


7 TRUSS BOTTOM CHORD CONNECTION
1" = 1'-0"

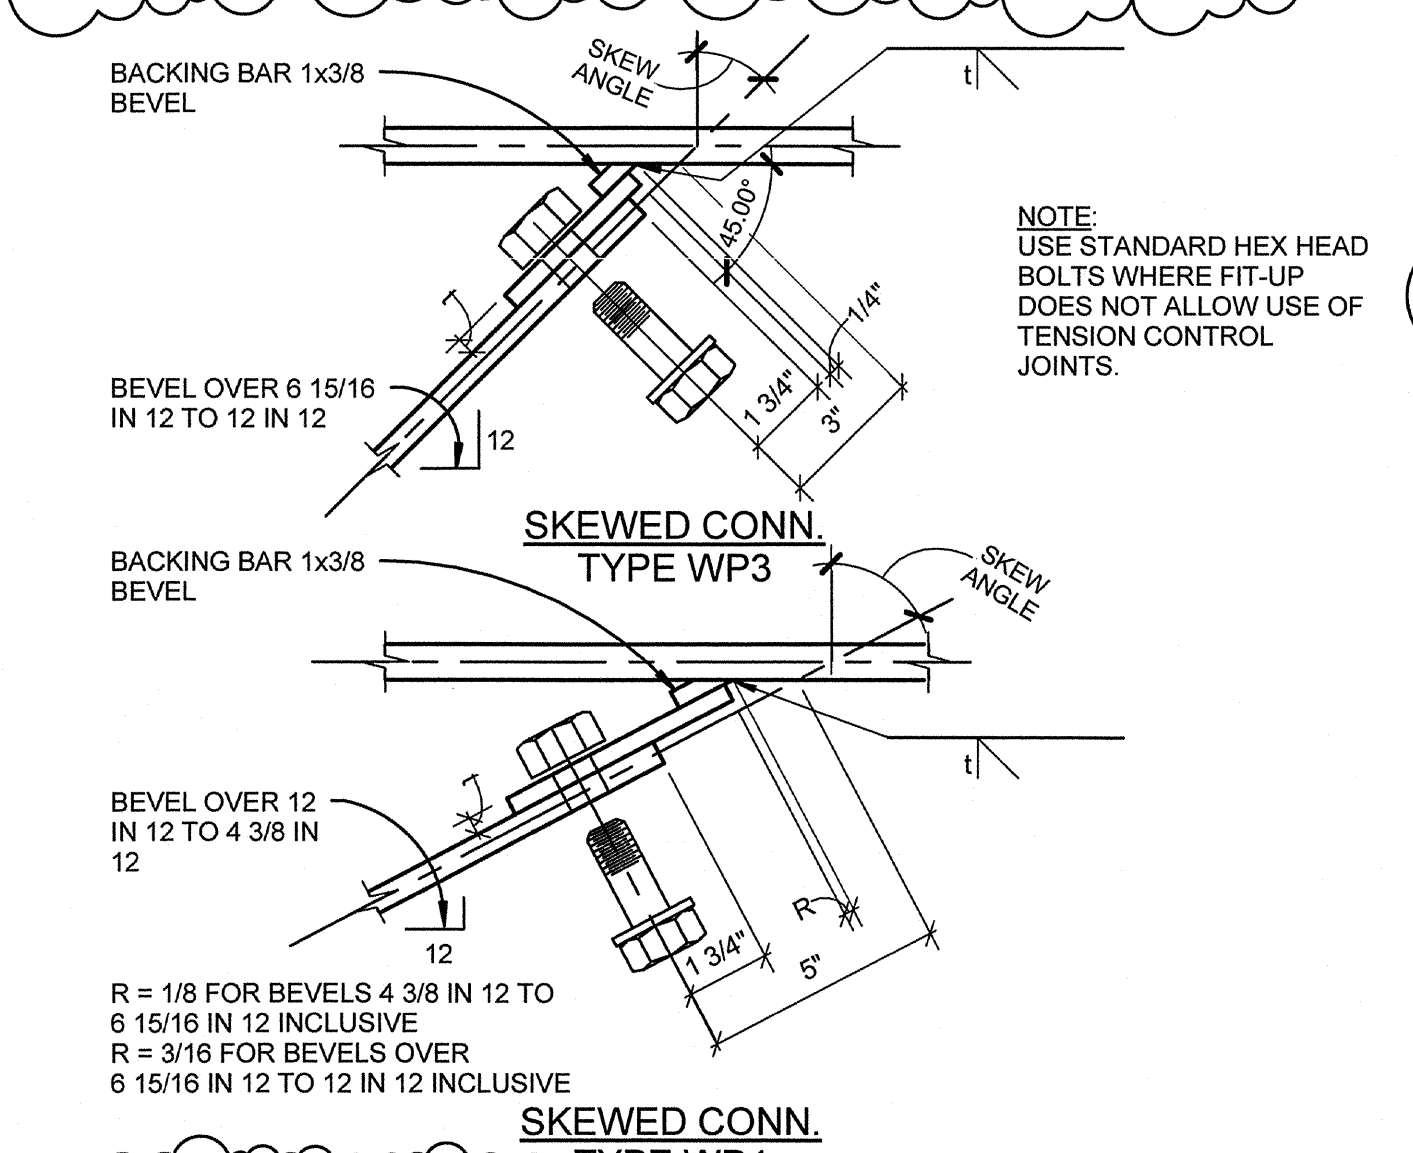


12 TYPICAL SKEWED SHEAR PLATE WELDS
3" = 1'-0"

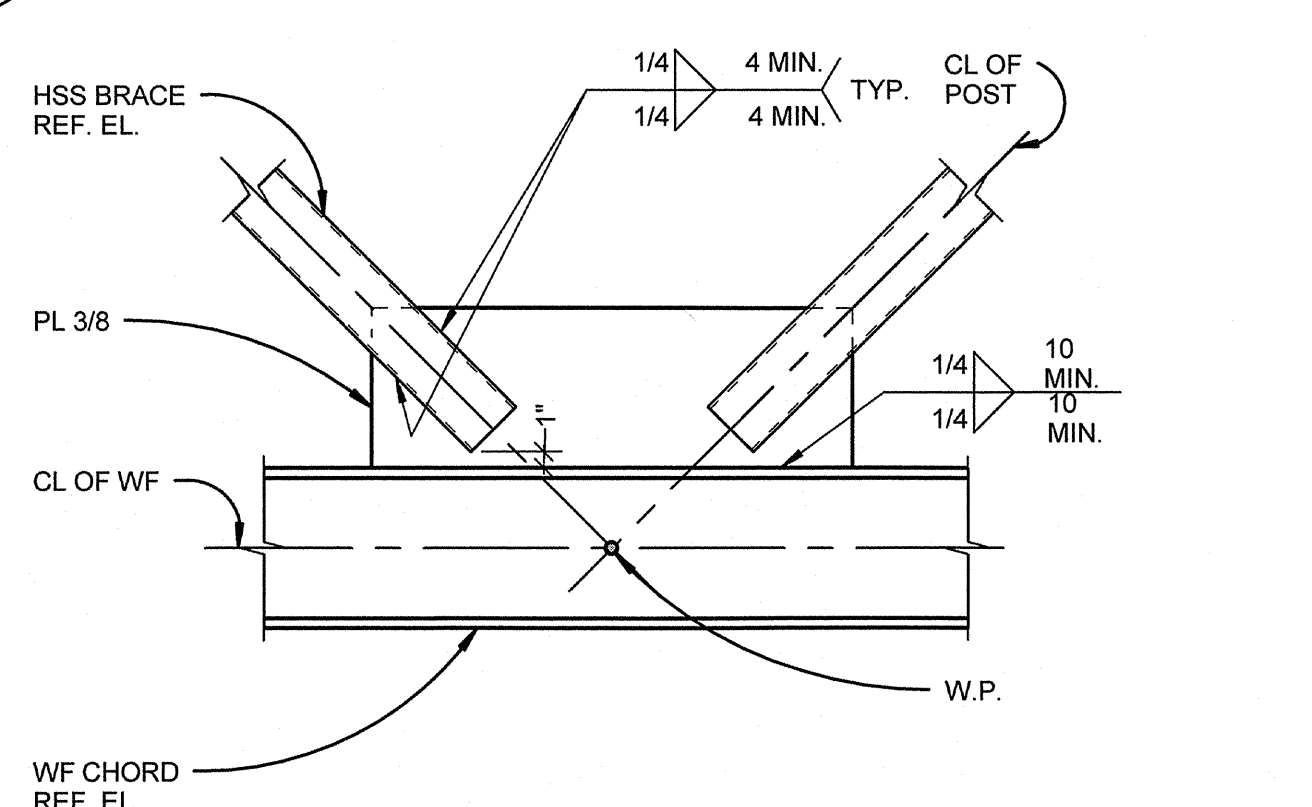


8 TYPICAL HSS BRACE-LOWER CHORD CONNECTION
1" = 1'-0"

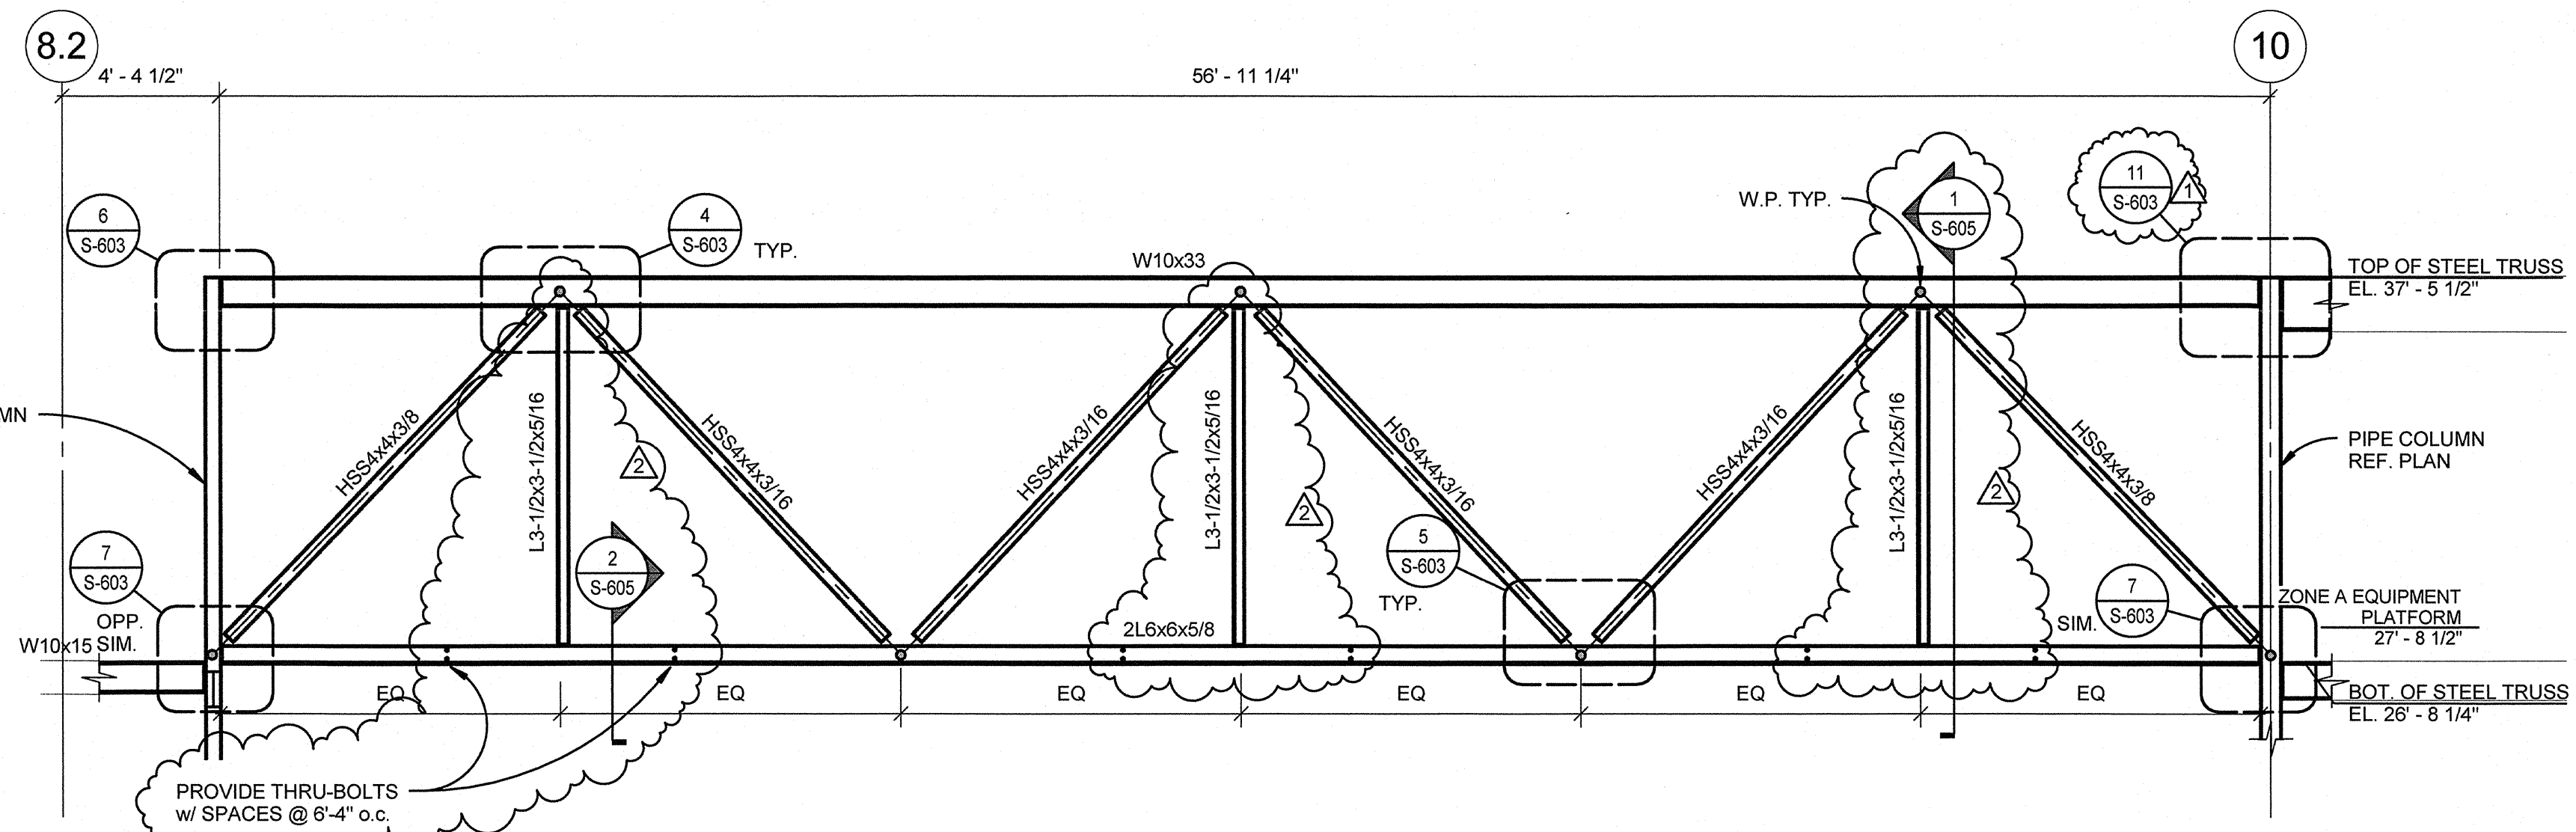

1 STEEL TRUSS ELEVATION - GRID E
1/4" = 1'-0"

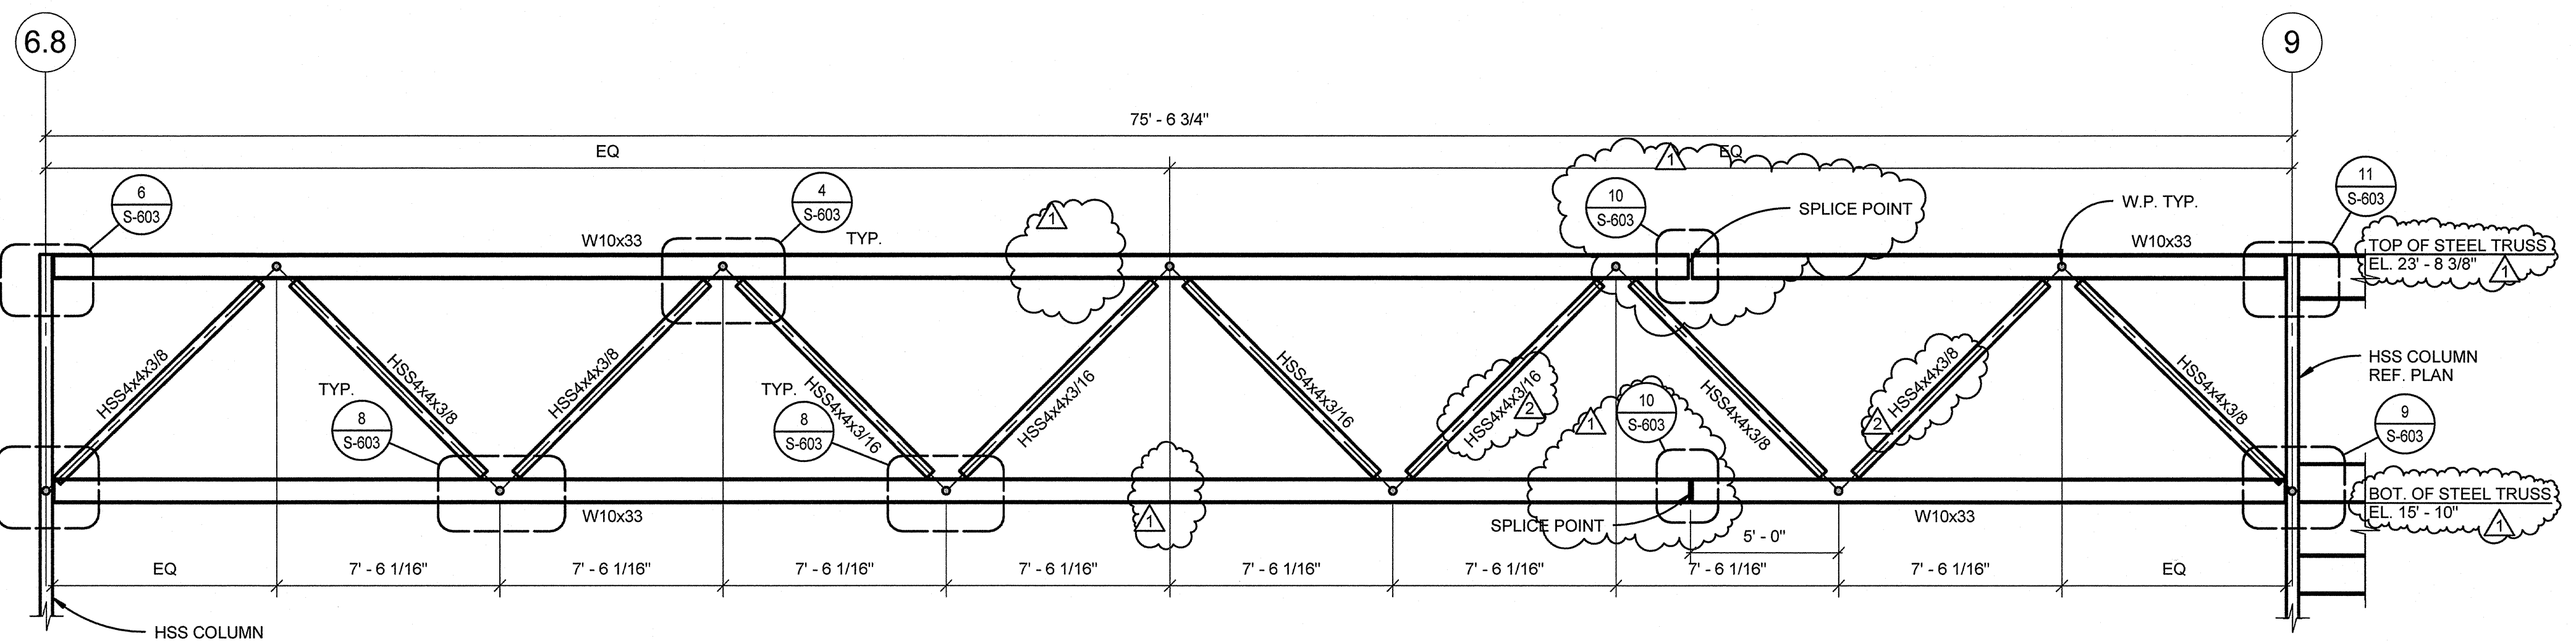

2 STEEL TRUSS ELEVATION - GRID P
1/4" = 1'-0"

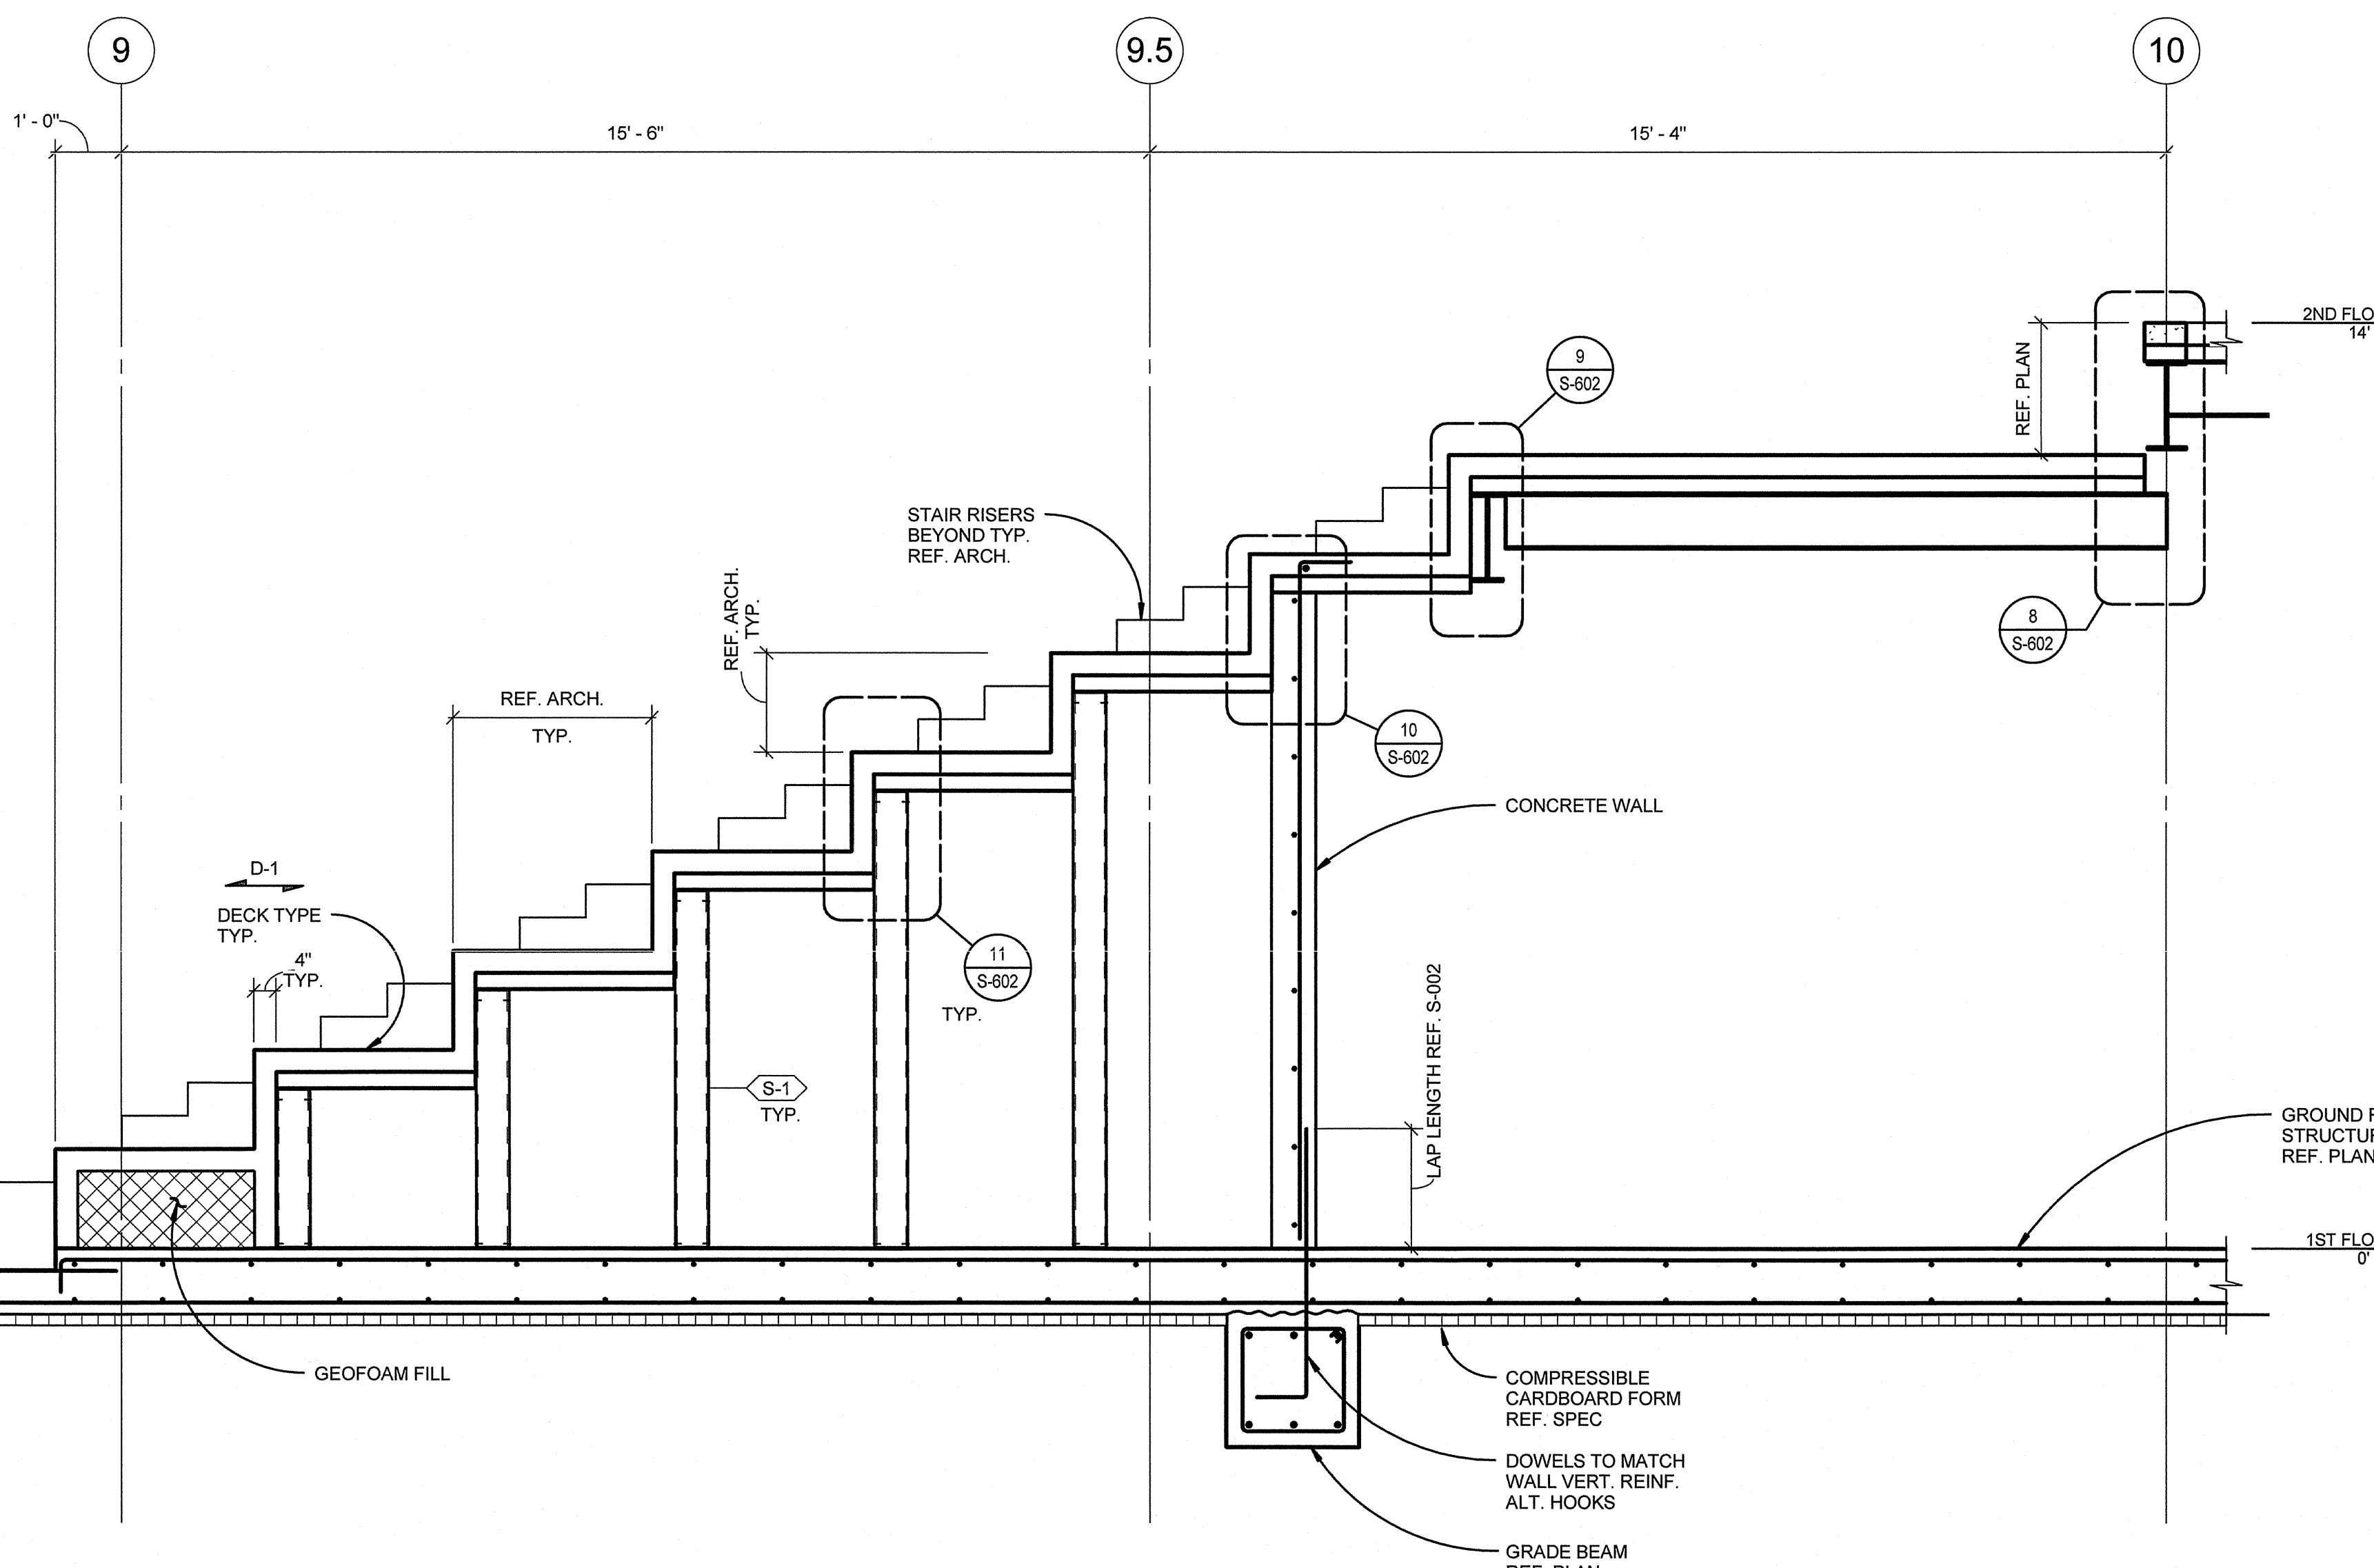

3 SECTION THROUGH FORUM STADIUM SEATING
1/2" = 1'-0"

MARK	DATE	DESCRIPTION
2	3-13-2015	ADDENDUM 6
1	2-18-2015	SUPPLEMENTAL INFO 1


ISSUE DATE: FEBRUARY 18, 2015
ISSUE: CONSTRUCTION DOCUMENTS
VOLUME: PACKAGE 1
PROJECT NO.: 213417
DRAWN BY: MF
CHECKED BY: MT
COPYRIGHT MAHLUM ARCHITECTS, INC. 2014 ORIGINAL SHEET SIZE: 30"X42"

STEEL DETAILS

MARK	DATE	DESCRIPTION
3	3-13-2015	ADDENDUM 6
2	3-6-2015	ADDENDUM 3
1	2-18-2015	SUPPLEMENTAL INFO 1

ISSUE DATE: FEBRUARY 18, 2015
 ISSUE: CONSTRUCTION DOCUMENTS
 VOLUME: PACKAGE 1
 PROJECT NO: 213417
 DRAWN BY: MF
 CHECKED BY: MT
COPYRIGHT MAHLUM ARCHITECTS, INC. 2014 ORIGINAL SHEET SIZE: 30"X42"

STEEL DETAILS

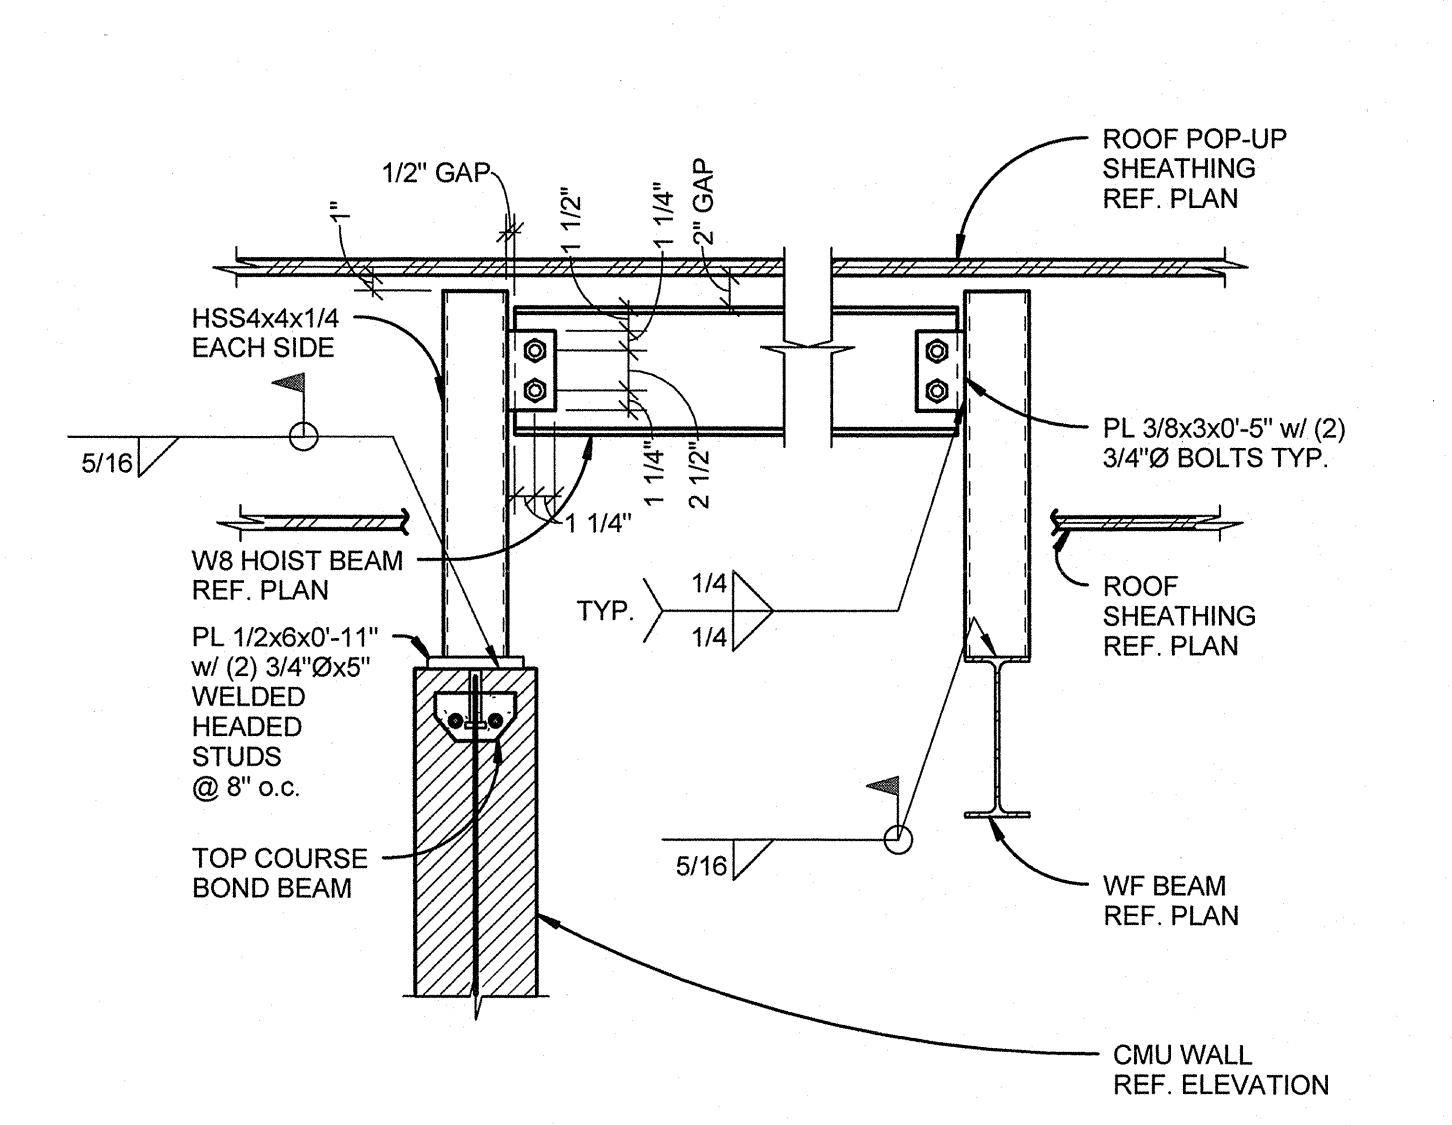


1 ELEVATOR HOIST BEAM DETAIL
1" = 1'-0"

GYM EQUIPMENT LOADING ON STEEL JOISTS


EQUIPMENT SUPPORTED	Fx	Fy	AXIAL
FRONT FOLD HOOP	717#	844#	209#
SIDE FOLD HOOP	771#	801# AND -134#	176#
VOLLEY BALL NET	N/A	1940#	N/A

NOTE: REF. 4/S-604 FOR LOADING DETAIL


5 GYM EQUIPMENT LOADING SCHEDULE
1" = 1'-0"

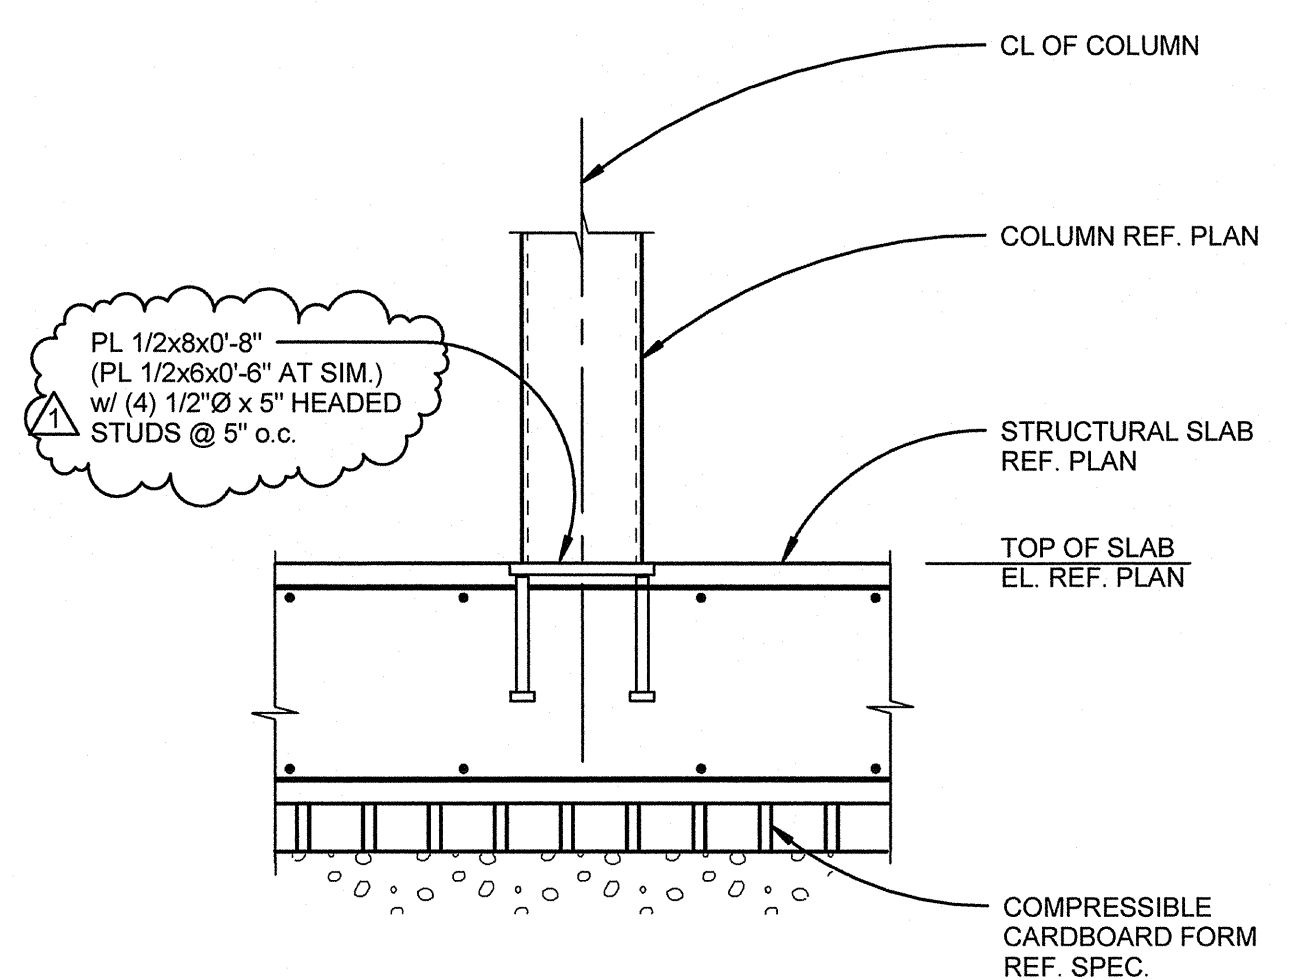


6 COLUMN BASE ON STRUCTURAL SLAB
1 1/2" = 1'-0"

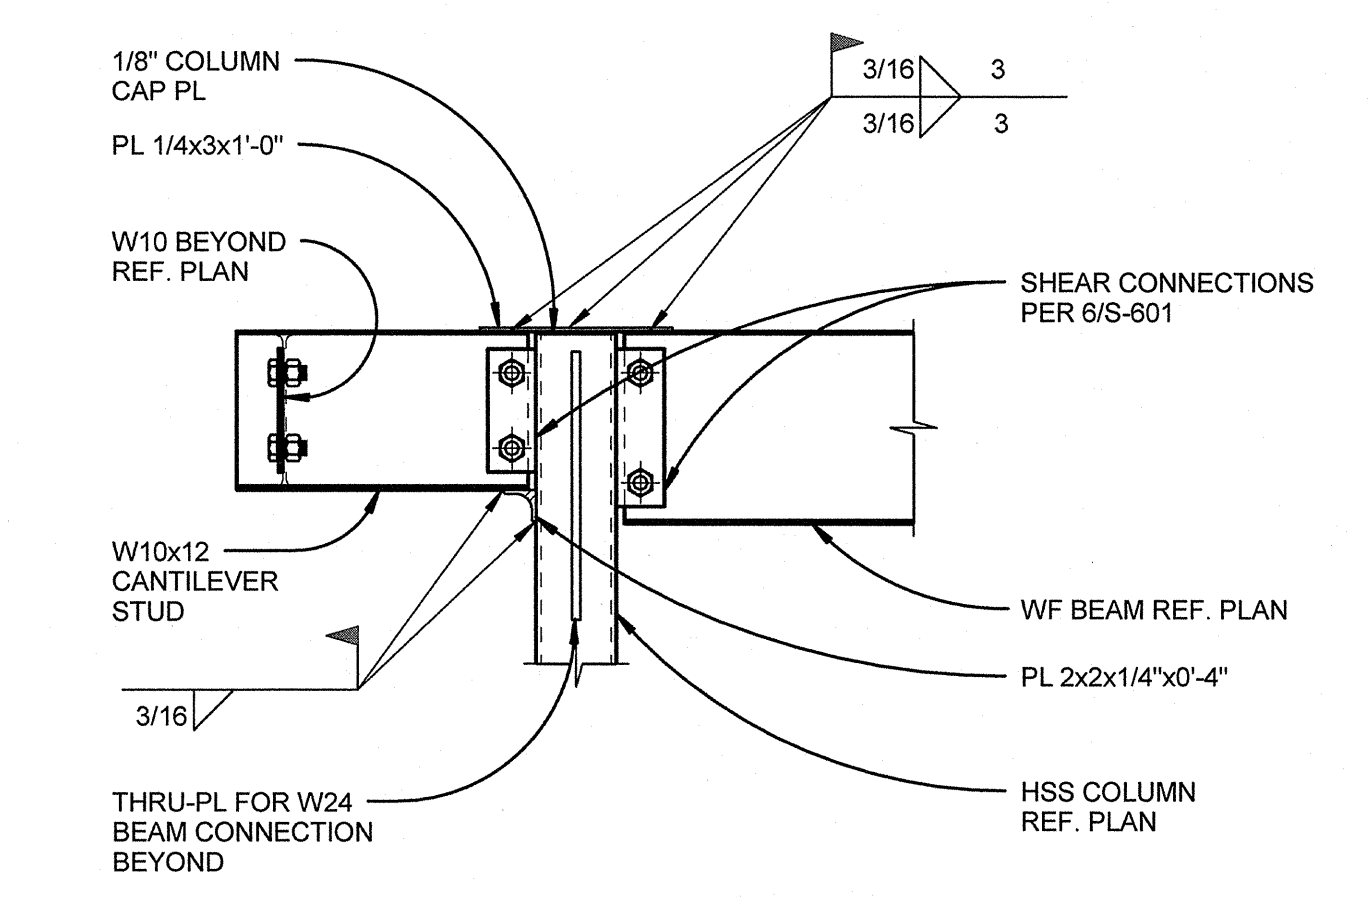


2 CANTILEVER STUB DETAIL
1" = 1'-0"

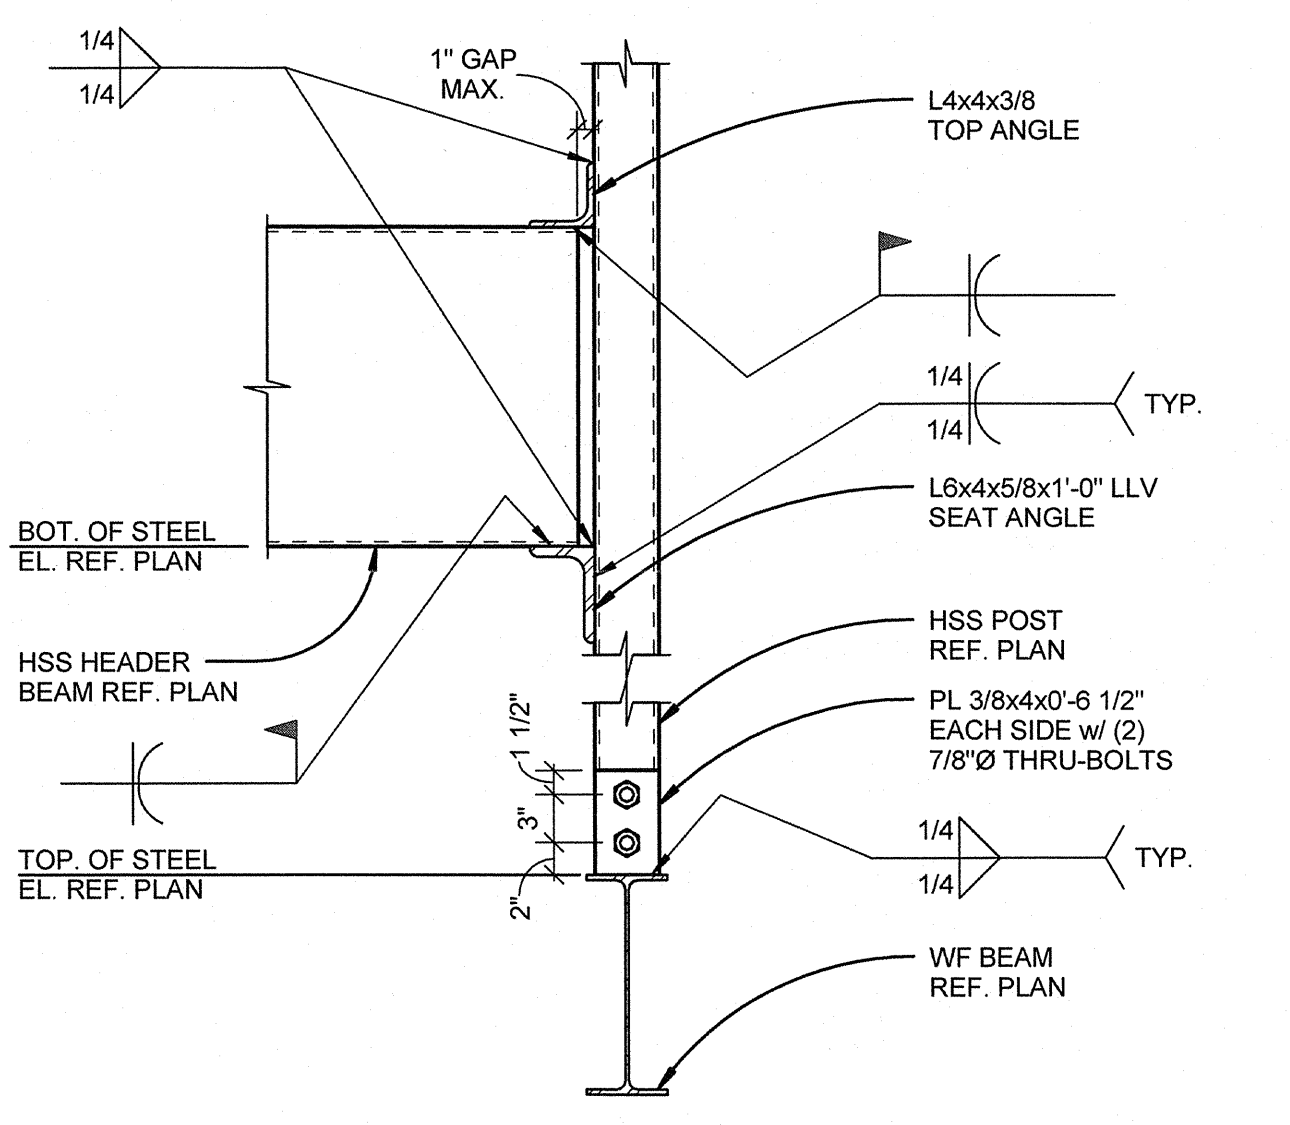


9 HEADER SUPPORT DETAIL
1" = 1'-0"

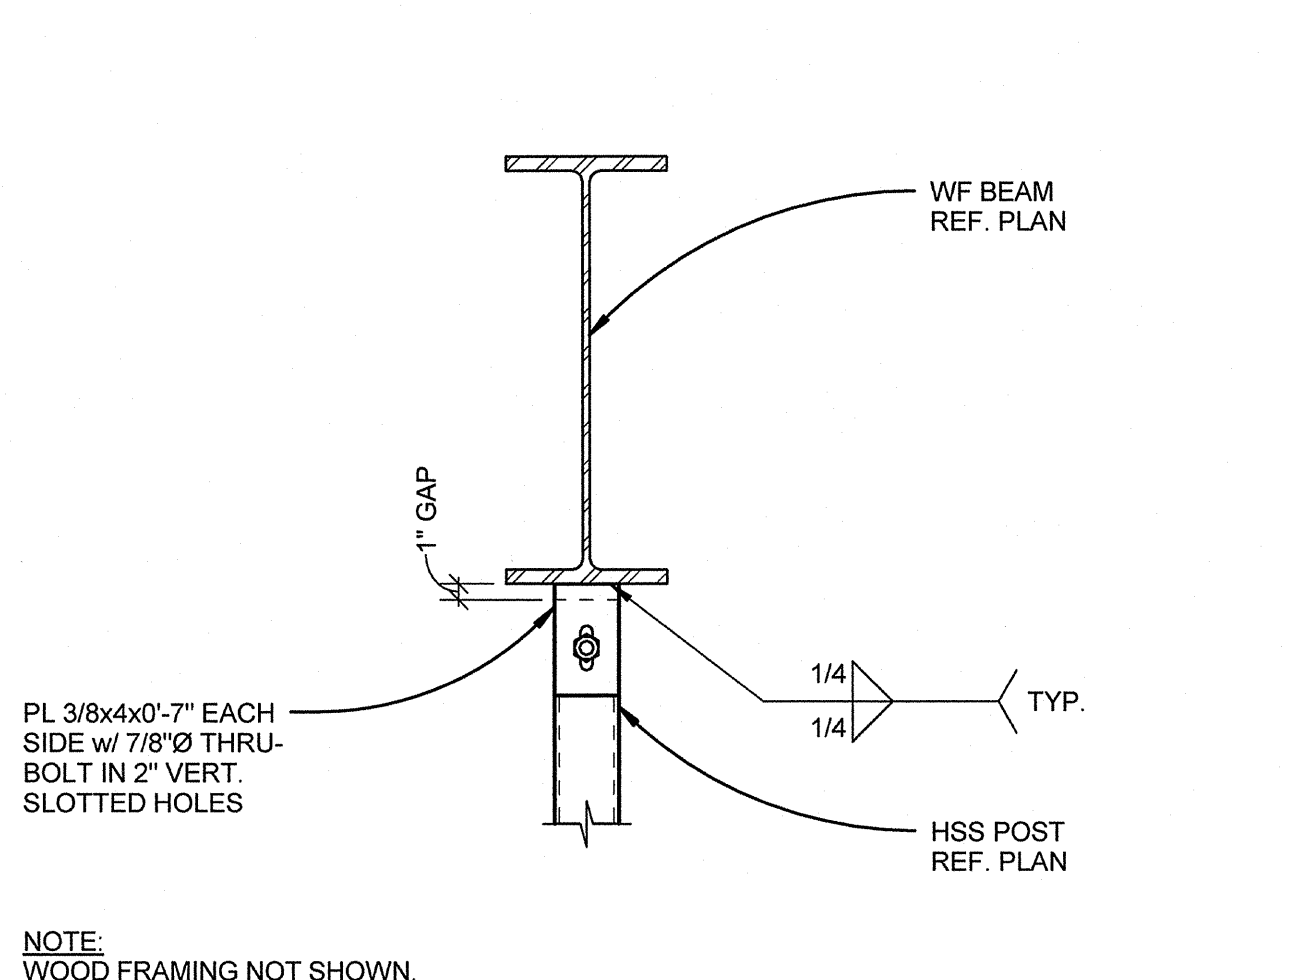


10 POST DEFLECTION HEAD DETAILS
1" = 1'-0"

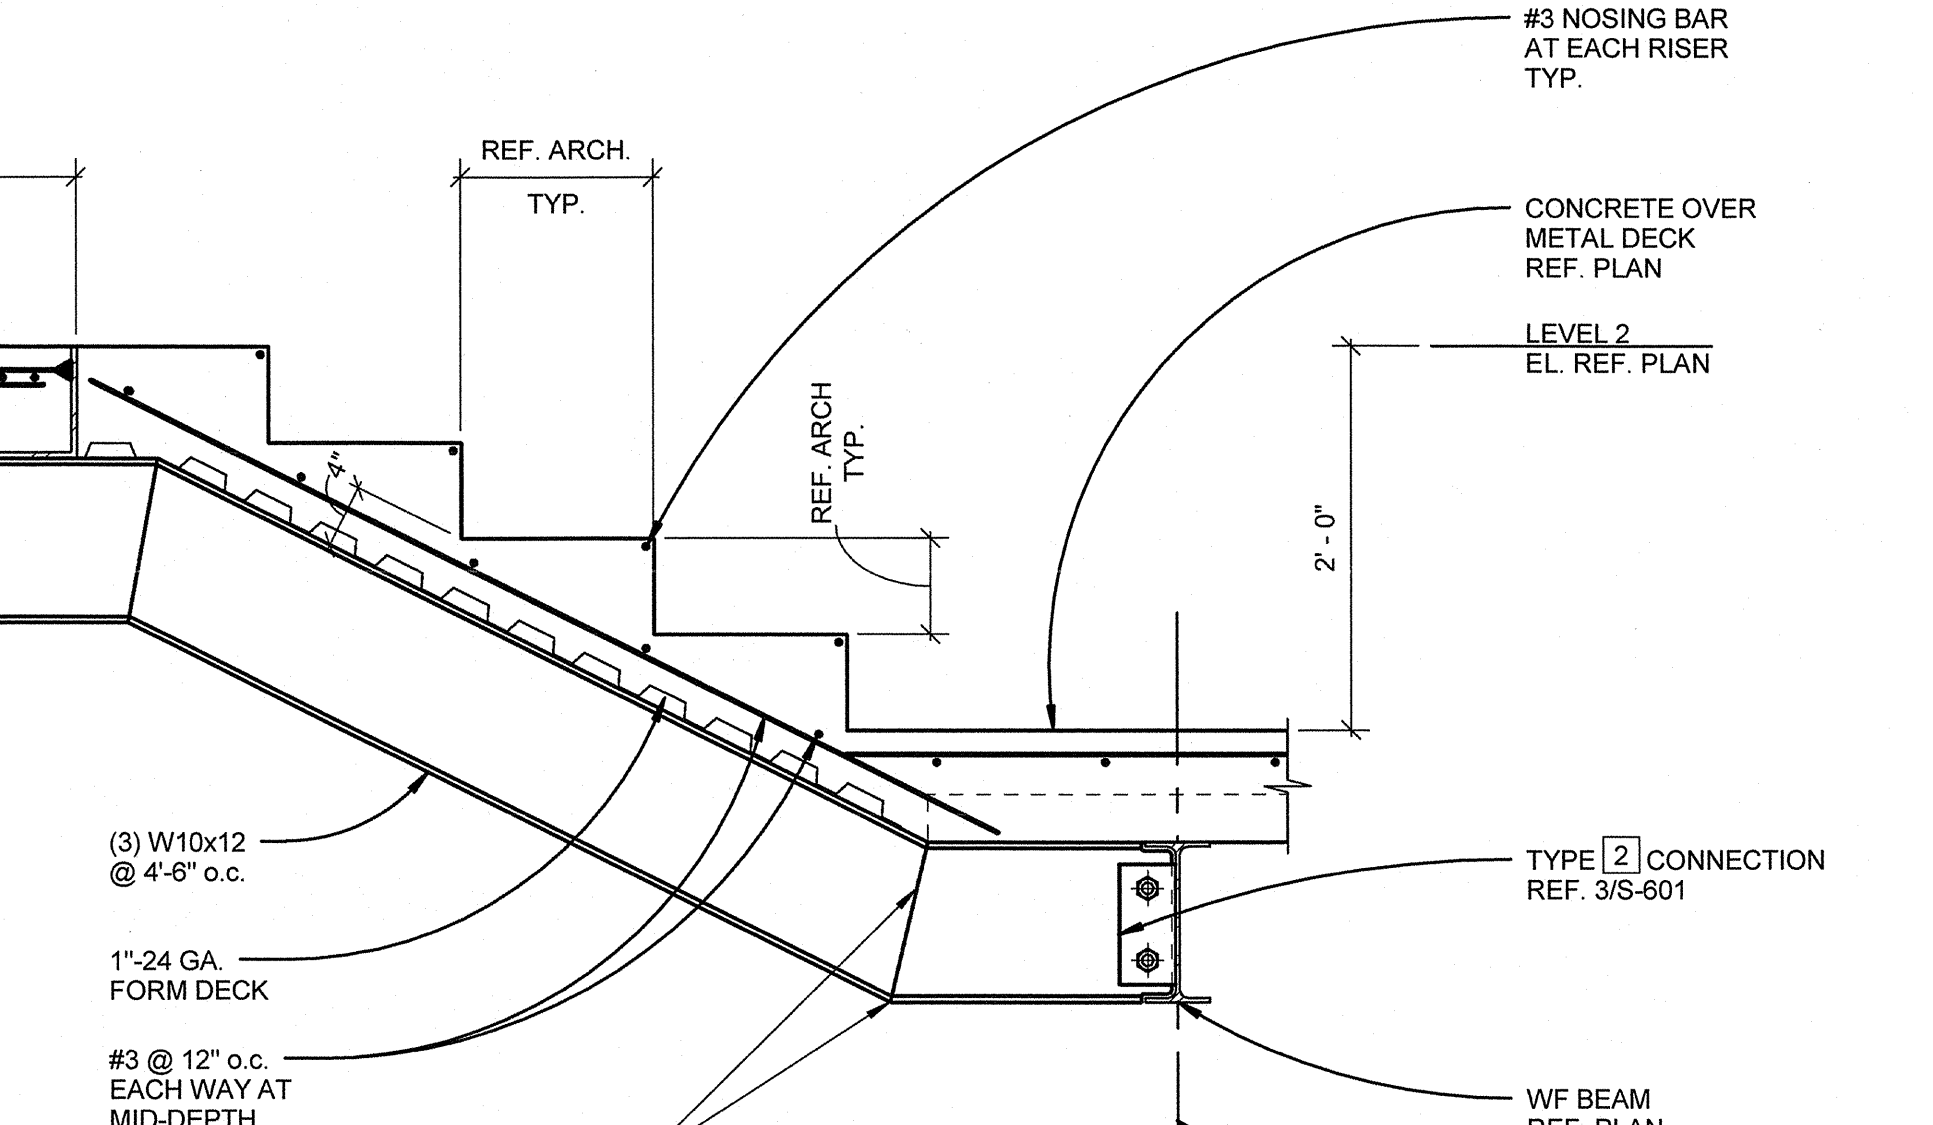



13 FORUM STAIR DETAIL
1" = 1'-0"

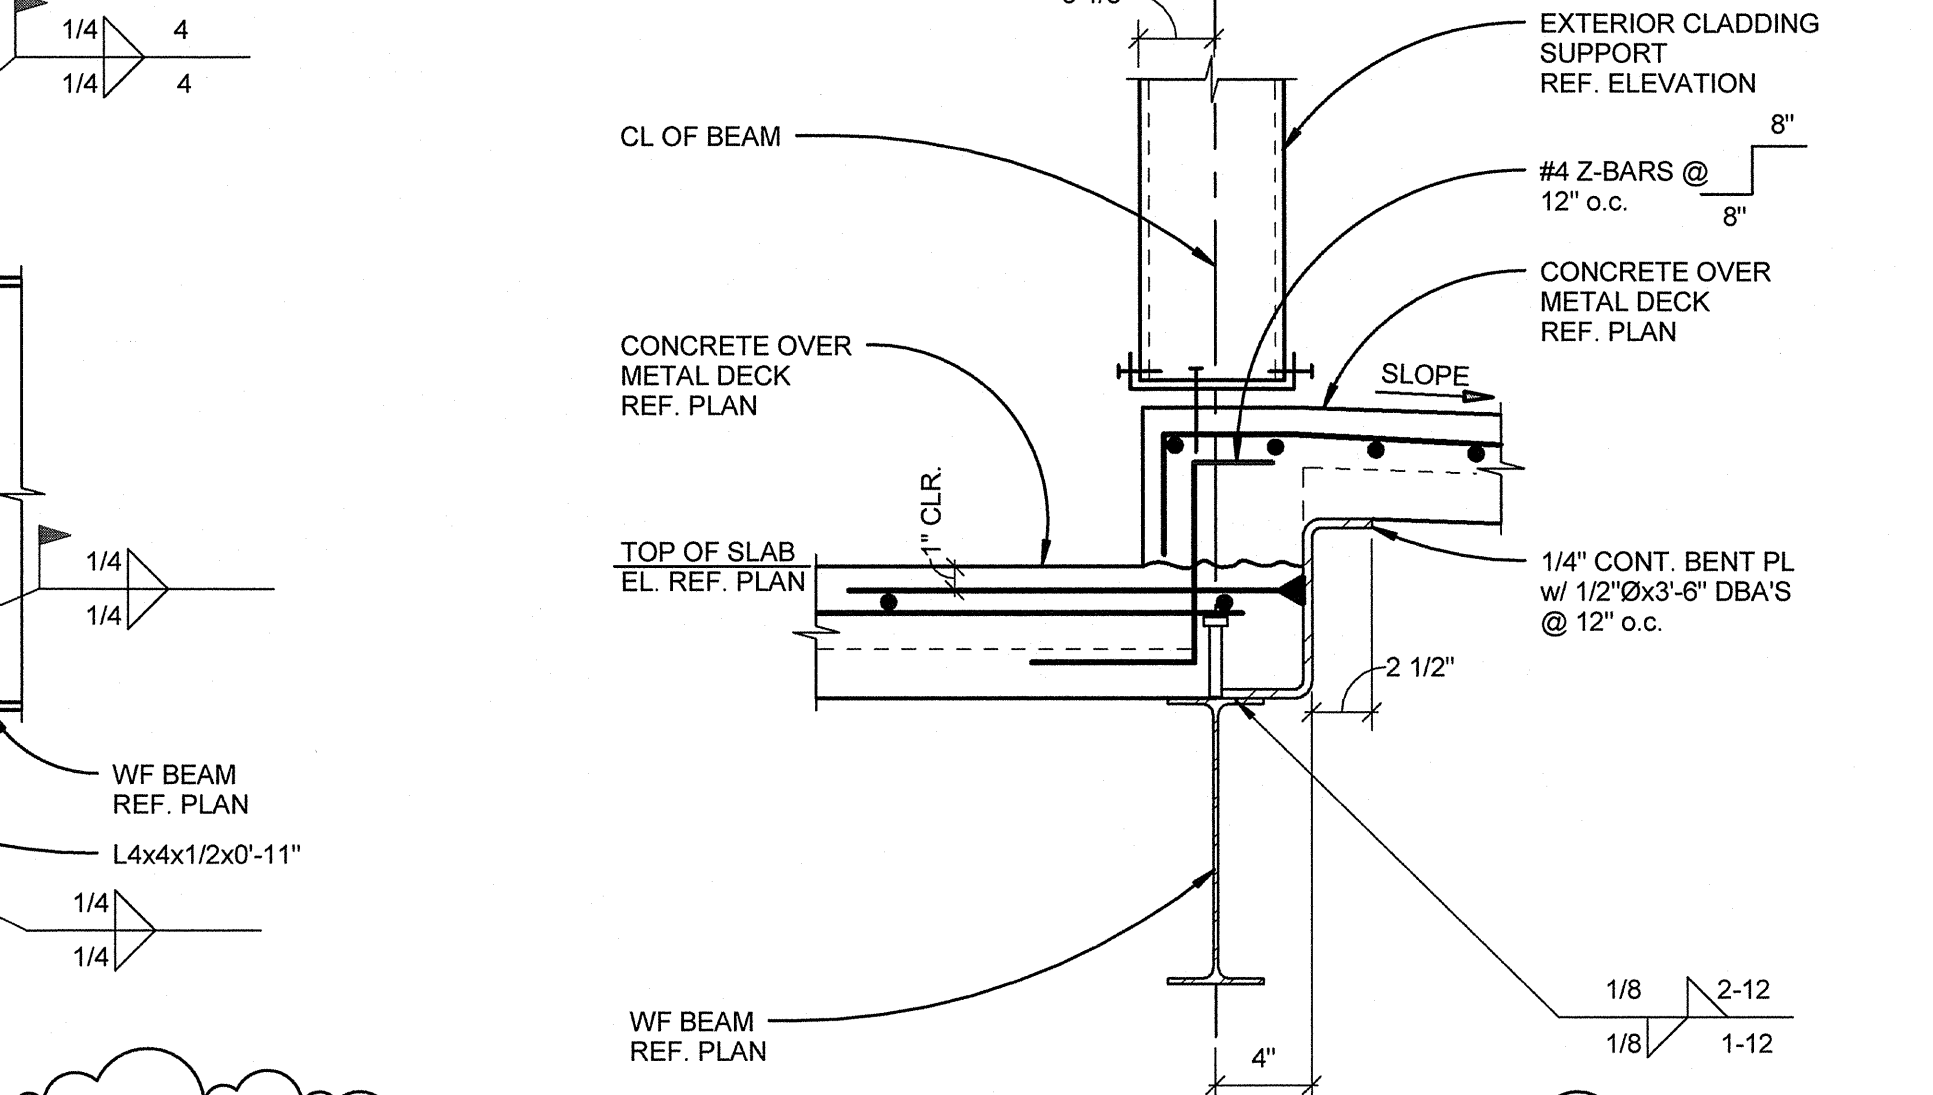


14 SLAB STEP DETAIL
1 1/2" = 1'-0"

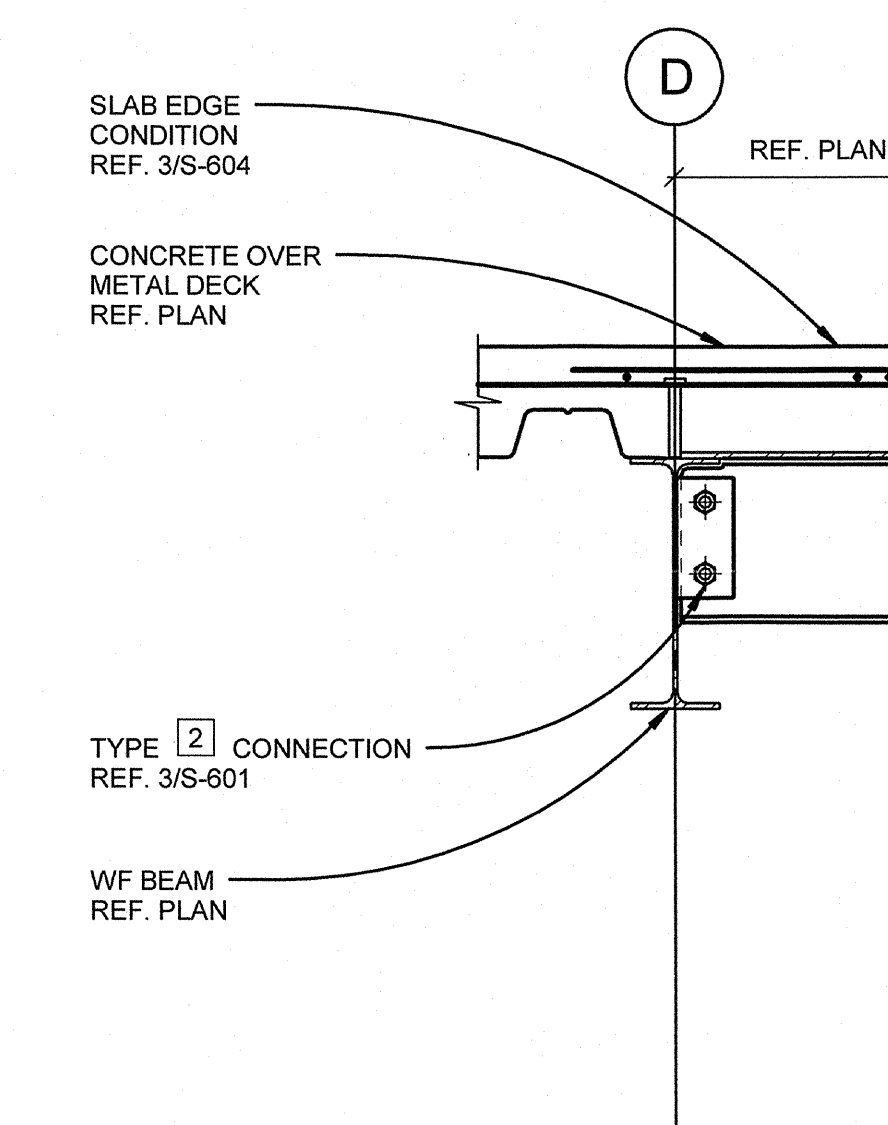


17 BEAM TO COLUMN CONNECTION
1" = 1'-0"

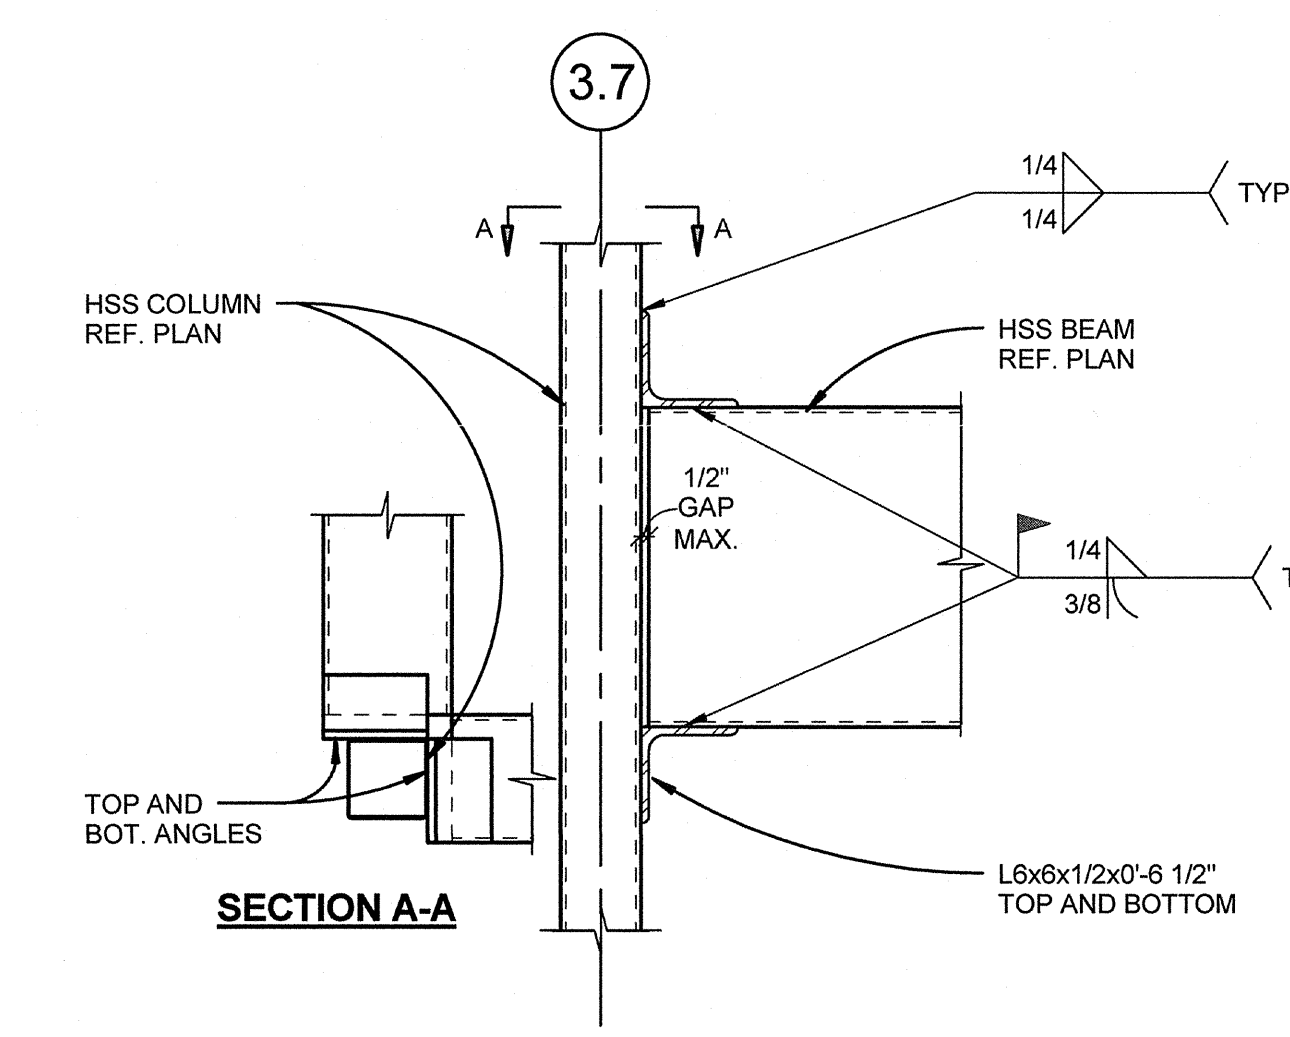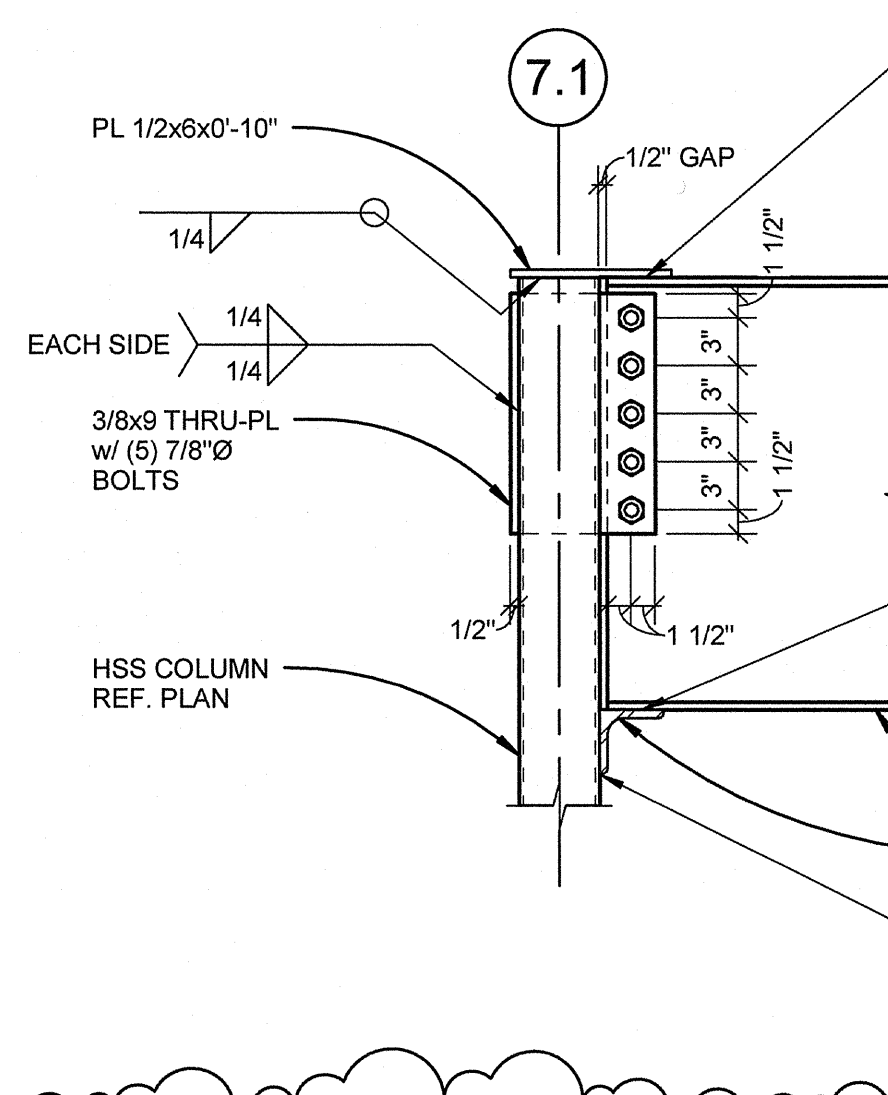


18 BEAMS TO HSS CONNECTOR
1" = 1'-0"

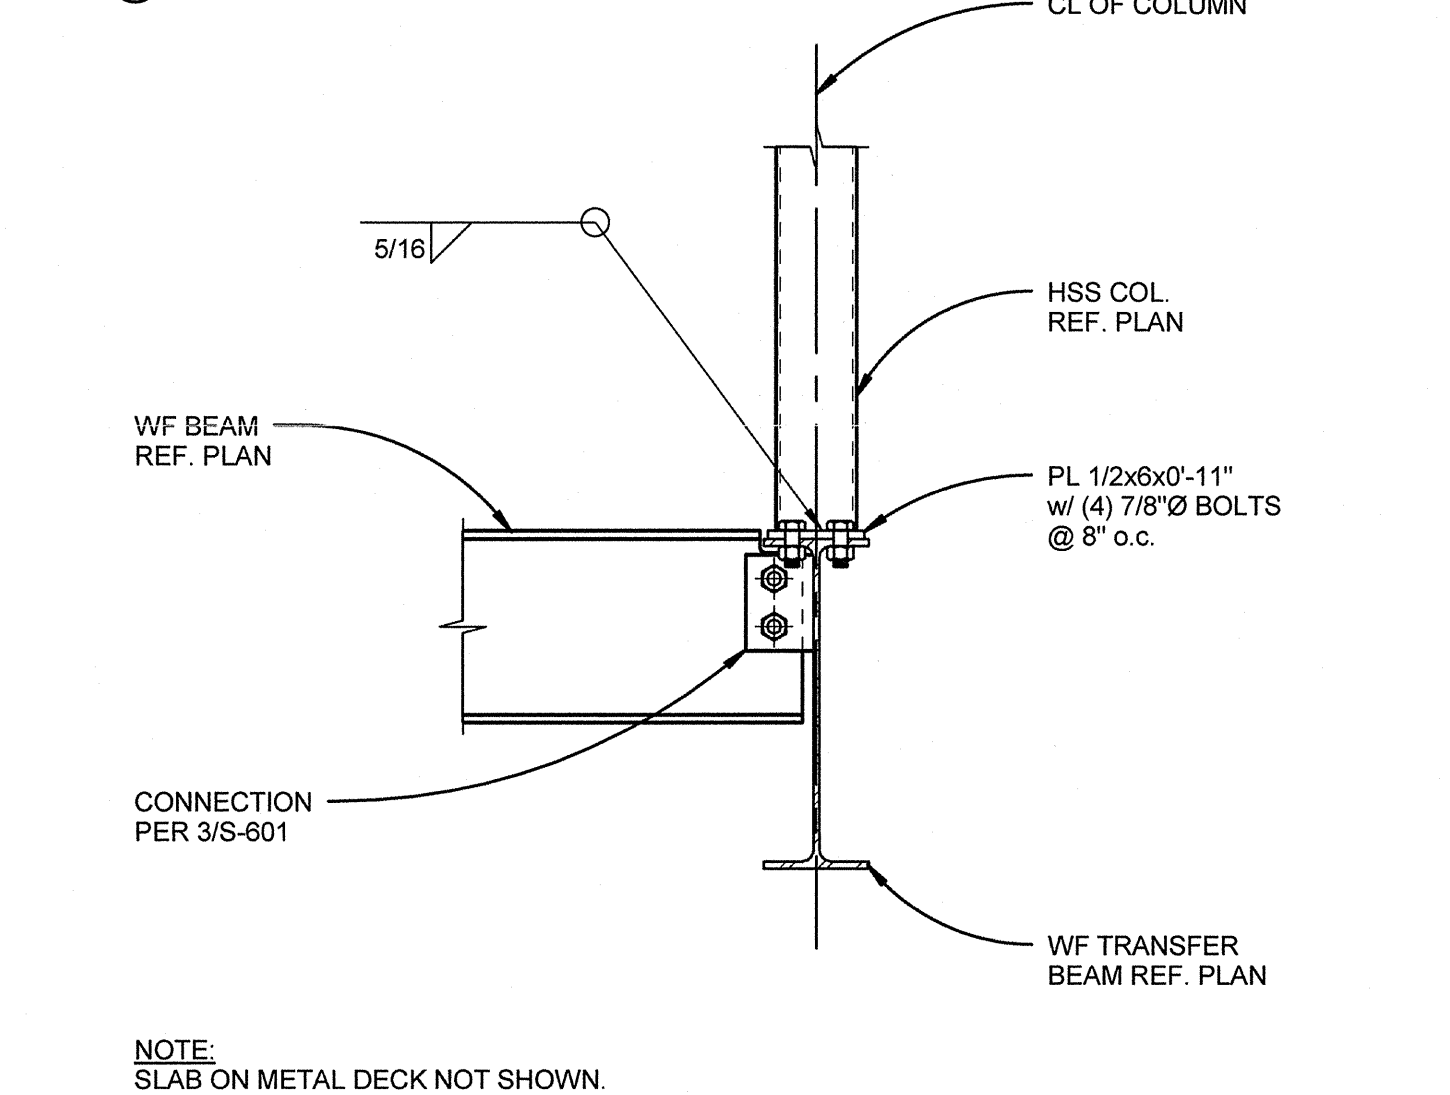


15 DETAIL AT COLUMN TRANSFER
1" = 1'-0"

 


11 NOT USED

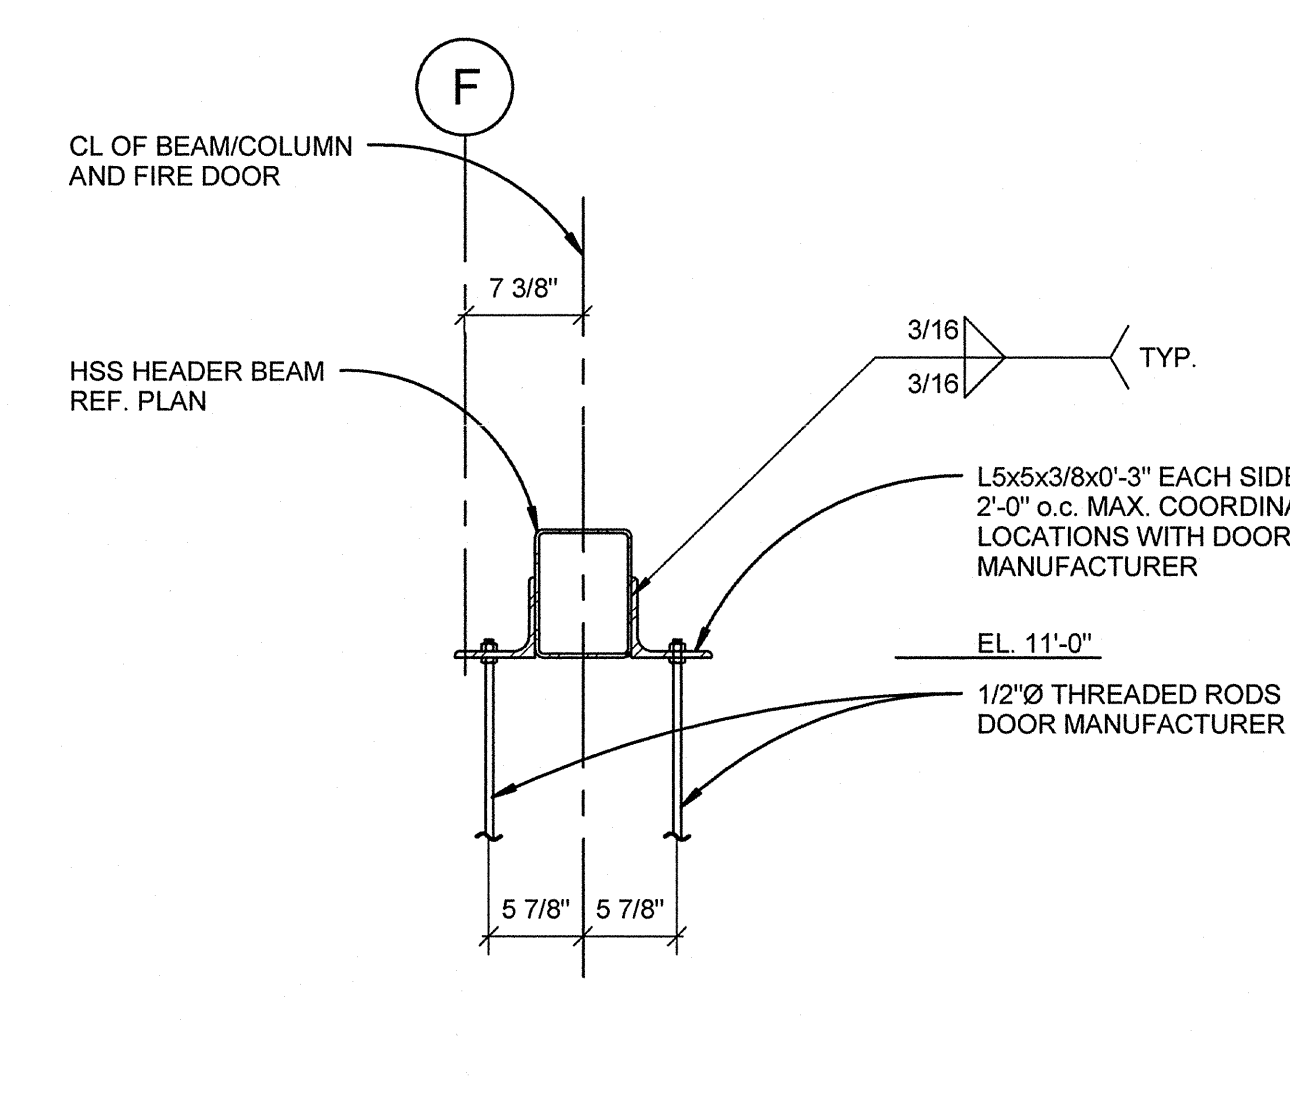


7 FIRE DOOR HEADER DETAIL
1" = 1'-0"

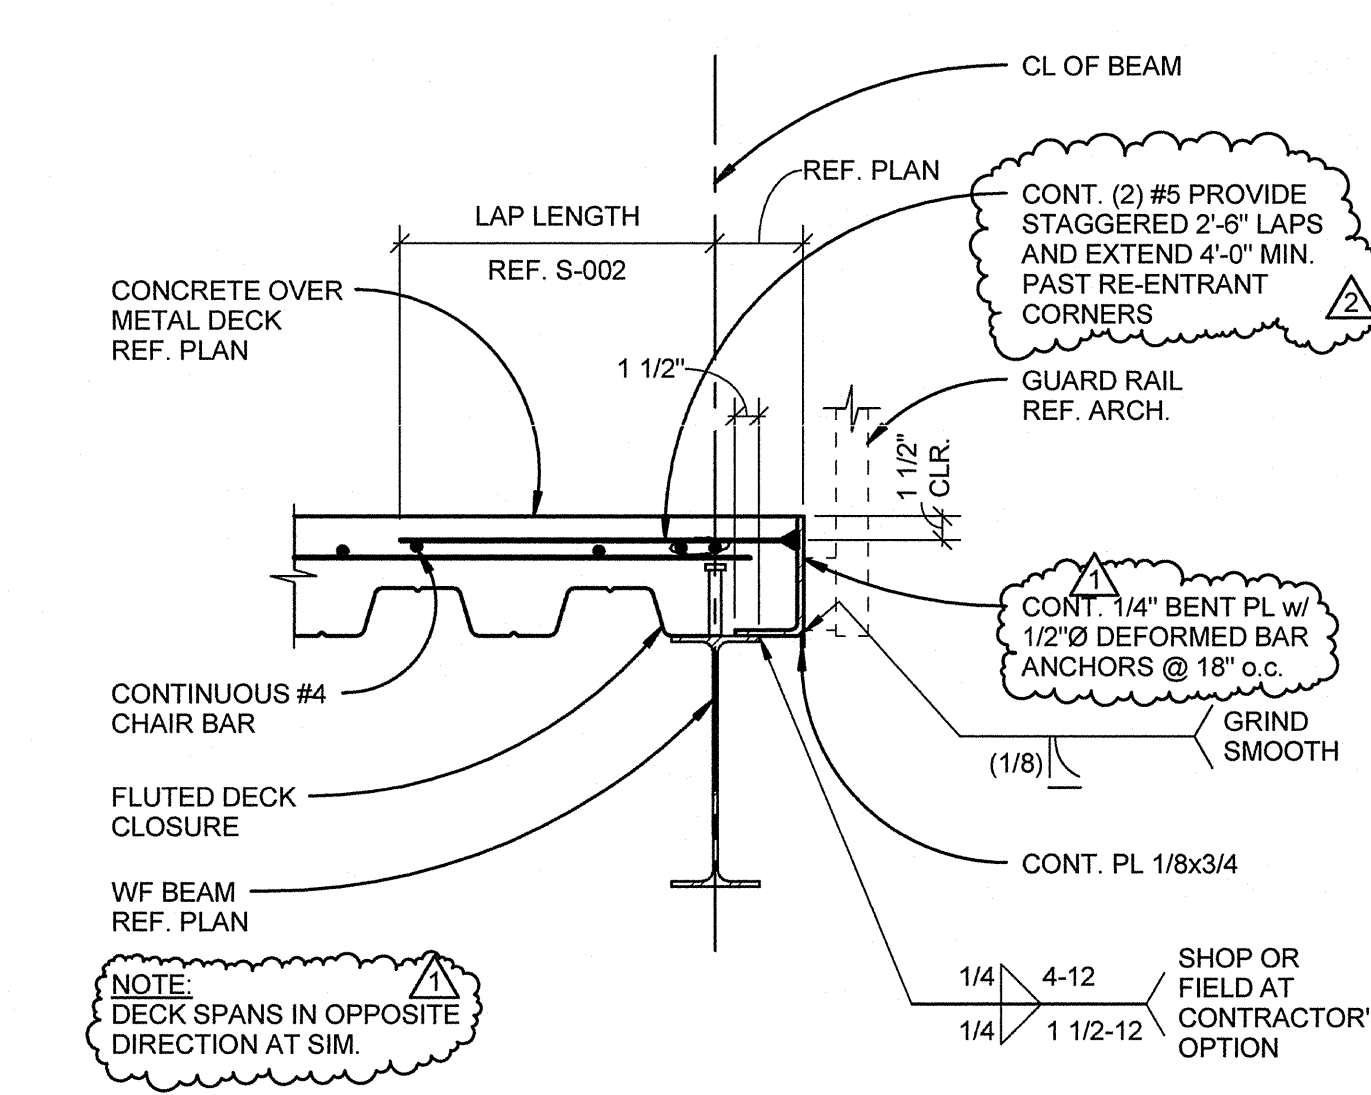


3 TYPICAL EDGE OF DECK DETAIL AT GUARD RAIL
1" = 1'-0"

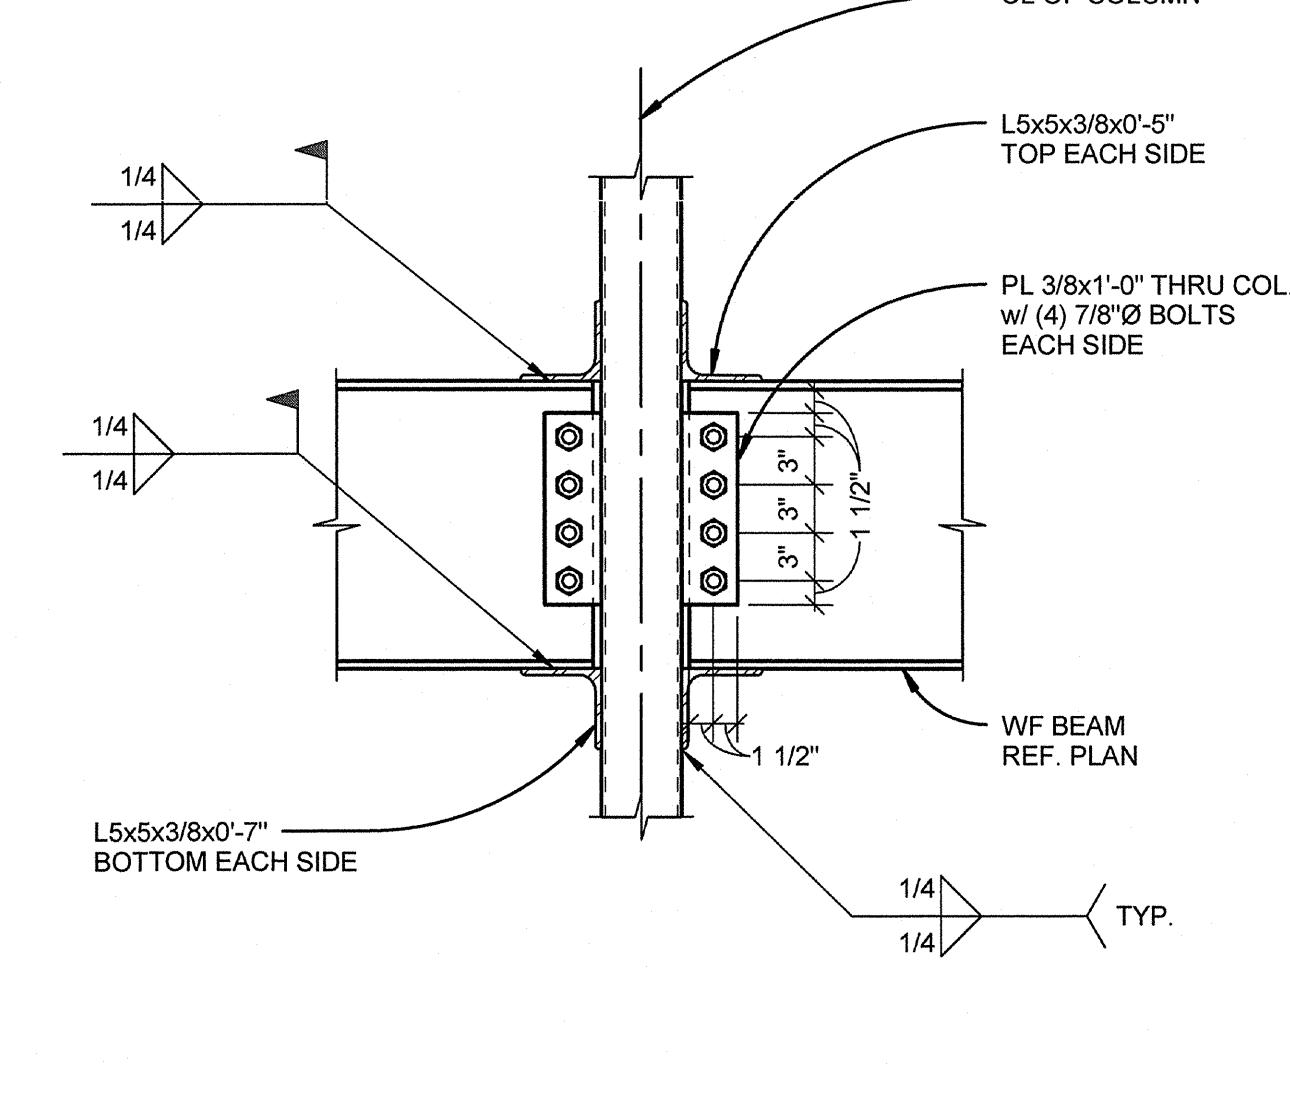


19 FIXED THRU BEAM CONNECTION
1" = 1'-0"

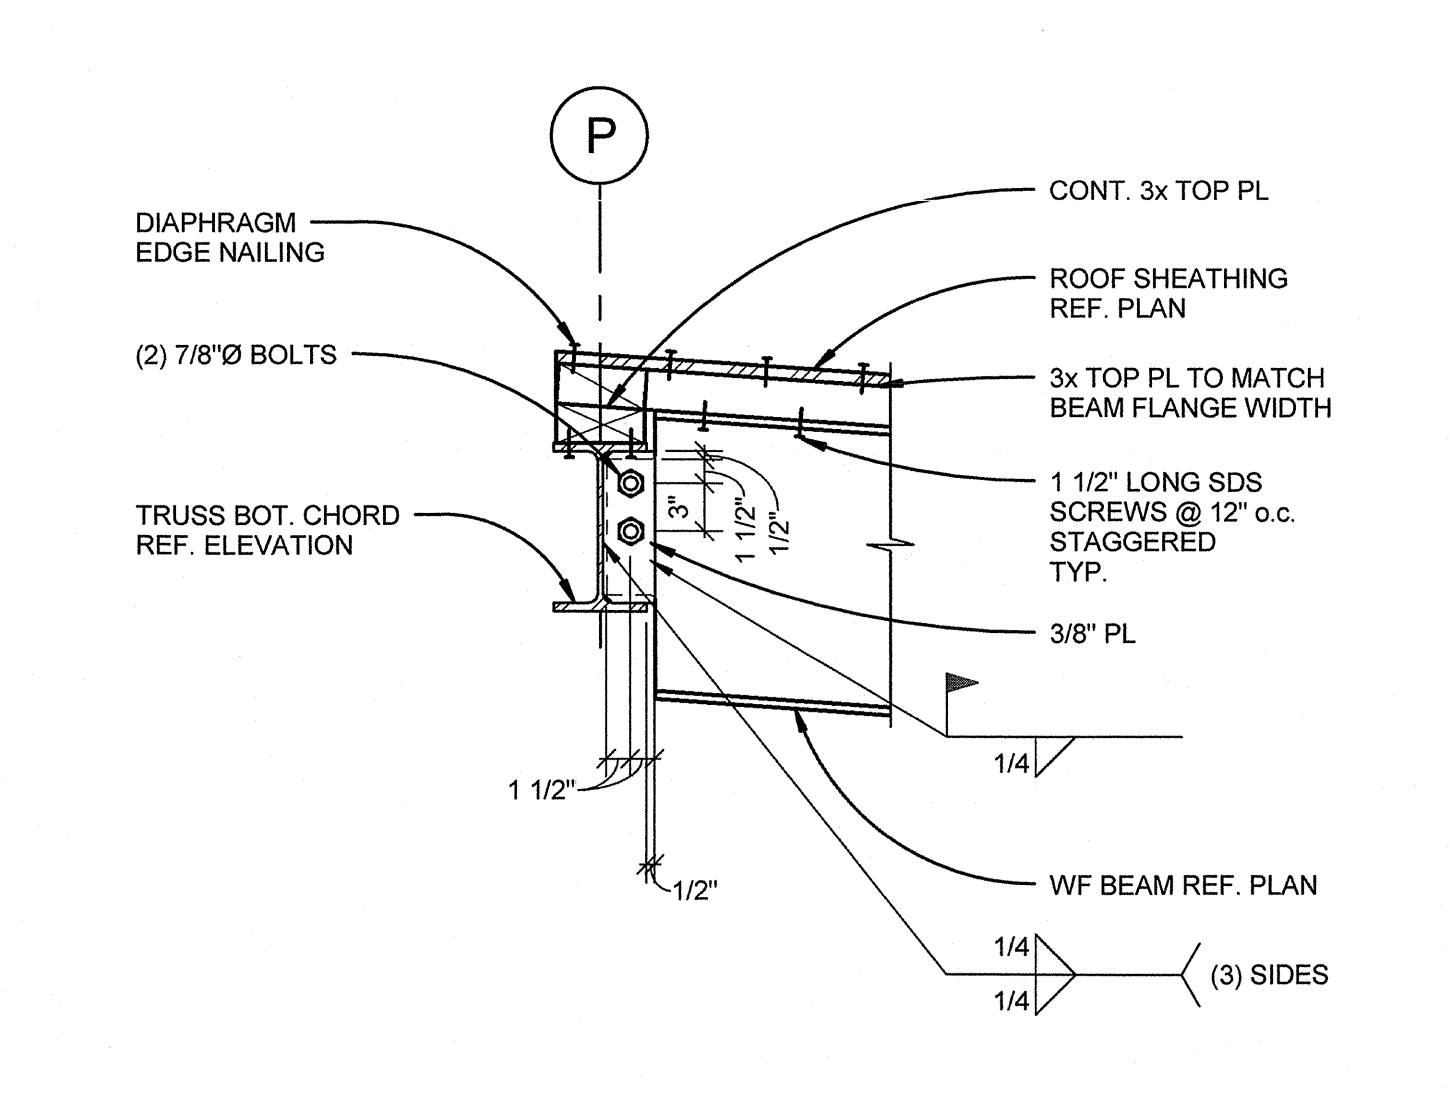

 
16 BEAM TO TRUSS BOTTOM CHORD
1" = 1'-0"



12 NOT USED

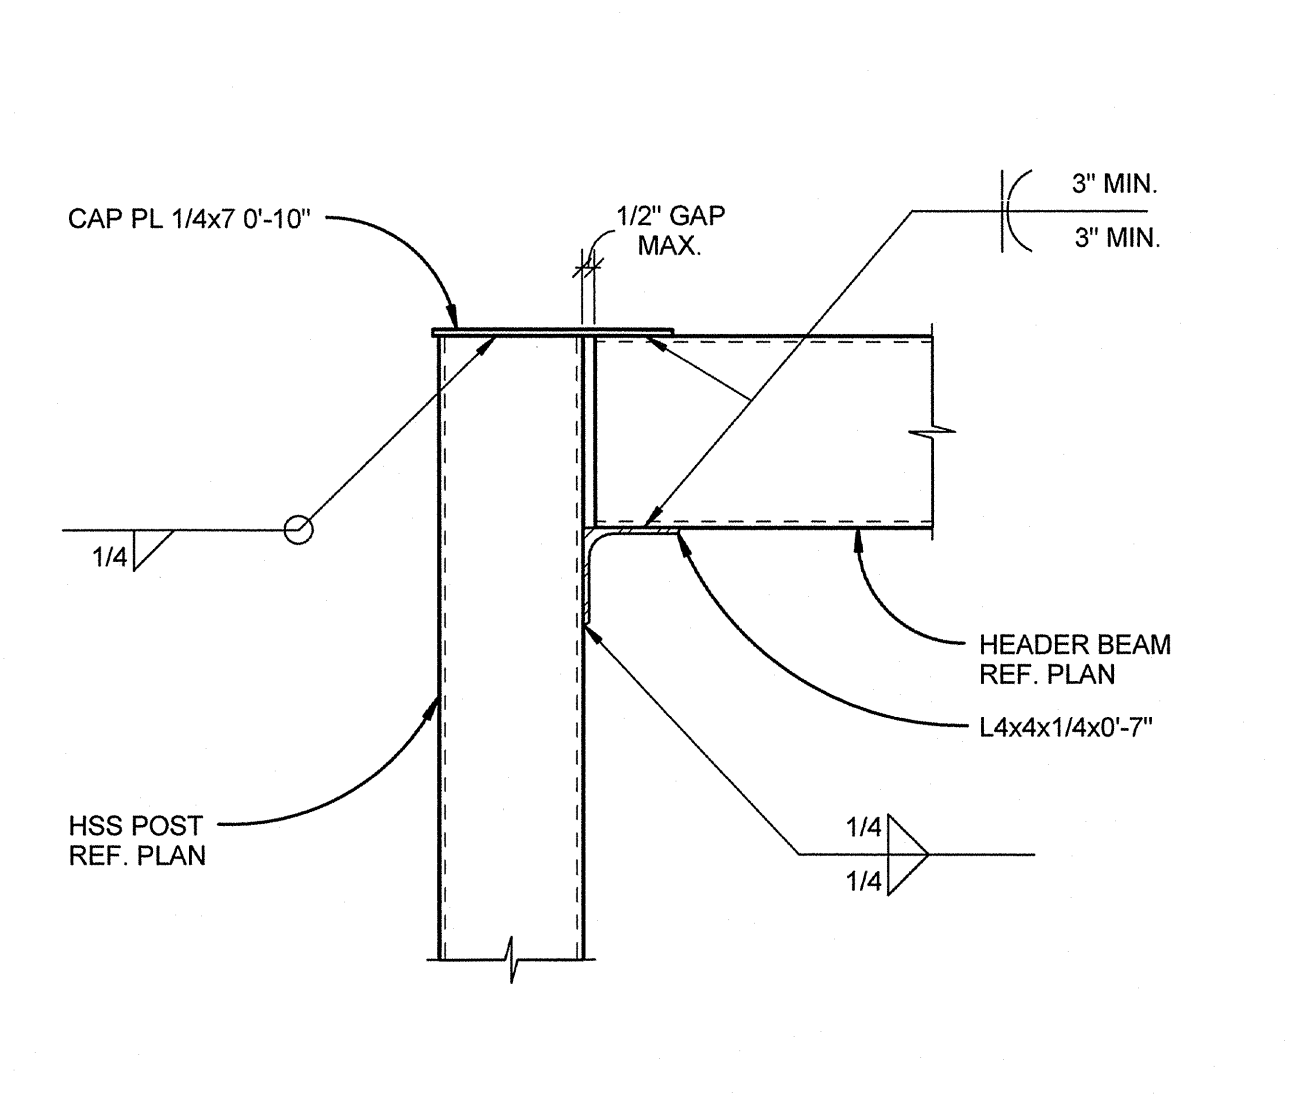

8 FIRE DOOR HEADER CONNECTION
1 1/2" = 1'-0"

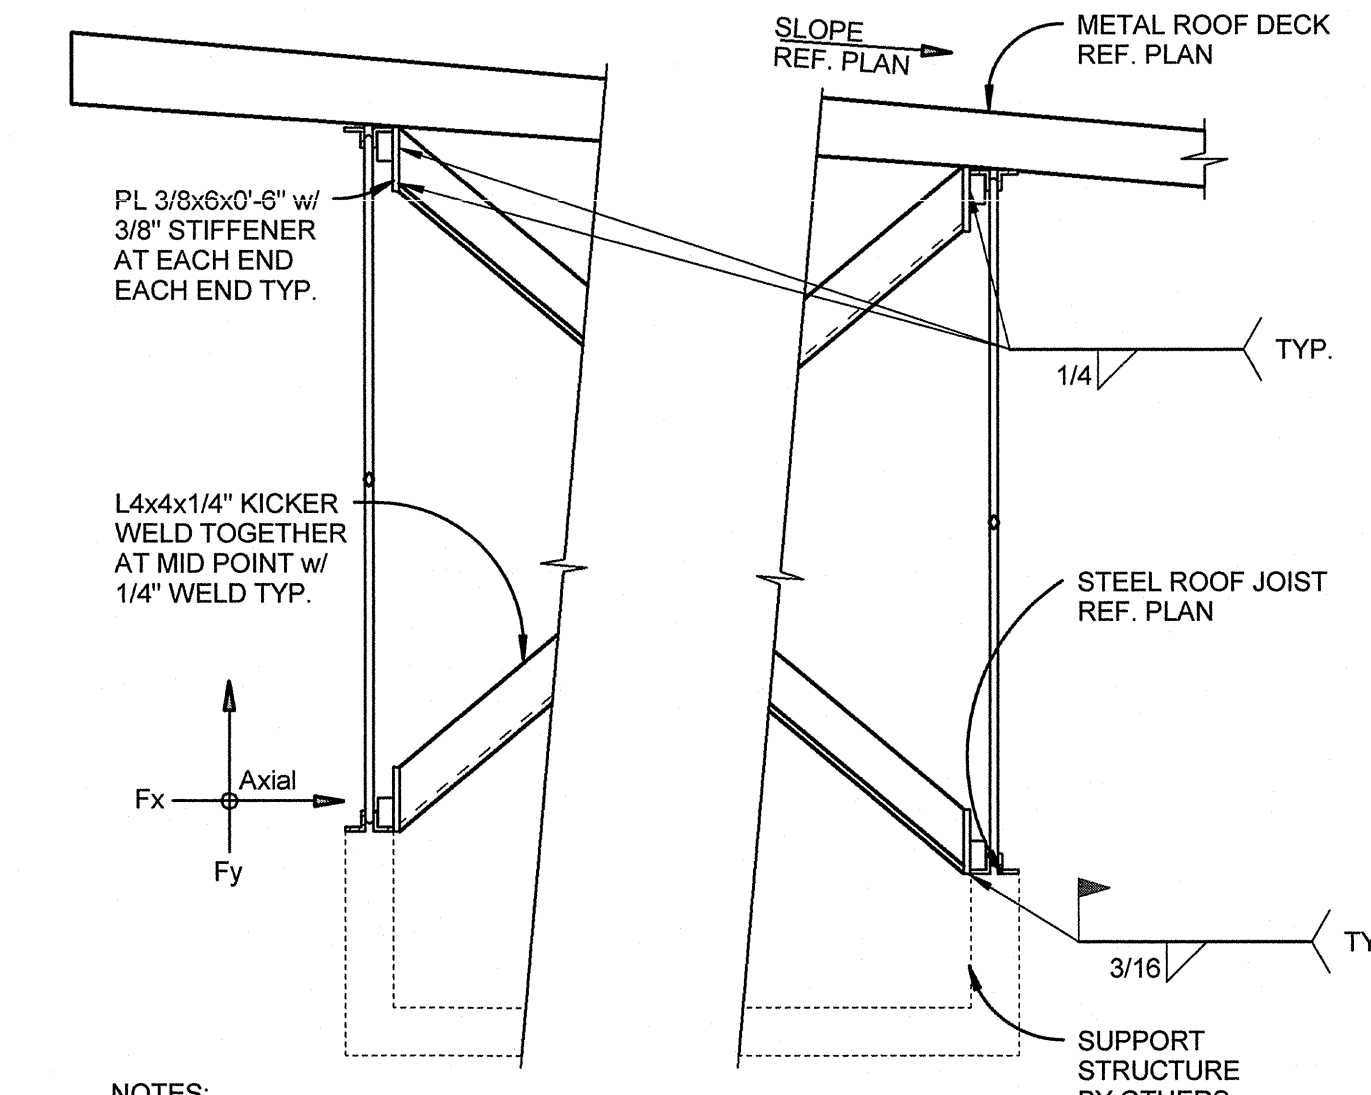

4 BRACING AT EQUIPMENT SUPPORT
1" = 1'-0"



1 TRUSS TORSIONAL BRACING DETAIL
1" = 1'-0" S-603

2 TRUSS BOTTOM CHORD DETAIL
3" = 1'-0" S-603




ROBERTSON/SHERWOOD/ARCHITECTS PC
132 EAST BROADWAY, SUITE 540
EUGENE, OREGON 97401
541-342-8077
www.robertsonsherwood.com


MAHLUM ARCHITECTS INC
1231 NW HOYT, SUITE 102
PORTLAND, OREGON 97209
503-224-4032
71 COLUMBIA, FLOOR 4
SEATTLE, WASHINGTON 98104
206-441-4151
www.mahlum.com



111 SW Fifth Ave., Suite 2500
Portland, OR 97204
O: 503.227.3251
F: 503.227.7980
www.kpff.com

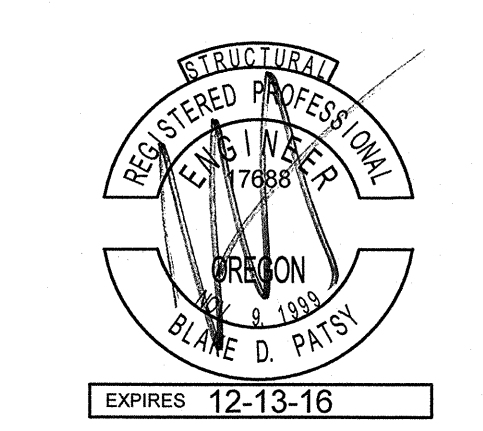

EUGENE SCHOOL DISTRICT 4J

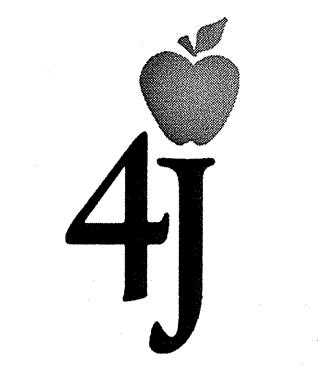

**REPLACEMENT ROOSEVELT
MIDDLE SCHOOL**
CIP NUMBER 410.566.001
680 EAST 24TH AVENUE
EUGENE, OREGON 97405
CIP NO. 410.566.001


MARK	DATE	DESCRIPTION
1	3-13-2015	ADDENDUM 6

ISSUE DATE: FEBRUARY 18, 2015
 ISSUE: CONSTRUCTION DOCUMENTS
 VOLUME: PACKAGE 1
 PROJECT NO: 213417
 DRAWN BY: MF
 CHECKED BY: MT
COPYRIGHT MAHLUM ARCHITECTS, INC. 2014 ORIGINAL SHEET SIZE: 30"x42"


STEEL DETAILS

S-605


3/13/2015 4:45:29 PM C:\Users\mahlum\Documents\2015\410.566.001\410.566.001_S-605.dwg

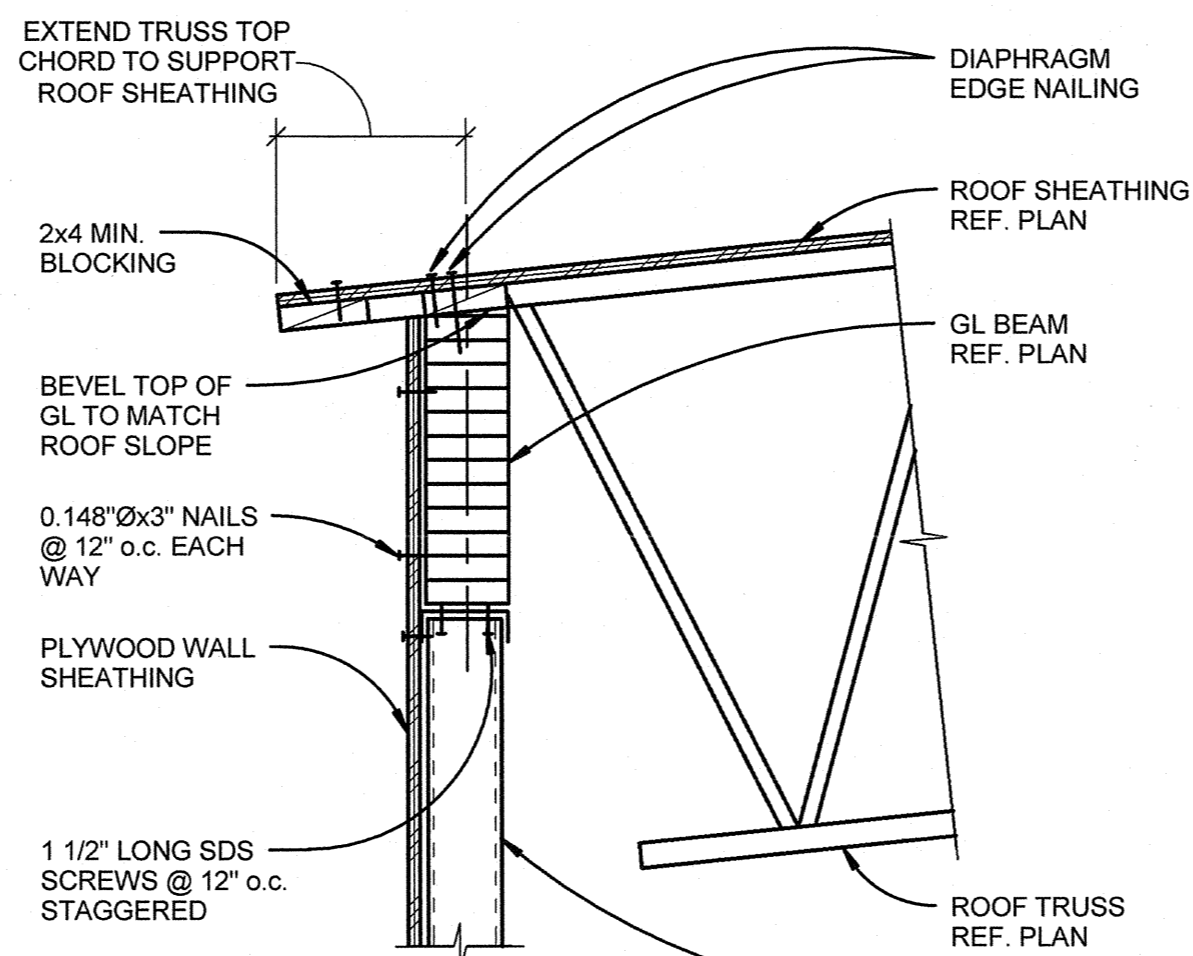


6 SHEAR WALL SHEAR TRANSFER AT GL BEAM
1" = 1'-0" S-123A

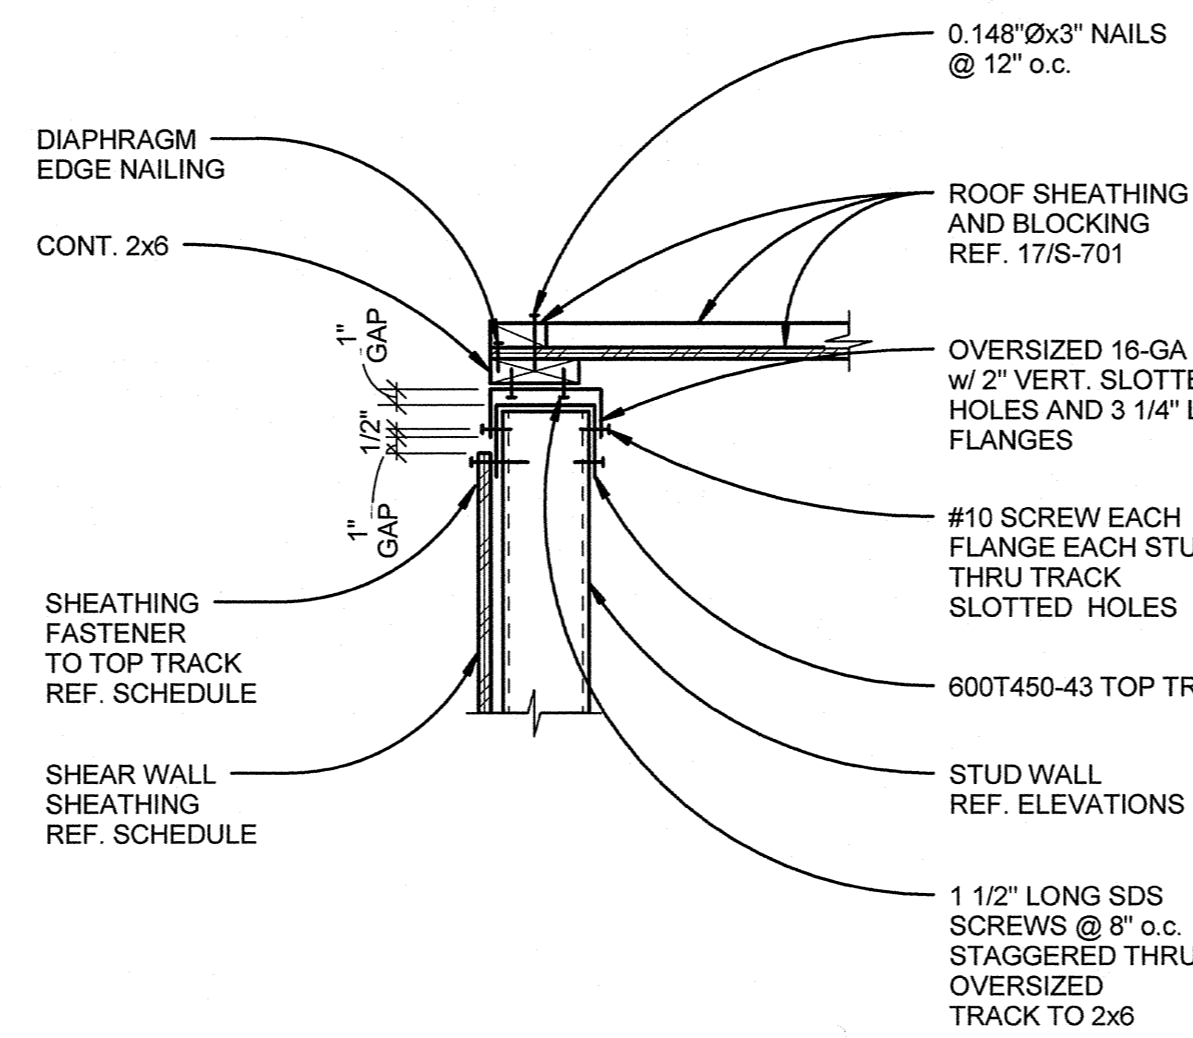


7 DEFLECTION JOINT AT SHEAR WALL
1" = 1'-0" S-701

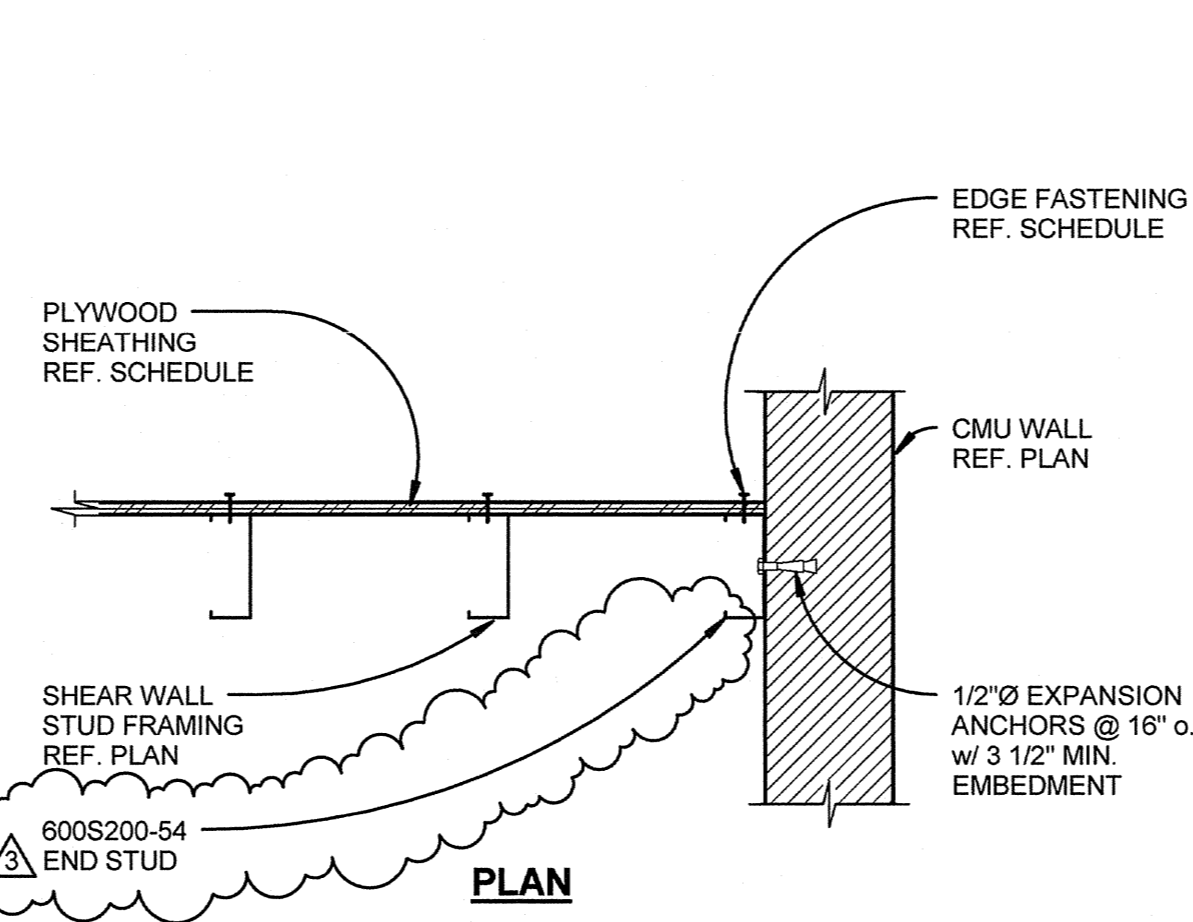


8 TYP. PLYWOOD SHEAR TO CMU WALL
1" = 1'-0"

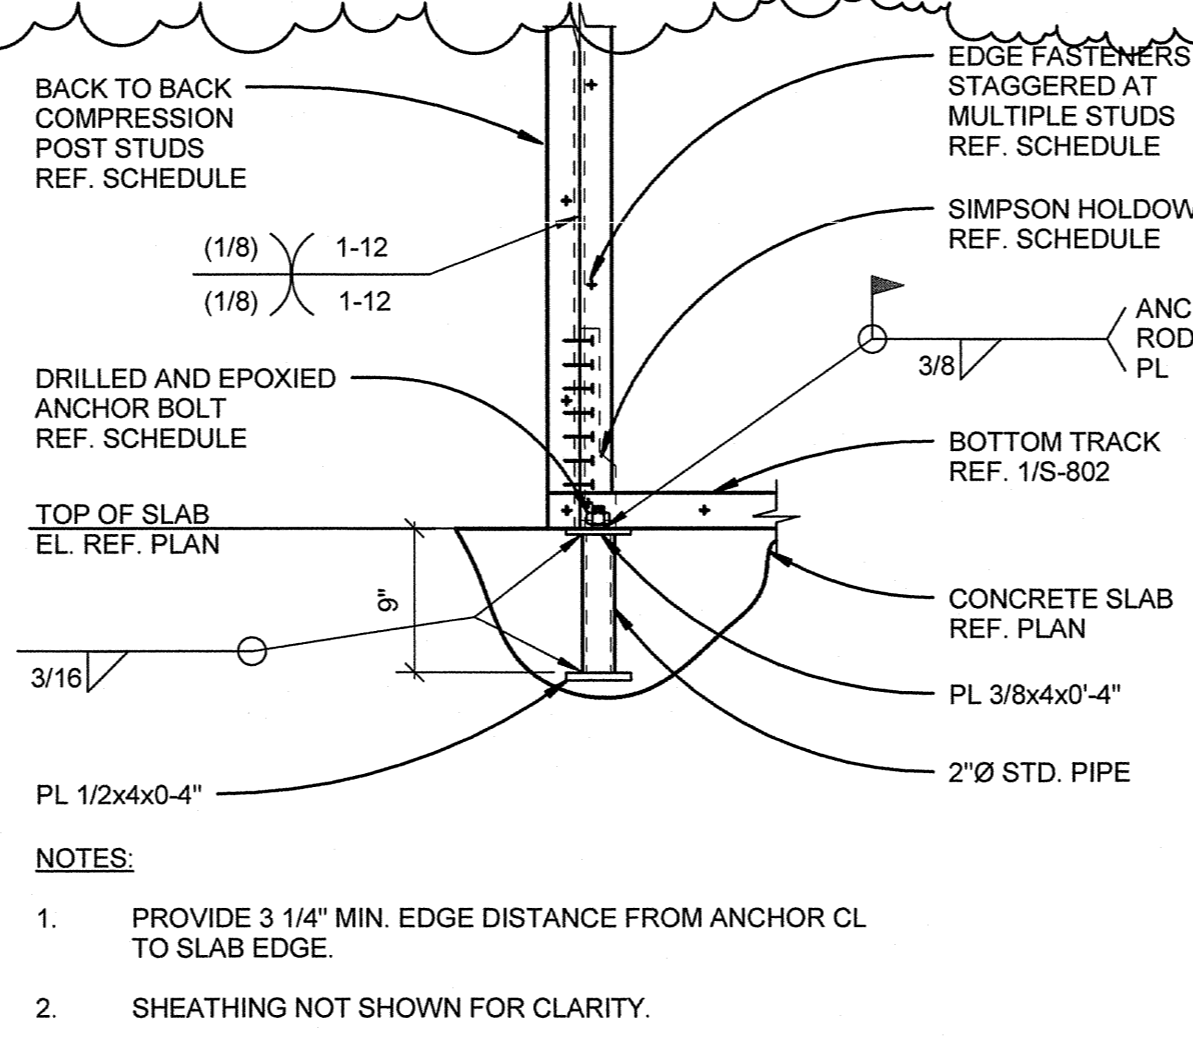


9 HOLDOWN TYPE B ANCHORAGE DETAIL
1" = 1'-0"

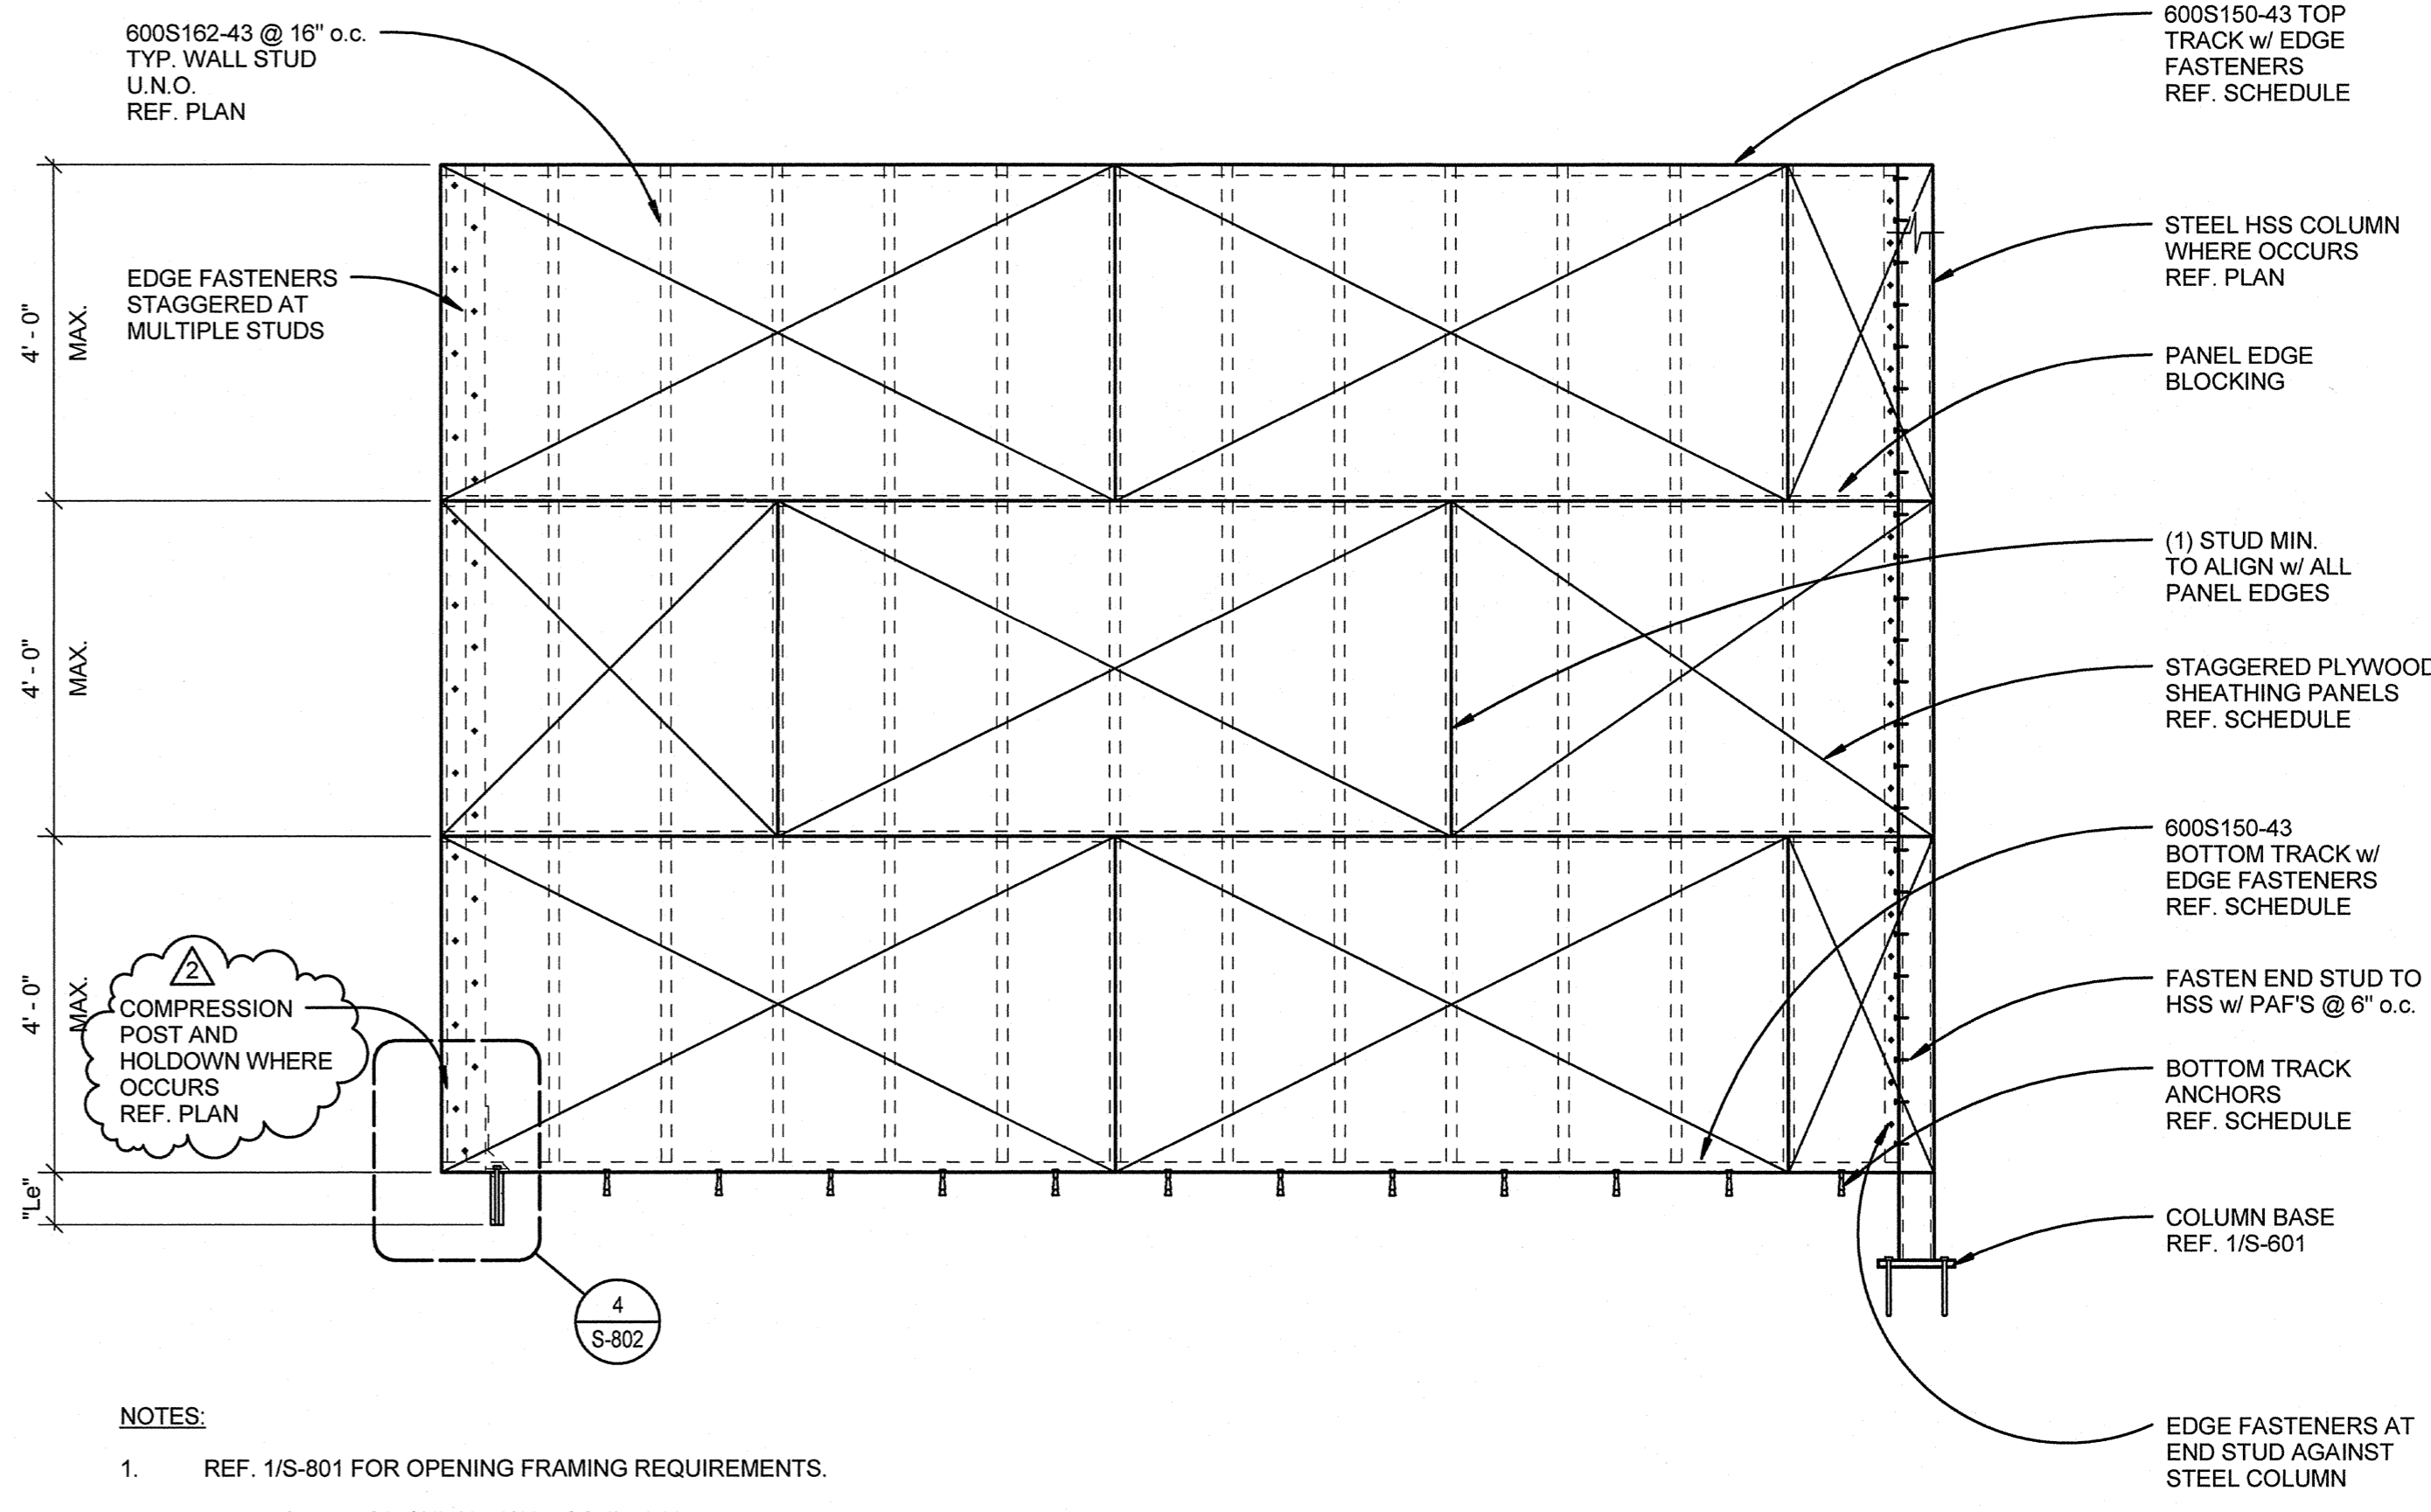

1 TYPICAL PLYWOOD SHEAR WALL ELEVATION
1/2" = 1'-0"

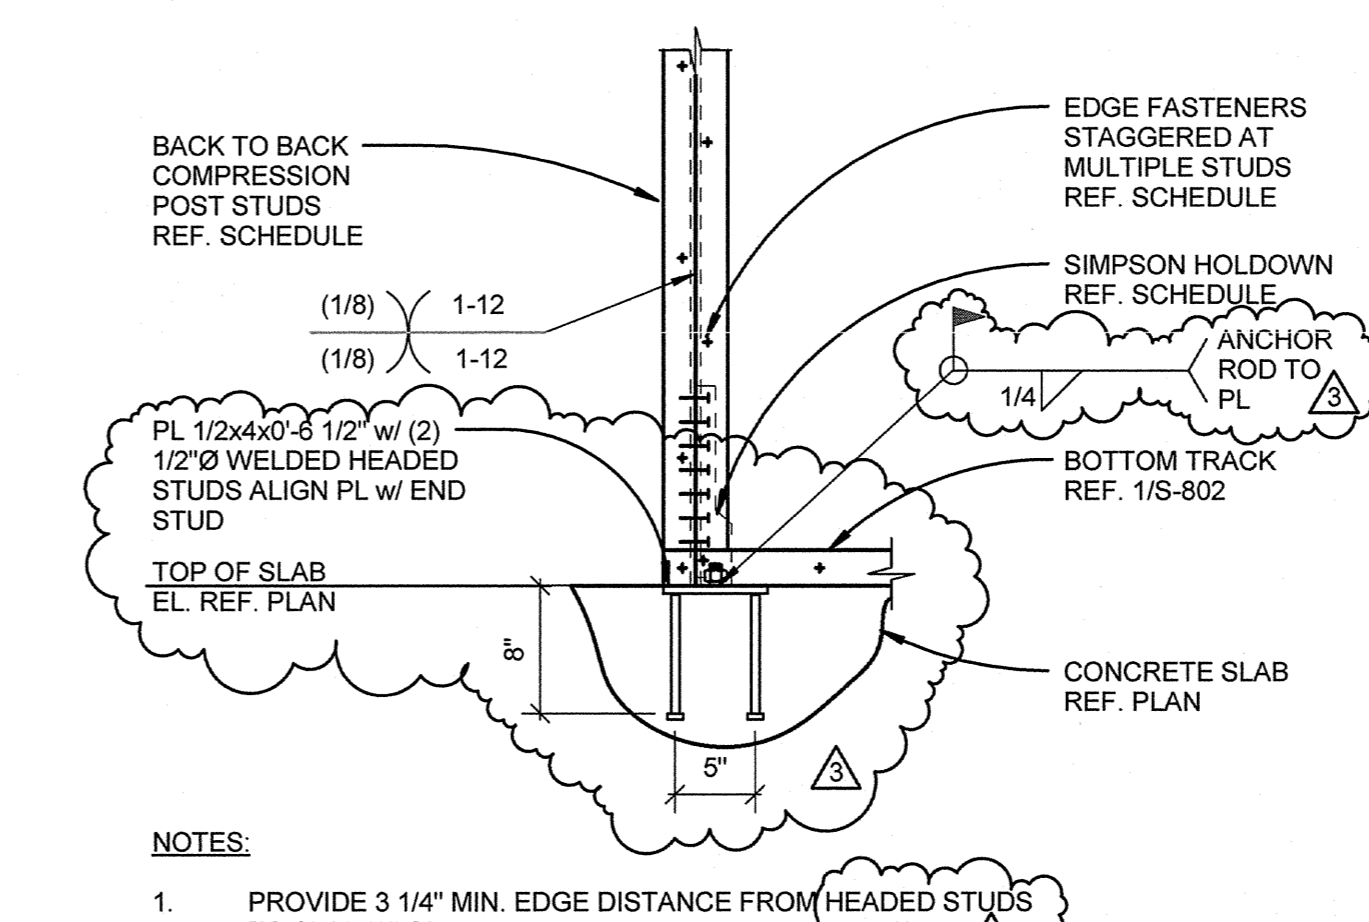

4 HOLDOWN TYPE A ANCHORAGE DETAIL
1" = 1'-0" S-802

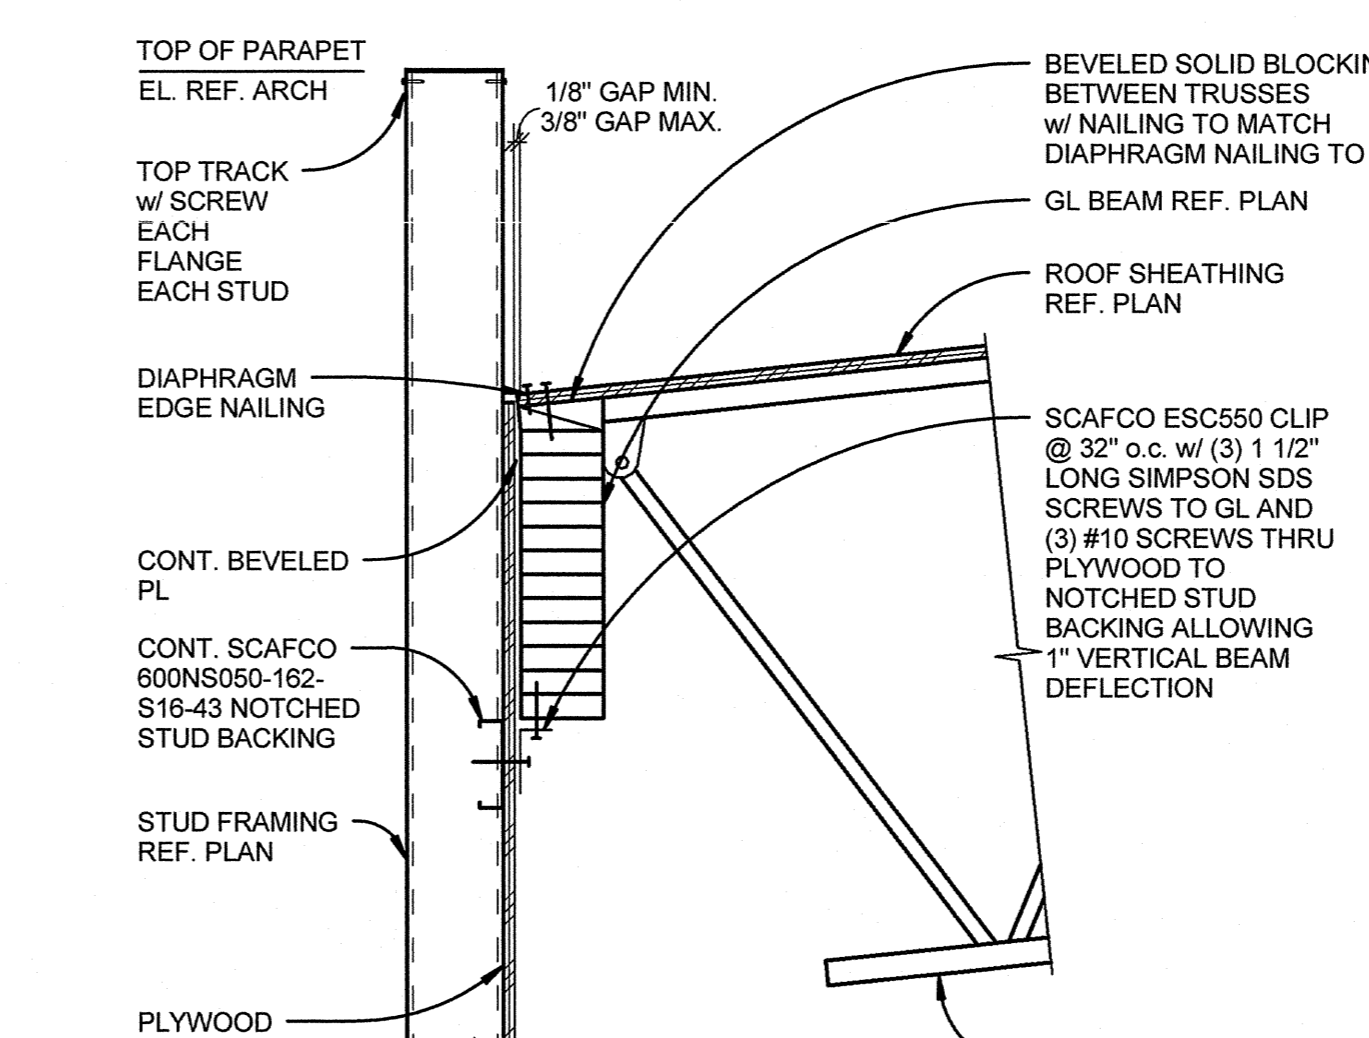

5 SHEAR WALL SHEAR TRANSFER AT GL BEAM
1" = 1'-0" S-122A

PLYWOOD SHEAR WALL SCHEDULE

SHEAR WALL SYMBOL	SHEATHING (1)	SCREWS (4)		BOTTOM TRACK ANCHOR FRAMING (8)
		EDGE (3)	FIELD SUPPORT (2)	
1	15/32"	#6 @ 6" o.c.	#6 @ 12" o.c.	4'-0" o.c.

- NOTES:**
- FIRE TREATED STRUCTURAL 1 PLYWOOD SHEATHING.
 - FIELD SCREWS OCCUR AT INTERMEDIATE FRAMING MEMBERS WITHIN PANELS.
 - EDGE SCREWS OCCUR AT ALL PANEL EDGES.
 - SHEATHING ATTACHMENT SCREWS SHALL BE #8x1" COUNTERSUNK SELF-TAPPING SCREWS WITH A MINIMUM HEAD DIAMETER OF .285 INCHES. EDGE SCREWS SHALL BE PLACED NOT LESS THAN 3/8" FROM PANEL EDGES.
 - BLOCK ALL HORIZONTAL PANEL EDGES PER 7/S-801.
 - TOP AND BOTTOM TRACKS SHALL MATCH GAUGE OF STUDS.
 - REF. 1/S-802 FOR TYPICAL SHEAR WALL ELEVATION.
 - ALL CONCRETE ANCHORS SHALL BE 1/2" HILTI KB-TZ EXPANSION ANCHORS W/ 3/2" EMBEDMENT.

2 PLYWOOD SHEAR WALL SCHEDULE
1" = 1'-0"

HOLDOWN SCHEDULE

MARK	TYPE	COMPRESSION POSTS	ANCHOR DIAMETER	DETAIL
A	SIMPSON S/HLD9	(2) 800S200-43	5/8"	4/S-802
B	SIMPSON S/HLD9	(2) 800S200-54	7/8"	9/S-802

- NOTES:**
- REF. 1/S-802 AND 4/S-802 FOR DEFINITION OF L_e.
 - ANCHORS SHALL BE ASTM A1554 GRADE 36 WELDABLE THREADED ANCHOR RODS.
 - ALL HOLDOWNS SHALL BE INSTALLED IN CONFORMANCE WITH THE MANUFACTURER'S RECOMMENDATIONS.


3 HOLDOWN SCHEDULE
1" = 1'-0"



EUGENE SCHOOL DISTRICT 4J



REPLACEMENT ROOSEVELT
MIDDLE SCHOOL
CIP NUMBER 410.566.001
680 EAST 24TH AVENUE
EUGENE, OREGON 97405
CIP NO. 410.566.001

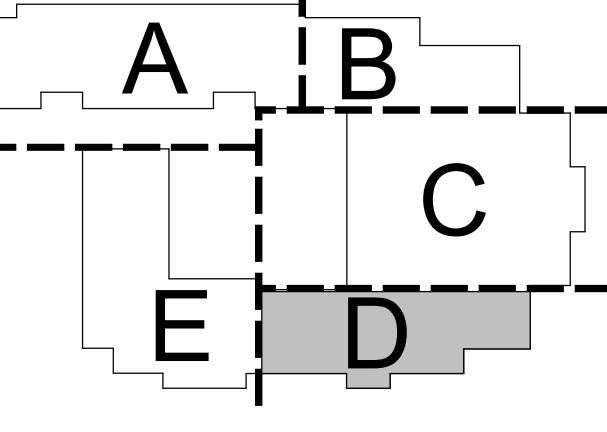


GENERAL NOTES:

- A. PROVIDE WALL CLEANOUTS ON WASTE PIPE SYSTEM EVERY 100 FT. FOR STRAIGHT RUNS, AT 90 DEGREE TURNS IN MAINS, AND AT ANY TURN EXCEEDING 135 DEGREES.
- B. PROVIDE EXTERIOR CTO'S ON WASTE PIPE SYSTEM AT BEGINNINGS AND ENDS OF WASTE PIPING MAINS.
- C. FINISHED FLOOR ELEVATION = 430'

NOTES:

- 1. TIGHT TO GRADE BEAMS OR PILE CAPS.
- 2. PIPE RUNS BELOW STRUCTURE.
- 3. REFER TO SHEET S-502 FOR VERTICAL GRADE BEAM PENETRATION.

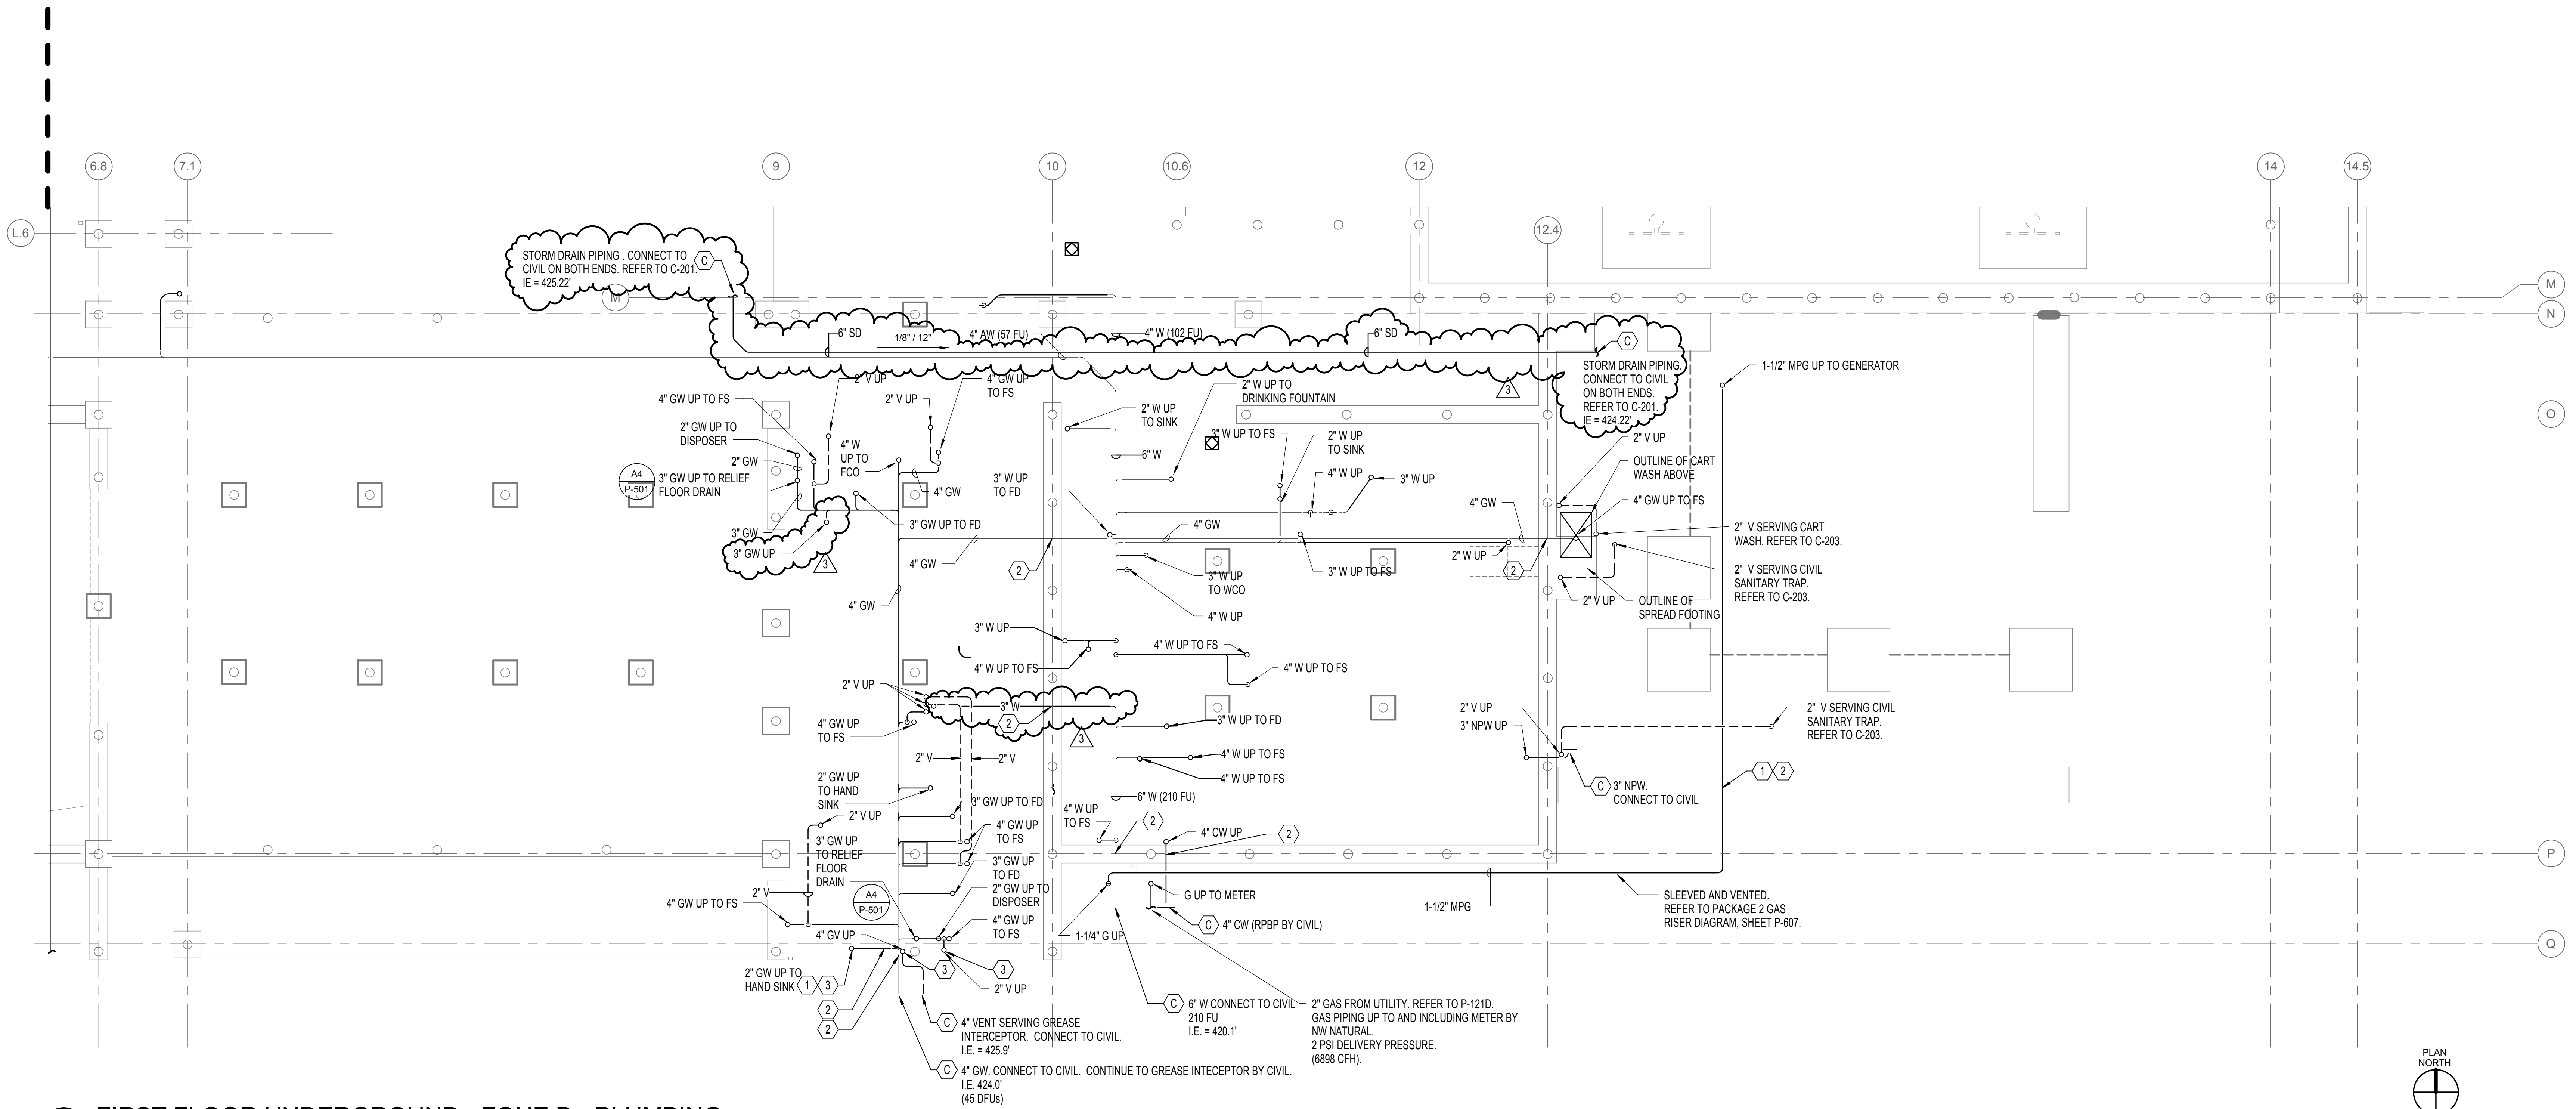

A1 FIRST FLOOR UNDERGROUND - ZONE D - PLUMBING
1/8" = 1'-0"



MARK	DATE	DESCRIPTION
3	03-13-2015	ADDENDUM 6
2	03-06-2015	ADDENDUM 4
1	2-18-2015	Supplemental Info 1

ISSUE DATE: FEBRUARY 18, 2015

ISSUE: CONSTRUCTION DOCUMENTS

VOLUME: PACKAGE 1


PROJECT NO.: 2013912.00

DRAWN BY: SG

CHECKED BY: JCY

COPYRIGHT MAHLUM ARCHITECTS, INC. 2014 ORIGINAL SHEET SIZE: 30"X42"

UNDERGROUND PLAN - ZONE D - PLUMBING

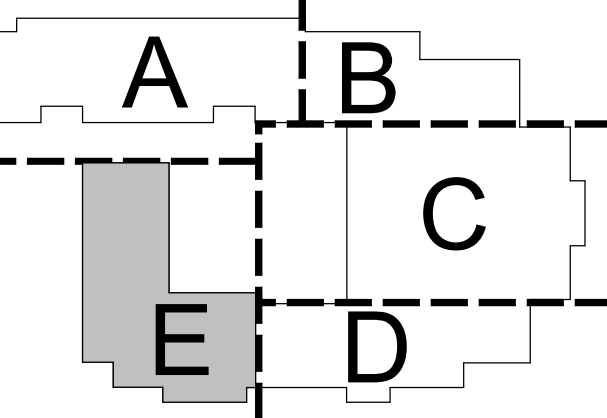

GENERAL NOTES:


A. PROVIDE WALL CLEANOUTS ON WASTE PIPE SYSTEM EVERY 100 FT. FOR STRAIGHT RUNS, AT 90 DEGREE TURNS IN MAINS, AND AT ANY TURN EXCEEDING 135 DEGREES.

B. PROVIDE EXTERIOR CTG'S ON WASTE PIPE SYSTEM AT BEGINNINGS AND ENDS OF WASTE PIPING MAINS.

C. FINISHED FLOOR ELEVATION = 430'

NOTES:

1. TIGHT TO GRADE BEAMS OR PILE CAPS.
2. PIPE RUNS BELOW STRUCTURE.
3. REFER TO SHEET S-502 FOR VERTICAL GRADE BEAM PENETRATION.

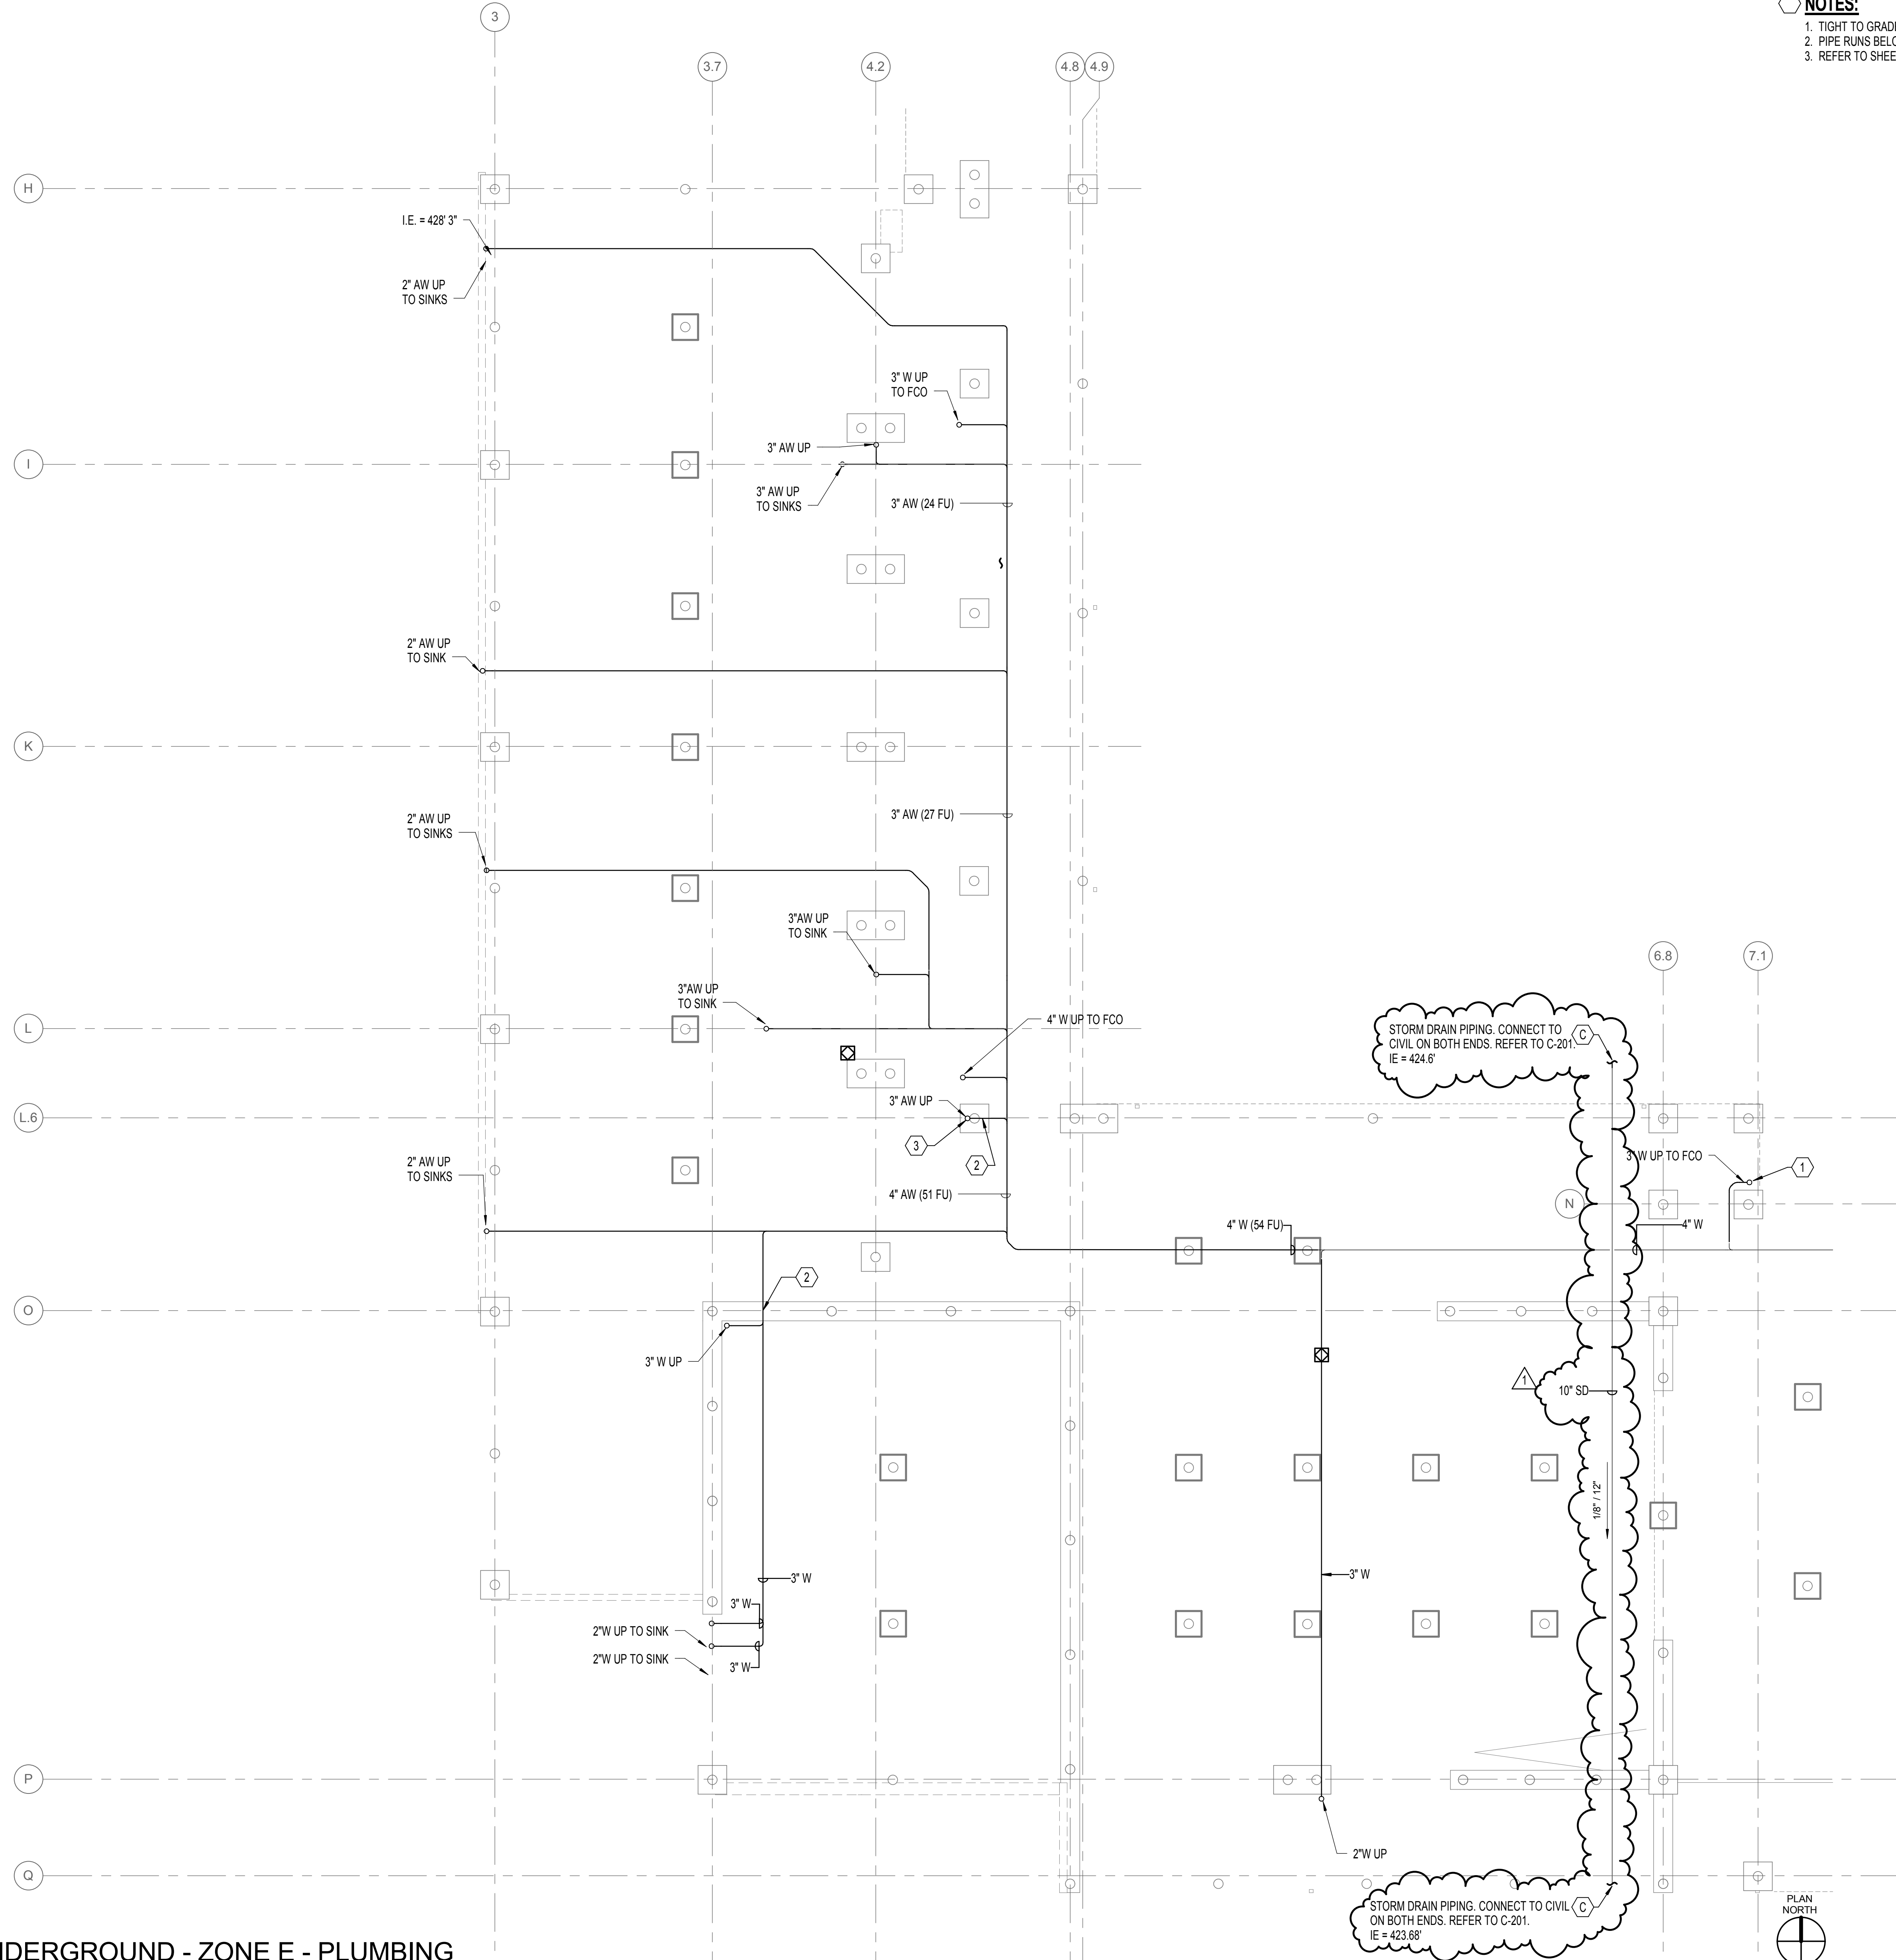

(A1) FIRST FLOOR UNDERGROUND - ZONE E - PLUMBING
1/8" = 1'-0"

MARK	DATE	DESCRIPTION
1	03-13-2015	ADDENDUM 6

ISSUE DATE: FEBRUARY 18, 2015

ISSUE: CONSTRUCTION DOCUMENTS

VOLUME: PACKAGE 1


PROJECT NO.: 2013912.00

DRAWN BY: SG

CHECKED BY: JCY


COPYRIGHT MAHLUM ARCHITECTS, INC. 2014 ORIGINAL SHEET SIZE: 30"x42"

UNDERGROUND PLAN - ZONE E - PLUMBING

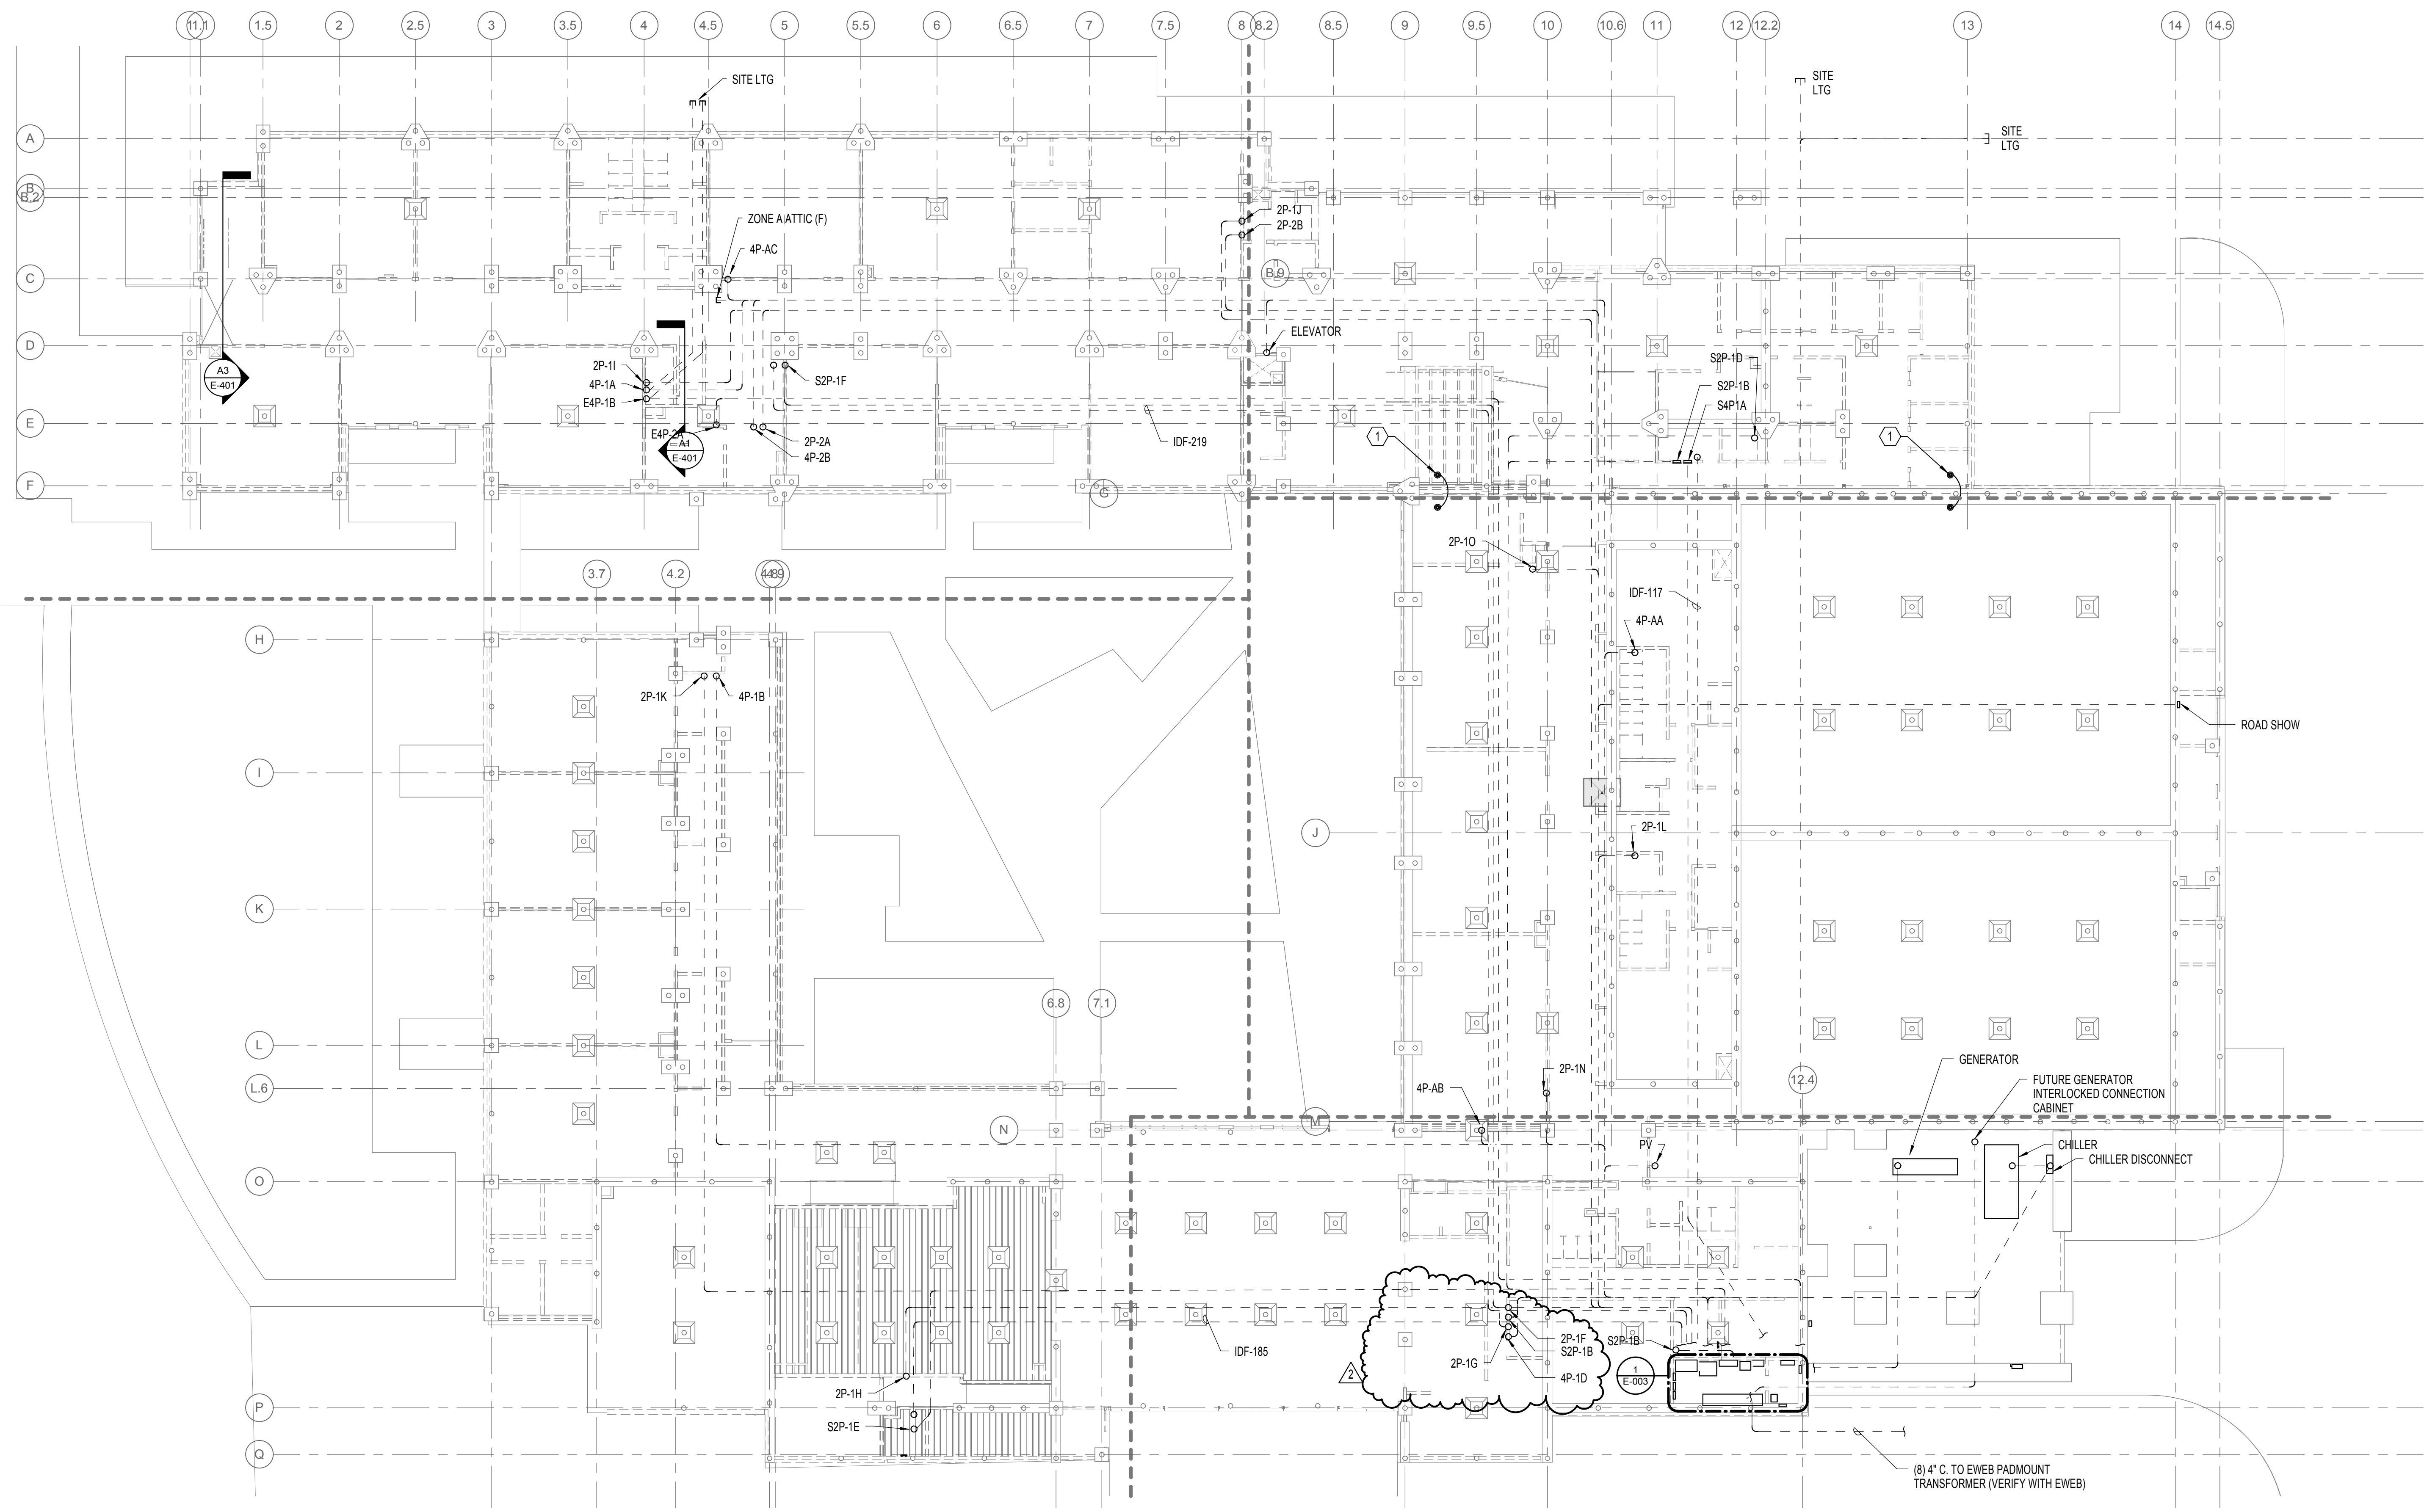

NOTES:
 1. #40 BARE COPPER BOND SEISMICALLY SEPARATED CONCRETE SLABS AT REBAR VIA EXOTHERMIC WELC CONNECTION.

A1 FIRST FLOOR UNDERGROUND - OVERALL - ELECTRICAL
 1/16" = 1'-0"

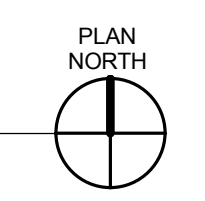


mahlum
 ROBERTSON/SHERWOOD/ARCHITECTS PC
 132 EAST BROADWAY, SUITE 540
 EUGENE, OREGON 97401
 541-342-8077
 www.robertsonsherwood.com

MAHLUM ARCHITECTS INC
 1233 NW HOYTE, SUITE 102
 PORTLAND, OREGON 97209
 503-224-4032

71 COLUMBIA FLOOR 4
 SEATTLE, WASHINGTON 98104
 206-441-1151
 www.mahlum.com


PAE
 Portland | San Francisco | Seattle
 pae-engineers.com

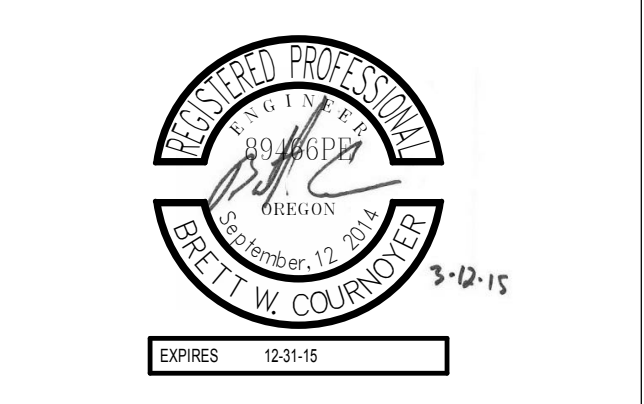

EUGENE SCHOOL DISTRICT 4J

4J


REPLACEMENT ROOSEVELT MIDDLE SCHOOL
 MIDDLE SCHOOL
 CIP NUMBER 410.566.001
 680 EAST 24TH AVENUE
 EUGENE, OREGON 97405
 CIP NO. 410.566.001

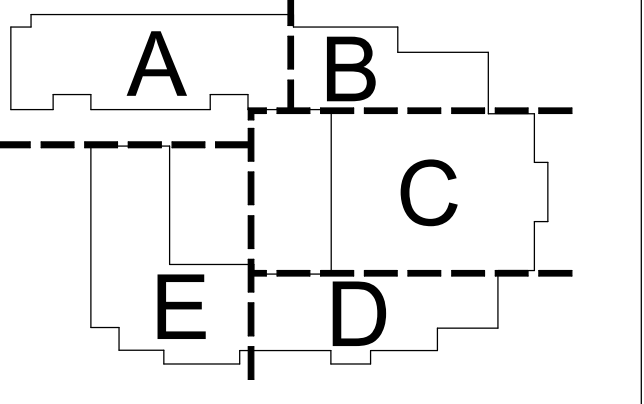

MARK	DATE	DESCRIPTION
2	03-13-2015	ADDENDUM 6
1	2-18-2015	Supplemental Info 1


ISSUE DATE: FEBRUARY 18, 2015
 ISSUE: CONSTRUCTION DOCUMENTS
 VOLUME: PACKAGE 1
 PROJECT NO: 2013912.00
 DRAWN BY: JAR
 CHECKED BY: SPD
CONTRIBUTOR: MAHLUM ARCHITECTS, INC. 2014 ORIGINAL SHEET NO. 2014

UNDERGROUND OVERALL - ELECTRICAL

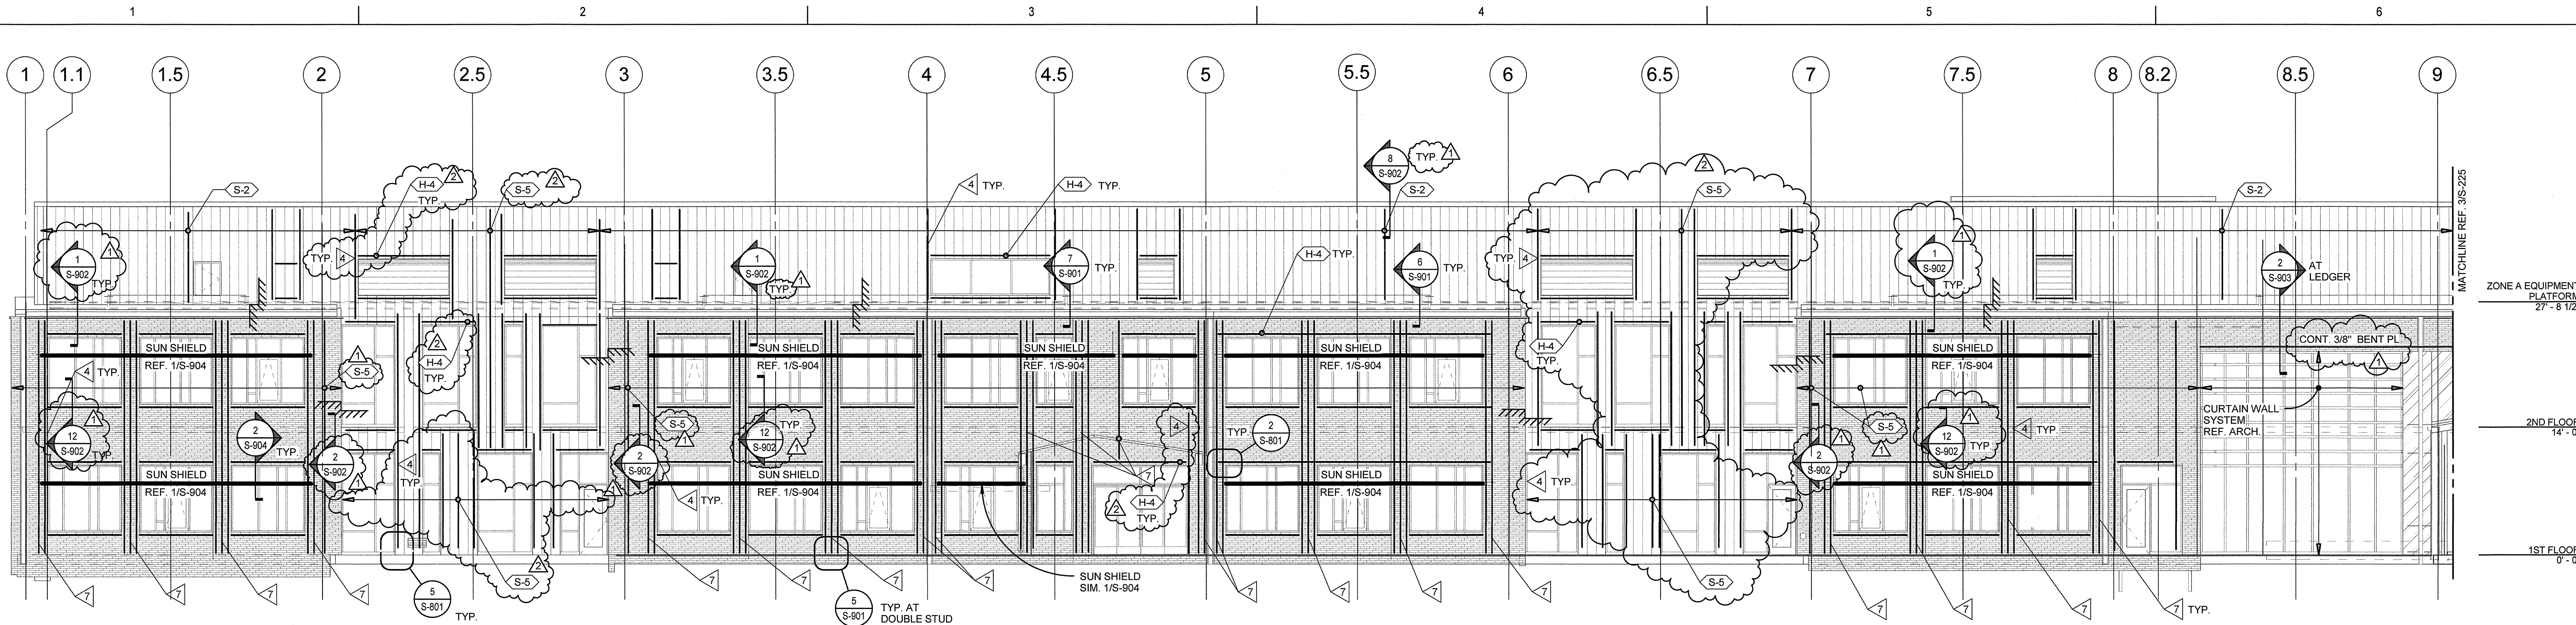


1 ENLARGED COURTYARD ELEVATION LOOKING NORTH
1/8" = 1'-0"


- CLADDING ELEVATION NOTES:**
1. REF. GENERAL STRUCTURAL NOTES FOR METAL STUD FRAMING REQUIREMENTS.
 2. COORDINATE STUD FRAMING AND DIMENSIONS WITH ARCHITECTURAL DRAWINGS.
 3. ALL EXTERIOR WALL FRAMING TO BE TYPE <S-2> REF. 7/S-801 FOR TYPICAL STUD BLOCKING, U.N.O.
 4. PROVIDE LOOSE LINGELS OVER OPENINGS IN BRICK REF. 3/S-901.
 5. SILLS TO BE 600T125-54 U.N.O. REF. 3/S-801 FOR DETAILS.
 6. REF. S-901 FOR EXTERIOR CLADDING STUD, HEADER, AND JAMB SCHEDULE.

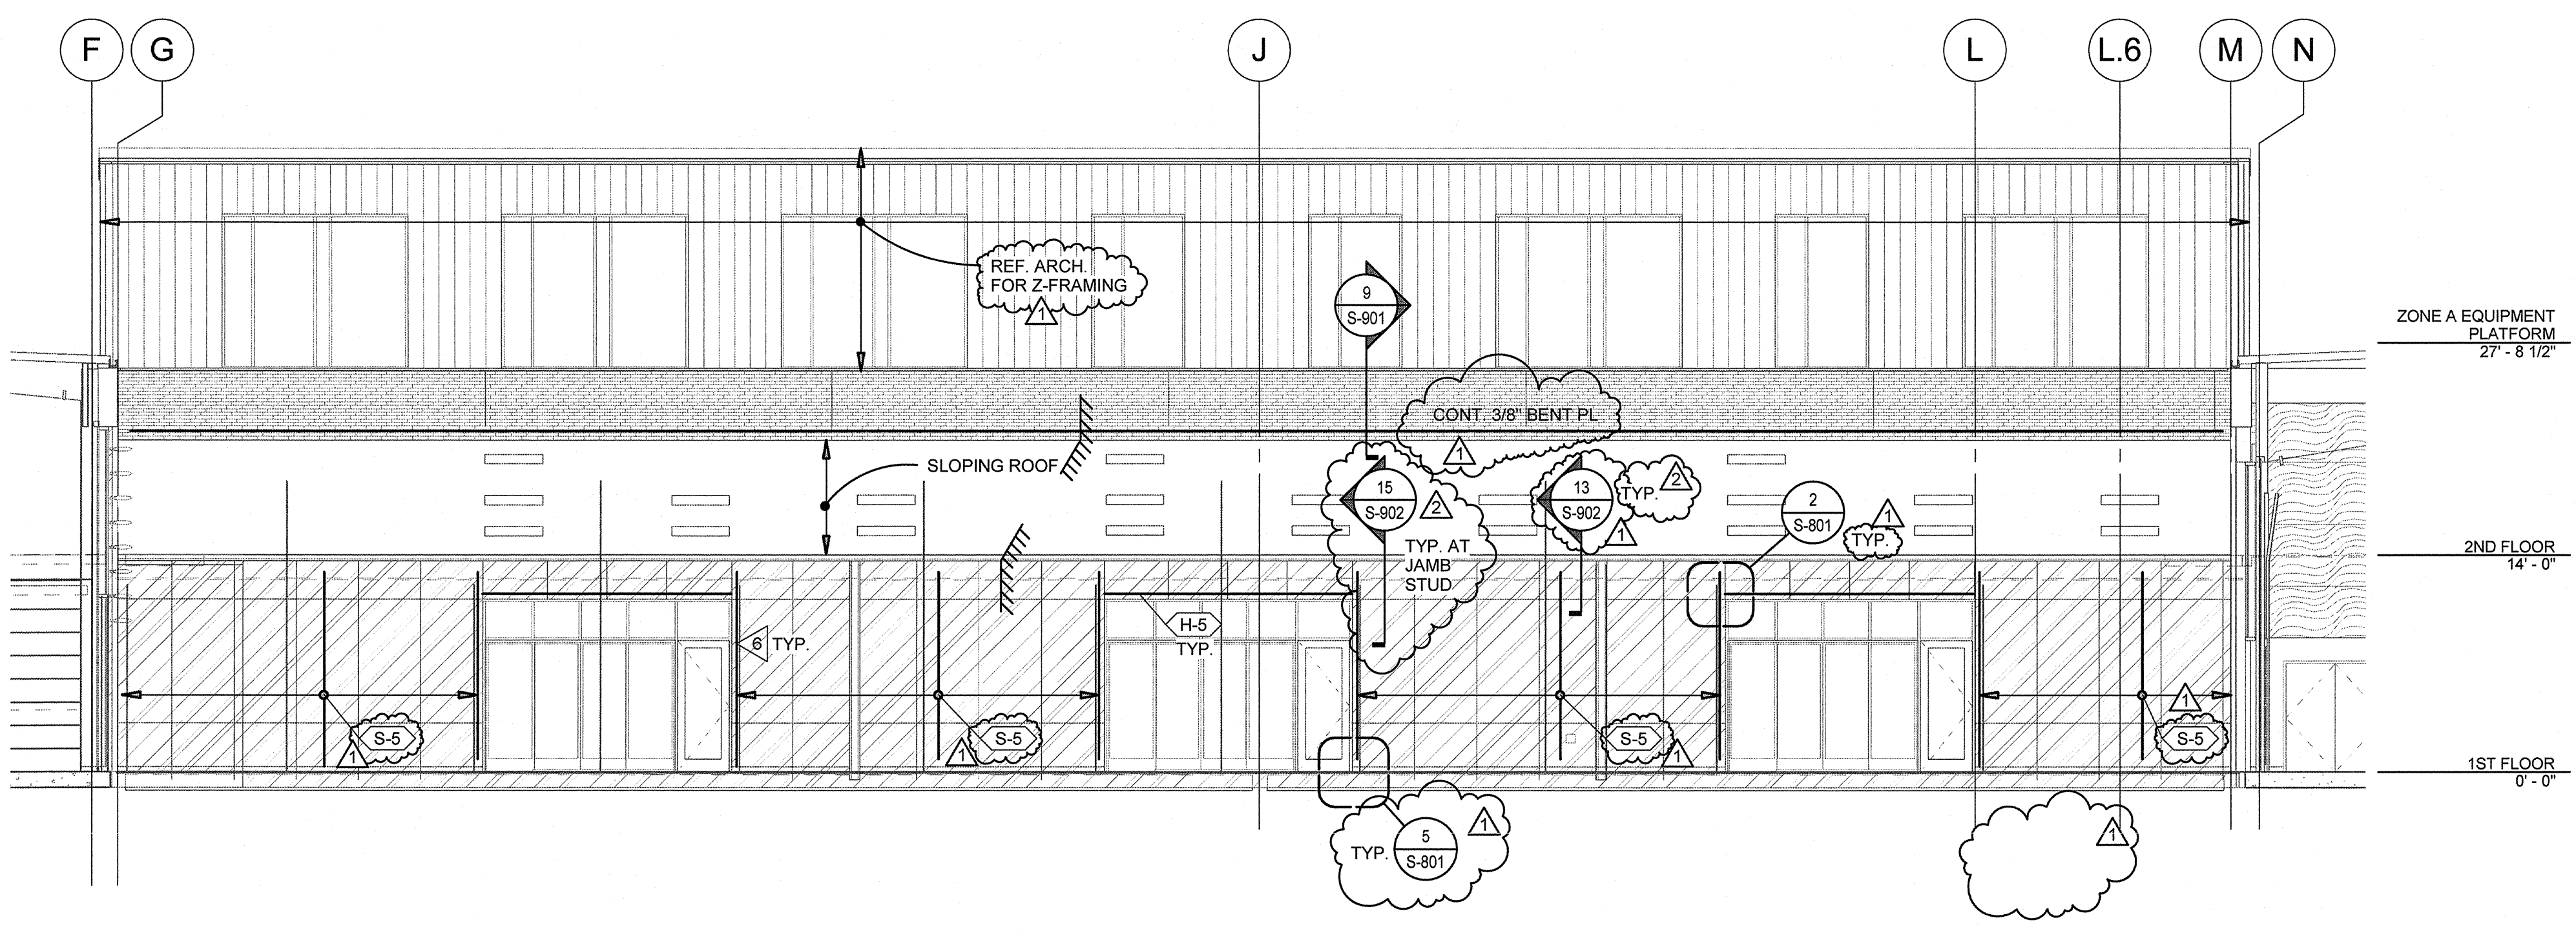

2 ENLARGED COURTYARD ELEVATION LOOKING EAST
1/8" = 1'-0"

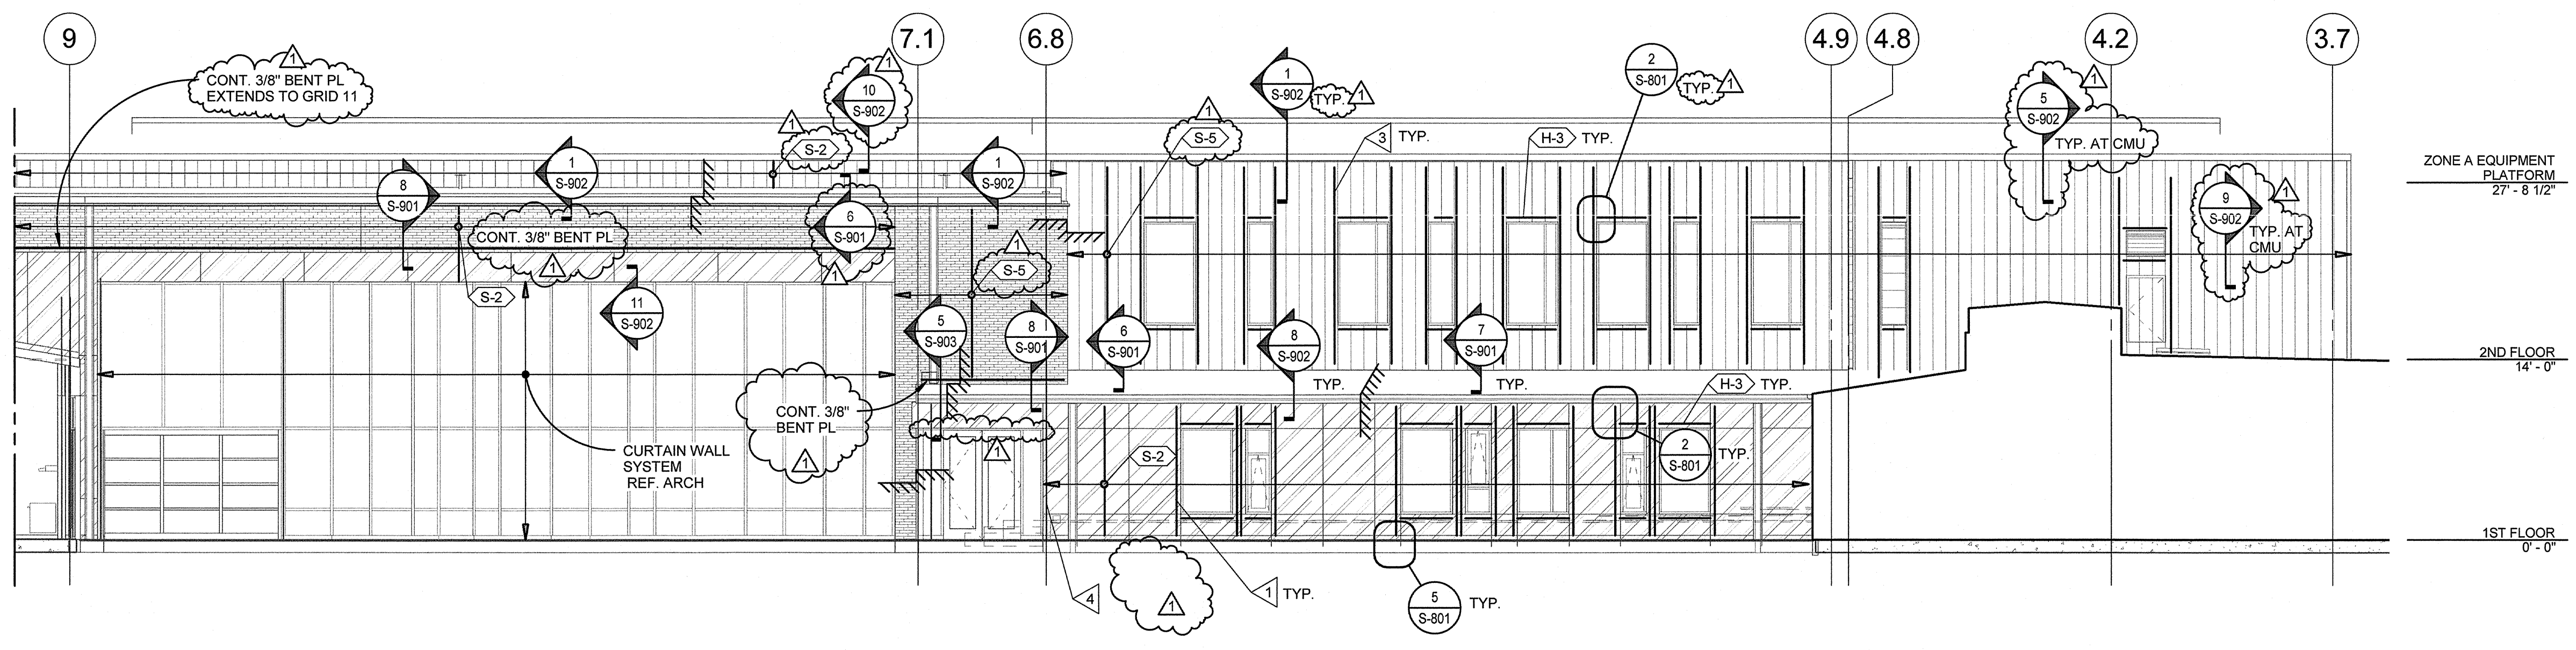


3 ENLARGED PARTIAL COURTYARD ELEVATION LOOKING SOUTH
1/8" = 1'-0"

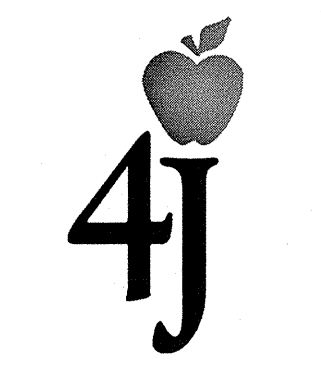

MARK	DATE	DESCRIPTION
2	3-13-2015	ADDENDUM 6
1	3-6-2015	ADDENDUM 3

ISSUE DATE: FEBRUARY 18, 2015
 ISSUE: CONSTRUCTION DOCUMENTS
 VOLUME: PACKAGE 2 VOLUME 1
 PROJECT NO: 213417
 DRAWN BY: MF
 CHECKED BY: MT
 COPYRIGHT MAHLUM ARCHITECTS, INC. 2014 ORIGINAL SHEET SIZE: 37x47

ENLARGED EXTERIOR CLADDING ELEVATIONS

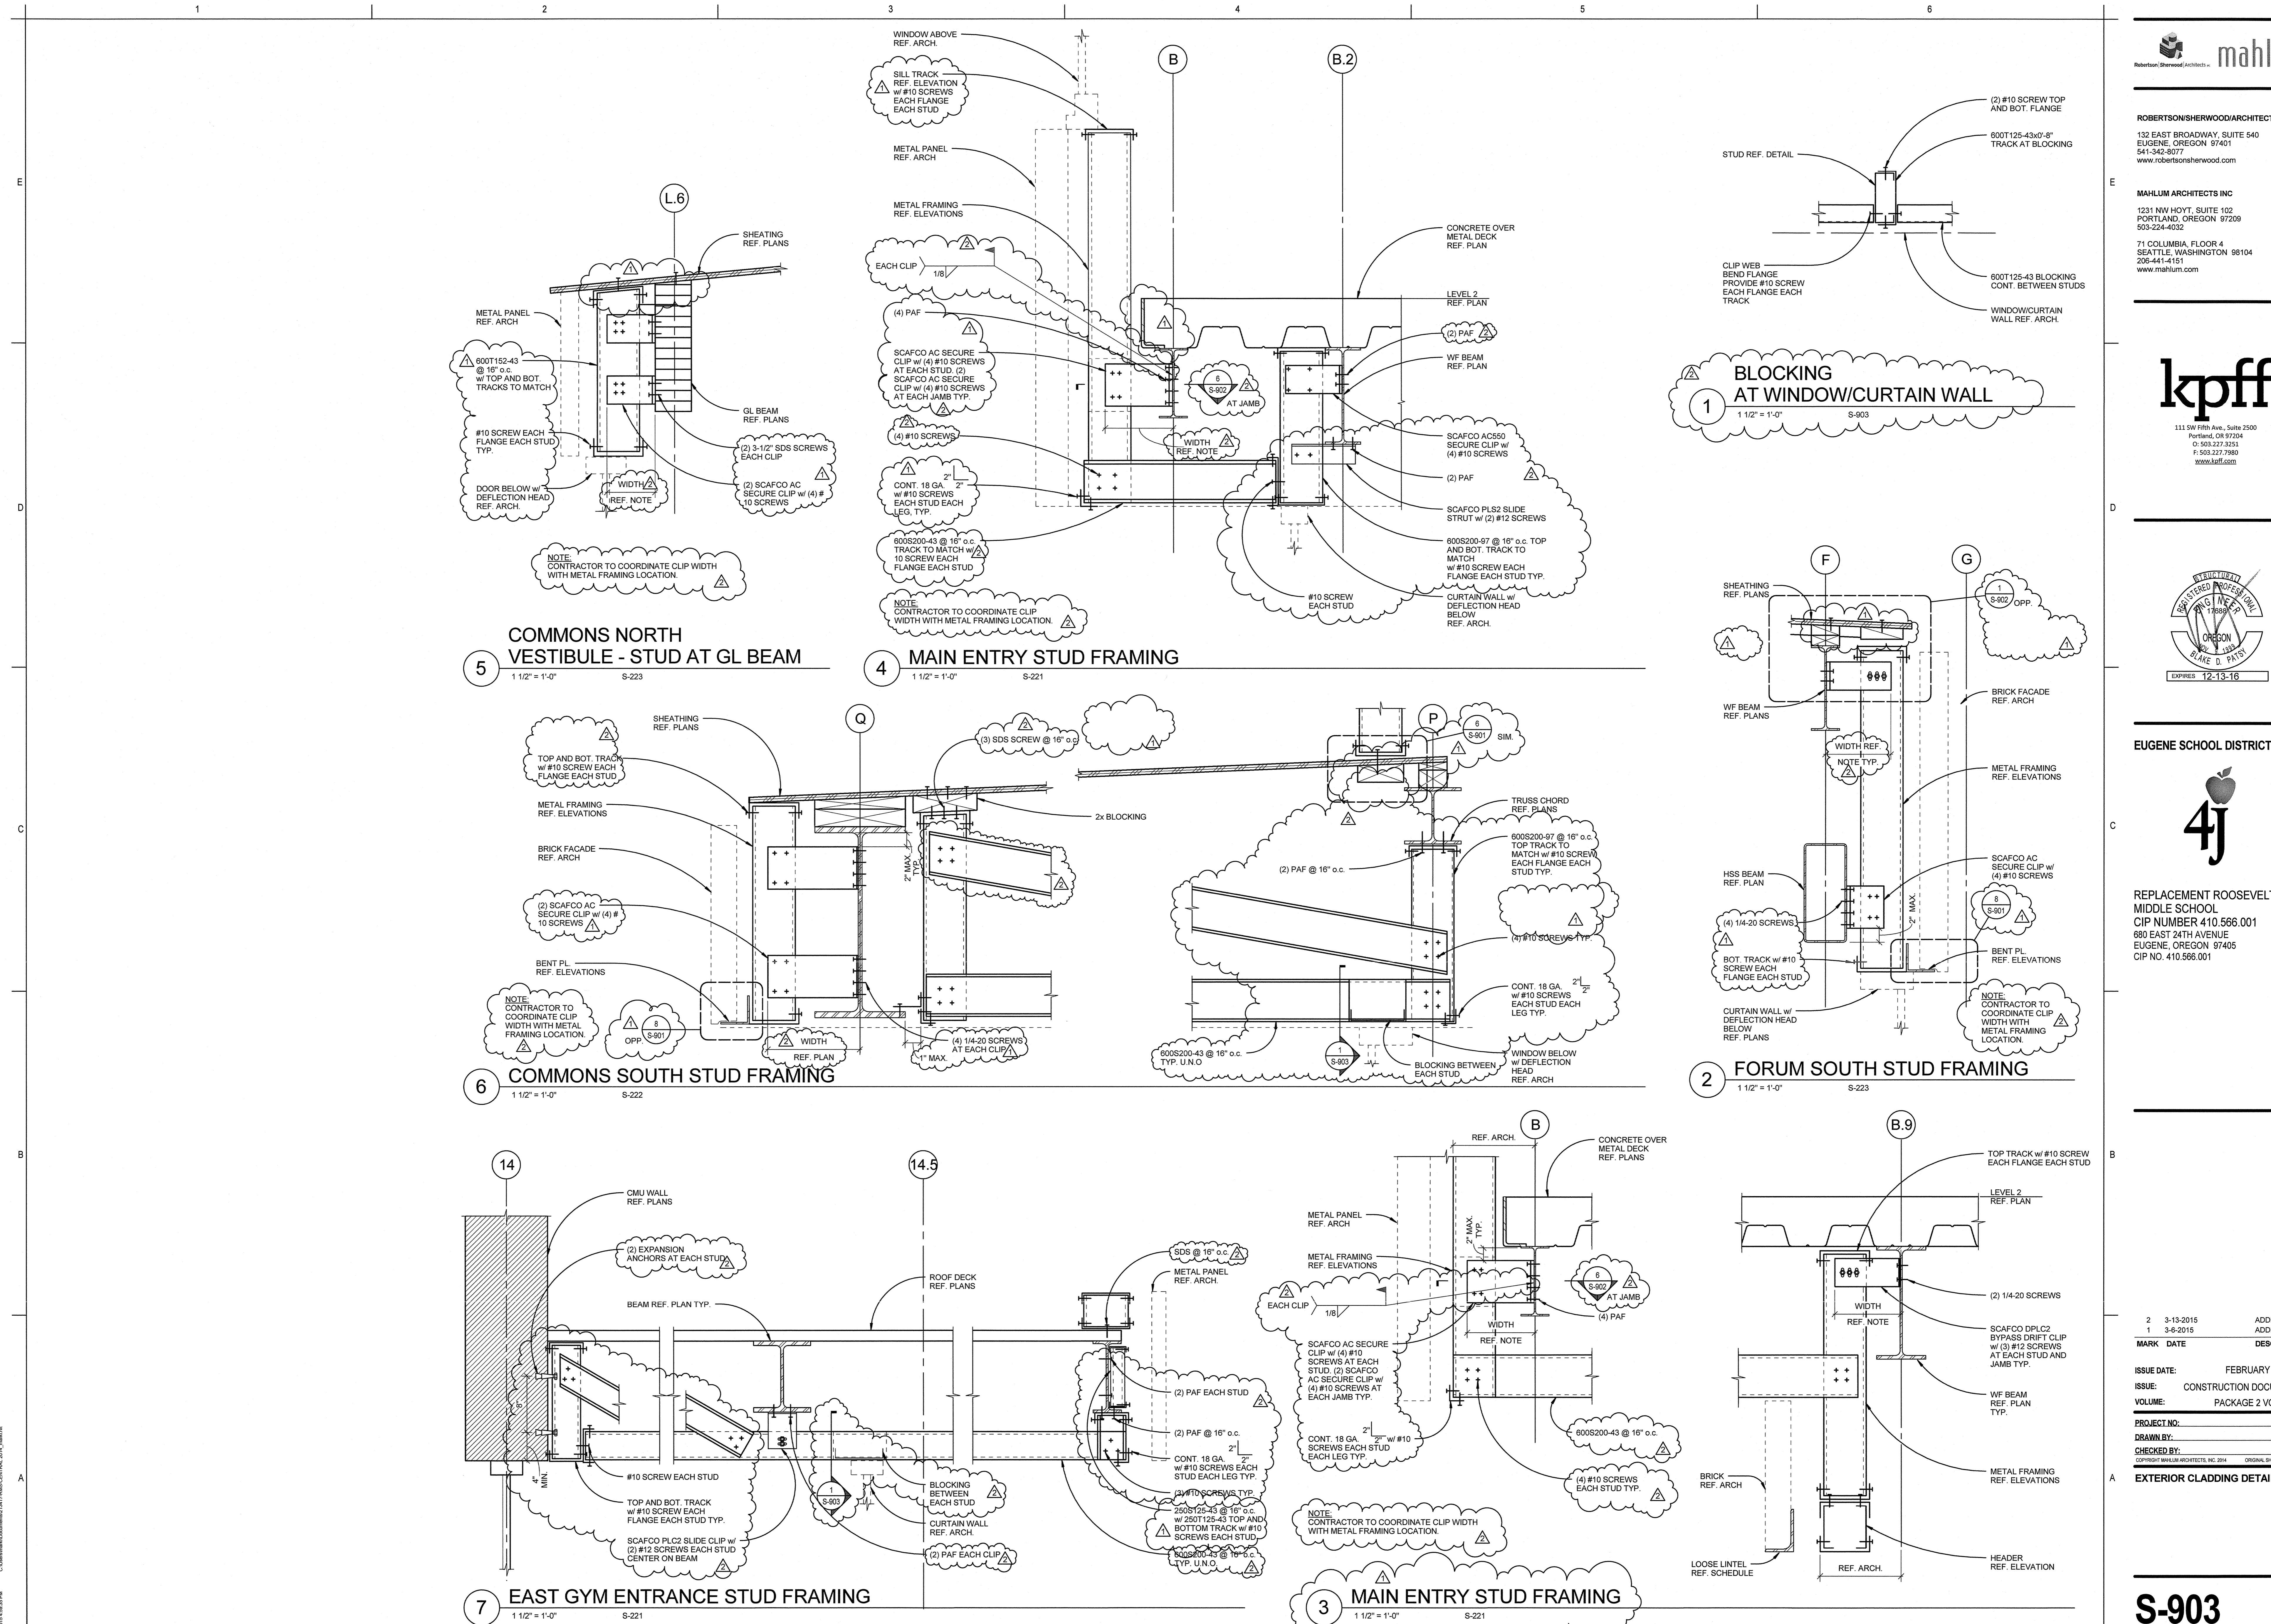

5 COMMONS NORTH VESTIBULE - STUD AT GL BEAM
 1 1/2" = 1'-0" S-223

4 MAIN ENTRY STUD FRAMING
 1 1/2" = 1'-0" S-221


6 COMMONS SOUTH STUD FRAMING
 1 1/2" = 1'-0" S-222

2 FORUM SOUTH STUD FRAMING
 1 1/2" = 1'-0" S-223

7 EAST GYM ENTRANCE STUD FRAMING
 1 1/2" = 1'-0" S-221

3 MAIN ENTRY STUD FRAMING
 1 1/2" = 1'-0" S-221

BLOCKING AT WINDOW/CURTAIN WALL
 1 1/2" = 1'-0" S-903

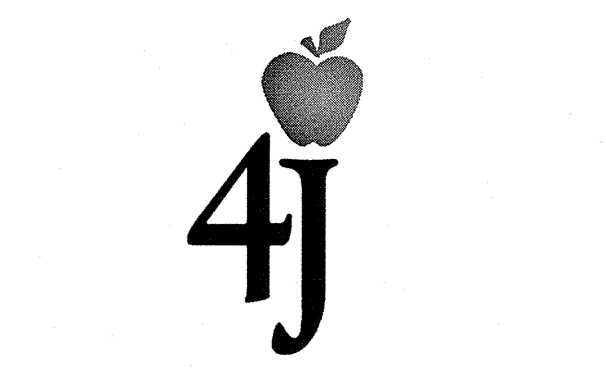

MARK	DATE	DESCRIPTION
2	3-13-2015	ADDENDUM 6
1	3-6-2015	ADDENDUM 3

ISSUE DATE: FEBRUARY 18, 2015
 ISSUE: CONSTRUCTION DOCUMENTS
 VOLUME: PACKAGE 2 VOLUME 1
 PROJECT NO: 213417
 DRAWN BY: MF
 CHECKED BY: MT
 ORIGINAL SHEET NO: 30742

EXTERIOR CLADDING DETAILS

PLAN GENERAL NOTES

- A. CONTRACTOR TO VERIFY ALL CONDITIONS AND DIMENSIONS AND NOTIFY ARCHITECT OF ANY DISCREPANCIES PRIOR TO ANY WORK.
- B. UNLESS OTHERWISE NOTED, PLAN DIMENSIONS SHOWN ARE:
 - AT INTERIOR PARTITIONS: TO THE FACE OF STUD
 - AT COLUMNS: TO THE CENTERLINE OF COLUMNS; IF WALL AT COLUMN CENTER WALL ON COLUMN
 - AT CONCRETE: TO THE FACE OF CONCRETE
 - AT EXTERIOR WALLS: TO THE FACE OF STUD (TO THE EDGE OF SLAB) (TO THE FACE OF FOUNDATION WALL)
 - CMU WALLS ARE CENTERED ON GRID & DIMENSIONED TO INDICATE FULL BLOCK CLR = CLEAR DIMENSIONS ARE TO FACE OF FINISHED MATERIAL
 - FOR WALLS AT GRIDLINES, CENTERLINE OF STUDS ARE AT CENTERLINE OF GRID / COLUMN UNLESS DIMENSIONED OTHERWISE.
- C. REFER TO ENLARGED PLANS OR DETAILS FOR ANY DIMENSIONS NOT INDICATED ON THESE PLANS.
- D. EXTERIOR DOOR AND WINDOW OPENING DIMENSIONS ARE TO FOM OR FACE OF STUD FRAMING (EDGE OF OPENING - NOT INCLUDING SEALANT JOINTS) UNLESS OTHERWISE NOTED.
- E. PROVIDE BACKING AS REQUIRED TO SUPPORT WALL AND CEILING MOUNTED CASEWORK, GRAB BARS, HANDRAILS, MIRRORS, EQUIPMENT AND OTHER ACCESSORIES THAT REQUIRE SUPPORT. VERIFY LOCATIONS PRIOR TO INSTALLATION OF GYPSUM BOARD. COORDINATE REQUIREMENTS FOR INCREASED STUD SIZES.
- F. SEE SHEET A-601 FOR EXTERIOR WALL ASSEMBLIES, A-602 FOR INTERIOR WALL ASSEMBLIES, AND A-603 FOR HORIZONTAL ASSEMBLIES.
- G. MULTIPLE LAYERS GWB WALLS TO HAVE MULTIPLE LAYERS ON SAME FACE AS WALL TAG UNLESS OTHERWISE NOTED. ALIGN FACE OF FINISHES AT ALL ADJACENT WALL TYPES U.N.O.
- H. CONTRACTOR TO VERIFY ALL INDICATED RECESS SLAB DEPTH WITH FINISH PRODUCT MANUFACTURER.
- I. ALL DOORS SHALL BE 6" FROM FACE OF STUD TO EDGE OF DOOR OPENING UNLESS OTHERWISE NOTED.
- J. SEE FINISH SCHEDULE FOR FLOOR FINISH INFORMATION.
- K. EXTERIOR STUD WALLS TO HAVE (1) LAYER OF GWB ON THE INTERIOR SIDE U.N.O.
- M. ASSEMBLIES FOR FIRE RATED WALLS AND COLUMNS SHALL EXTEND FROM STRUCTURAL FLOOR TO UNDERSIDE OF FLOOR DECK OR ROOF ABOVE, UNLESS SPECIFICALLY NOTED OTHERWISE. ALL OPENINGS AND JOINTS SHALL BE PROTECTED AS REQUIRED BY CODE.
- N. MAINTAIN FIRE RESISTANCE RATING FOR ALL CONSTRUCTION INDICATED AT THROUGH-WALL PENETRATIONS, BUILT-IN WALL FIXTURES, ACCESSORIES, AND BEHIND MAILBOXES, FIRE EXTINGUISHER CABINETS, PLUMBING FIXTURES, ELECTRIC PANELS AND SIMILAR ITEMS, IN COMPLIANCE WITH REQUIREMENTS OF APPLICABLE CODES. COORDINATE CONSTRUCTION OF FIRE-RATED ASSEMBLIES WITH DESIGNATED DESIGN NUMBER.
- O. COMPLETELY SEAL AROUND PENETRATIONS THROUGH ACoustICAL WALLS. FILL DEPTH OF GAPS AROUND CUT-OUTS FOR ELECTRICAL BOXES, PIPES AND PLUMBING, AND OTHER PENETRATIONS. PROVIDE INSULATION BETWEEN THE CONCEALED FACE OF FINISH MATERIALS (WITHIN THE STUD OR JOIST CAVITY) AND PIPES, PLUMBING, THE BACK OF BOXES, OR OTHER RECESSED FIXTURES.
- P. FRAME AND FINISH OPENINGS FOR MECHANICAL AND ELECTRICAL SYSTEMS AS REQUIRED BY MECHANICAL/ELECTRICAL DOCUMENTS.
- Q. COORDINATE WITH STRUCTURAL DRAWINGS FOR REQUIRED SHEARWALL SHEATHING. PROVIDE IN ADDITION TO COMPONENTS INDICATED ON WALL TYPE DETAILS AS REQUIRED.

KEYNOTES

Key Value	Keynote Text
P10	08 33 28 OVERHEAD COILING GRILLS; DEPLOYABLE EXIT DOORS
P11	08 33 45 VERTICAL ACTING FIRE DOOR SYSTEM
P12	10 51 00 HALLWAY LOCKERS
P18	11 66 23 WALL MOUNTED BACKSTOP; COORDINATE LOCATION WITH MANUFACTURER, COORDINATE WITH GAME LINES IN FINISH FLOOR PLANS.
P28	12 66 13 TELESCOPING BLEACHERS
P36	DIV 22 WATER FOUNTAIN
P38	DIV 26 GENERATOR, VERIFY MIN. CLEARANCES WITH MANUFACTURER
P39	DIV 26 FUTURE GENERATOR, VERIFY MIN. CLEARANCES WITH MANUFACTURER
P40	BIKE RACKS

Key Value	Keynote Text
F43	OFFICE KILN
P51	SEE A1/A-173 FOR COURT LINE LAYOUT
R01	DOWNSPOUT


PLAN SYMBOL LEGEND

- NON RATED WALL
- 1-HOUR RATED WALL
- 2-HOUR RATED WALL
- 3-HOUR RATED WALL
- ROUGH OPENING
- MASONRY OPENING


Robertson Sherwood Architects
mahlum
 ROBERTSON/SHERWOOD/ARCHITECTS PC
 132 EAST BROADWAY, SUITE 540
 EUGENE, OREGON 97401
 541-342-8077
 www.robertsonsherwood.com

MAHLUM ARCHITECTS INC
 121 NW HOYT, SUITE 102
 PORTLAND, OREGON 97209
 503-224-4032


71 COLUMBIA FLOOR 4
 SEATTLE, WASHINGTON 98104
 206-441-4151
 www.mahlum.com

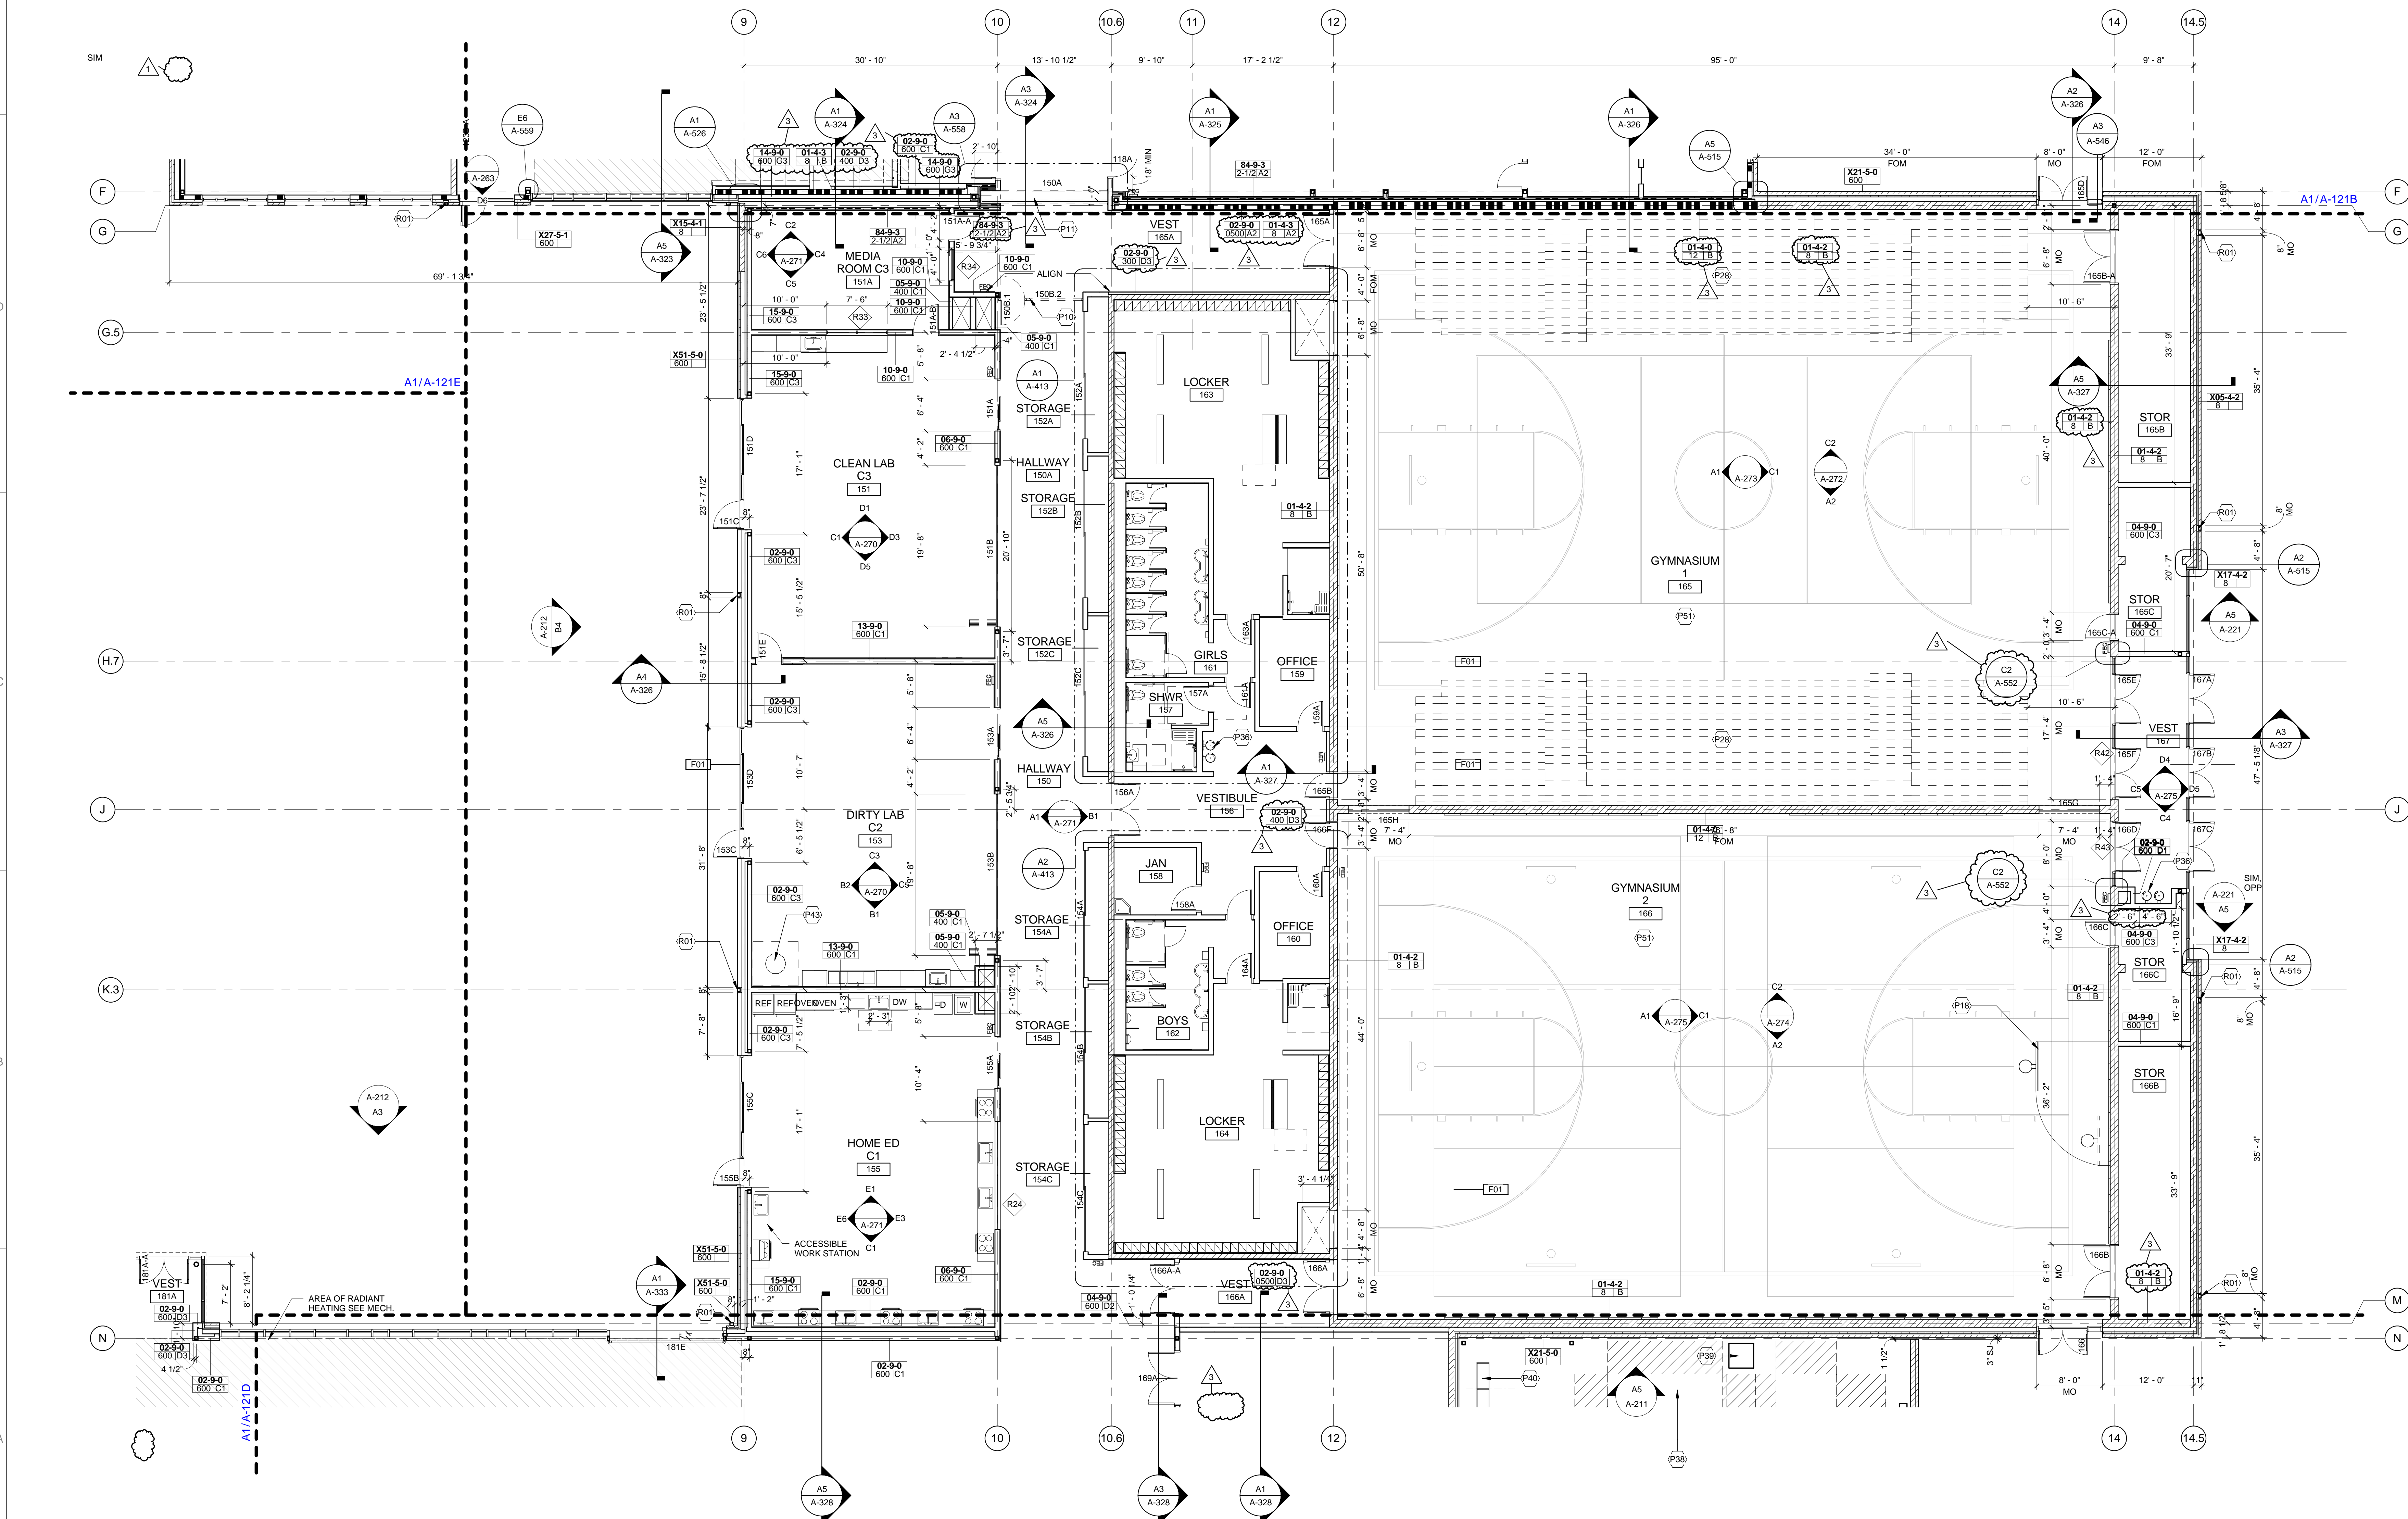

A1 FIRST FLOOR PLAN - ZONE C
 1/8" = 1'-0"

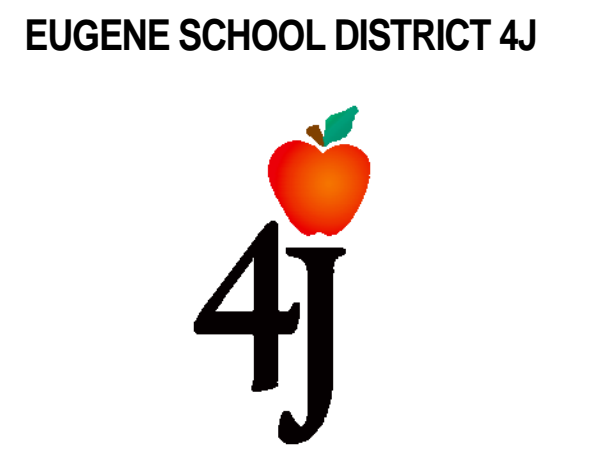

REPLACEMENT ROOSEVELT
 MIDDLE SCHOOL
 CIP NUMBER 410.566.001
 680 EAST 24TH AVENUE
 EUGENE, OREGON 97405

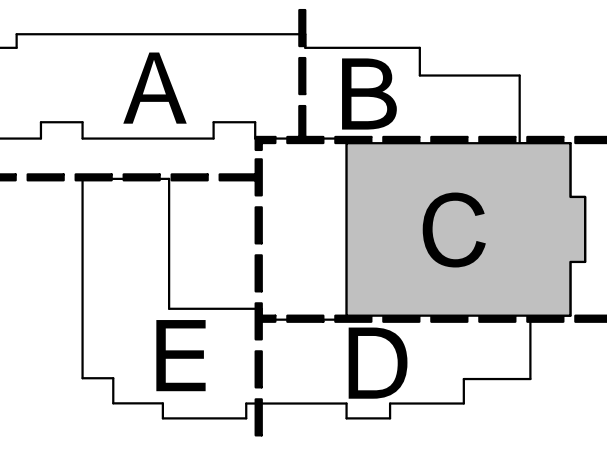

MARK	DATE	DESCRIPTION
3	3-13-2015	ADDENDUM 6
2	3-11-2015	ADDENDUM 5
1	2-27-2015	ADDENDUM 1

ISSUE DATE: FEBRUARY 18, 2015
 ISSUE: CONSTRUCTION DOCUMENTS
 VOLUME: PACKAGE 2 VOLUME 1

PROJECT NO.: 2013912.00
 DRAWN BY: AC
 CHECKED BY: DE
Copyright Mahlum Architects, Inc. 2014 ORIGINAL SHEET SIZE: 30" x 42"

FIRST FLOOR PLAN - ZONE C

A-121C

3/12/2015 4:45:10 PM C:\Users\msherman\OneDrive\Documents\121315\A-121C\A-121C.dwg

PLAN GENERAL NOTES

- A. CONTRACTOR TO VERIFY ALL CONDITIONS AND DIMENSIONS AND NOTIFY ARCHITECT OF ANY DISCREPANCIES PRIOR TO ANY WORK.
- B. UNLESS OTHERWISE NOTED, PLAN DIMENSIONS SHOWN ARE:
 -AT INTERIOR PARTITIONS: TO THE FACE OF STUD
 -AT COLUMNS: TO THE CENTERLINE OF COLUMNS, IF WALL AT COLUMN CENTER WALL ON COLUMN
 -AT CONCRETE: TO THE FACE OF CONCRETE
 -AT EXTERIOR WALLS: TO THE FACE OF STUD (TO THE EDGE OF SLAB) (TO THE FACE OF FOUNDATION WALL)
 -CMU WALLS ARE CENTERED ON GRID & DIMENSIONED TO INDICATE FULL BLOCK CLR = CLEAR DIMENSIONS ARE TO FACE OF FINISHED MATERIAL FOR WALLS AT GRIDLINES, CENTERLINE OF STUDS ARE AT CENTERLINE OF GRID / COLUMN UNLESS DIMENSIONED OTHERWISE.
- C. REFER TO ENLARGED PLANS OR DETAILS FOR ANY DIMENSIONS NOT INDICATED ON THESE PLANS.
- D. EXTERIOR DOOR AND WINDOW OPENING DIMENSIONS ARE TO FOM OR FACE OF STUD FRAMING (EDGE OF OPENING - NOT INCLUDING SEALANT JOINTS) UNLESS OTHERWISE NOTED.
- E. PROVIDE BACKING AS REQUIRED TO SUPPORT WALL AND CEILING MOUNTED CASEWORK, GRAB BARS, HANDRAILS, MIRRORS, EQUIPMENT AND OTHER ACCESSORIES THAT REQUIRE SUPPORT. VERIFY LOCATIONS PRIOR TO INSTALLATION OF GYPSUM BOARD. COORDINATE REQUIREMENTS FOR INCREASED STUD SIZES.
- F. SEE SHEET A-601 FOR EXTERIOR WALL ASSEMBLIES, A-602 FOR INTERIOR WALL ASSEMBLIES, AND A-603 FOR HORIZONTAL ASSEMBLIES.
- G. MULTIPLE LAYERS GWB WALLS TO HAVE MULTIPLE LAYERS ON SAME FACE AS WALL TAG UNLESS OTHERWISE NOTED. ALIGN FACE OF FINISHES AT ALL ADJACENT WALL TYPES U.N.O.
- H. CONTRACTOR TO VERIFY ALL INDICATED RECESS SLAB DEPTH WITH FINISH PRODUCT MANUFACTURER.
- I. ALL DOORS SHALL BE 6" FROM FACE OF STUD TO EDGE OF DOOR OPENING UNLESS OTHERWISE NOTED.
- J. SEE FINISH SCHEDULE FOR FLOOR FINISH INFORMATION.
- K. EXTERIOR STUD WALLS TO HAVE (1) LAYER OF GWB ON THE INTERIOR SIDE U.N.O.

- M. ASSEMBLIES FOR FIRE RATED WALLS AND COLUMNS SHALL EXTEND FROM STRUCTURAL FLOOR TO UNDERSIDE OF FLOOR DECK OR ROOF ABOVE, UNLESS SPECIFICALLY NOTED OTHERWISE. ALL OPENINGS AND JOINTS SHALL BE PROTECTED AS REQUIRED BY CODE.
- N. MAINTAIN FIRE RESISTANCE RATING FOR ALL CONSTRUCTION INDICATED AT THROUGH-WALL PENETRATIONS, BUILT-IN WALL FIXTURES, ACCESSORIES, AND BEHIND MAILBOXES, FIRE EXTINGUISHER CABINETS, PLUMBING FIXTURES, ELECTRIC PANELS AND SIMILAR ITEMS, IN COMPLIANCE WITH REQUIREMENTS OF APPLICABLE CODES. COORDINATE CONSTRUCTION OF FIRE-RATED ASSEMBLIES WITH DESIGNATED DESIGN NUMBER.
- O. COMPLETELY SEAL AROUND PENETRATIONS THROUGH ACOUSTICAL WALLS. FILL DEPTH OF GAPS AROUND CUT-OUTS FOR ELECTRICAL BOXES, PIPES AND PLUMBING, AND OTHER PENETRATIONS. PROVIDE INSULATION BETWEEN THE CONCEALED FACE OF FINISH MATERIALS (WITHIN THE STUD OR JOIST CAVITY) AND PIPES, PLUMBING, THE BACK OF BOXES, OR OTHER RECESSED FIXTURES.
- P. FRAME AND FINISH OPENINGS FOR MECHANICAL AND ELECTRICAL SYSTEMS AS REQUIRED BY MECHANICAL/ELECTRICAL DOCUMENTS.
- Q. COORDINATE WITH STRUCTURAL DRAWINGS FOR REQUIRED SHEARWALL SHEATHING. PROVIDE IN ADDITION TO COMPONENTS INDICATED ON WALL TYPE DETAILS AS REQUIRED.

KEYNOTES

A- KEYNOTES FLOOR PLAN	
Key Value	Keynote Text
P04	05 51 33 WALL LADDER WITH EXTENSIONS
P08	08 33 13 COILING COUNTER DOOR
P09	08 33 23 OVERHEAD COILING DOOR
P16	11 40 00 CAN WASH
P18	11 69 23 WALL MOUNTED BACKSTOP, COORDINATE LOCATION WITH MANUFACTURER. COORDINATE WITH GAME LINES IN FINISH FLOOR PLANS.
P31	BOLLARD, SEE 2A-106.3
P35	PROVIDE BLOCKING FOR MOP HOLDERS
P36	DIV 22 WATER FOUNTAIN
P37	DIV 23 CHILLER, VERIFY MIN. CLEARANCES WITH MANUFACTURER
P38	DIV 26 GENERATOR, VERIFY MIN. CLEARANCES WITH MANUFACTURER

A- KEYNOTES FLOOR PLAN	
Key Value	Keynote Text
P39	DIV 26 FUTURE GENERATOR, VERIFY MIN. CLEARANCES WITH MANUFACTURER
P40	BIKE RACKS
P47	OPCI TRASH COMPACTOR
P48	11 40 00 REFRIGERANT SKID
P50	DIV 26 ELECTRICAL METER
P58	DIV 22 FLOOR DRAIN
R01	DOWNSPOUT


PLAN SYMBOL LEGEND

- NON RATED WALL
- 1-HOUR RATED WALL
- 2-HOUR RATED WALL
- 3-HOUR RATED WALL
- ROUGH OPENING
- MASONRY OPENING


mahlum
 Robert Sherwood Architects
ROBERTSON/SHERWOOD/ARCHITECTS PC
 132 EAST BROADWAY, SUITE 540
 EUGENE, OREGON 97401
 541-342-8077
 www.robertsonsherwood.com

MAHLUM ARCHITECTS INC
 1231 NW HOYT, SUITE 102
 PORTLAND, OREGON 97209
 503-224-4032

71 COLUMBIA FLOOR 4
 SEATTLE, WASHINGTON 98104
 206-441-4151
 www.mahlum.com

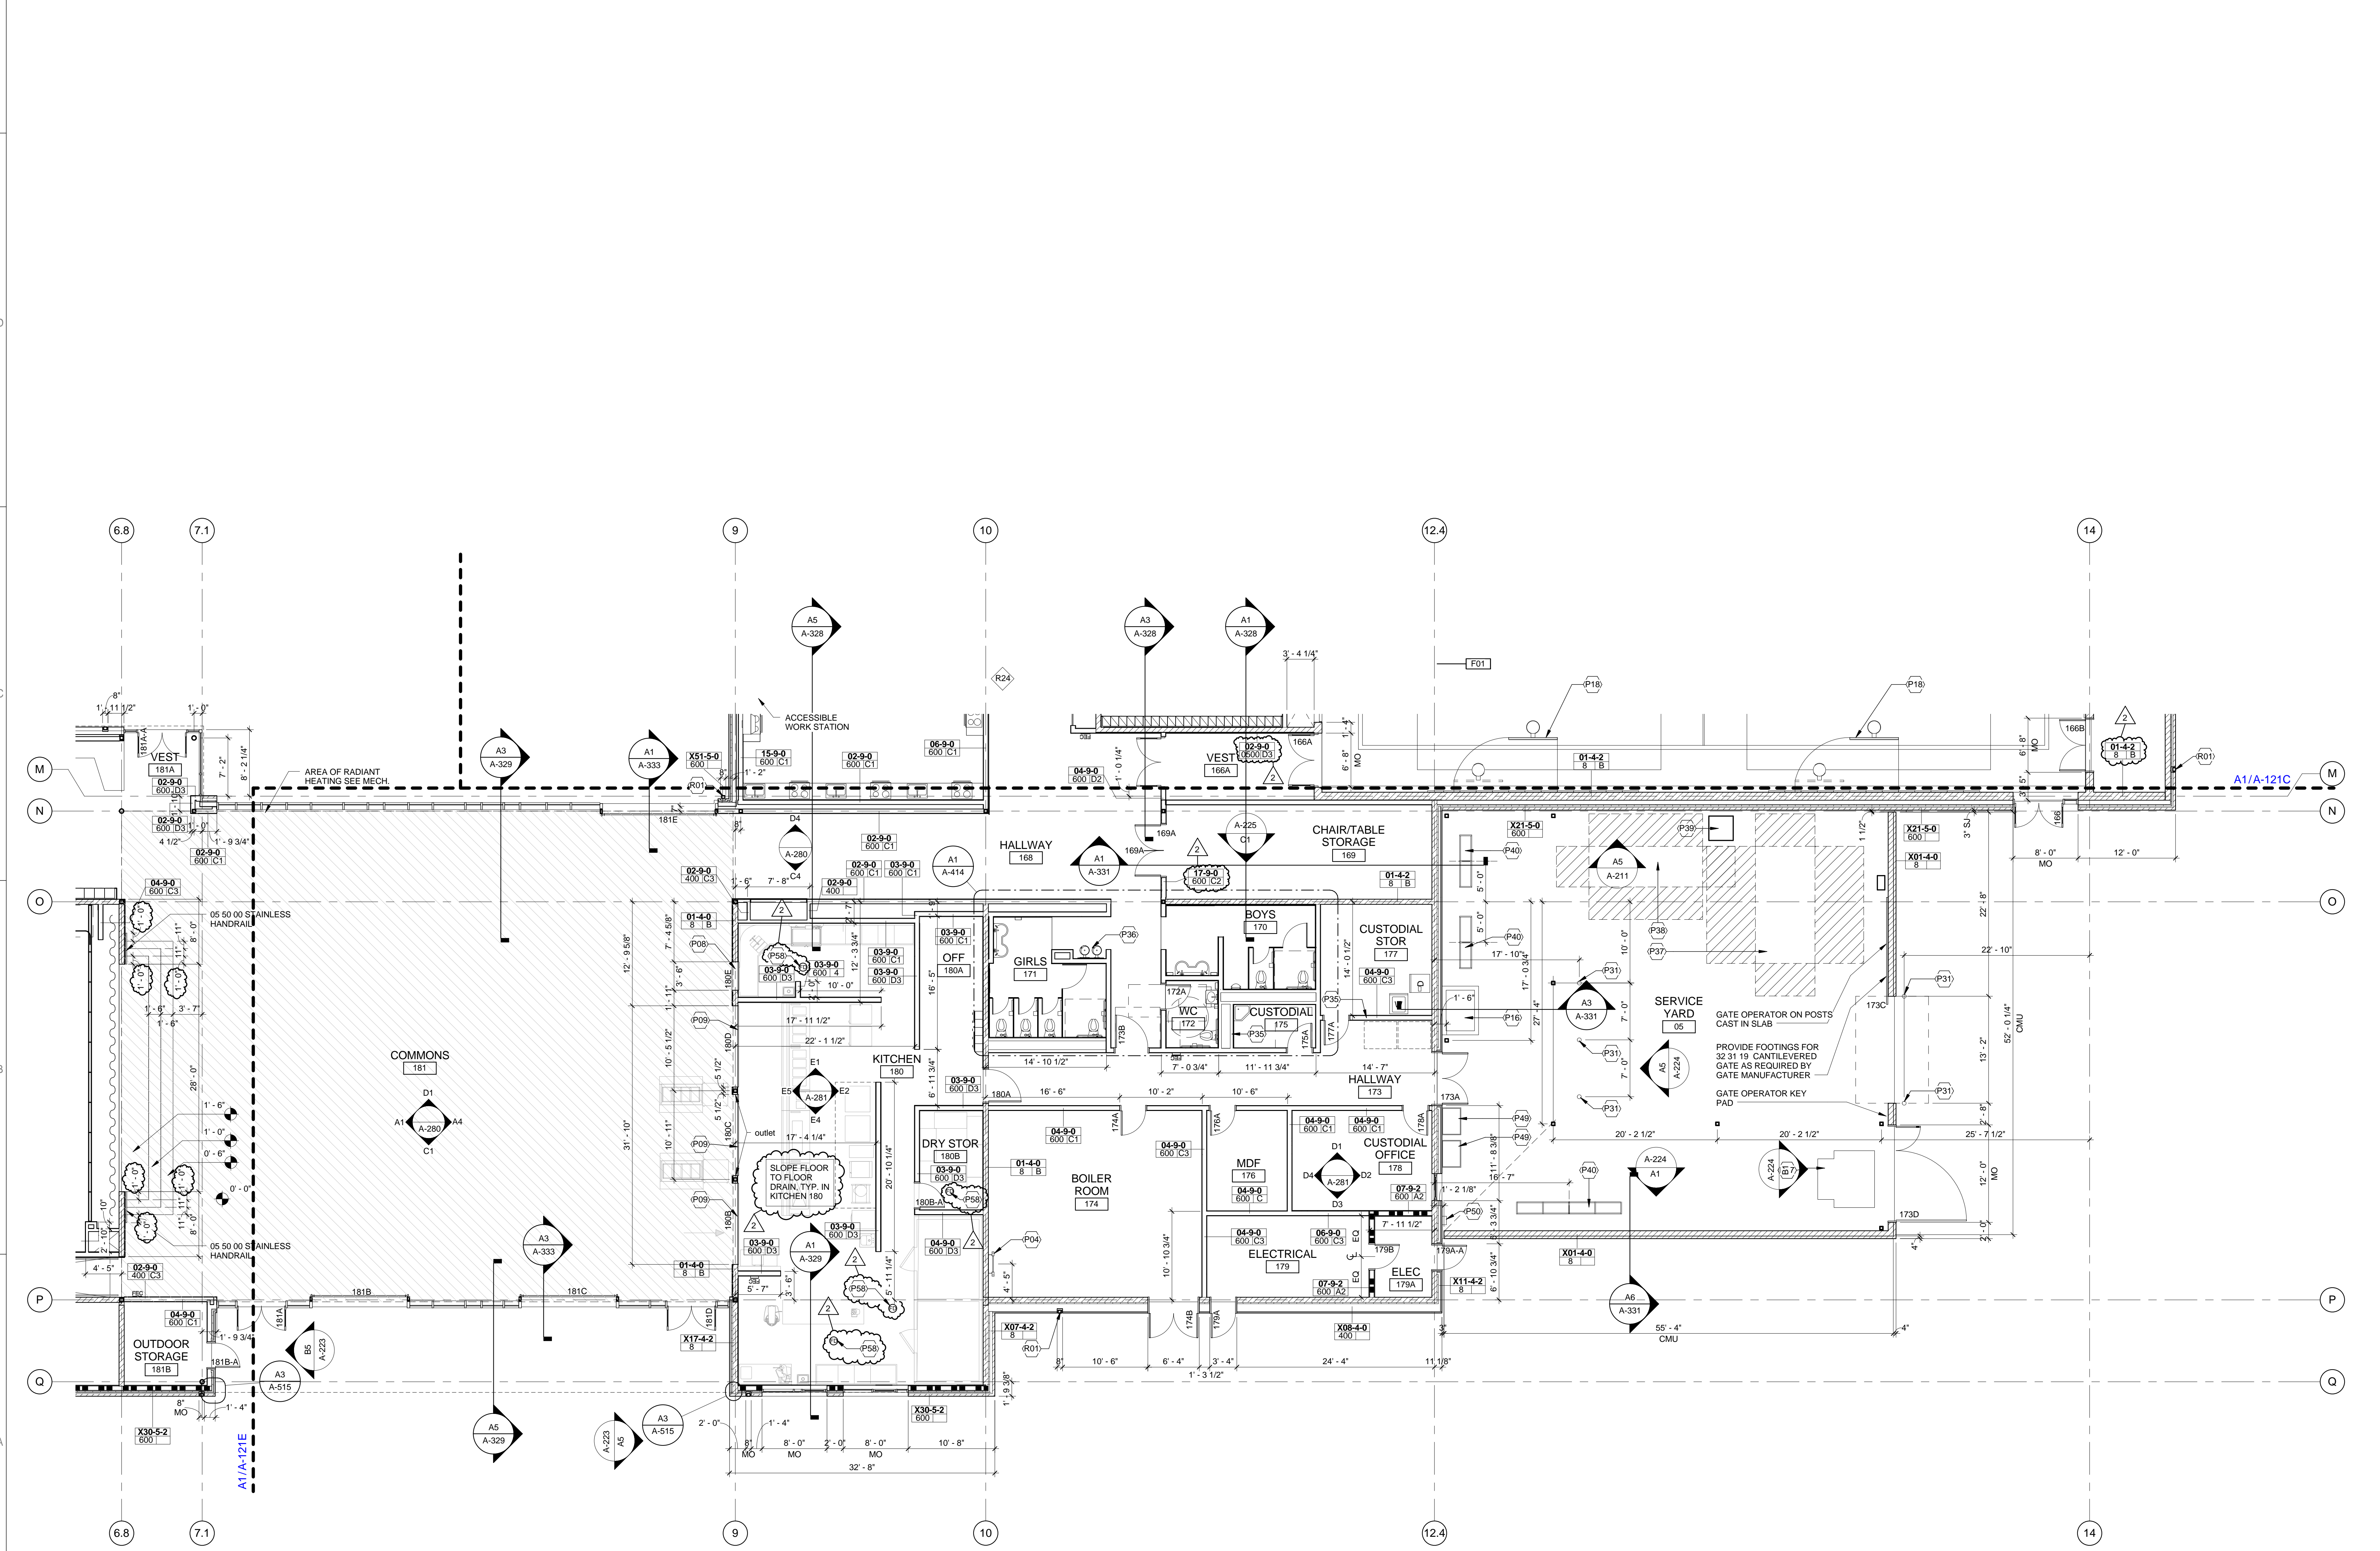


A1 FIRST FLOOR PLAN - ZONE D
 1/8" = 1'-0"

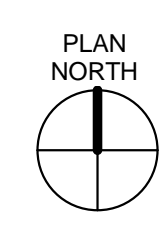

EUGENE SCHOOL DISTRICT 4J

REPLACEMENT ROOSEVELT
 MIDDLE SCHOOL
 CIP NUMBER 410.566.001
 680 EAST 24TH AVENUE
 EUGENE, OREGON 97405

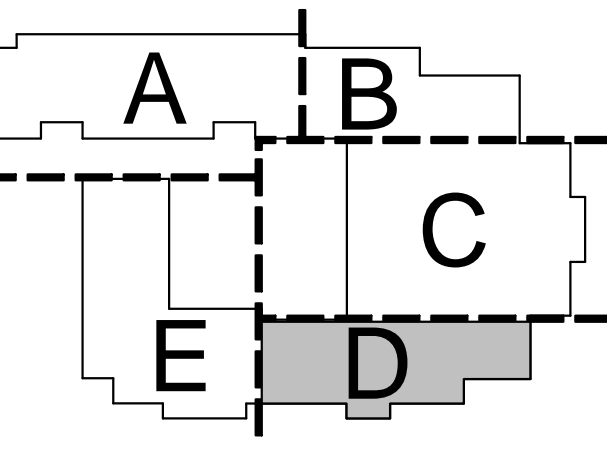

MARK	DATE	DESCRIPTION
2	3-13-2015	ADDENDUM 6
1	3-11-2015	ADDENDUM 5

ISSUE DATE: FEBRUARY 18, 2015
 ISSUE: CONSTRUCTION DOCUMENTS
 VOLUME: PACKAGE 2 VOLUME 1

PROJECT NO: 2013912.00
 DRAWN BY: AC
 CHECKED BY: Checker
 COPYRIGHT MAHLUM ARCHITECTS, INC. 2014 ORIGINAL SHEET SIZE: 30" x 42"

FIRST FLOOR PLAN - ZONE D

A-121D

PLAN GENERAL NOTES

- A. CONTRACTOR TO VERIFY ALL CONDITIONS AND DIMENSIONS AND NOTIFY ARCHITECT OF ANY DISCREPANCIES PRIOR TO ANY WORK.
- B. UNLESS OTHERWISE NOTED, PLAN DIMENSIONS SHOWN ARE:
- AT INTERIOR PARTITIONS, TO THE FACE OF STUD
- AT COLUMNS, TO THE CENTERLINE OF COLUMNS, IF WALL AT COLUMN CENTER WALL ON COLUMN
- AT CONCRETE, TO THE FACE OF CONCRETE
- AT EXTERIOR WALLS, TO THE FACE OF STUD (TO THE EDGE OF SLAB) (TO THE FACE OF FOUNDATION WALL)
- CMU WALLS ARE CENTERED ON GRID & DIMENSIONED TO INDICATE FULL BLOCK CLR = CLEAR DIMENSIONS ARE TO FACE OF FINISHED MATERIAL
FOR WALLS AT GRIDLINES, CENTERLINE OF STUDS ARE AT CENTERLINE OF GRID / COLUMN UNLESS DIMENSIONED OTHERWISE.
- C. REFER TO ENLARGED PLANS OR DETAILS FOR ANY DIMENSIONS NOT INDICATED ON THESE PLANS.
- D. EXTERIOR DOOR AND WINDOW OPENING DIMENSIONS ARE TO FOM OR FACE OF STUD FRAMING (EDGE OF OPENING - NOT INCLUDING SEALANT JOINTS) UNLESS OTHERWISE NOTED.
- E. PROVIDE BACKING AS REQUIRED TO SUPPORT WALL AND CEILING MOUNTED CASEWORK, GRAB BARS, HANDRAILS, MIRRORS, EQUIPMENT AND OTHER ACCESSORIES THAT REQUIRE SUPPORT. VERIFY LOCATIONS PRIOR TO INSTALLATION OF GYPSUM BOARD. COORDINATE REQUIREMENTS FOR INCREASED STUD SIZES.
- F. SEE SHEET A-601 FOR EXTERIOR WALL ASSEMBLIES, A-602 FOR INTERIOR WALL ASSEMBLIES, AND A-603 FOR HORIZONTAL ASSEMBLIES.
- G. MULTIPLE LAYERS GWB WALLS TO HAVE MULTIPLE LAYERS ON SAME FACE AS WALL TAG UNLESS OTHERWISE NOTED. ALIGN FACE OF FINISHES AT ALL ADJACENT WALL TYPES U.N.O.
- H. CONTRACTOR TO VERIFY ALL INDICATED RECESS SLAB DEPTH WITH FINISH PRODUCT MANUFACTURER.
- I. ALL DOORS SHALL BE 6" FROM FACE OF STUD TO EDGE OF DOOR OPENING UNLESS OTHERWISE NOTED.
- J. SEE FINISH SCHEDULE FOR FLOOR FINISH INFORMATION.
- K. EXTERIOR STUD WALLS TO HAVE (1) LAYER OF GWB ON THE INTERIOR SIDE U.N.O.

- M. ASSEMBLIES FOR FIRE RATED WALLS AND COLUMNS SHALL EXTEND FROM STRUCTURAL FLOOR TO UNDERSIDE OF FLOOR DECK OR ROOF ABOVE, UNLESS SPECIFICALLY NOTED OTHERWISE. ALL OPENINGS AND JOINTS SHALL BE PROTECTED AS REQUIRED BY CODE.
- N. MAINTAIN FIRE RESISTANCE RATING FOR ALL CONSTRUCTION INDICATED AT THROUGH-WALL PENETRATIONS, BUILT-IN WALL FIXTURES, ACCESSORIES, AND BEHIND MAILBOXES, FIRE EXTINGUISHER CABINETS, PLUMBING FIXTURES, ELECTRIC PANELS AND SIMILAR ITEMS, IN COMPLIANCE WITH REQUIREMENTS OF APPLICABLE CODES. COORDINATE CONSTRUCTION OF FIRE-RATED ASSEMBLIES WITH DESIGNATED DESIGN NUMBER.
- O. COMPLETELY SEAL AROUND PENETRATIONS THROUGH ACoustICAL WALLS. FILL DEPTH OF GAPS AROUND CUT-OUTS FOR ELECTRICAL BOXES, PIPES AND PLUMBING, AND OTHER PENETRATIONS. PROVIDE INSULATION BETWEEN THE CONCRETE FACE OF FINISH MATERIALS (WITHIN THE STUD OR JOIST CAVITY) AND PIPES, PLUMBING, THE BACK OF BOXES, OR OTHER RECESSED FIXTURES.
- P. FRAME AND FINISH OPENINGS FOR MECHANICAL AND ELECTRICAL SYSTEMS AS REQUIRED BY MECHANICAL/ELECTRICAL DOCUMENTS.
- Q. COORDINATE WITH STRUCTURAL DRAWINGS FOR REQUIRED SHEARWALL SHEATHING. PROVIDE IN ADDITION TO COMPONENTS INDICATED ON WALL TYPE DETAILS AS REQUIRED.

KEYNOTES

Key Value	Keynote Text
P03	05 51 33 SHIPS LADDER
P04	05 51 33 WALL LADDER WITH EXTENSIONS
P05	05 51 33 WALL LADDER NO EXTENSIONS
P10	08 33 28 OVERHEAD COILING GRILLS/ DEPLOYABLE EXIT DOORS
P12	10 51 00 HALLWAY LOCKERS
P14	10 22 26 33 SLIDING PANEL PARTITION
P42	05 05 REFRIGERATOR

PLAN SYMBOL LEGEND

- NON RATED WALL
- 1-HOUR RATED WALL
- 2-HOUR RATED WALL
- 3-HOUR RATED WALL
- ROUGH OPENING
- MASONRY OPENING

Robertson Sherwood Architects
mahlum
 ROBERTSON/SHERWOOD/ARCHITECTS PC
 132 EAST BROADWAY, SUITE 540
 EUGENE, OREGON 97401
 541-342-8077
 www.robertsonsherwood.com

MAHLUM ARCHITECTS INC
 1231 NW HOYT, SUITE 102
 PORTLAND, OREGON 97209
 503-224-4032

71 COLUMBIA FLOOR 4
 SEATTLE, WASHINGTON 98104
 206-441-4151
 www.mahlum.com



mahlum

REGISTERED ARCHITECT
 5594
 LEROY LANDERS
 PORTLAND, OREGON
 STATE OF OREGON

EUGENE SCHOOL DISTRICT 4J

4j

REPLACEMENT ROOSEVELT
 MIDDLE SCHOOL
 CIP NUMBER 410.566.001
 680 EAST 24TH AVENUE
 EUGENE, OREGON 97405

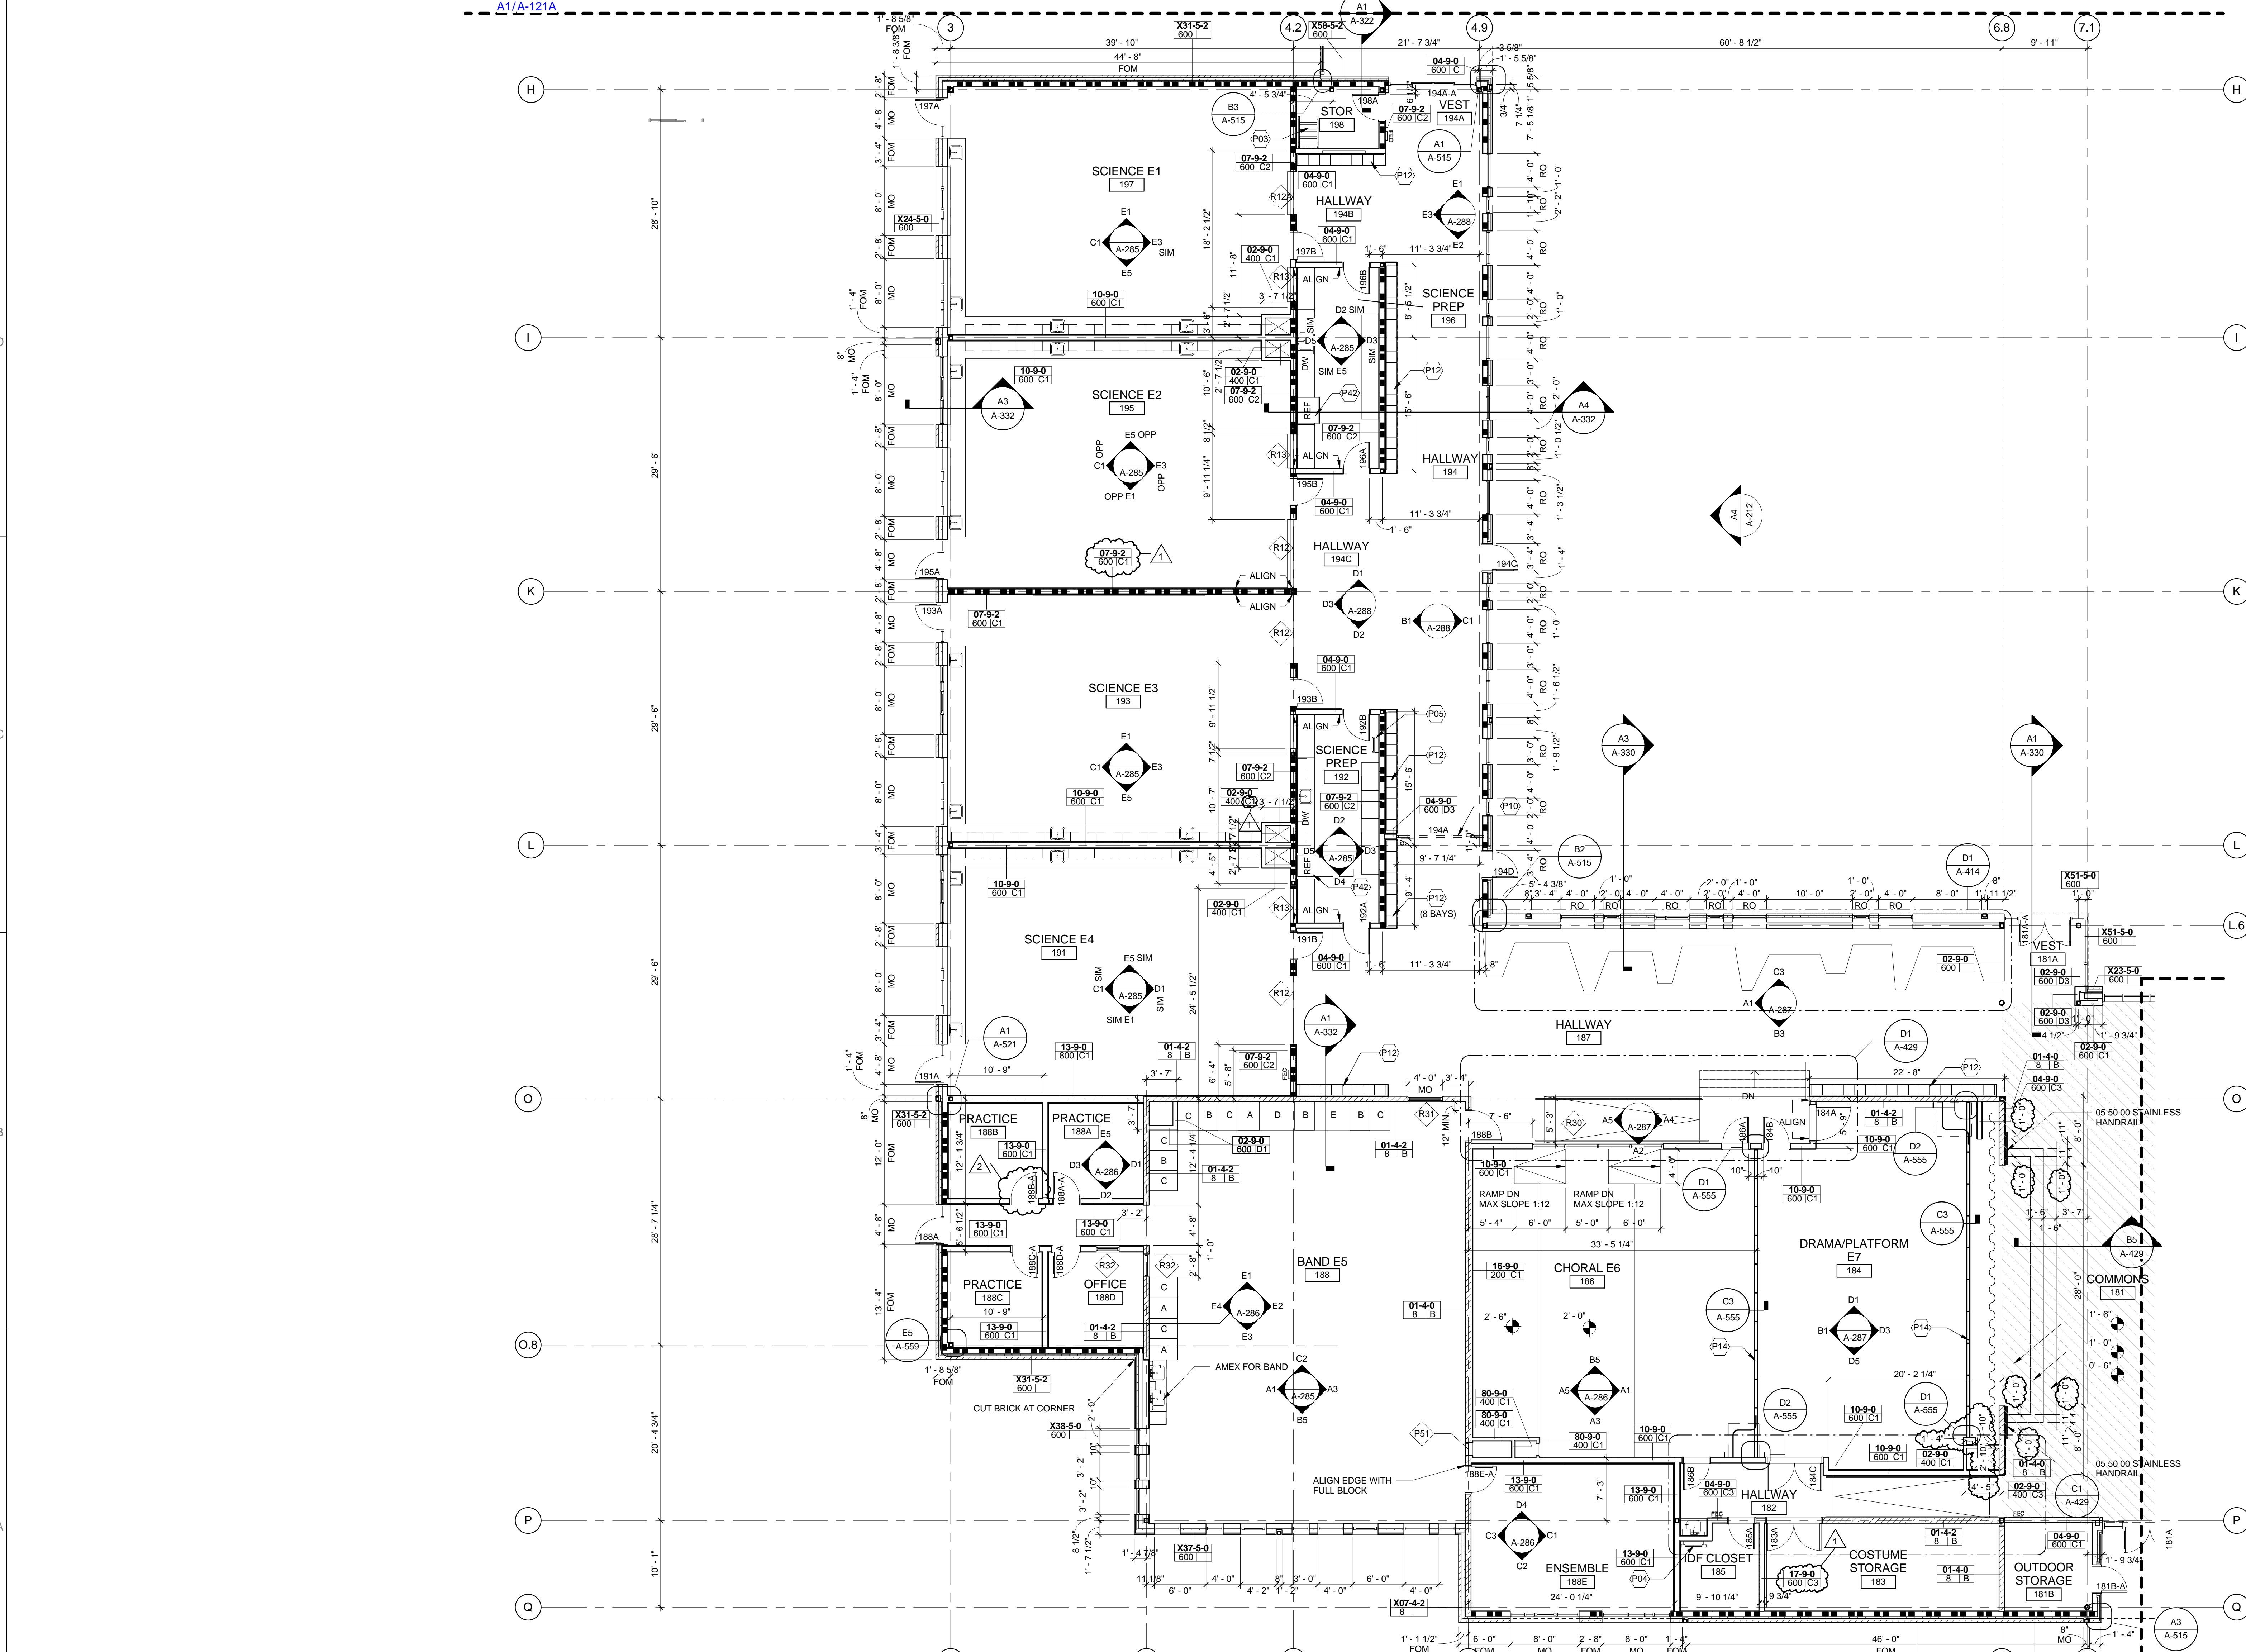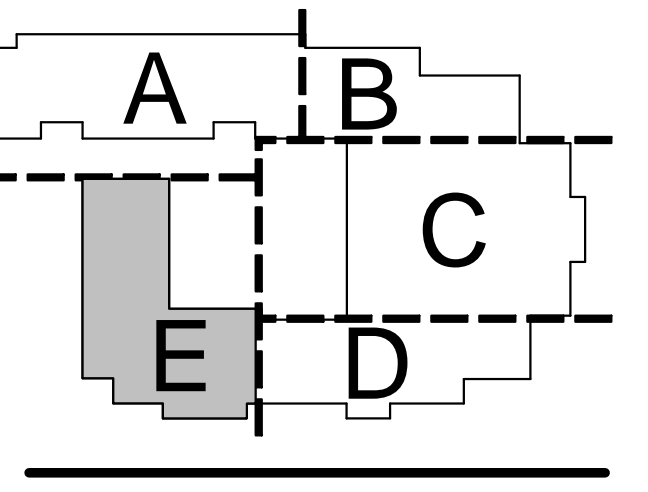

A1 FIRST FLOOR PLAN - ZONE E
 1/8" = 1'-0"

MARK	DATE	DESCRIPTION
2	3-13-2015	ADDENDUM 6
1	3-11-2015	ADDENDUM 5

ISSUE DATE: FEBRUARY 18, 2015
 ISSUE: CONSTRUCTION DOCUMENTS
 VOLUME: PACKAGE 2 VOLUME 1

PROJECT NO: 2013912.00
 DRAWN BY: AC
 CHECKED BY: DE
 COPYRIGHT MAHLUM ARCHITECTS, INC. 2014 ORIGINAL SHEET SIZE: 30"X42"

FIRST FLOOR PLAN - ZONE E

A-121E

PLAN GENERAL NOTES

- A. CONTRACTOR TO VERIFY ALL CONDITIONS AND DIMENSIONS AND NOTIFY ARCHITECT OF ANY DISCREPANCIES PRIOR TO ANY WORK.
- B. UNLESS OTHERWISE NOTED, PLAN DIMENSIONS SHOWN ARE:
 - AT INTERIOR PARTITIONS: TO THE FACE OF STUD
 - AT COLUMNS: TO THE CENTERLINE OF COLUMNS, IF WALL AT COLUMN CENTER WALL ON COLUMN
 - AT CONCRETE: TO THE FACE OF CONCRETE
 - AT EXTERIOR WALLS: TO THE FACE OF STUD (TO THE EDGE OF SLAB) (TO THE FACE OF FOUNDATION WALL)
 - CMU WALLS ARE CENTERED ON GRID & DIMENSIONED TO INDICATE FULL BLOCK CLR = CLEAR DIMENSIONS ARE TO FACE OF FINISHED MATERIAL
 - FOR WALLS AT GRIDLINES, CENTERLINE OF STUDS ARE AT CENTERLINE OF GRID / COLUMN UNLESS DIMENSIONED OTHERWISE.
- C. REFER TO ENLARGED PLANS OR DETAILS FOR ANY DIMENSIONS NOT INDICATED ON THESE PLANS.
- D. EXTERIOR DOOR AND WINDOW OPENING DIMENSIONS ARE TO FOM OR FACE OF STUD FRAMING (EDGE OF OPENING - NOT INCLUDING SEALANT JOINTS) UNLESS OTHERWISE NOTED.
- E. PROVIDE BACKING AS REQUIRED TO SUPPORT WALL AND CEILING MOUNTED CASEWORK, GRAB BARS, HANDRAILS, MIRRORS, EQUIPMENT AND OTHER ACCESSORIES THAT REQUIRE SUPPORT. VERIFY LOCATIONS PRIOR TO INSTALLATION OF GYPSUM BOARD. COORDINATE REQUIREMENTS FOR INCREASED STUD SIZES.
- F. SEE SHEET A-601 FOR EXTERIOR WALL ASSEMBLIES, A-602 FOR INTERIOR WALL ASSEMBLIES, AND A-603 FOR HORIZONTAL ASSEMBLIES.
- G. MULTIPLE LAYERS GWB WALLS TO HAVE MULTIPLE LAYERS ON SAME FACE AS WALL TAG UNLESS OTHERWISE NOTED. ALIGN FACE OF FINISHES AT ALL ADJACENT WALL TYPES U.N.O.
- H. CONTRACTOR TO VERIFY ALL INDICATED RECESS SLAB DEPTH WITH FINISH PRODUCT MANUFACTURER.
- I. ALL DOORS SHALL BE 6" FROM FACE OF STUD TO EDGE OF DOOR OPENING UNLESS OTHERWISE NOTED.
- J. SEE FINISH SCHEDULE FOR FLOOR FINISH INFORMATION.
- K. EXTERIOR STUD WALLS TO HAVE (1) LAYER OF GWB ON THE INTERIOR SIDE U.N.O.

KEYNOTES

A- KEYNOTES FLOOR PLAN	
Key Value	Keynote Text
P04	05 51 33 WALL LADDER WITH EXTENSIONS
P36	DIV 22 WATER FOUNTAIN
P54	FULLY RECESSED FIRE EXTINGUISHER CABINET
P57	SURFACE MOUNT FIRE EXTINGUISHER BRACKET

PLAN SYMBOL LEGEND


	NON RATED WALL
	1-HOUR RATED WALL
	2-HOUR RATED WALL
	3-HOUR RATED WALL
	ROUGH OPENING
	MASONRY OPENING

Robertson Sherwood Architects
mahlum

ROBERTSON/SHERWOOD/ARCHITECTS PC
 132 EAST BROADWAY, SUITE 540
 EUGENE, OREGON 97401
 541-342-8077
 www.robertsonsherwood.com

MAHLUM ARCHITECTS INC
 1321 NW HOYT, SUITE 102
 PORTLAND, OREGON 97209
 503-224-4032

71 COLUMBIA FLOOR 4
 SEATTLE, WASHINGTON 98104
 206-441-4151
 www.mahlum.com

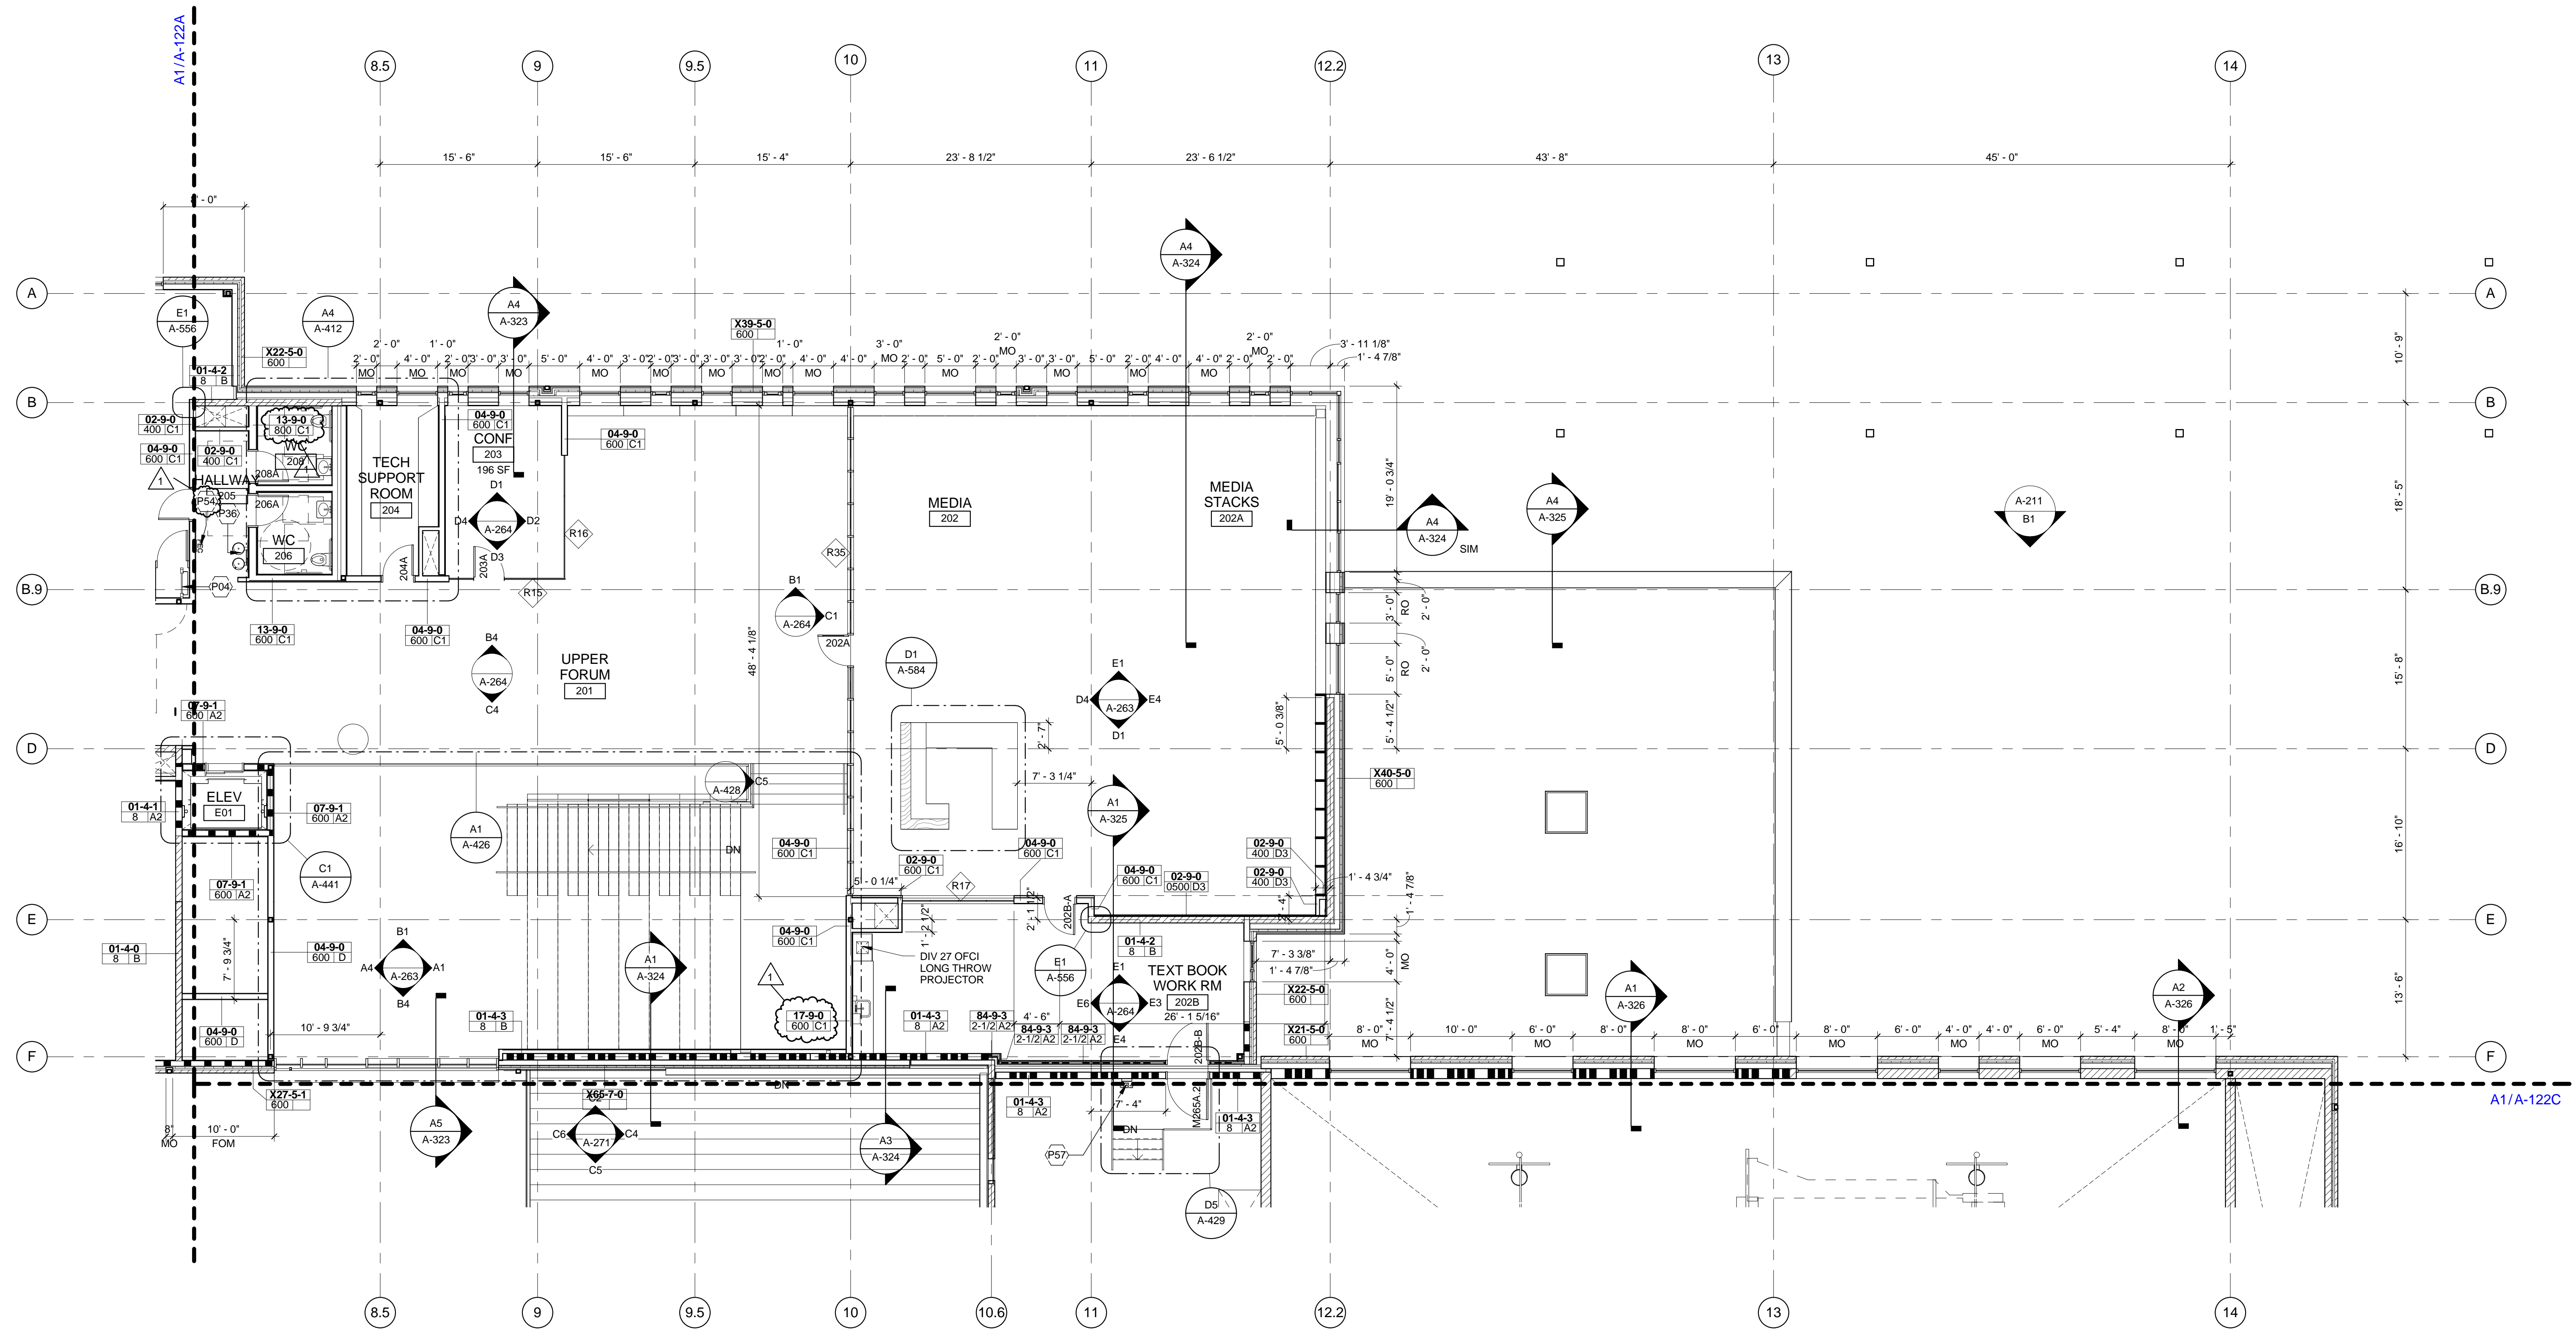


A1 SECOND FLOOR PLAN - ZONE B
1/8" = 1'-0"



EUGENE SCHOOL DISTRICT 4J


4J

REPLACEMENT ROOSEVELT
 MIDDLE SCHOOL
 CIP NUMBER 410.566.001
 680 EAST 24TH AVENUE
 EUGENE, OREGON 97405

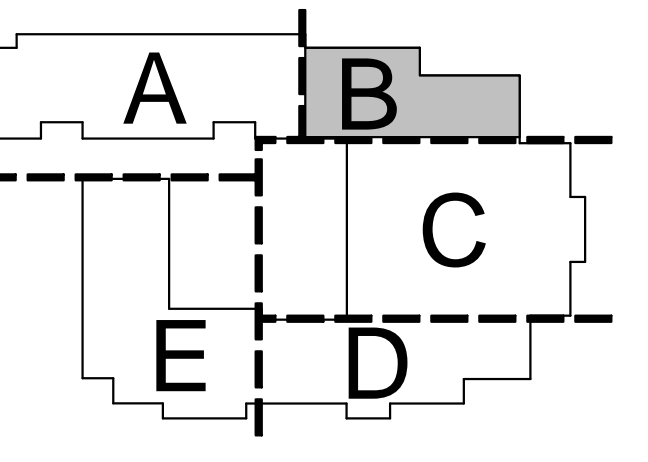

MARK	DATE	DESCRIPTION
1	2-27-2015	ADDENDUM 1
ISSUE DATE: FEBRUARY 18, 2015		
ISSUE: CONSTRUCTION DOCUMENTS		
VOLUME: PACKAGE 2 VOLUME 1		
PROJECT NO.:	2013912.00	
DRAWN BY:	AC	
CHECKED BY:	DE	
COPYRIGHT MAHLUM ARCHITECTS, INC. 2014 ORIGINAL SHEET SIZE: 30"X42"		
SECOND FLOOR PLAN - ZONE B		

A-122B

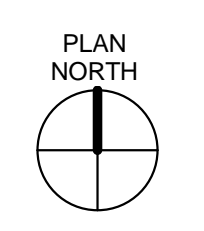

3/10/2015 4:43:35 PM C:\Users\msherman\OneDrive\Documents\A-122B.dwg _printplot.dwg

ROOF PLAN GENERAL NOTES

- A. REFERENCE STRUCTURAL AND MECHANICAL DRAWINGS FOR ROOF PENETRATIONS.
- B. VERIFY ALL ROOF PENETRATIONS AND ROOFING DETAILS COMPLY WITH MANUFACTURERS STANDARD DETAILS BEFORE INSTALLING.
- C. COORDINATE ROOFTOP WALKWAYS WITH MECHANICAL UNITS AND ACCESS PATHWAY. ALL UNITS ON MEMBRANE ROOFS TO HAVE PERIMETER WALKWAYS.
- D. ALL SHEET METAL ROOF FLASHING TO BE COLOR SM 1 UNLESS NOTED OTHERWISE ON THE ROOFING DETAILS.
- E. PROVIDE EXPANSION JOINTS @ ALL GUTTERS AND GUTTER COVERS. REFER EXPANSION JOINT DETAILS ON A2 & A3/A-532.

KEYNOTES

Key Value	Keynote Text
R01	DOWNSPOUT
R02	SCUPPER AND DOWNPOUT
R03	ROOF DRAIN AND DOWNPOUT
R04	KITCHEN EXHAUST
R05	FLUME HOOD EXHAUST
R06	SKYLIGHT, TYP.
R07	SUNSHADE, TYP.
R09	ROOF-MOUNTED ANTENNAE - REFER TO TECHNOLOGY DRAWINGS
R10	ROOF HATCH
R11	SOLAR PANELS W/ BRACKETS MOUNTED ON STEEL FRAME
R12	EXPANSION JOINT
R13	REFER TO MECHANICAL

Key Value	Keynote Text
R15	SOLAR THERMAL PANEL W/ BRACKETS MOUNTED ON STEEL FRAME
R16	SCUPPER
R17	SNOW GUARD
R18	FALL PROTECTION ANCHOR

ROOF PLAN MATERIAL LEGEND

- 07 41 13 STANDING SEAM METAL ROOFING
- 07 54 00 MEMBRANE ROOFING
- 07 54 00 TAPERED INSULATION
- 07 54 00 WALKWAY PAD
- FALL PROTECTION ANCHOR

ROOF PLAN SYMBOL LEGEND

- FOUR FOOT WIDE ROOF ZONE SOUTH OF GRID F & BETWEEN GRIDS 9 & 12 THAT REQUIRES FIRE RETARDANT TREATED PLYWOOD & NO ROOF PENETRATIONS ZONE.
- SNOWGUARDS ABOVE ALL ENTRIES AT METAL ROOFS ONLY.

mahlum
 132 EAST BROADWAY, SUITE 540
 EUGENE, OREGON 97401
 541-342-8077
 www.robertsonsherwood.com

MAHLUM ARCHITECTS INC
 1231 NW HOYT, SUITE 102
 PORTLAND, OREGON 97209
 503-224-4032


71 COLUMBIA, FLOOR 4
 SEATTLE, WASHINGTON 98104
 206-441-4151
 www.mahlum.com

Robertson Sherwood Architects
 132 East Broadway, Suite 540
 Eugene, Oregon 97401
 P (541) 342-8077
 F (541) 345-9302


REGISTERED ARCHITECT
 5594
 LEROY A. LANDERS
 STATE OF OREGON

EUGENE SCHOOL DISTRICT 4J


REPLACEMENT ROOSEVELT MIDDLE SCHOOL
 CIP NUMBER 410.566.001
 680 EAST 24TH AVENUE
 EUGENE, OREGON 97405

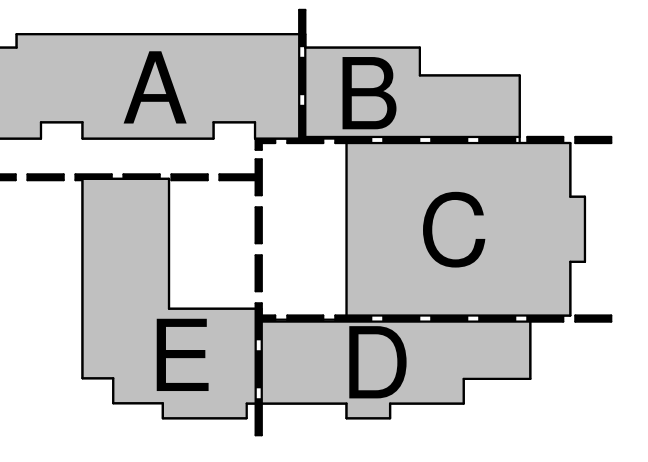


MARK	DATE	DESCRIPTION
1	3-13-2015	ADDENDUM 6
ISSUE DATE: FEBRUARY 18, 2015		
ISSUE: CONSTRUCTION DOCUMENTS		
VOLUME: PACKAGE 2 VOLUME 1		
PROJECT NO.: 2013912.00		
DRAWN BY: JR		
CHECKED BY: DG		
ROOF PLAN		

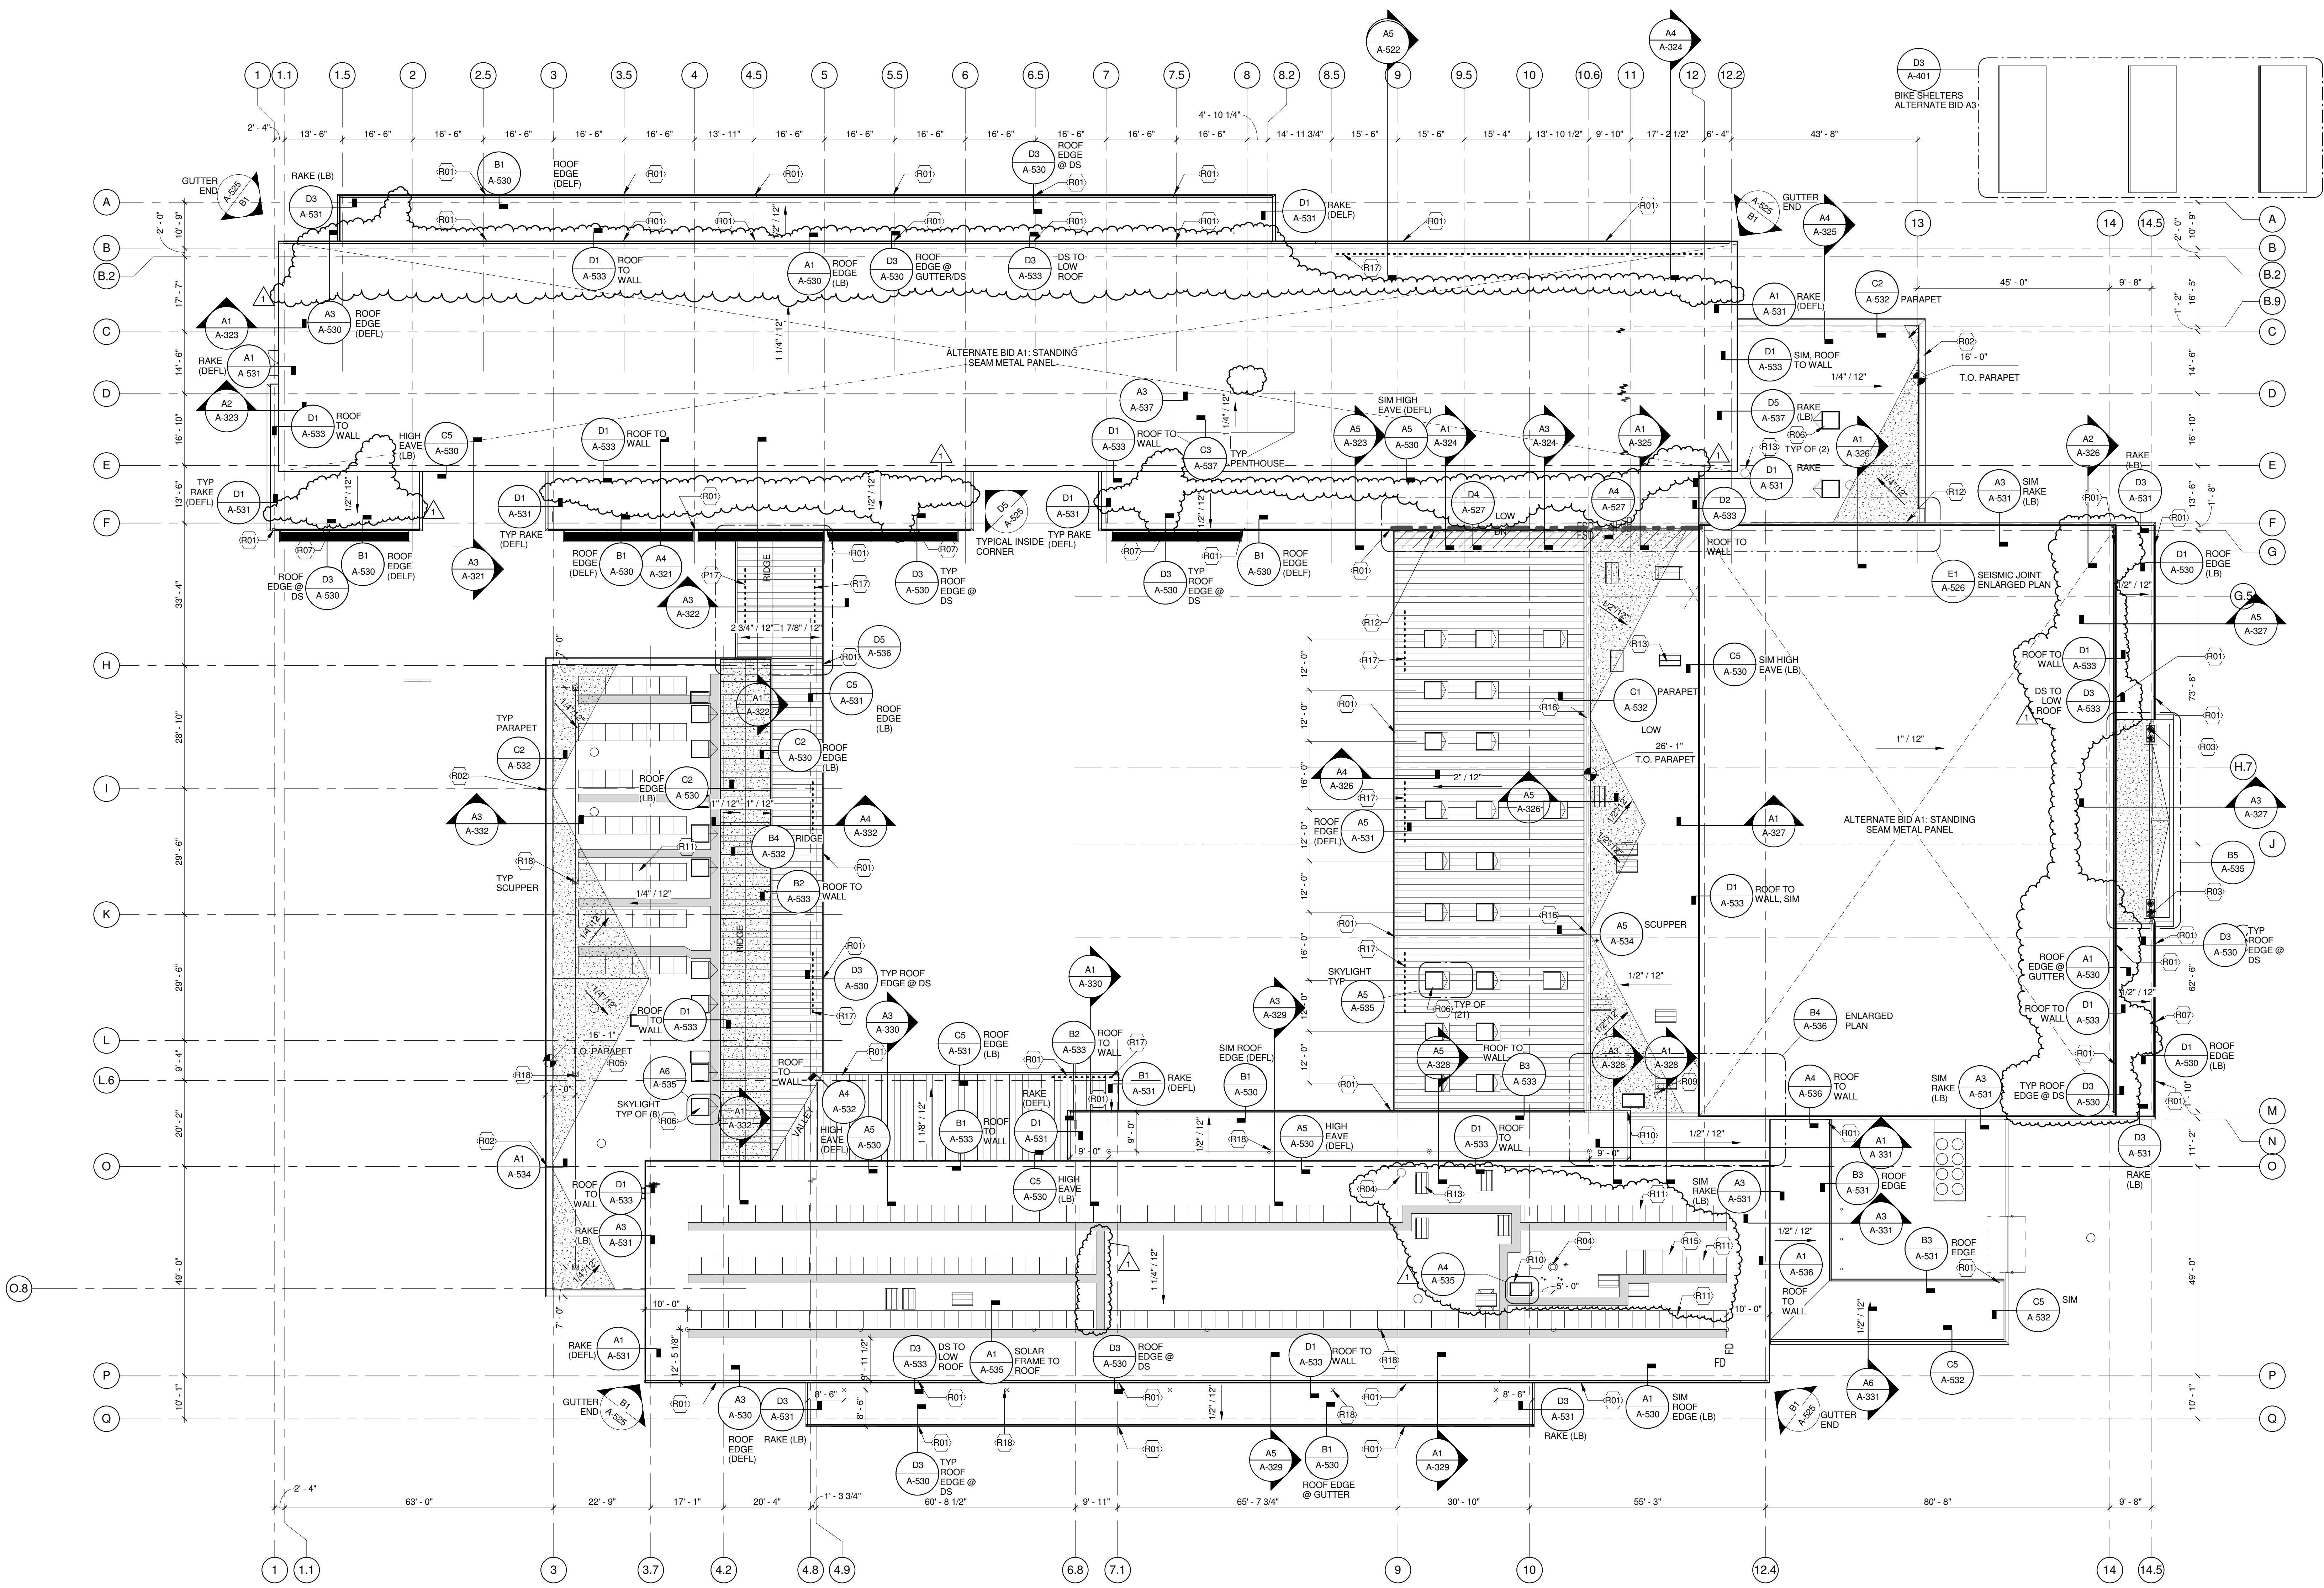


A1 ROOF PLAN
 1/16" = 1'-0"

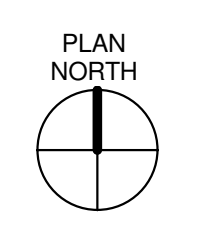


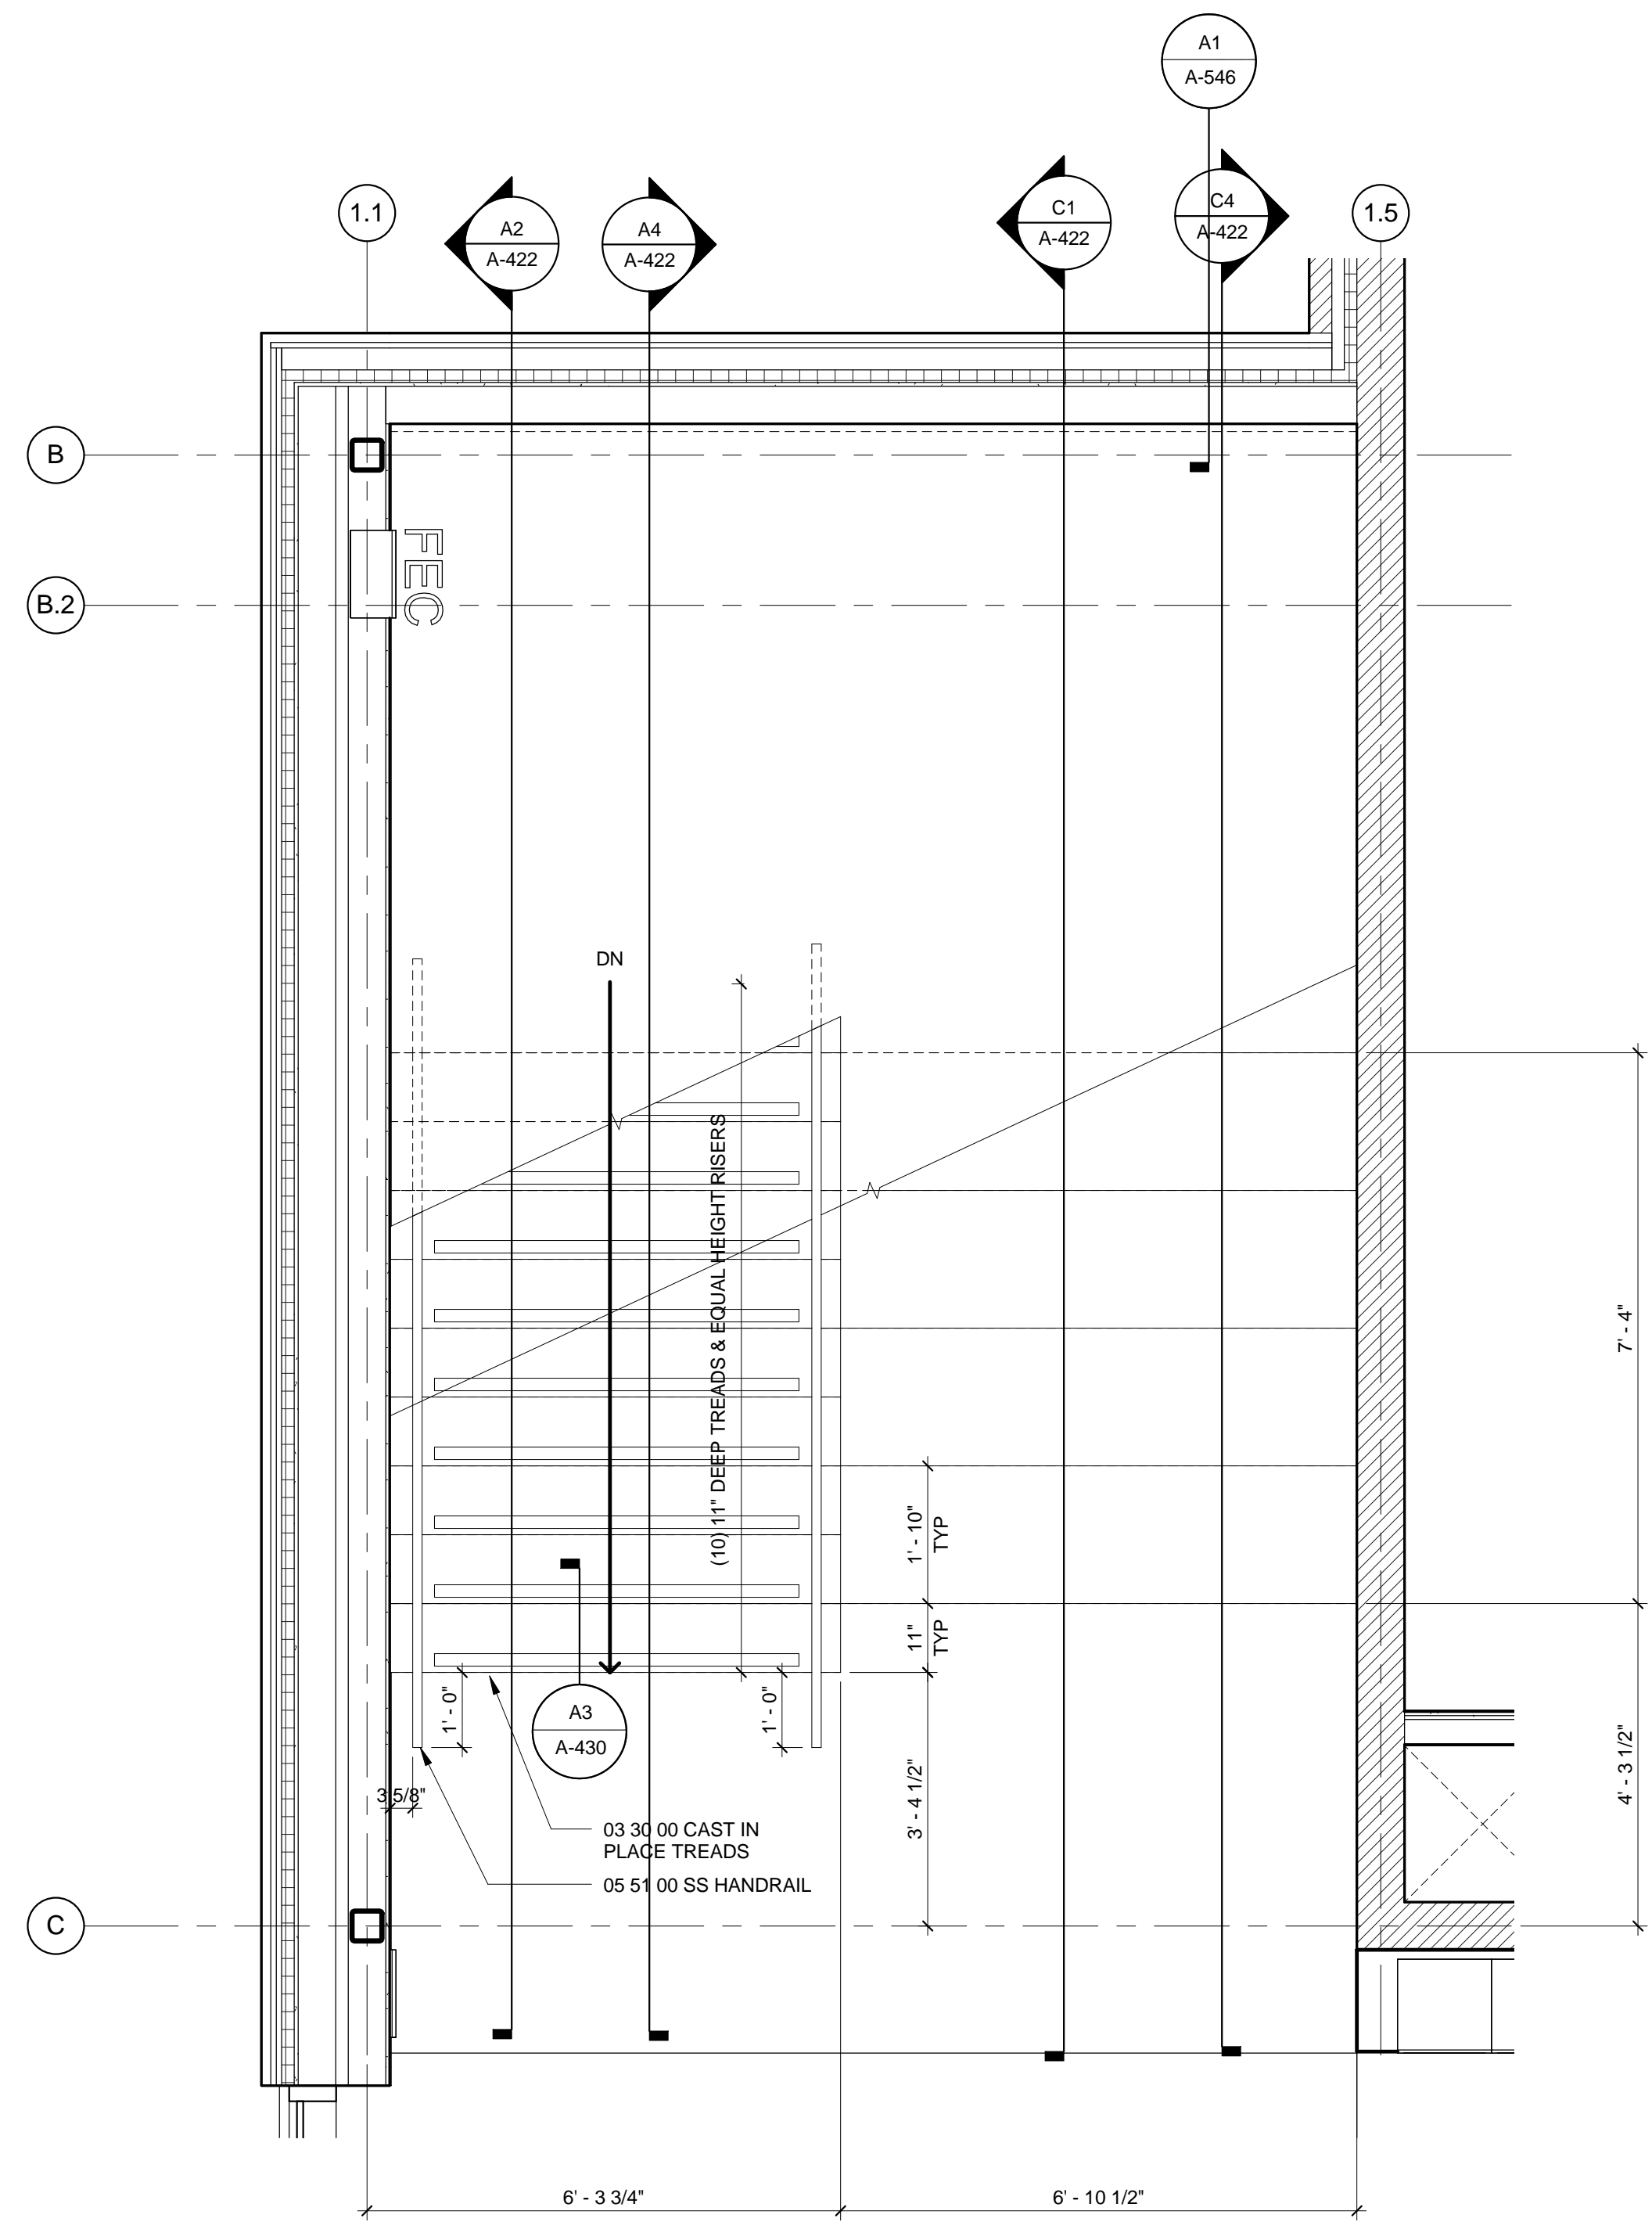

C3 STAIR 1 - FIRST FLOOR PLAN
1/2" = 1'-0"

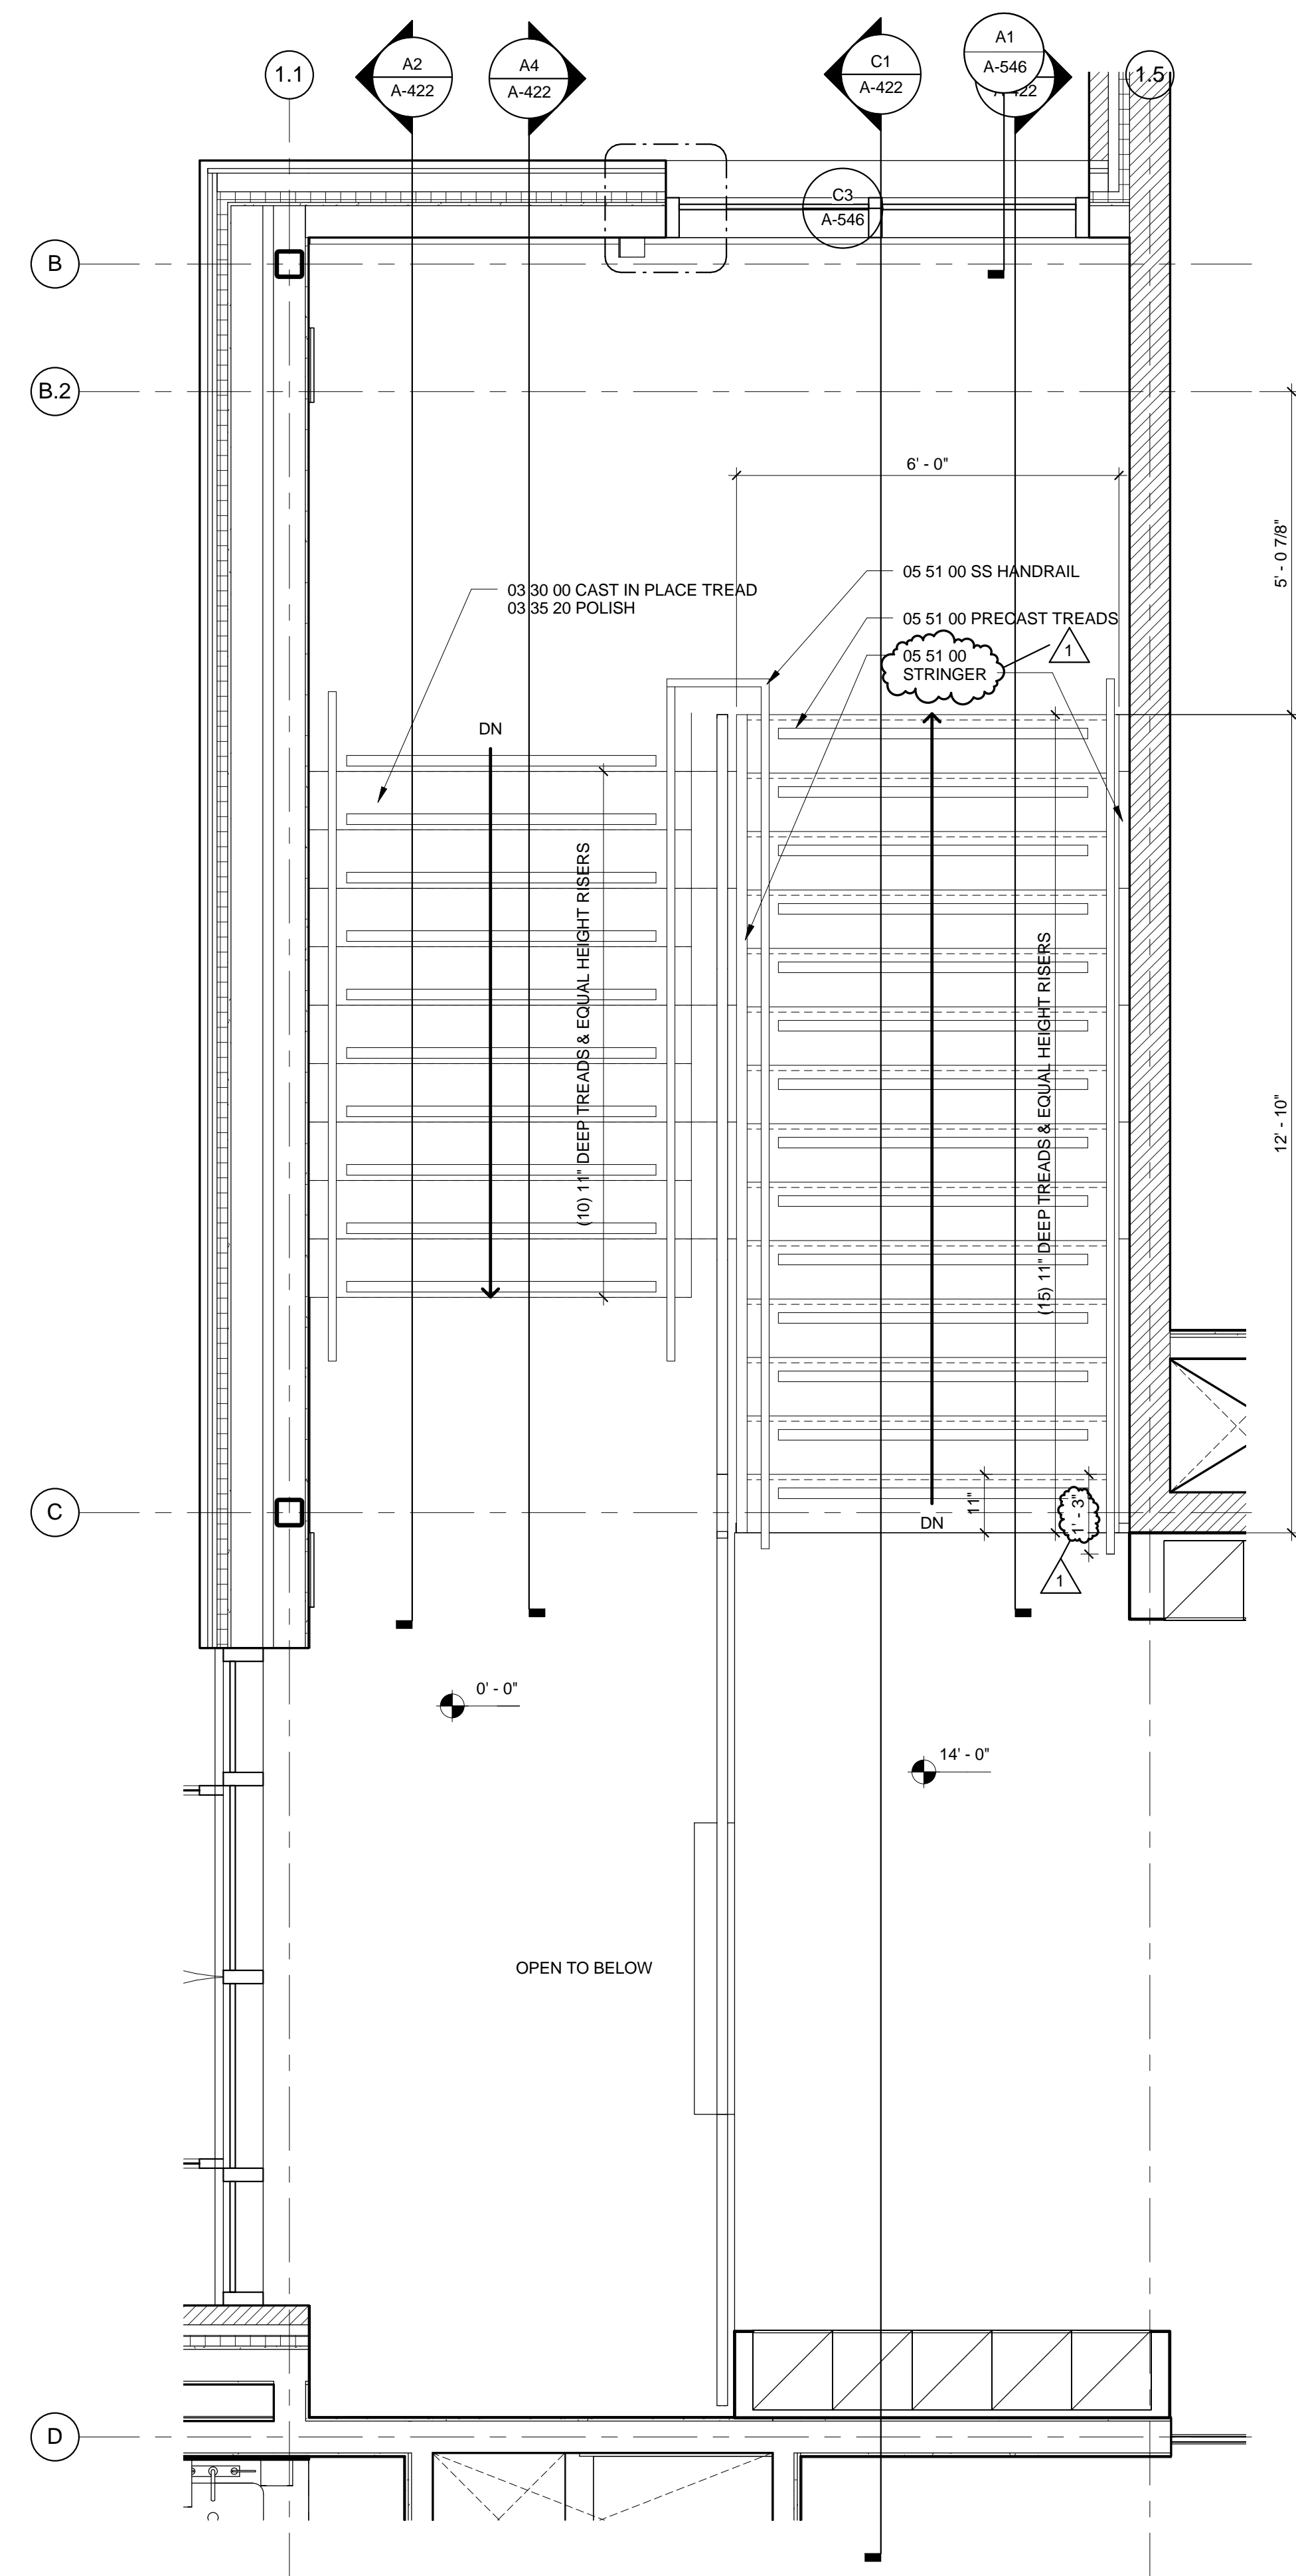


B5 STAIR 1 - SECOND FLOOR PLAN
1/2" = 1'-0"

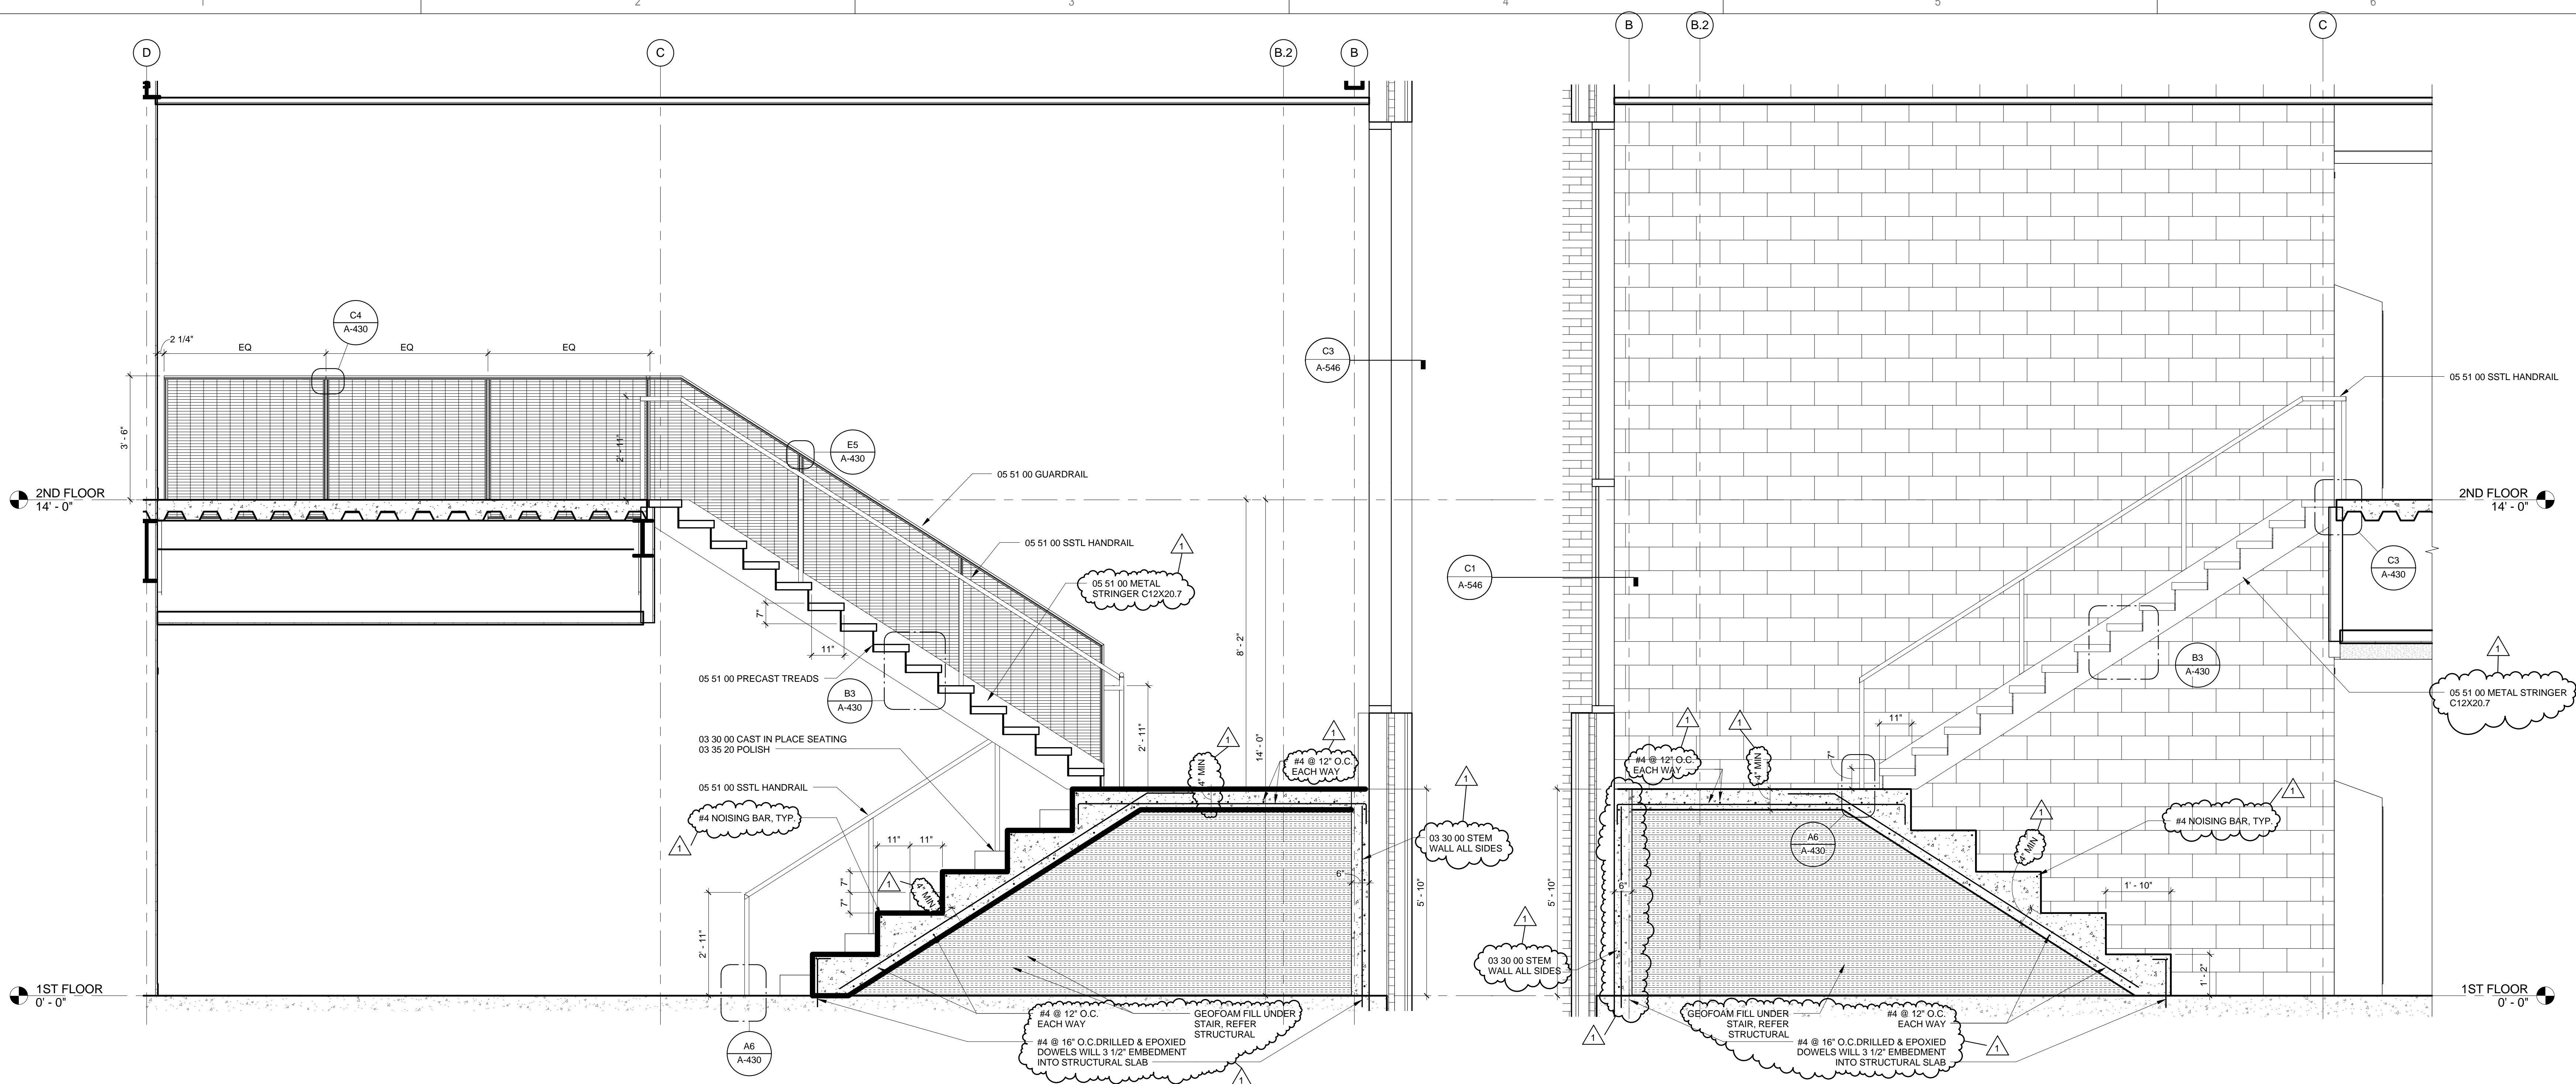

C1 STAIR 1 - SECTION D
1/2" = 1'-0"

C4 ZONE A STAIR SECTION UPPER RUN
1/2" = 1'-0"

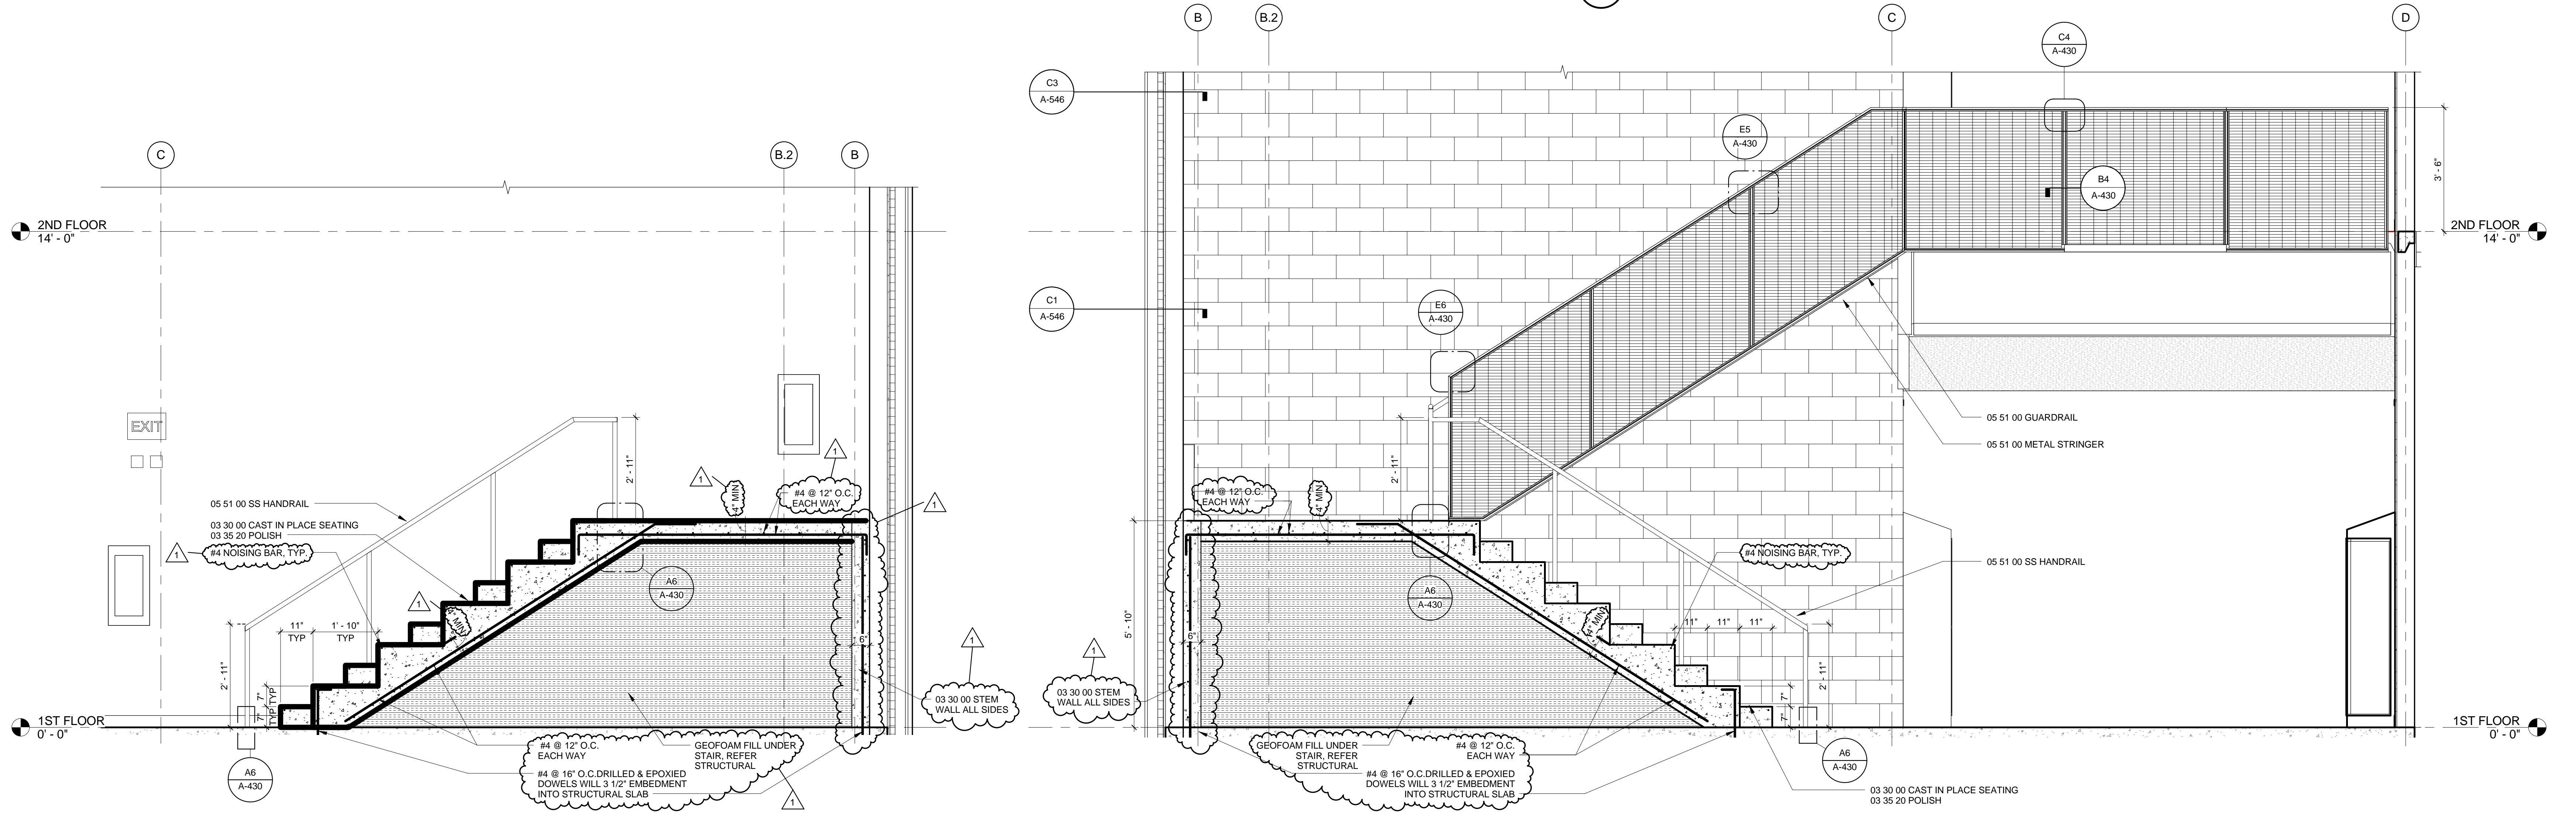


A2 STAIR 1 - SECTION C
1/2" = 1'-0"


A4 ZONE A STAIR SECTION LOWER RUN
1/2" = 1'-0"

MARK	DATE	DESCRIPTION
1	3-13-2015	ADDENDUM 6
ISSUE DATE: FEBRUARY 18, 2015		
ISSUE: CONSTRUCTION DOCUMENTS		
VOLUME: PACKAGE 2 VOLUME 1		
PROJECT NO: 2013912.00		
DRAWN BY: JB		
CHECKED BY: DE		
COPYRIGHT MAHLUM ARCHITECTS, INC 2014 ORIGINAL SHEET SIZE: 30"X42"		


STAIR 1 - SECTIONS

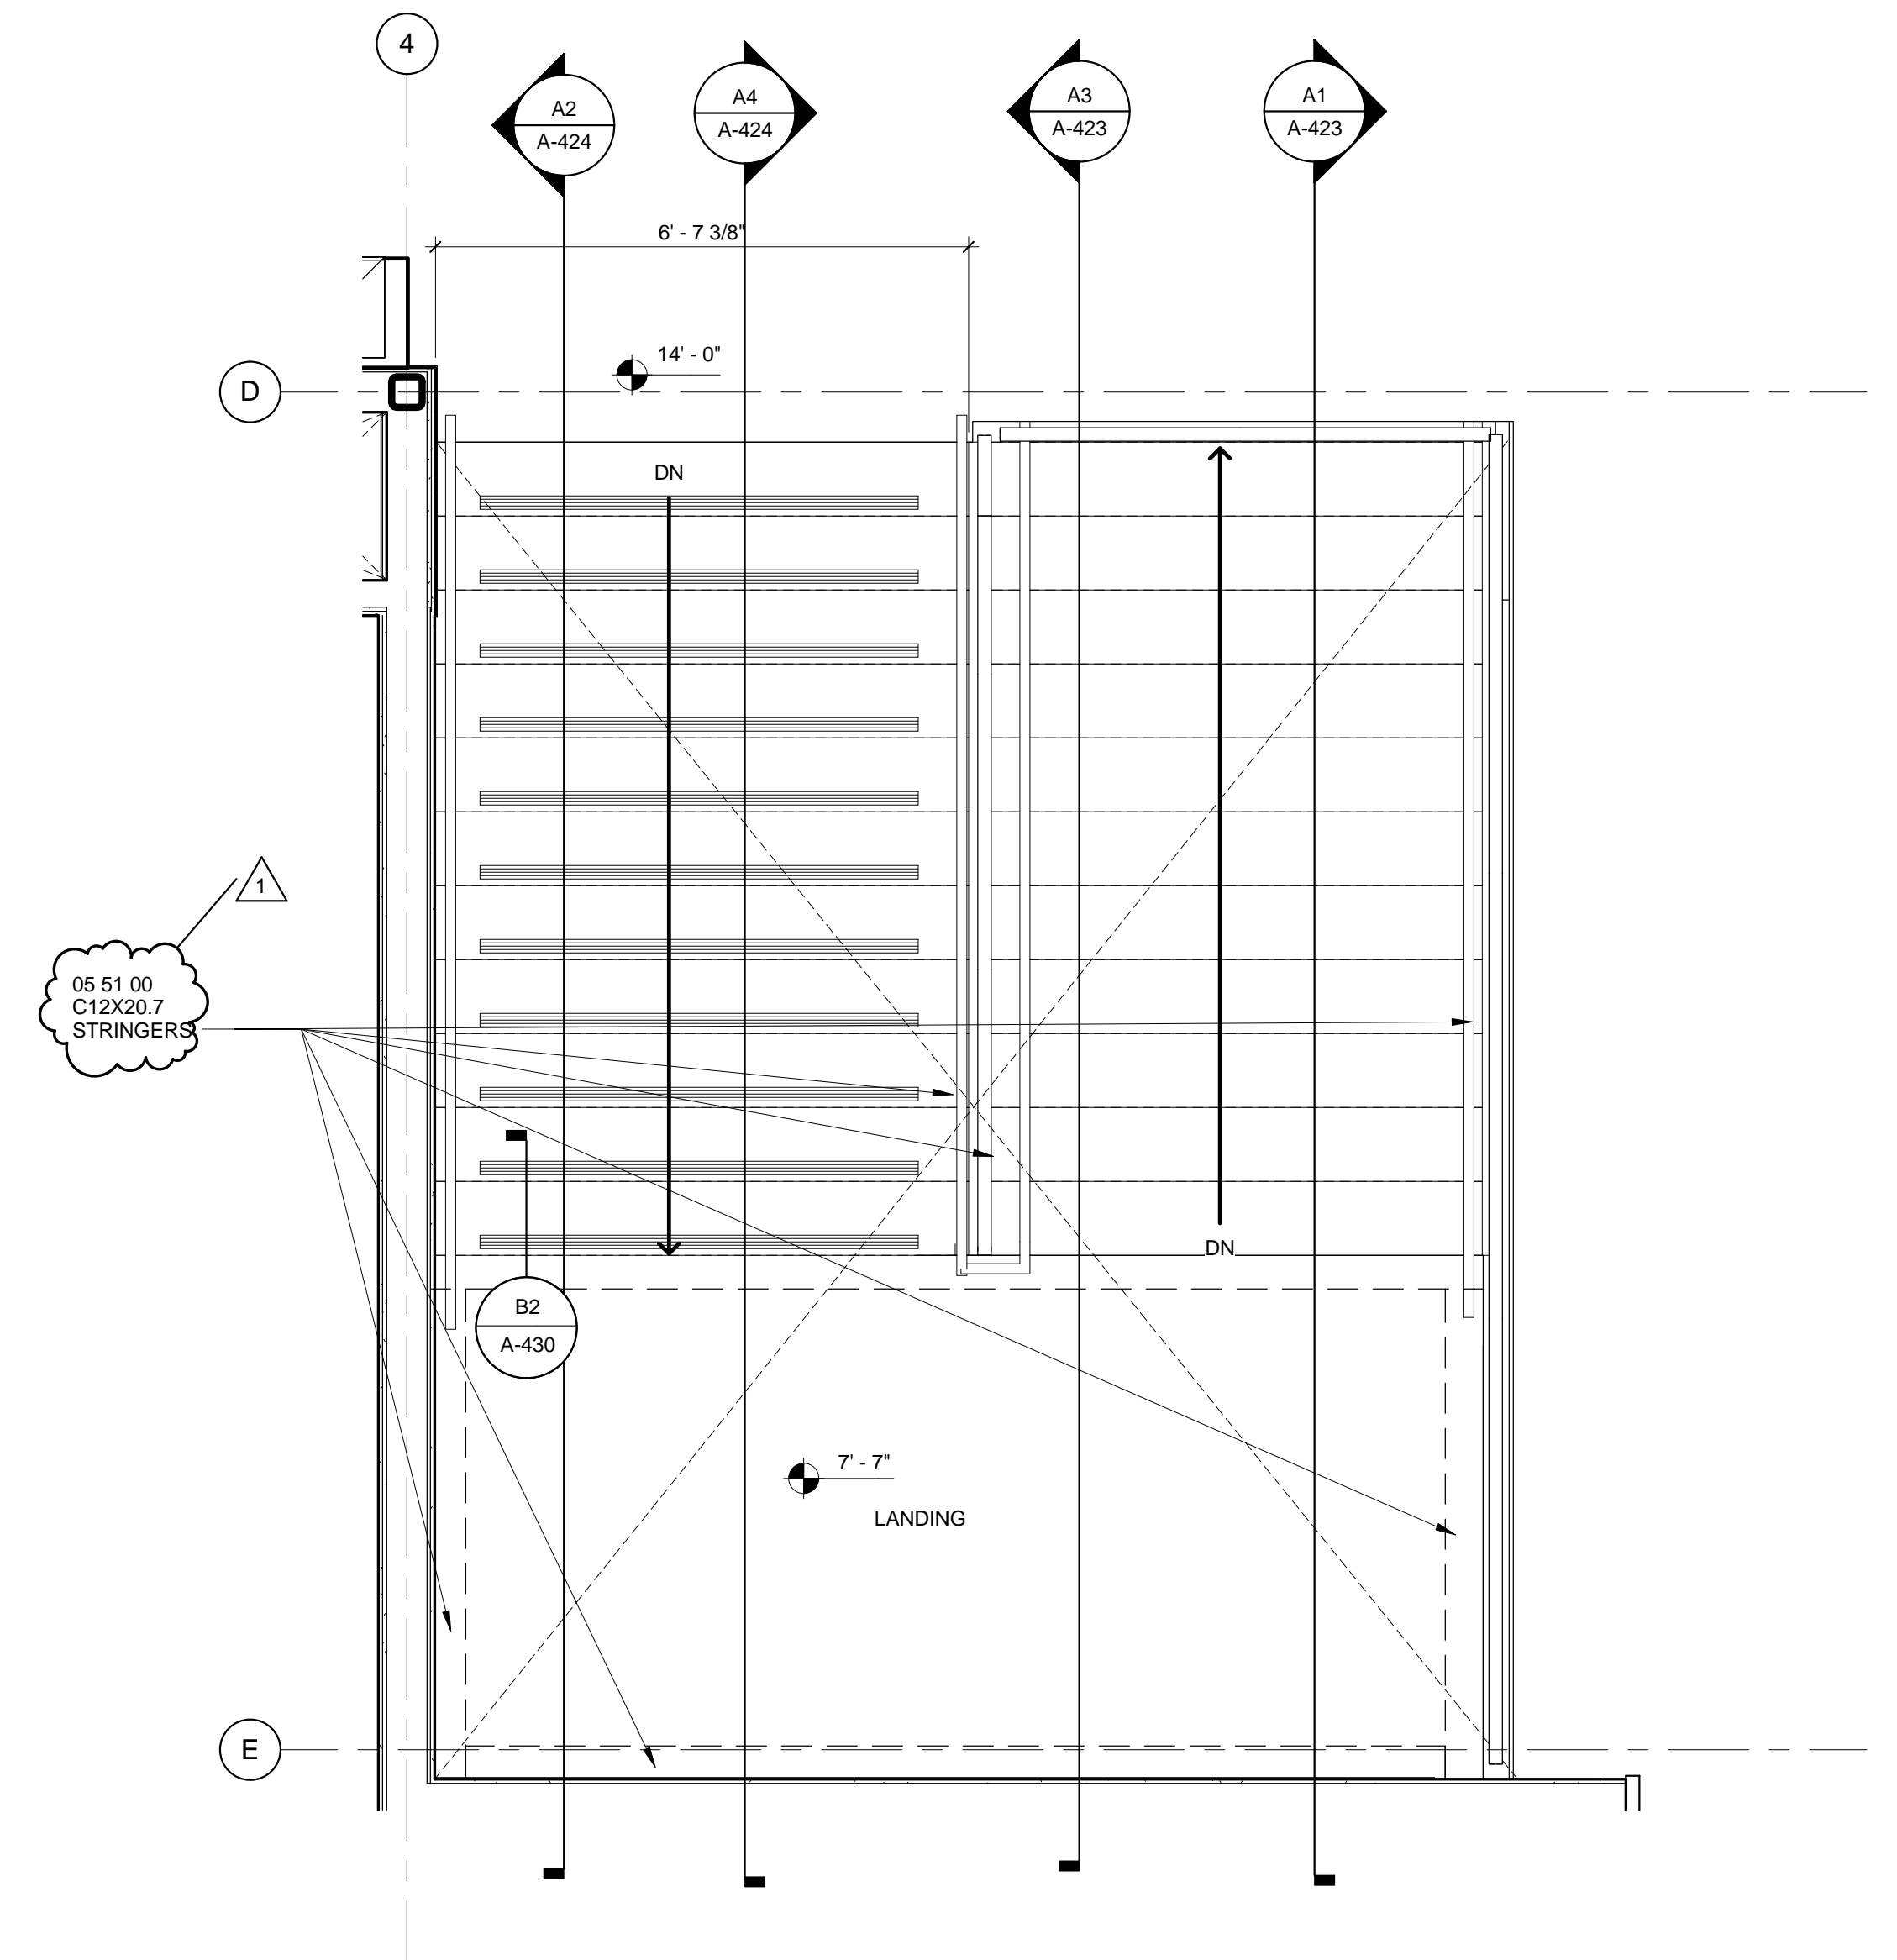

C5 STAIR 2 - SECOND FLOOR PLAN
1/2" = 1'-0"

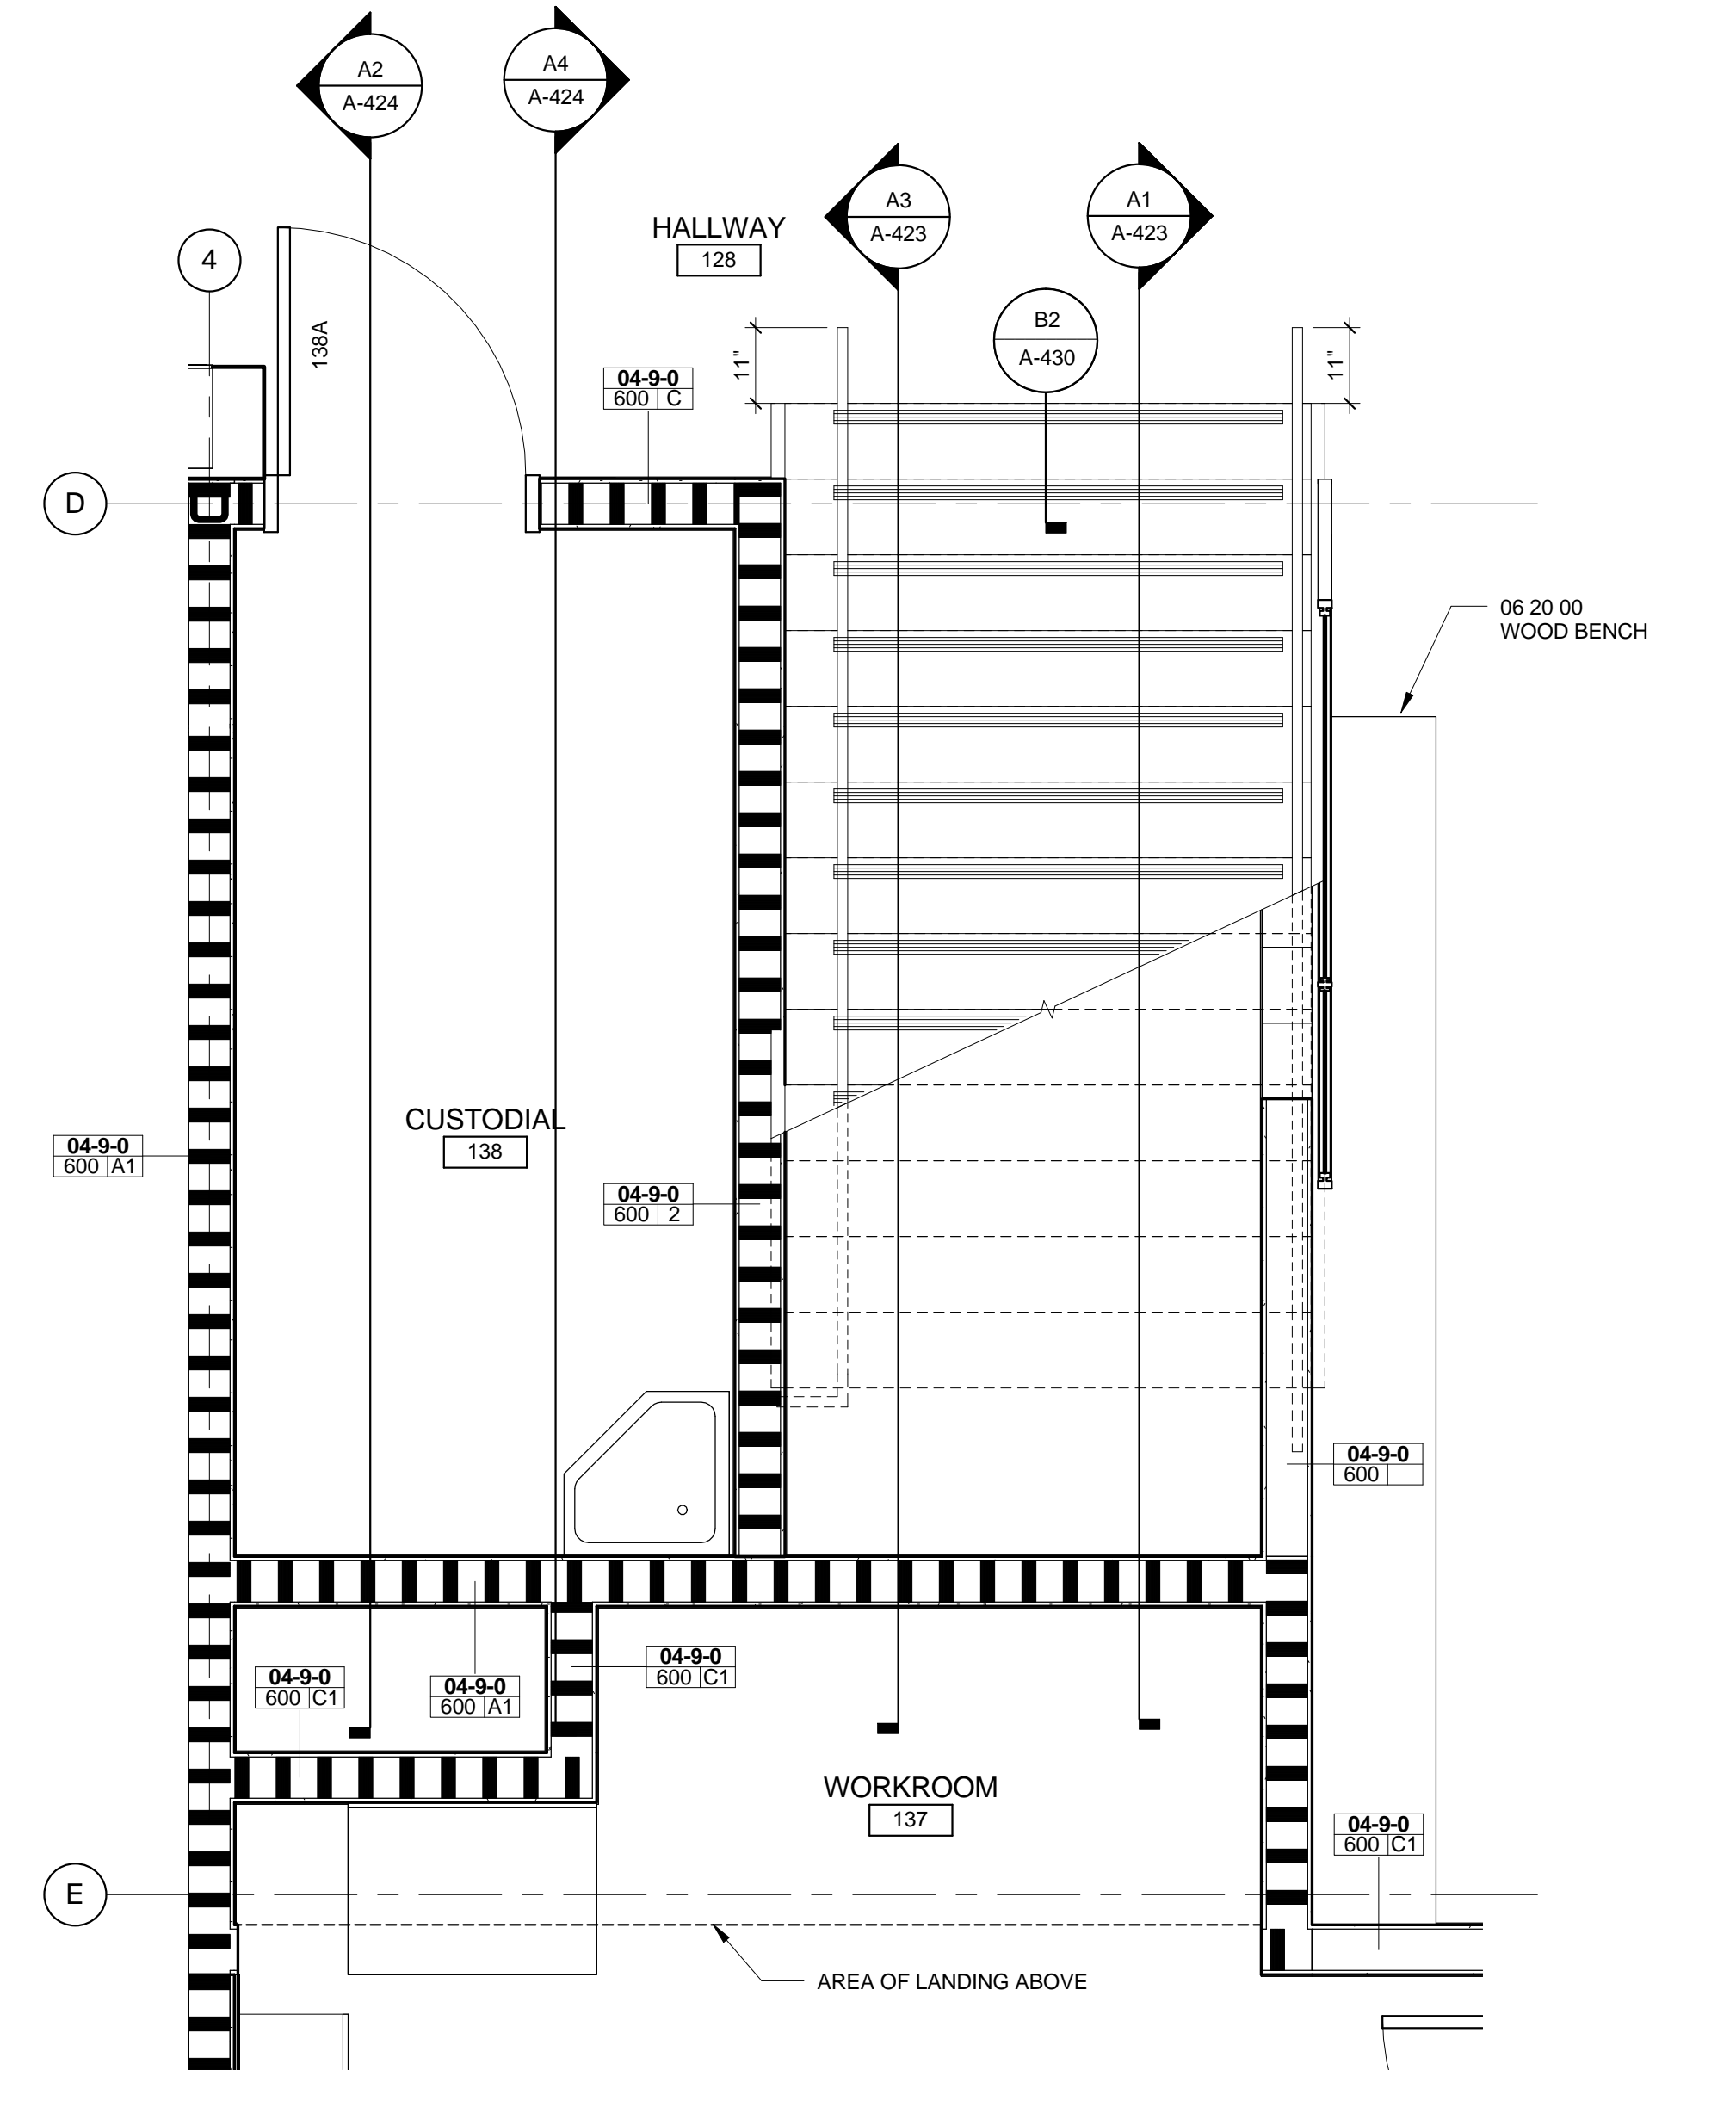


A5 STAIR 2 - FIRST FLOOR PLAN
1/2" = 1'-0"

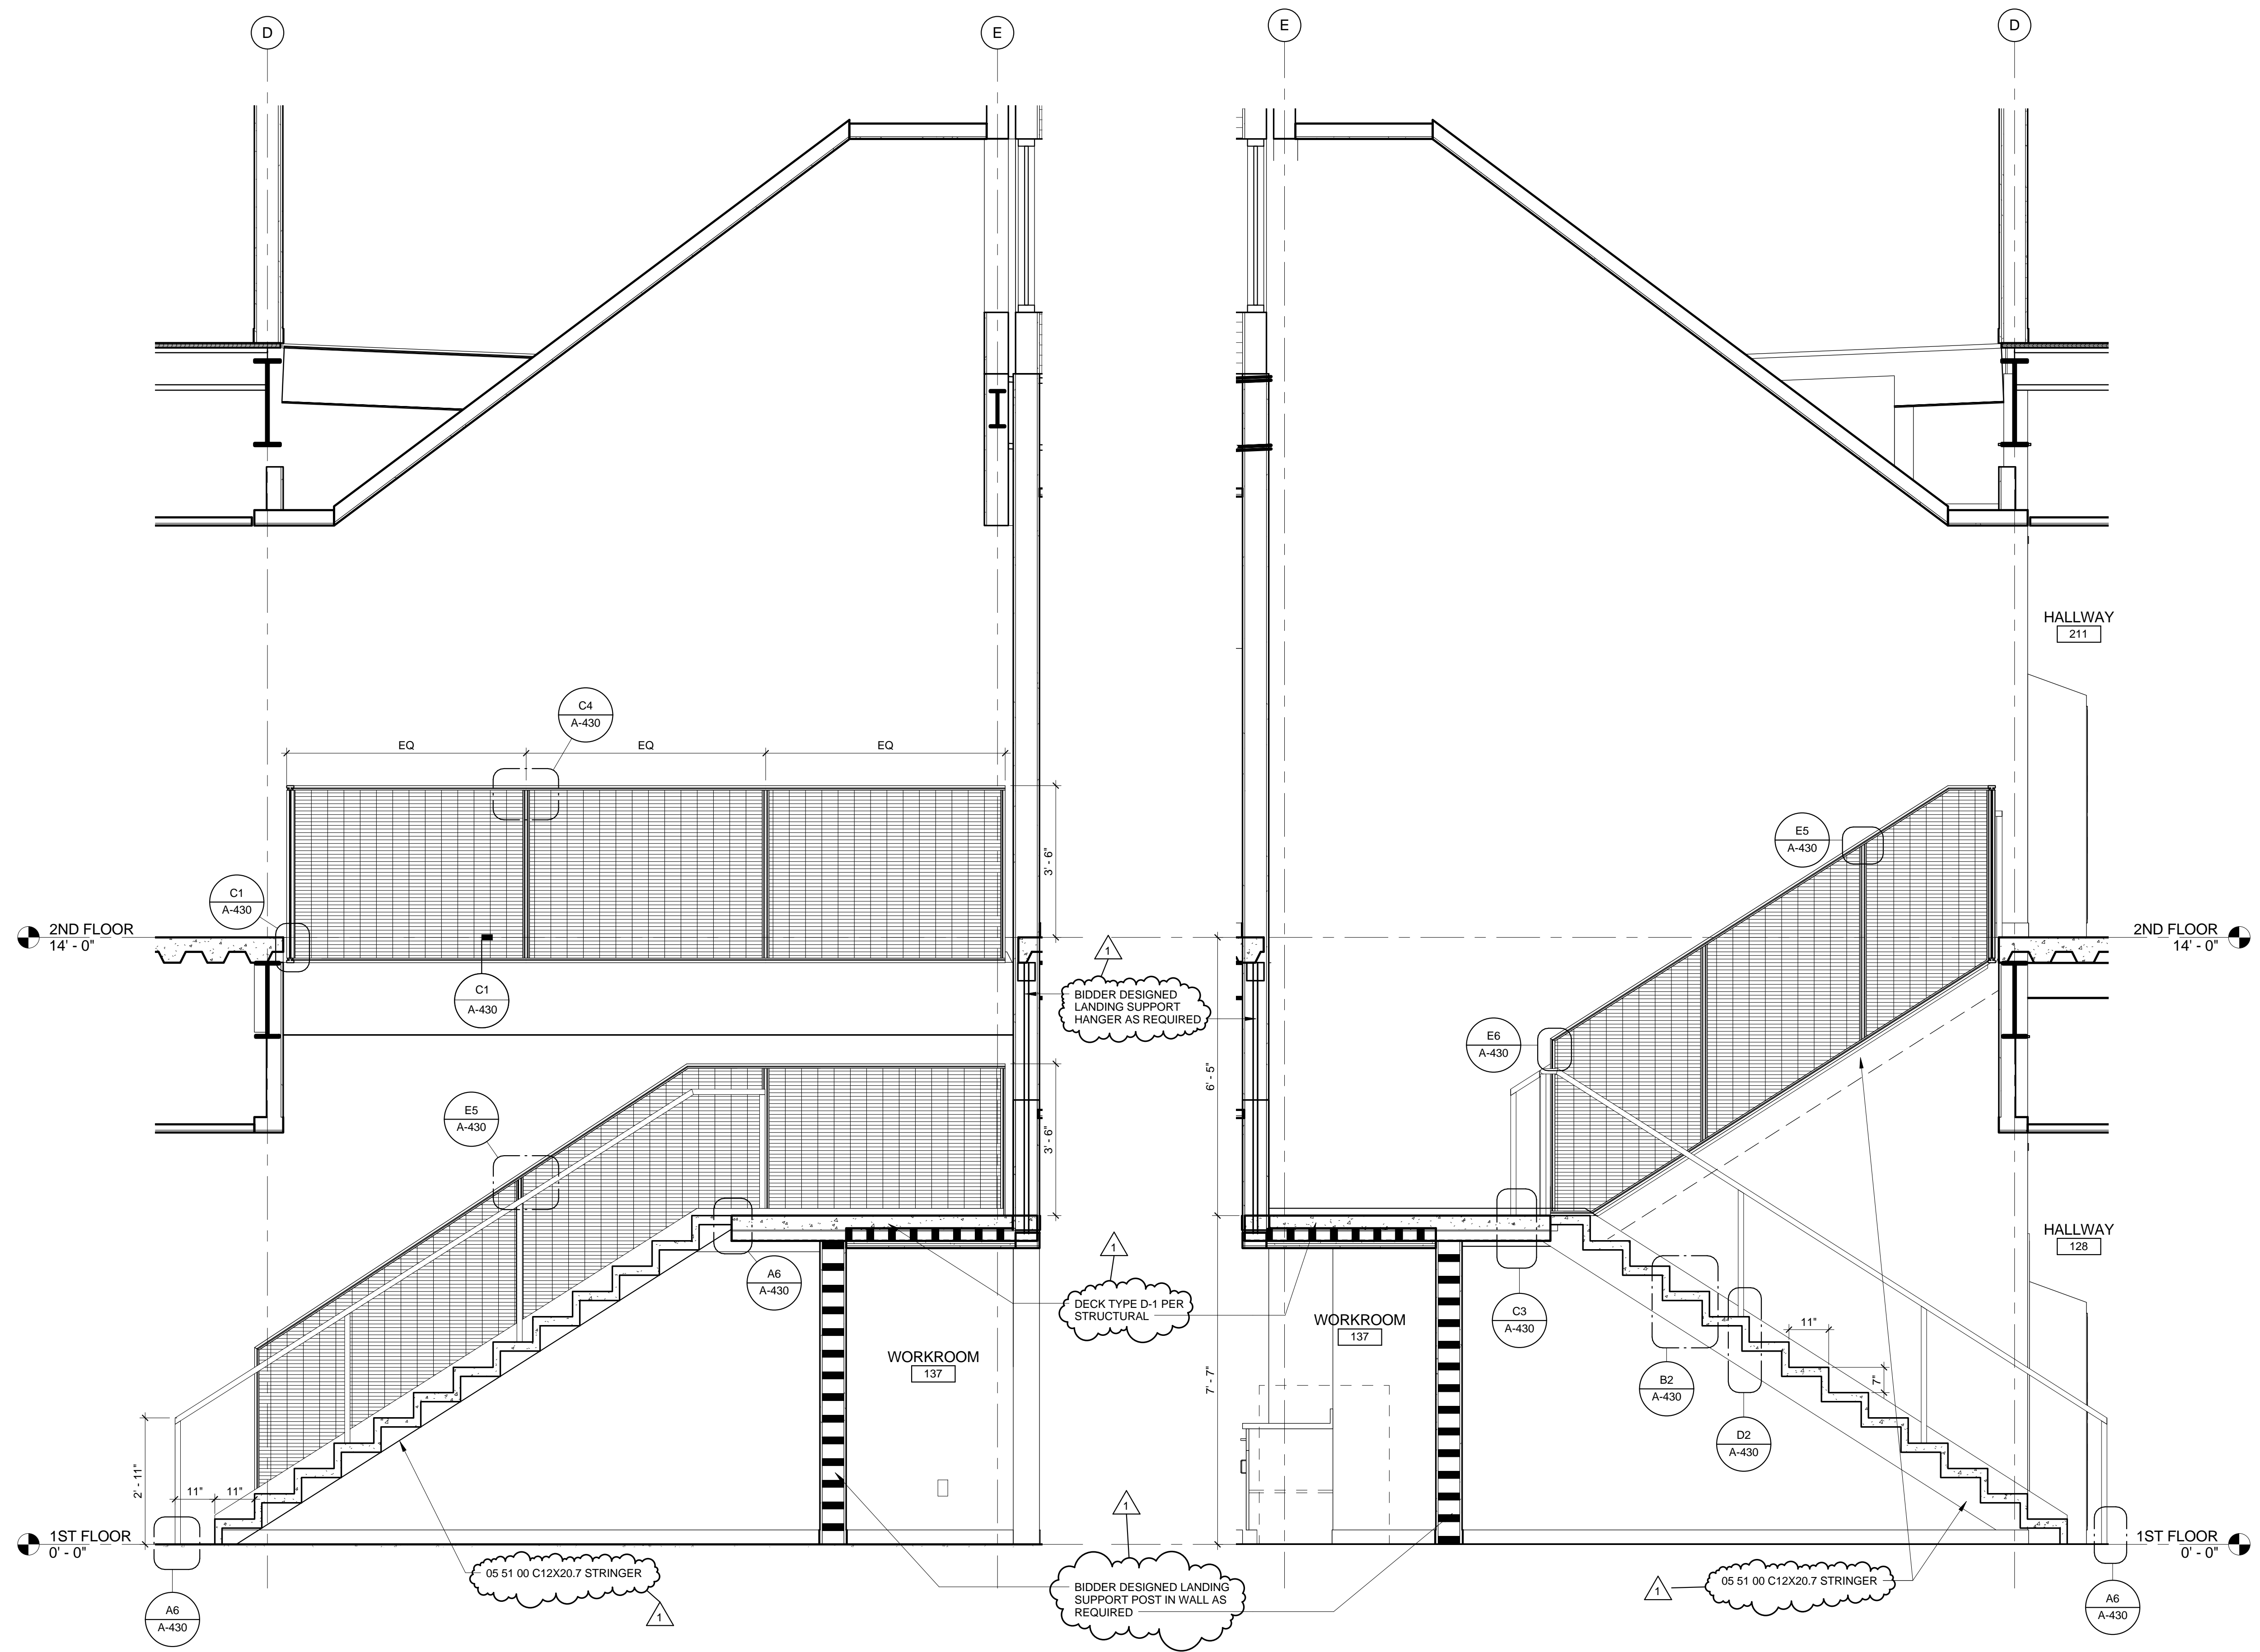

A1 STAIR 2 - SECTION A
1/2" = 1'-0"

A3 STAIR 2 - SECTION D
1/2" = 1'-0"

3/13/2015 11:13:52 AM C:\mahlum\p0213912\305\A5\A1.dwg_jpl/psd/plot

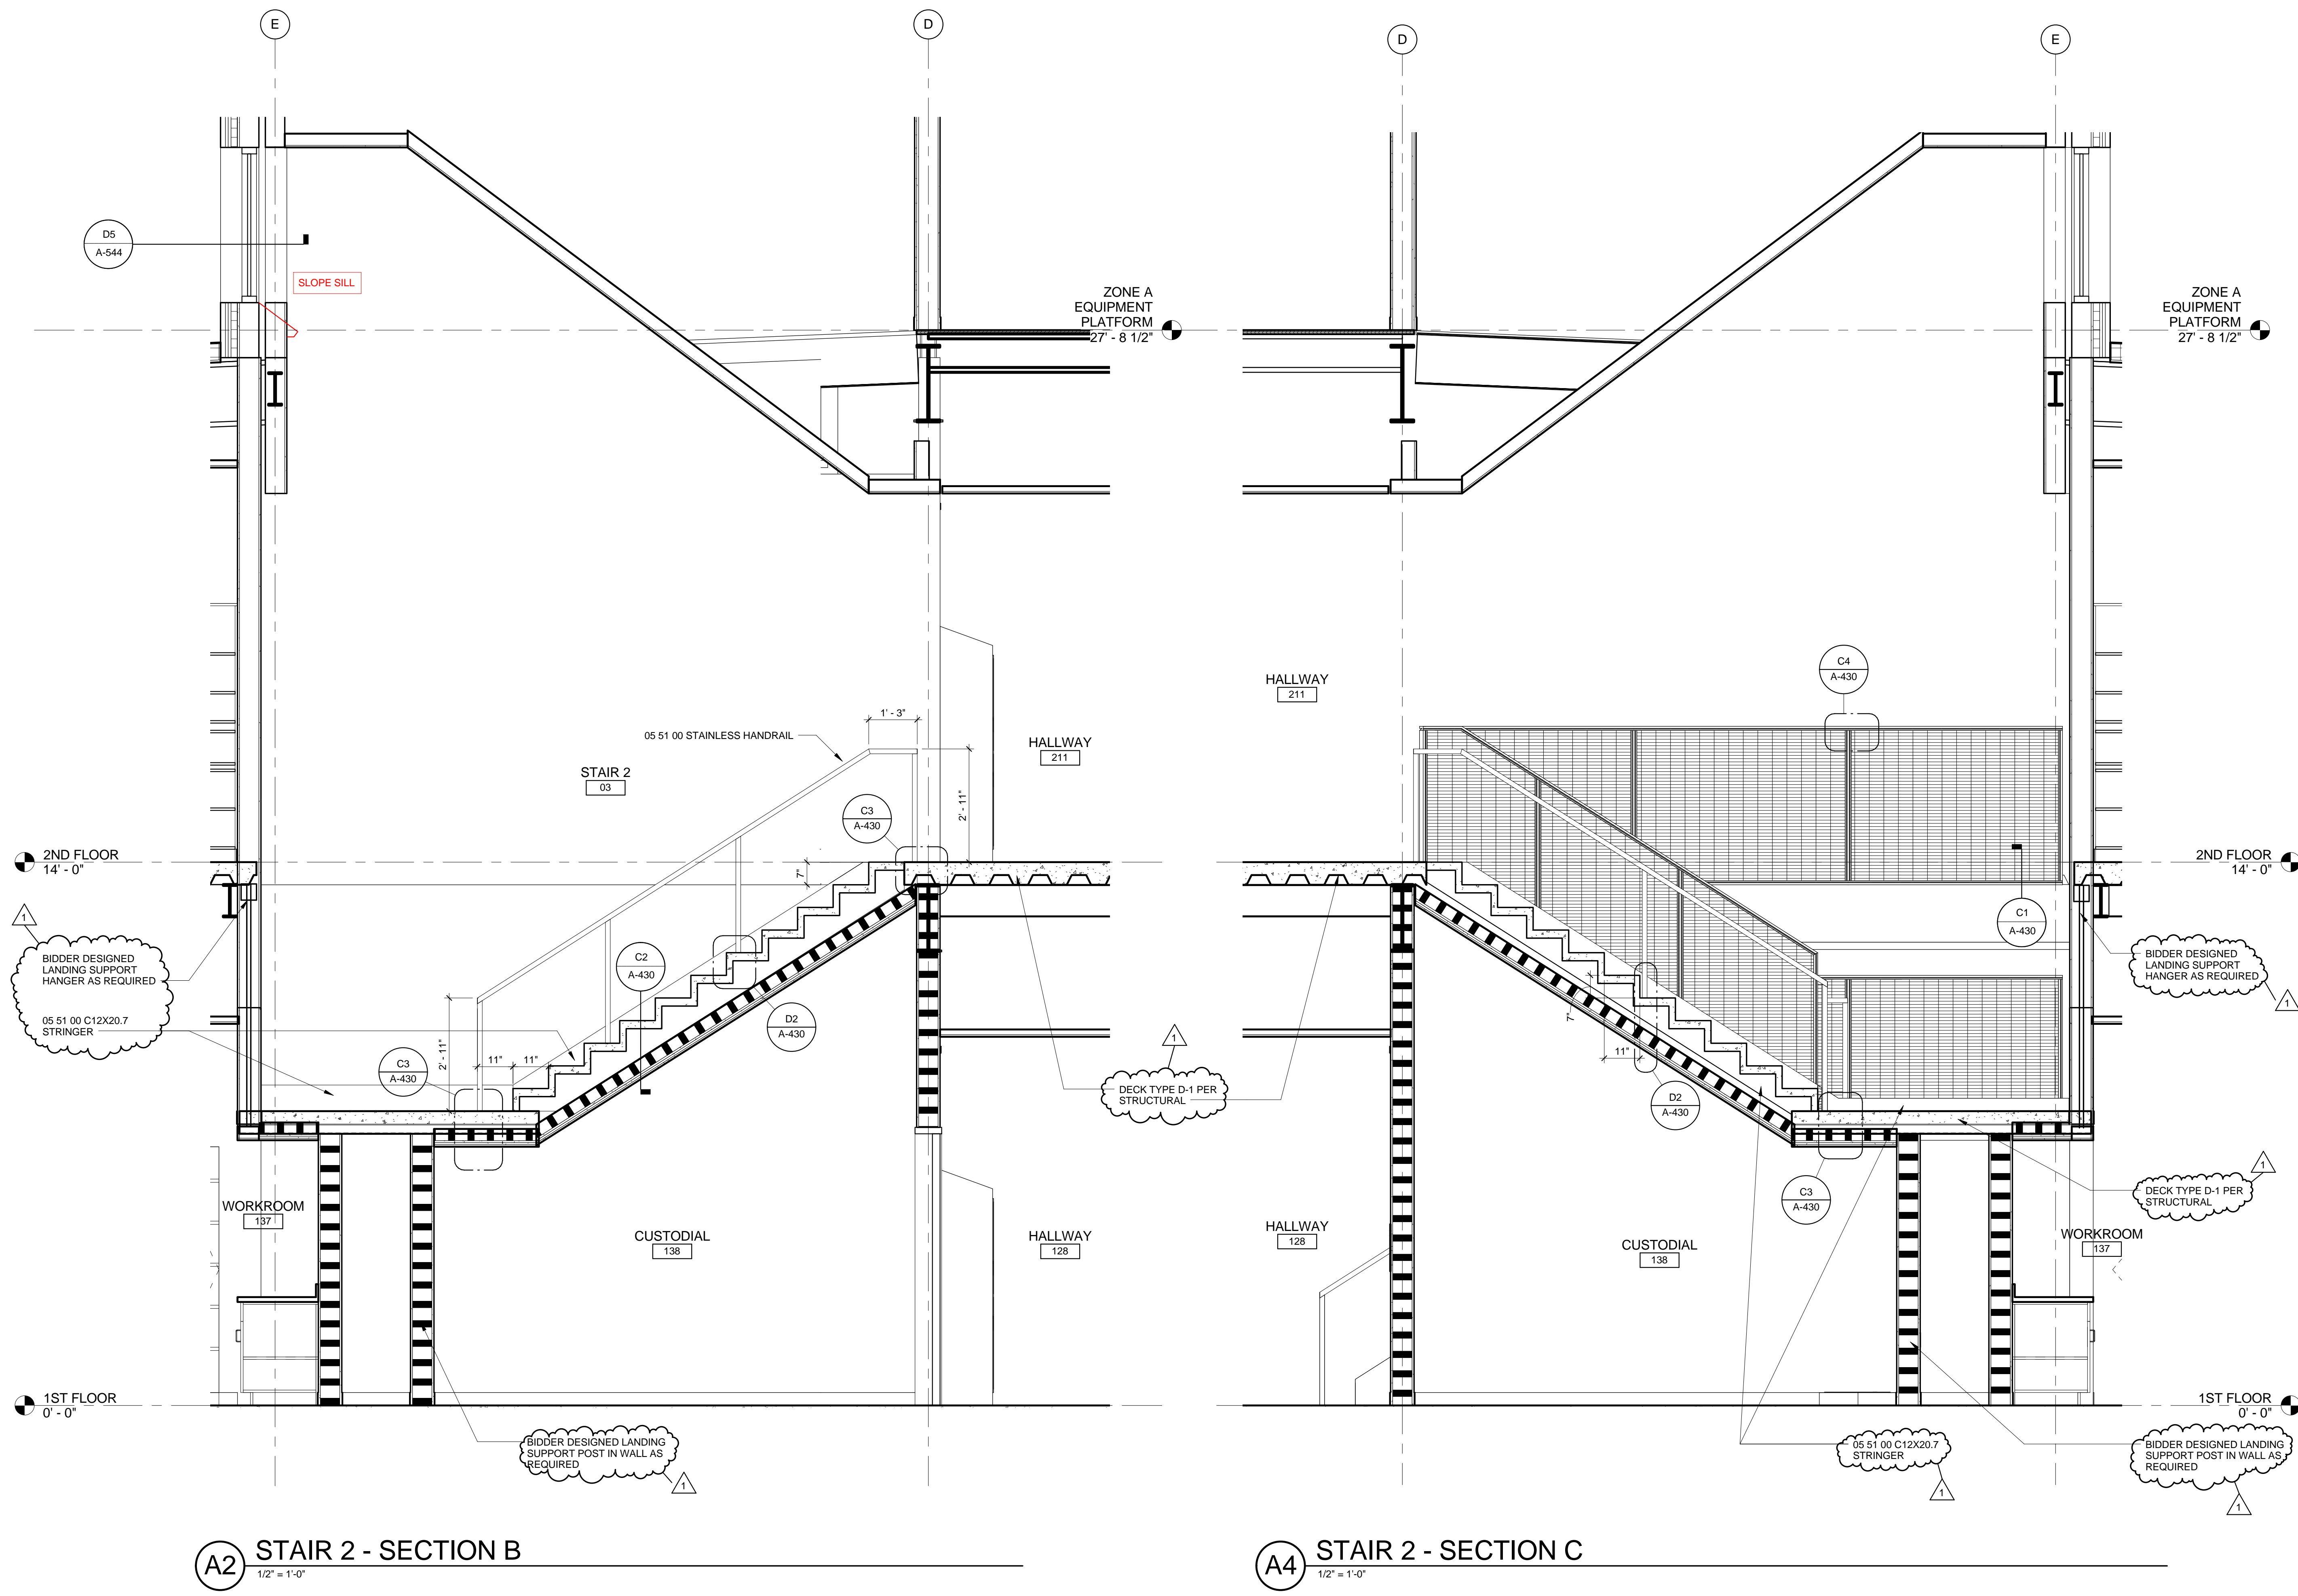

A2 STAIR 2 - SECTION B
1/2" = 1'-0"

A4 STAIR 2 - SECTION C
1/2" = 1'-0"


MARK	DATE	DESCRIPTION
1	3-13-2015	ADDENDUM 6

ISSUE DATE:	FEBRUARY 18, 2015
ISSUE:	CONSTRUCTION DOCUMENTS
VOLUME:	PACKAGE 2 VOLUME 1
PROJECT NO.:	2013912.00
DRAWN BY:	JB
CHECKED BY:	DE
<small>COPYRIGHT MAHLUM ARCHITECTS, INC. 2014 ORIGINAL SHEET SIZE: 30"X42"</small>	


STAIR 2 - SECTIONS

MARK	DATE	DESCRIPTION
1	3-13-2015	ADDENDUM 6
ISSUE DATE: FEBRUARY 18, 2015		
ISSUE: CONSTRUCTION DOCUMENTS		
VOLUME: PACKAGE 2 VOLUME 1		
PROJECT NO: 2013912.00		
DRAWN BY: JB		
CHECKED BY: DE		
COPYRIGHT MAHLUM ARCHITECTS, INC 2014 ORIGINAL SHEET SIZE: 30"X42"		


STAIR DETAILS

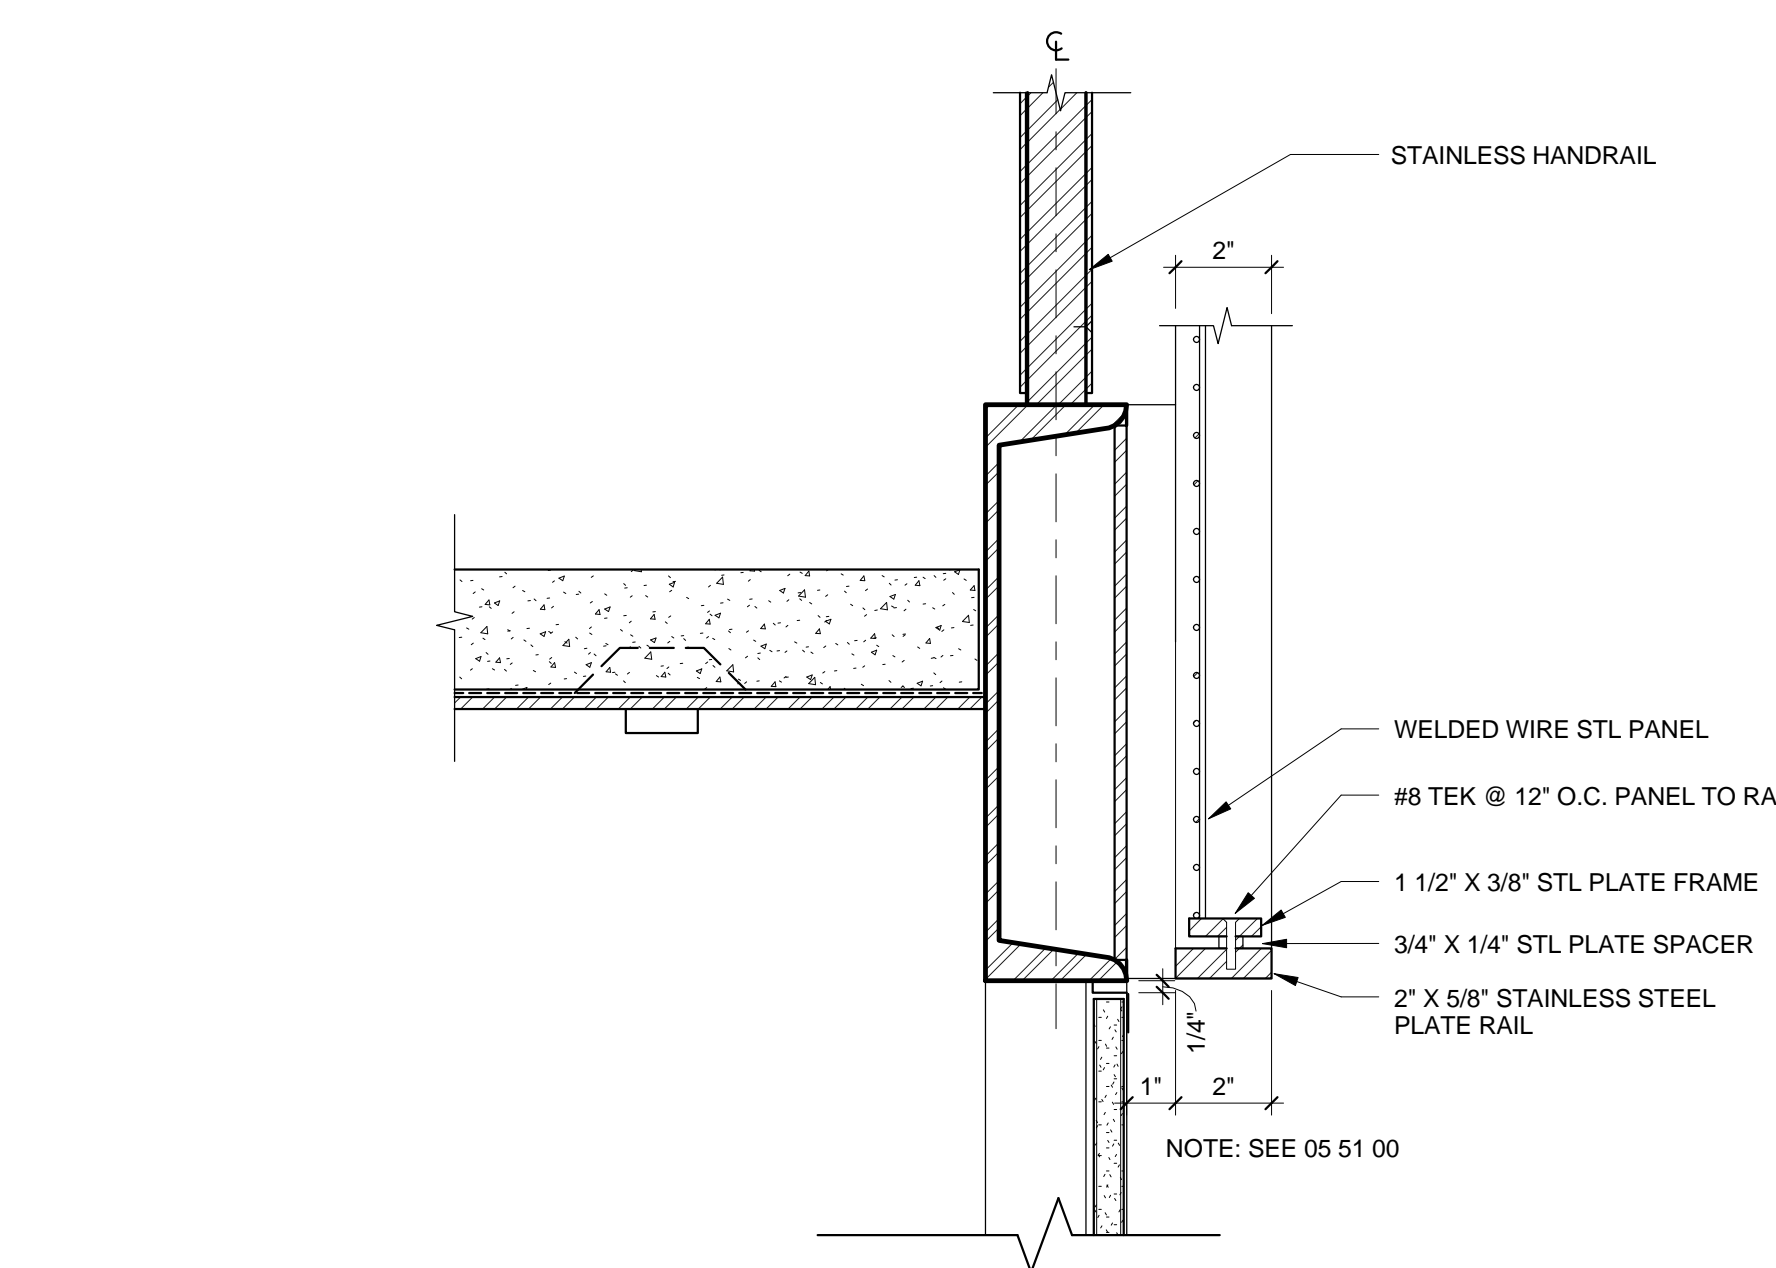


D1 STAIR 2 @ STRINGER @ WALL
3\"/>

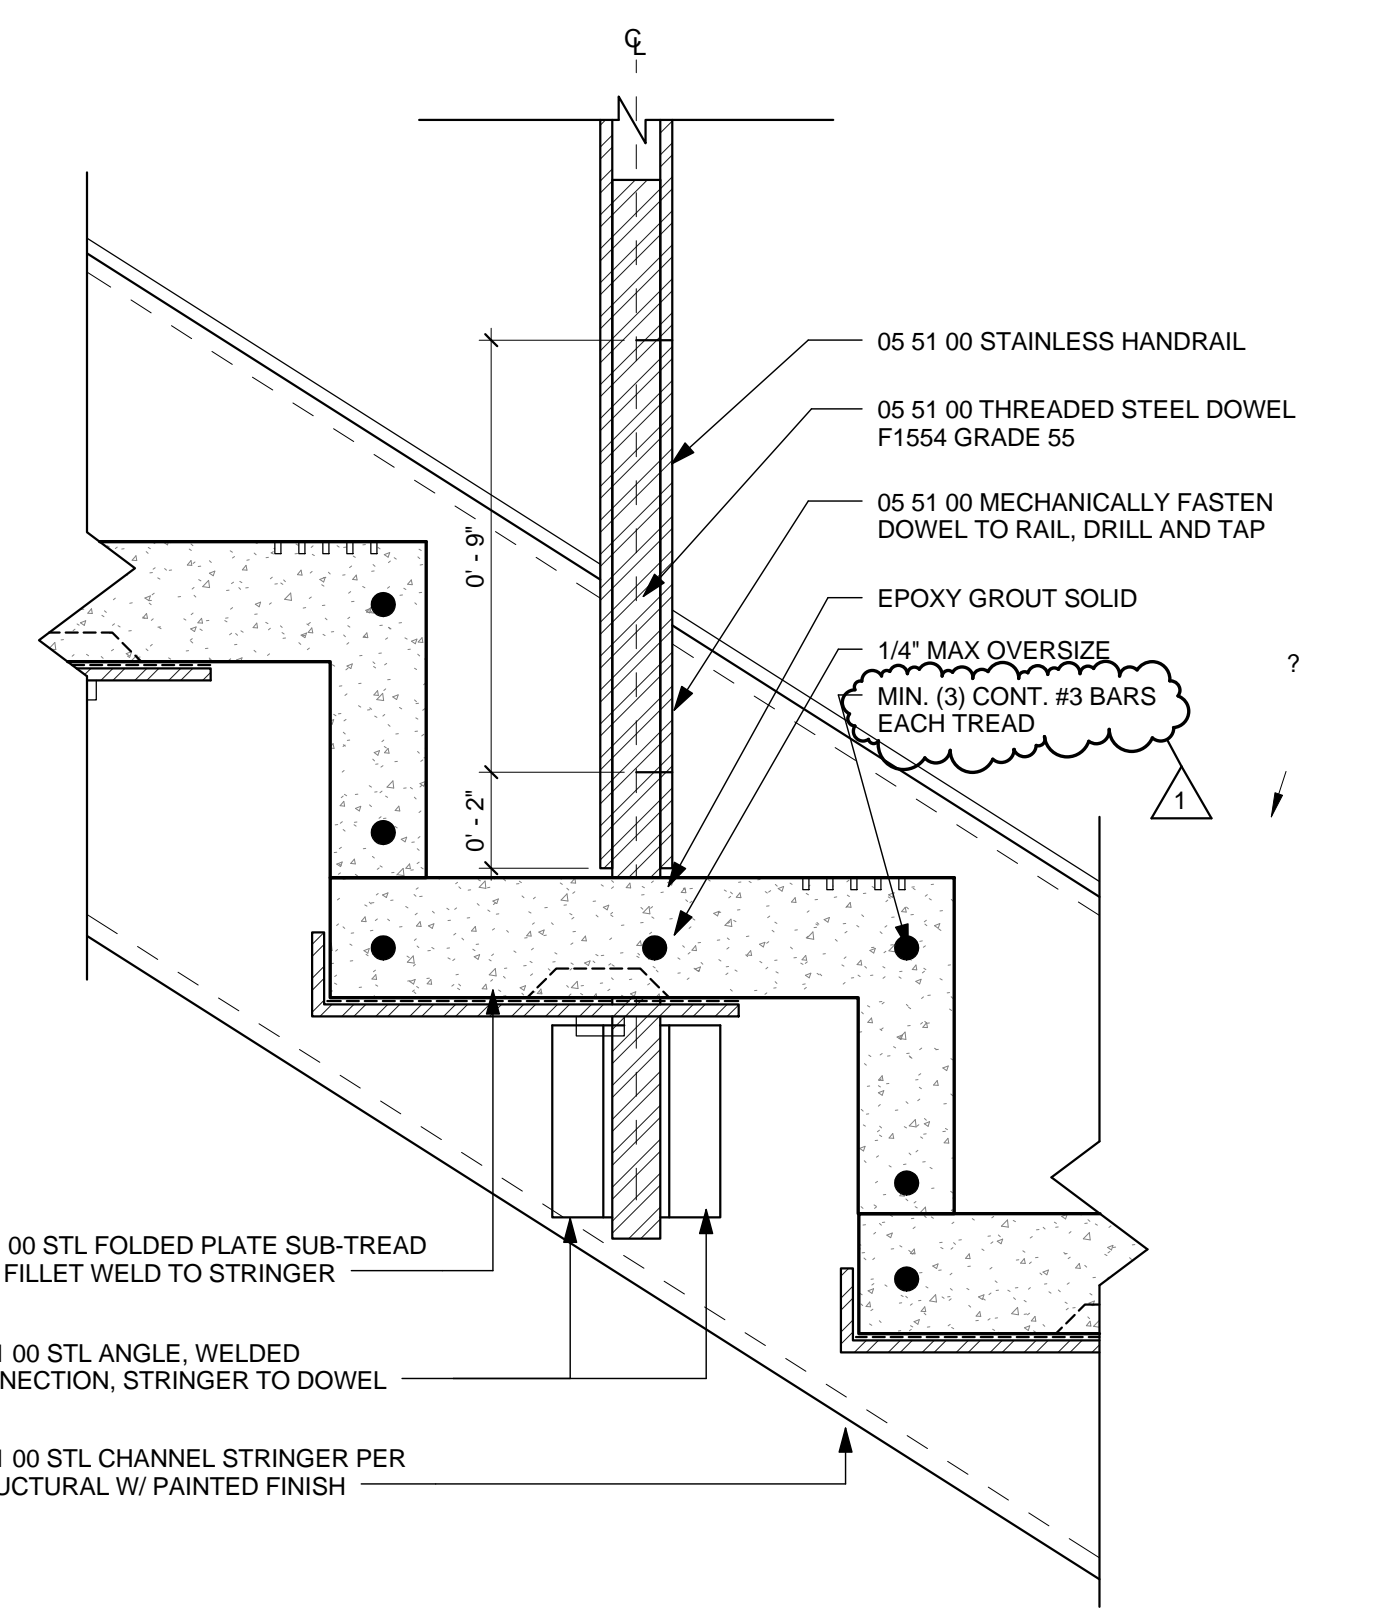


E4 GUARDRAIL TOP
3\"/>

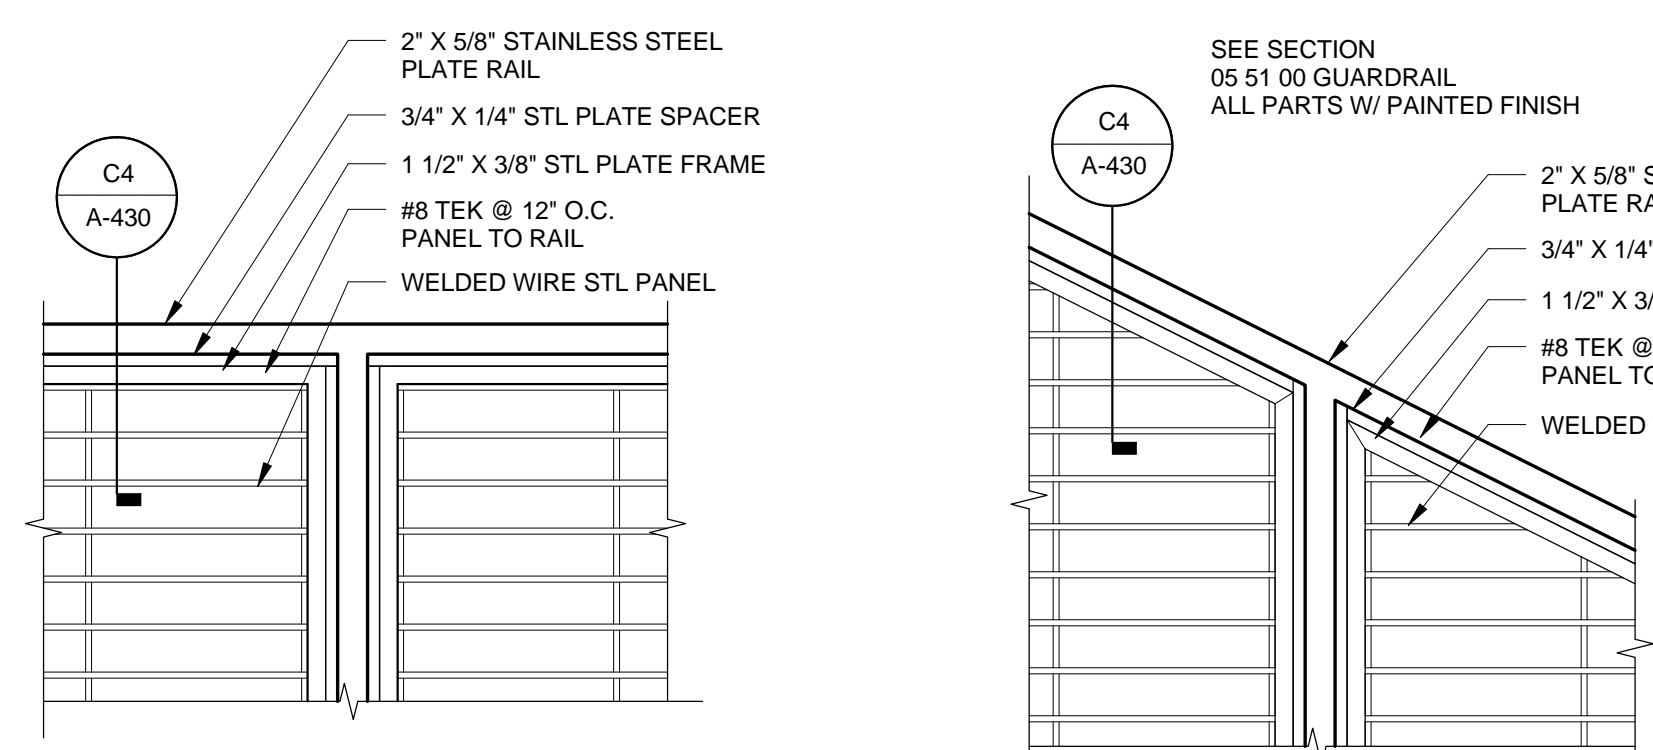


E5 GUARDRAIL @ STAIR 2
3\"/>

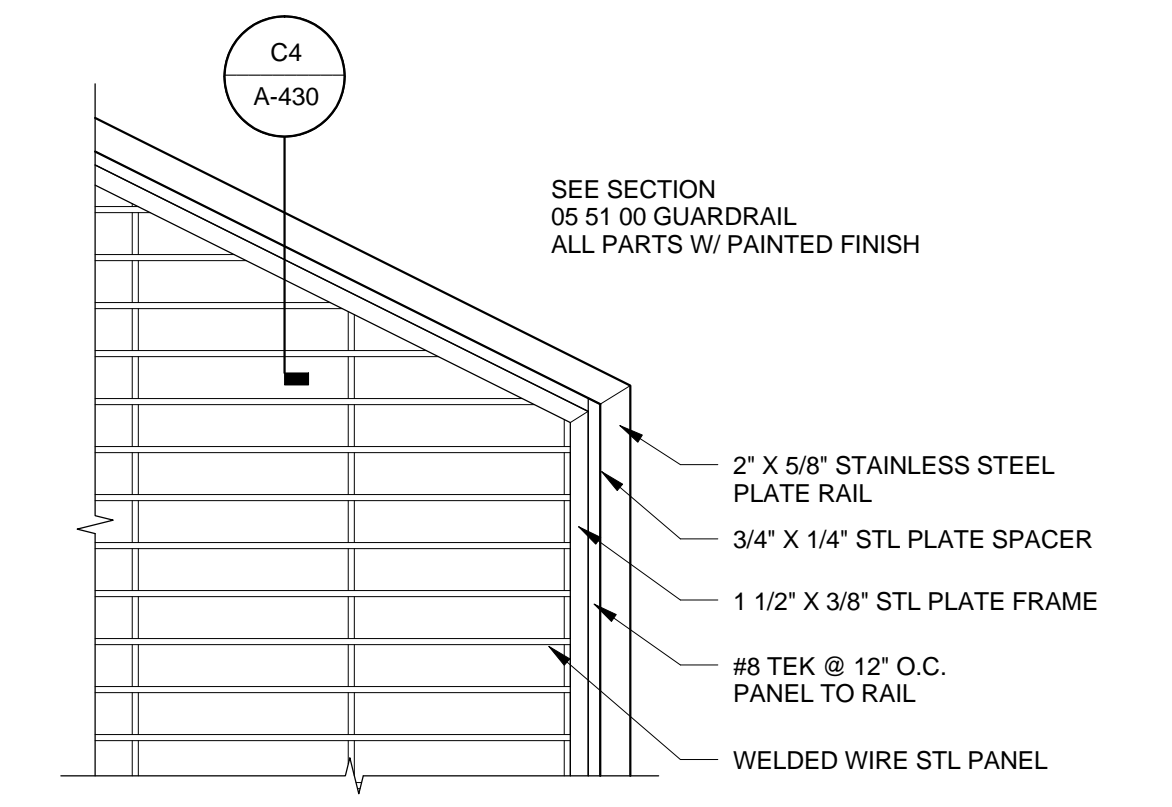


E6 GUARDRAIL @ STAIR
3\"/>

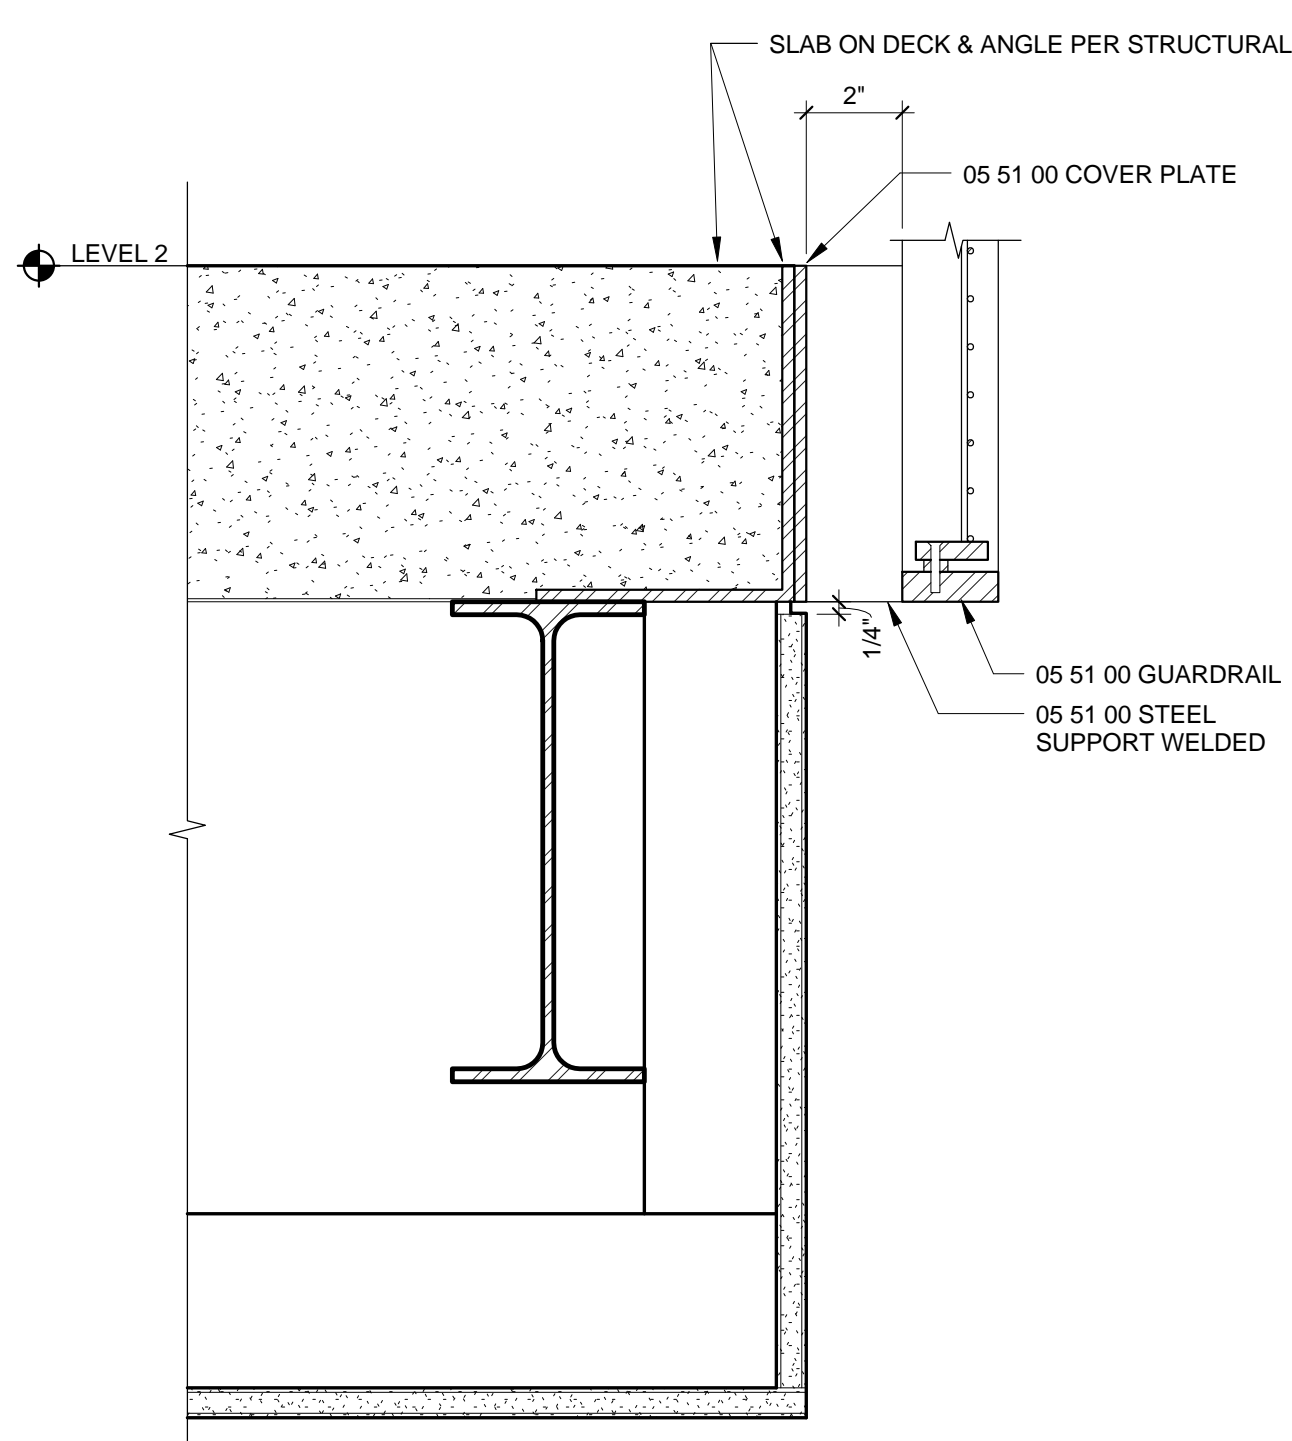


C1 GUARDRAIL @ 2ND FLR
3\"/>

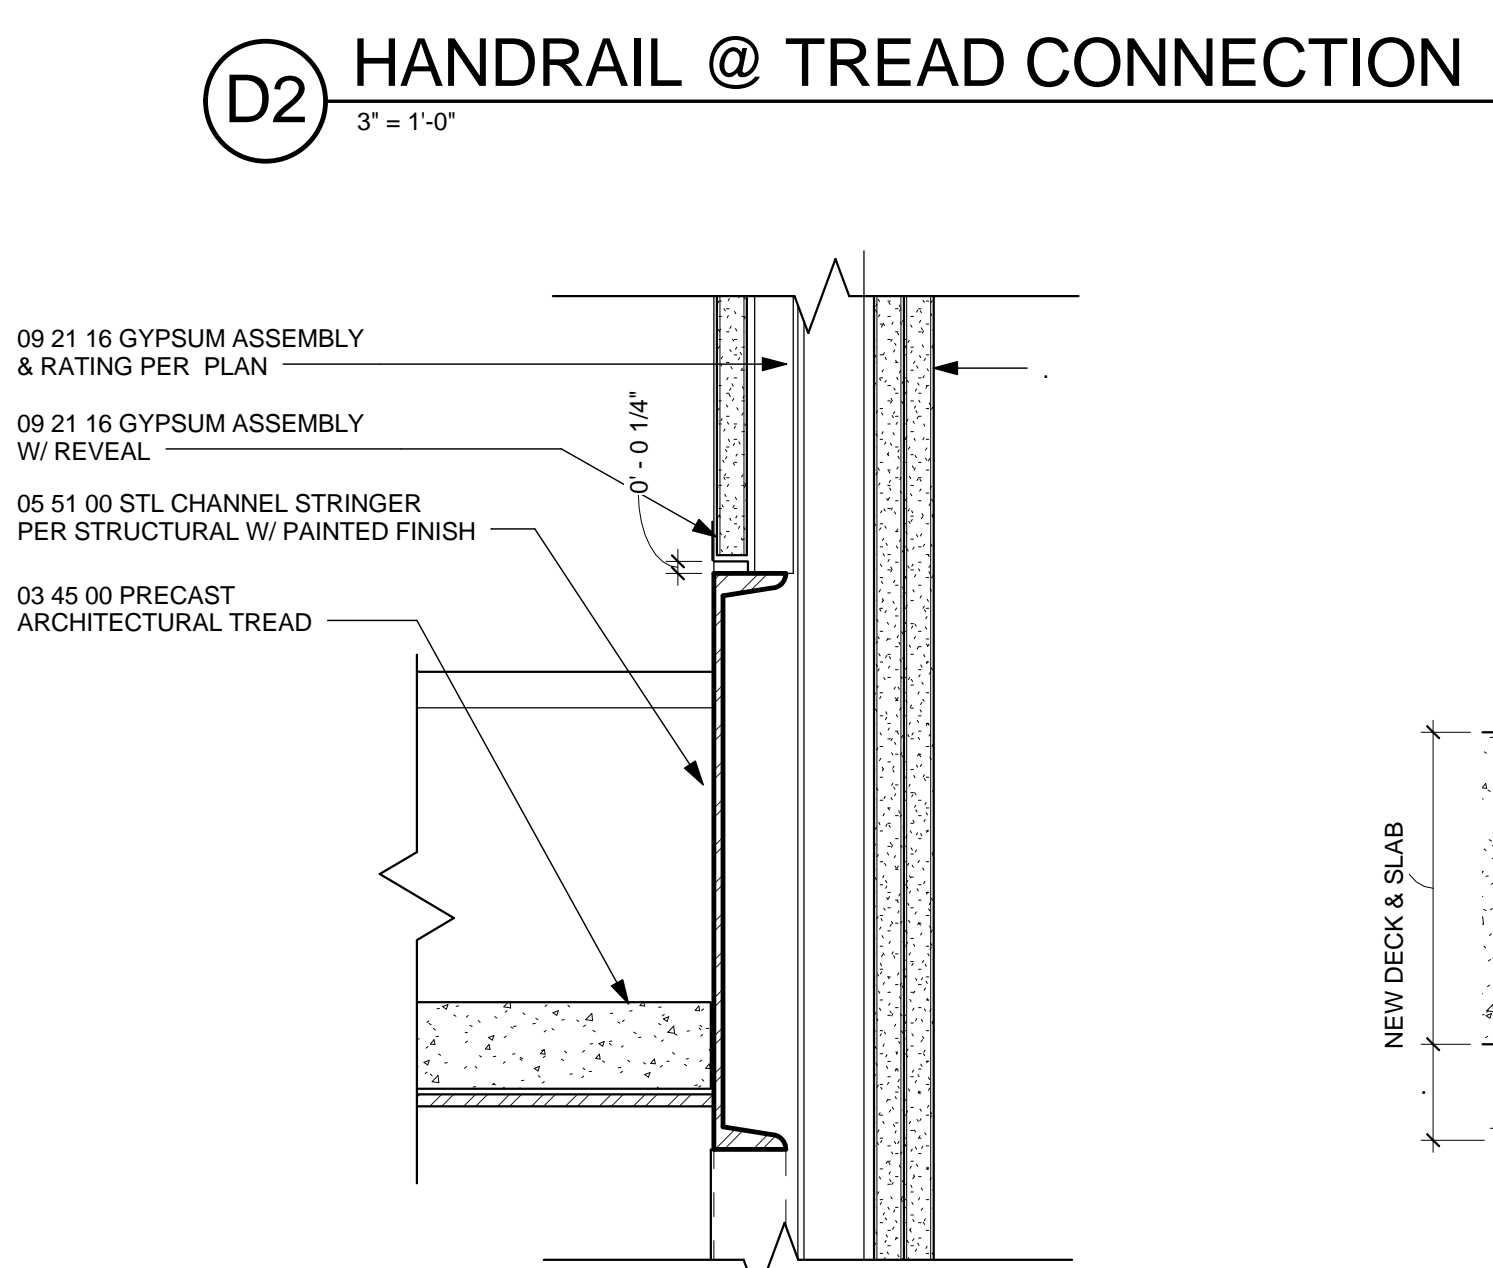


D2 HANDRAIL @ TREAD CONNECTION
3\"/>

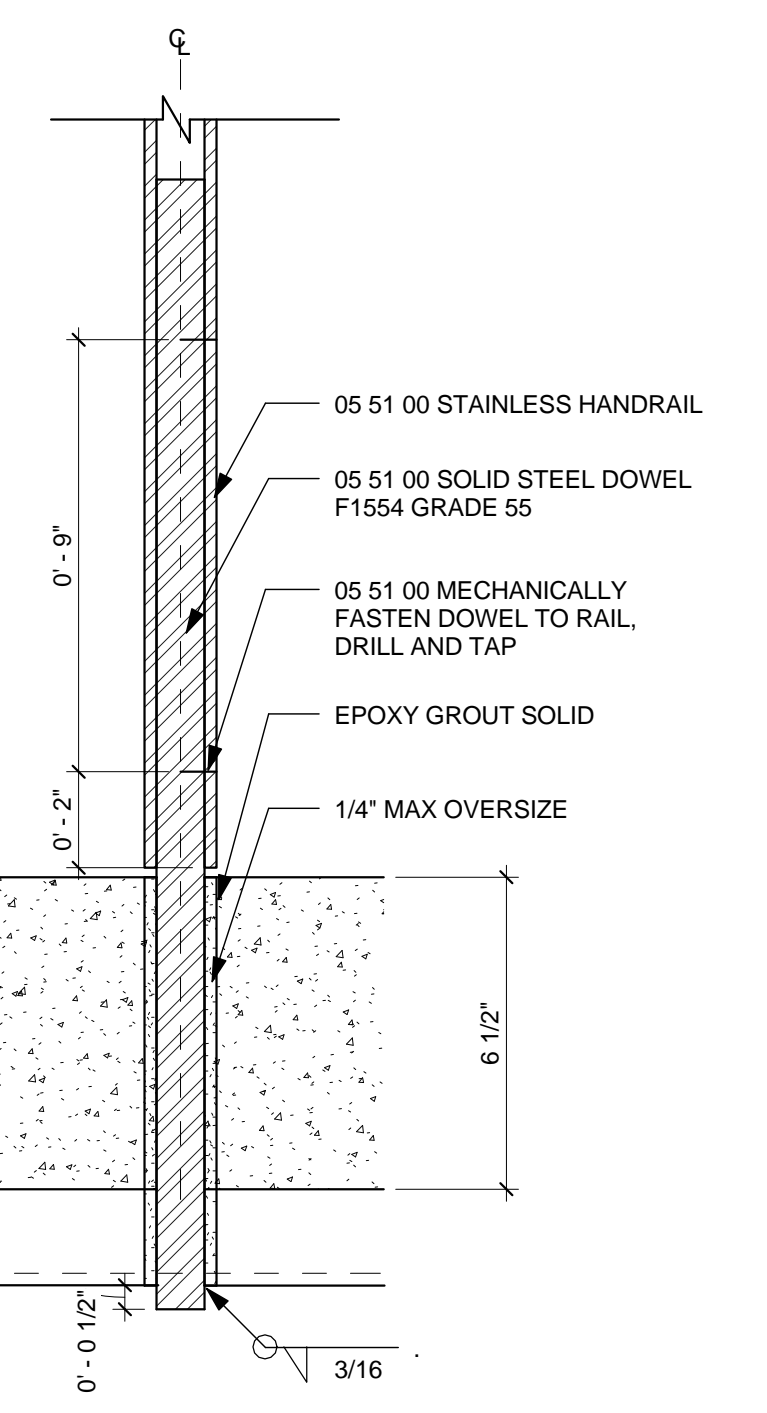


D5 GUARDRAIL @ STEP
3\"/>

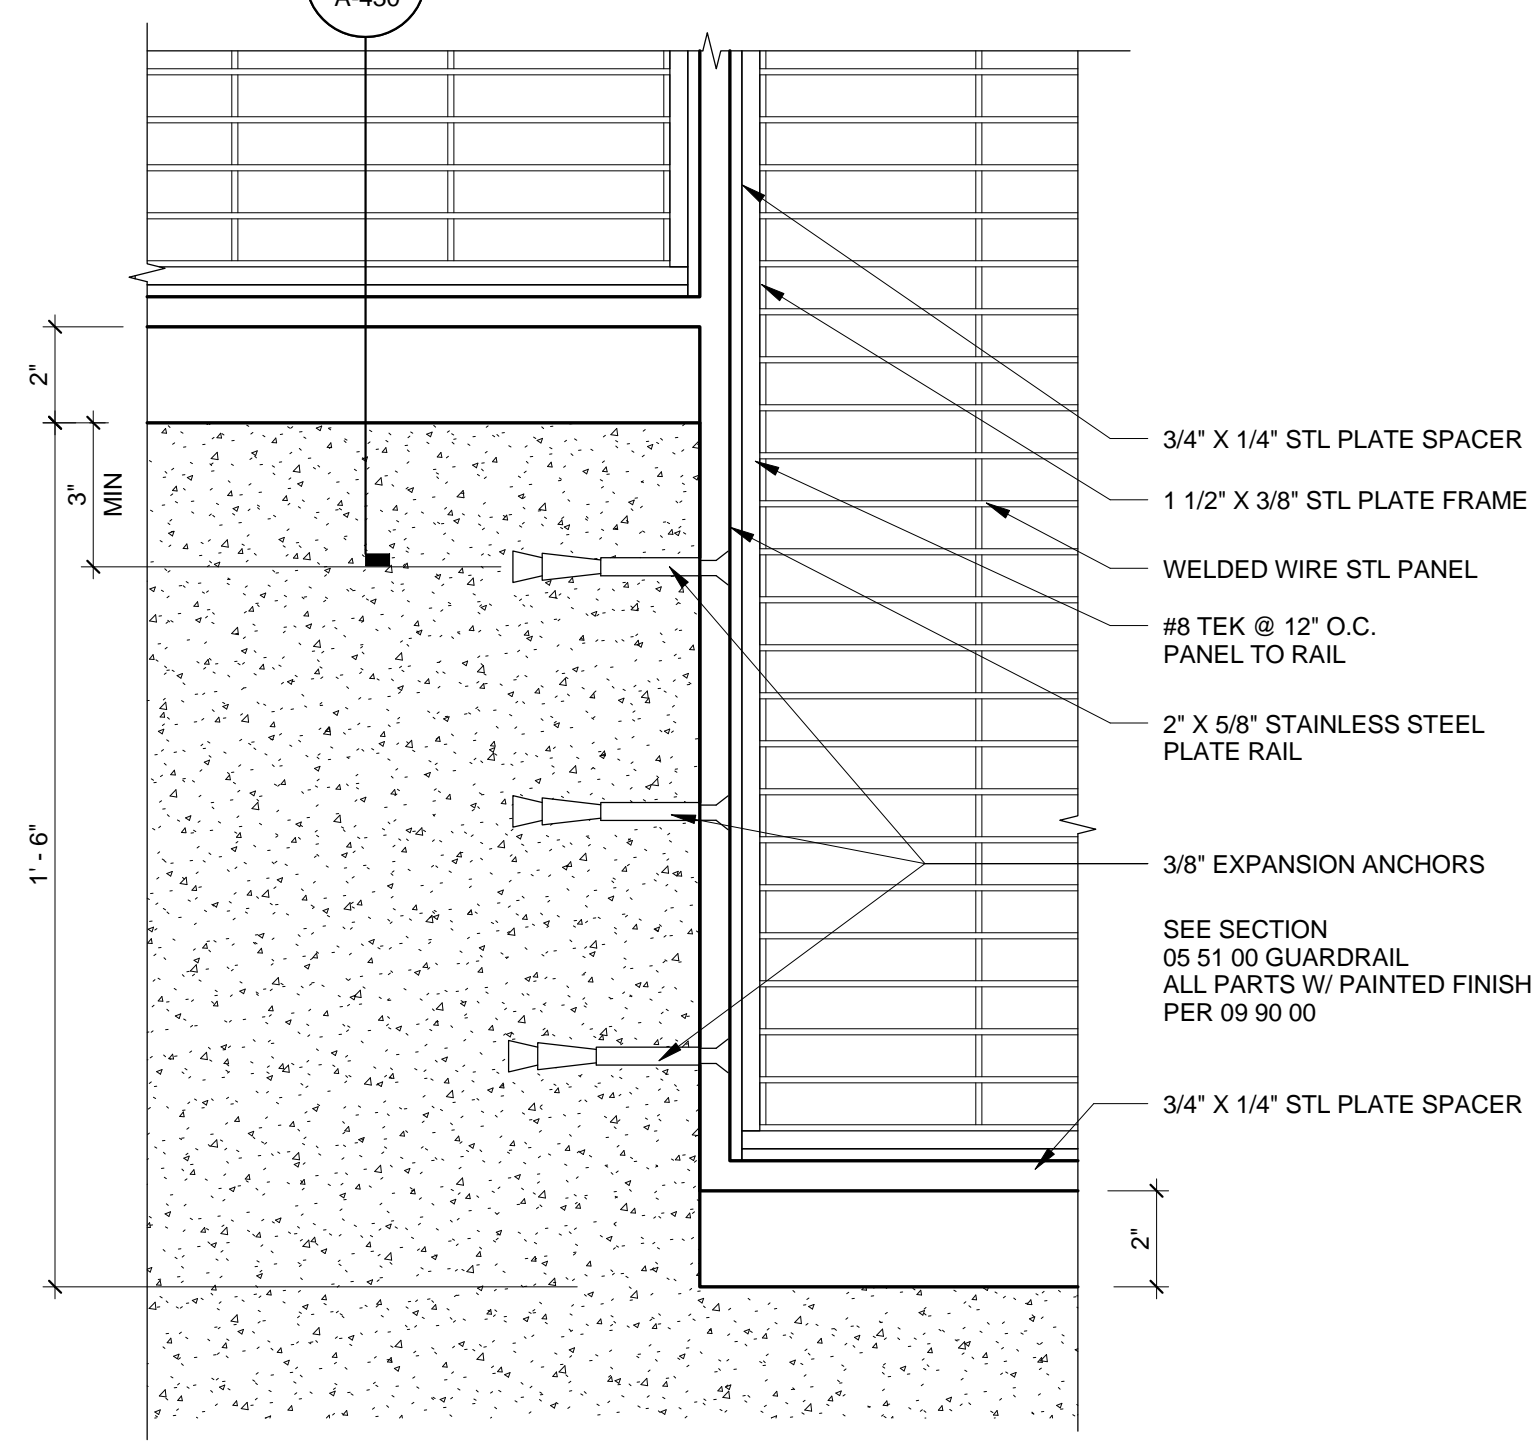


D6 GUARDRAIL @ FORUM
3\"/>

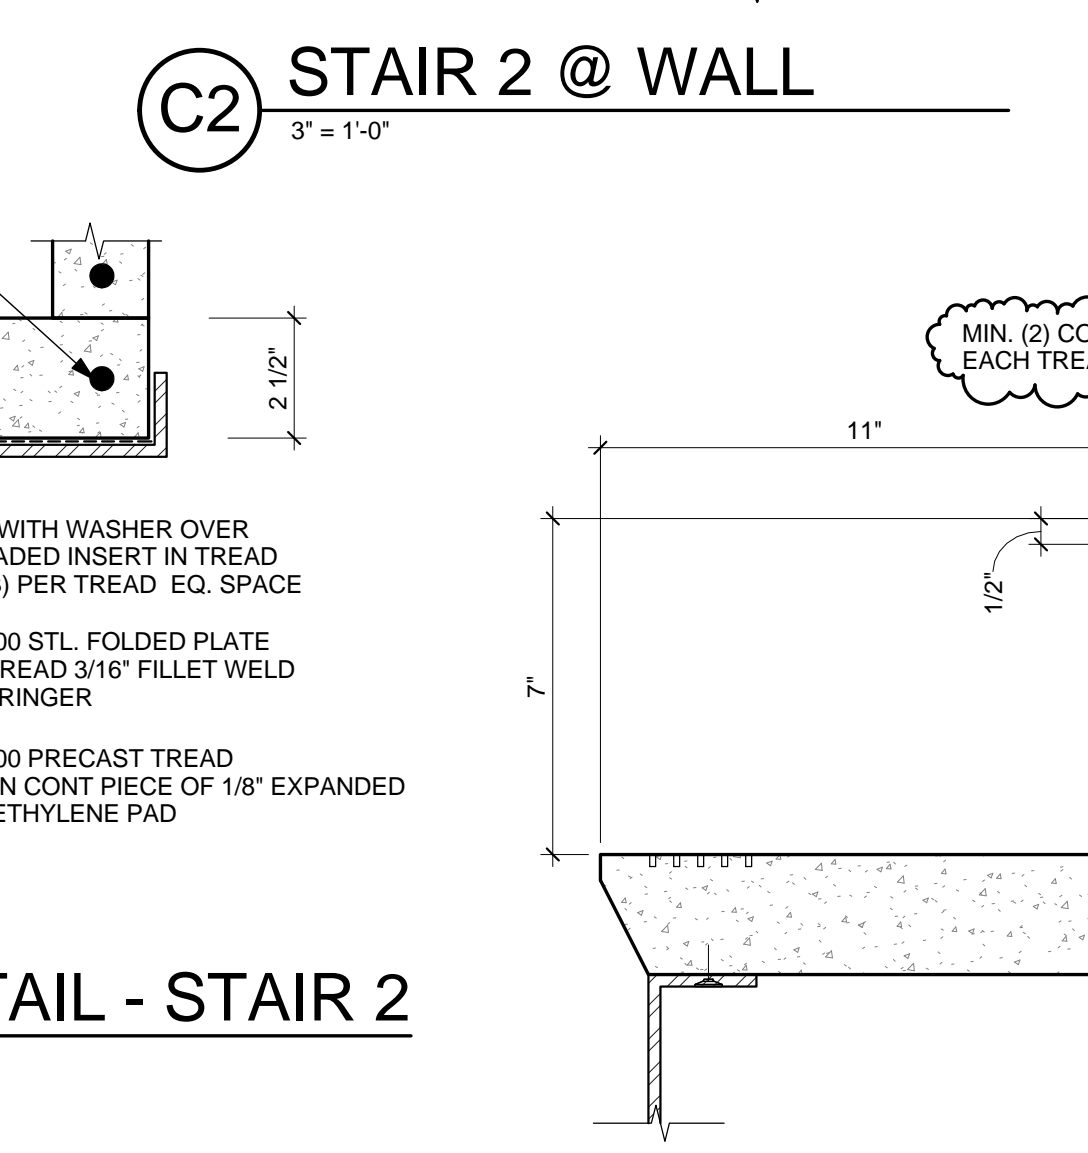


C2 STAIR 2 @ WALL
3\"/>

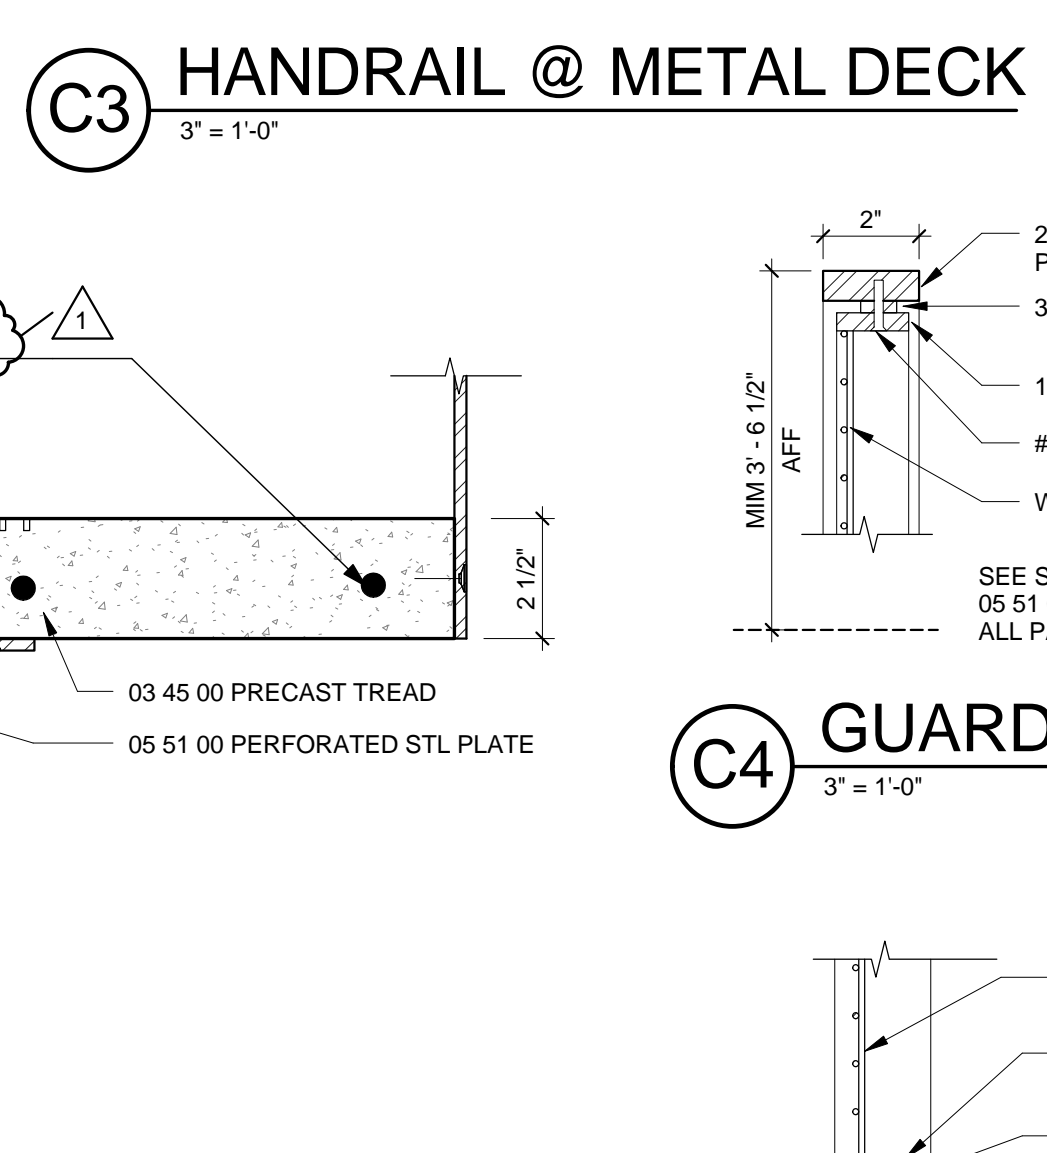


C3 HANDRAIL @ METAL DECK
3\"/>

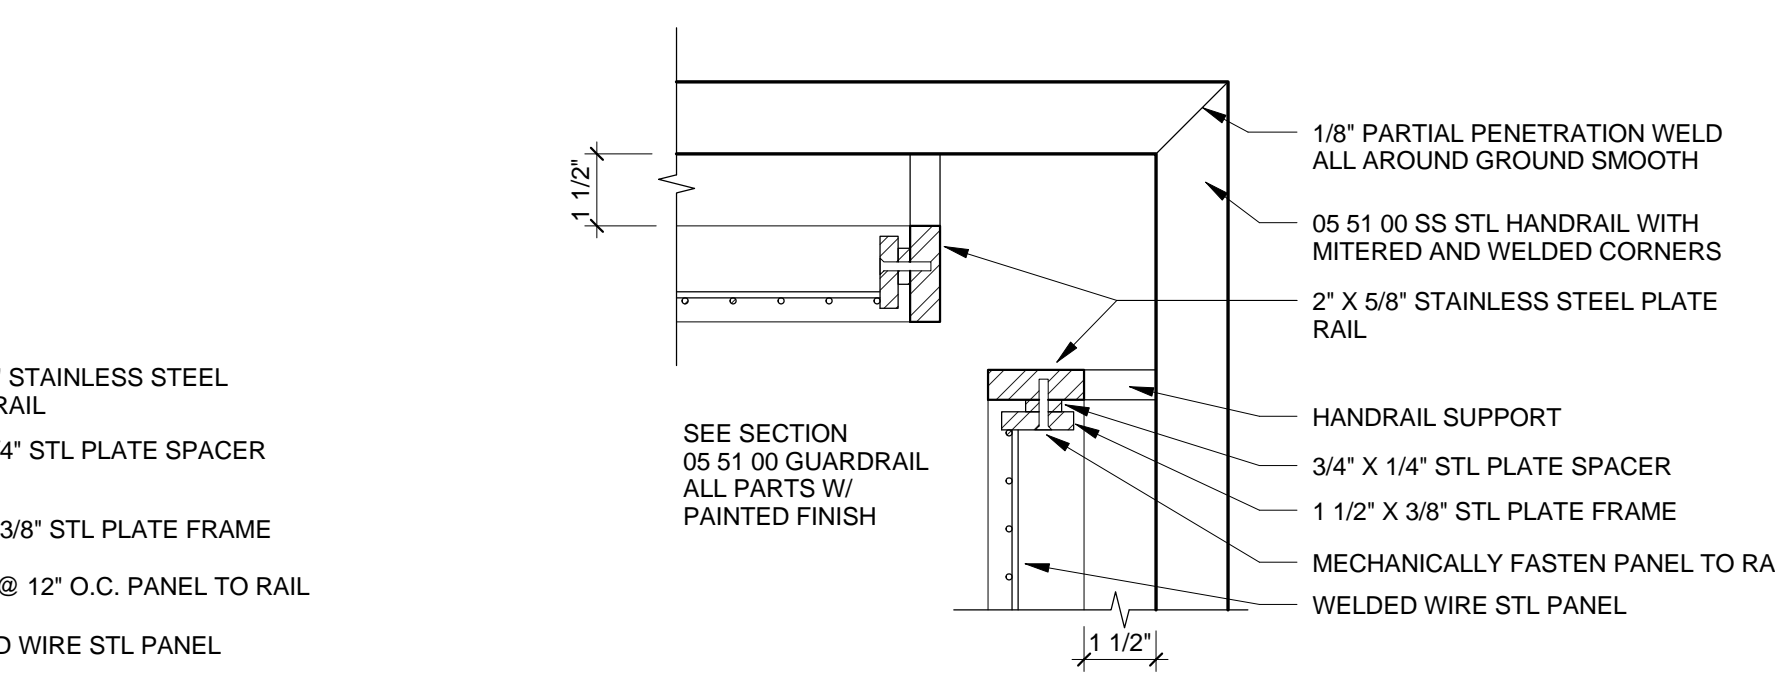


C5 GUARDRAIL & HANDRAIL CORNER
3\"/>

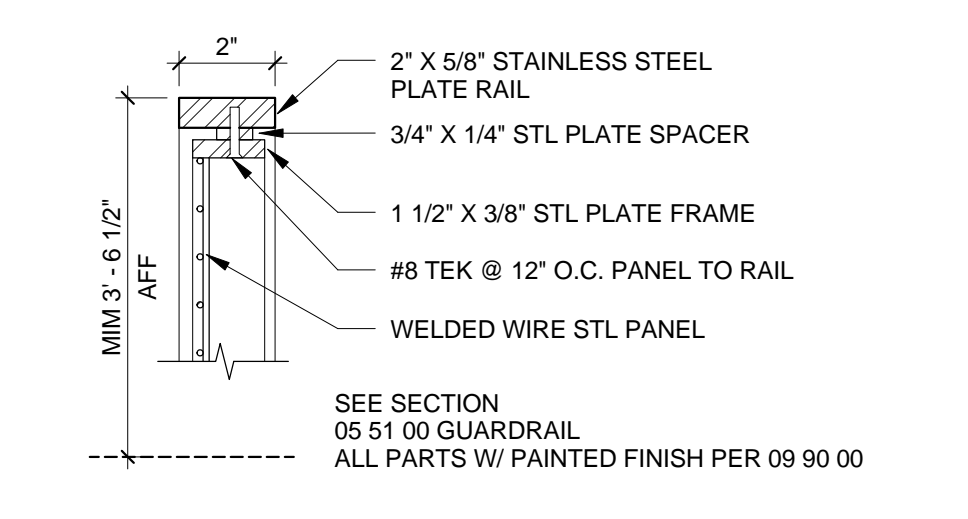


C4 GUARDRAIL TOP DETAIL
3\"/>

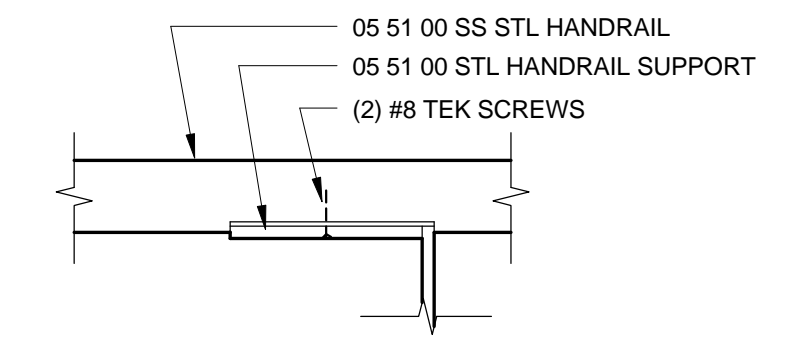


B6 HANDRAIL SUPPORT
3\"/>

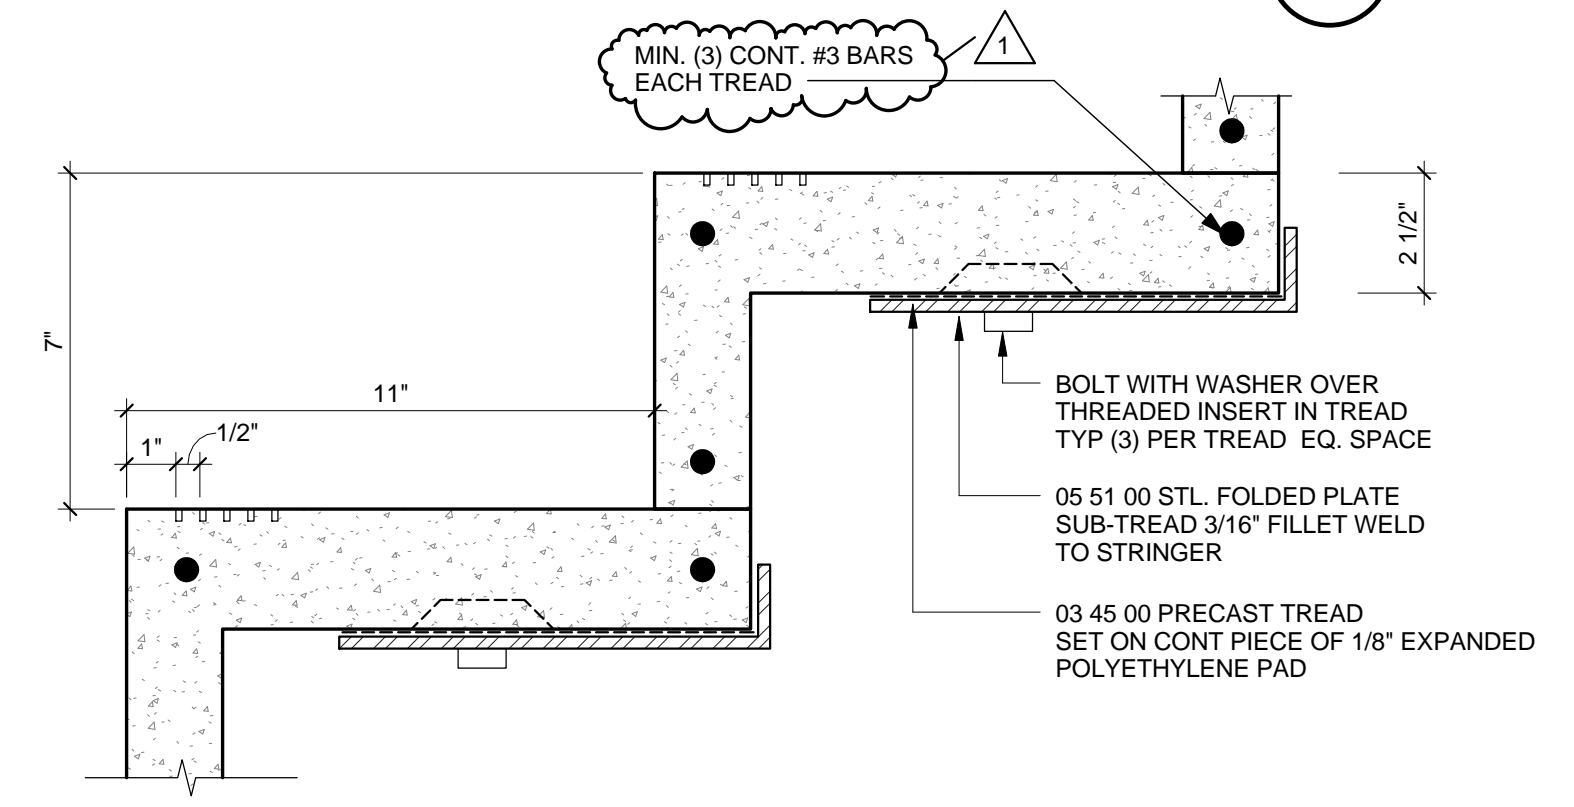


B2 PRECAST TREAD & RISER DETAIL - STAIR 2
3\"/>

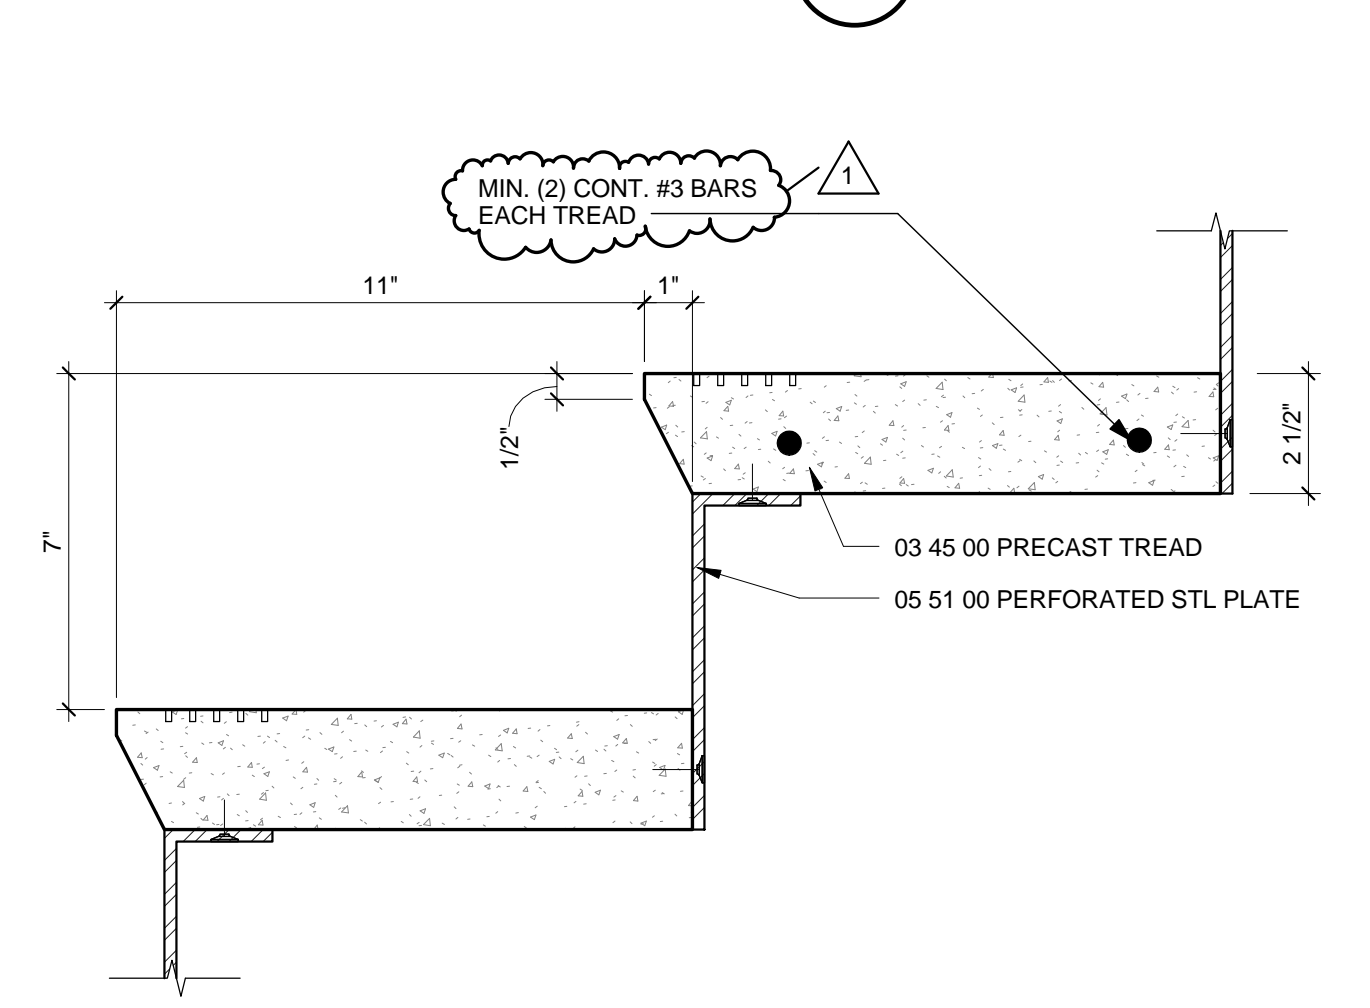


B3 PRECAST TREAD DETAIL - STAIR 1
3\"/>

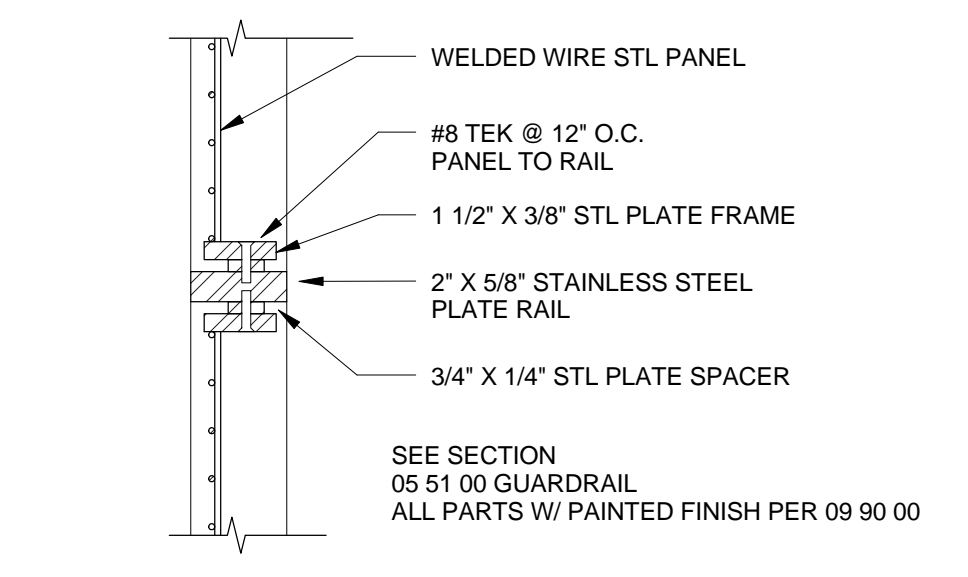


B4 PANEL TO PANEL DETAIL
3\"/>

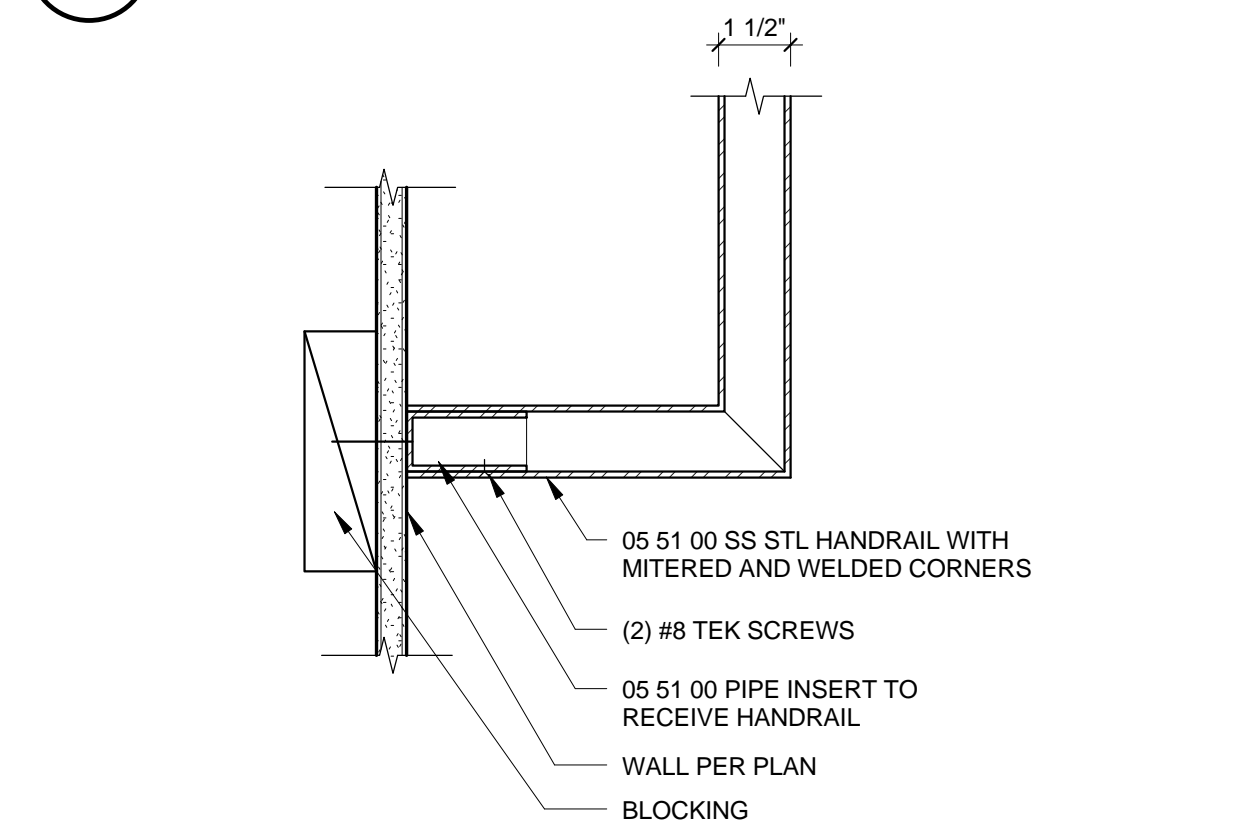


B5 HANDRAIL TO WALL DETAIL
3\"/>

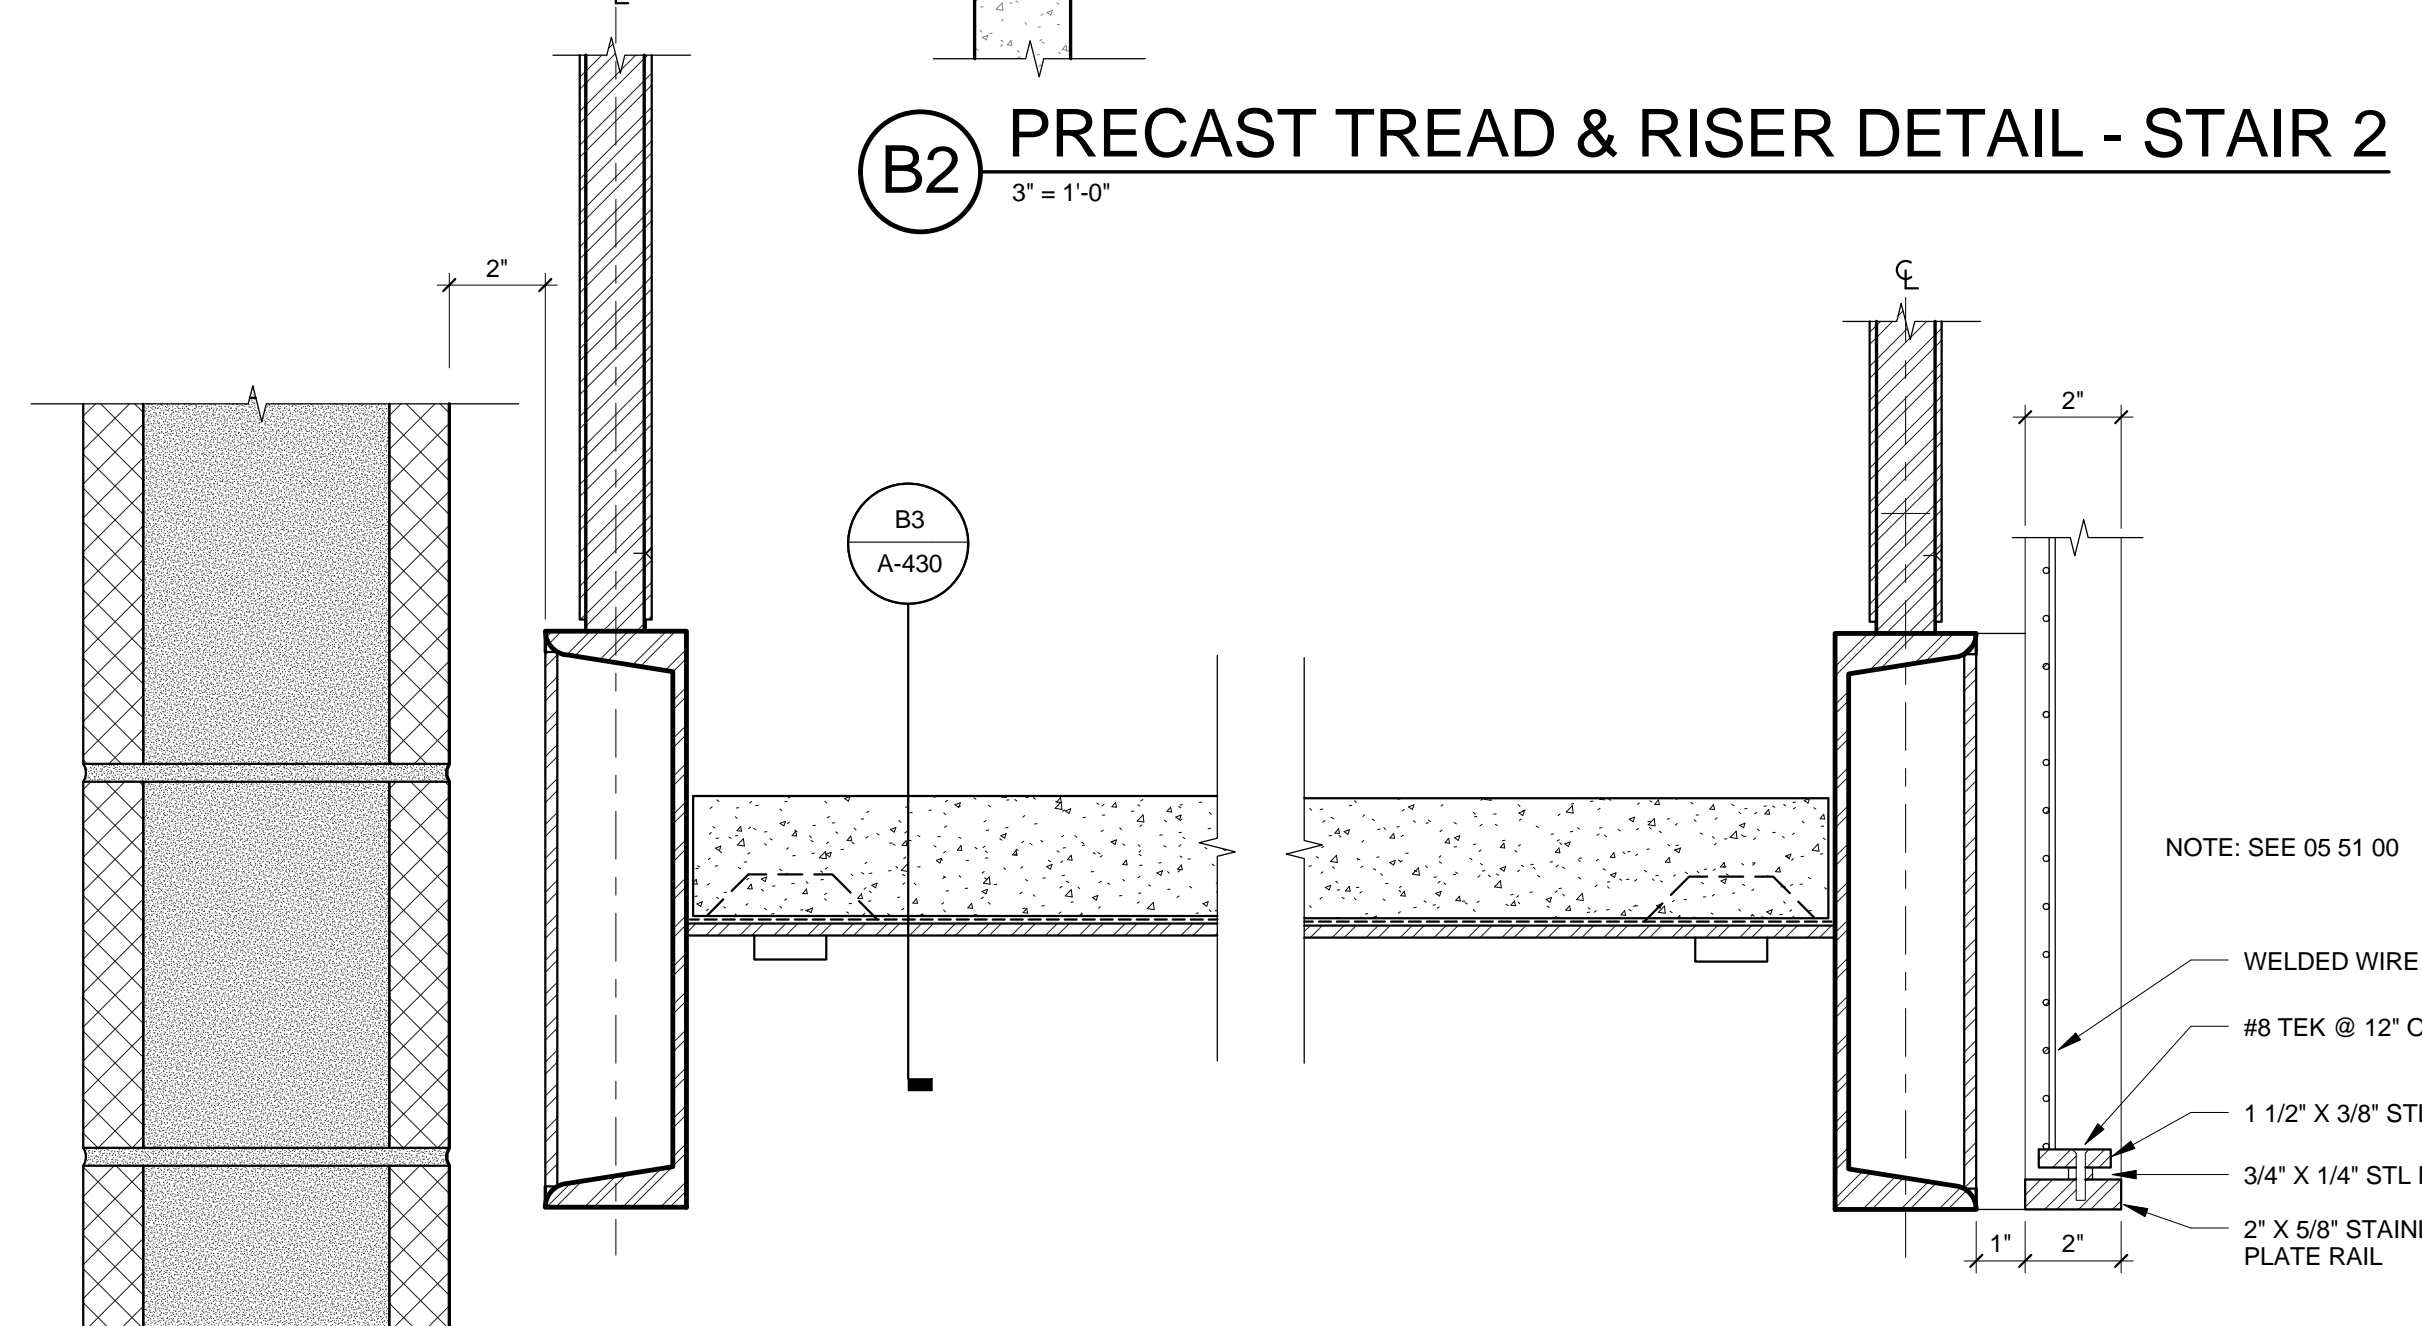


A2 TREAD @ STAIR 1
3\"/>

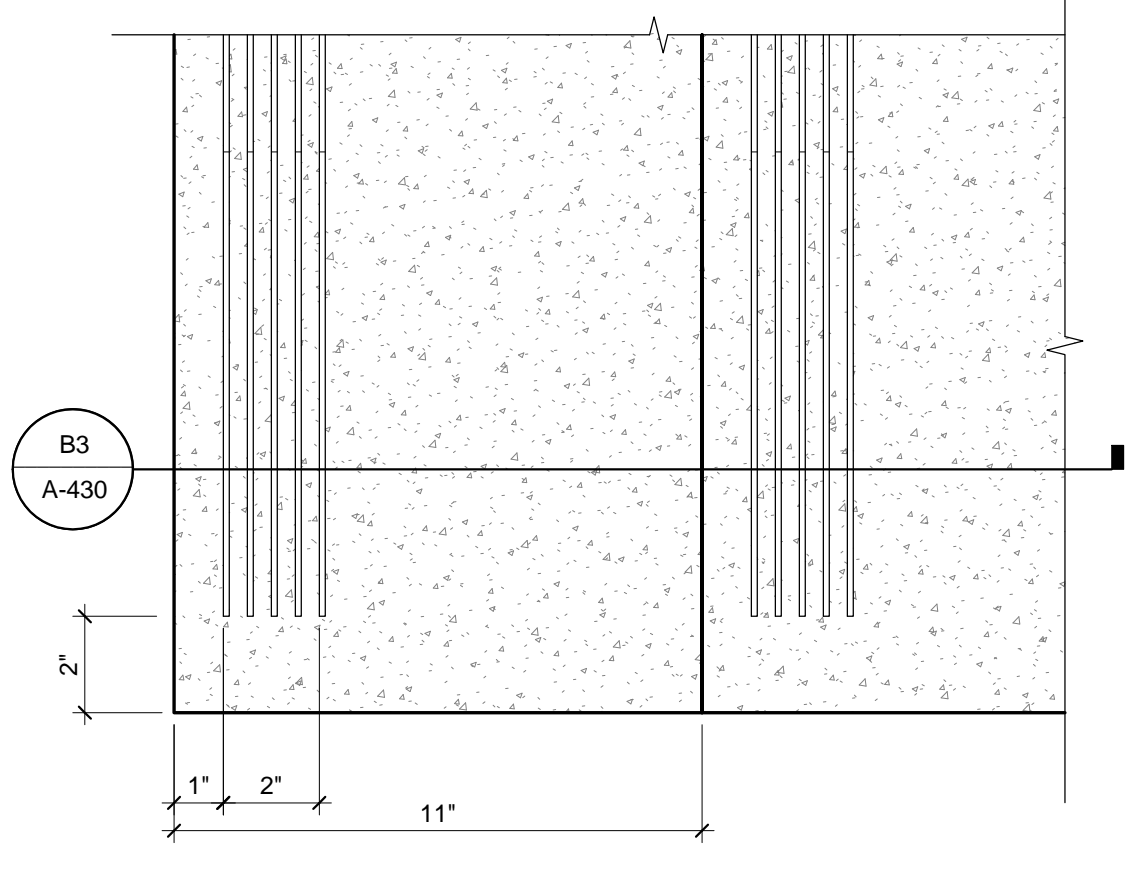


A3 TREAD PLAN DETAIL
3\"/>

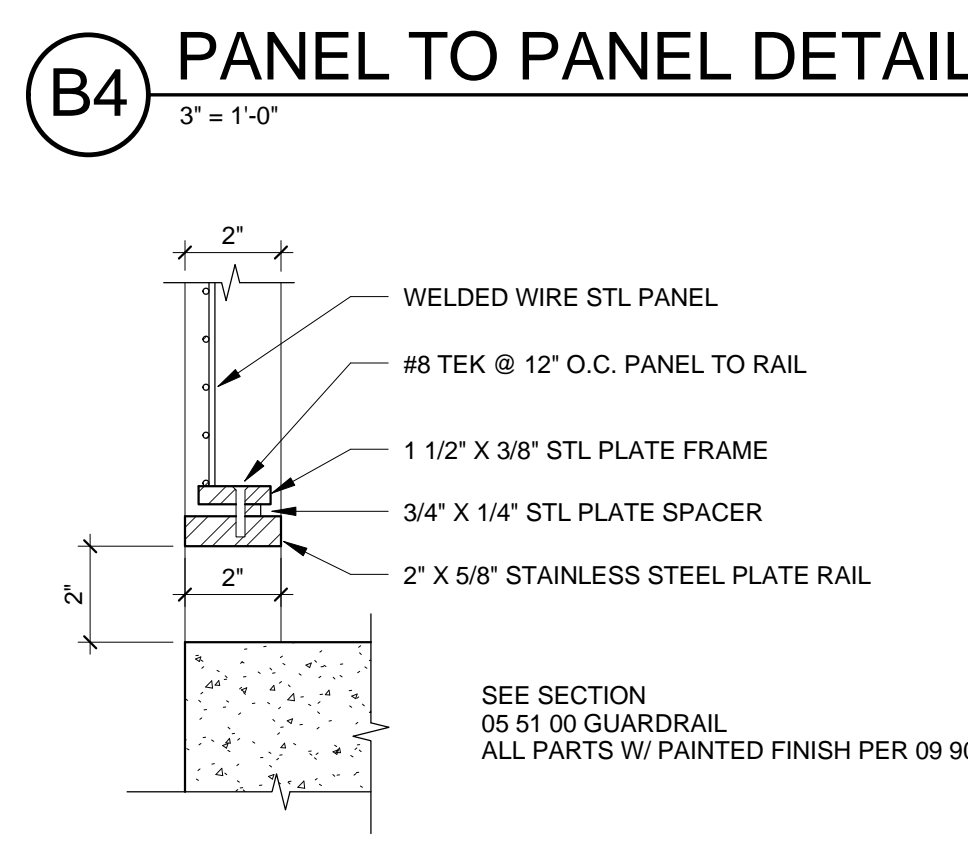

A4 GUARDRAIL BASE DETAIL
3\"/>

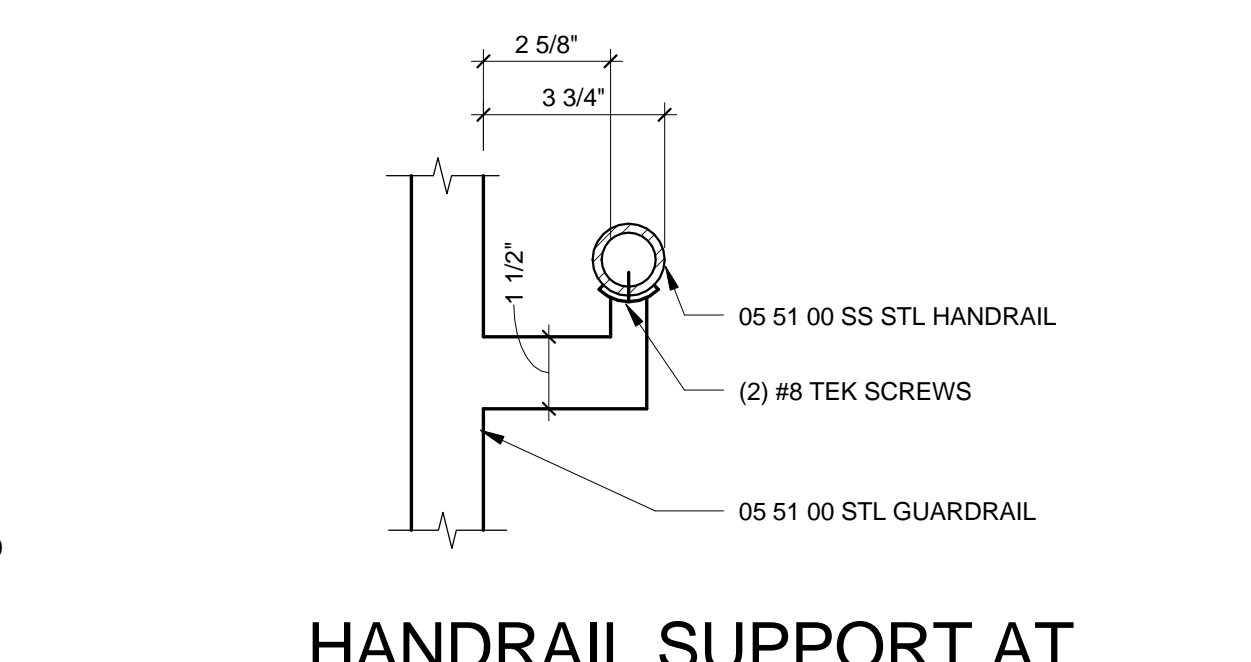




A5 HANDRAIL SUPPORT AT GAURDRAIL
3\"/>

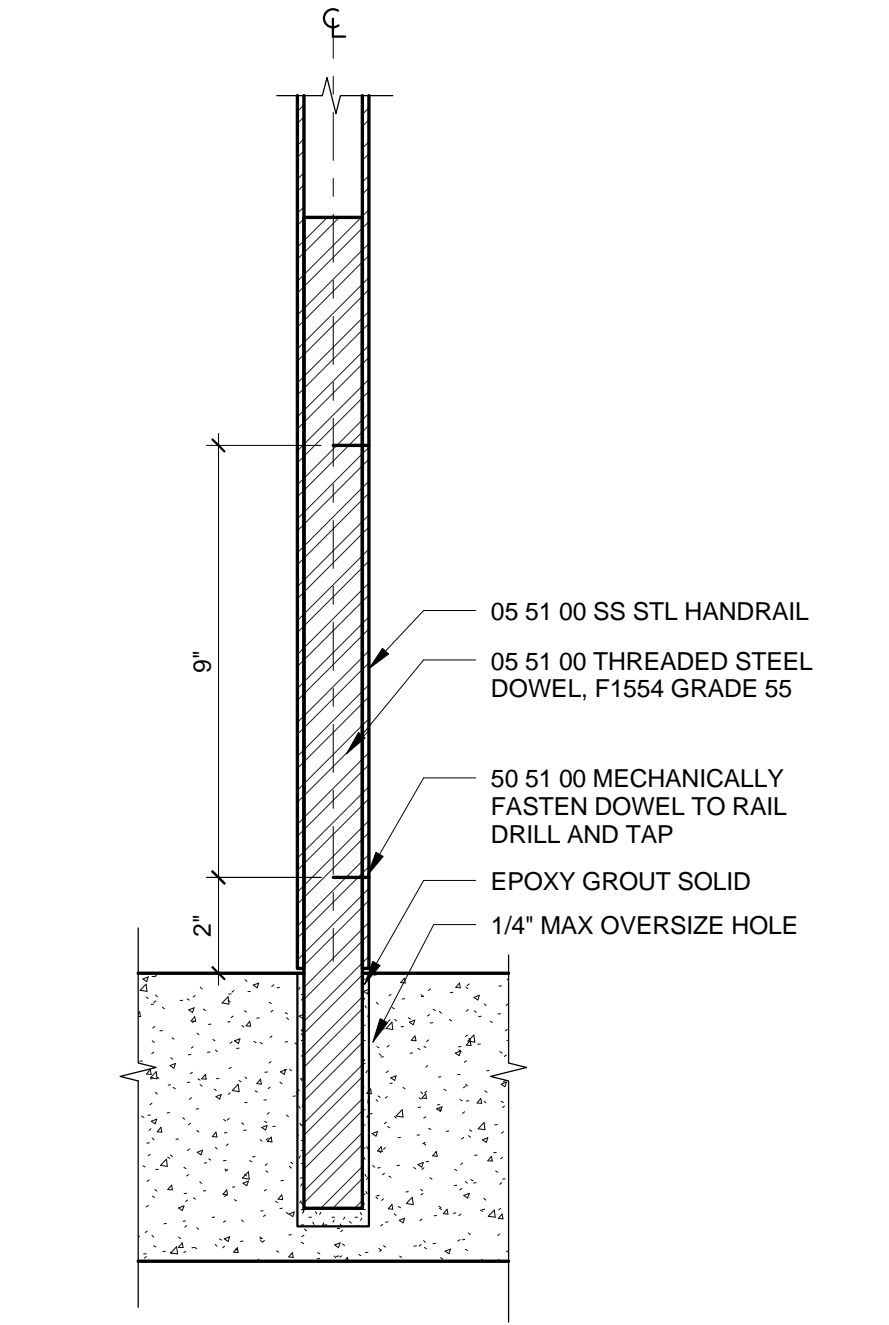


A6 HANDRAIL @ SLAB
3\"/>

A1 STAIR 1 @ CMU WALL
3\"/>


3/13/2015 11:52:16 AM C:\mahlum\p0213912\Arch\A-430.dwg JB

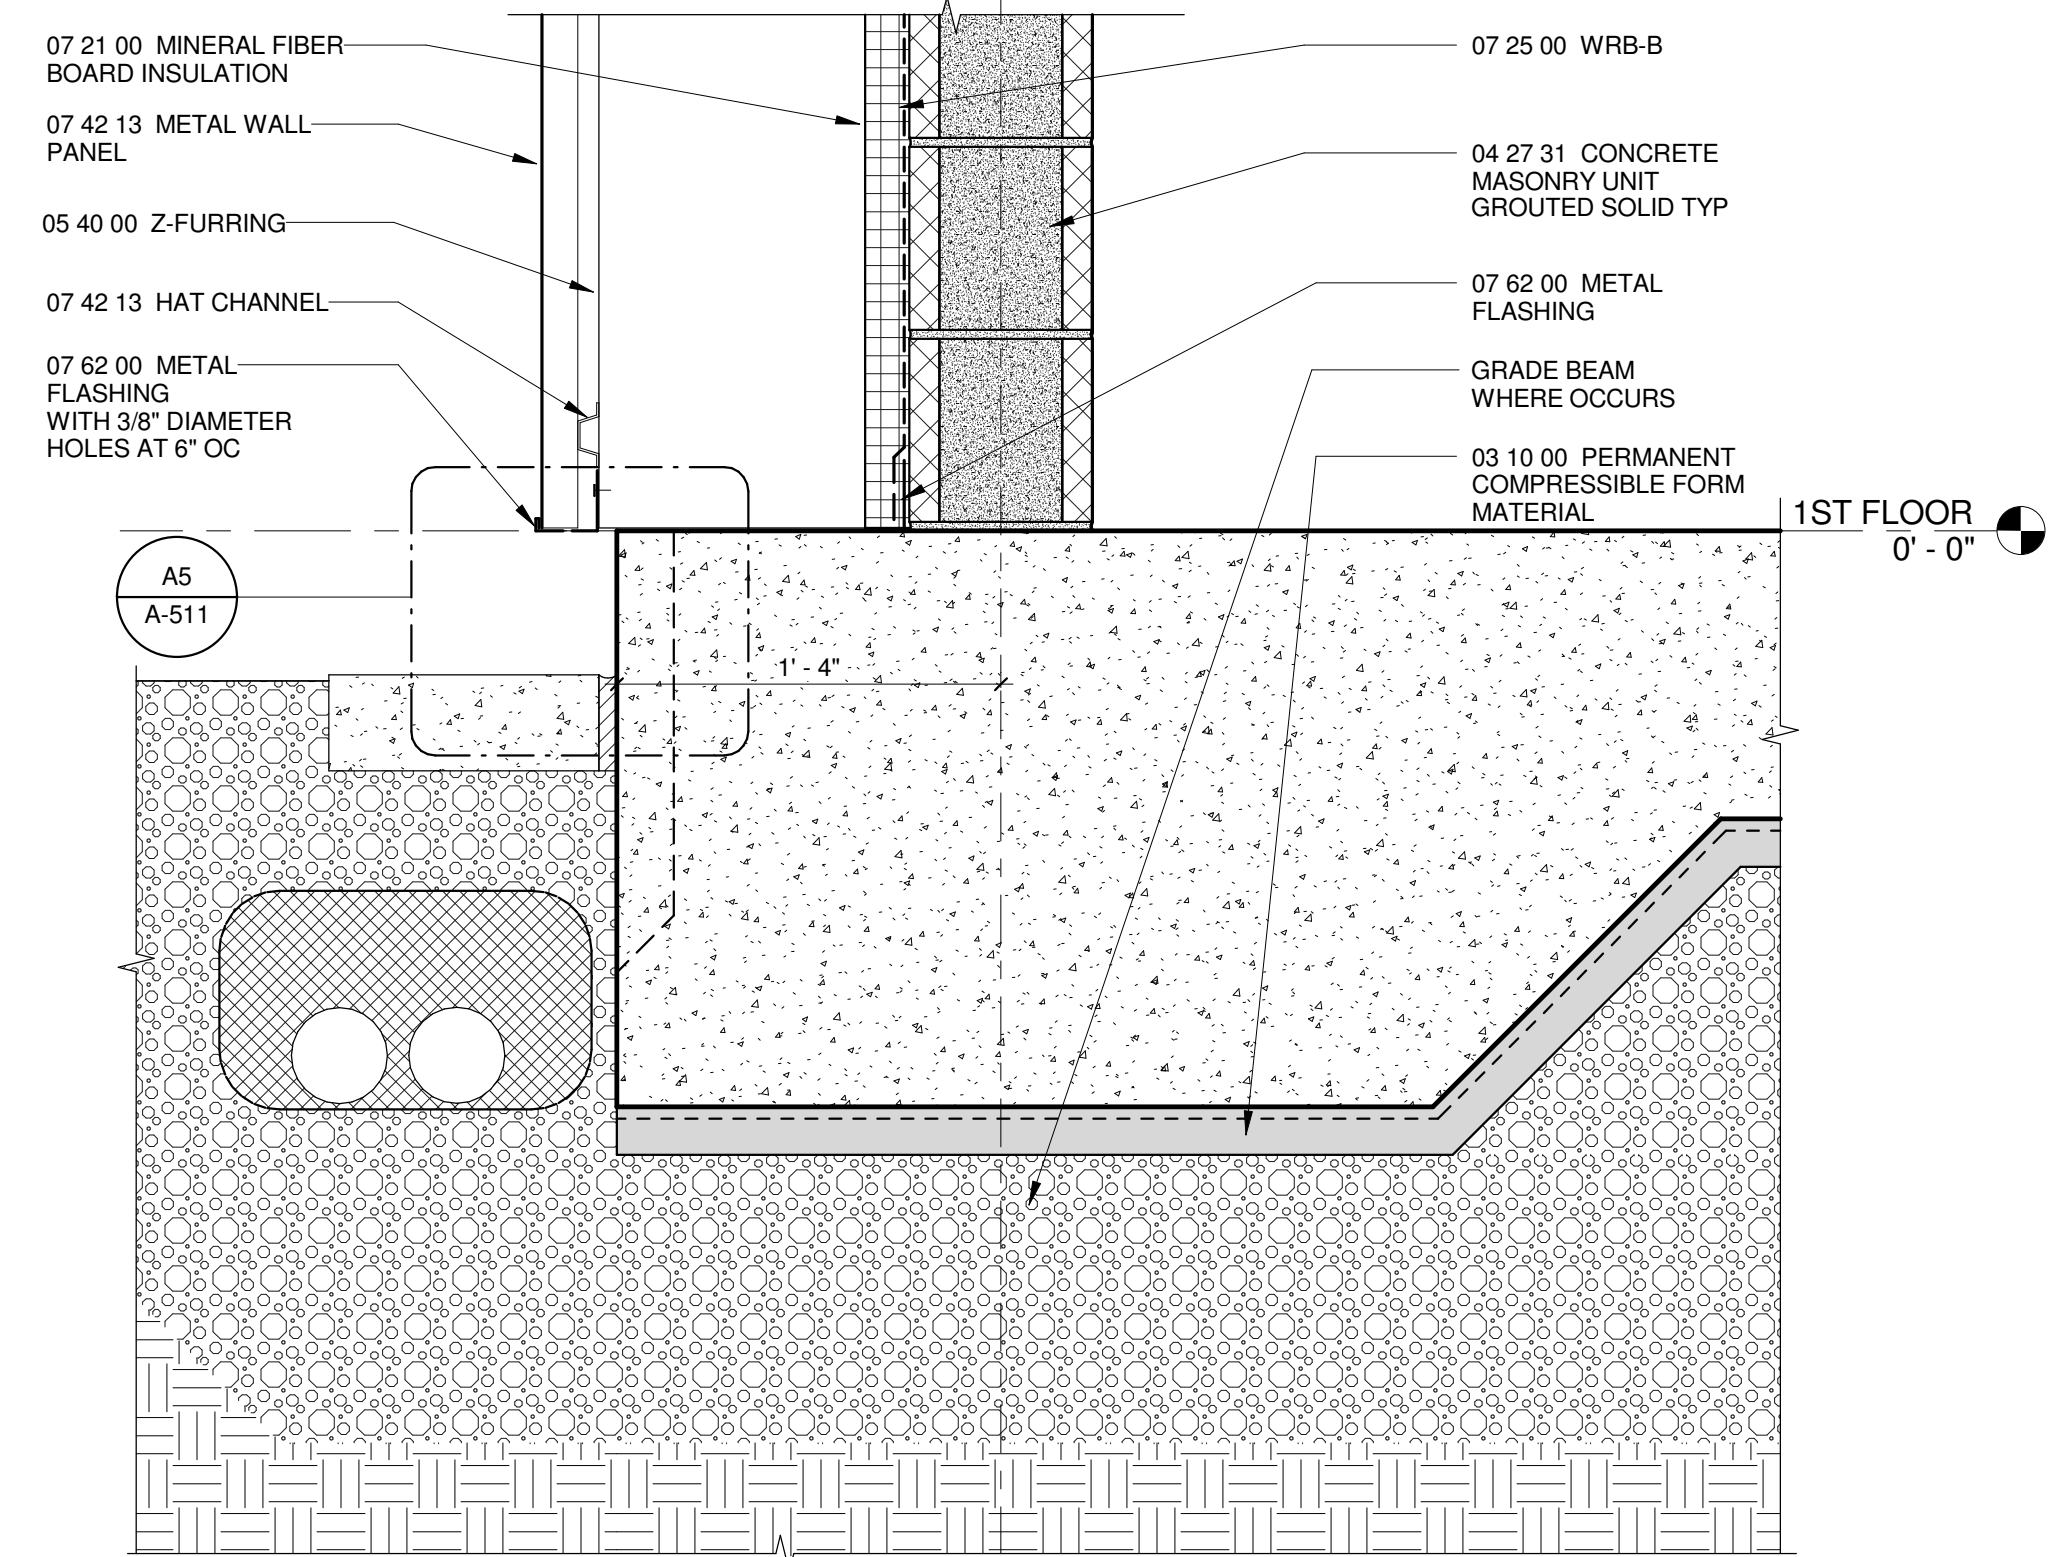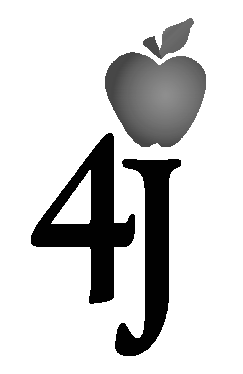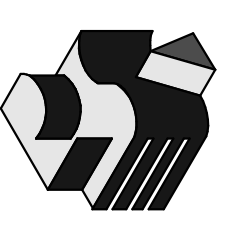


D1 SLAB EDGE AT X-08
1 1/2" = 1'-0"

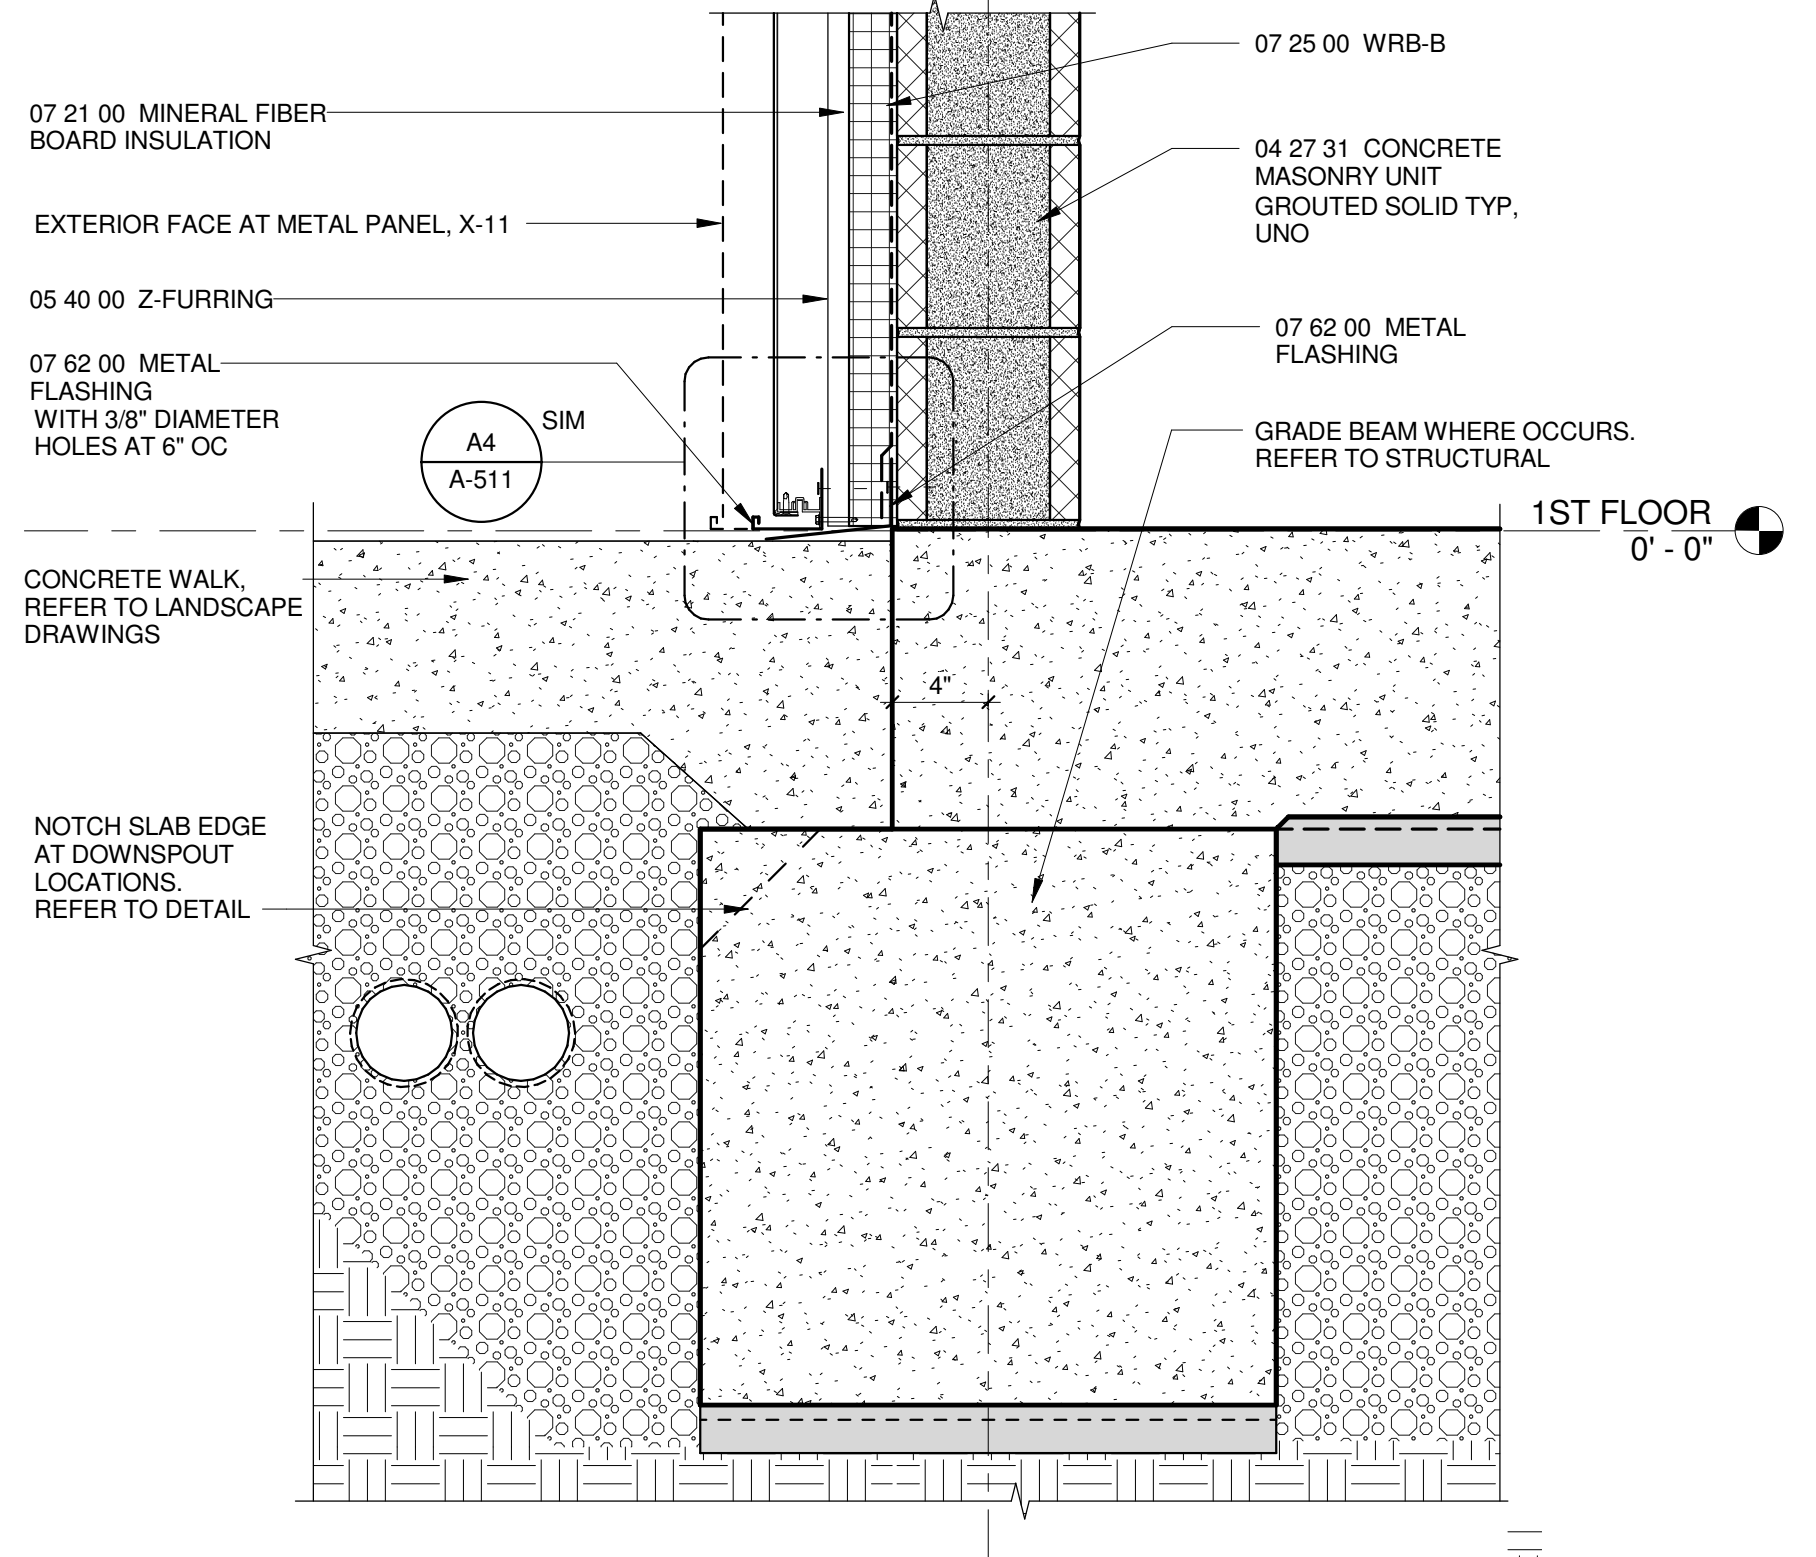


D3 SLAB EDGE AT X-11
1 1/2" = 1'-0"
X-17

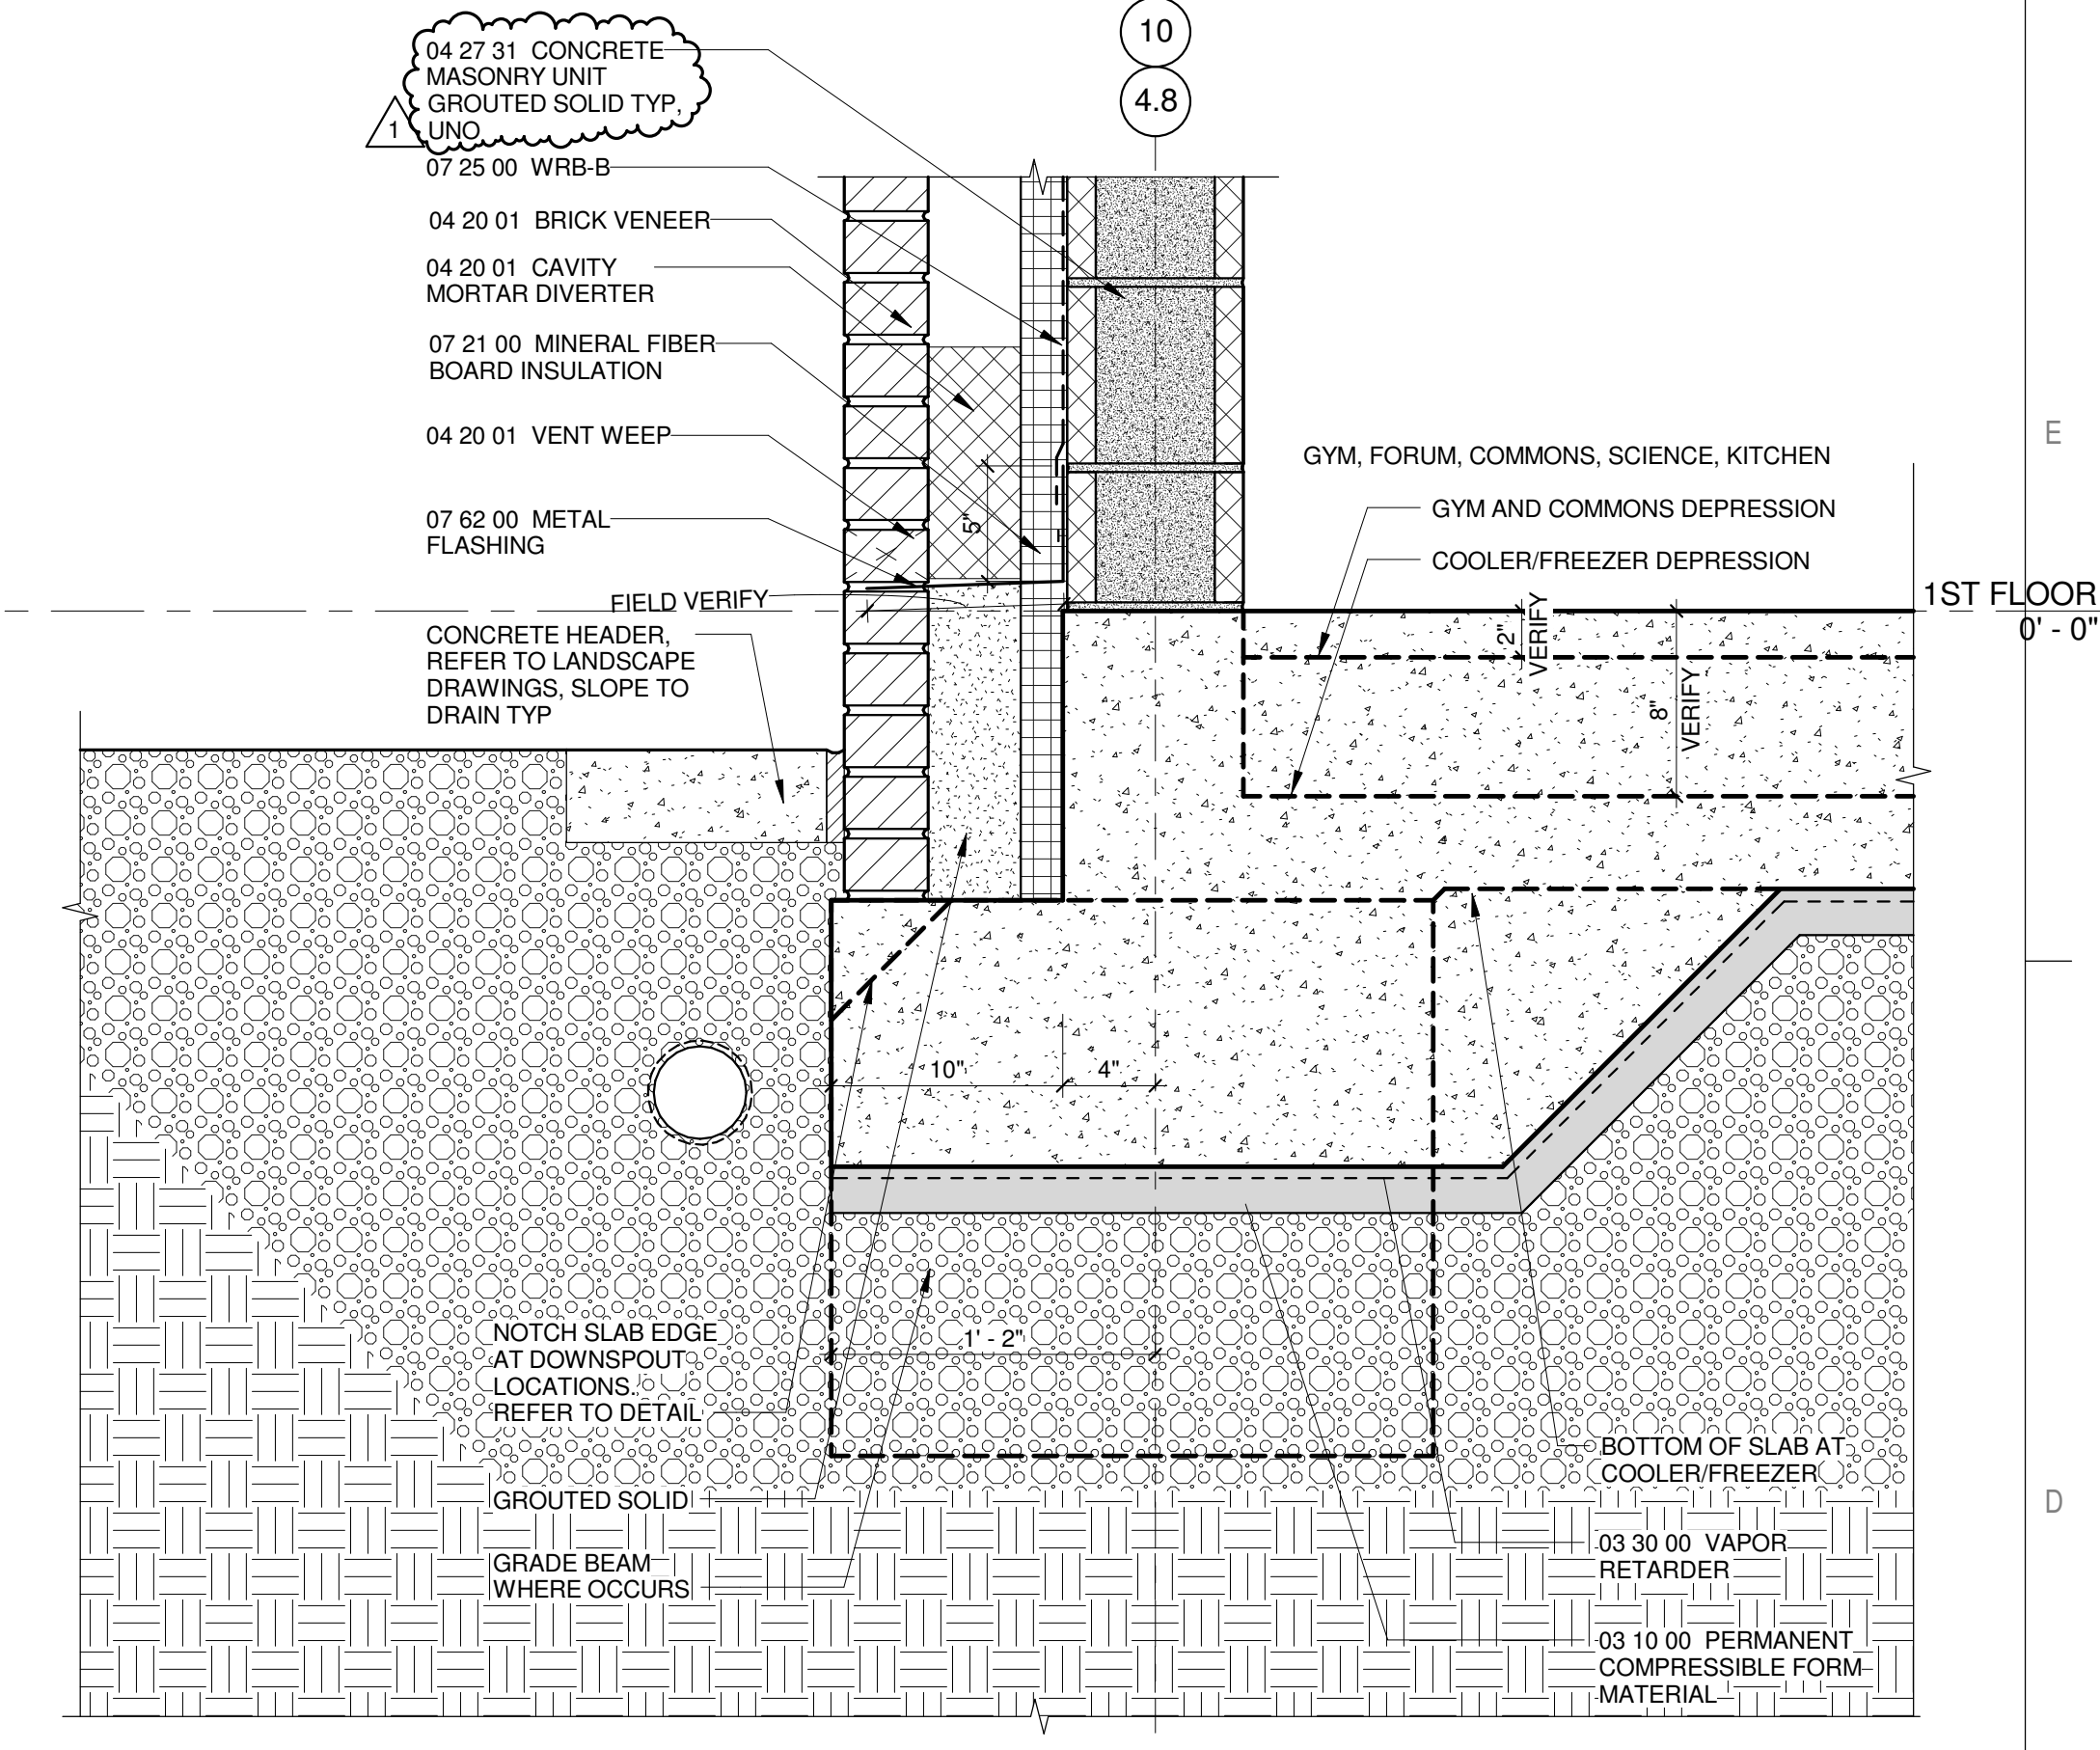


D5 SLAB EDGE AT X-07
1 1/2" = 1'-0"

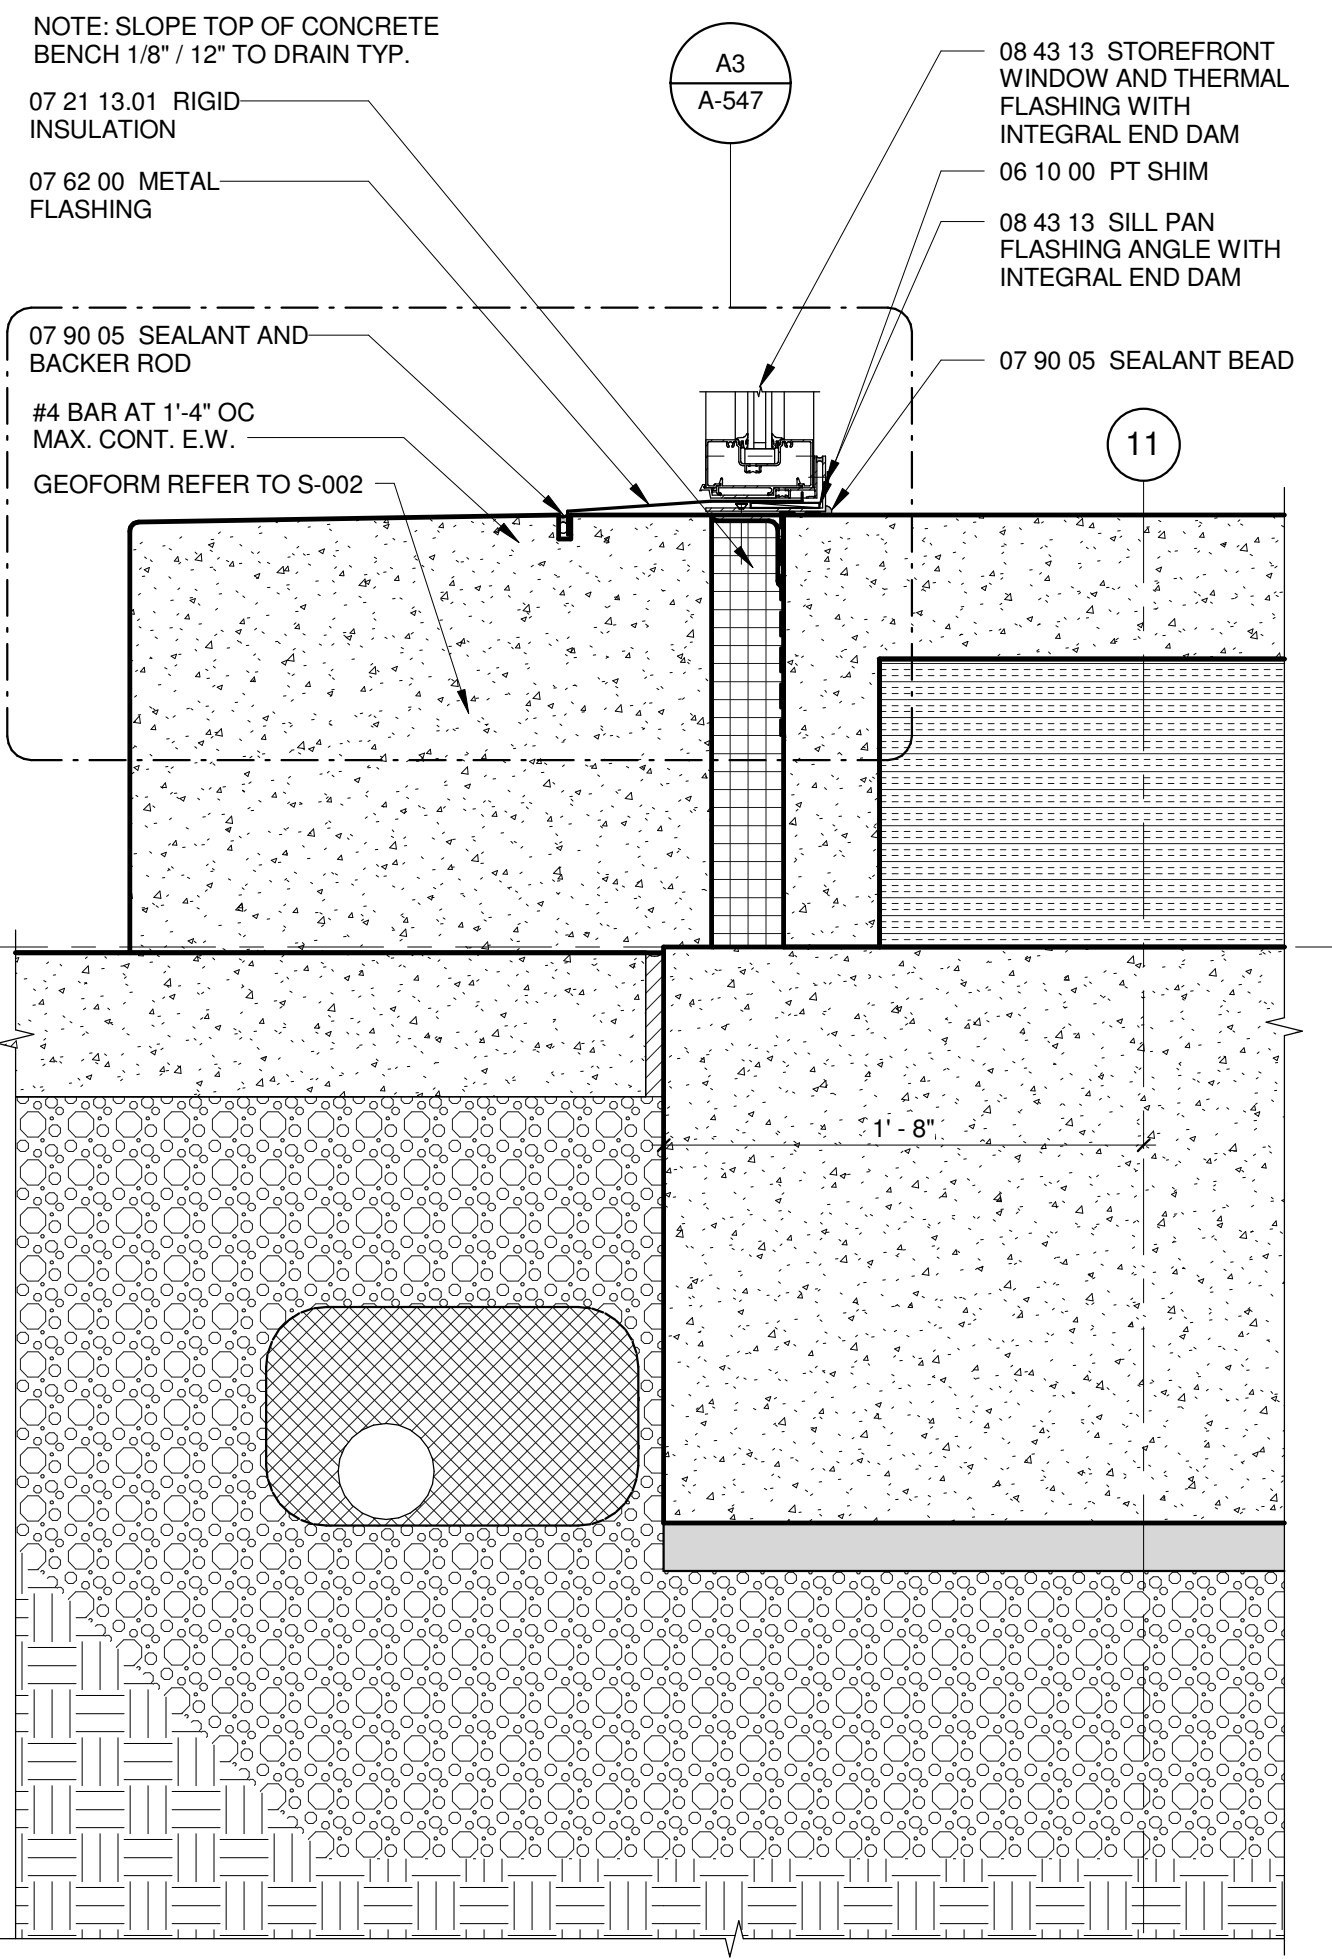


A1 SLAB EDGE AT ENTRY BENCH E/W
1 1/2" = 1'-0"

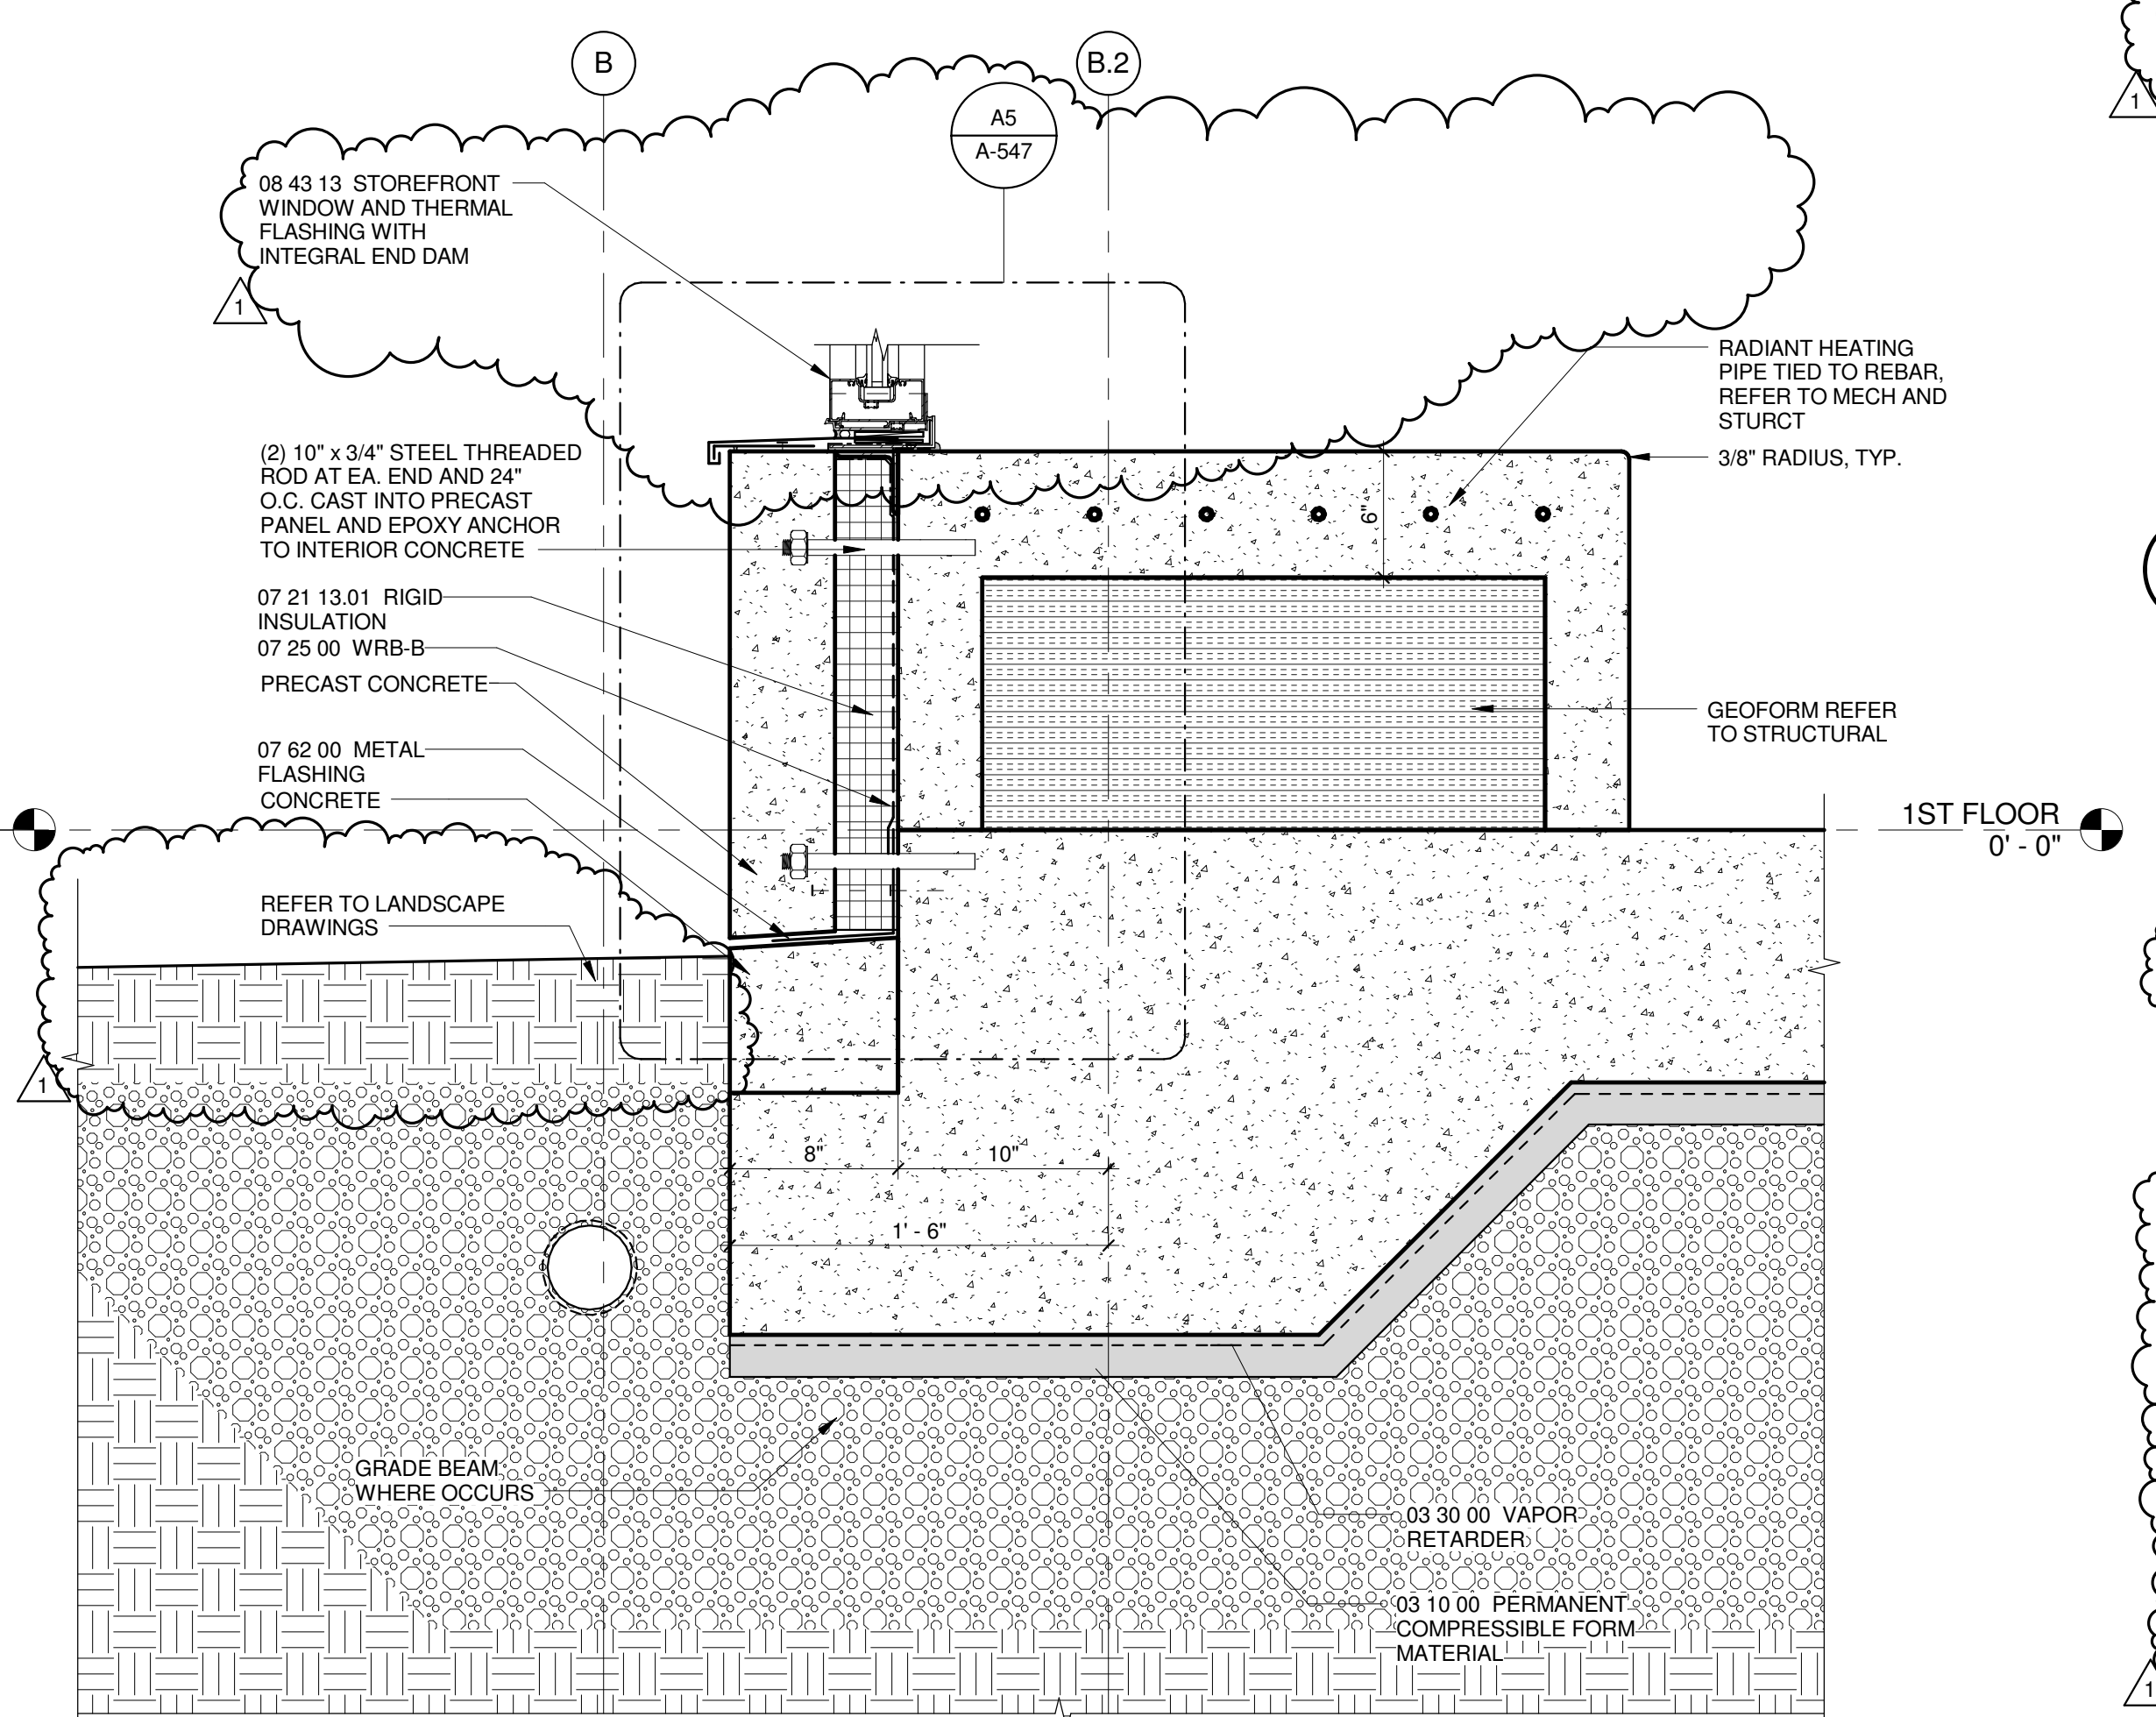


A2 SLAB EDGE AT ENTRY CONCRETE BENCH
1 1/2" = 1'-0"

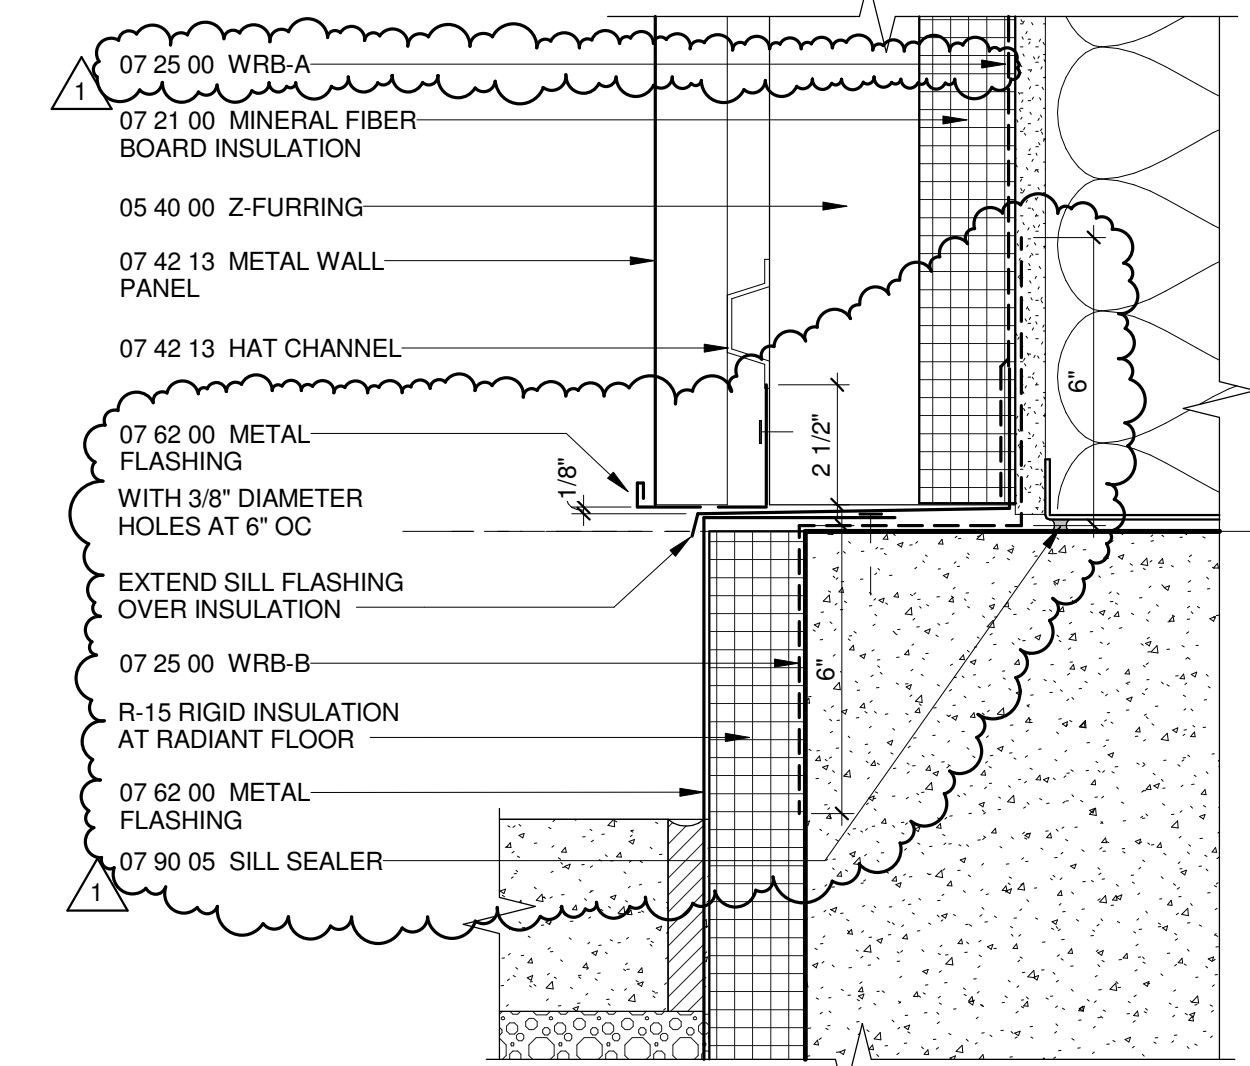


B4 SLAB EDGE AT METAL PANEL AT CONCRETE HEADER
3\"/>

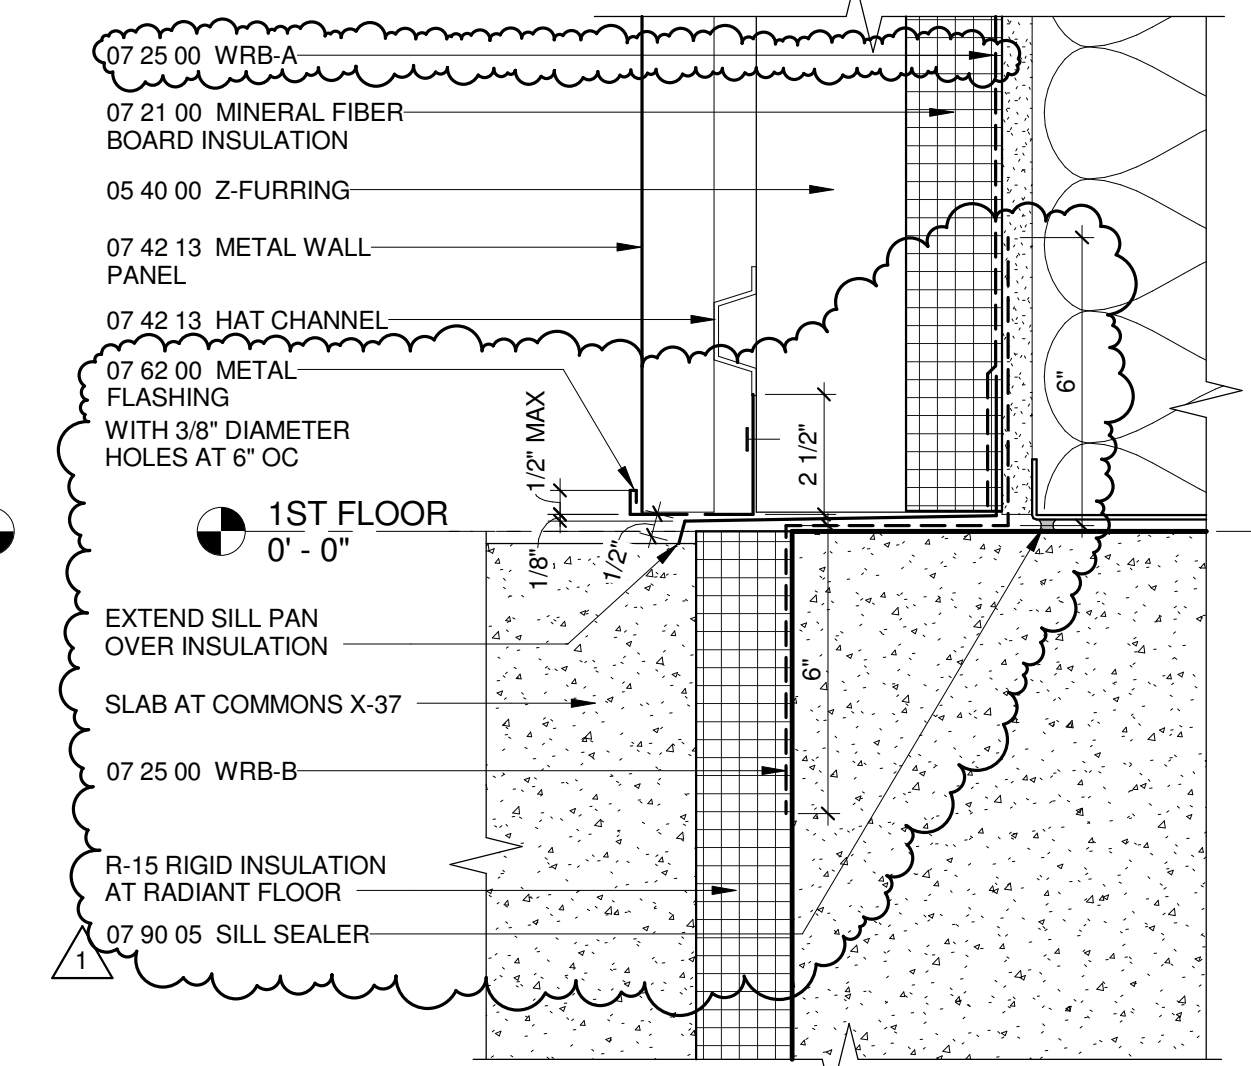

B5 SLAB EDGE AT METAL PANEL AT CONCRETE WALK
3\"/>

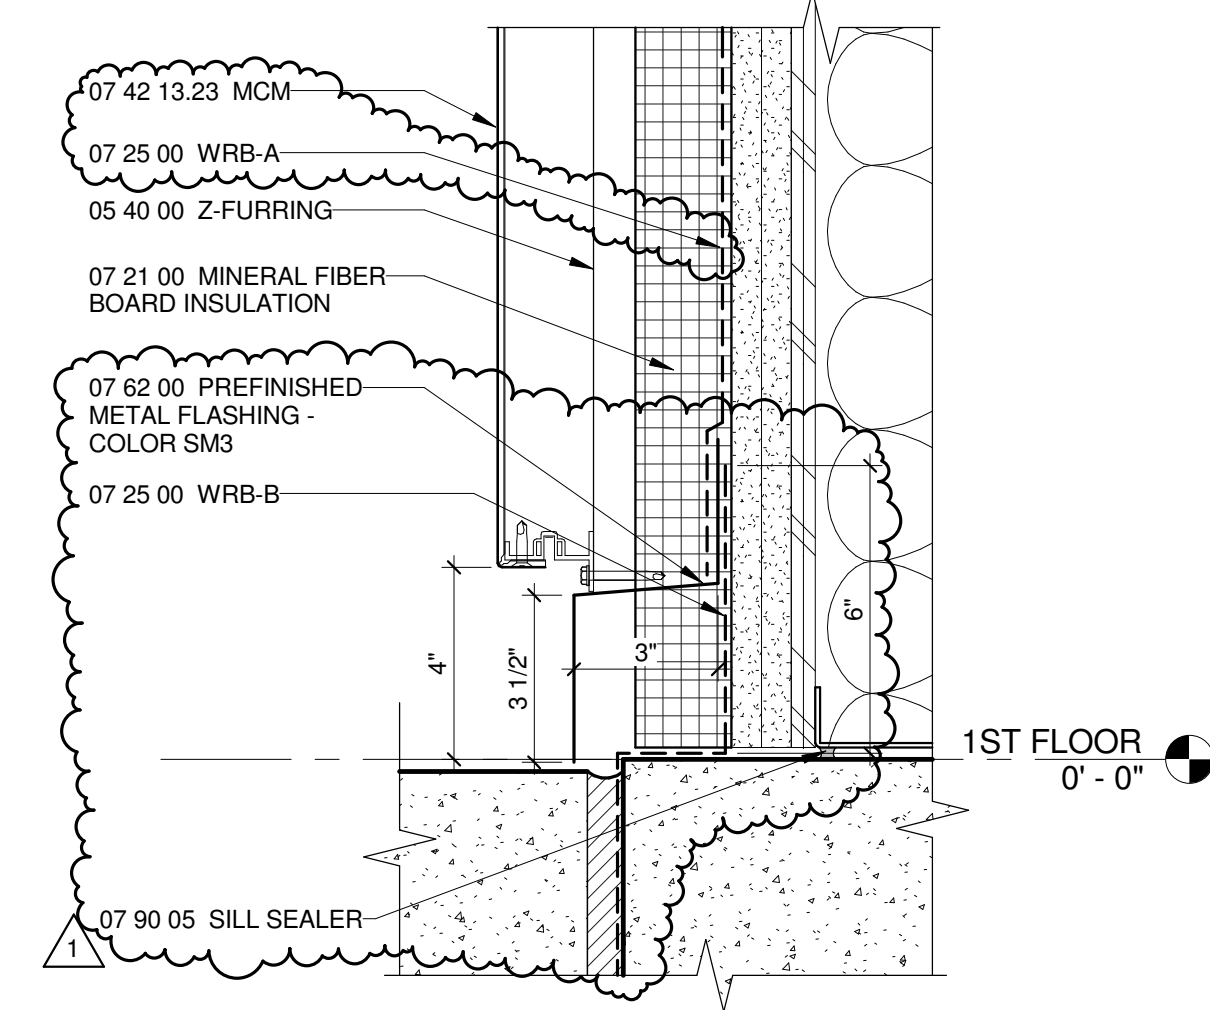

A4 SLAB EDGE AT MCM AT CONCRETE WALK
3\"/>


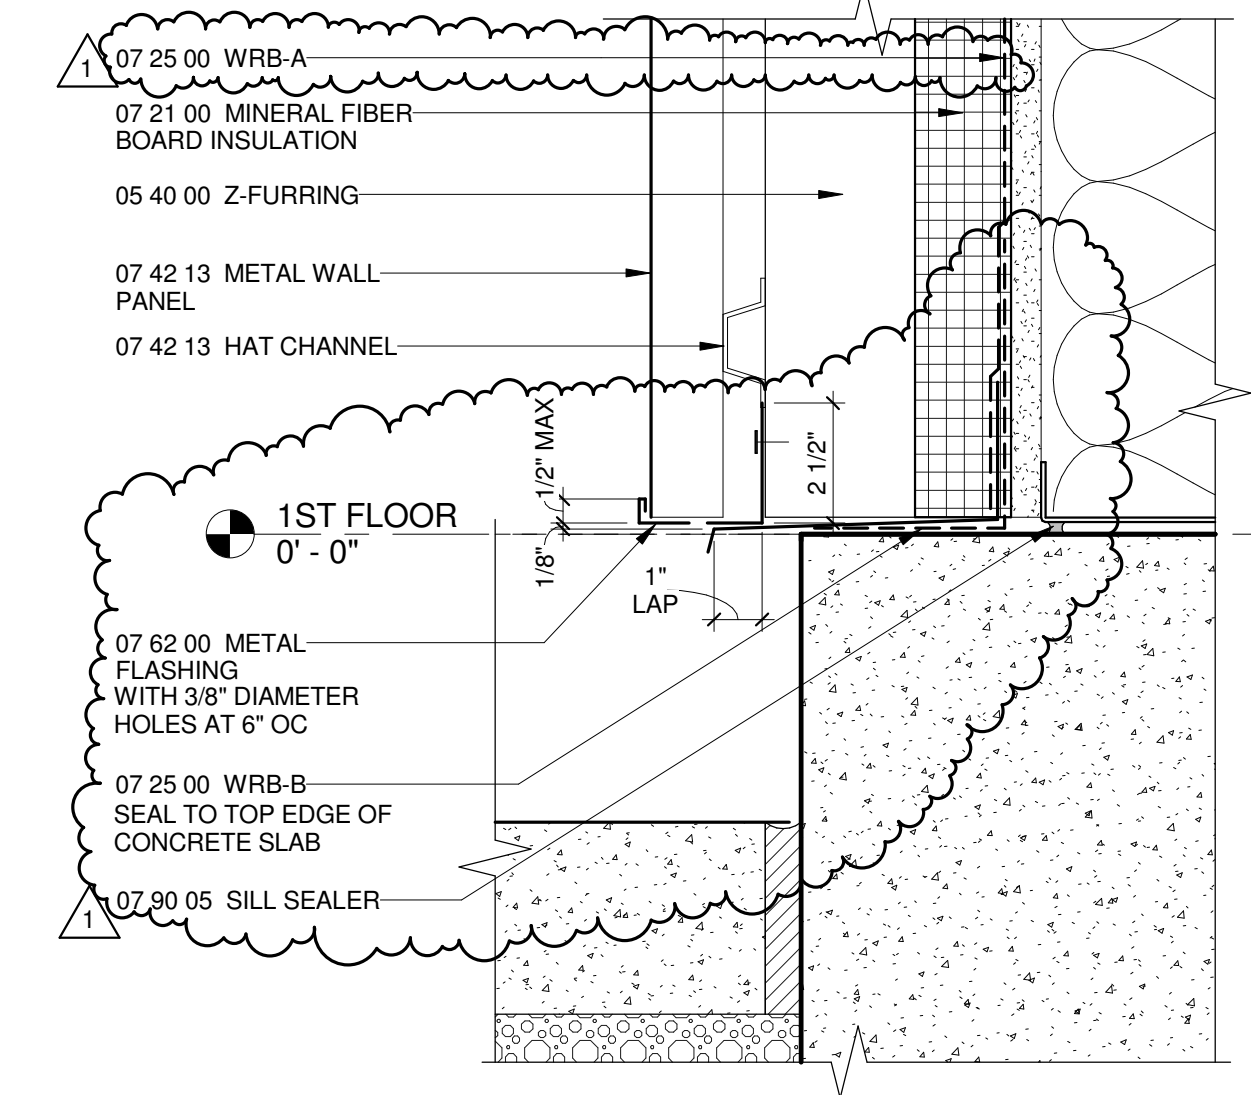


A5 SLAB EDGE AT METAL PANEL
3\"/>


MARK	DATE	DESCRIPTION
1	3-13-2015	ADDENDUM 6

ISSUE DATE:	FEBRUARY 18, 2015
ISSUE:	CONSTRUCTION DOCUMENTS
VOLUME:	PACKAGE 2 VOLUME 1
PROJECT NO.:	2013912.00
DRAWN BY:	MEB
CHECKED BY:	DG


EXTERIOR DETAILS - FOUNDATION

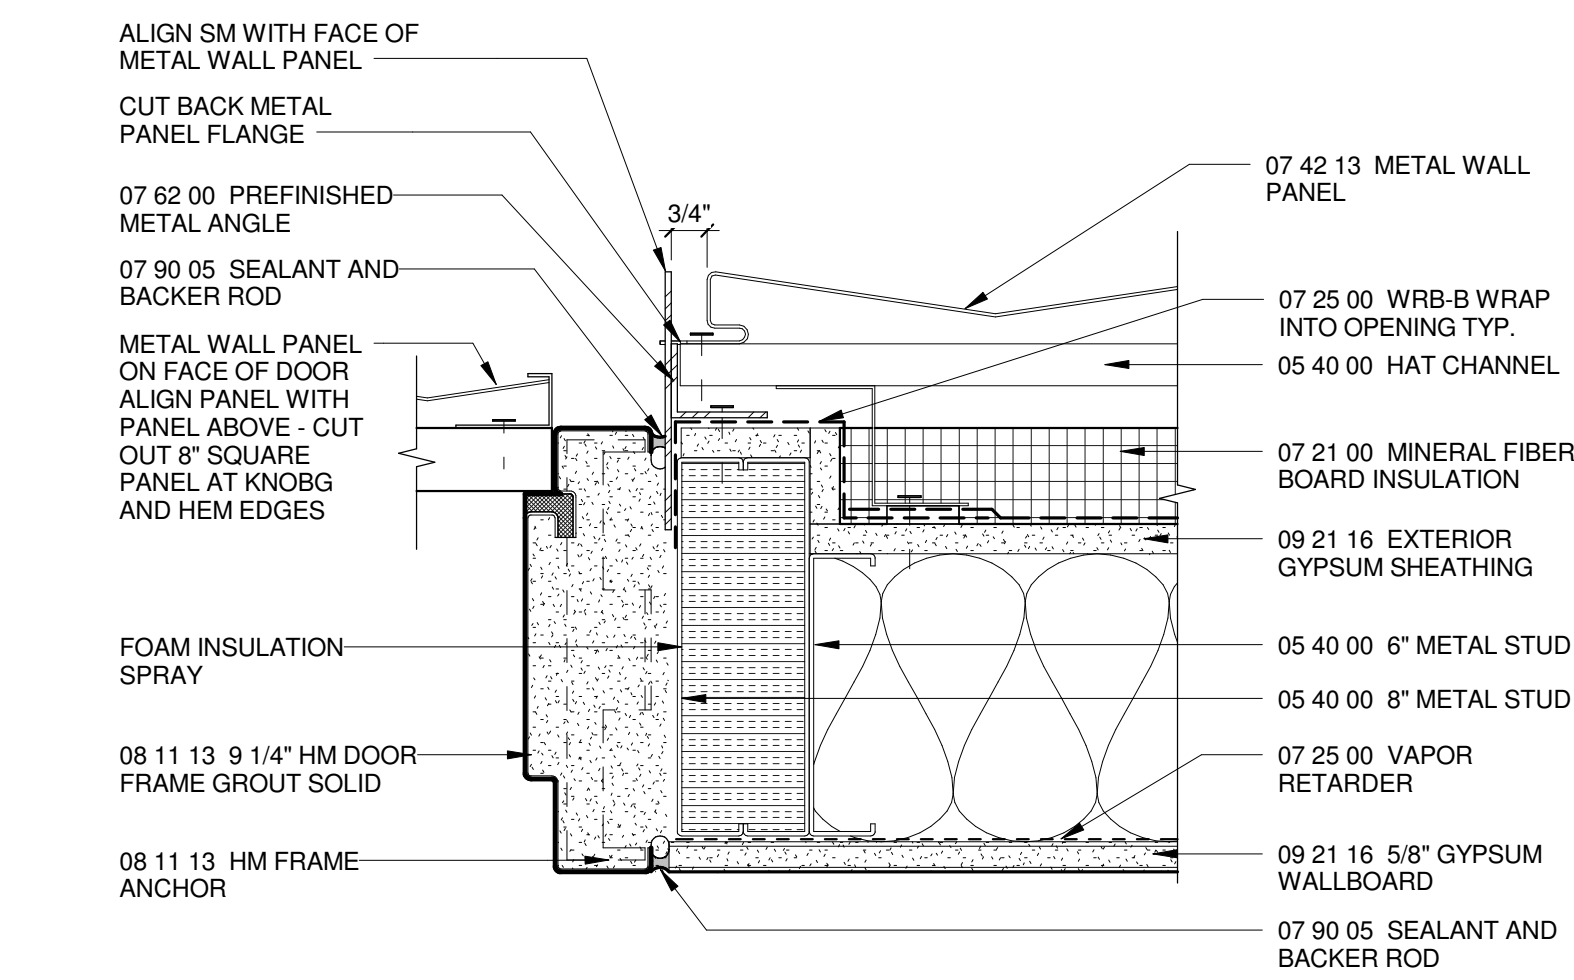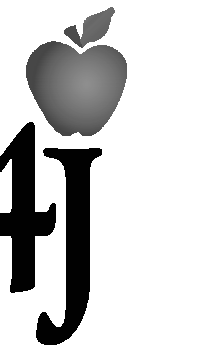


D2 HM DOOR JAMB AT ROOF ACCESS
 3" = 1'-0"

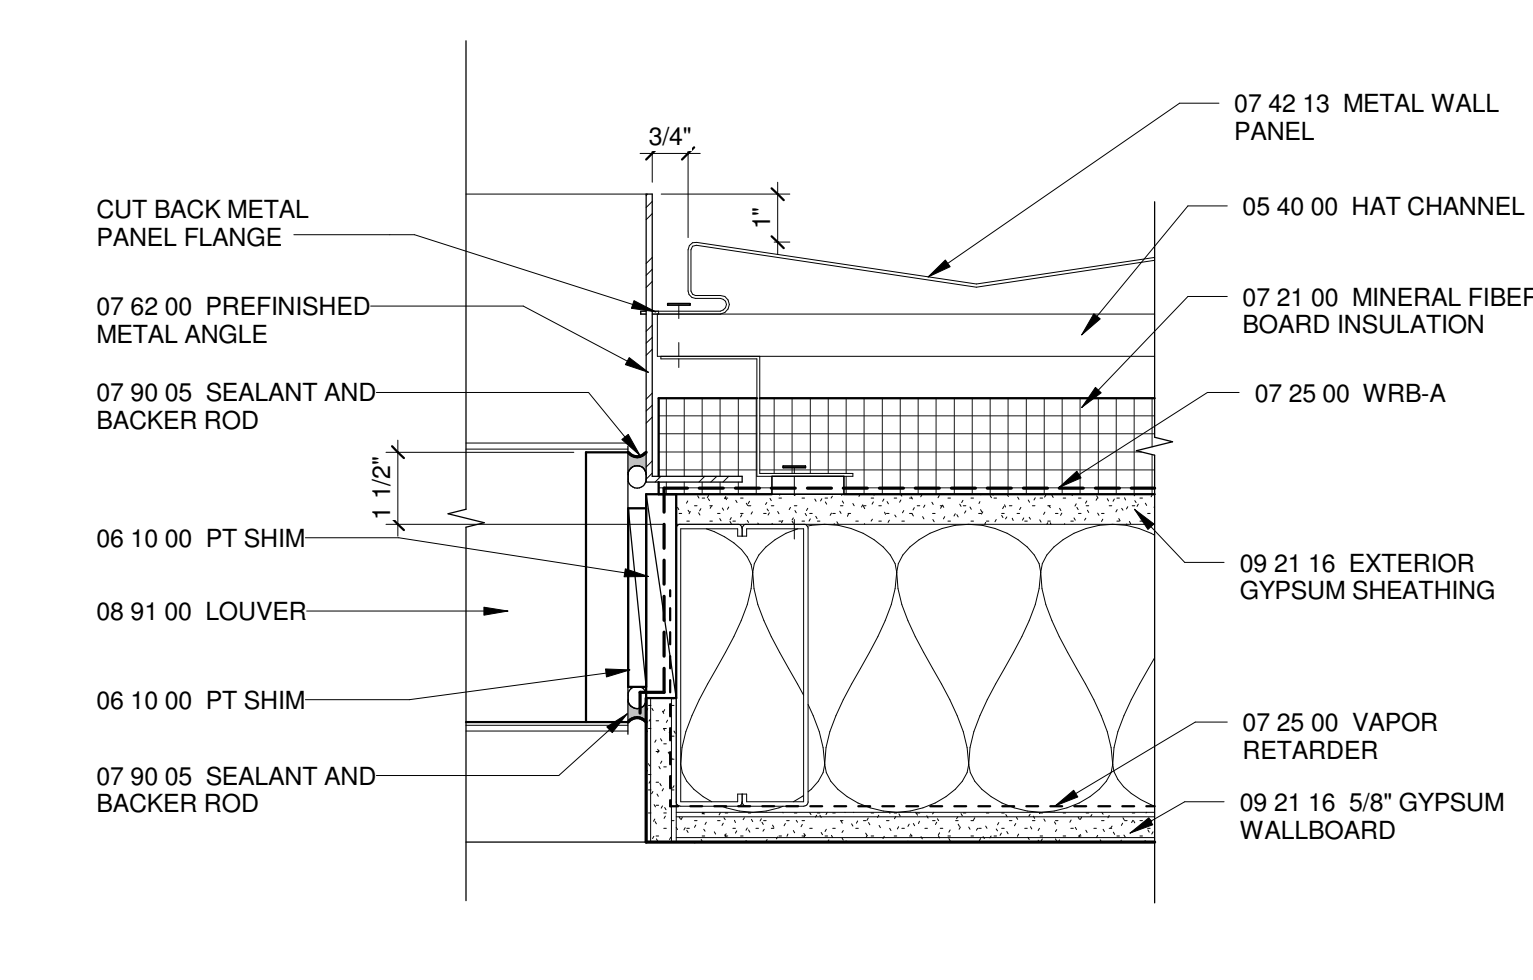


D4 LOUVER JAMB AT METAL WALL PANEL
 3" = 1'-0"

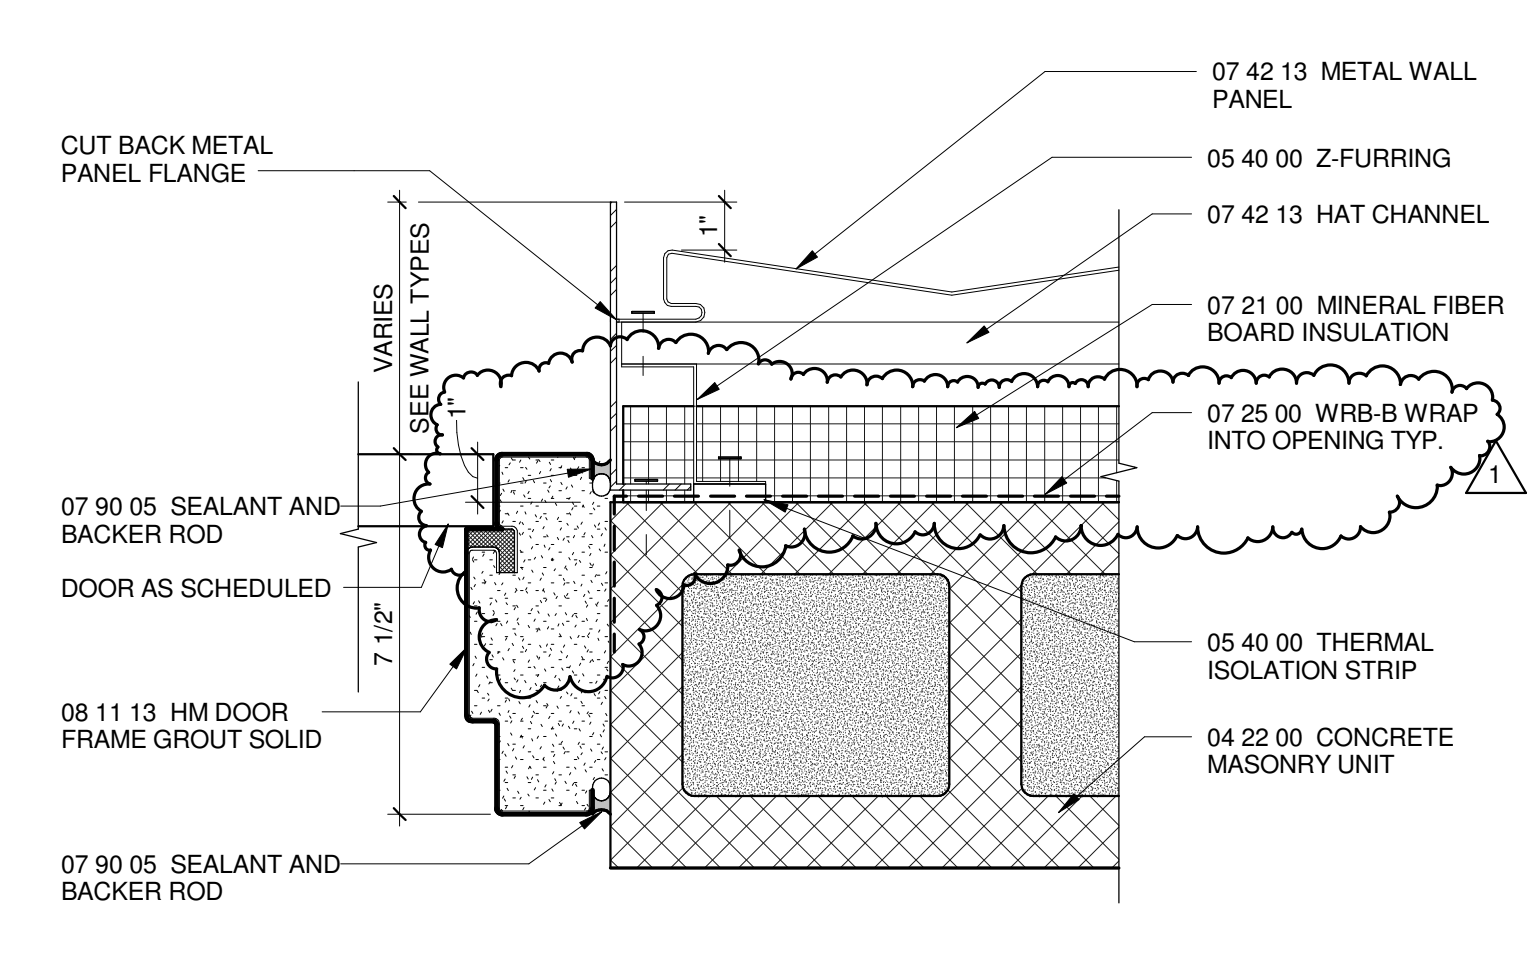


D5 HM DOOR JAMB AT METAL WALL PANEL
 3" = 1'-0"

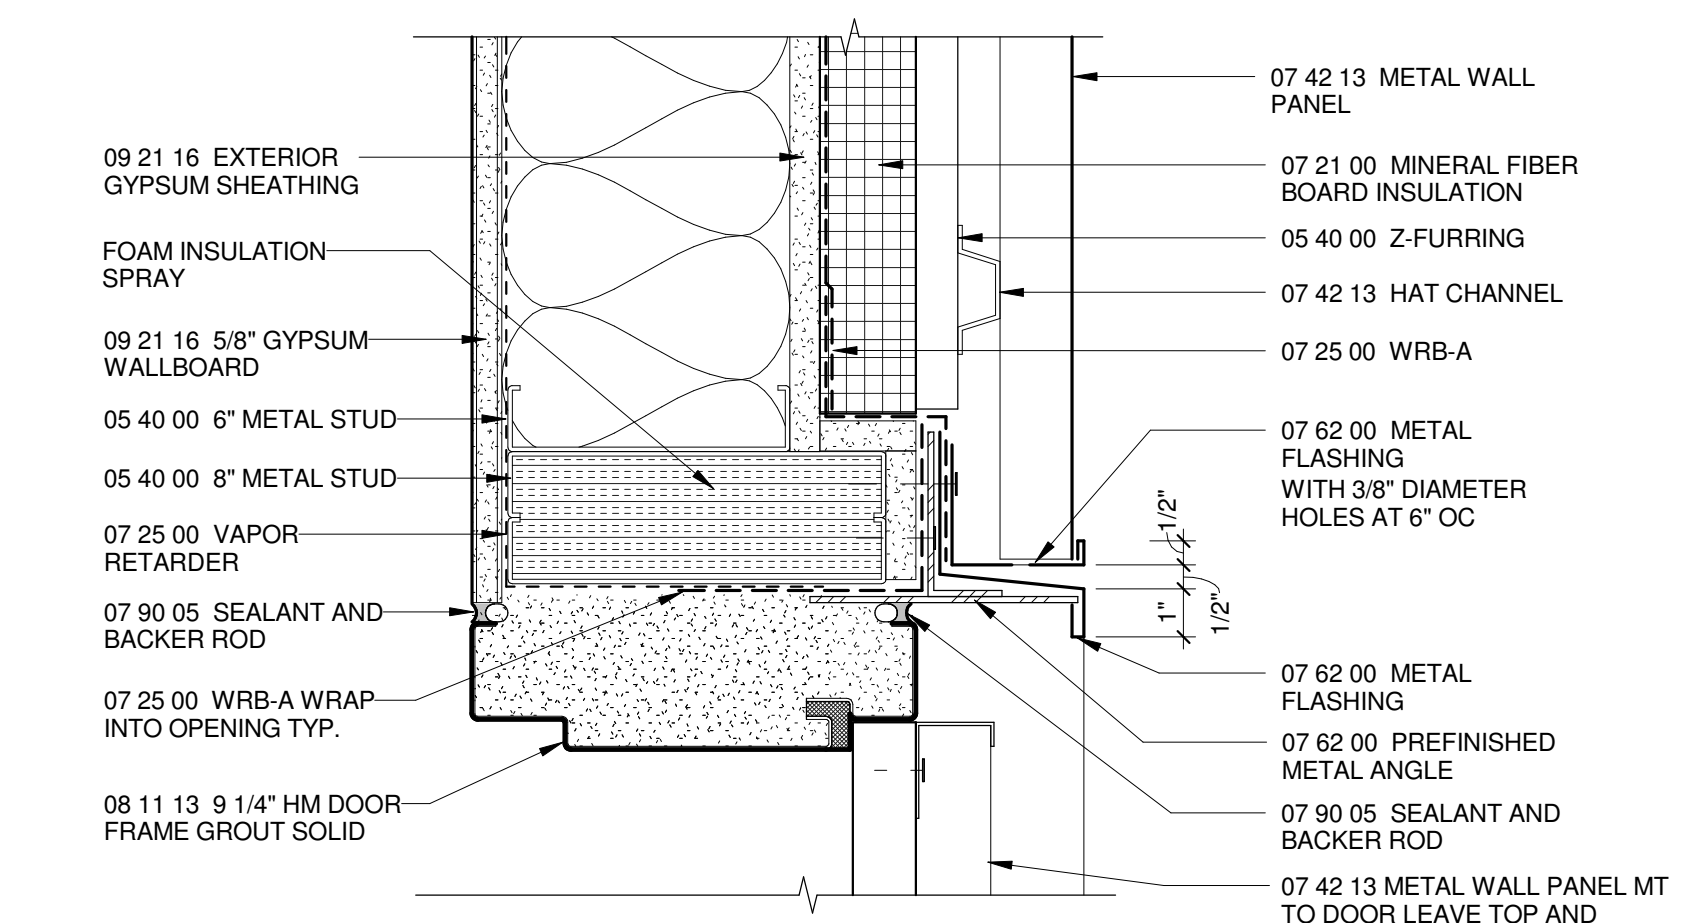


C2 HM DOOR HEAD AT ROOF ACCESS
 3" = 1'-0"

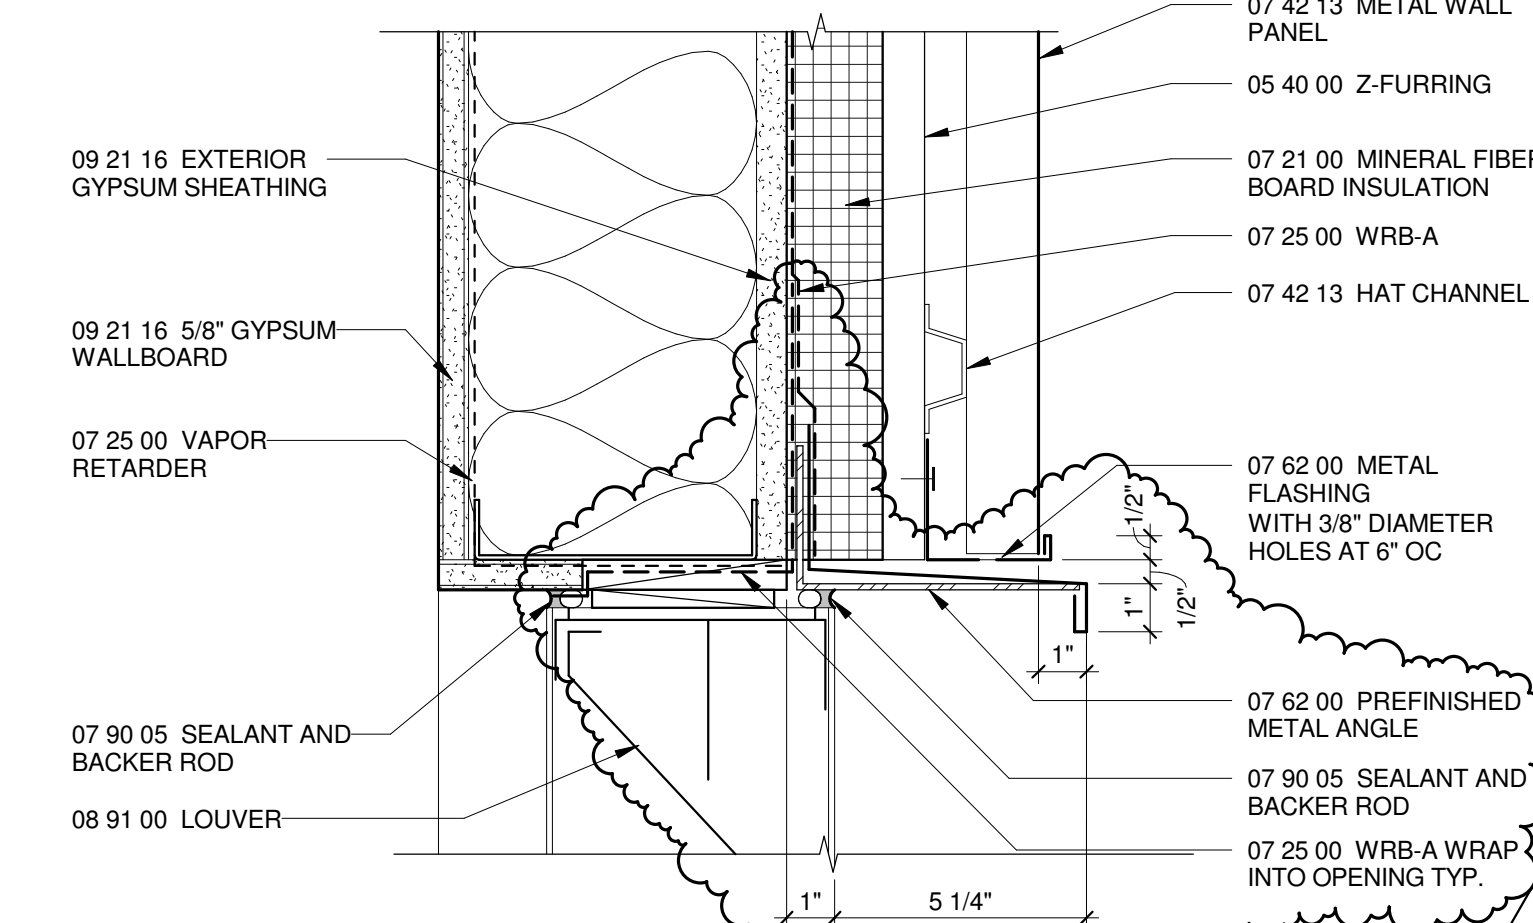


C4 LOUVER HEAD AT METAL WALL PANEL
 3" = 1'-0"

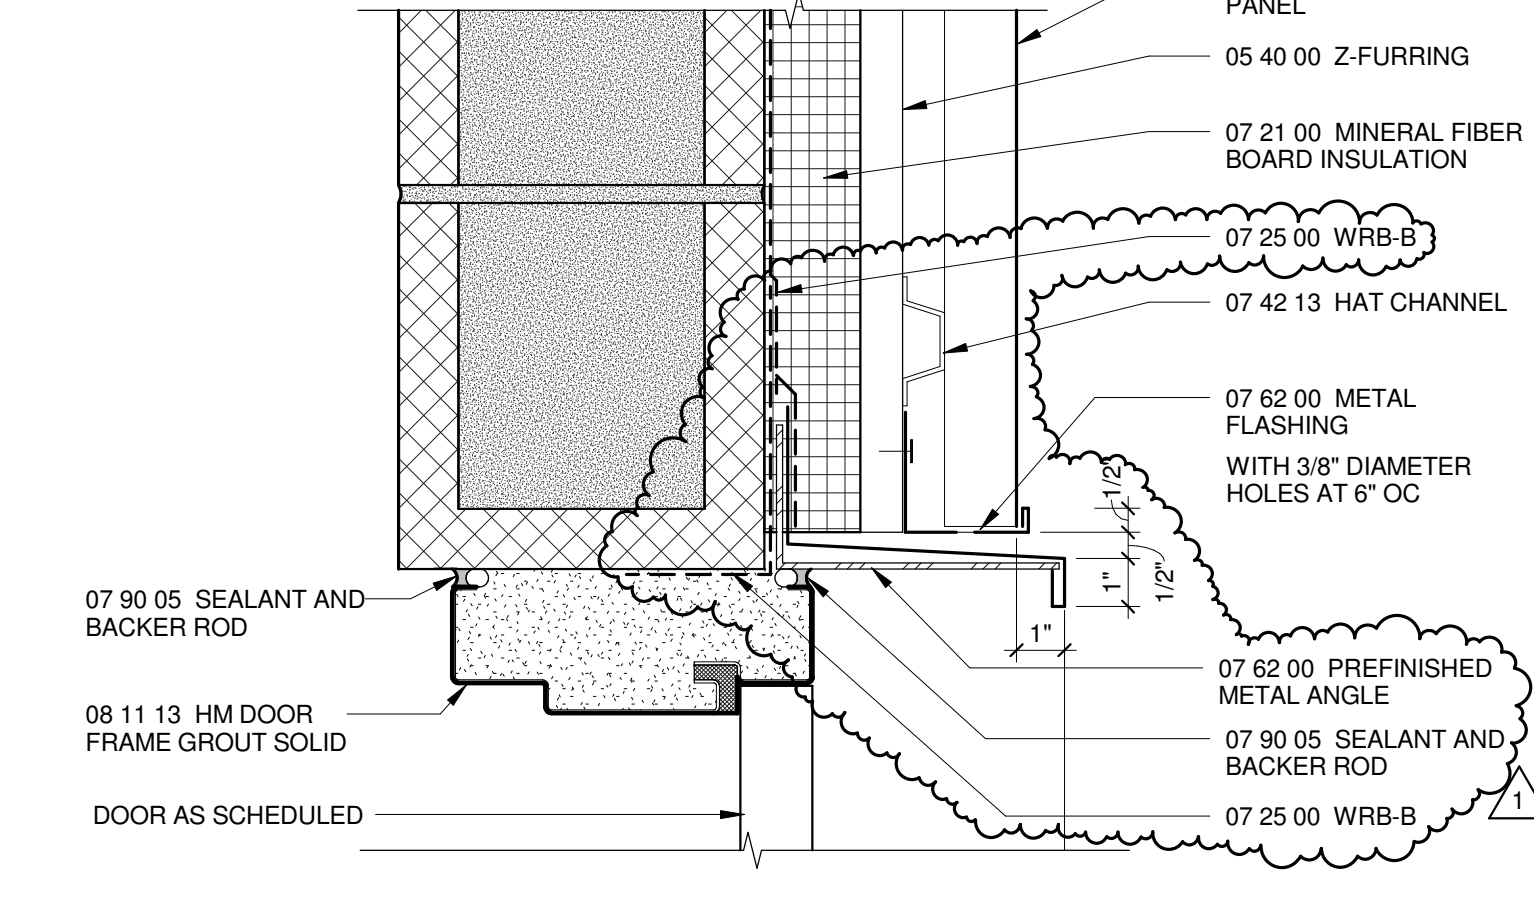


C5 HM DOOR HEAD AT METAL WALL PANEL
 3" = 1'-0"

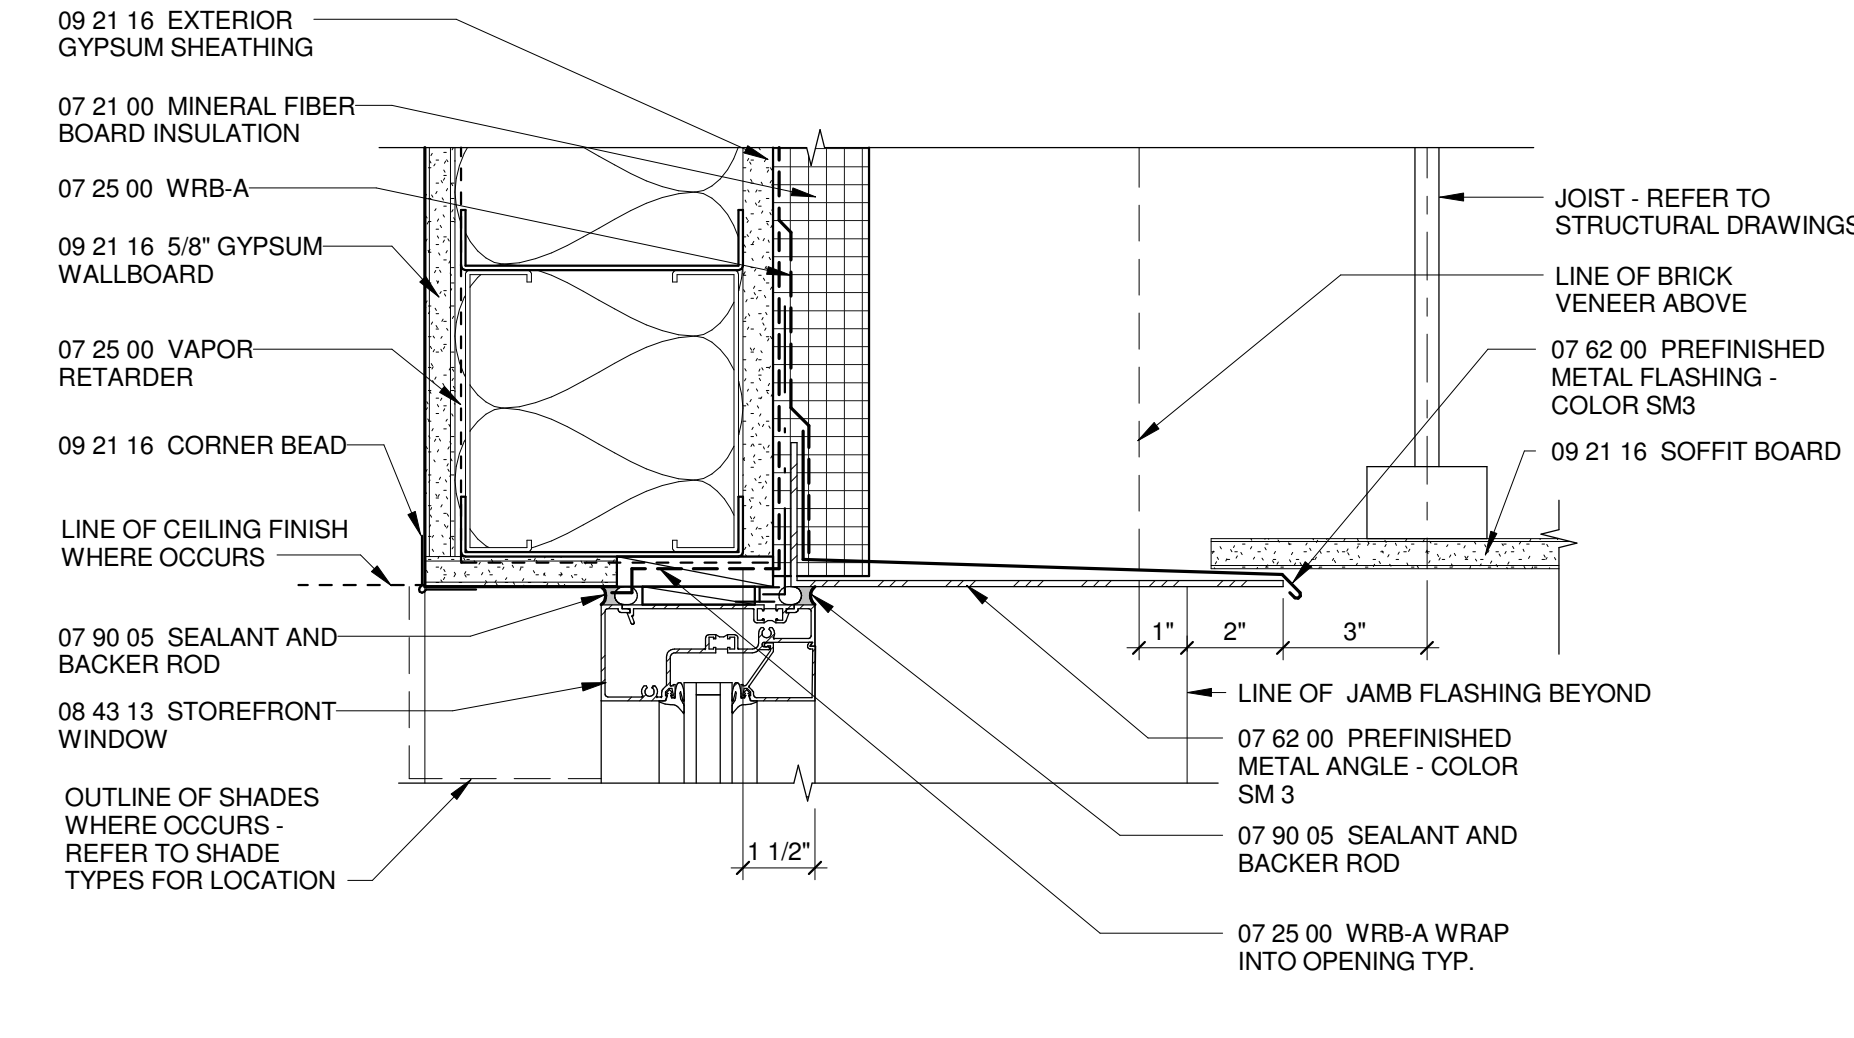


B1 STOREFRONT HEAD AT COVERED WALK
 3" = 1'-0"

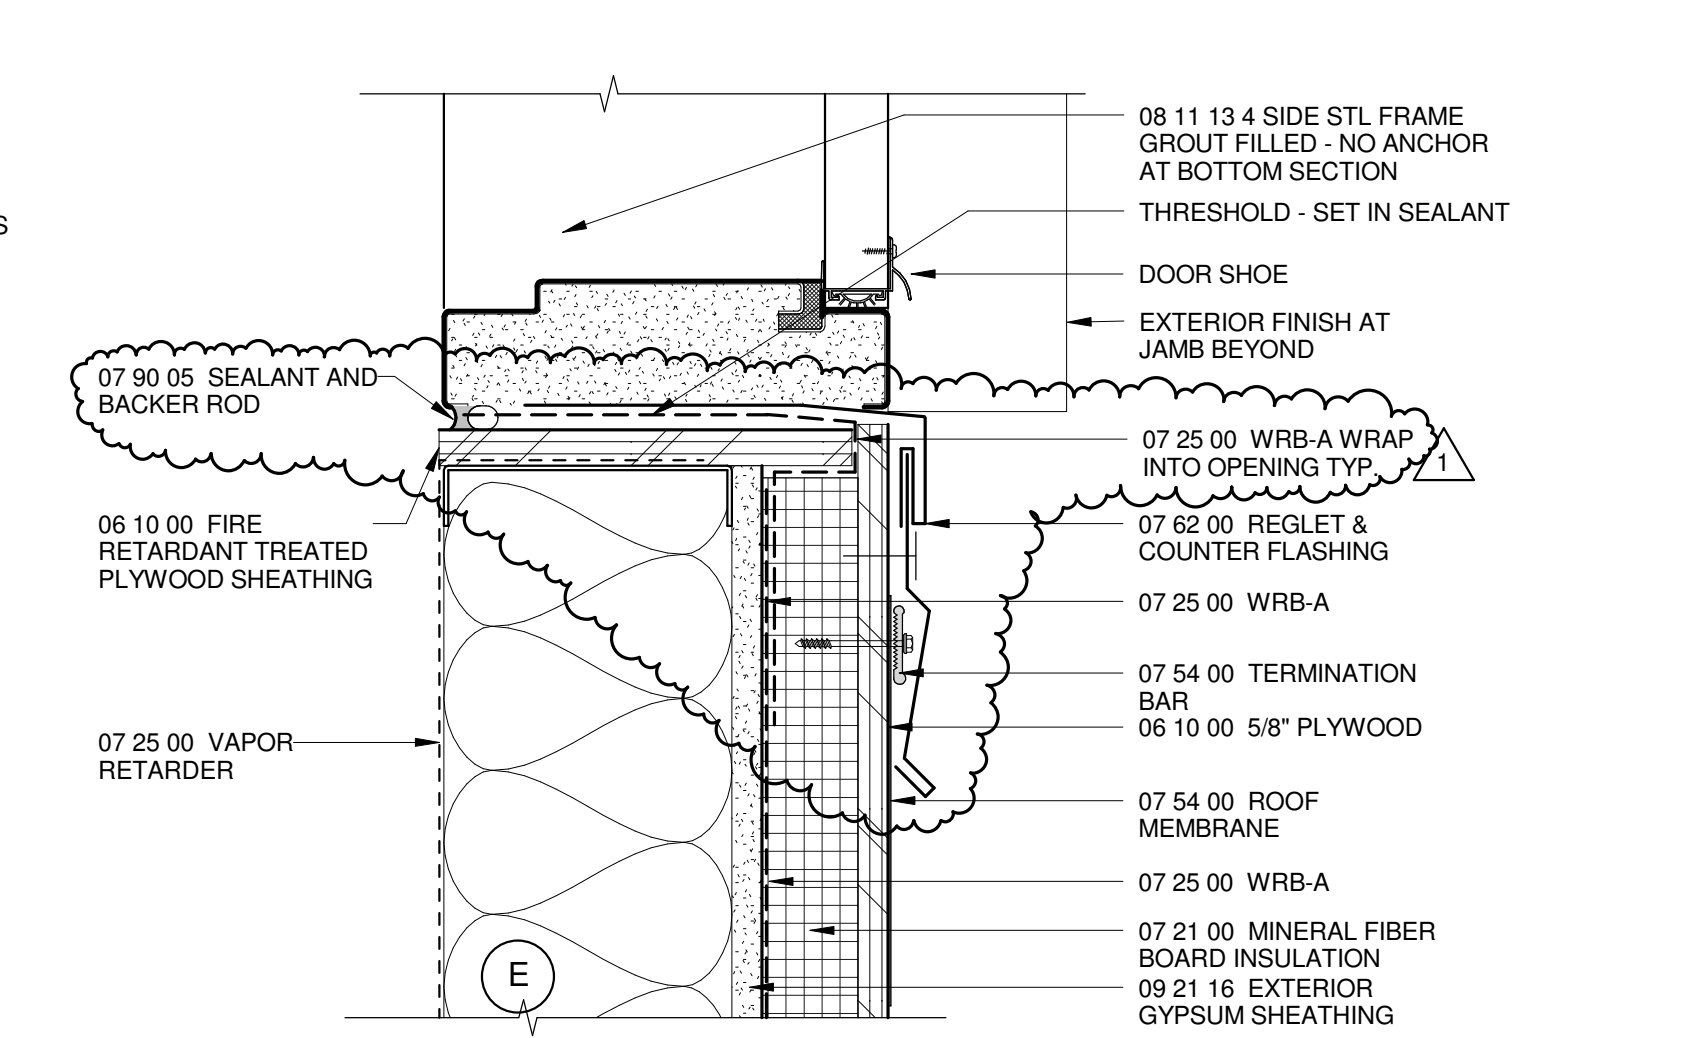


B2 HM THRESHOLD AT ACCESS DOOR
 3" = 1'-0"

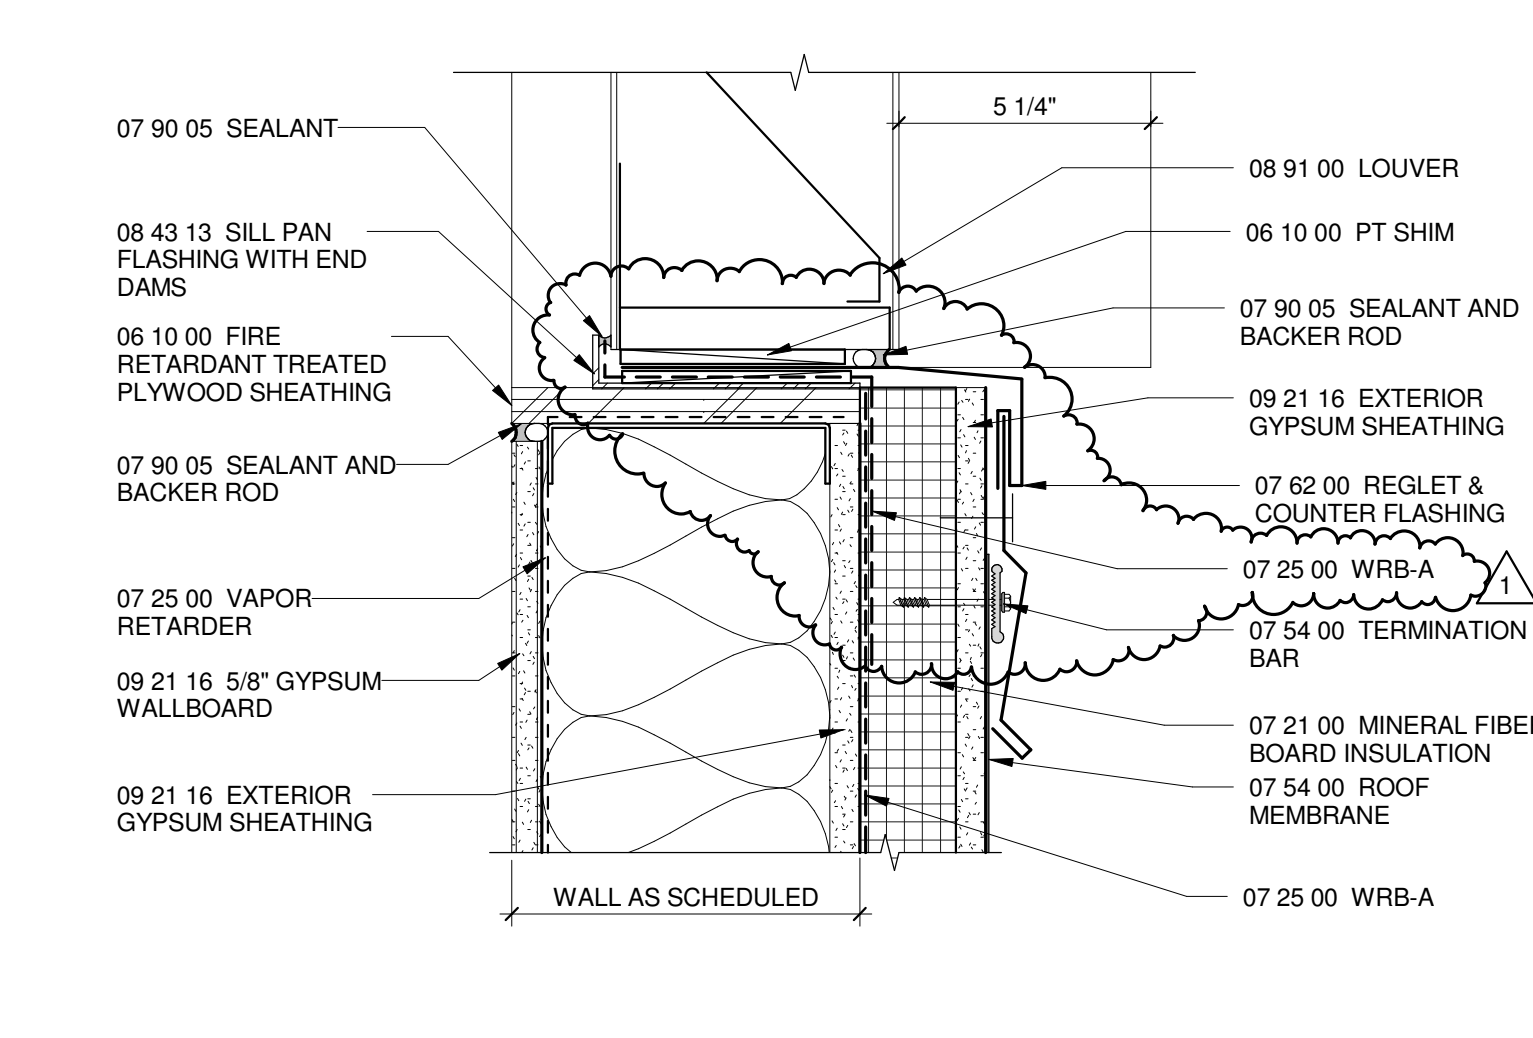

B4 LOUVER SILL AT METAL WALL PANEL
 3" = 1'-0"

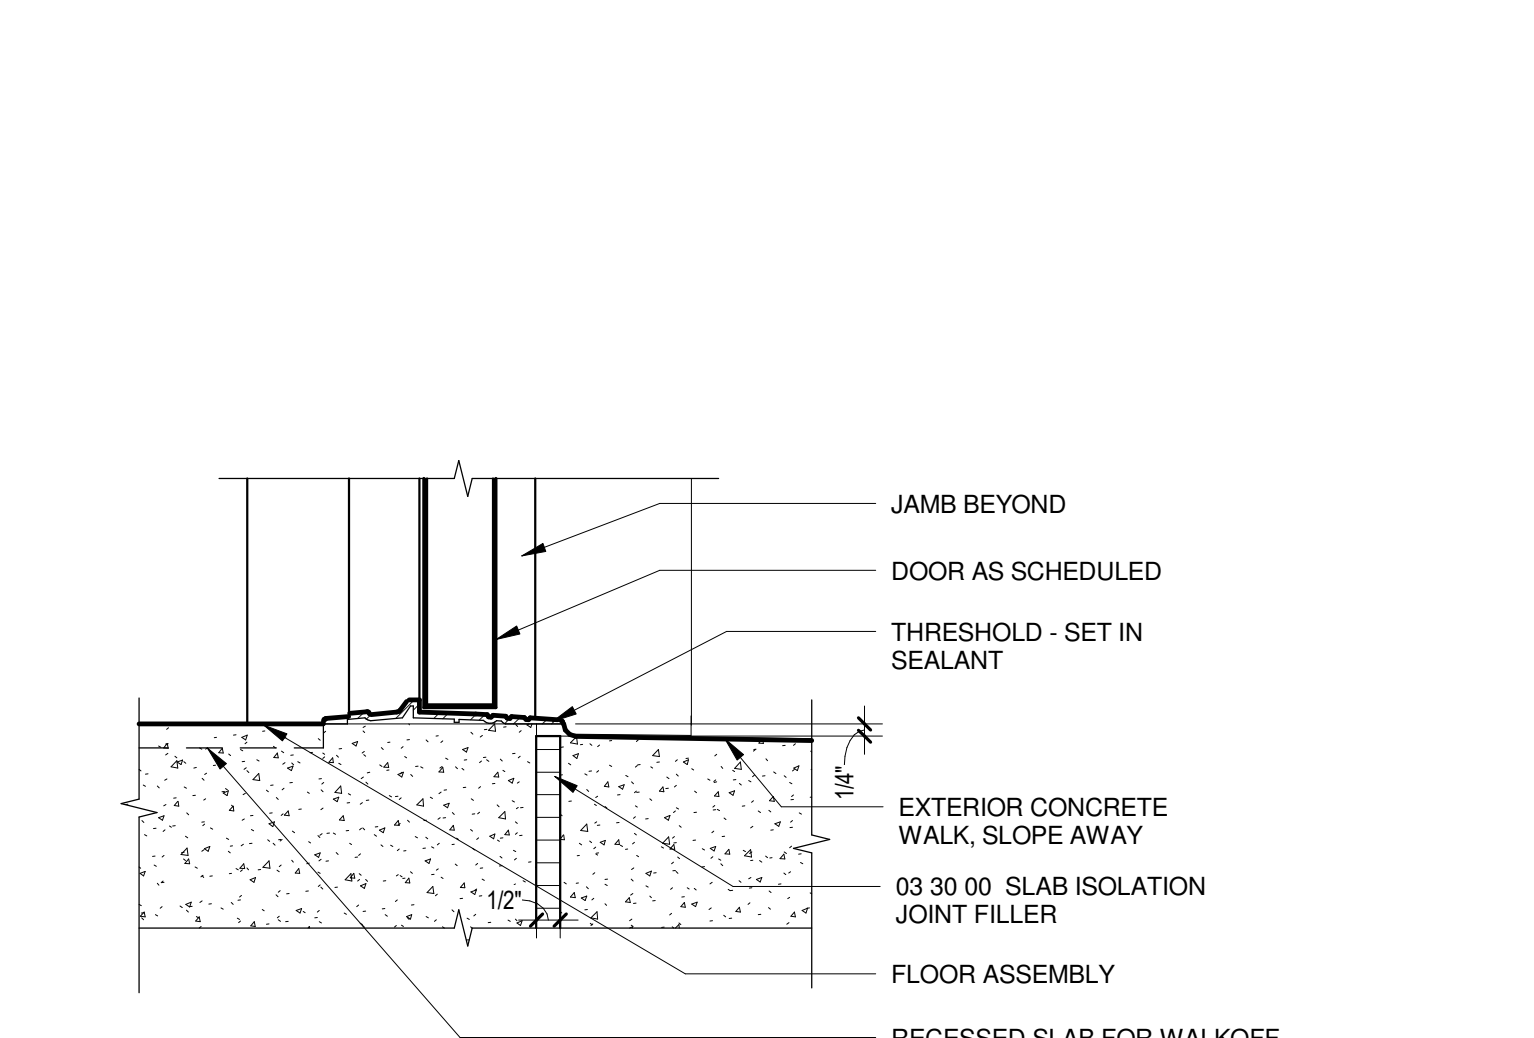

B5 EXTERIOR DOOR THRESHOLD
 3" = 1'-0"

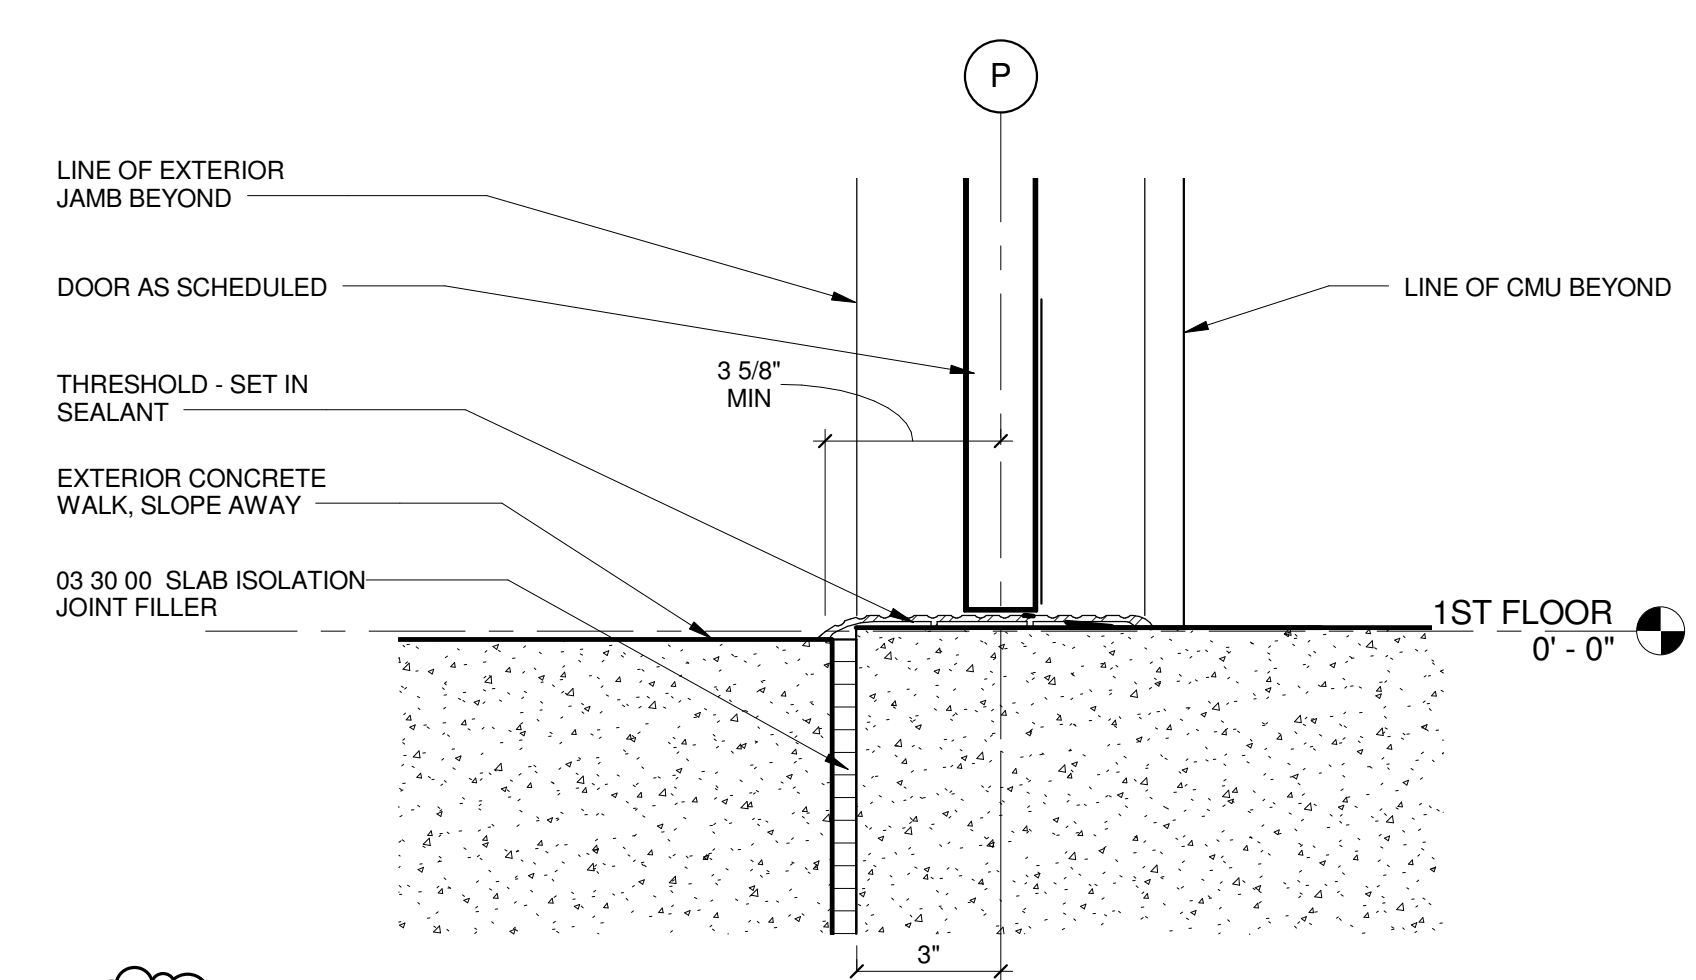

A2 SLAB EDGE AT DOOR B3 (ELEC AND MECH)
 3" = 1'-0"

DETAIL NOT USED


DETAIL NOT USED

MARK	DATE	DESCRIPTION
1	3-13-2015	ADDENDUM 6


ISSUE DATE:	FEBRUARY 18, 2015
ISSUE:	CONSTRUCTION DOCUMENTS
VOLUME:	PACKAGE 2 VOLUME 1
PROJECT NO.:	2013912.00
DRAWN BY:	LS
CHECKED BY:	DG
COPYRIGHT MAHLUM ARCHITECTS, INC. 2014 ORIGINAL SHEET SIZE: 30" x 42"	

EXTERIOR DOOR AND LOUVER DETAILS


3/13/2015 1:42:02 PM \\SRV\ER\Drawings\A Documents\2013912\A-541.dwg: Jmt, rvc

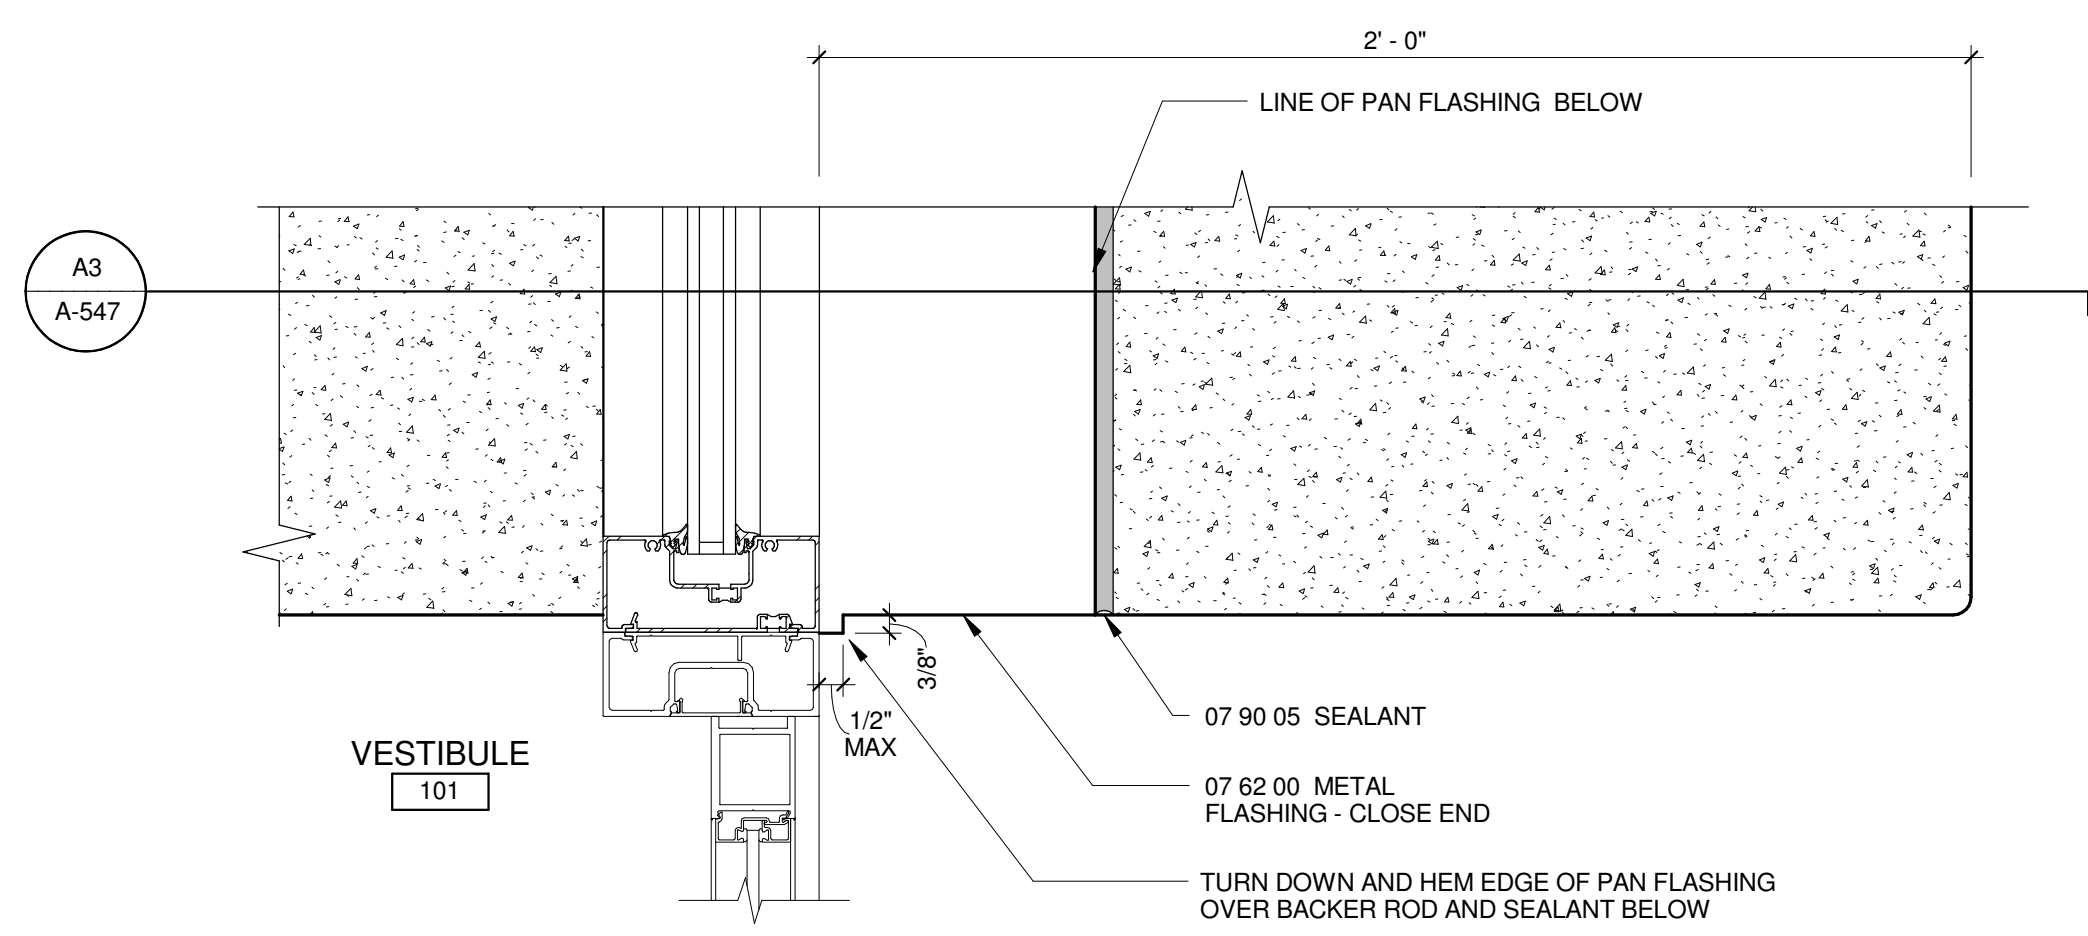


D1 ENTRY DOOR JAMB AT WINDOW
3" = 1'-0"

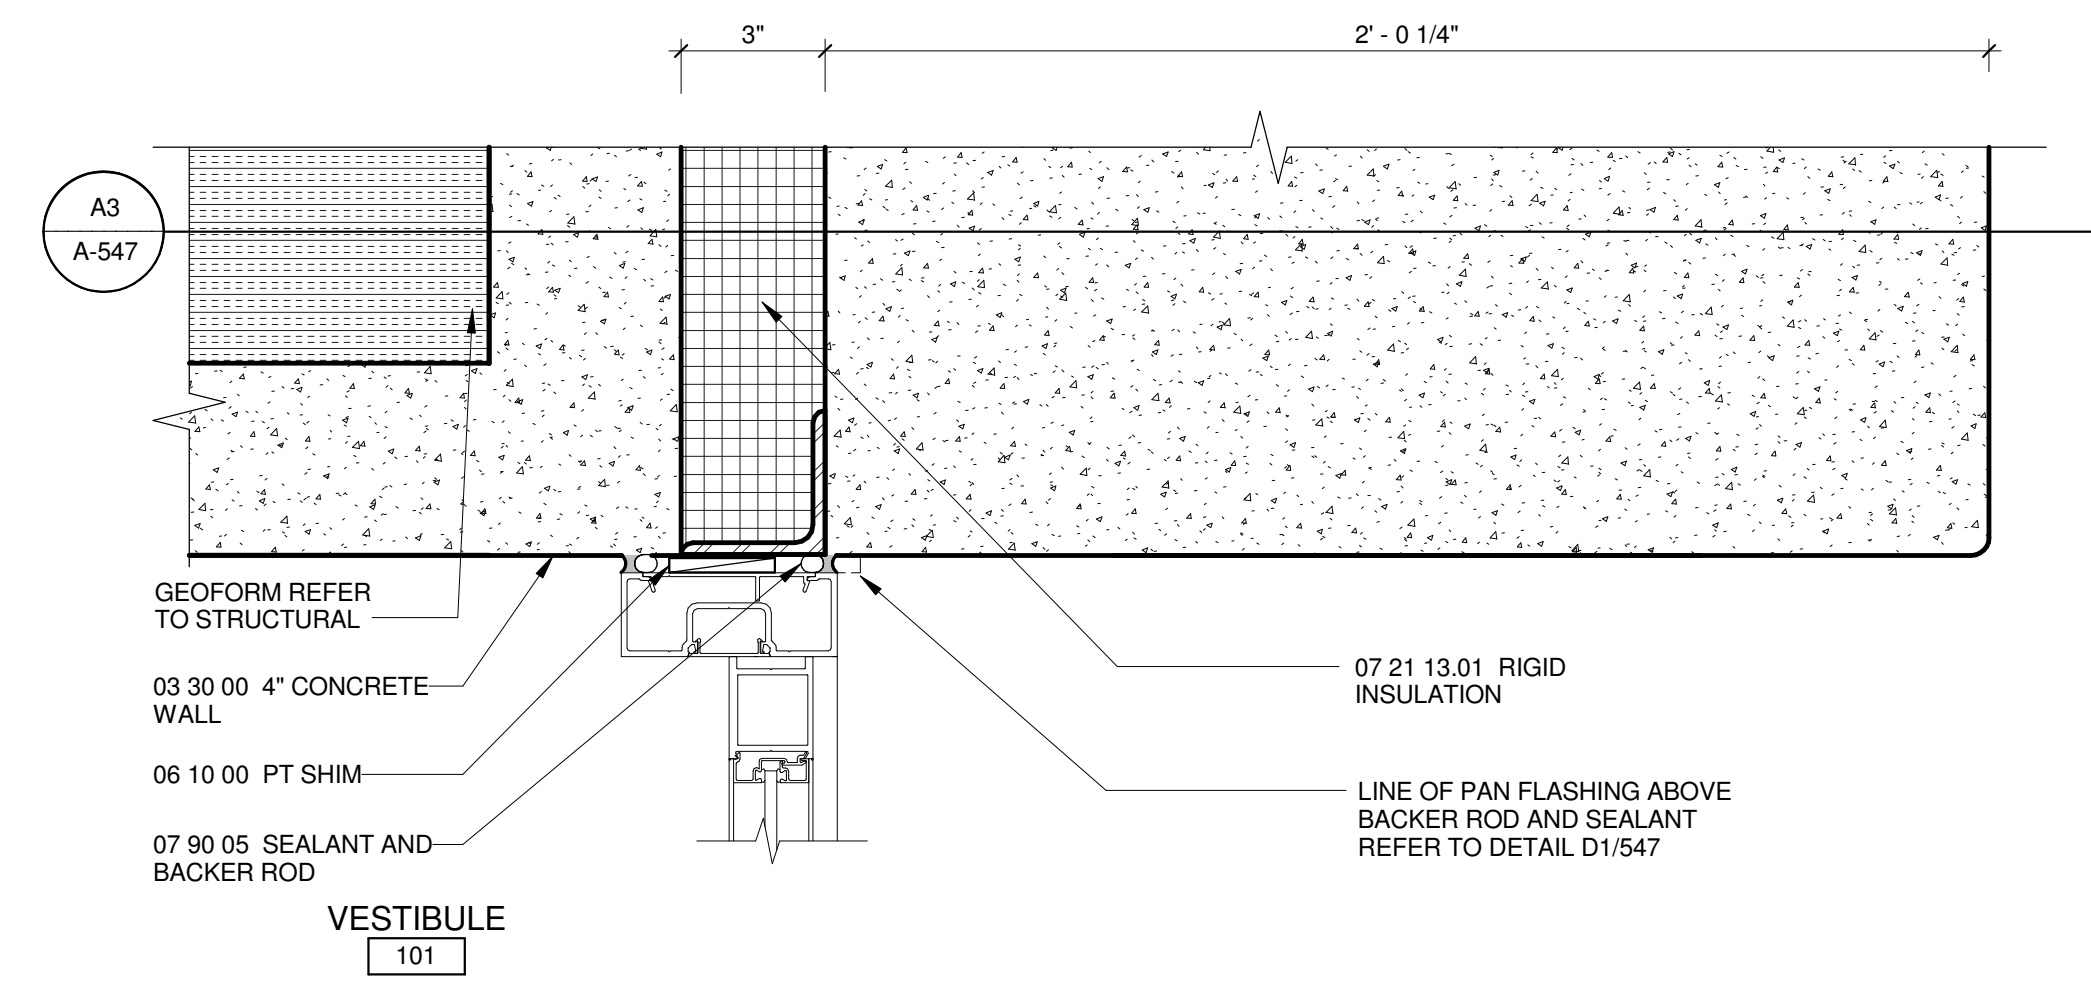


D3 ENTRY DOOR JAMB AT CONCRETE BENCH
3" = 1'-0"

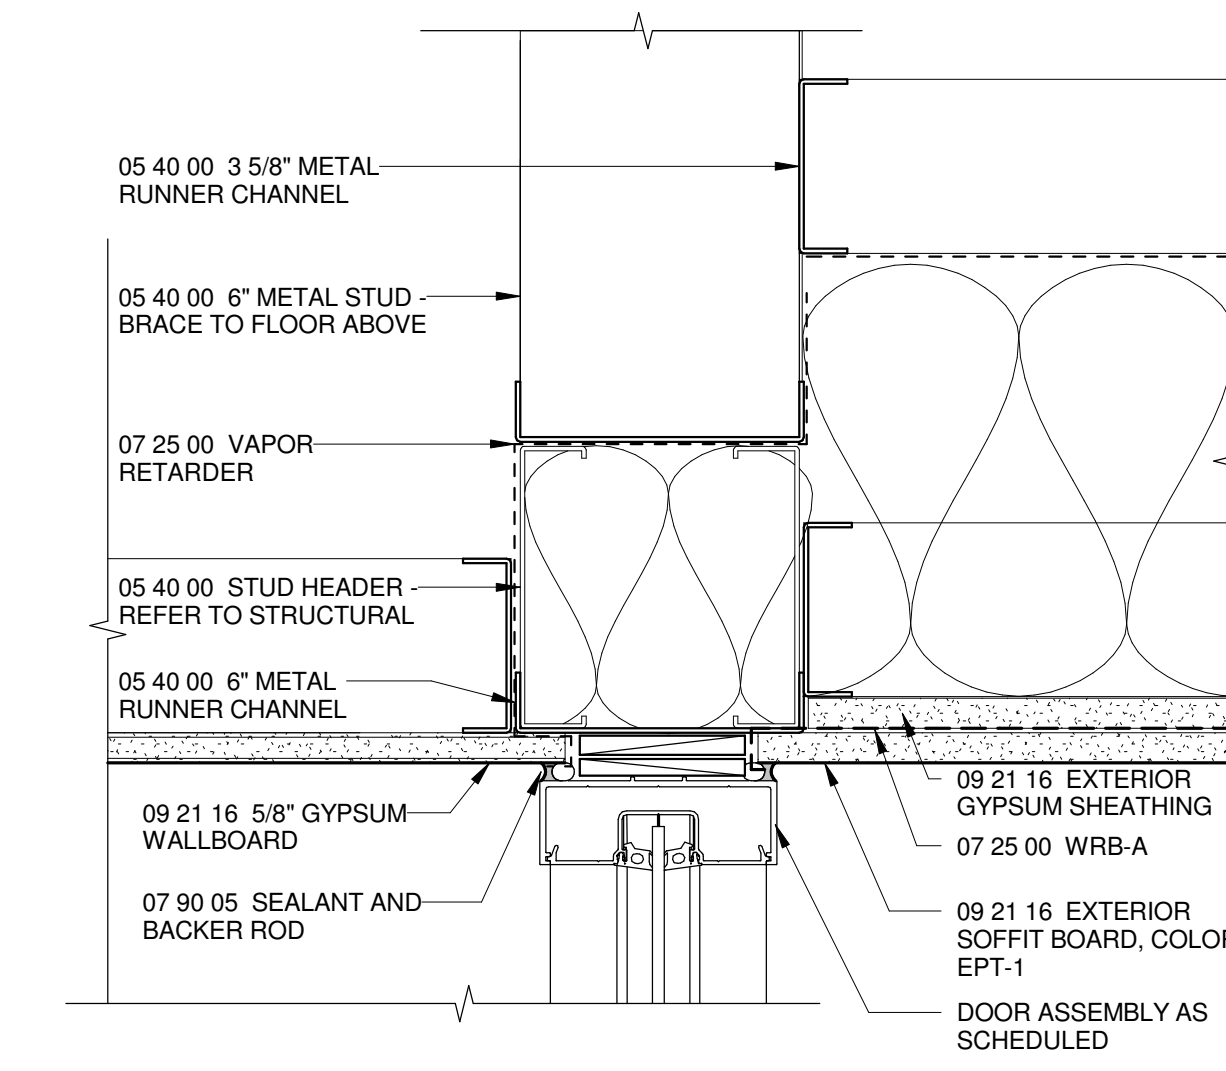


D5 ENTRY DOOR HEAD
3" = 1'-0"

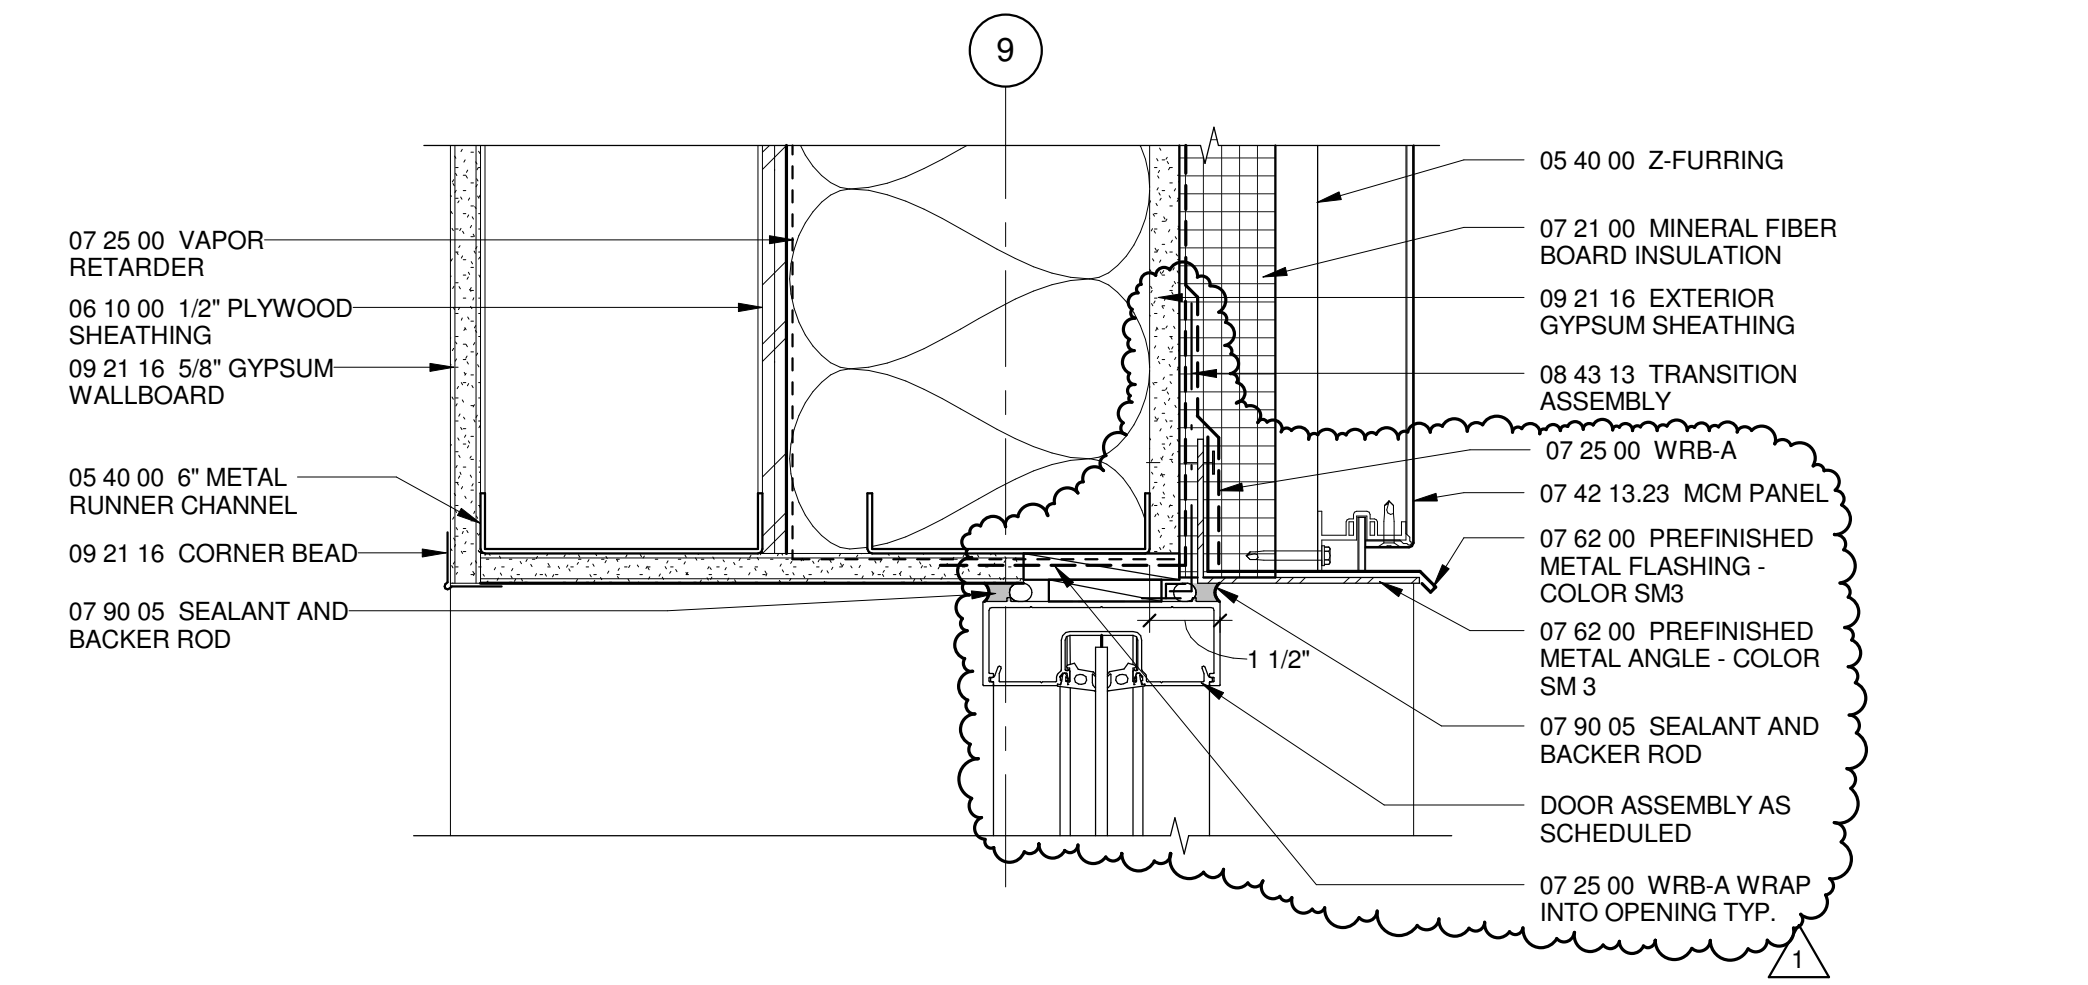


C1 AUTOMATIC DOOR HEAD AT MCM
3" = 1'-0"

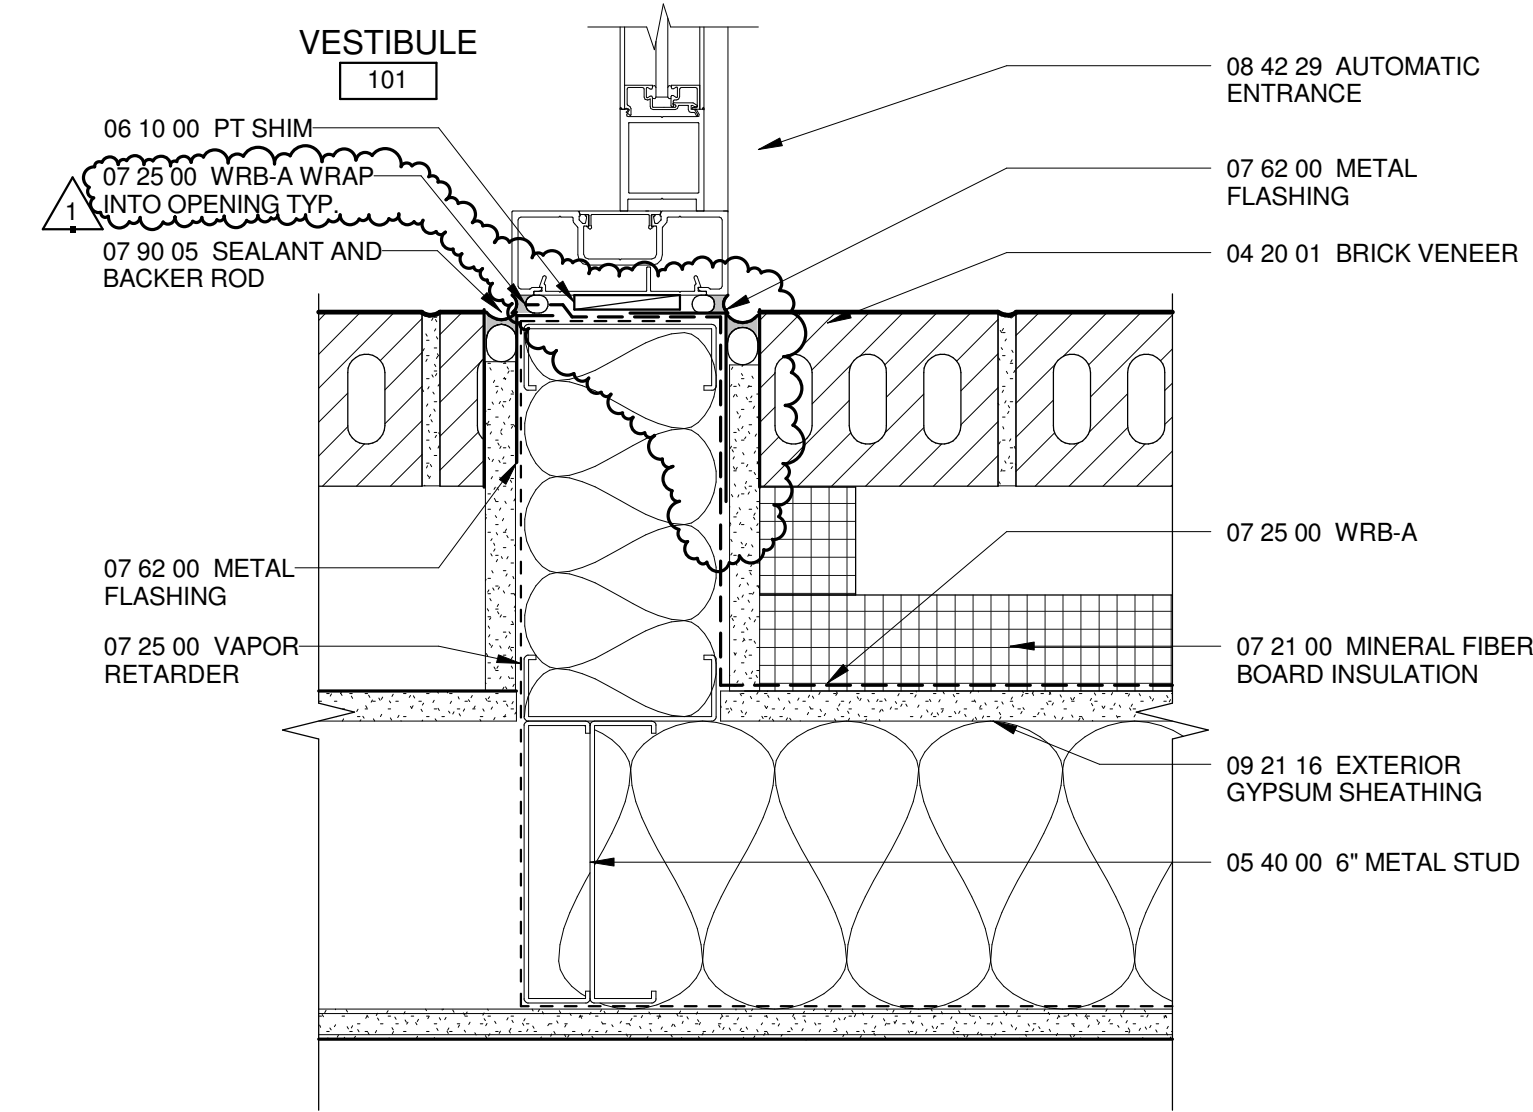


C3 ENTRY DOOR JAMB AT BRICK
3" = 1'-0"

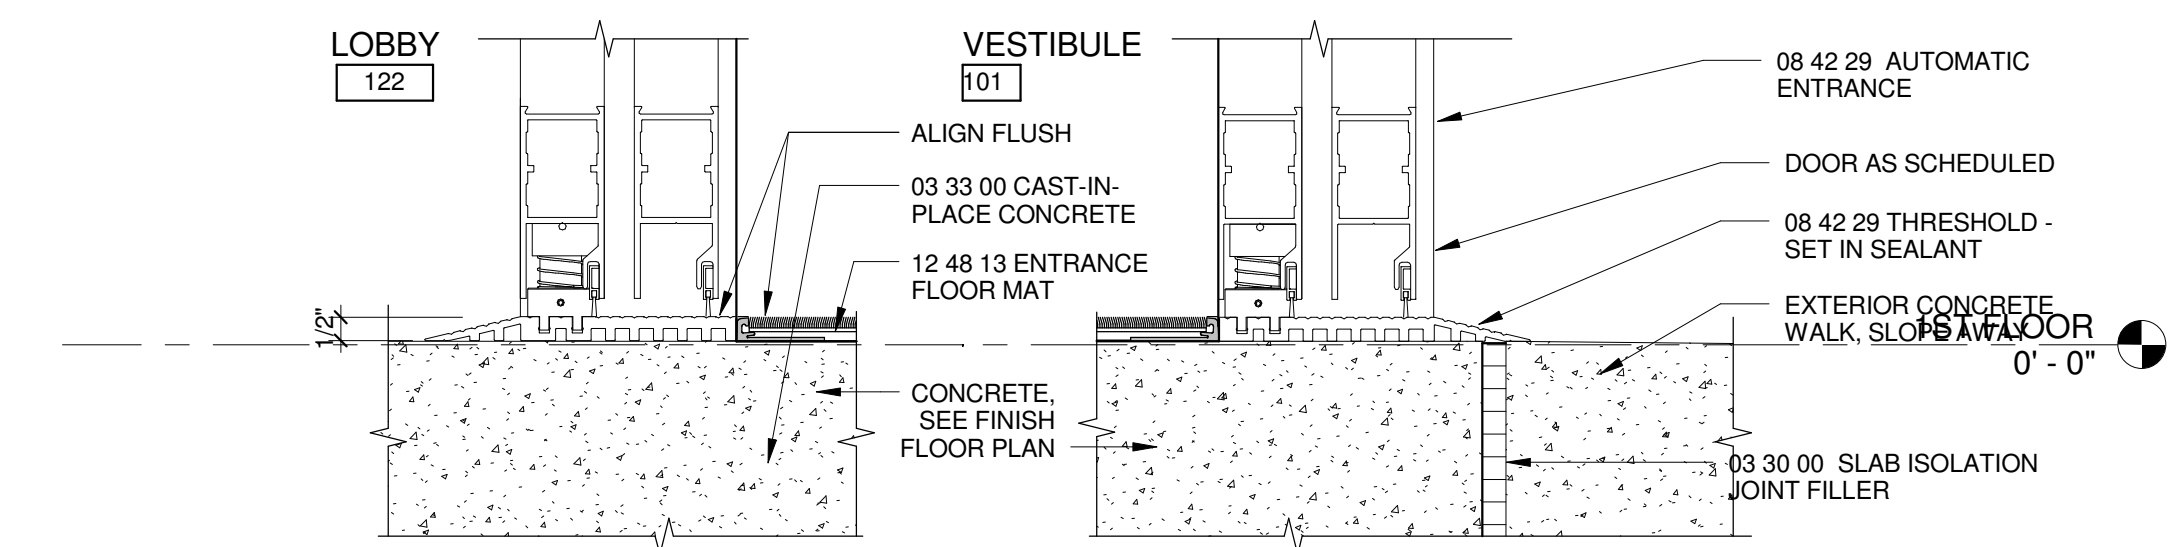


C5 ENTRY DOOR THRESHOLD
3" = 1'-0"

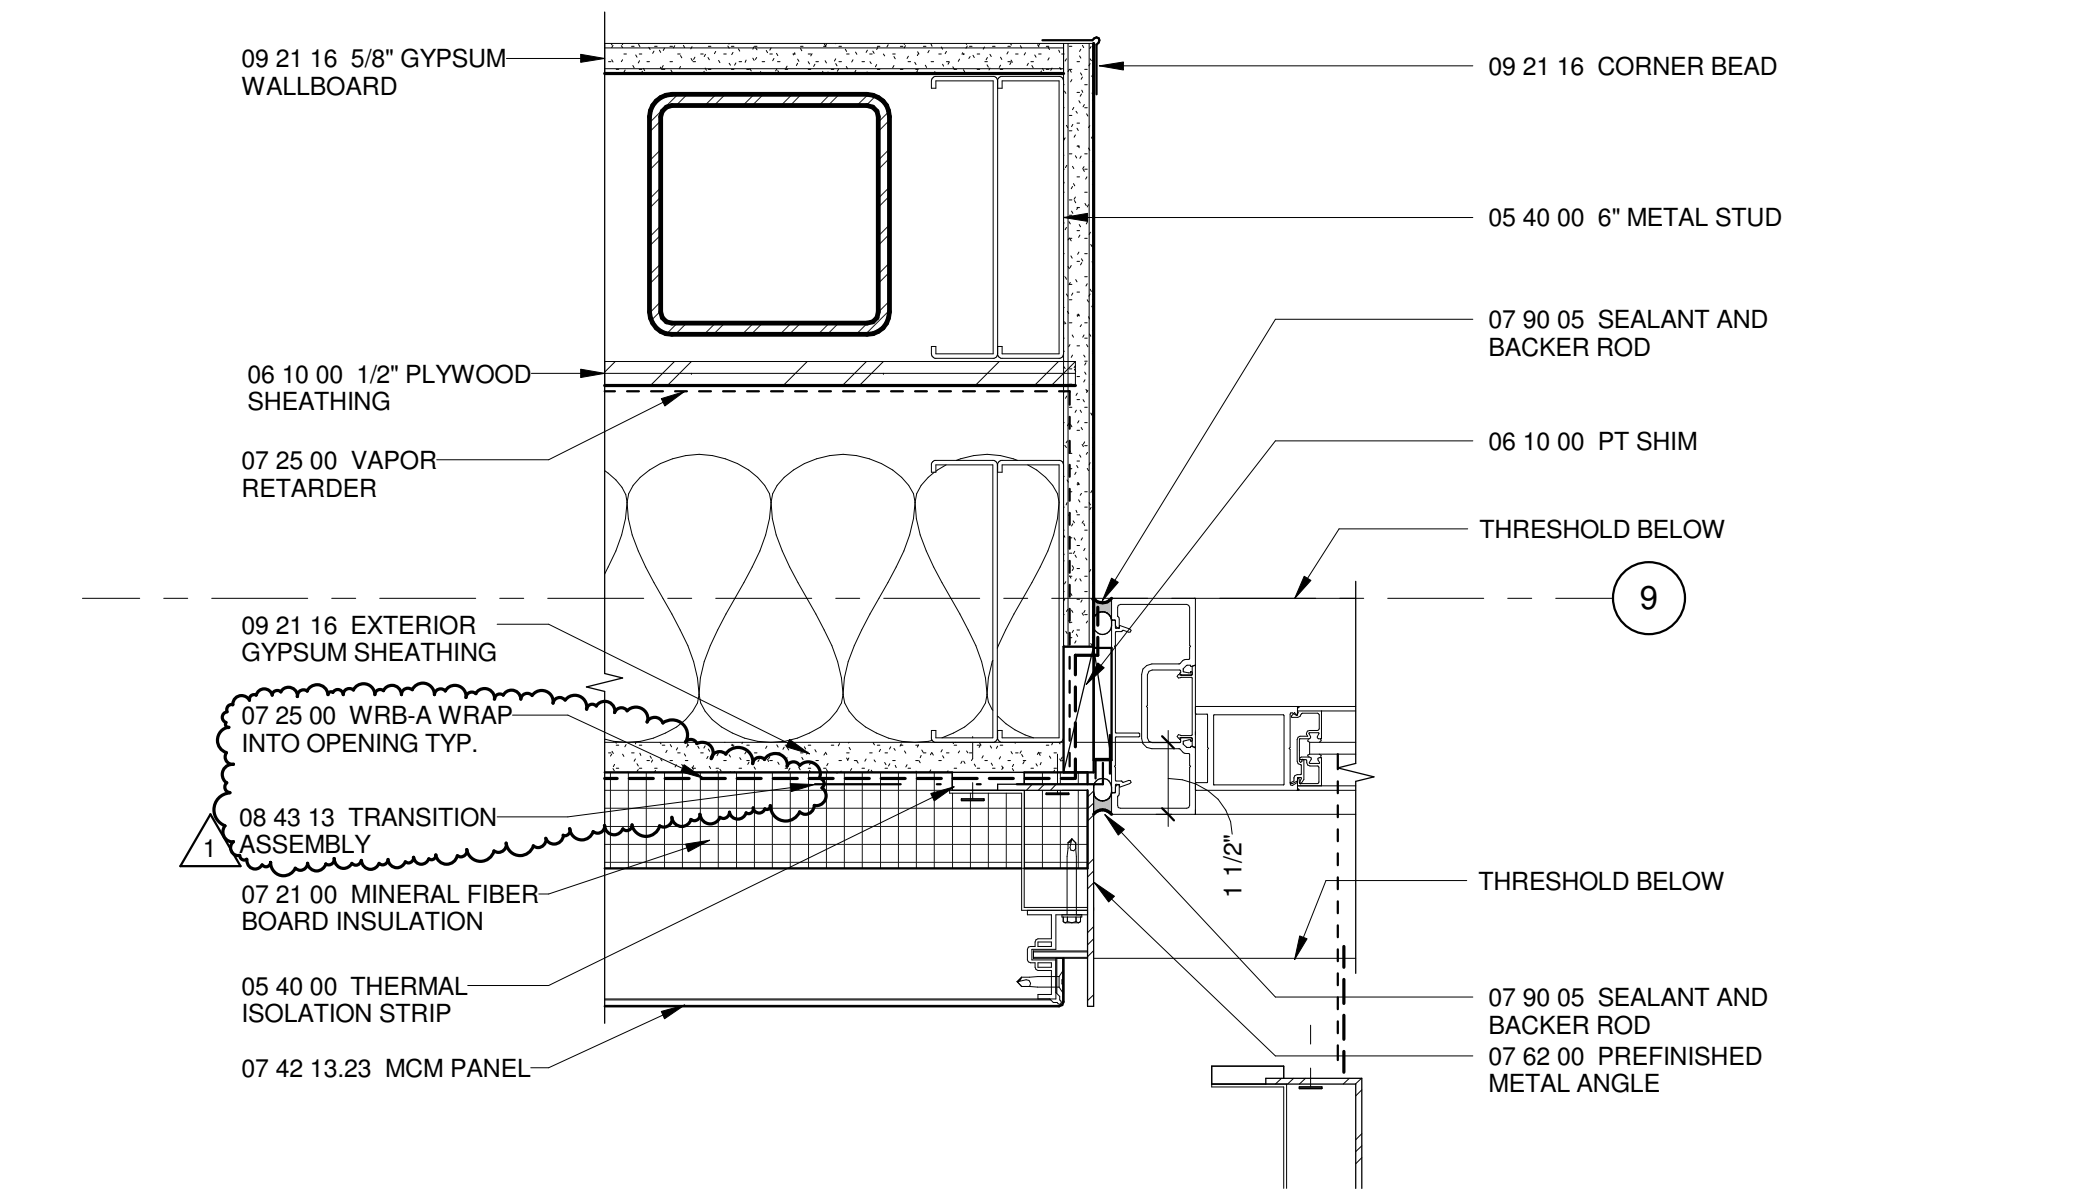


B1 AUTOMATIC DOOR JAMB AT MCM
3" = 1'-0"

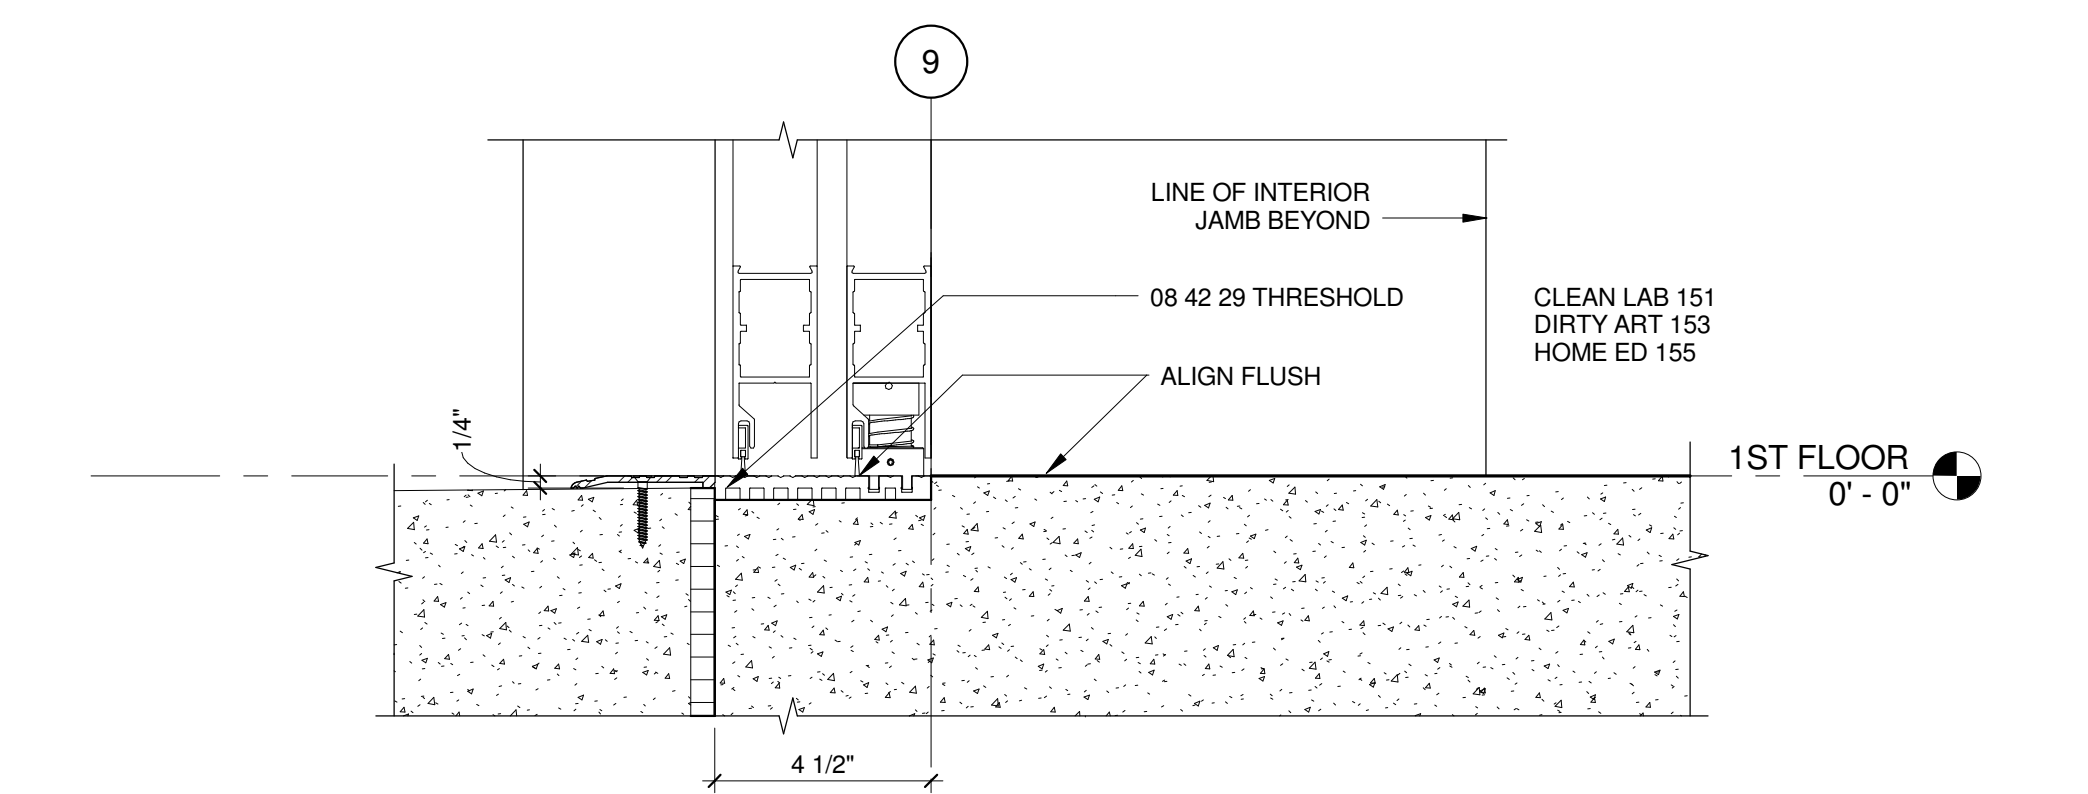

A1 DOOR THRESHOLD AT MAKER'S LAB
3" = 1'-0"

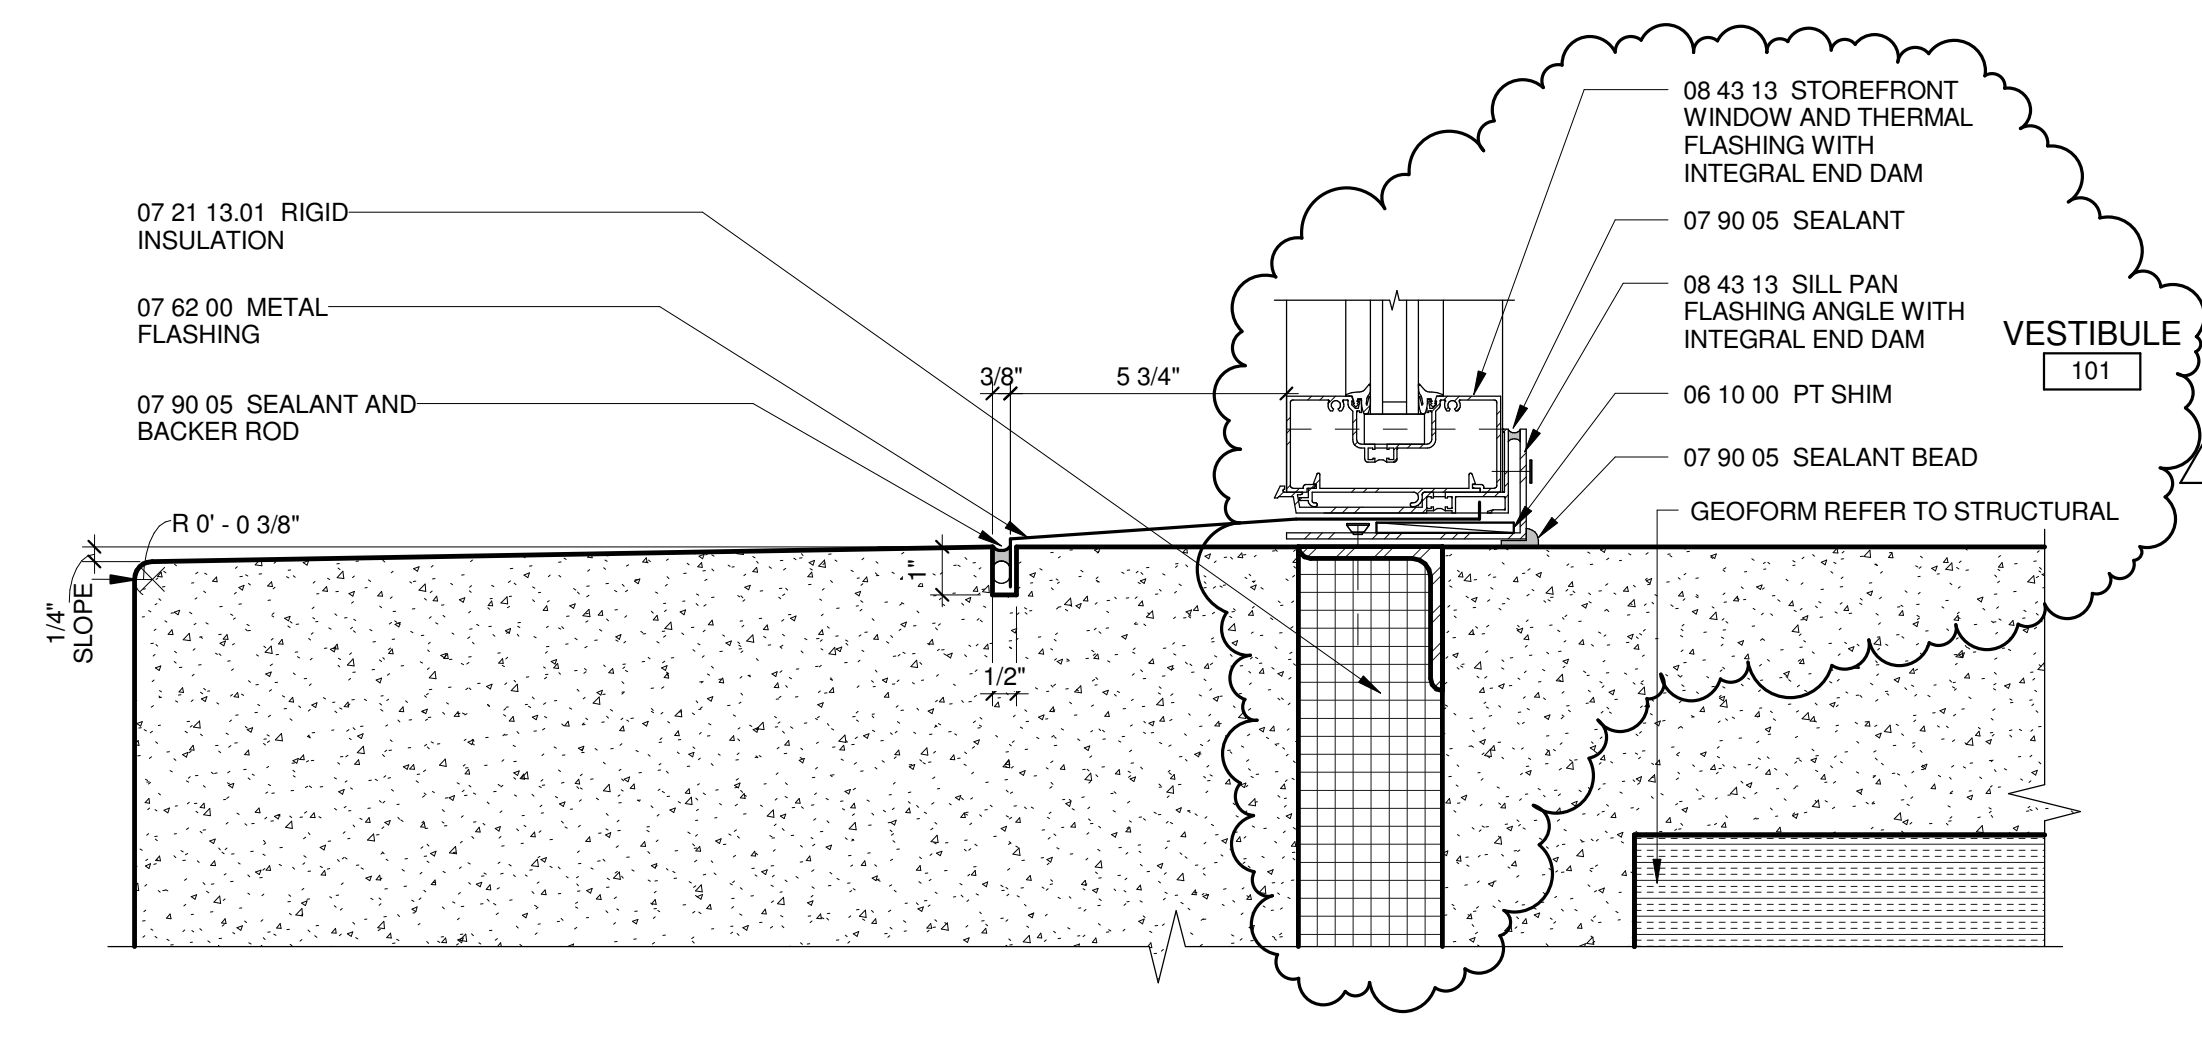


A3 STOREFRONTSILL AT ENTRY CONCRETE BENCH E/W
3" = 1'-0"

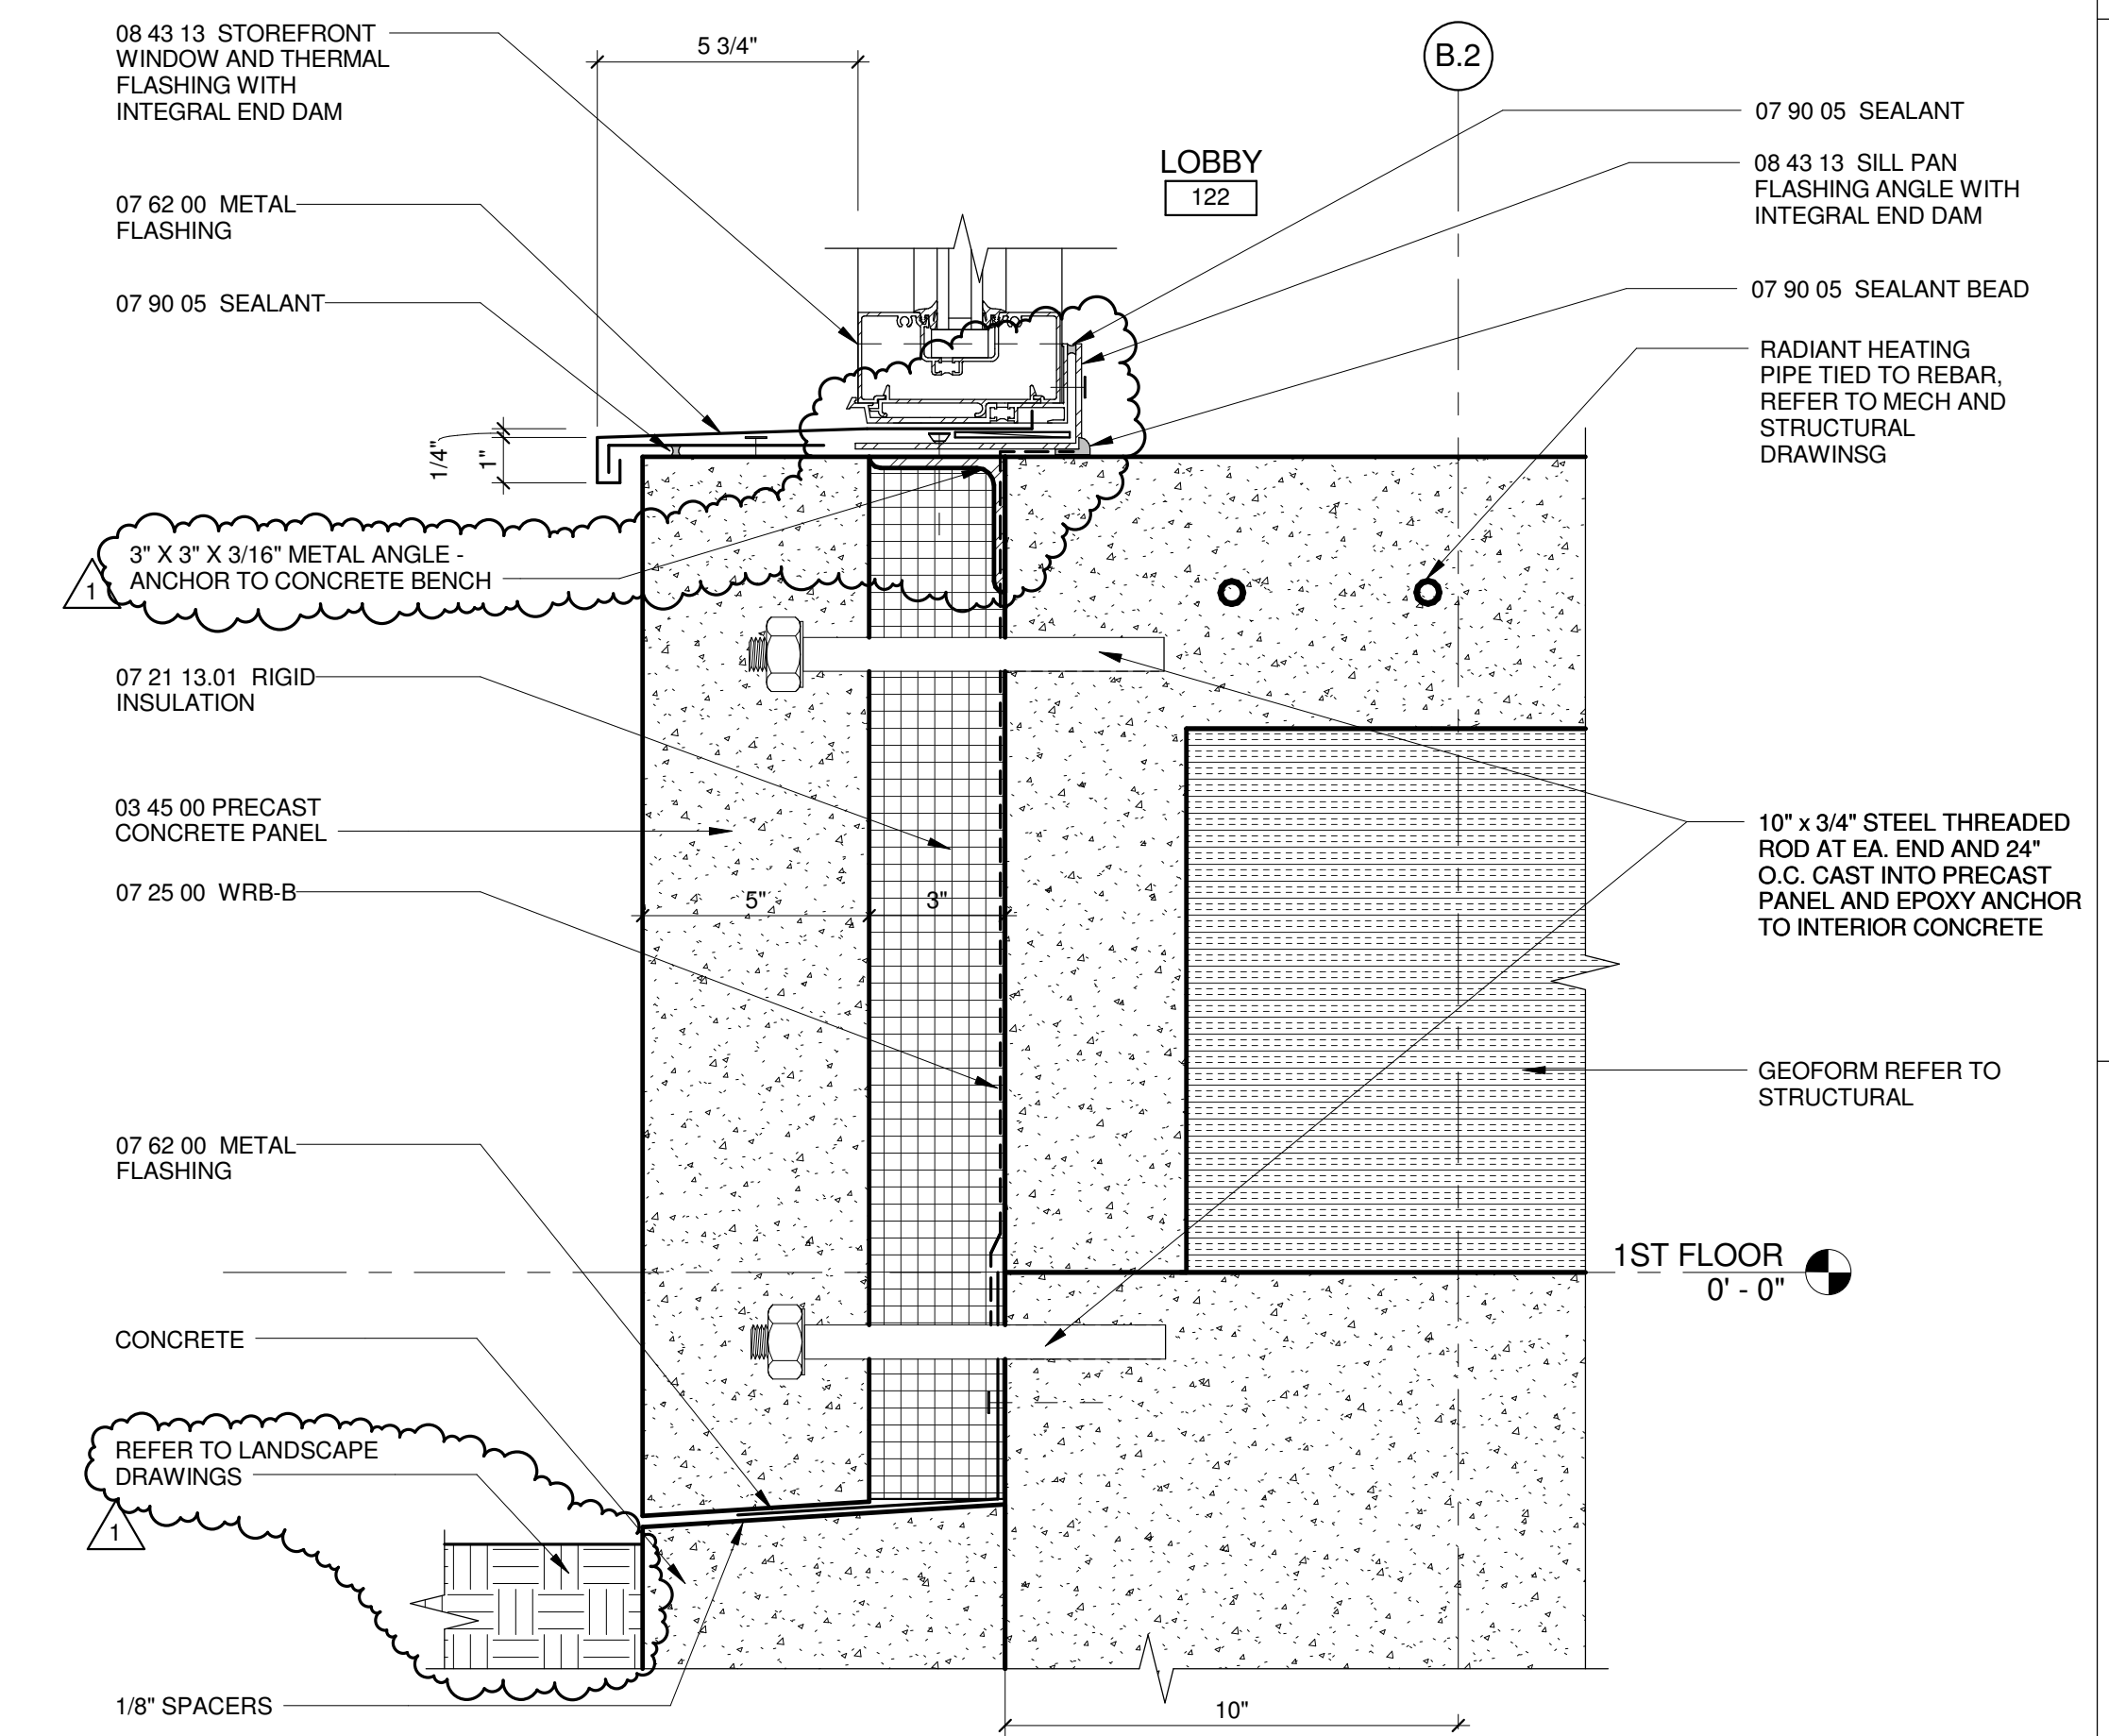


A5 STOREFRONT SILL AT ENTRY CONCRETE BENCH N/S
3" = 1'-0"


MARK	DATE	DESCRIPTION
1	3-11-2015	ADDENDUM 5
ISSUE DATE: FEBRUARY 18, 2015		
ISSUE: CONSTRUCTION DOCUMENTS		
VOLUME: PACKAGE 2 VOLUME 1		
PROJECT NO: 2013912.00		
DRAWN BY: JB		
CHECKED BY: DE		
COPYRIGHT MAHLUM ARCHITECTS, INC 2014 ORIGINAL SHEET SIZE: 30"X42"		

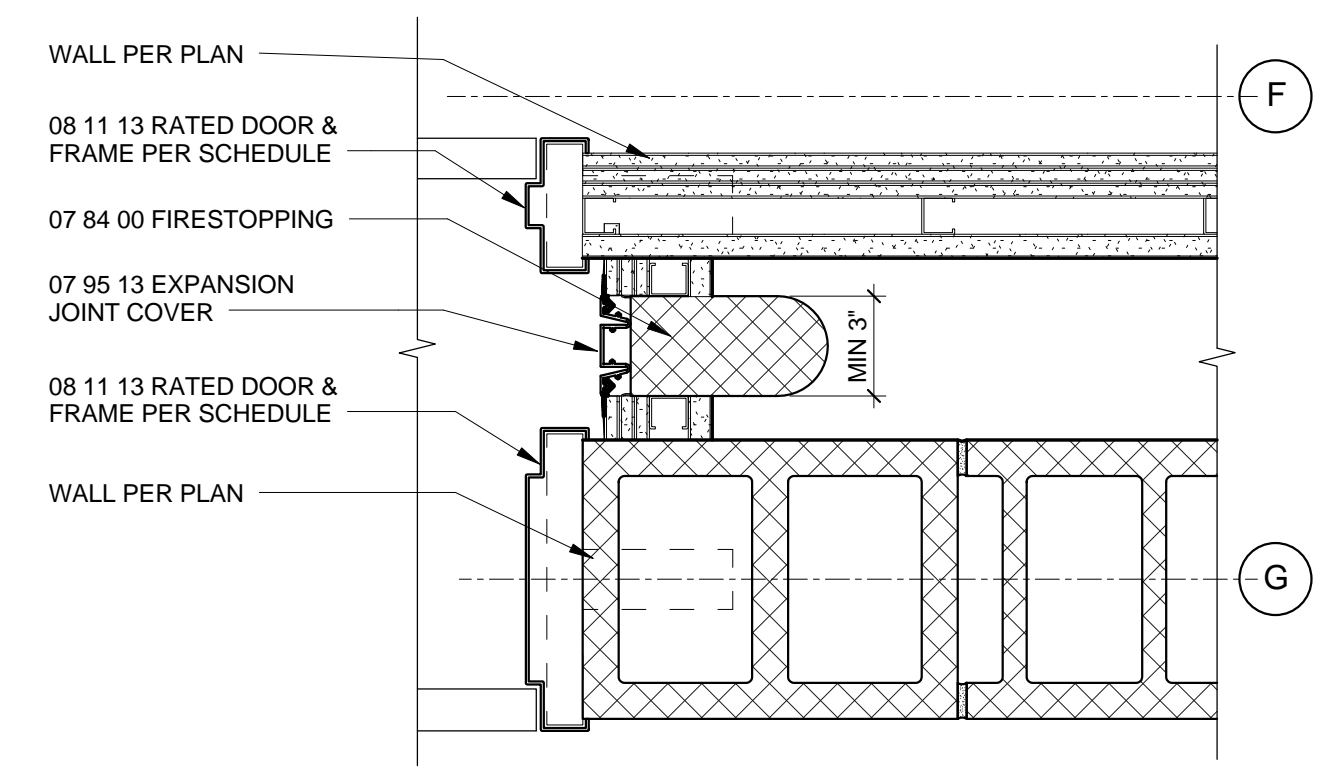


D5 HOLLOW MTL DOOR HEAD & JAMB @ 3 HOUR WALL
 1 1/2" = 1'-0"

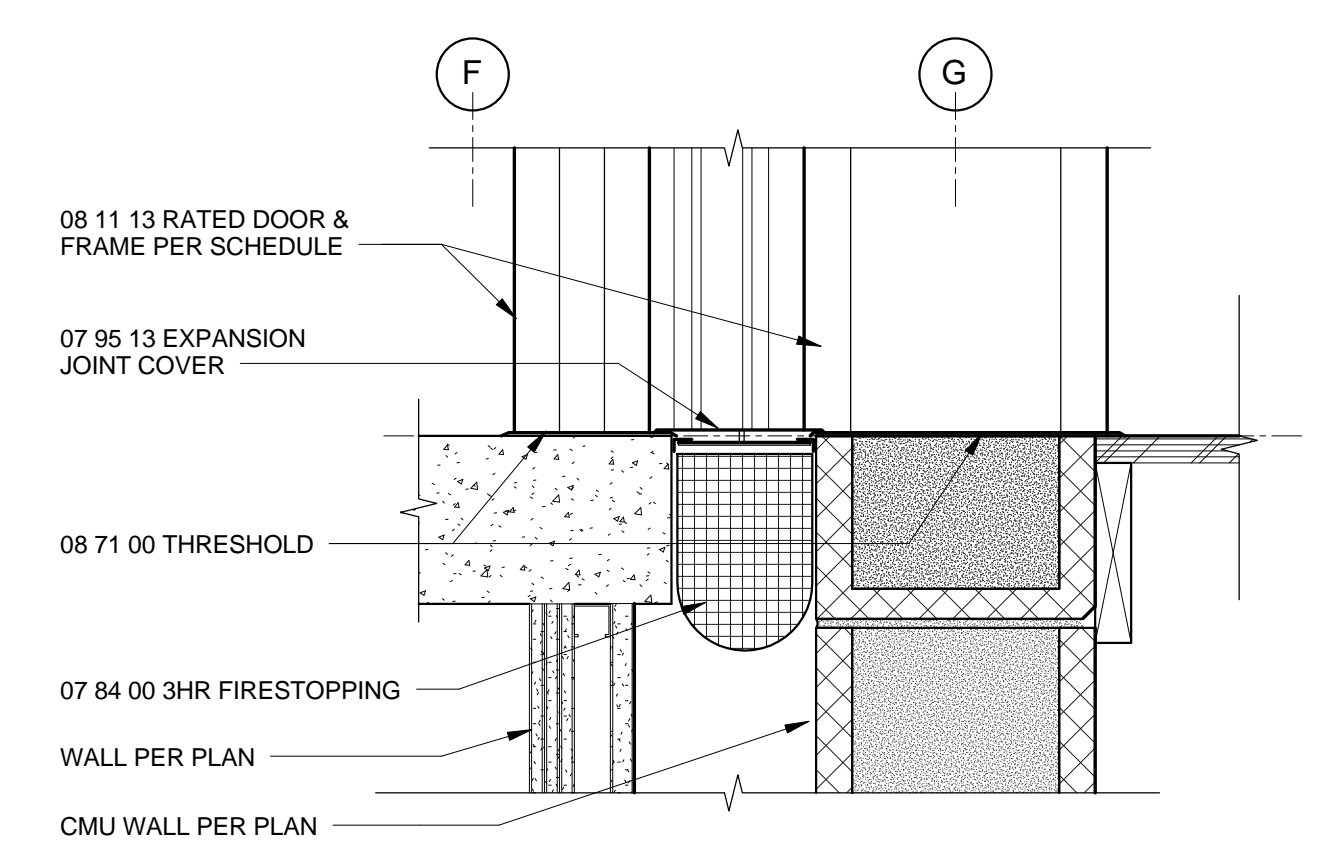

C5 DOOR SILL @ 3 HOUR WALL
 1 1/2" = 1'-0"

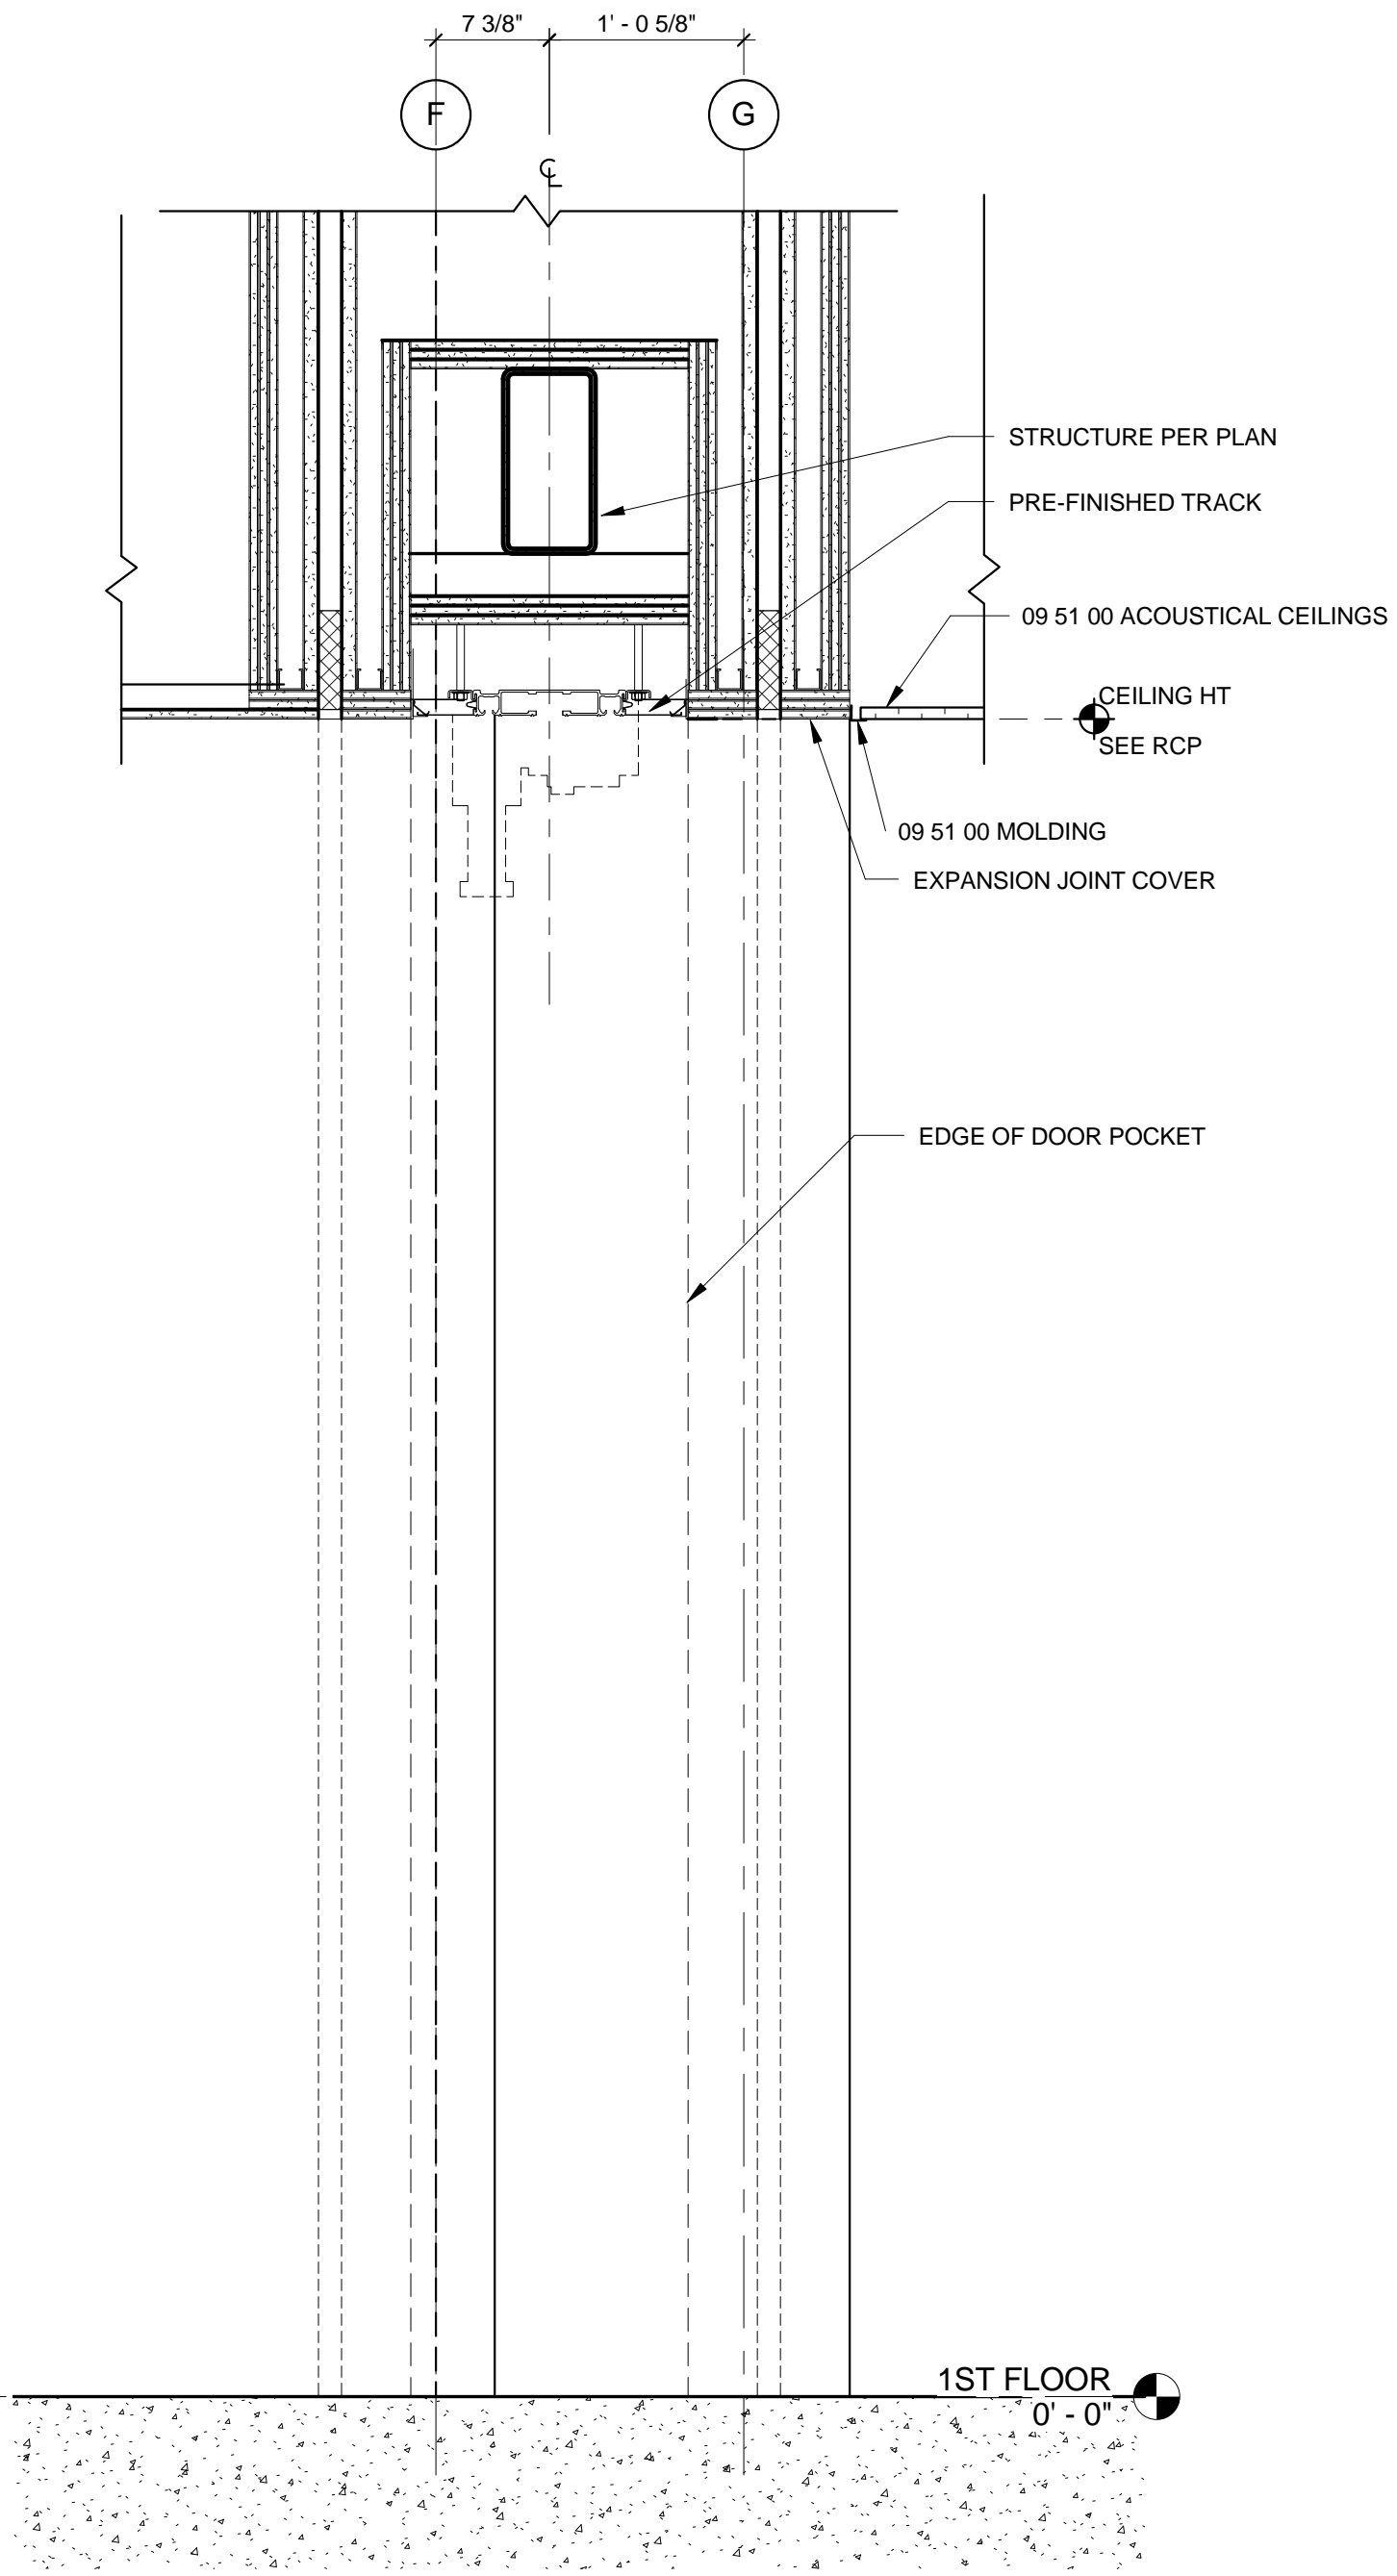

A5 SECTION @ 3-HR FIRE DOOR
 1" = 1'-0"

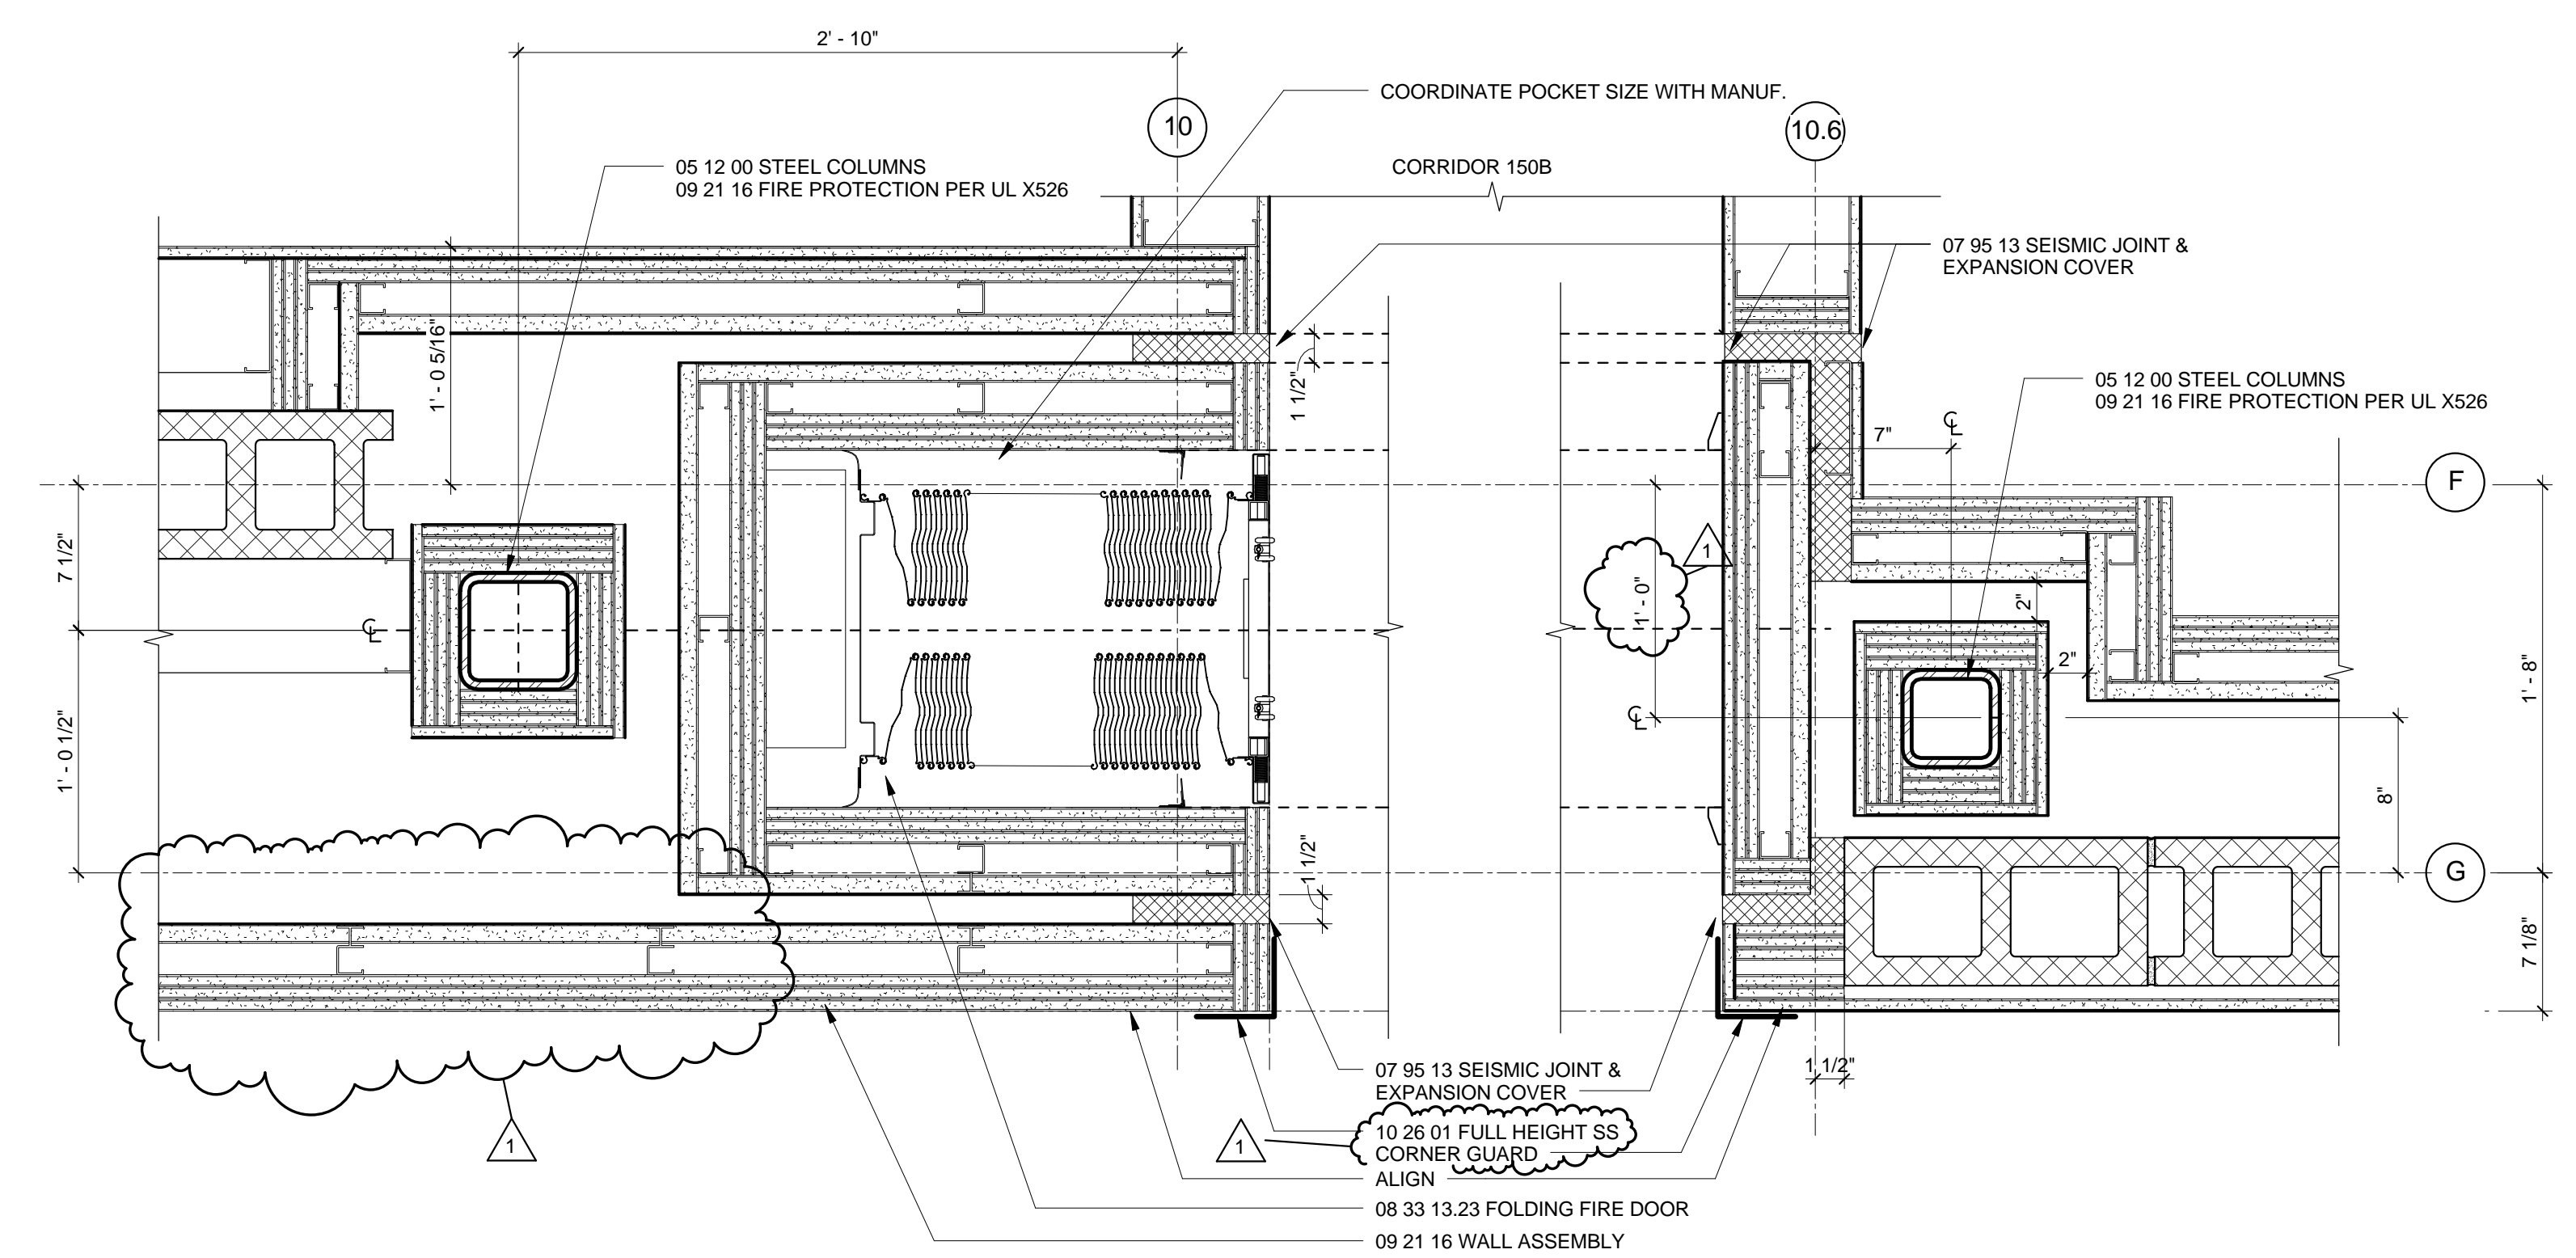

A3 3-HR COILING DOOR JAMB
 1 1/2" = 1'-0"

3/10/2015 4:22:20 PM C:\Users\jsherman\OneDrive\Documents\A-558.dwg

GENERAL NOTES:

- A. IT SHALL BE THE RESPONSIBILITY OF THE CONTRACTOR TO COORDINATE THE WORK WITH THAT OF ALL OTHER TRADES, INCLUDING BUT NOT LIMITED TO: ELECTRICAL, HVAC, FIRE SPRINKLER, PLUMBING, STRUCTURAL, AND GENERAL ARCHITECTURE.
- B. ALL PLUMBING EQUIPMENT, PIPING, INSULATION, ETC. INSTALLED IN HVAC PLENUM AND ATTIC SPACES SHALL MEET CODE REQUIREMENTS FOR SMOKE AND COMBUSTIBILITY.
- C. VERIFY EXACT SIZES, LOCATIONS, INVERTS, AND ELEVATIONS PRIOR TO RUNNING ANY PIPING. REFER TO ARCHITECTURAL DRAWINGS FOR EXACT LOCATIONS OF ALL FIXTURES AND EQUIPMENT. REFER TO KITCHEN LAYOUT DRAWING FOR EXACT LOCATION AND ROUGH-IN REQUIREMENTS OF ALL KITCHEN FIXTURES AND EQUIPMENT.
- D. PLUMBING CONTRACTOR IS RESPONSIBLE FOR EXTENDING ALL REGULATOR VENTS TO ATMOSPHERE. REGULATORS ARE PART OF EQUIPMENT GAS TRAIN.
- E. WATER HEATERS SHALL BE INSTALLED WITH DRAIN PANS UNDER HEATERS. ROUTE PAN DRAINS TO NEAREST FLOOR DRAIN OR SAFE DRAIN.
- F. PIPING SHALL NOT RUN OVER ELECTRICAL PANELS AND SHALL BE COORDINATED WITH WORK OF OTHER TRADES.
- G. NPW PIPING FROM RAINWATER SYSTEM SHALL BE ROUTED FROM BOILER ROOM 174 PARALLEL TO CW PIPING AND SHALL SERVE ALL FLUSH FIXTURES.
- H. PROVIDE WALL CLEANOUTS ON WASTE PIPE SYSTEM EVERY 100 FT. FOR STRAIGHT RUNS, AT 90 DEGREE TURNS IN MAINS, AND AT ANY TURN EXCEEDING 135 DEGREES.
- I. PROVIDE EXTERIOR CTG'S ON WASTE PIPE SYSTEM AT BEGINNINGS AND ENDS OF WASTE PIPING MAINS.
- J. IN RESTROOMS PROVIDE WALL CLEANOUTS, SHOCK ARRESTORS AND SHUT-OFF VALVES BEHIND ACCESS PANELS AS APPROPRIATE. PROVIDE HOSE BIBB IN EACH RESTROOM.

NOTES:

- 1. PROVIDE C/W/H/W/RHW ANGLE STOPS IN FRAMED WALL BELOW COUNTER.
- 2. CONNECT RHW LINE WITHIN 12" OF ANGLE STOP VALVE. REFER TO RISER DIAGRAM.
- 3. PROVIDE RIGID RISERS HELD TIGHT TO BOTTOM OF COUNTER, FOR ADA COMPLIANCE, TO CONNECT TO PLUMBING FIXTURES.
- 4. INSULATE HW AND W LINES BELOW SINK FOR ADA COMPLIANCE.
- 5. CONNECT WASTE PIPING INTO FRAMED WALL.



ROBERTSON/SHERWOOD/ARCHITECTS PC
132 EAST BROADWAY, SUITE 540
EUGENE, OREGON 97401
541-342-8077
www.robertsonsherwood.com

MAHLUM ARCHITECTS INC
1231 NW HOYT, SUITE 102
PORTLAND, OREGON 97209
503-224-4032
71 COLUMBIA FLOOR 4
SEATTLE, WASHINGTON 98104
206-441-4151
www.mahlum.com



EUGENE SCHOOL DISTRICT 4J




REPLACEMENT ROOSEVELT
MIDDLE SCHOOL
CIP NUMBER 410.566.001
680 EAST 24TH AVENUE
EUGENE, OREGON 97405
CIP NO. 410.566.001

MARK	DATE	DESCRIPTION
1	03-13-2015	ADDENDUM 6

ISSUE DATE: FEBRUARY 18, 2015
ISSUE: CONSTRUCTION DOCUMENTS
VOLUME: PACKAGE 2 VOLUME 2
PROJECT NO: 2013912.00
DRAWN BY: SG
CHECKED BY: JCY
COPYRIGHT MAHLUM ARCHITECTS, INC. 2014 ORIGINAL SHEET SIZE: 30"X42"

FIRST FLOOR PLAN - ZONE A - PLUMBING

P-121A

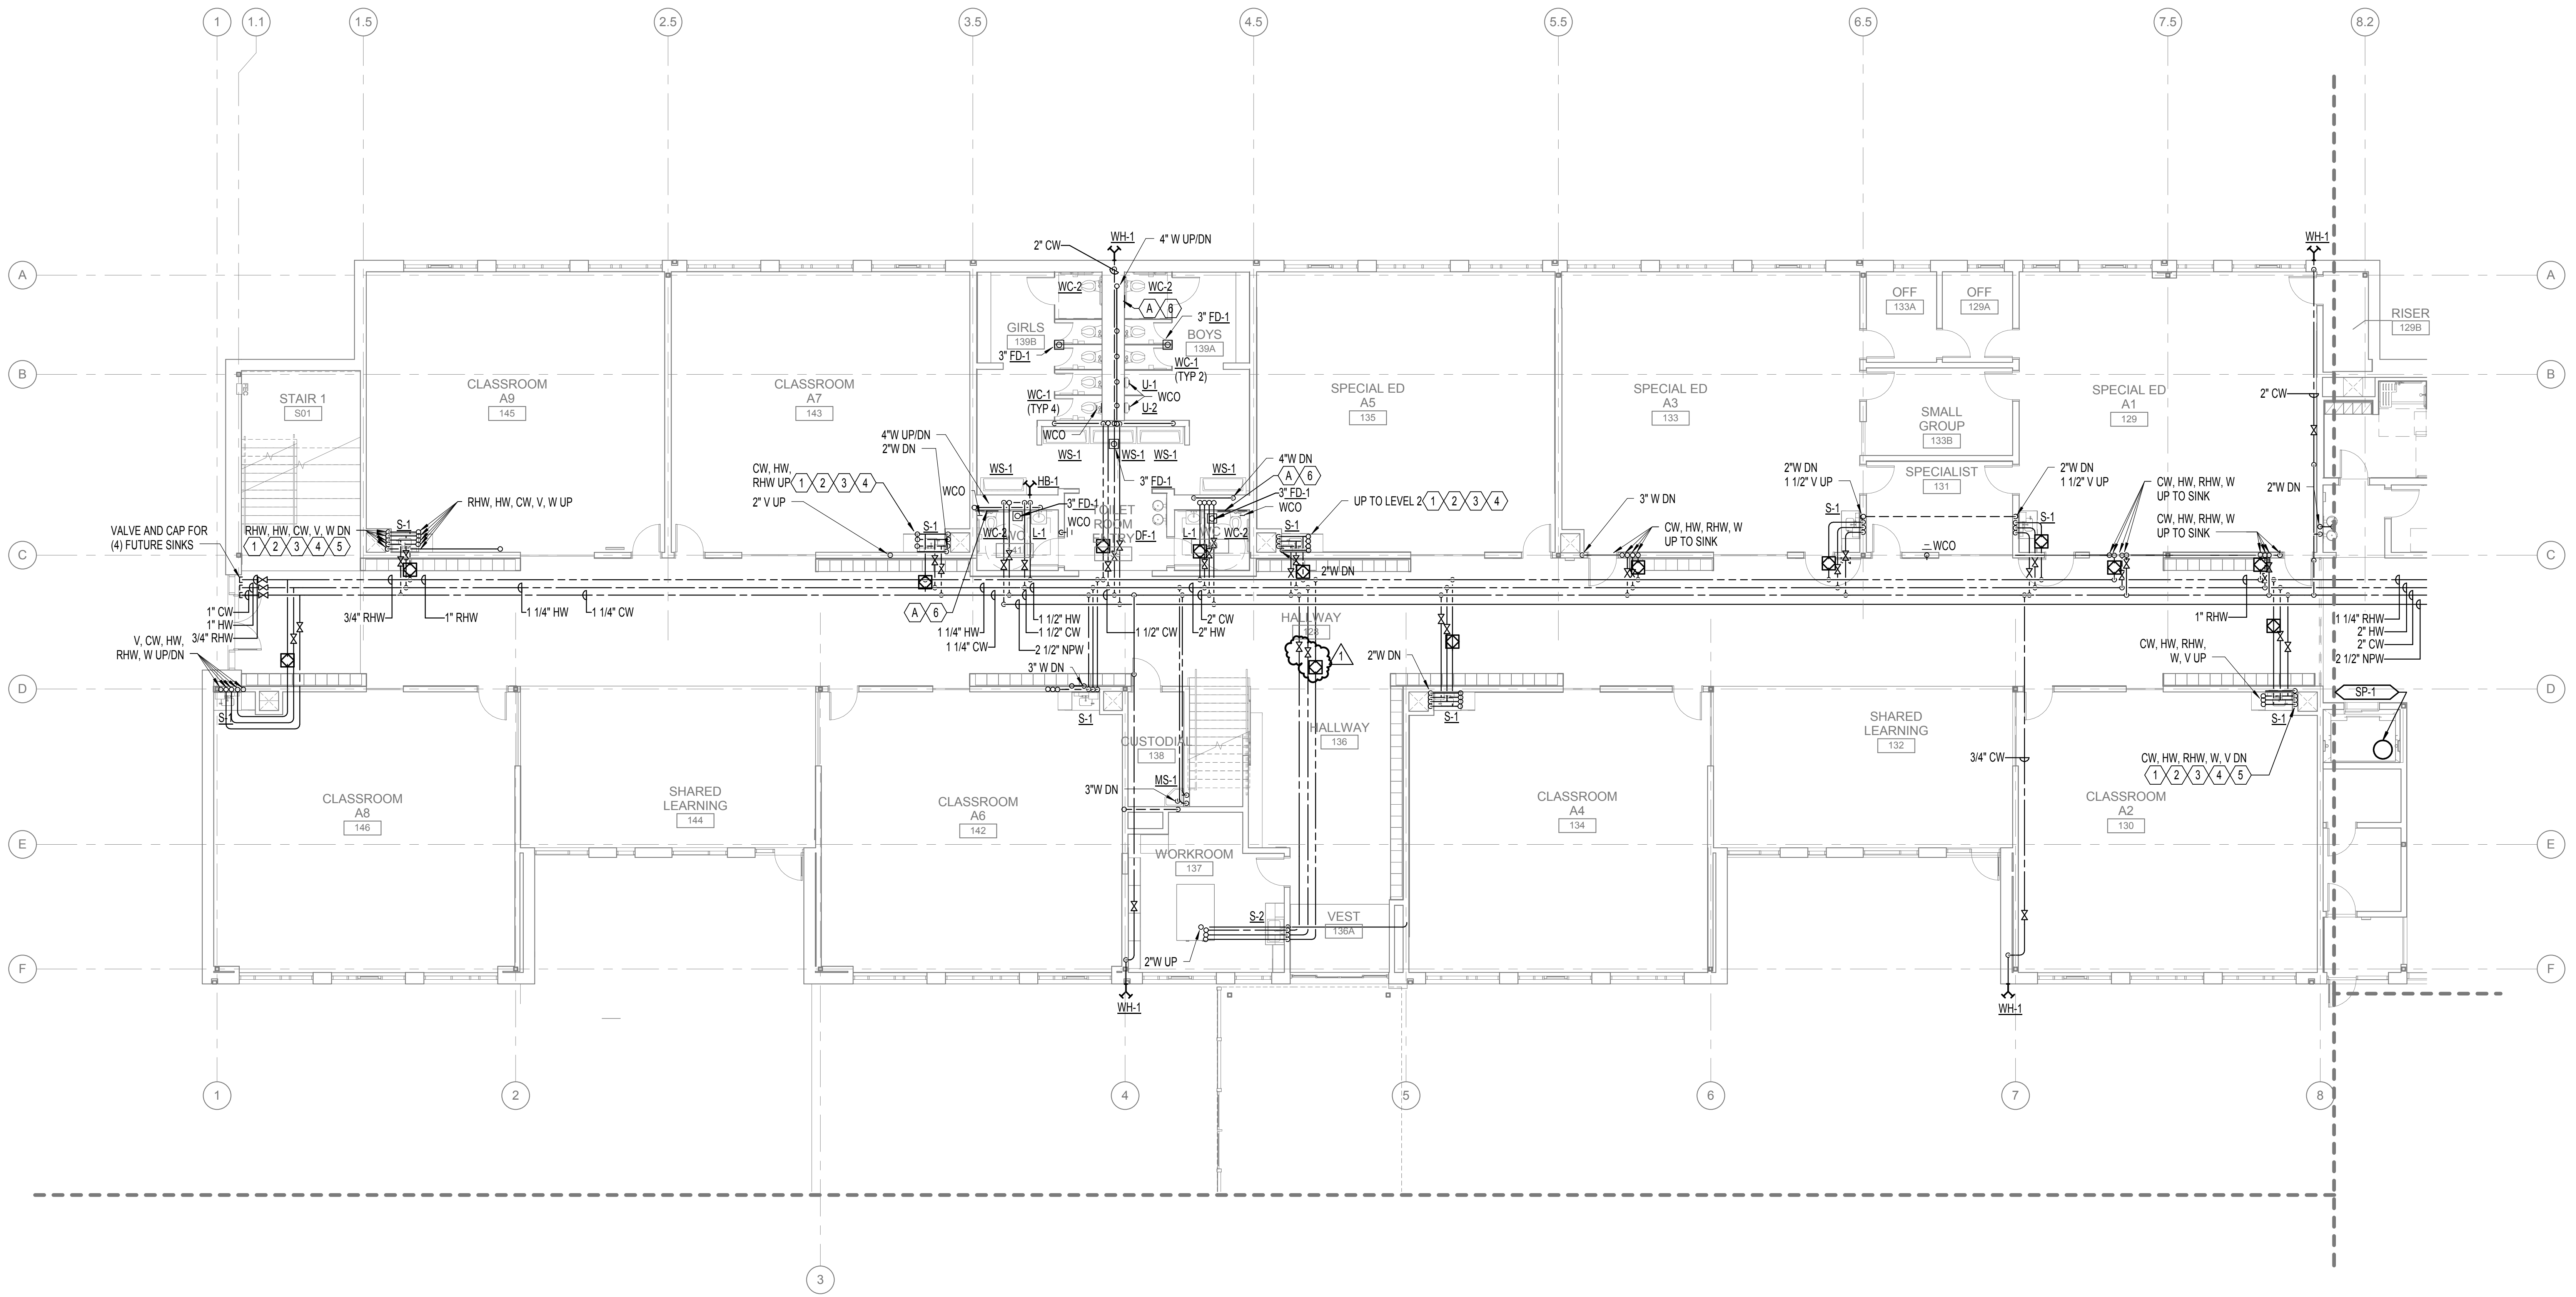

A1 FIRST FLOOR PLAN - ZONE A - PLUMBING
1/8" = 1'-0"


3/10/2015 3:52:10 PM C:\Users\Local\Public\3-108\BPT\GENERAL\plan\m121a.dwg

GENERAL NOTES:


- A. IT SHALL BE THE RESPONSIBILITY OF THE CONTRACTOR TO COORDINATE THE WORK WITH THAT OF ALL OTHER TRADES, INCLUDING BUT NOT LIMITED TO: ELECTRICAL, HVAC, FIRE SPRINKLER, PLUMBING, STRUCTURAL, AND GENERAL ARCHITECTURE.
- B. ALL PLUMBING EQUIPMENT, PIPING, INSULATION, ETC. INSTALLED IN HVAC PLENUM AND ATTIC SPACES SHALL MEET CODE REQUIREMENTS FOR SMOKE AND COMBUSTIBILITY.
- C. VERIFY EXACT SIZES, LOCATIONS, INVERTS, AND ELEVATIONS PRIOR TO RUNNING ANY PIPING. REFER TO ARCHITECTURAL DRAWINGS FOR EXACT LOCATIONS OF ALL FIXTURES AND EQUIPMENT. REFER TO KITCHEN LAYOUT DRAWING FOR EXACT LOCATION AND ROUGH-IN REQUIREMENTS OF ALL KITCHEN FIXTURES AND EQUIPMENT.
- D. PLUMBING CONTRACTOR IS RESPONSIBLE FOR EXTENDING ALL REGULATOR VENTS TO ATMOSPHERE. REGULATORS ARE PART OF EQUIPMENT GAS TRAIN.
- E. WATER HEATERS SHALL BE INSTALLED WITH DRAIN PANS UNDER HEATERS. ROUTE PAN DRAINS TO NEAREST FLOOR DRAIN OR SAFE DRAIN.
- F. PIPING SHALL NOT RUN OVER ELECTRICAL PANELS AND SHALL BE COORDINATED WITH WORK OF OTHER TRADES.
- G. NPW PIPING FROM RAINWATER SYSTEM SHALL BE ROUTED FROM BOILER ROOM 174 PARALLEL TO CW PIPING AND SHALL SERVE ALL FLUSH FIXTURES.
- H. PROVIDE WALL CLEANOUTS ON WASTE PIPE SYSTEM EVERY 100 FT. FOR STRAIGHT RUNS, AT 90 DEGREE TURNS IN MAINS, AND AT ANY TURN EXCEEDING 135 DEGREES.
- I. PROVIDE EXTERIOR CTG'S ON WASTE PIPE SYSTEM AT BEGINNINGS AND ENDS OF WASTE PIPING MAINS.
- J. IN RESTROOMS PROVIDE WALL CLEANOUTS, SHOCK ARRESTORS AND SHUT-OFF VALVES BEHIND ACCESS PANELS AS APPROPRIATE. PROVIDE HOSE BIBB IN EACH RESTROOM.

NOTES:

- 1. LOCATE SHOCK ARRESTOR BEHIND ACCESS PANEL.

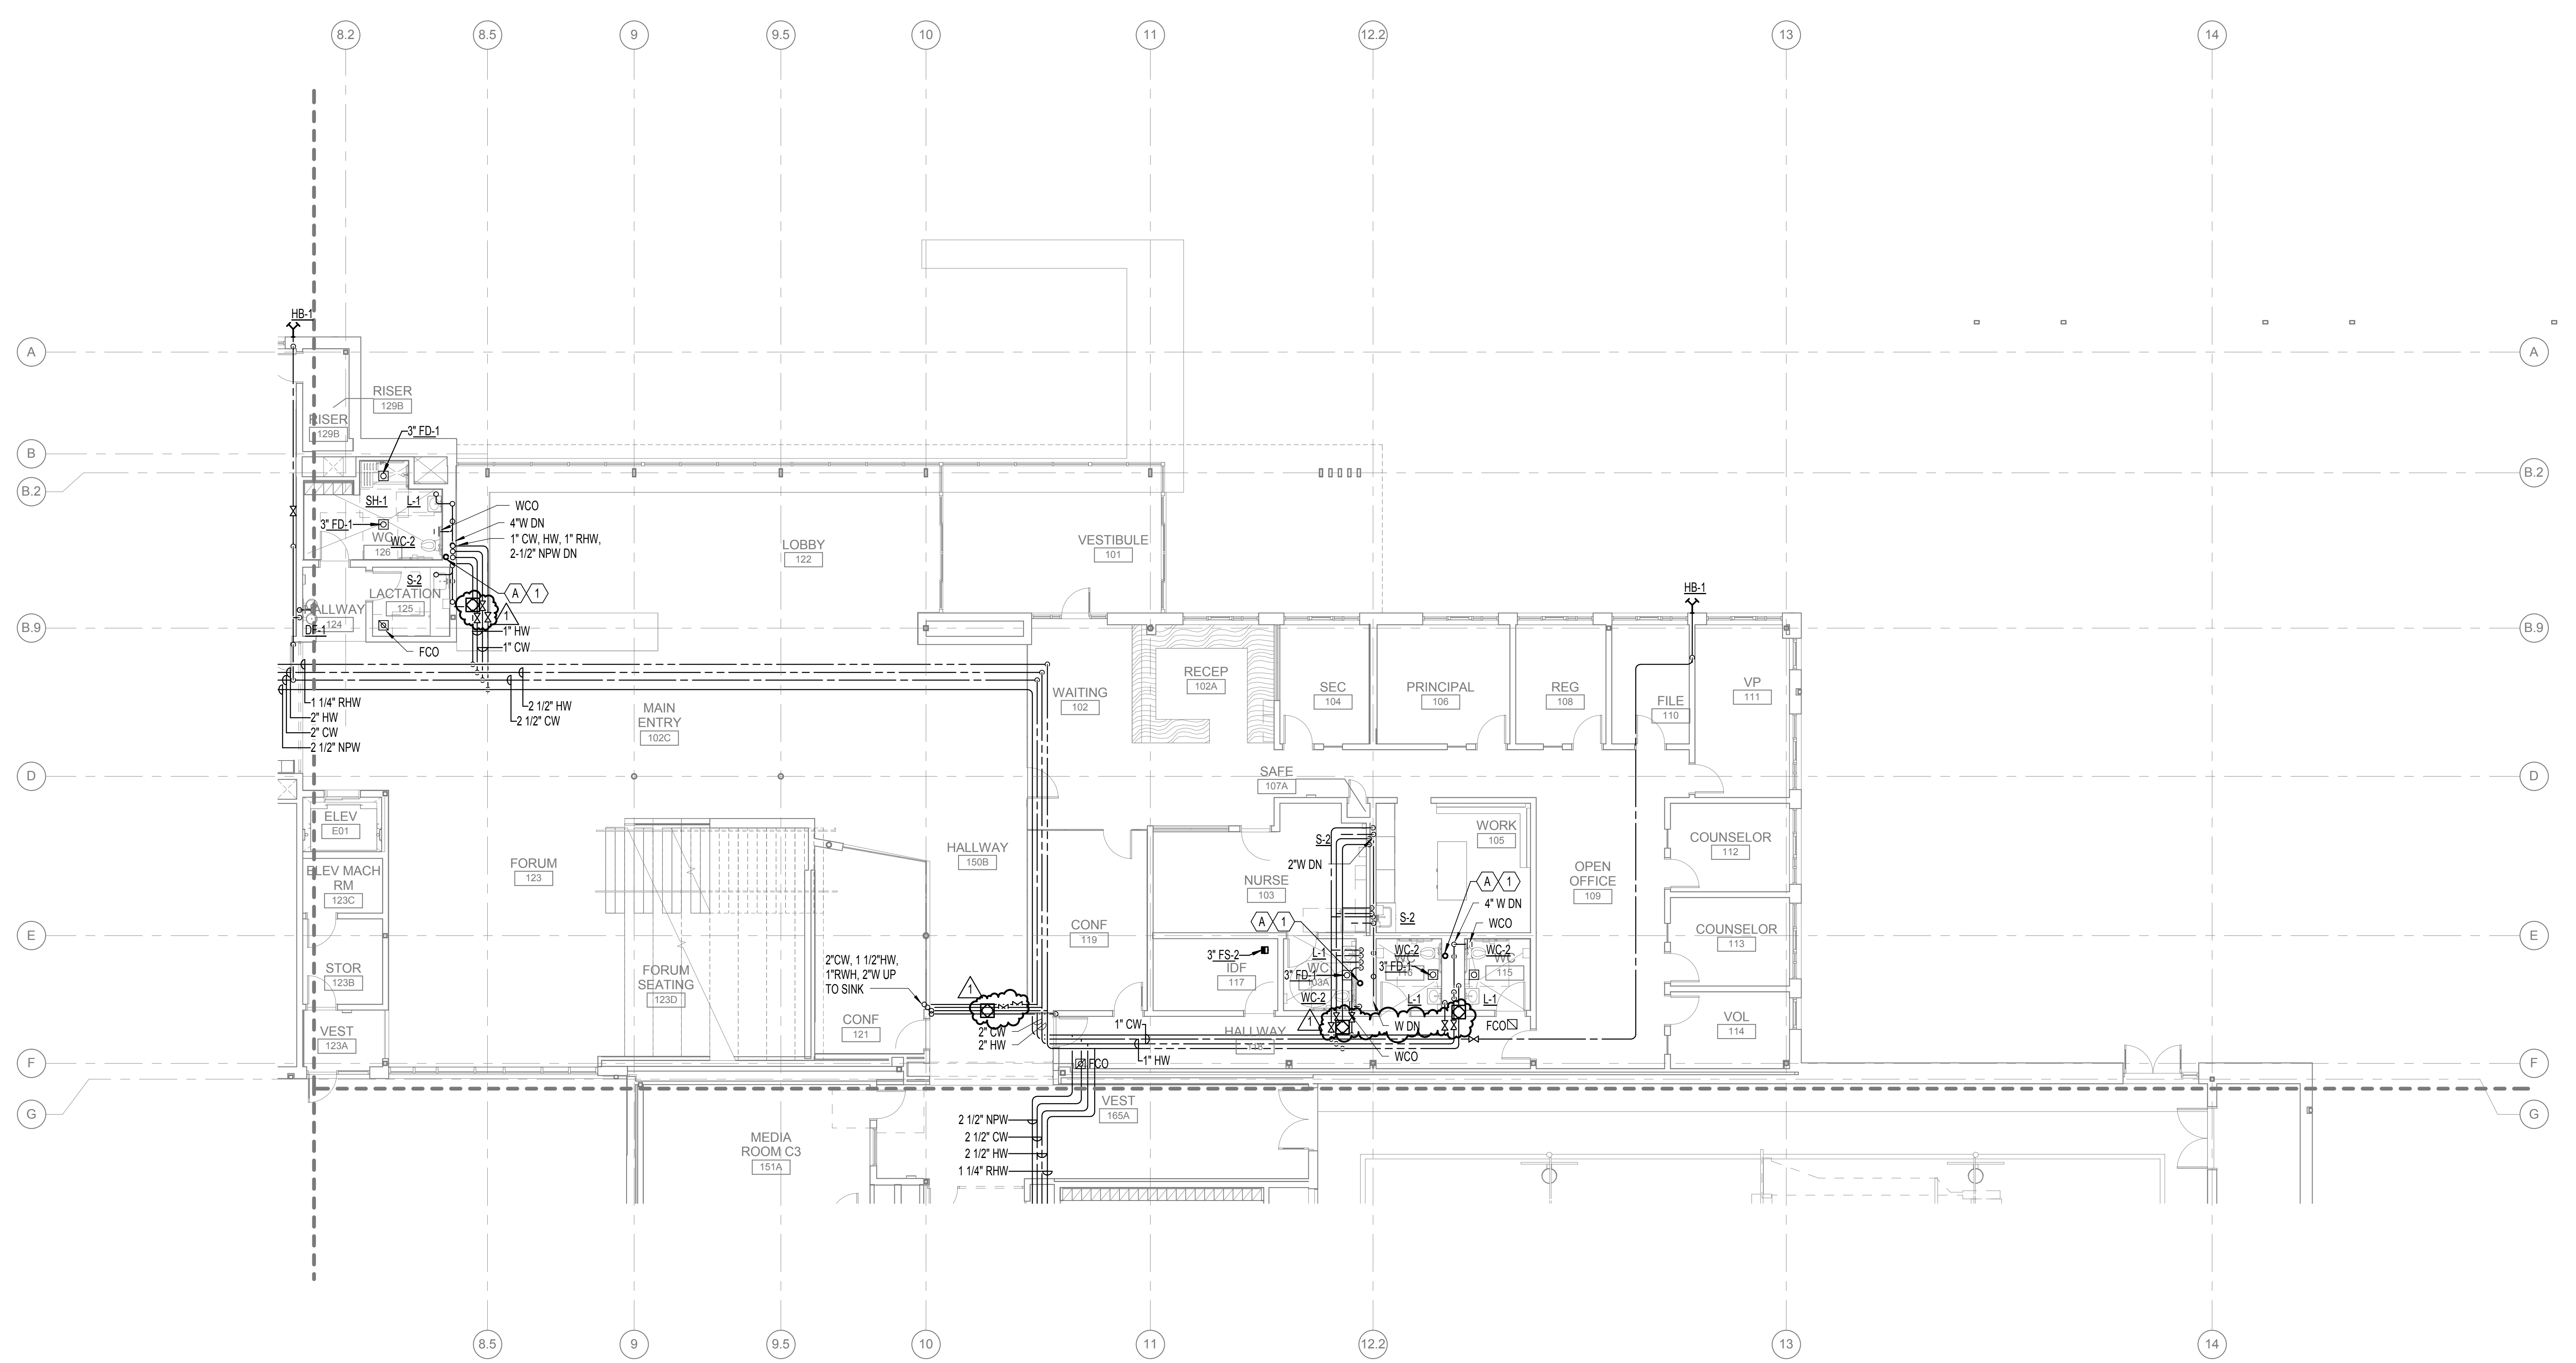

A1 FIRST FLOOR PLAN - ZONE B - PLUMBING
1/8" = 1'-0"

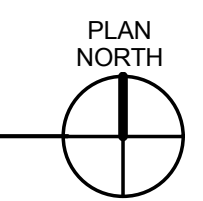

ROBERTSON/SHERWOOD/ARCHITECTS PC
132 EAST BROADWAY, SUITE 540
EUGENE, OREGON 97401
541-342-8077
www.robertsonsherwood.com

MAHLUM ARCHITECTS INC
1231 NW HOYT, SUITE 102
PORTLAND, OREGON 97209
503-224-4032
71 COLUMBIA FLOOR 4
SEATTLE, WASHINGTON 98104
206-441-4151
www.mahlum.com



EUGENE SCHOOL DISTRICT 4J




REPLACEMENT ROOSEVELT MIDDLE SCHOOL
CIP NUMBER 410.566.001
680 EAST 24TH AVENUE
EUGENE, OREGON 97405
CIP NO. 410.566.001

MARK	DATE	DESCRIPTION
1	03-13-2015	ADDENDUM 6


ISSUE DATE: FEBRUARY 18, 2015
ISSUE: CONSTRUCTION DOCUMENTS
VOLUME: PACKAGE 2 VOLUME 2
PROJECT NO: 2013912.00
DRAWN BY: SG
CHECKED BY: JCY
COPYRIGHT MAHLUM ARCHITECTS, INC. 2014 ORIGINAL SHEET SIZE: 30"X42"

FIRST FLOOR PLAN - ZONE B - PLUMBING

P-121B

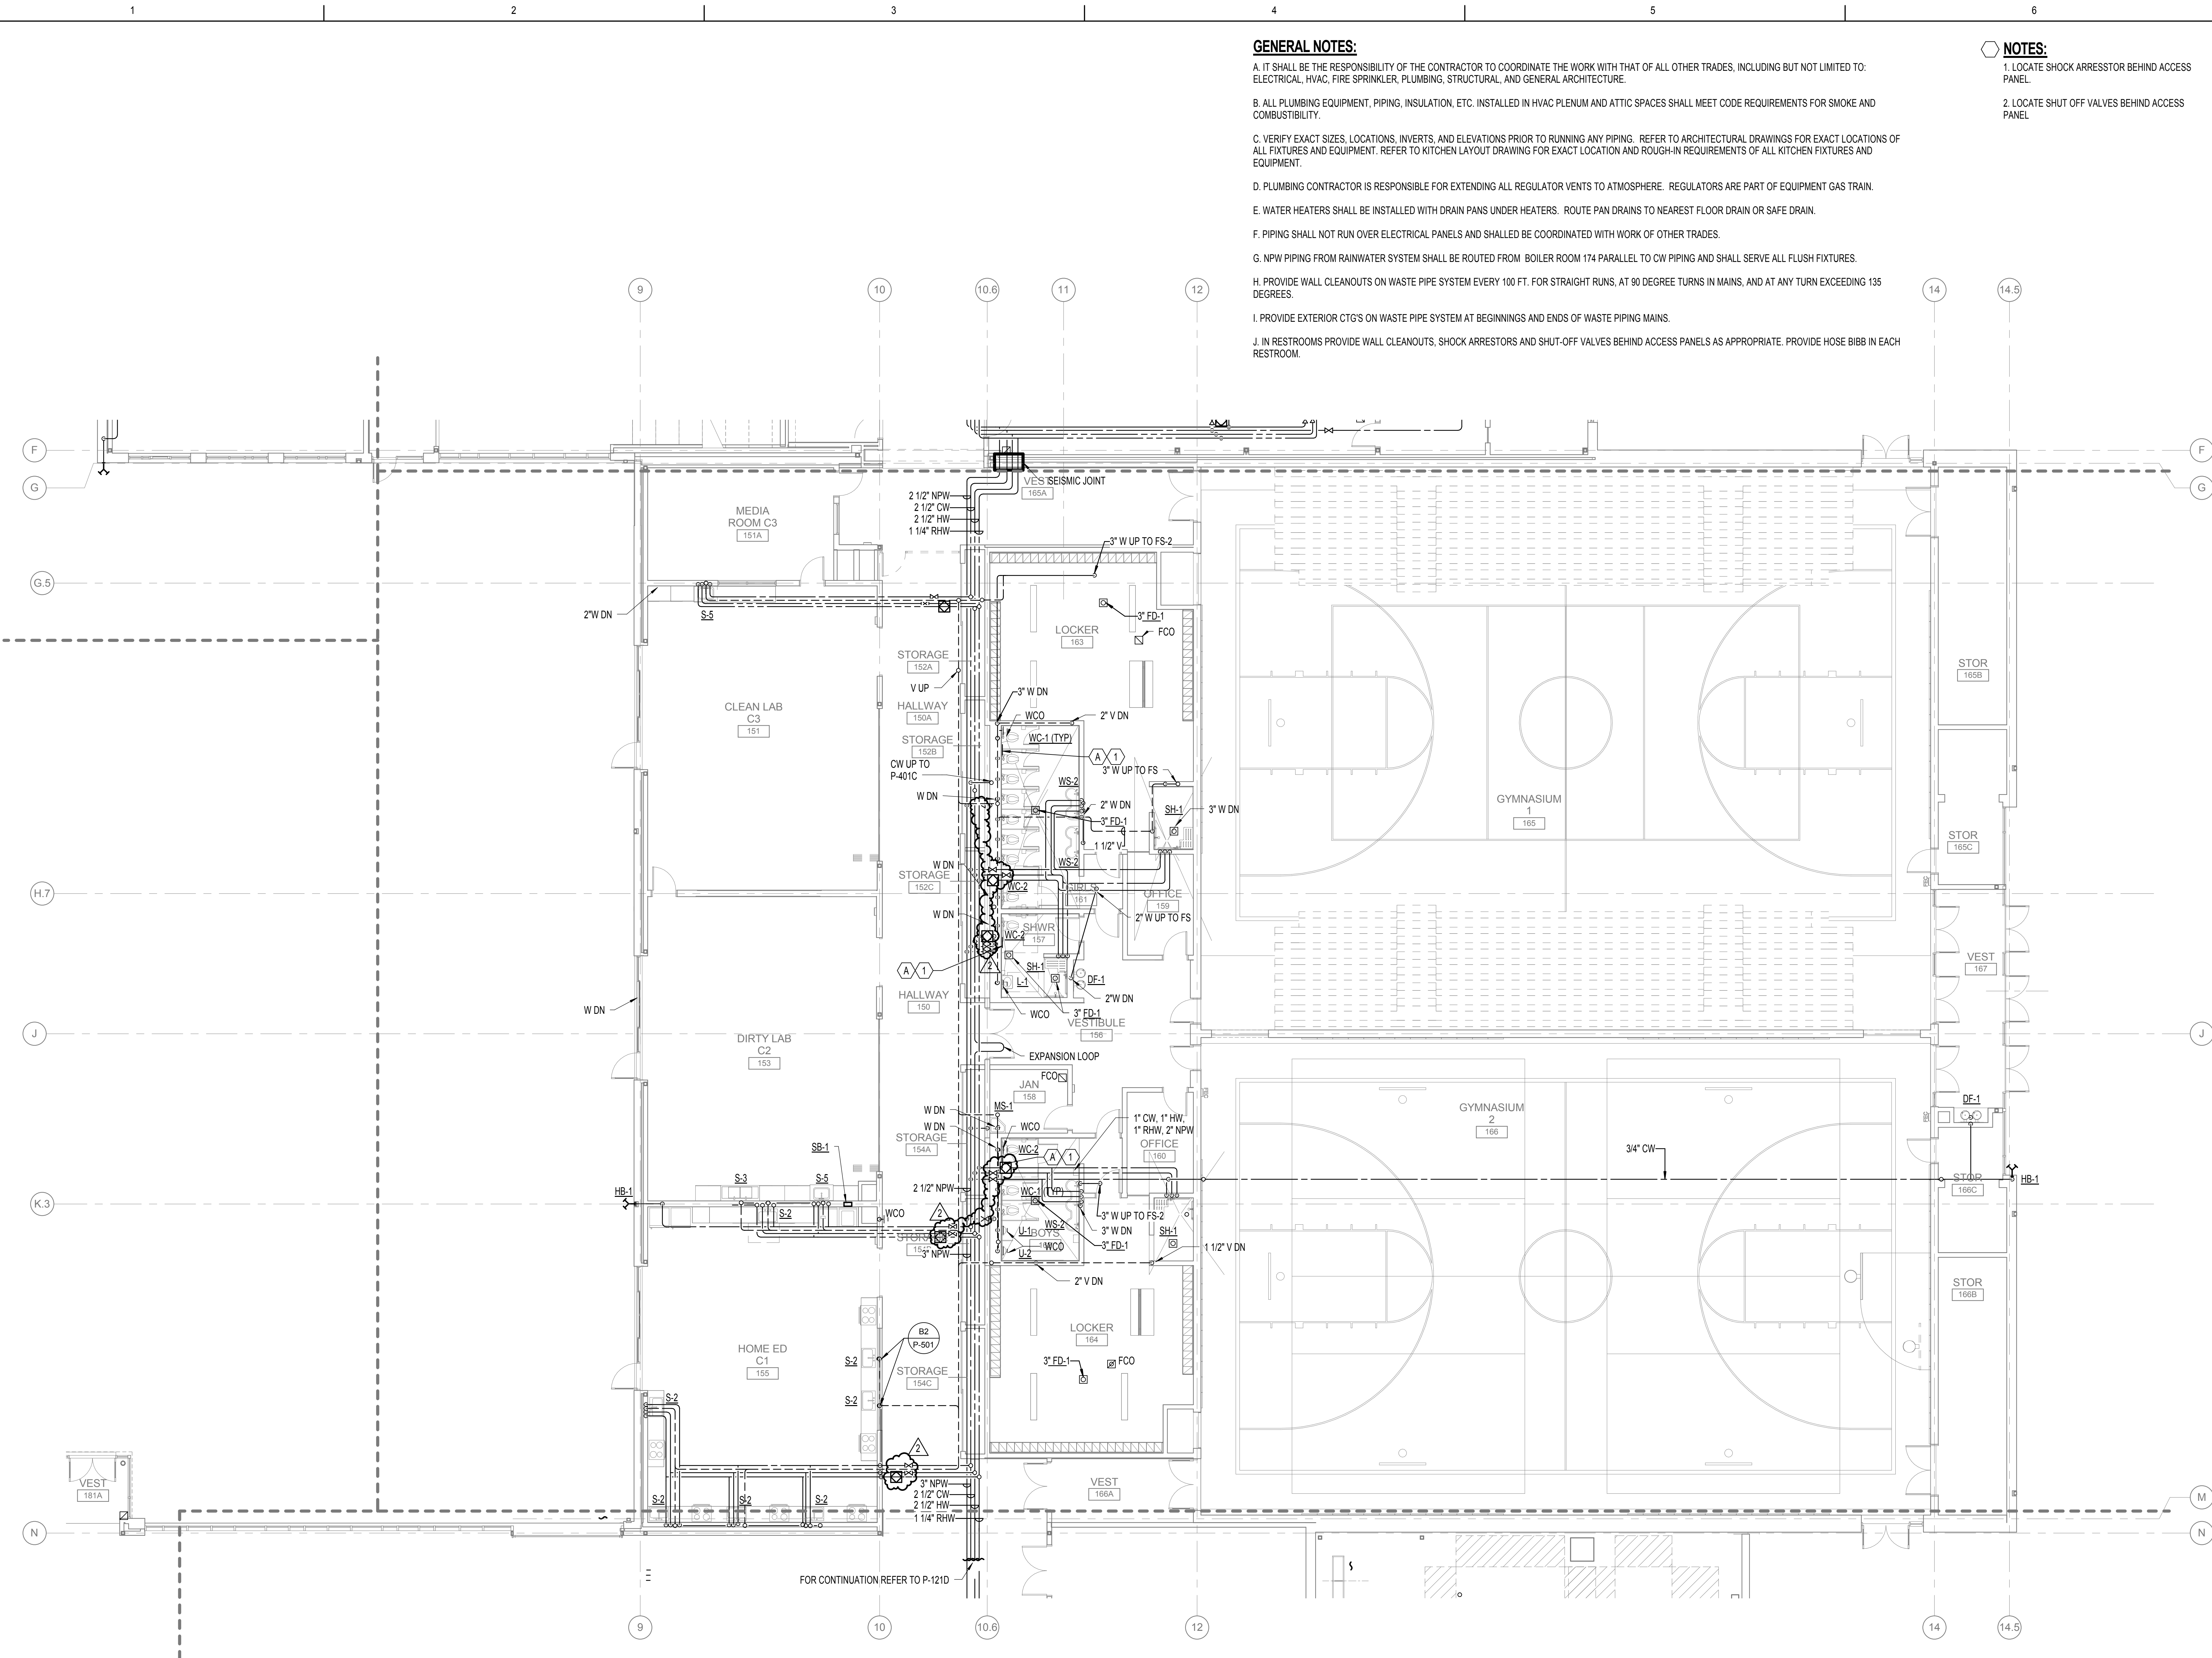

A1 FIRST FLOOR PLAN - ZONE C - PLUMBING
1/8" = 1'-0"

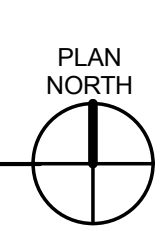

GENERAL NOTES:

- A. IT SHALL BE THE RESPONSIBILITY OF THE CONTRACTOR TO COORDINATE THE WORK WITH THAT OF ALL OTHER TRADES, INCLUDING BUT NOT LIMITED TO: ELECTRICAL, HVAC, FIRE SPRINKLER, PLUMBING, STRUCTURAL, AND GENERAL ARCHITECTURE.
- B. ALL PLUMBING EQUIPMENT, PIPING, INSULATION, ETC. INSTALLED IN HVAC PLENUM AND ATTIC SPACES SHALL MEET CODE REQUIREMENTS FOR SMOKE AND COMBUSTIBILITY.
- C. VERIFY EXACT SIZES, LOCATIONS, INVERTS, AND ELEVATIONS PRIOR TO RUNNING ANY PIPING. REFER TO ARCHITECTURAL DRAWINGS FOR EXACT LOCATIONS OF ALL FIXTURES AND EQUIPMENT. REFER TO KITCHEN LAYOUT DRAWING FOR EXACT LOCATION AND ROUGH-IN REQUIREMENTS OF ALL KITCHEN FIXTURES AND EQUIPMENT.
- D. PLUMBING CONTRACTOR IS RESPONSIBLE FOR EXTENDING ALL REGULATOR VENTS TO ATMOSPHERE. REGULATORS ARE PART OF EQUIPMENT GAS TRAIN.
- E. WATER HEATERS SHALL BE INSTALLED WITH DRAIN PANS UNDER HEATERS. ROUTE PAN DRAINS TO NEAREST FLOOR DRAIN OR SAFE DRAIN.
- F. PIPING SHALL NOT RUN OVER ELECTRICAL PANELS AND SHALL BE COORDINATED WITH WORK OF OTHER TRADES.
- G. NPW PIPING FROM RAINWATER SYSTEM SHALL BE ROUTED FROM BOILER ROOM 174 PARALLEL TO CW PIPING AND SHALL SERVE ALL FLUSH FIXTURES.
- H. PROVIDE WALL CLEANOUTS ON WASTE PIPE SYSTEM EVERY 100 FT. FOR STRAIGHT RUNS, AT 90 DEGREE TURNS IN MAINS, AND AT ANY TURN EXCEEDING 135 DEGREES.
- I. PROVIDE EXTERIOR CTG'S ON WASTE PIPE SYSTEM AT BEGINNINGS AND ENDS OF WASTE PIPING MAINS.
- J. IN RESTROOMS PROVIDE WALL CLEANOUTS, SHOCK ARRESTORS AND SHUT-OFF VALVES BEHIND ACCESS PANELS AS APPROPRIATE. PROVIDE HOSE BIBB IN EACH RESTROOM.

NOTES:

- 1. LOCATE SHOCK ARRESTOR BEHIND ACCESS PANEL.
- 2. LOCATE SHUT OFF VALVES BEHIND ACCESS PANEL.

mahlum
Robertson/Sherwood Architects
ROBERTSON/SHERWOOD/ARCHITECTS PC
132 EAST BROADWAY, SUITE 540
EUGENE, OREGON 97401
541-342-8077
www.robertsonsherwood.com

MAHLUM ARCHITECTS INC
1231 NW HOYT, SUITE 102
PORTLAND, OREGON 97209
503-224-4032

71 COLUMBIA, FLOOR 4
SEATTLE, WASHINGTON 98104
206-441-4151
www.mahlum.com

PAE
Portland | San Francisco | Seattle
pae-engineers.com



EUGENE SCHOOL DISTRICT 4J

4J

REPLACEMENT ROOSEVELT
MIDDLE SCHOOL
CIP NUMBER 410.566.001
680 EAST 24TH AVENUE
EUGENE, OREGON 97405
CIP NO. 410.566.001

MARK	DATE	DESCRIPTION
2	03-13-2015	ADDENDUM 6
1	2-27-2015	ADDENDUM 1

ISSUE DATE: FEBRUARY 18, 2015
ISSUE: CONSTRUCTION DOCUMENTS
VOLUME: PACKAGE 2 VOLUME 2

PROJECT NO.: 2013912.00
DRAWN BY: SG
CHECKED BY: JCY
COPYRIGHT MAHLUM ARCHITECTS, INC. 2014 ORIGINAL SHEET SIZE: 30"x42"

FIRST FLOOR PLAN - ZONE C - PLUMBING


P-121C

3/10/2015 3:52:22 PM C:\Users\Local\Public\3108\BPI\4-CENTRAL_Lam\BPI\01

GENERAL NOTES:

- A. IT SHALL BE THE RESPONSIBILITY OF THE CONTRACTOR TO COORDINATE THE WORK WITH THAT OF ALL OTHER TRADES, INCLUDING BUT NOT LIMITED TO: ELECTRICAL, HVAC, FIRE SPRINKLER, PLUMBING, STRUCTURAL, AND GENERAL ARCHITECTURE.
- B. ALL PLUMBING EQUIPMENT, PIPING, INSULATION, ETC. INSTALLED IN HVAC PLENUM AND ATTIC SPACES SHALL MEET CODE REQUIREMENTS FOR SMOKE AND COMBUSTIBILITY.
- C. VERIFY EXACT SIZES, LOCATIONS, INVERTS, AND ELEVATIONS PRIOR TO RUNNING ANY PIPING. REFER TO ARCHITECTURAL DRAWINGS FOR EXACT LOCATIONS OF ALL FIXTURES AND EQUIPMENT. REFER TO KITCHEN LAYOUT DRAWING FOR EXACT LOCATION AND ROUGH-IN REQUIREMENTS OF ALL KITCHEN FIXTURES AND EQUIPMENT.
- D. PLUMBING CONTRACTOR IS RESPONSIBLE FOR EXTENDING ALL REGULATOR VENTS TO ATMOSPHERE. REGULATORS ARE PART OF EQUIPMENT GAS TRAIN.
- E. WATER HEATERS SHALL BE INSTALLED WITH DRAIN PANS UNDER HEATERS. ROUTE PAN DRAINS TO NEAREST FLOOR DRAIN OR SAFE DRAIN.
- F. PIPING SHALL NOT RUN OVER ELECTRICAL PANELS AND SHALL BE COORDINATED WITH WORK OF OTHER TRADES.
- G. NPW PIPING FROM RAINWATER SYSTEM SHALL BE ROUTED FROM BOILER ROOM 174 PARALLEL TO CW PIPING AND SHALL SERVE ALL FLUSH FIXTURES.
- H. PROVIDE WALL CLEANOUTS ON WASTE PIPE SYSTEM EVERY 100 FT. FOR STRAIGHT RUNS, AT 90 DEGREE TURNS IN MAINS, AND AT ANY TURN EXCEEDING 135 DEGREES.
- I. PROVIDE EXTERIOR CTG'S ON WASTE PIPE SYSTEM AT BEGINNINGS AND ENDS OF WASTE PIPING MAINS.
- J. IN RESTROOMS PROVIDE WALL CLEANOUTS, SHOCK ARRESTORS AND SHUT-OFF VALVES BEHIND ACCESS PANELS AS APPROPRIATE. PROVIDE HOSE BIBB IN EACH RESTROOM.

- NOTES:
1. LOCATE SHOCK ARRESTOR BEHIND ACCESS PANEL.

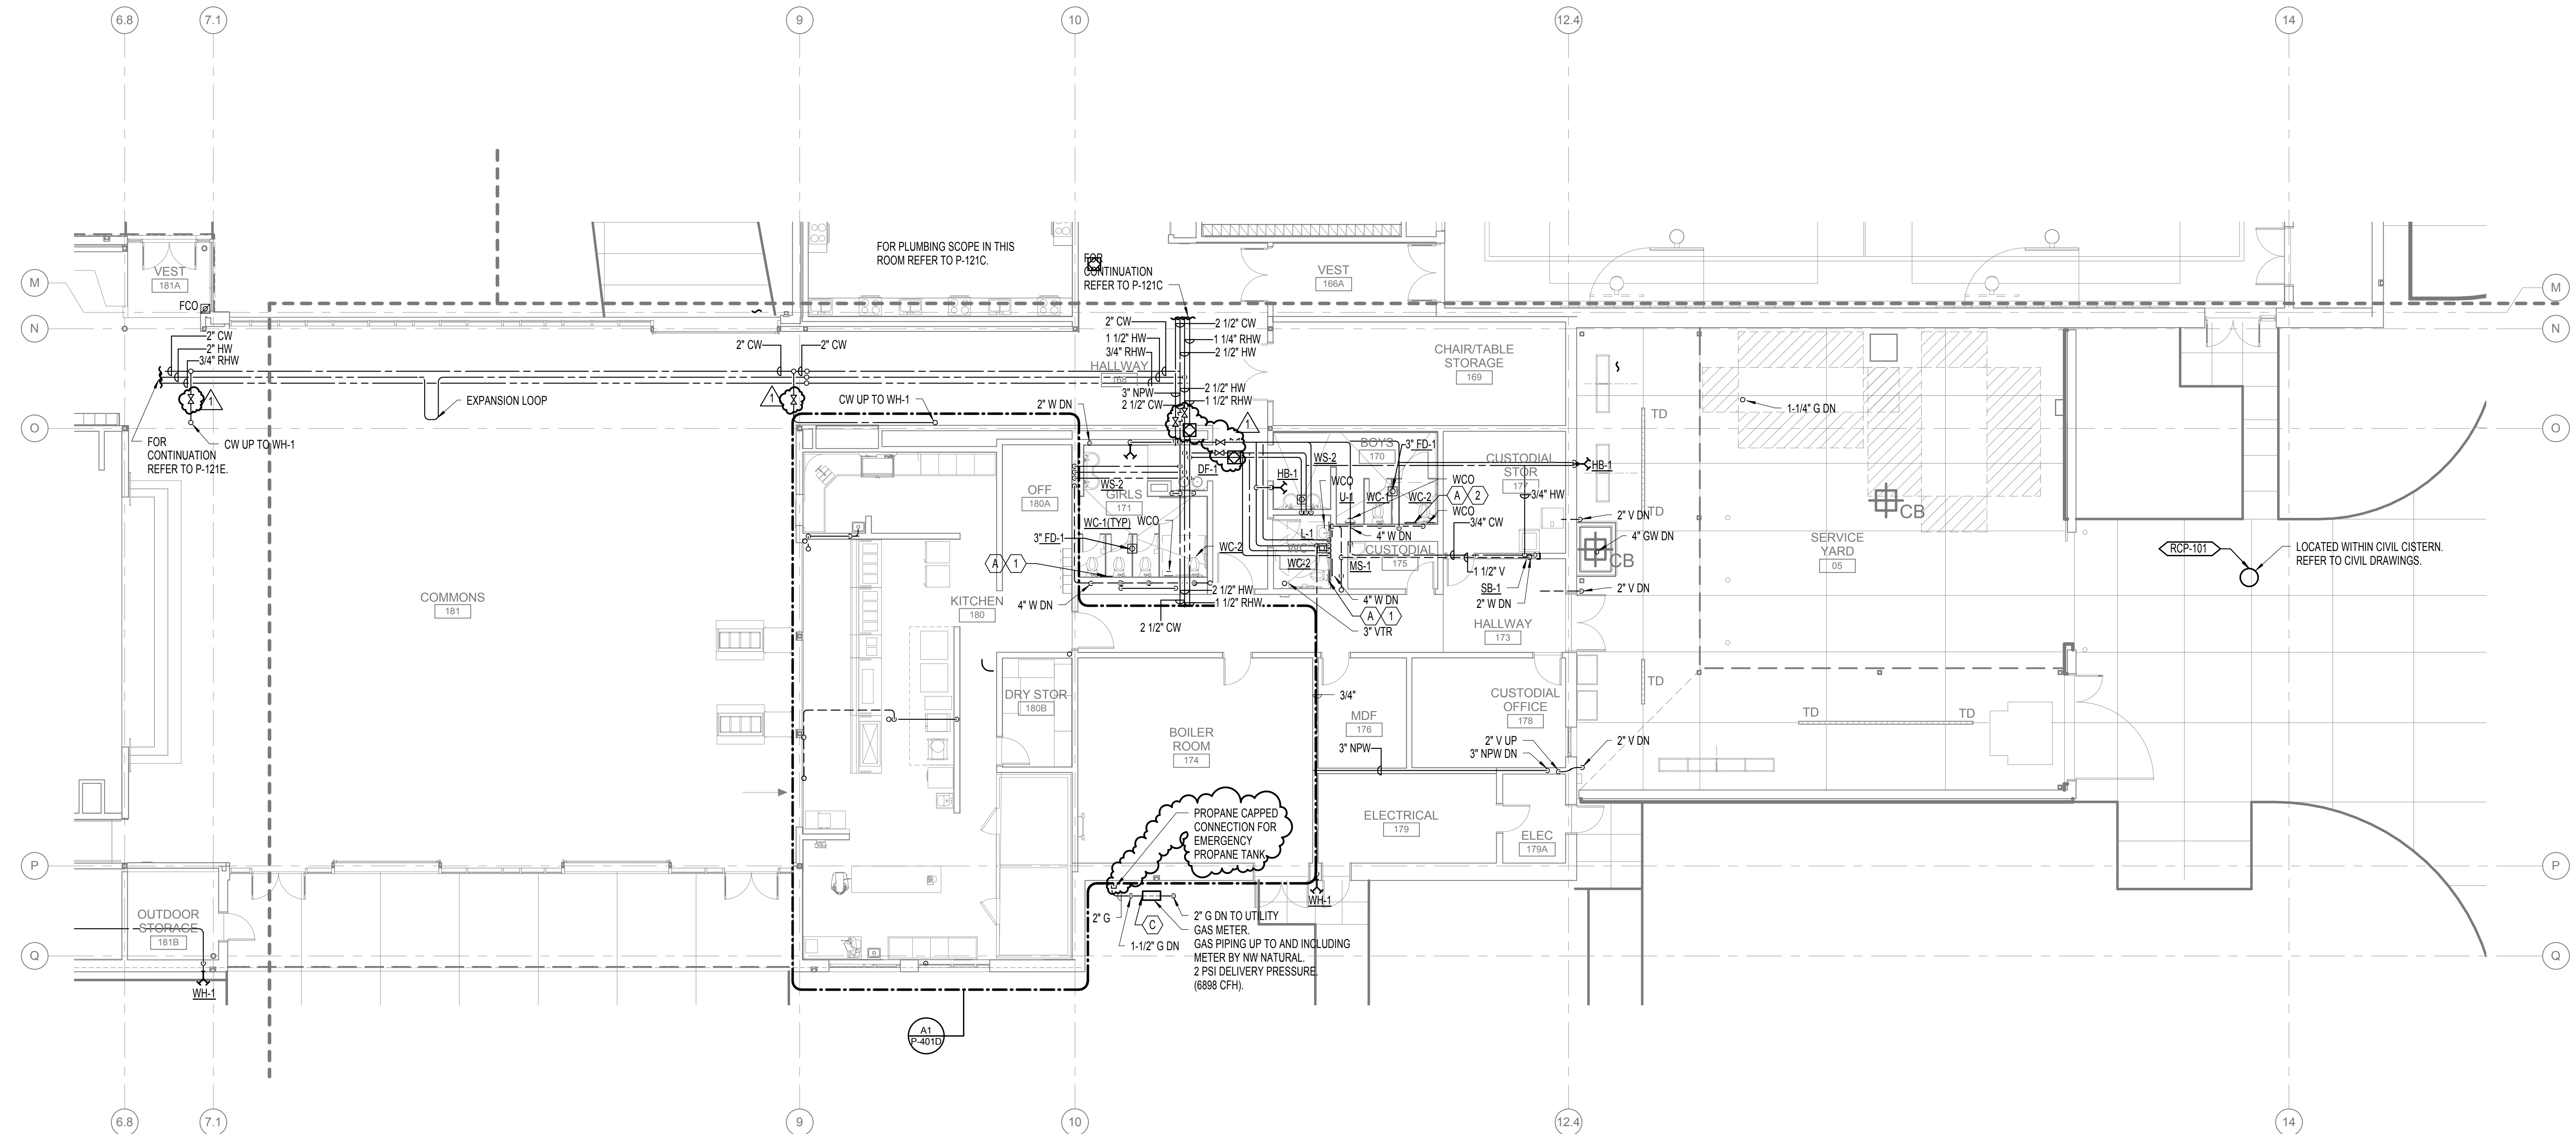

EUGENE SCHOOL DISTRICT 4J




REPLACEMENT ROOSEVELT
MIDDLE SCHOOL
CIP NUMBER 410.566.001
680 EAST 24TH AVENUE
EUGENE, OREGON 97405
CIP NO. 410.566.001

MARK	DATE	DESCRIPTION
1	03-13-2015	ADDENDUM 6


ISSUE DATE:	FEBRUARY 18, 2015
ISSUE:	CONSTRUCTION DOCUMENTS
VOLUME:	PACKAGE 2 VOLUME 2
PROJECT NO.:	2013912.00
DRAWN BY:	SG
CHECKED BY:	JCY

COPYRIGHT MAHLUM ARCHITECTS, INC. 2014 ORIGINAL SHEET SIZE: 36"X48"
A FIRST FLOOR PLAN - ZONE D - PLUMBING

A1 FIRST FLOOR PLAN - ZONE D - PLUMBING
1/8" = 1'-0"

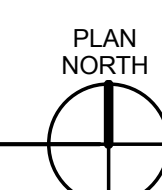

P-121D

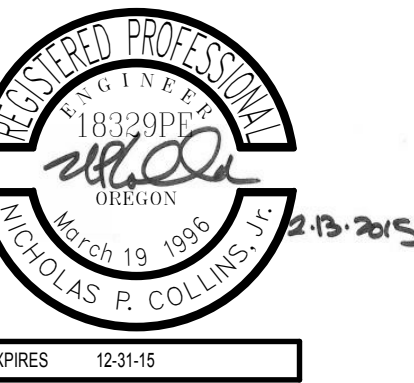


MARK	DATE	DESCRIPTION
2	03-13-2015	ADDENDUM 6
1	2-27-2015	ADDENDUM 1

ISSUE DATE: FEBRUARY 18, 2015
ISSUE: CONSTRUCTION DOCUMENTS
VOLUME: PACKAGE 2 VOLUME 2

PROJECT NO.: 2013912.00
DRAWN BY: SG
CHECKED BY: JCY
COPYRIGHT MAHLUM ARCHITECTS, INC. 2014 ORIGINAL SHEET SIZE: 30"x42"

FIRST FLOOR PLAN - ZONE E - PLUMBING

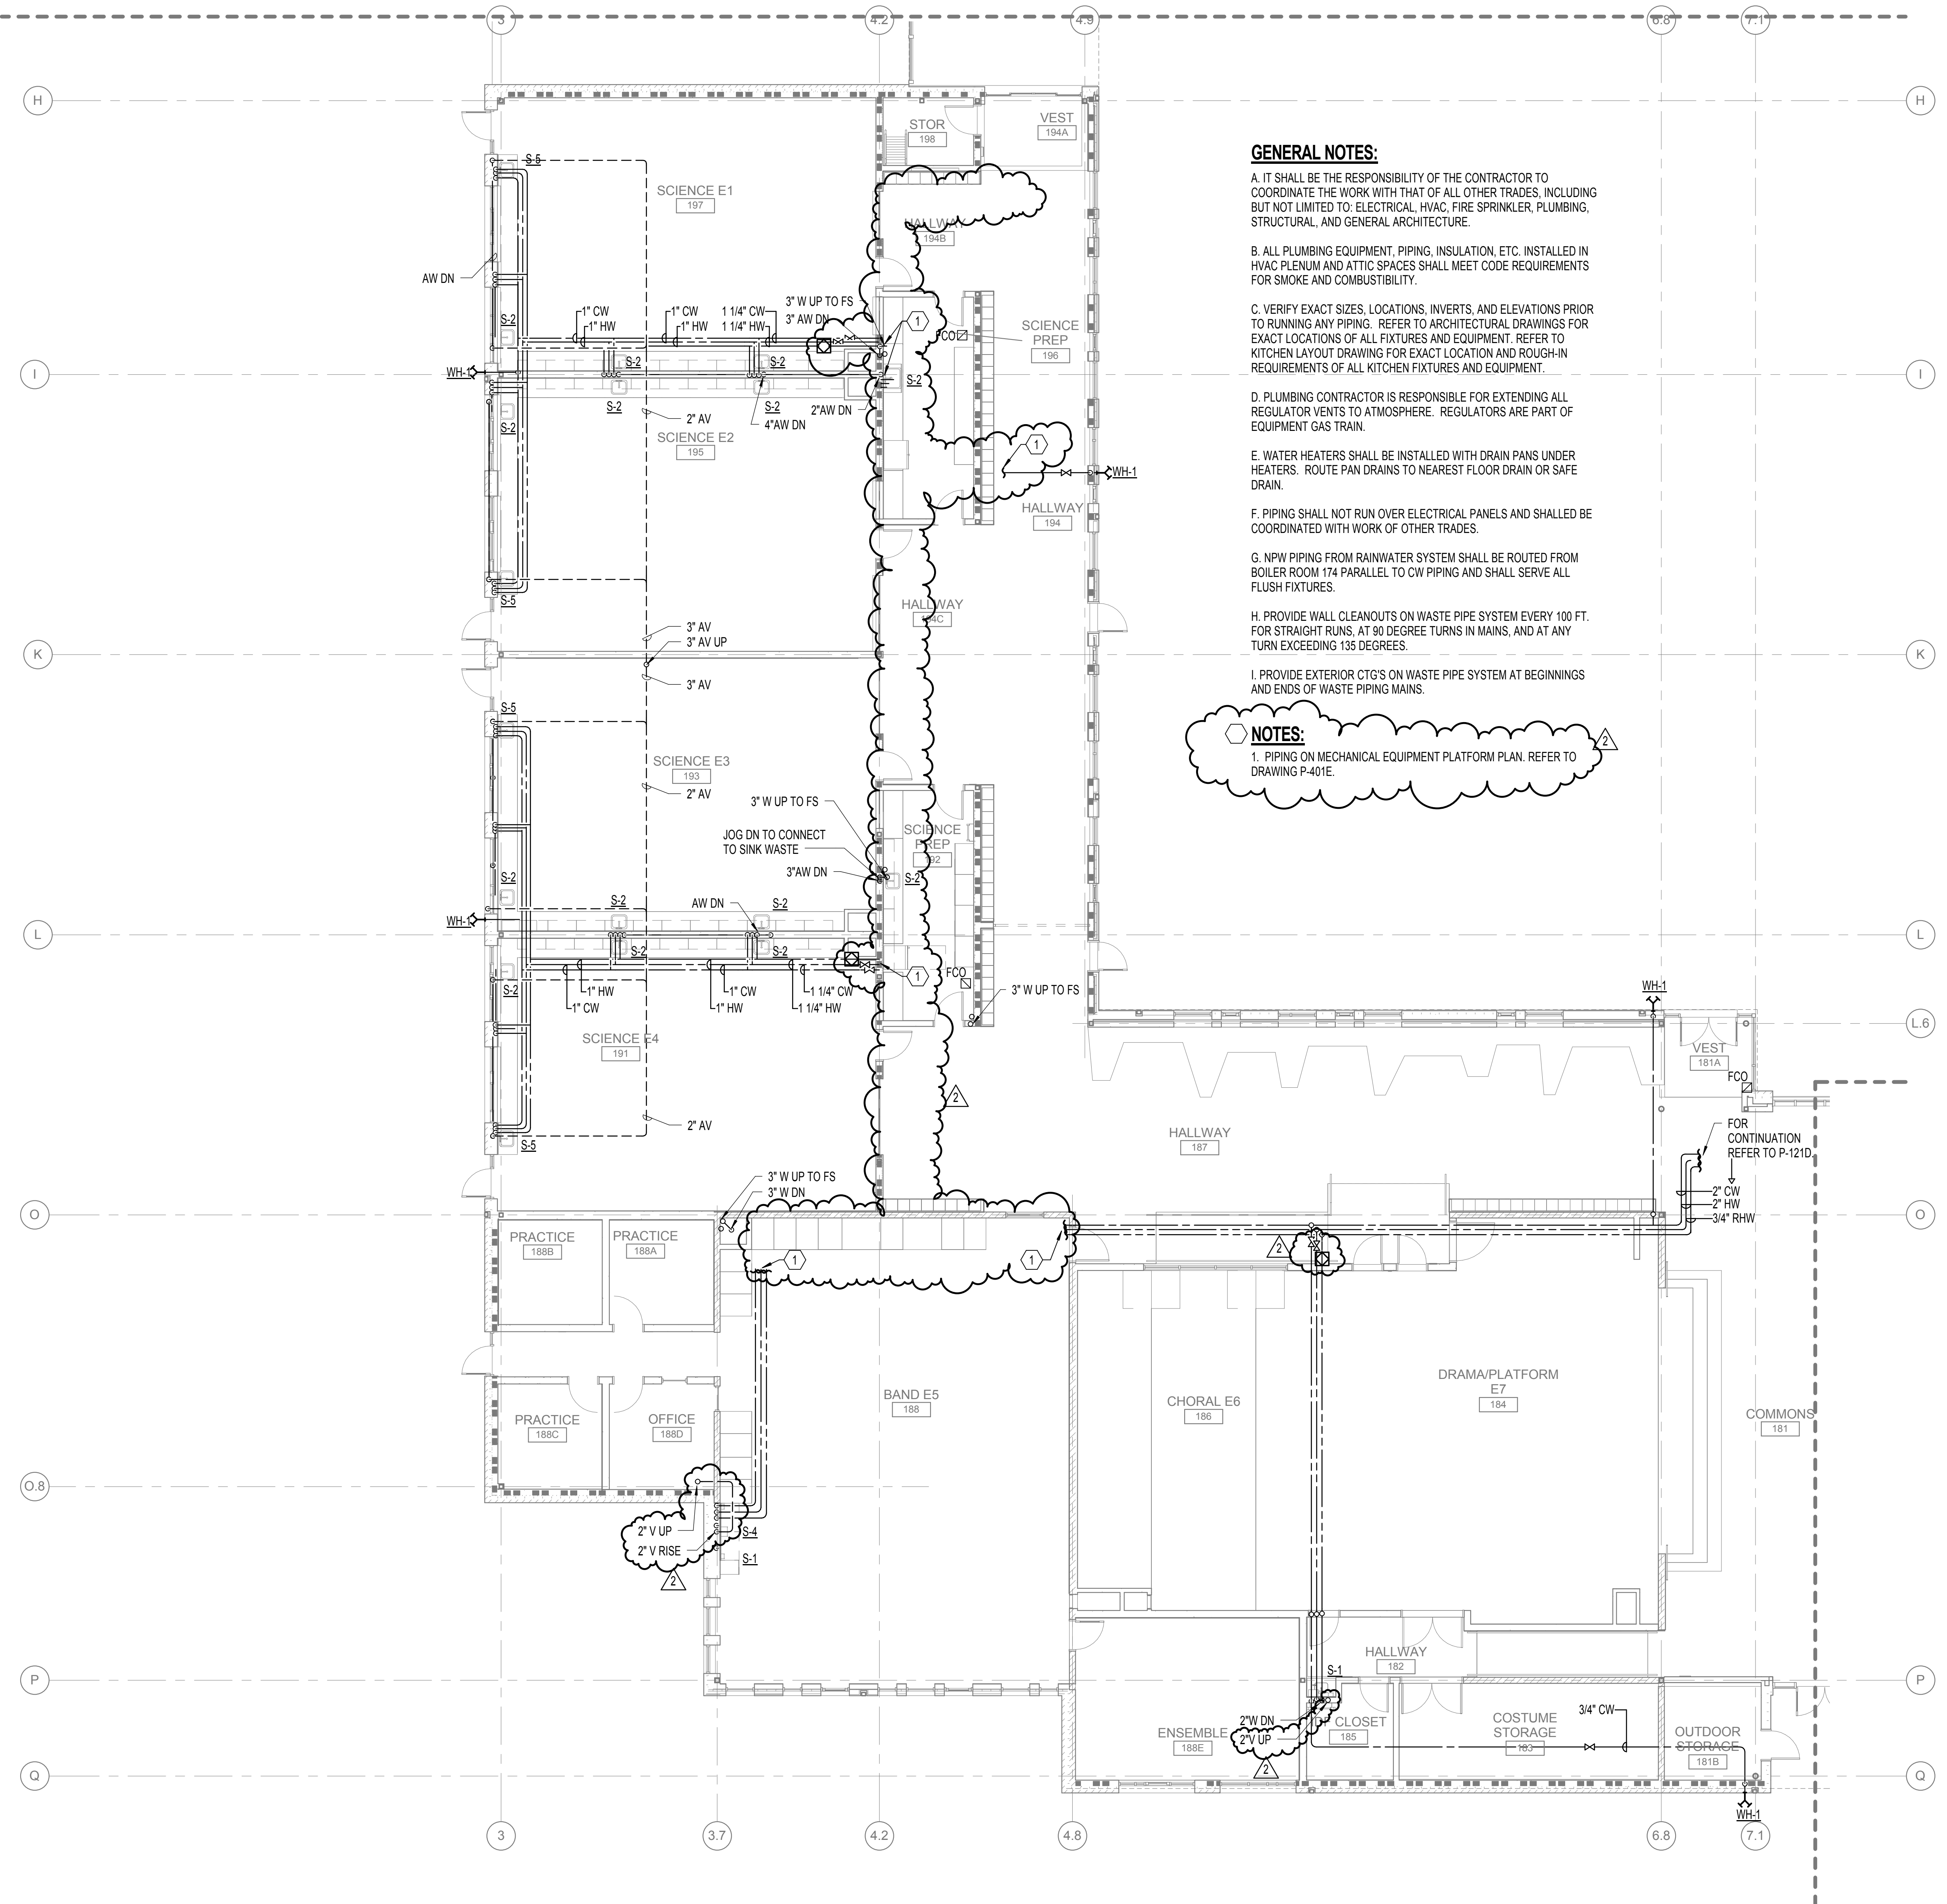


GENERAL NOTES:

- A. IT SHALL BE THE RESPONSIBILITY OF THE CONTRACTOR TO COORDINATE THE WORK WITH THAT OF ALL OTHER TRADES, INCLUDING BUT NOT LIMITED TO: ELECTRICAL, HVAC, FIRE SPRINKLER, PLUMBING, STRUCTURAL, AND GENERAL ARCHITECTURE.
- B. ALL PLUMBING EQUIPMENT, PIPING, INSULATION, ETC. INSTALLED IN HVAC PLENUM AND ATTIC SPACES SHALL MEET CODE REQUIREMENTS FOR SMOKE AND COMBUSTIBILITY.
- C. VERIFY EXACT SIZES, LOCATIONS, INVERTS, AND ELEVATIONS PRIOR TO RUNNING ANY PIPING. REFER TO ARCHITECTURAL DRAWINGS FOR EXACT LOCATIONS OF ALL FIXTURES AND EQUIPMENT. REFER TO KITCHEN LAYOUT DRAWING FOR EXACT LOCATION AND ROUGH-IN REQUIREMENTS OF ALL KITCHEN FIXTURES AND EQUIPMENT.
- D. PLUMBING CONTRACTOR IS RESPONSIBLE FOR EXTENDING ALL REGULATOR VENTS TO ATMOSPHERE. REGULATORS ARE PART OF EQUIPMENT GAS TRAIN.
- E. WATER HEATERS SHALL BE INSTALLED WITH DRAIN PANS UNDER HEATERS. ROUTE PAN DRAINS TO NEAREST FLOOR DRAIN OR SAFE DRAIN.
- F. PIPING SHALL NOT RUN OVER ELECTRICAL PANELS AND SHALL BE COORDINATED WITH WORK OF OTHER TRADES.
- G. NPW PIPING FROM RAINWATER SYSTEM SHALL BE ROUTED FROM BOILER ROOM 174 PARALLEL TO CW PIPING AND SHALL SERVE ALL FLUSH FIXTURES.
- H. PROVIDE WALL CLEANOUTS ON WASTE PIPE SYSTEM EVERY 100 FT. FOR STRAIGHT RUNS, AT 90 DEGREE TURNS IN MAINS, AND AT ANY TURN EXCEEDING 135 DEGREES.
- I. PROVIDE EXTERIOR CTC'S ON WASTE PIPE SYSTEM AT BEGINNINGS AND ENDS OF WASTE PIPING MAINS.

NOTES:

- 1. PIPING ON MECHANICAL EQUIPMENT PLATFORM PLAN. REFER TO DRAWING P-401E.

A1 FIRST FLOOR PLAN - ZONE E - PLUMBING
1/8" = 1'-0"

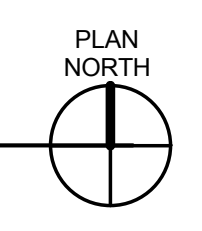

GENERAL NOTES:

- A. IT SHALL BE THE RESPONSIBILITY OF THE CONTRACTOR TO COORDINATE THE WORK WITH THAT OF ALL OTHER TRADES, INCLUDING BUT NOT LIMITED TO: ELECTRICAL, HVAC, FIRE SPRINKLER, PLUMBING, STRUCTURAL, AND GENERAL ARCHITECTURE.
- B. ALL PLUMBING EQUIPMENT, PIPING, INSULATION, ETC. INSTALLED IN HVAC PLENUM AND ATTIC SPACES SHALL MEET CODE REQUIREMENTS FOR SMOKE AND COMBUSTIBILITY.
- C. VERIFY EXACT SIZES, LOCATIONS, INVERTS, AND ELEVATIONS PRIOR TO RUNNING ANY PIPING. REFER TO ARCHITECTURAL DRAWINGS FOR EXACT LOCATIONS OF ALL FIXTURES AND EQUIPMENT. REFER TO KITCHEN LAYOUT DRAWING FOR EXACT LOCATION AND ROUGH-IN REQUIREMENTS OF ALL KITCHEN FIXTURES AND EQUIPMENT.
- D. PLUMBING CONTRACTOR IS RESPONSIBLE FOR EXTENDING ALL REGULATOR VENTS TO ATMOSPHERE. REGULATORS ARE PART OF EQUIPMENT GAS TRAIN.
- E. WATER HEATERS SHALL BE INSTALLED WITH DRAIN PANS UNDER HEATERS. ROUTE PAN DRAINS TO NEAREST FLOOR DRAIN OR SAFE DRAIN.
- F. PIPING SHALL NOT RUN OVER ELECTRICAL PANELS AND SHALL BE COORDINATED WITH WORK OF OTHER TRADES.
- G. NPW PIPING FROM RAINWATER SYSTEM SHALL BE ROUTED FROM BOILER ROOM 174 PARALLEL TO CW PIPING AND SHALL SERVE ALL FLUSH FIXTURES.
- H. PROVIDE WALL CLEANOUTS ON WASTE PIPE SYSTEM EVERY 100 FT. FOR STRAIGHT RUNS, AT 90 DEGREE TURNS IN MAINS, AND AT ANY TURN EXCEEDING 135 DEGREES.
- I. PROVIDE EXTERIOR CTG'S ON WASTE PIPE SYSTEM AT BEGINNINGS AND ENDS OF WASTE PIPING MAINS.
- J. IN RESTROOMS PROVIDE WALL CLEANOUTS, SHOCK ARRESTORS AND SHUT-OFF VALVES BEHIND ACCESS PANELS AS APPROPRIATE. PROVIDE HOSE BIBB IN EACH RESTROOM.

NOTES:

- 1. THESE ANNOTATIONS ARE TYPICAL FOR ALL "SECTOR A" CLASSROOM SINKS.
- 2. LOCATE SHOCK ARRESTOR BEHIND ACCESS PANEL
- 3. DISHWASHER - PROVIDE 1/2" HW CONNECTION & CONNECT DRAIN LINE FROM DISHWASHER TO THE SINK WASTE PIPE

mahlum
 Robert Sherwood Architects
 ROBERTSON/SHERWOOD/ARCHITECTS PC
 132 EAST BROADWAY, SUITE 540
 EUGENE, OREGON 97401
 541-342-8077
 www.robertsonsherwood.com

MAHLUM ARCHITECTS INC
 1231 NW HOYT, SUITE 102
 PORTLAND, OREGON 97209
 503-224-4032

71 COLUMBIA, FLOOR 4
 SEATTLE, WASHINGTON 98104
 206-441-4151
 www.mahlum.com

P A E
 Portland | San Francisco | Seattle
 pae-engineers.com




EUGENE SCHOOL DISTRICT 4J

UPPER FORUM 2011
REPLACEMENT ROOSEVELT MIDDLE SCHOOL
 CIP NUMBER 410.566.001
 680 EAST 24TH AVENUE
 EUGENE, OREGON 97405
 CIP NO. 410.566.001

MARK	DATE	DESCRIPTION
2	03-13-2015	ADDENDUM 6
1	2-27-2015	ADDENDUM 1

ISSUE DATE: FEBRUARY 18, 2015
 ISSUE: CONSTRUCTION DOCUMENTS
 VOLUME: PACKAGE 2 VOLUME 2

PROJECT NO: 2013912.00
 DRAWN BY: SG
 CHECKED BY: JCY
Copyright Mahlum Architects, Inc. 2014. Original Sheet Size: 30"x42"

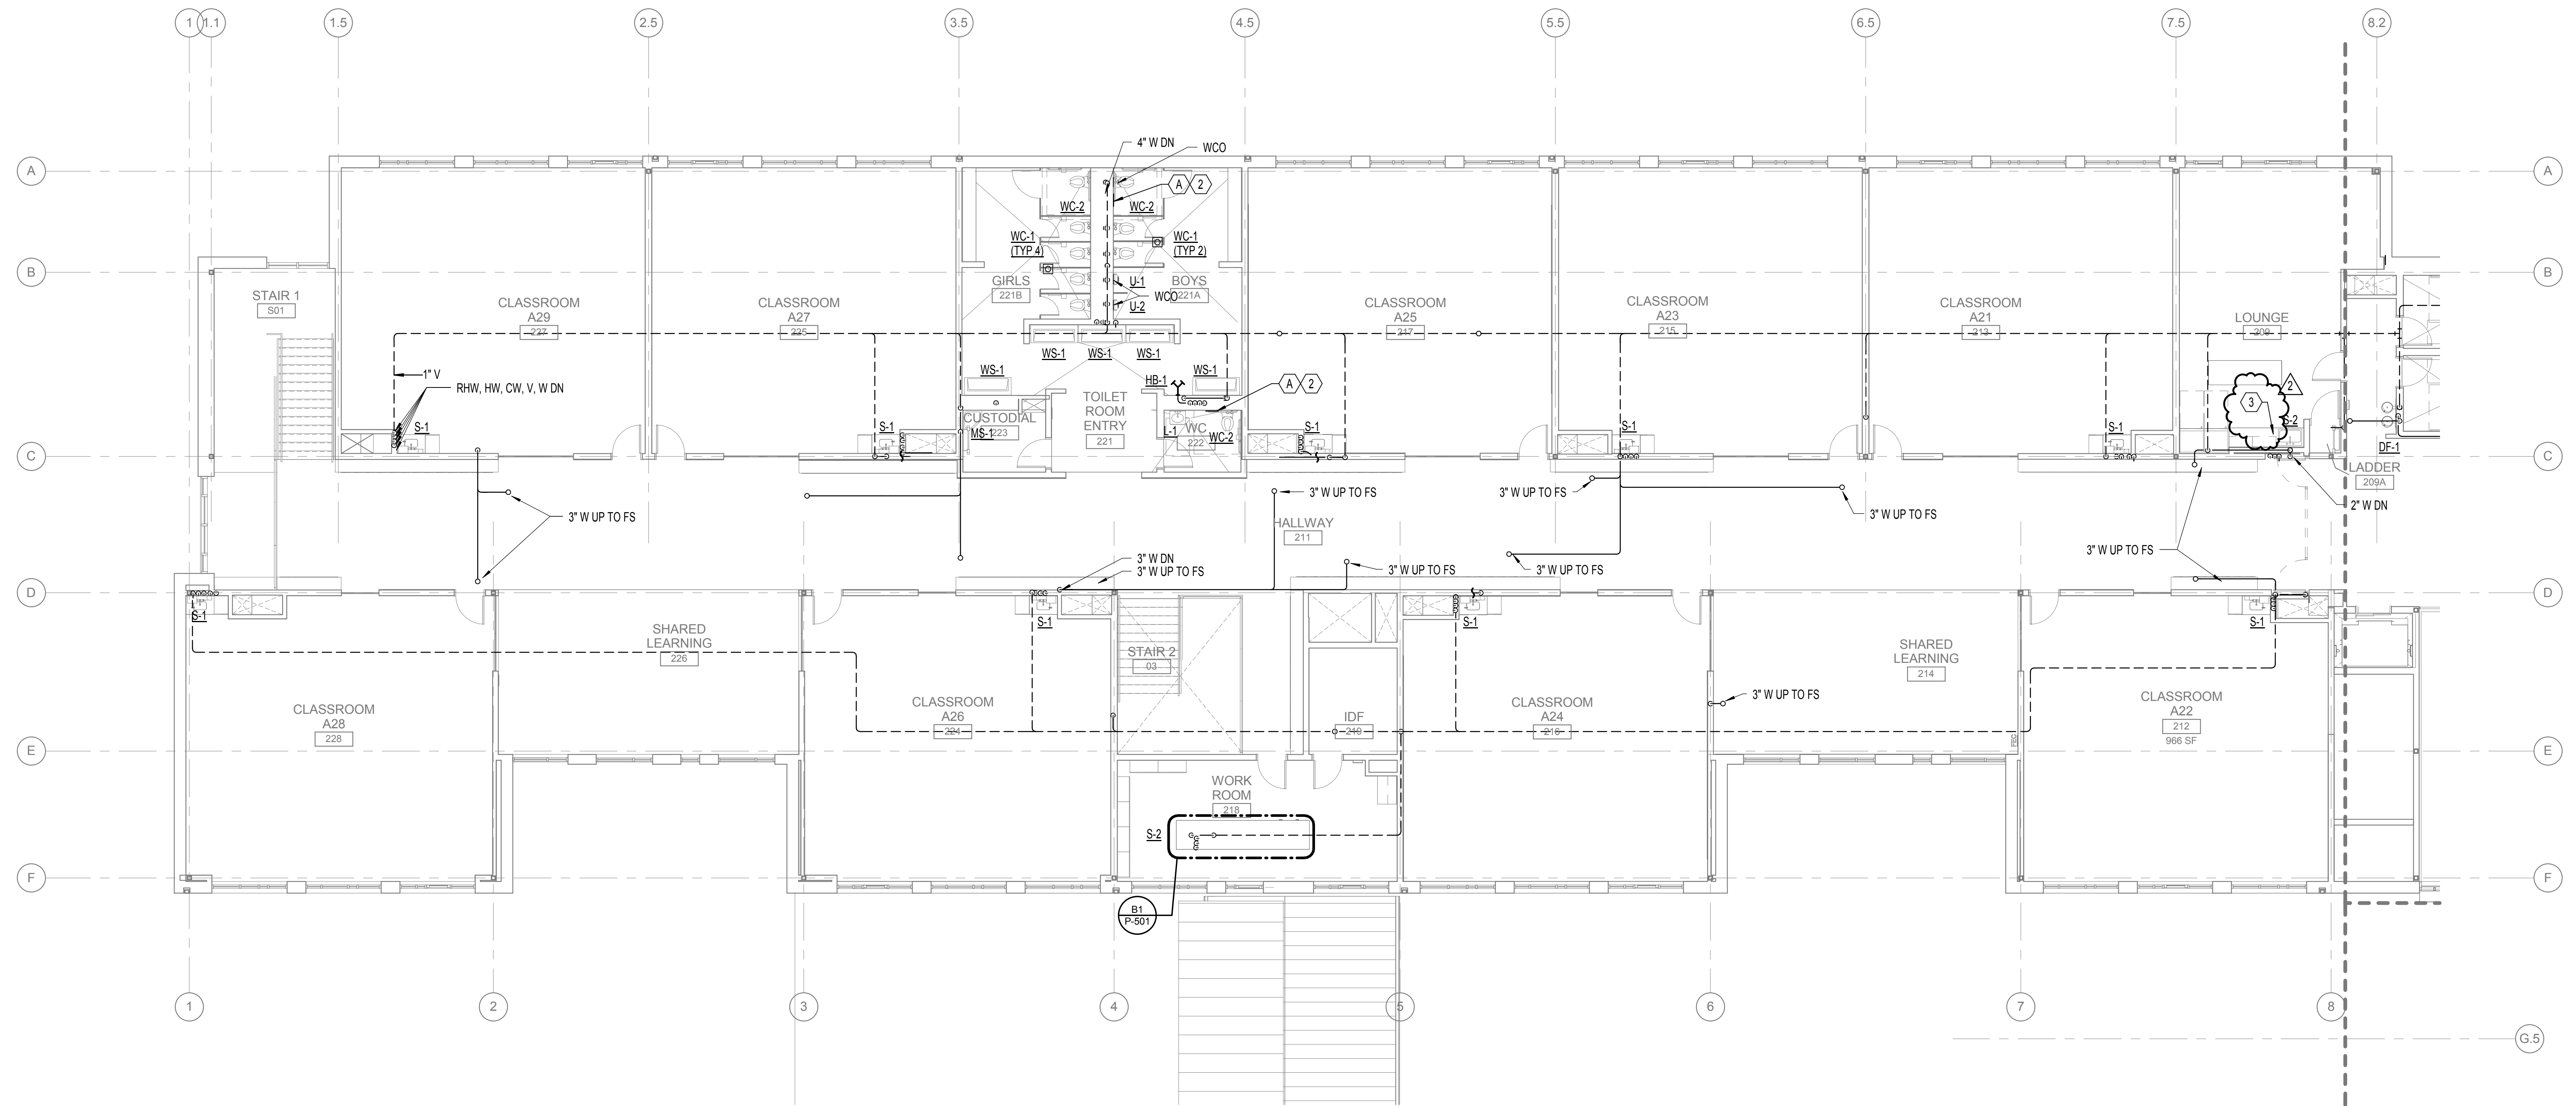

A1 SECOND FLOOR PLAN - ZONE A - PLUMBING
 1/8" = 1'-0"


3/10/2015 3:52:42 PM C:\Users\Local\Public\3-108-MPH-CENTRAL\Jama\msh001.dwg

GENERAL NOTES:

- A. IT SHALL BE THE RESPONSIBILITY OF THE CONTRACTOR TO COORDINATE THE WORK WITH THAT OF ALL OTHER TRADES, INCLUDING BUT NOT LIMITED TO: ELECTRICAL, HVAC, FIRE SPRINKLER, PLUMBING, STRUCTURAL, AND GENERAL ARCHITECTURE.
- B. ALL PLUMBING EQUIPMENT, PIPING, INSULATION, ETC. INSTALLED IN HVAC PLENUM AND ATTIC SPACES SHALL MEET CODE REQUIREMENTS FOR SMOKE AND COMBUSTIBILITY.
- C. VERIFY EXACT SIZES, LOCATIONS, INVERTS, AND ELEVATIONS PRIOR TO RUNNING ANY PIPING. REFER TO ARCHITECTURAL DRAWINGS FOR EXACT LOCATIONS OF ALL FIXTURES AND EQUIPMENT. REFER TO KITCHEN LAYOUT DRAWING FOR EXACT LOCATION AND ROUGH-IN REQUIREMENTS OF ALL KITCHEN FIXTURES AND EQUIPMENT.
- D. PLUMBING CONTRACTOR IS RESPONSIBLE FOR EXTENDING ALL REGULATOR VENTS TO ATMOSPHERE. REGULATORS ARE PART OF EQUIPMENT GAS TRAIN.
- E. WATER HEATERS SHALL BE INSTALLED WITH DRAIN PANS UNDER HEATERS. ROUTE PAN DRAINS TO NEAREST FLOOR DRAIN OR SAFE DRAIN.
- F. PIPING SHALL NOT RUN OVER ELECTRICAL PANELS AND SHALL BE COORDINATED WITH WORK OF OTHER TRADES.
- G. NPW PIPING FROM RAINWATER SYSTEM SHALL BE ROUTED FROM BOILER ROOM 174 PARALLEL TO CW PIPING AND SHALL SERVE ALL FLUSH FIXTURES.

NOTES:

- 1. (3) 48" x 96" SOLAR THERMAL WATER HEATING PANELS. MOUNT PANELS 45 DEGREES ABOVE HORIZONTAL. PER MANUFACTURER'S INSTALLATION RECOMMENDATIONS. REFER TO SPECIFICATIONS.

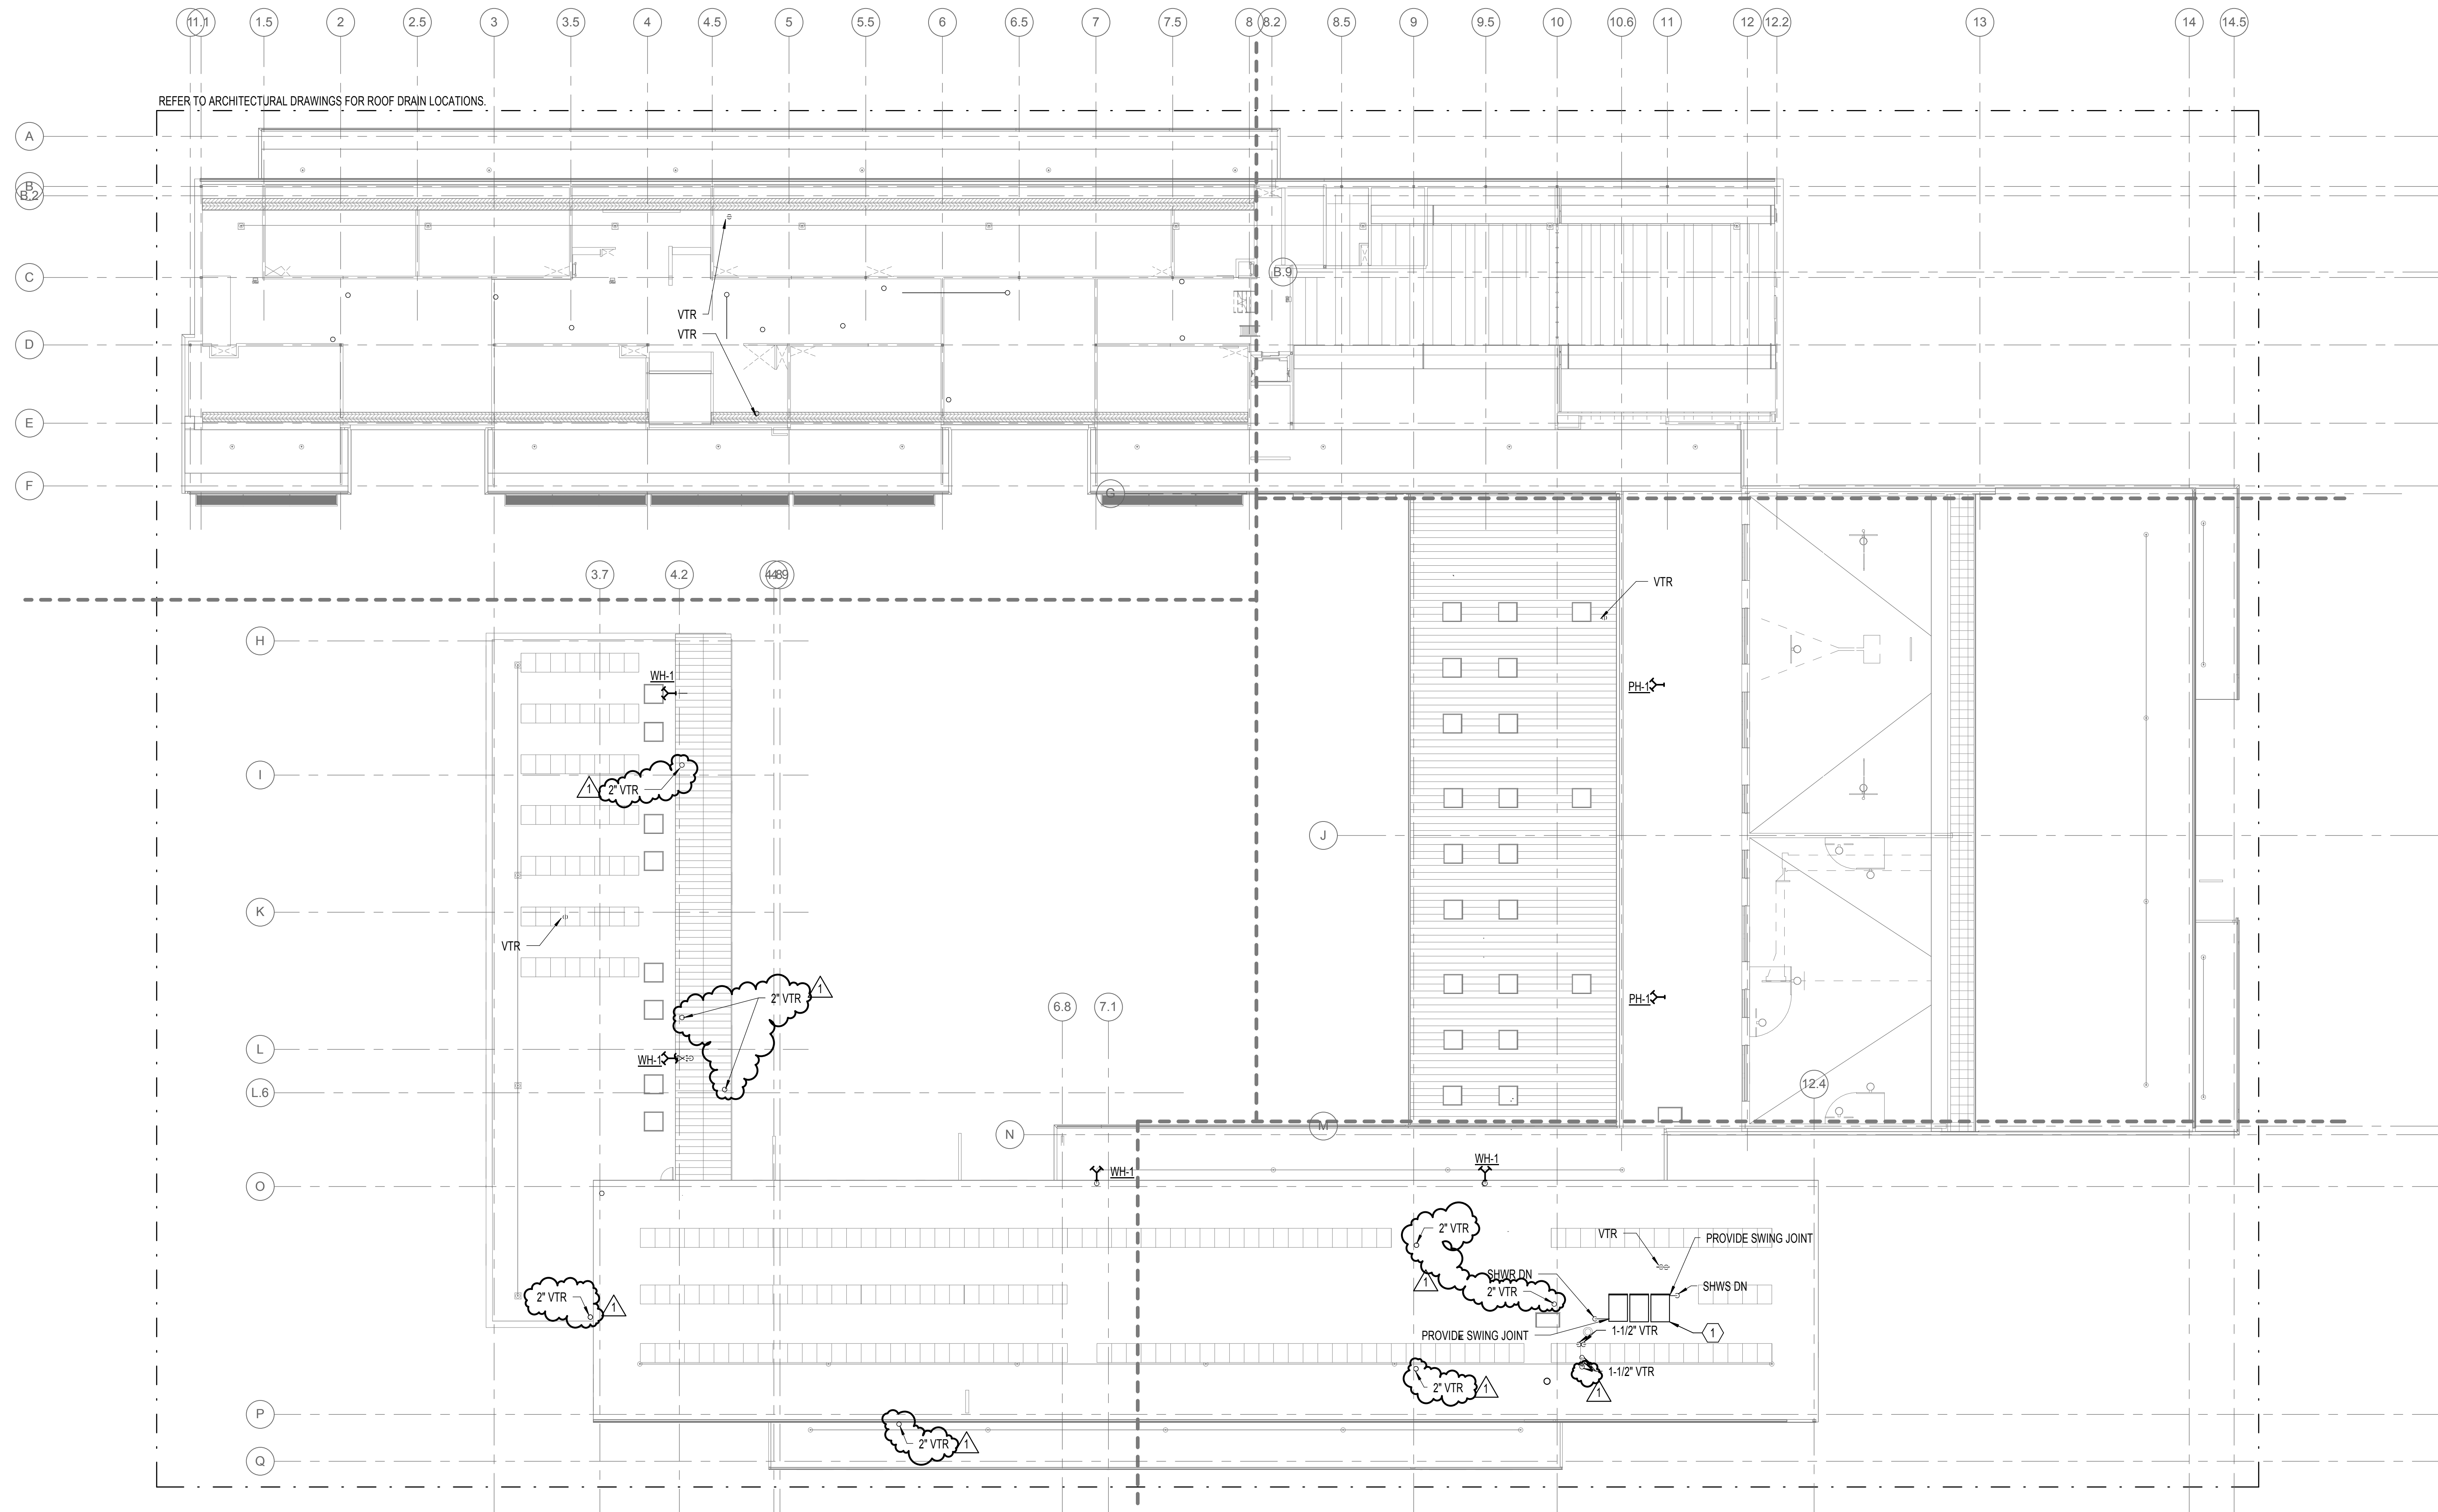

A1 ROOF PLAN OVERALL - PLUMBING
1/16" = 1'-0"




ROBERTSON/SHERWOOD/ARCHITECTS PC
132 EAST BROADWAY, SUITE 540
EUGENE, OREGON 97401
541-342-8077
www.robertsonsherwood.com

MAHLUM ARCHITECTS INC
1231 NW HOYT, SUITE 102
PORTLAND, OREGON 97209
503-224-4032
71 COLUMBIA FLOOR 4
SEATTLE, WASHINGTON 98104
206-441-4151
www.mahlum.com



EUGENE SCHOOL DISTRICT 4J

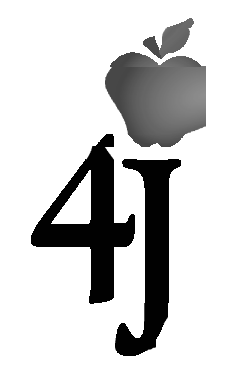

REPLACEMENT ROOSEVELT MIDDLE SCHOOL
CIP NUMBER 410.566.001
680 EAST 24TH AVENUE
EUGENE, OREGON 97405
CIP NO. 410.566.001

MARK	DATE	DESCRIPTION
1	03-13-2015	ADDENDUM 6

ISSUE DATE: FEBRUARY 18, 2015
ISSUE: CONSTRUCTION DOCUMENTS
VOLUME: PACKAGE 2 VOLUME 2

PROJECT NO: 2013912.00
DRAWN BY: SG
CHECKED BY: JCY

ROOF PLAN - PLUMBING

NOTES:
 1. FLOOR SINK FOR AHU CONDENSATE DRAINAGE.



ROBERTSON/SHERWOOD/ARCHITECTS PC
 132 EAST BROADWAY, SUITE 540
 EUGENE, OREGON 97401
 541-342-8077
 www.robertsonsherwood.com


MAHLUM ARCHITECTS INC
 1231 NW HOYT, SUITE 102
 PORTLAND, OREGON 97209
 503-224-4032
 71 COLUMBIA, FLOOR 4
 SEATTLE, WASHINGTON 98104
 206-441-4151
 www.mahlum.com




EUGENE SCHOOL DISTRICT 4J



REPLACEMENT ROOSEVELT MIDDLE SCHOOL
 CIP NUMBER 410.566.001
 680 EAST 24TH AVENUE
 EUGENE, OREGON 97405
 CIP NO. 410.566.001

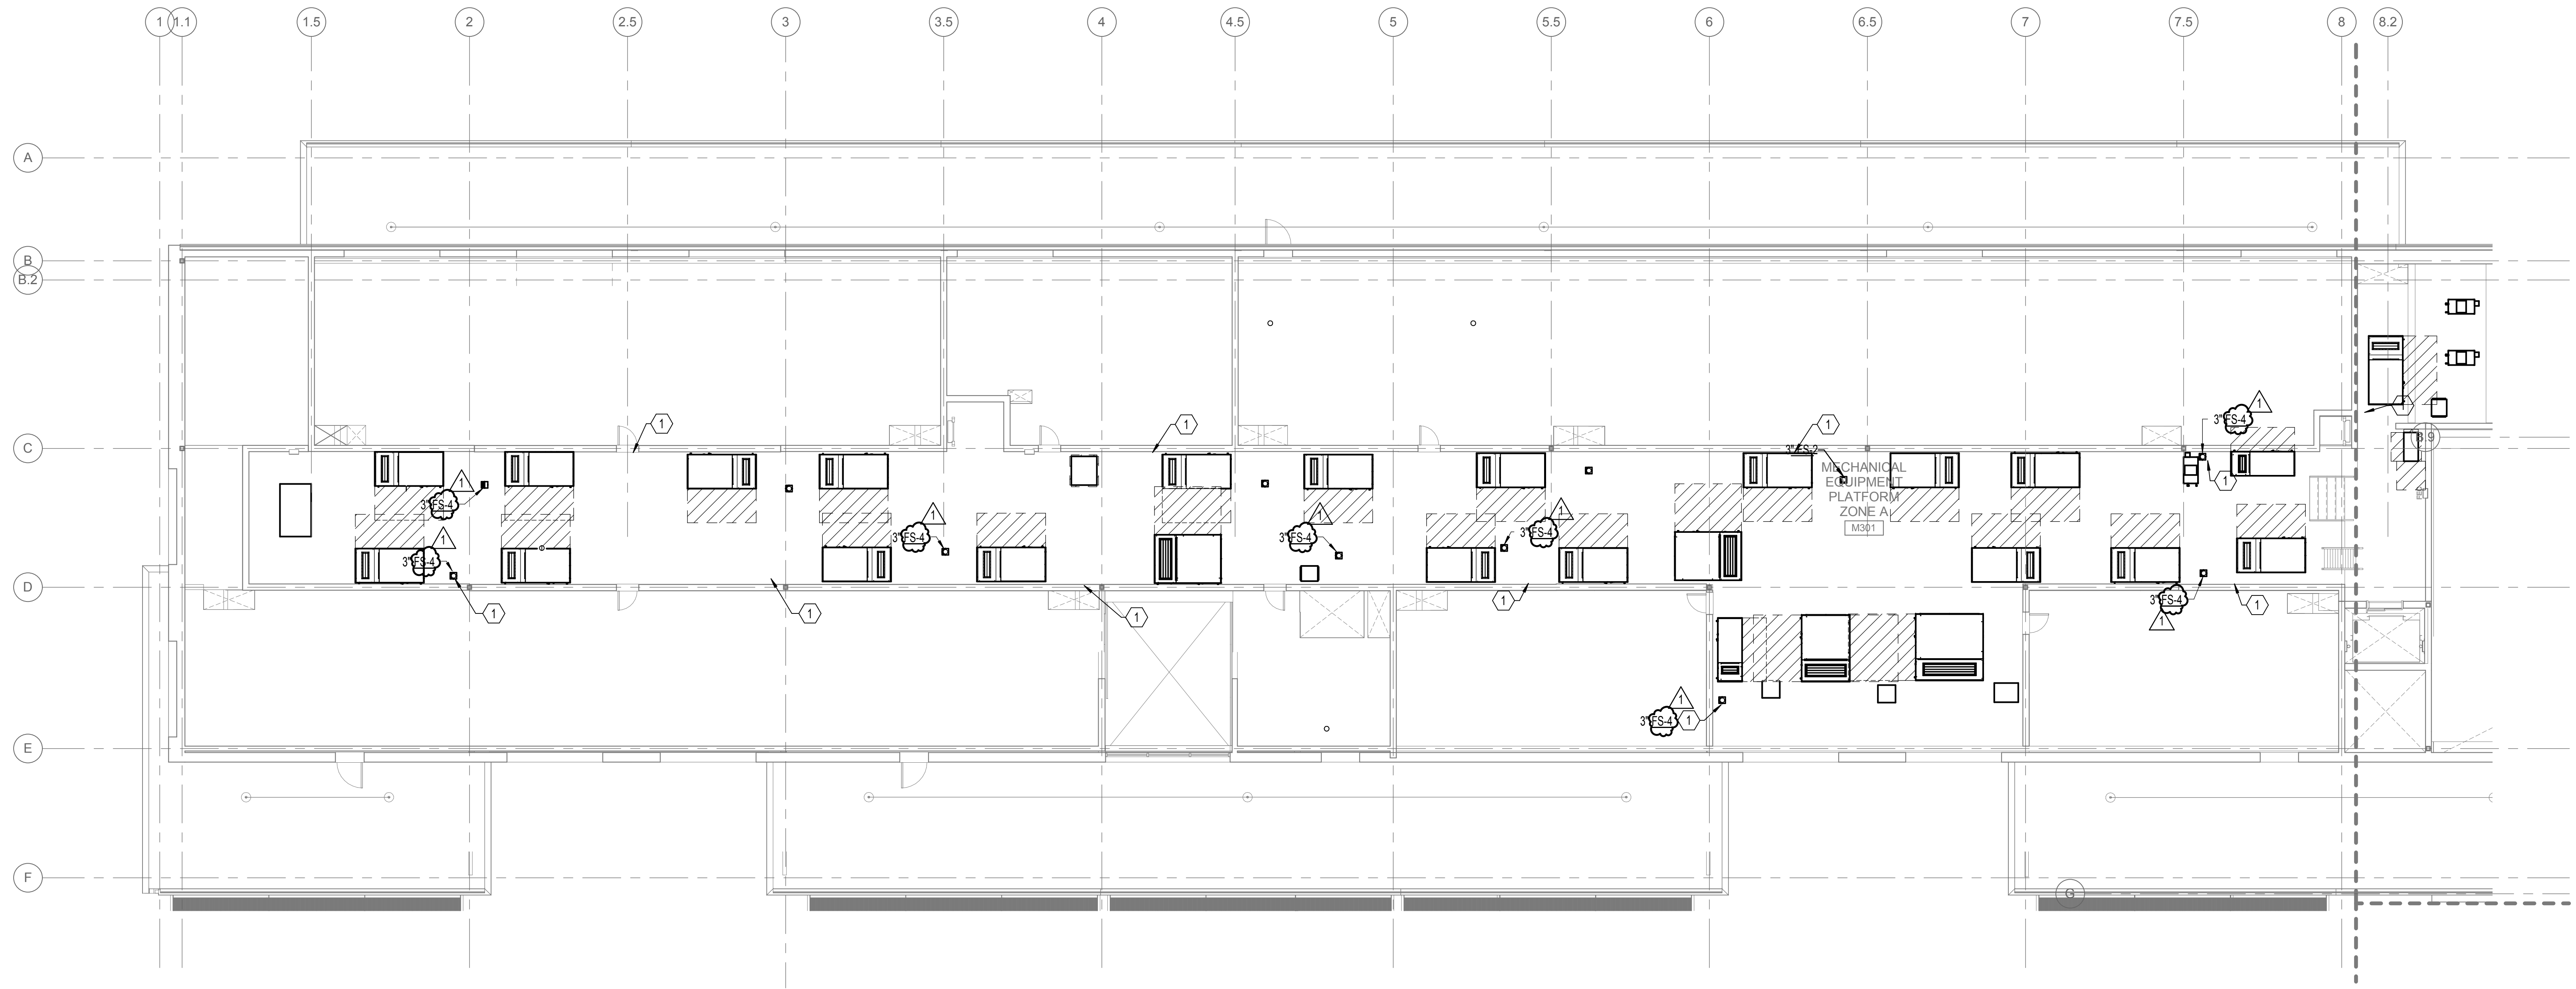

A1 MECHANICAL EQUIPMENT PLATFORM PLAN - ZONE A - PLUMBING
 1/8" = 1'-0"

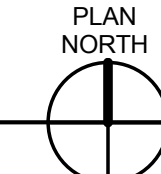

MARK	DATE	DESCRIPTION
1	03-13-2015	ADDENDUM 6

ISSUE DATE: FEBRUARY 18, 2015
 ISSUE: CONSTRUCTION DOCUMENTS
 VOLUME: PACKAGE 2 VOLUME 2
 PROJECT NO: 2013912.00
 DRAWN BY: SG
 CHECKED BY: JCY
COPYRIGHT MAHLUM ARCHITECTS, INC. 2014 ORIGINAL SHEET SIZE: 30"x42"

MECHANICAL EQUIPMENT PLATFORM PLAN - ZONE A - PLUMBING

P-401A


3/10/2015 3:52:27 PM C:\Users\Local\Public\3-108-MEP\4-CENTRAL_Lam\mop1.dwg

NOTES:
1. FLOOR SINK FOR AHU CONDENSATE DRAINAGE.




ROBERTSON/SHERWOOD/ARCHITECTS PC
132 EAST BROADWAY, SUITE 540
EUGENE, OREGON 97401
541-342-8077
www.robertsonsherwood.com


MAHLUM ARCHITECTS INC
1231 NW HOYT, SUITE 102
PORTLAND, OREGON 97209
503-224-4032
71 COLUMBIA, FLOOR 4
SEATTLE, WASHINGTON 98104
206-441-4151
www.mahlum.com

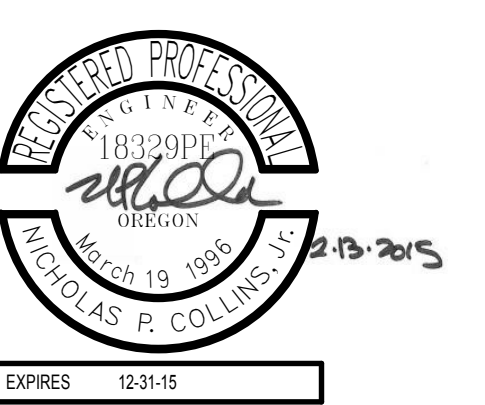

EUGENE SCHOOL DISTRICT 4J

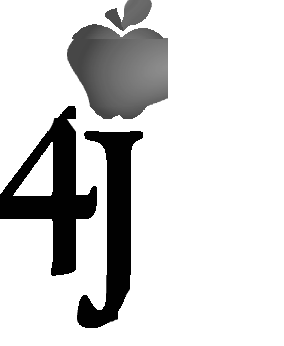

REPLACEMENT ROOSEVELT MIDDLE SCHOOL
CIP NUMBER 410.566.001
680 EAST 24TH AVENUE
EUGENE, OREGON 97405
CIP NO. 410.566.001

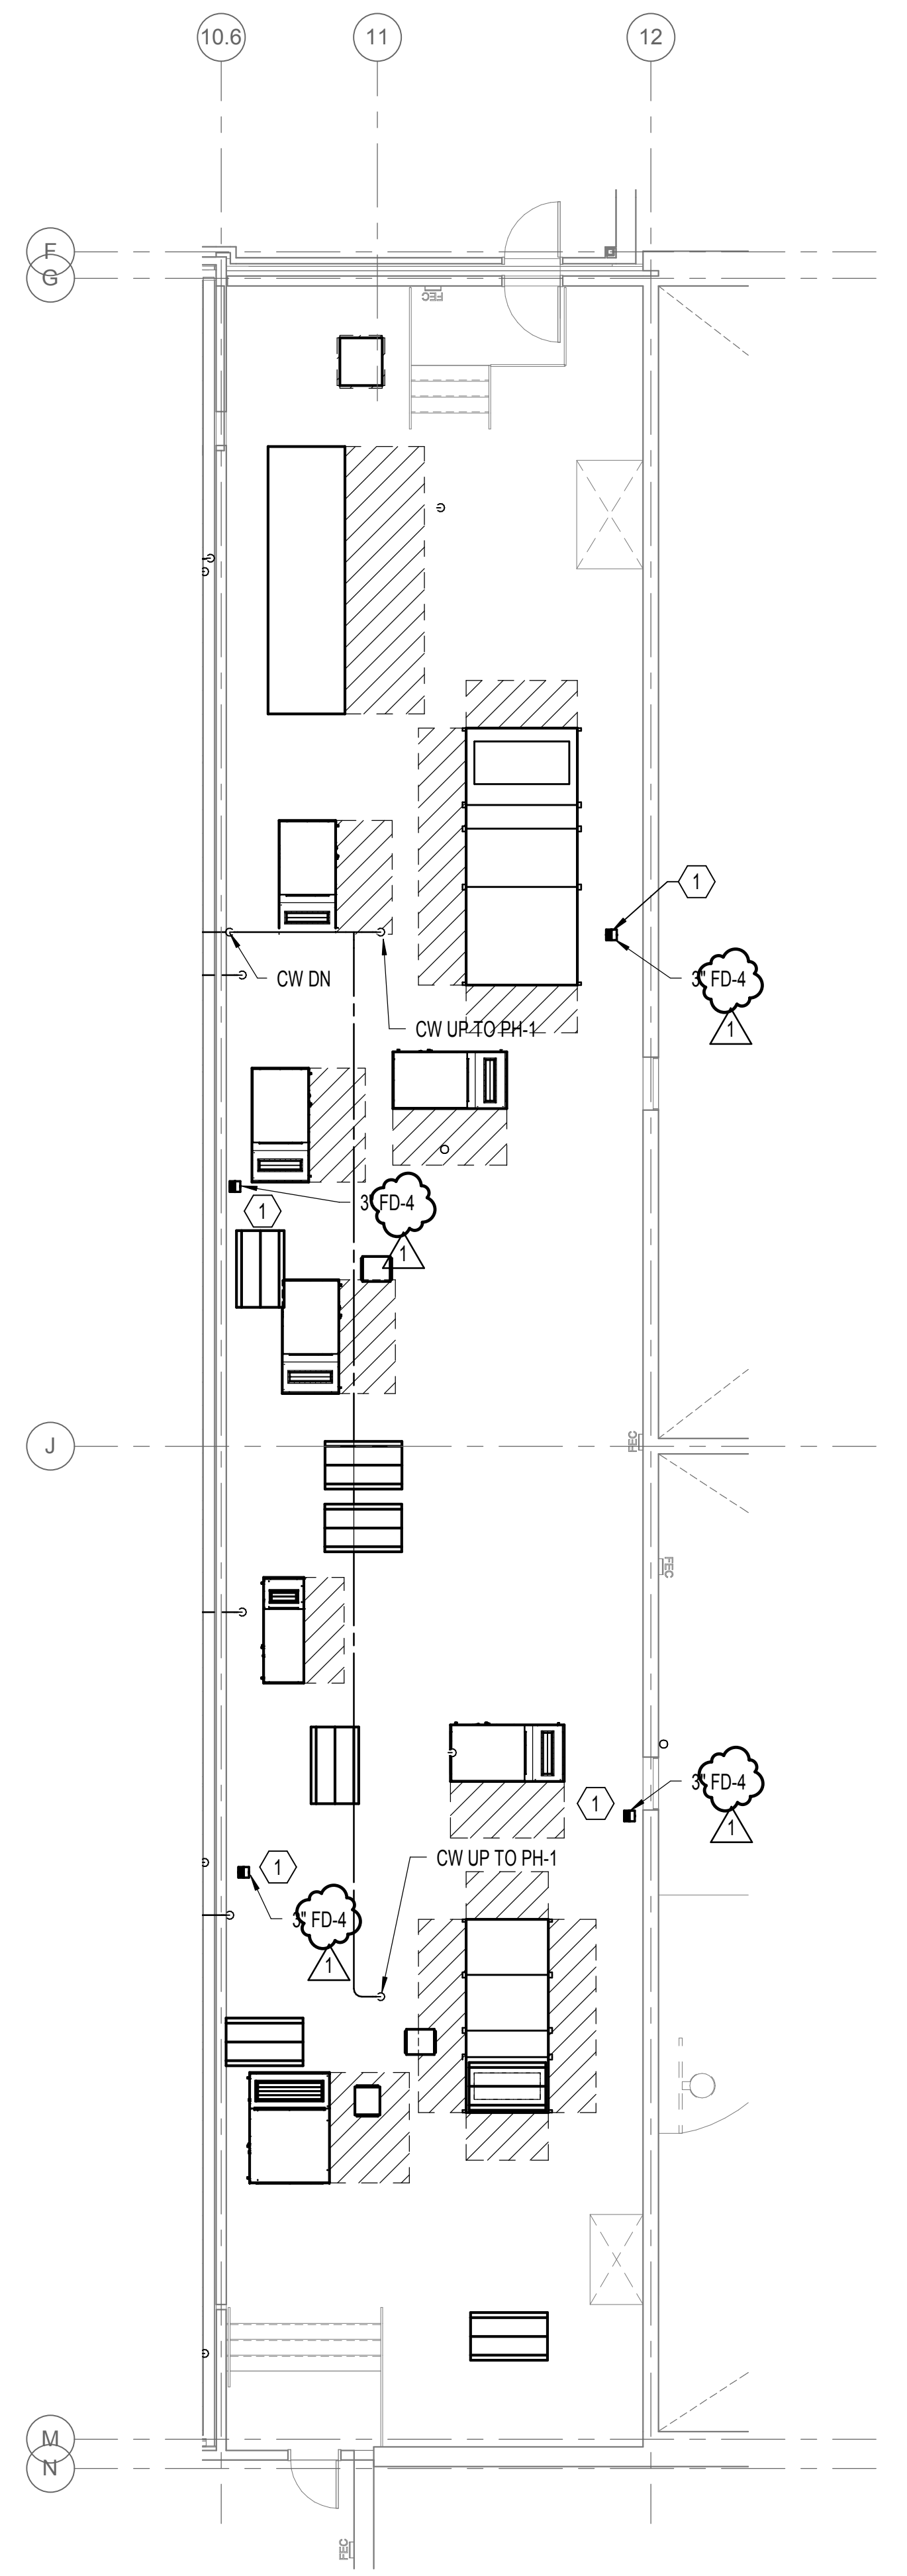

A1 MECHANICAL EQUIPMENT PLATFORM PLAN - ZONE C - PLUMBING
1/8" = 1'-0"

MARK	DATE	DESCRIPTION
1	03-13-2015	ADDENDUM 6

ISSUE DATE: FEBRUARY 18, 2015
ISSUE: CONSTRUCTION DOCUMENTS
VOLUME: PACKAGE 2 VOLUME 2
PROJECT NO: 2013912.00
DRAWN BY: SG
CHECKED BY: JCY
COPYRIGHT MAHLUM ARCHITECTS, INC. 2014 ORIGINAL SHEET SIZE: 30"x42"

MECHANICAL EQUIPMENT PLATFORM PLAN - ZONE C - PLUMBING

P-401C

3/10/2015 3:53:04 PM C:\Users\Local\Public\3-108-MPH-CENTRAL_Lam\20150111

MARK	DATE	DESCRIPTION
2	03-13-2015	ADDENDUM 6
1	03-06-2015	ADDENDUM 4

ISSUE DATE: FEBRUARY 18, 2015

ISSUE: CONSTRUCTION DOCUMENTS

VOLUME: PACKAGE 2 VOLUME 2

PROJECT NO.: 2013912.00

DRAWN BY: SG

CHECKED BY: JCY

COPYRIGHT MAHLUM ARCHITECTS, INC. 2014 ORIGINAL SHEET SIZE: 30"x42"

PARTIAL PLANS - ZONE D - PLUMBING

GENERAL NOTES:

A. IT SHALL BE THE RESPONSIBILITY OF THE CONTRACTOR TO COORDINATE THE WORK WITH THAT OF ALL OTHER TRADES, INCLUDING BUT NOT LIMITED TO: ELECTRICAL, HVAC, FIRE SPRINKLER, PLUMBING, STRUCTURAL, AND GENERAL ARCHITECTURE.

B. ALL PLUMBING EQUIPMENT, PIPING, INSULATION, ETC. INSTALLED IN HVAC PLENUM AND ATTIC SPACES SHALL MEET CODE REQUIREMENTS FOR SMOKE AND COMBUSTIBILITY.

C. VERIFY EXACT SIZES, LOCATIONS, INVERTS, AND ELEVATIONS PRIOR TO RUNNING ANY PIPING. REFER TO ARCHITECTURAL DRAWINGS FOR EXACT LOCATIONS OF ALL FIXTURES AND EQUIPMENT. REFER TO KITCHEN LAYOUT DRAWING FOR EXACT LOCATION AND ROUGH-IN REQUIREMENTS OF ALL KITCHEN FIXTURES AND EQUIPMENT.

D. PLUMBING CONTRACTOR IS RESPONSIBLE FOR EXTENDING ALL REGULATOR VENTS TO ATMOSPHERE. REGULATORS ARE PART OF EQUIPMENT GAS TRAIN.

E. WATER HEATERS SHALL BE INSTALLED WITH DRAIN PANS UNDER HEATERS. ROUTE PAN DRAINS TO NEAREST FLOOR DRAIN OR SAFE DRAIN.



F. PIPING SHALL NOT RUN OVER ELECTRICAL PANELS AND SHALL BE COORDINATED WITH WORK OF OTHER TRADES.

G. NPW PIPING FROM RAINWATER SYSTEM SHALL BE ROUTED FROM BOILER ROOM 174 PARALLEL TO CW PIPING AND SHALL SERVE ALL FLUSH FIXTURES.

H. PROVIDE GAS REGULATORS (2 PSI TO EACH REGULATOR) TO BOILERS AND DOMESTIC WATER HEATERS. REGULATORS ON BOILERS SHALL BE NO CLOSER THAN 10 FEET OF PIPE LENGTH FROM BOILER.

NOTES:

1. FLOOR SINK FOR AHU CONDENSATE DRAINAGE.

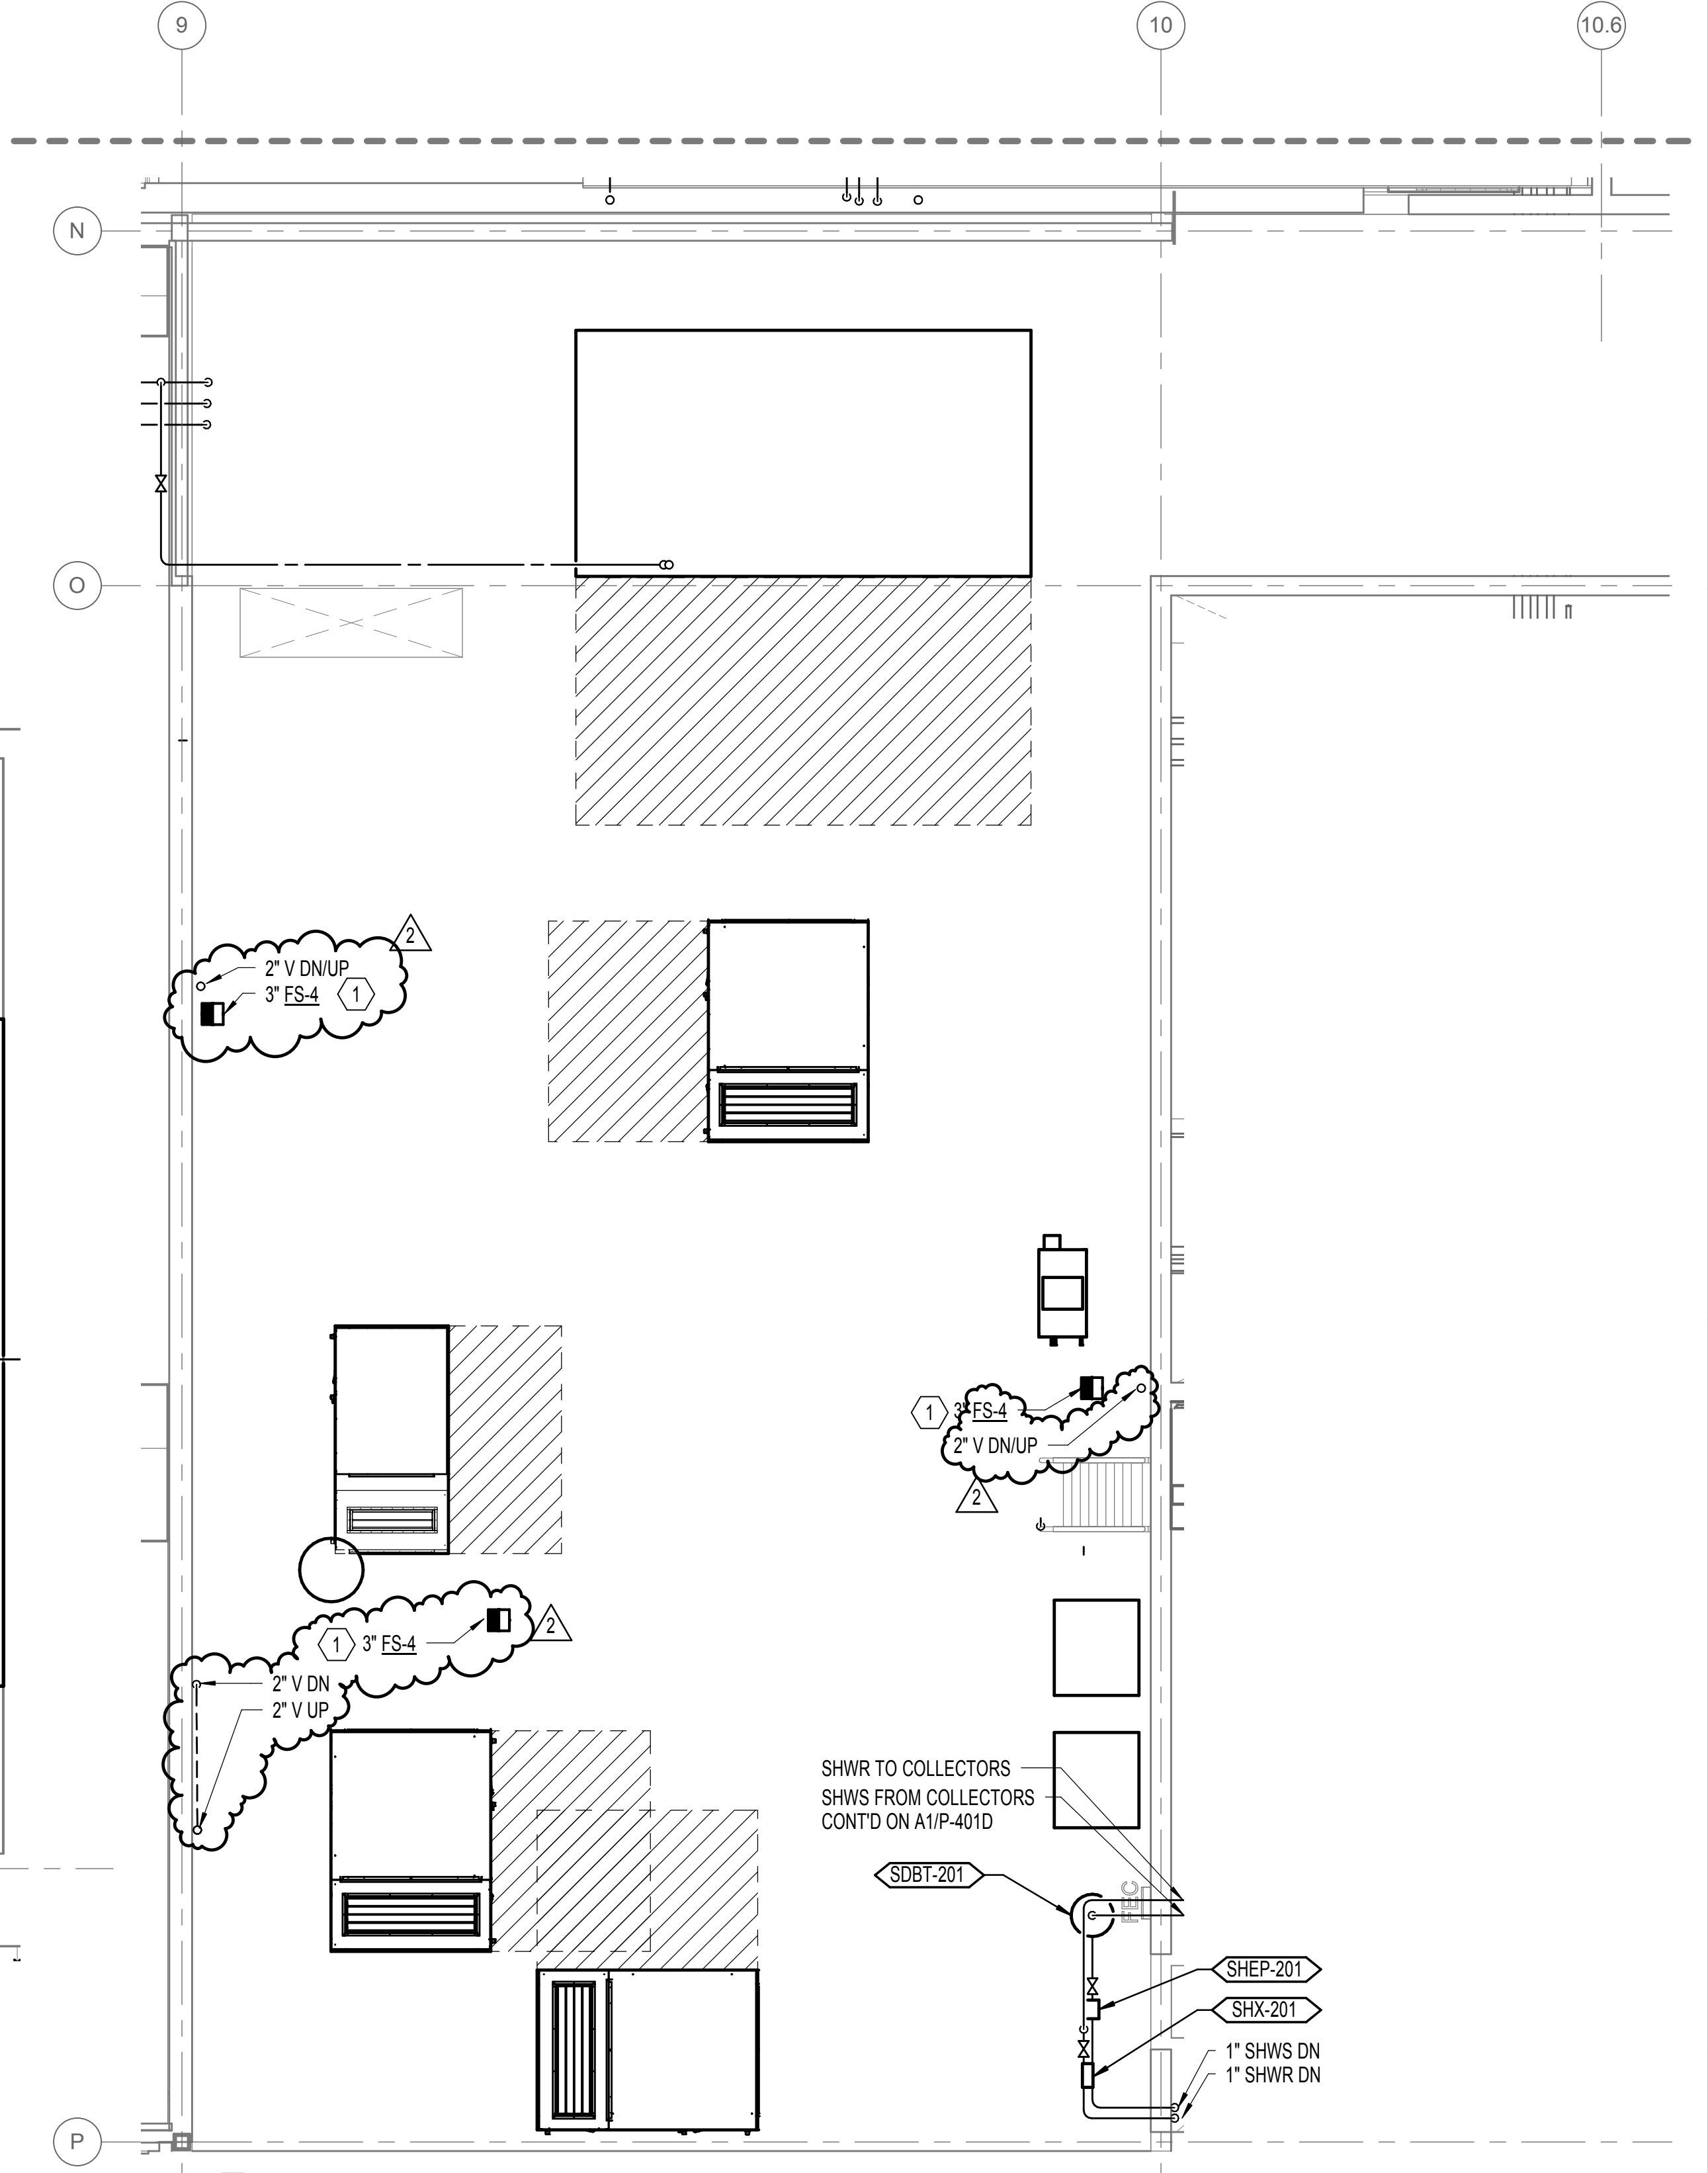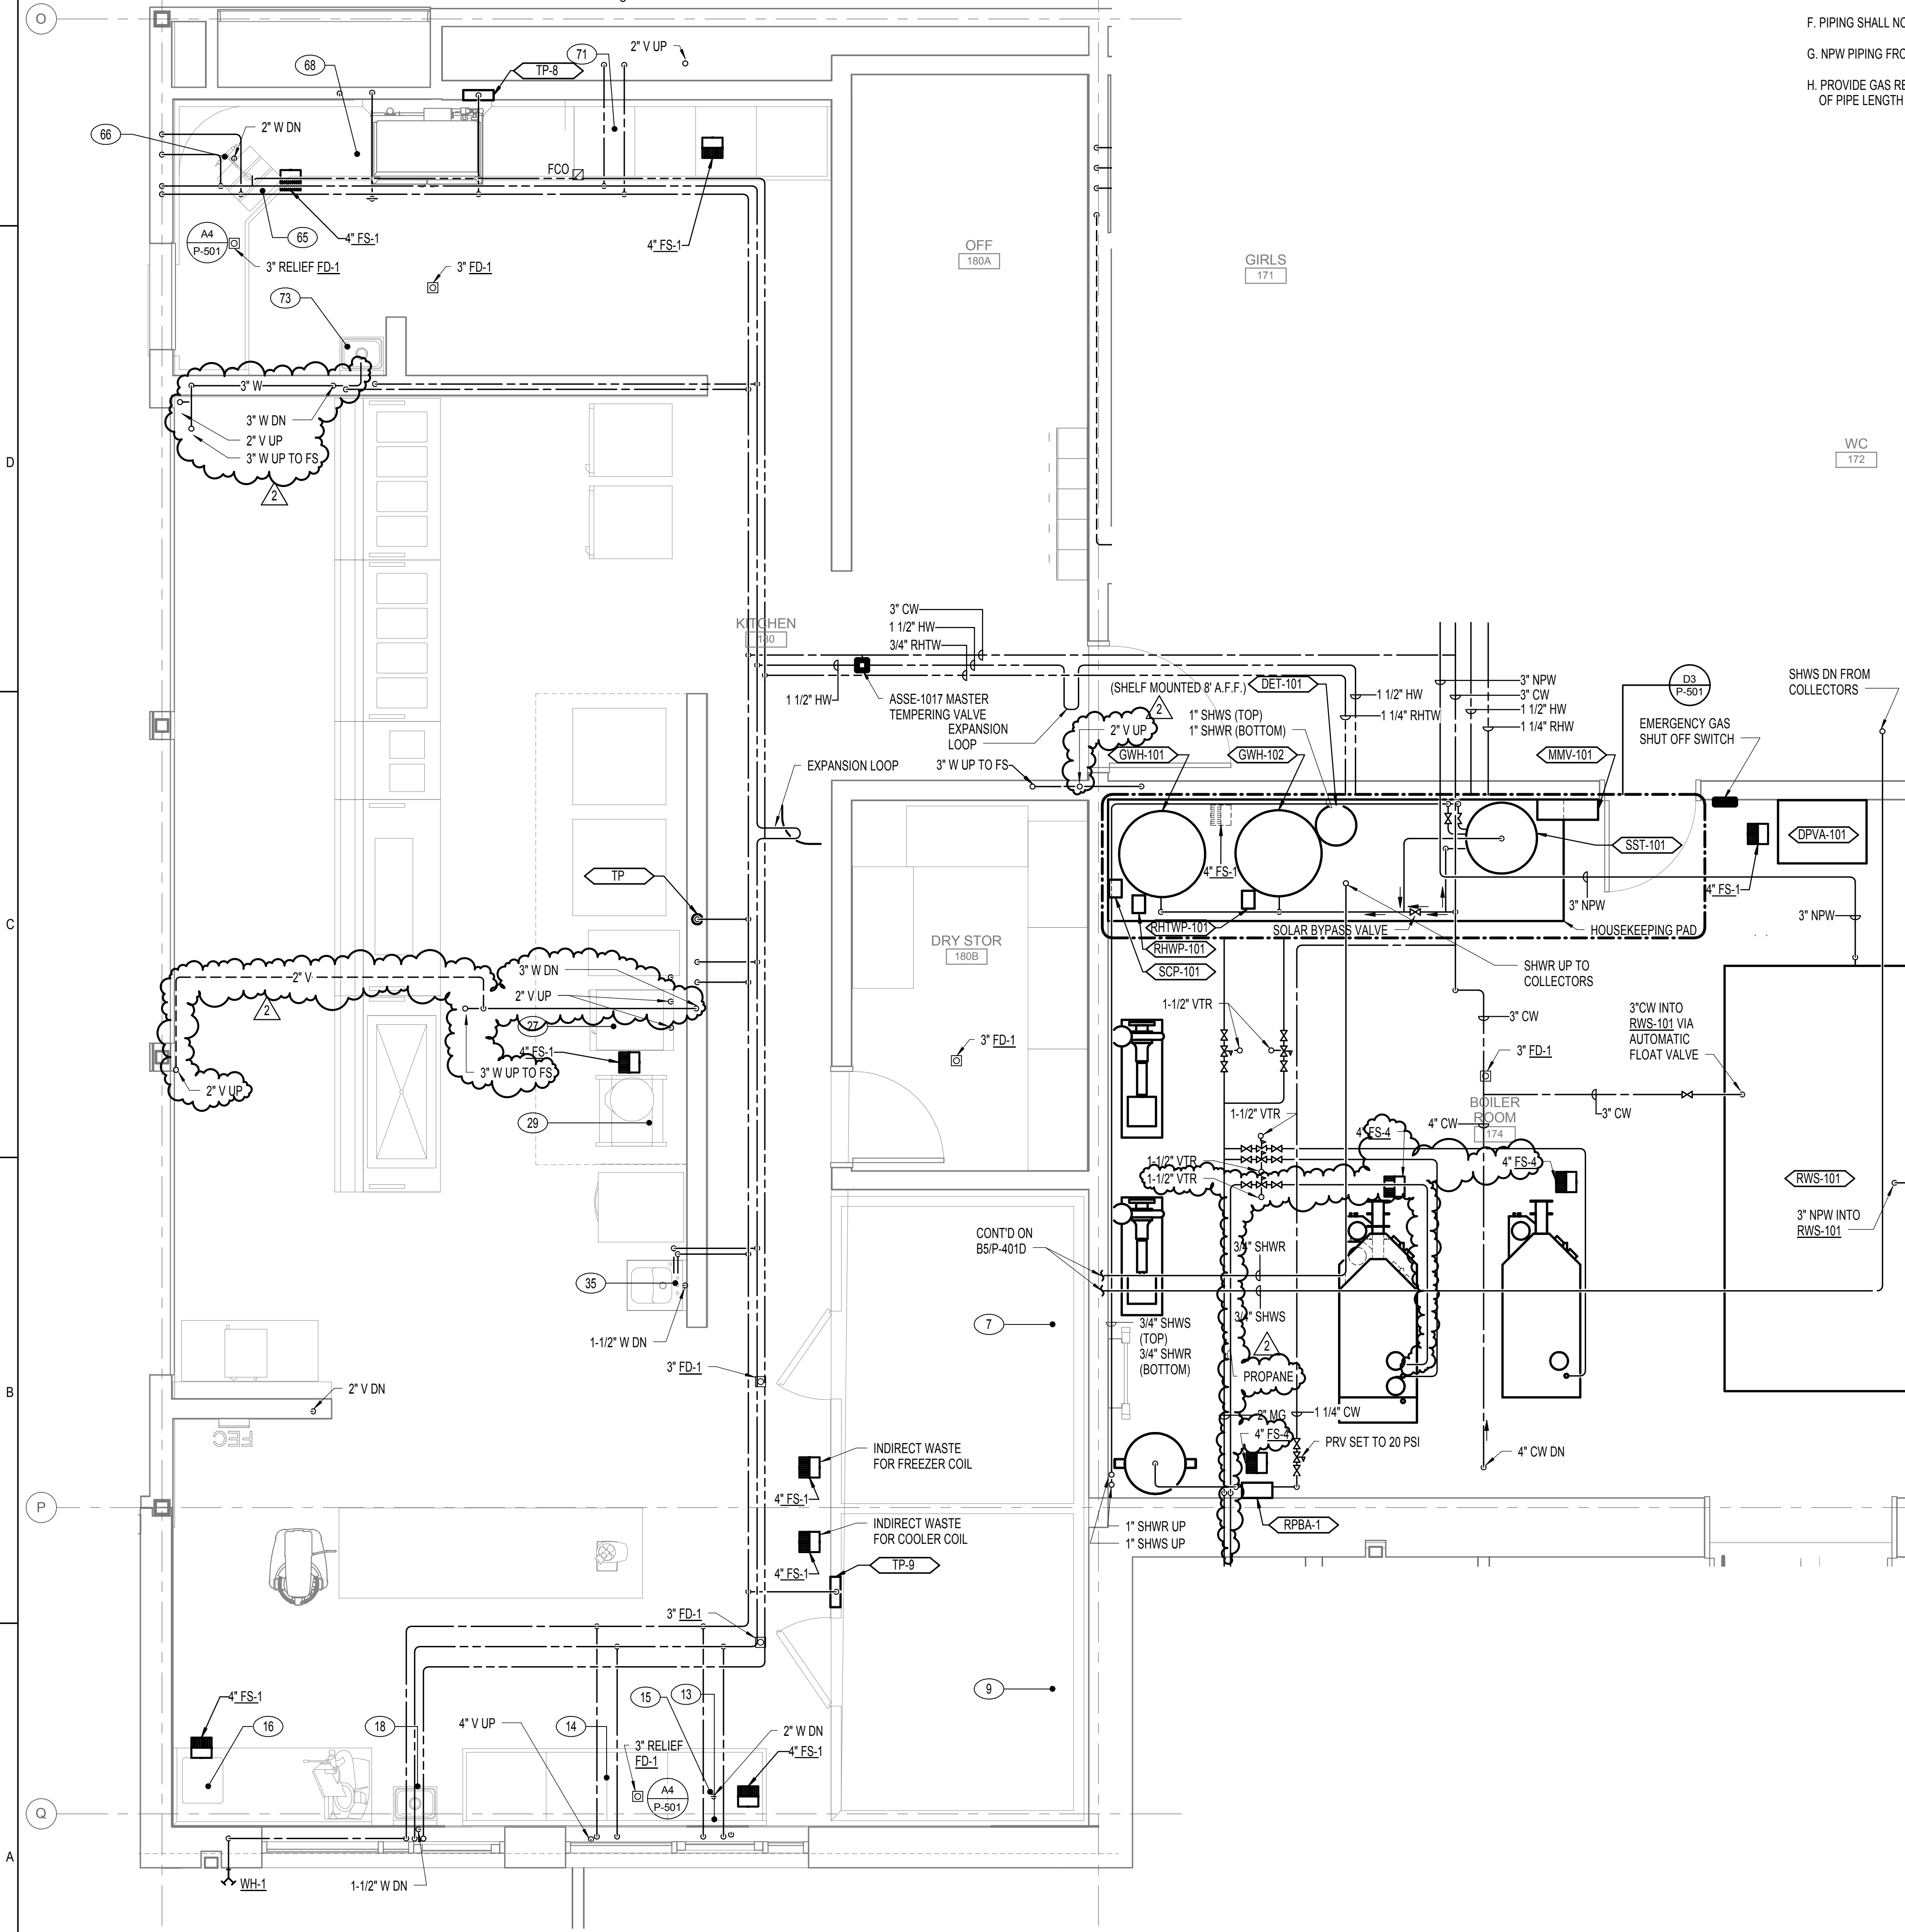

A1 PARTIAL PLAN - KITCHEN AND BOILER ROOM - PLUMBING
3/8" = 1'-0"

B5 MECHANICAL EQUIPMENT PLATFORM PLAN- ZONE D - PLUMBING
1/4" = 1'-0"




3/10/2015 3:50:11 PM C:\p\local\p\4013-108\B5\A1-CENTRAL.plm




GENERAL NOTES:


- A. IT SHALL BE THE RESPONSIBILITY OF THE CONTRACTOR TO COORDINATE THE WORK WITH THAT OF ALL OTHER TRADES, INCLUDING BUT NOT LIMITED TO, ELECTRICAL, HVAC, FIRE SPRINKLER, PLUMBING, STRUCTURAL, AND GENERAL ARCHITECTURE.
- B. ALL PLUMBING EQUIPMENT, PIPING, INSULATION, ETC. INSTALLED IN HVAC PLENUM AND ATTIC SPACES SHALL MEET CODE REQUIREMENTS FOR SMOKE AND COMBUSTIBILITY.
- C. VERIFY EXACT SIZES, LOCATIONS, INVERTS, AND ELEVATIONS PRIOR TO RUNNING ANY PIPING. REFER TO ARCHITECTURAL DRAWINGS FOR EXACT LOCATIONS OF ALL FIXTURES AND EQUIPMENT. REFER TO KITCHEN LAYOUT DRAWING FOR EXACT LOCATION AND ROUGH-IN REQUIREMENTS OF ALL KITCHEN FIXTURES AND EQUIPMENT.
- D. PLUMBING CONTRACTOR IS RESPONSIBLE FOR EXTENDING ALL REGULATOR VENTS TO ATMOSPHERE. REGULATORS ARE PART OF EQUIPMENT GAS TRAIN.
- E. WATER HEATERS SHALL BE INSTALLED WITH DRAIN PANS UNDER HEATERS. ROUTE PAN DRAINS TO NEAREST FLOOR DRAIN OR SAFE DRAIN.
- F. PIPING SHALL NOT RUN OVER ELECTRICAL PANELS AND SHALL BE COORDINATED WITH WORK OF OTHER TRADES.
- G. NPW PIPING FROM RAINWATER SYSTEM SHALL BE ROUTED FROM BOILER ROOM 174 PARALLEL TO CW PIPING AND SHALL SERVE ALL FLUSH FIXTURES.

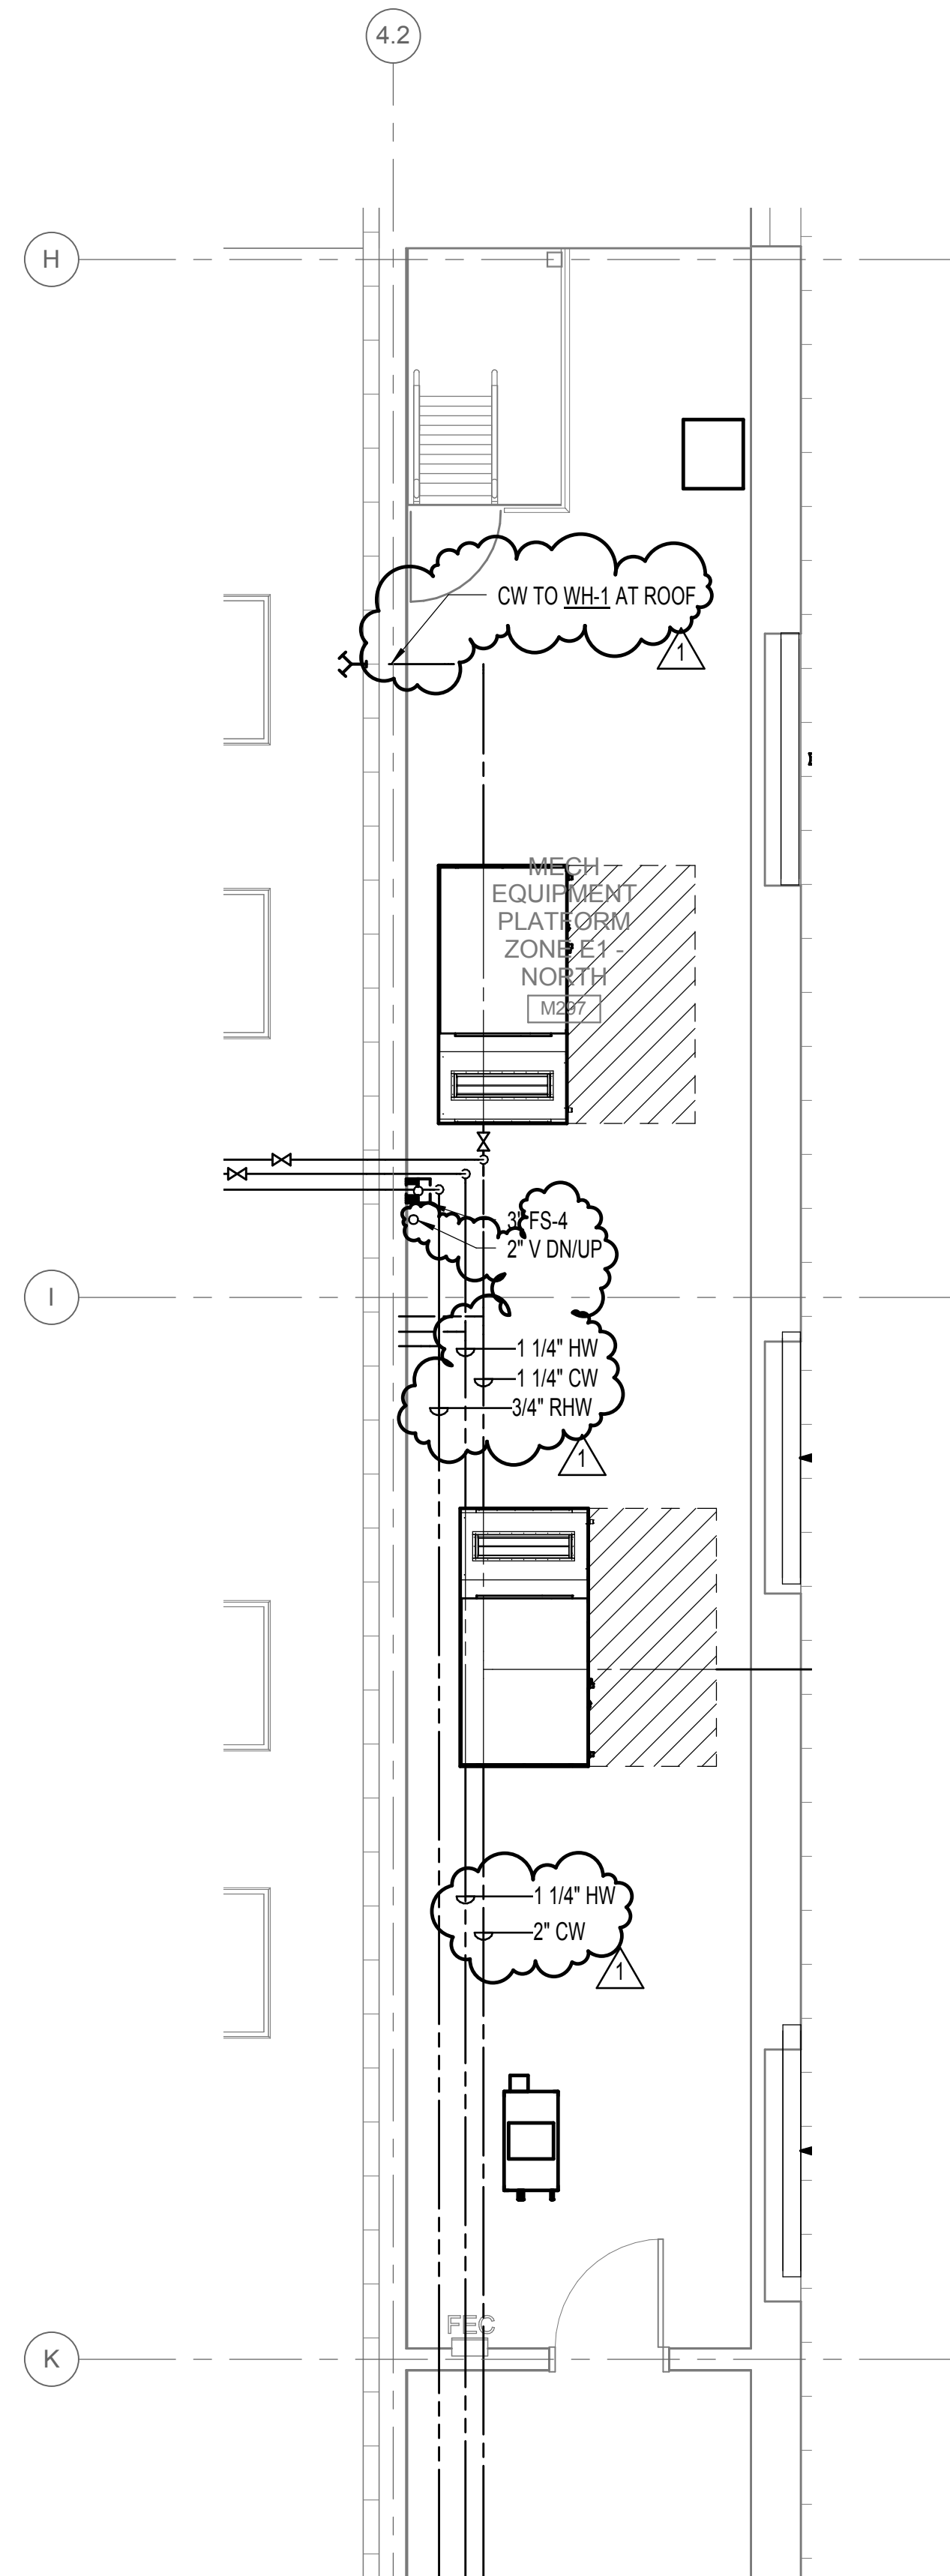

1 MECHANICAL EQUIPMENT PLATFORM PLAN - ZONE E NORTH - MECHANICAL
 1/4" = 1'-0"

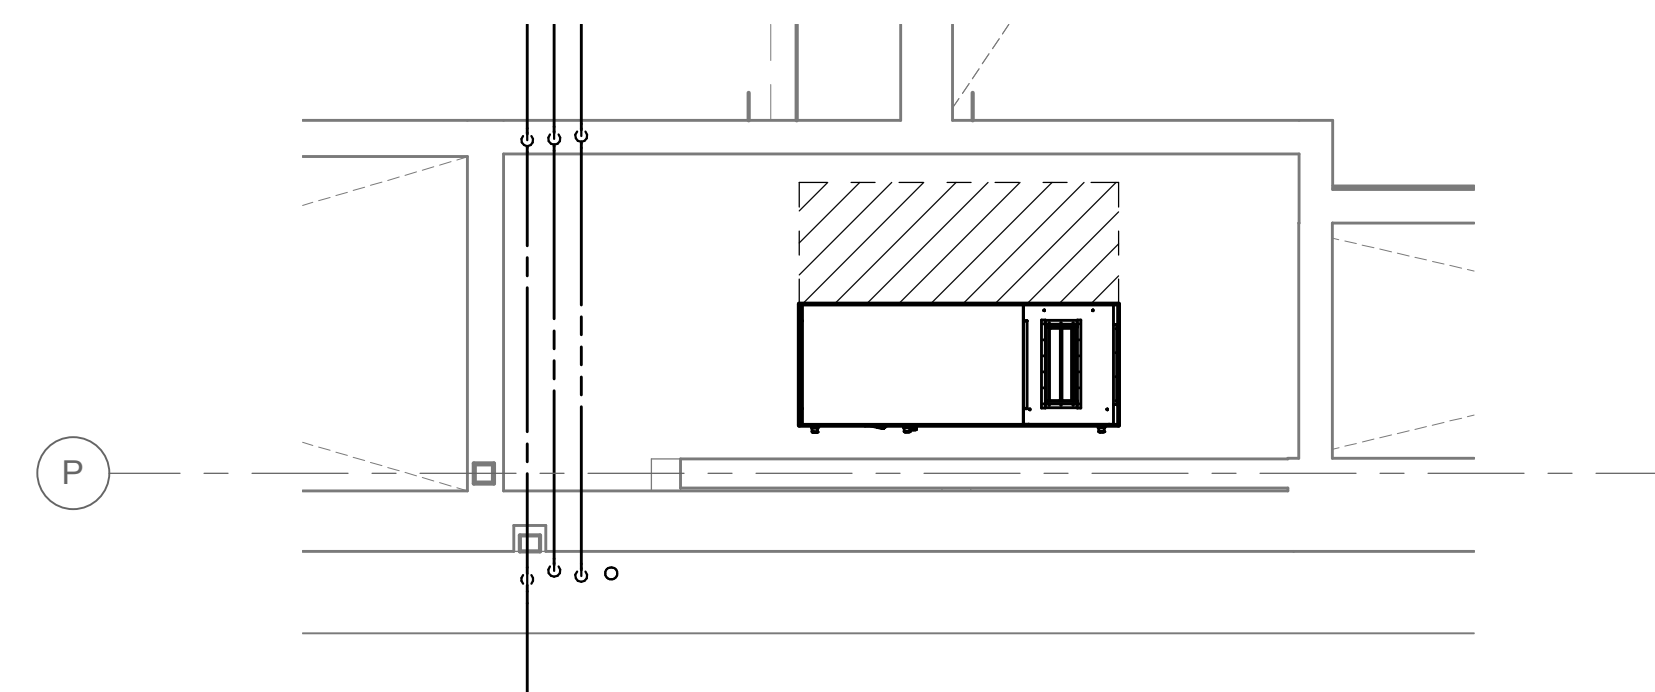

3 MECHANICAL EQUIPMENT PLATFORM PLAN - ZONE E EAST - MECHANICAL
 1/4" = 1'-0"

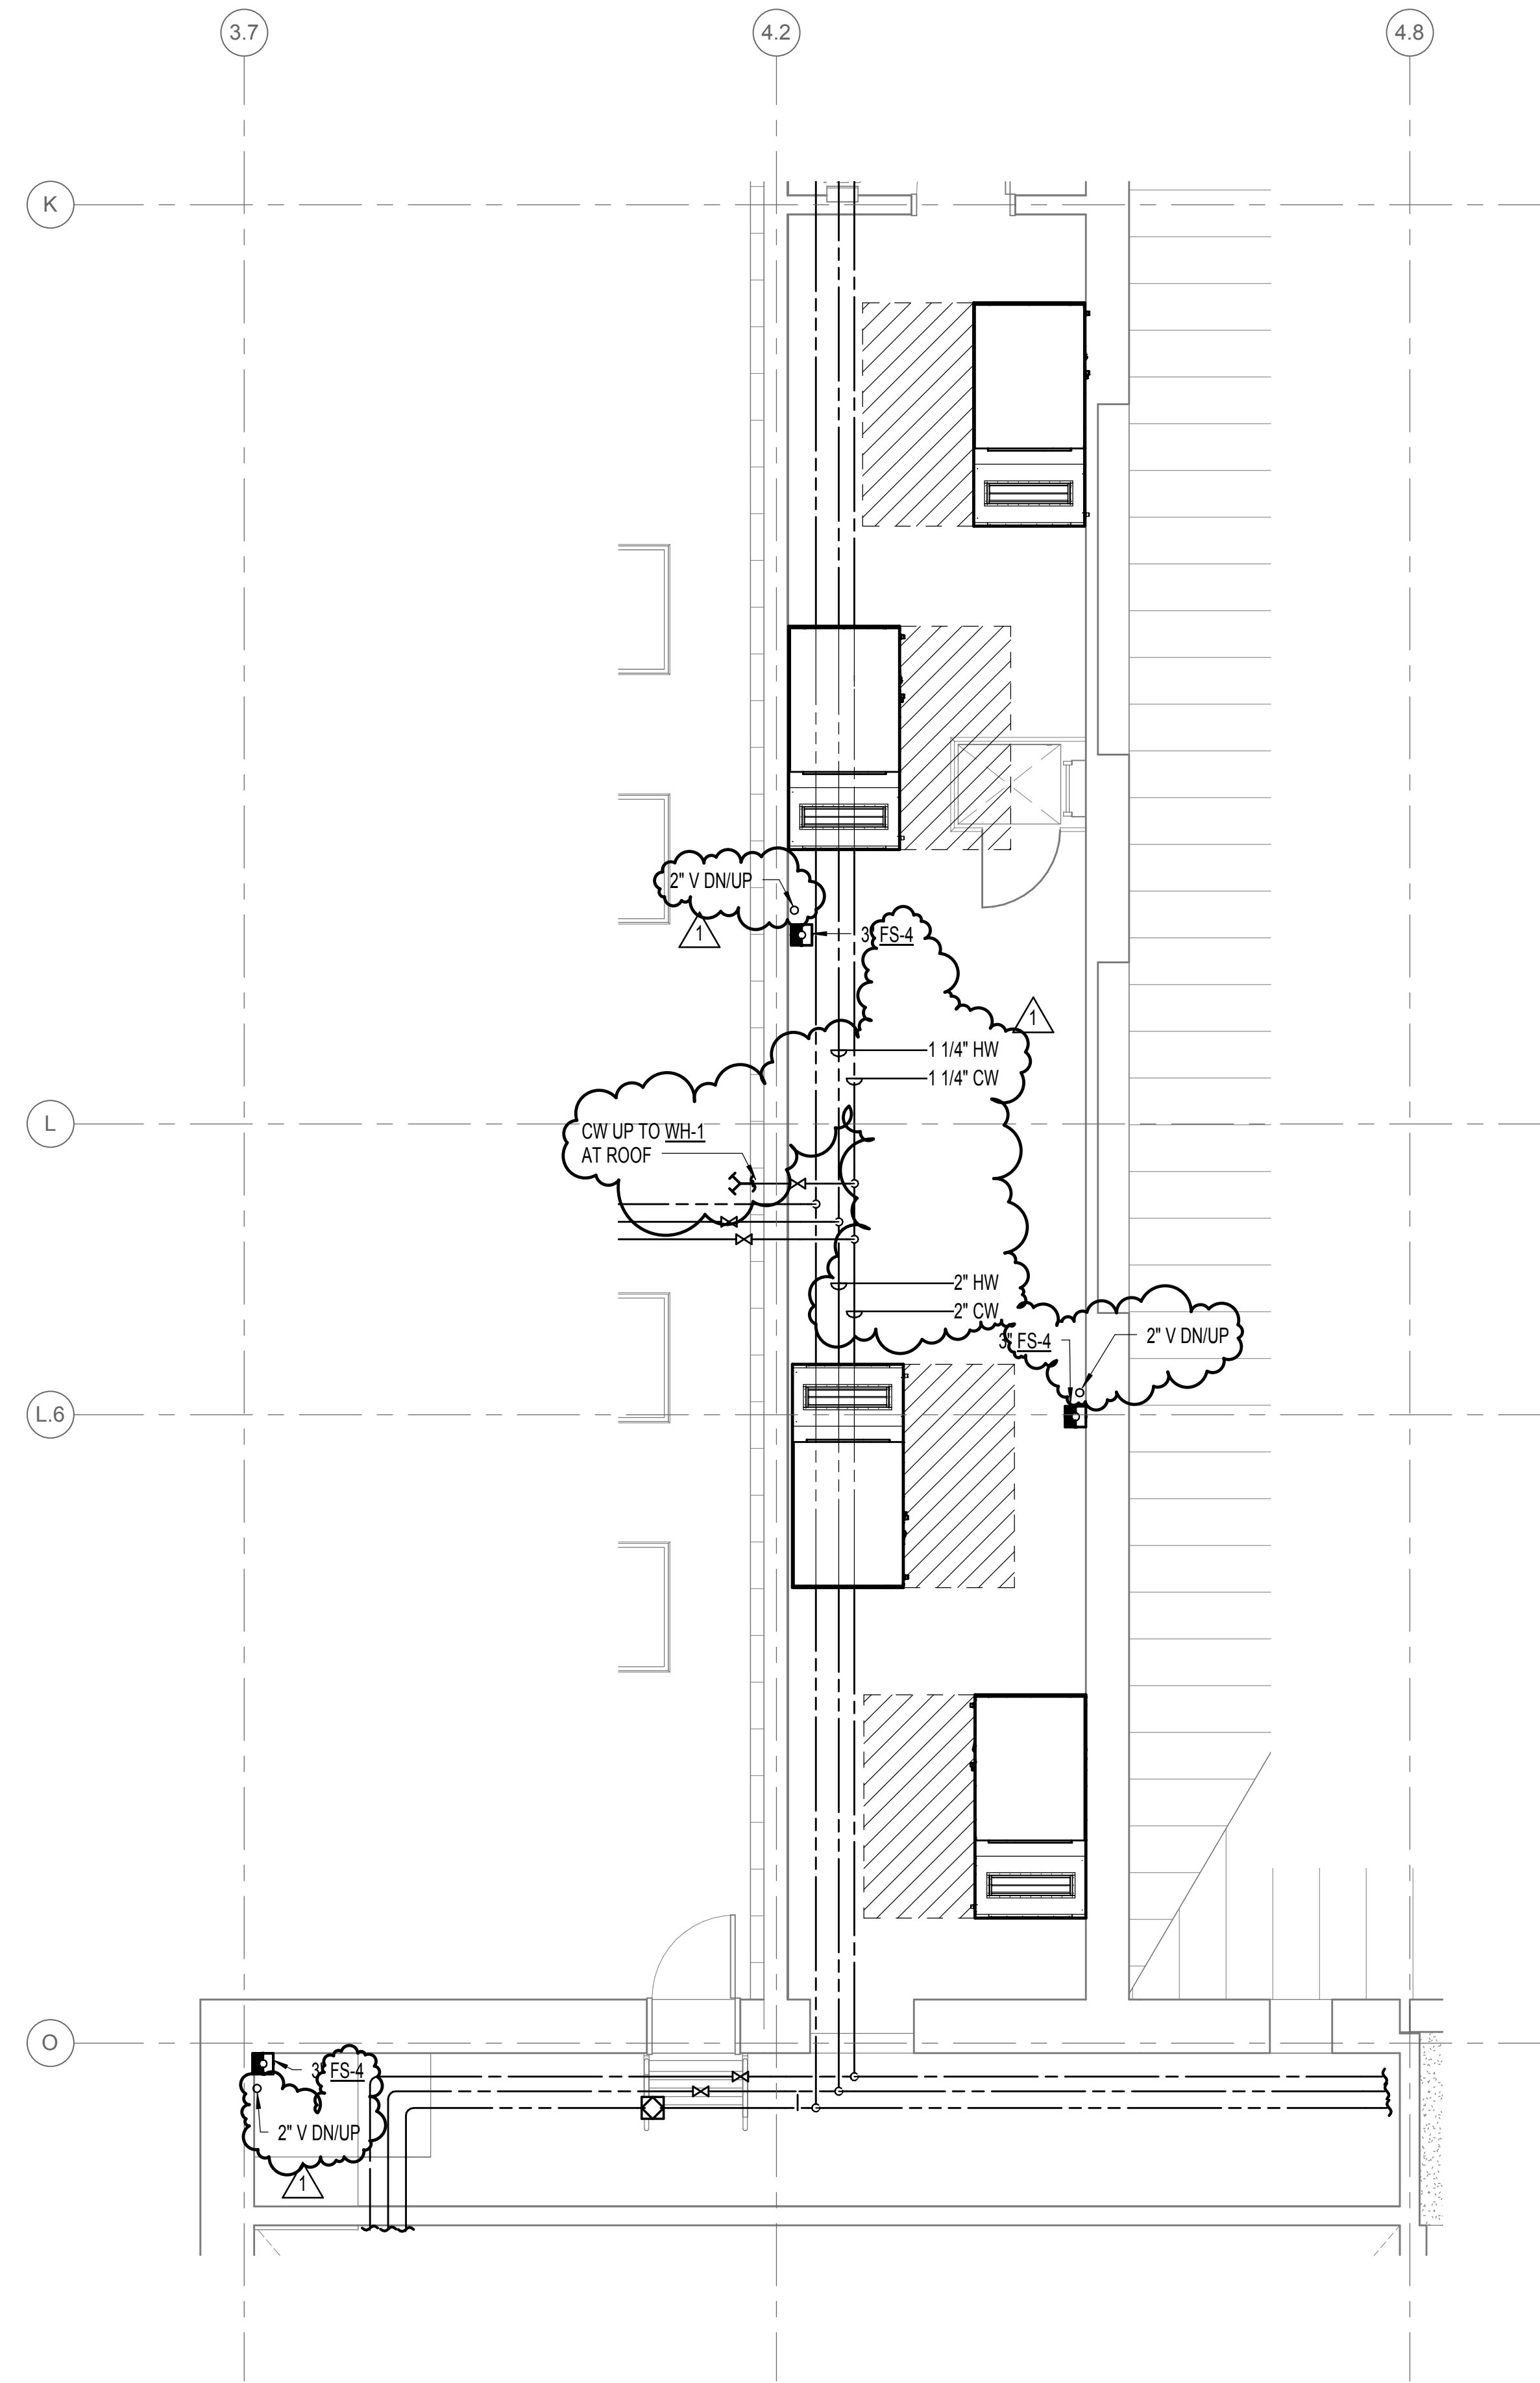


2 MECHANICAL EQUIPMENT PLATFORM PLAN - ZONE E SOUTH - MECHANICAL
 1/4" = 1'-0"



MARK	DATE	DESCRIPTION
1	03-13-2015	ADDENDUM 6

ISSUE DATE: FEBRUARY 18, 2015
 ISSUE: CONSTRUCTION DOCUMENTS
 VOLUME: PACKAGE 2 VOLUME 2
 PROJECT NO: 2013912.00
 DRAWN BY: SG
 CHECKED BY: JCY
COPYRIGHT MAHLUM ARCHITECTS, INC. 2014 ORIGINAL SHEET SIZE: 30"x42"

MECHANICAL EQUIPMENT PLATFORM PLAN - ZONE E - PLUMBING

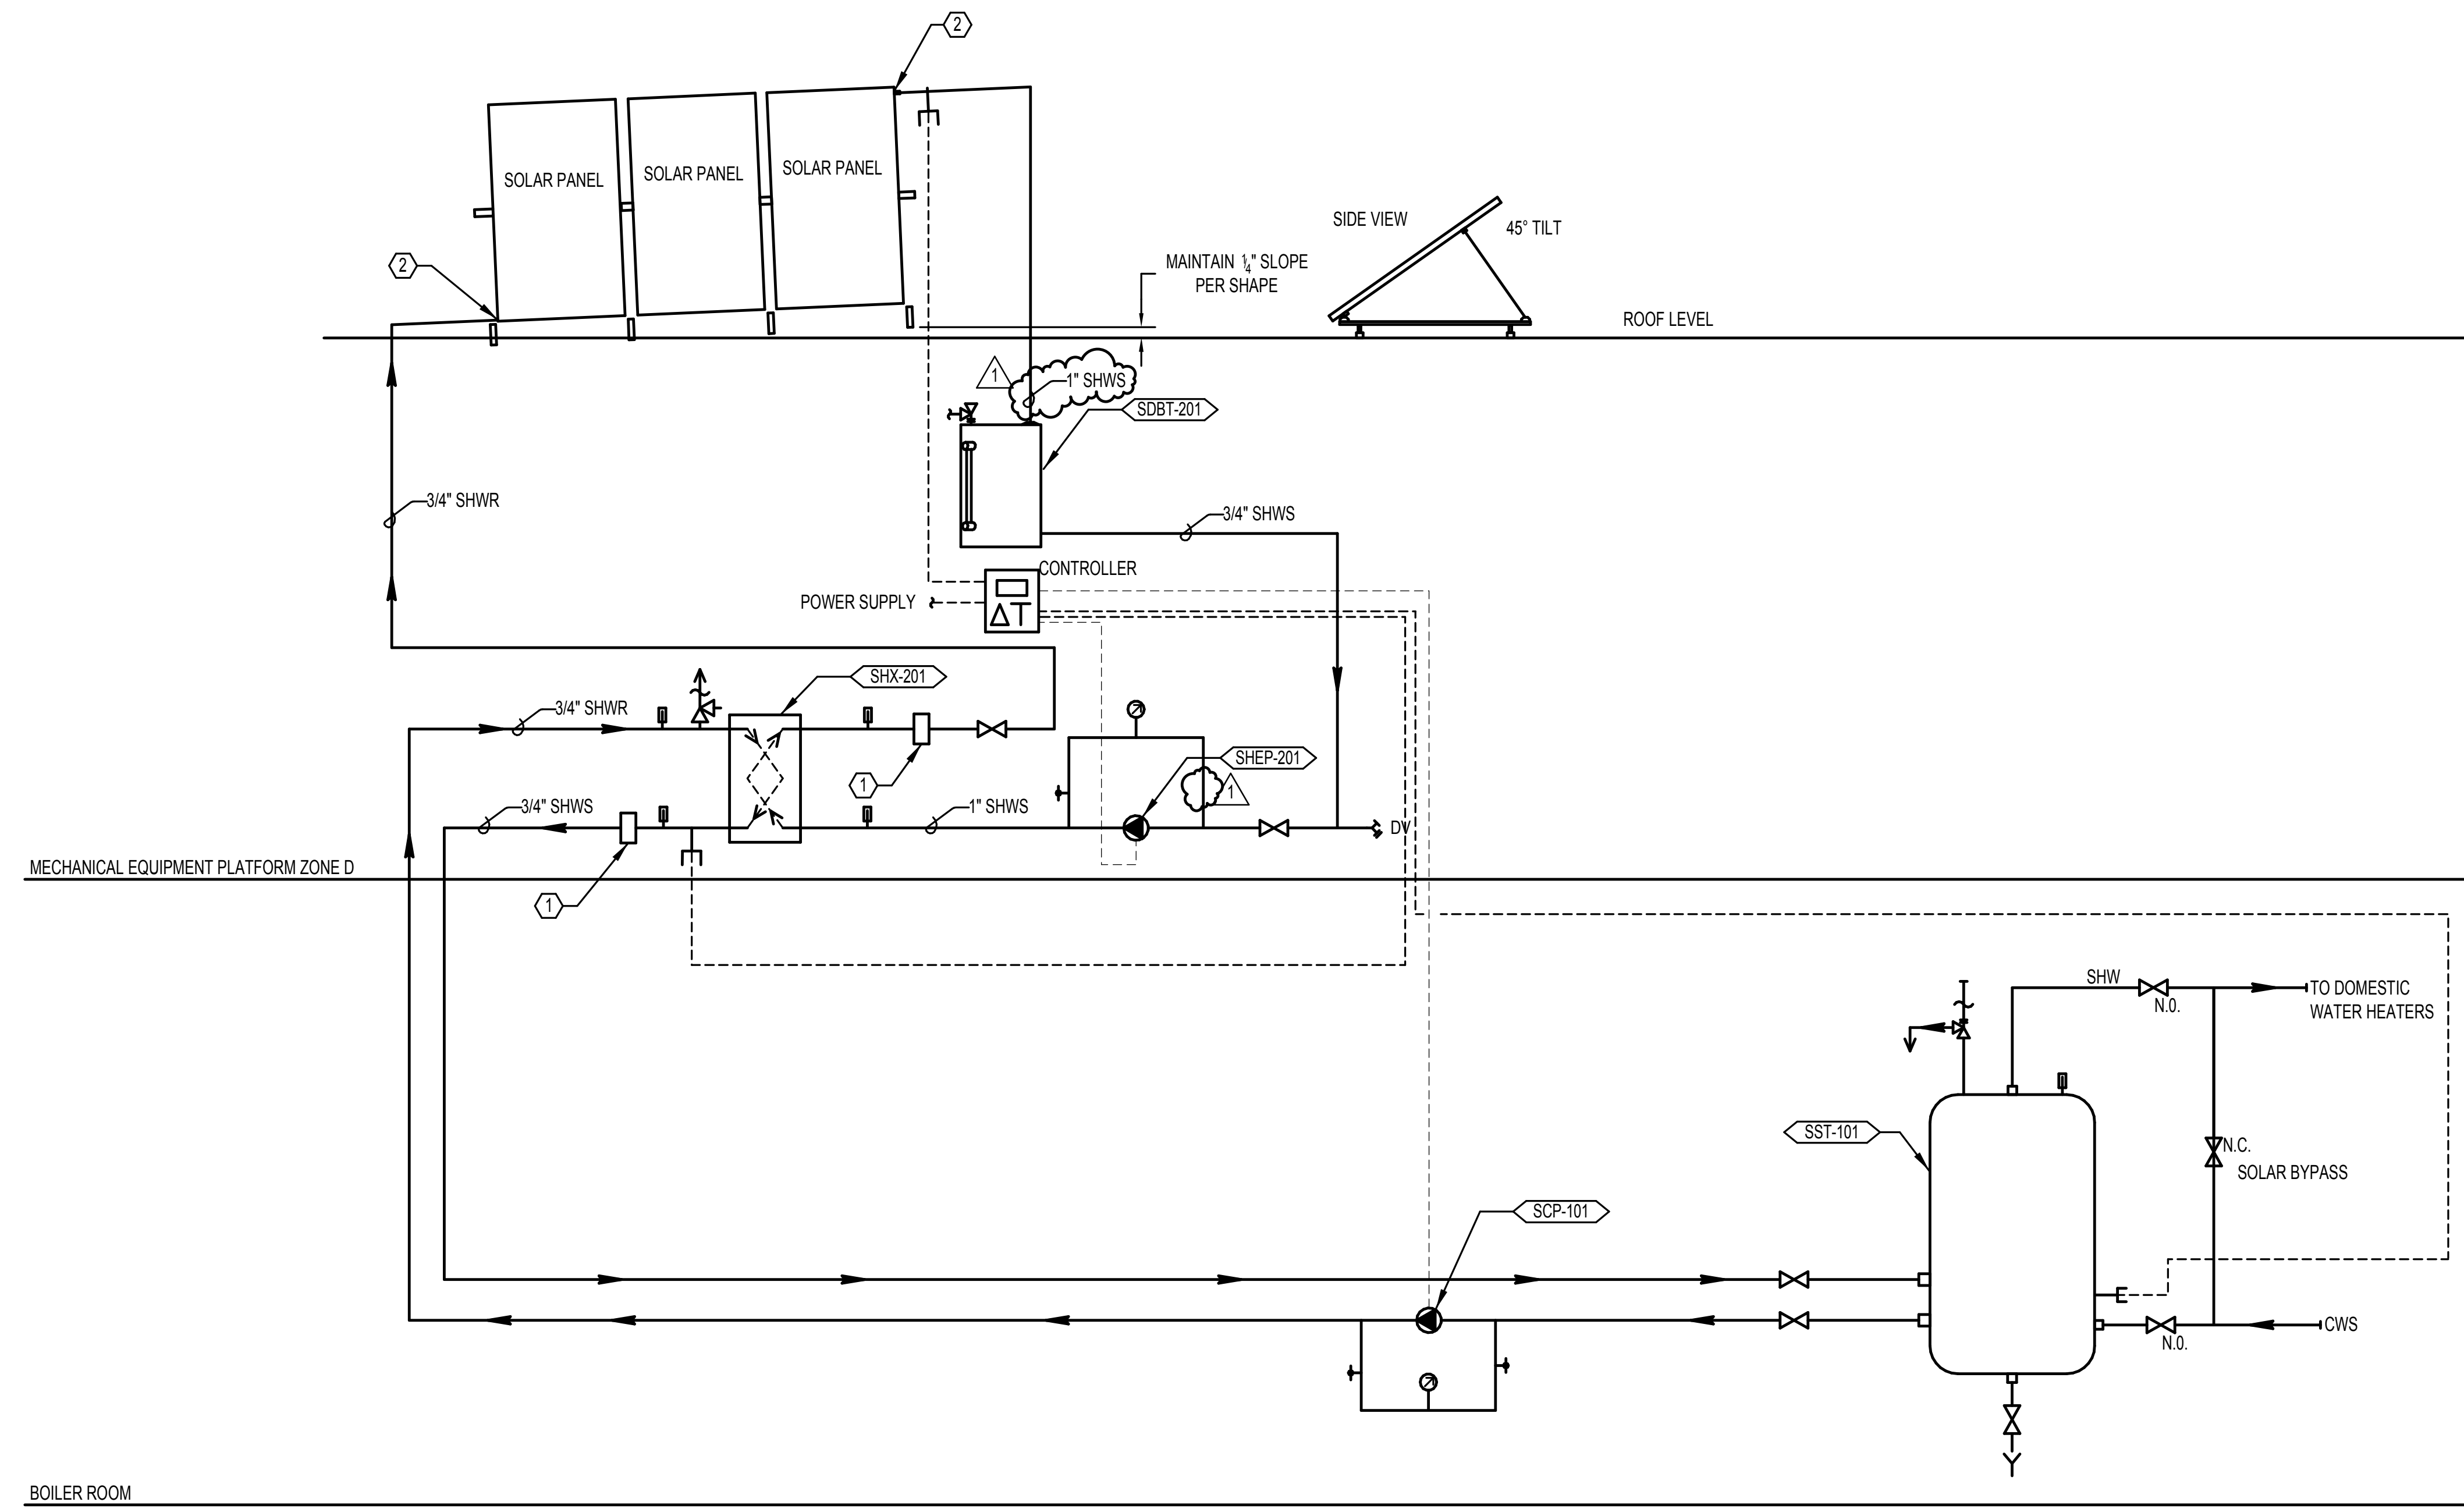

C2 SOLAR THERMAL DRAINBACK DIAGRAM


SCALE: NONE

GENERAL NOTES:

- A. ALL EXPOSED PIPING AND COLLECTORS MUST SLOPE 1/4" PER FOOT BACK TO DRAIN BACK TANK.
- B. REFER TO PLANS FOR SPECIFIC EQUIPMENT LOCATIONS.
- C. DRAINBACK TANK MUST DOUBLE VOLUME OF PIPE AND COLLECTORS ABOVE PLANNED TANK LEVEL.

NOTES:

- 1. PROVIDE INLINE VISUAL FLOW INDICATOR/BALANCING VALVE. REFER TO SPECIFICATIONS.
- 2. PROVIDE SWING JOINT AT INLET AND OUTLET OF COLLECTOR ARRAY.

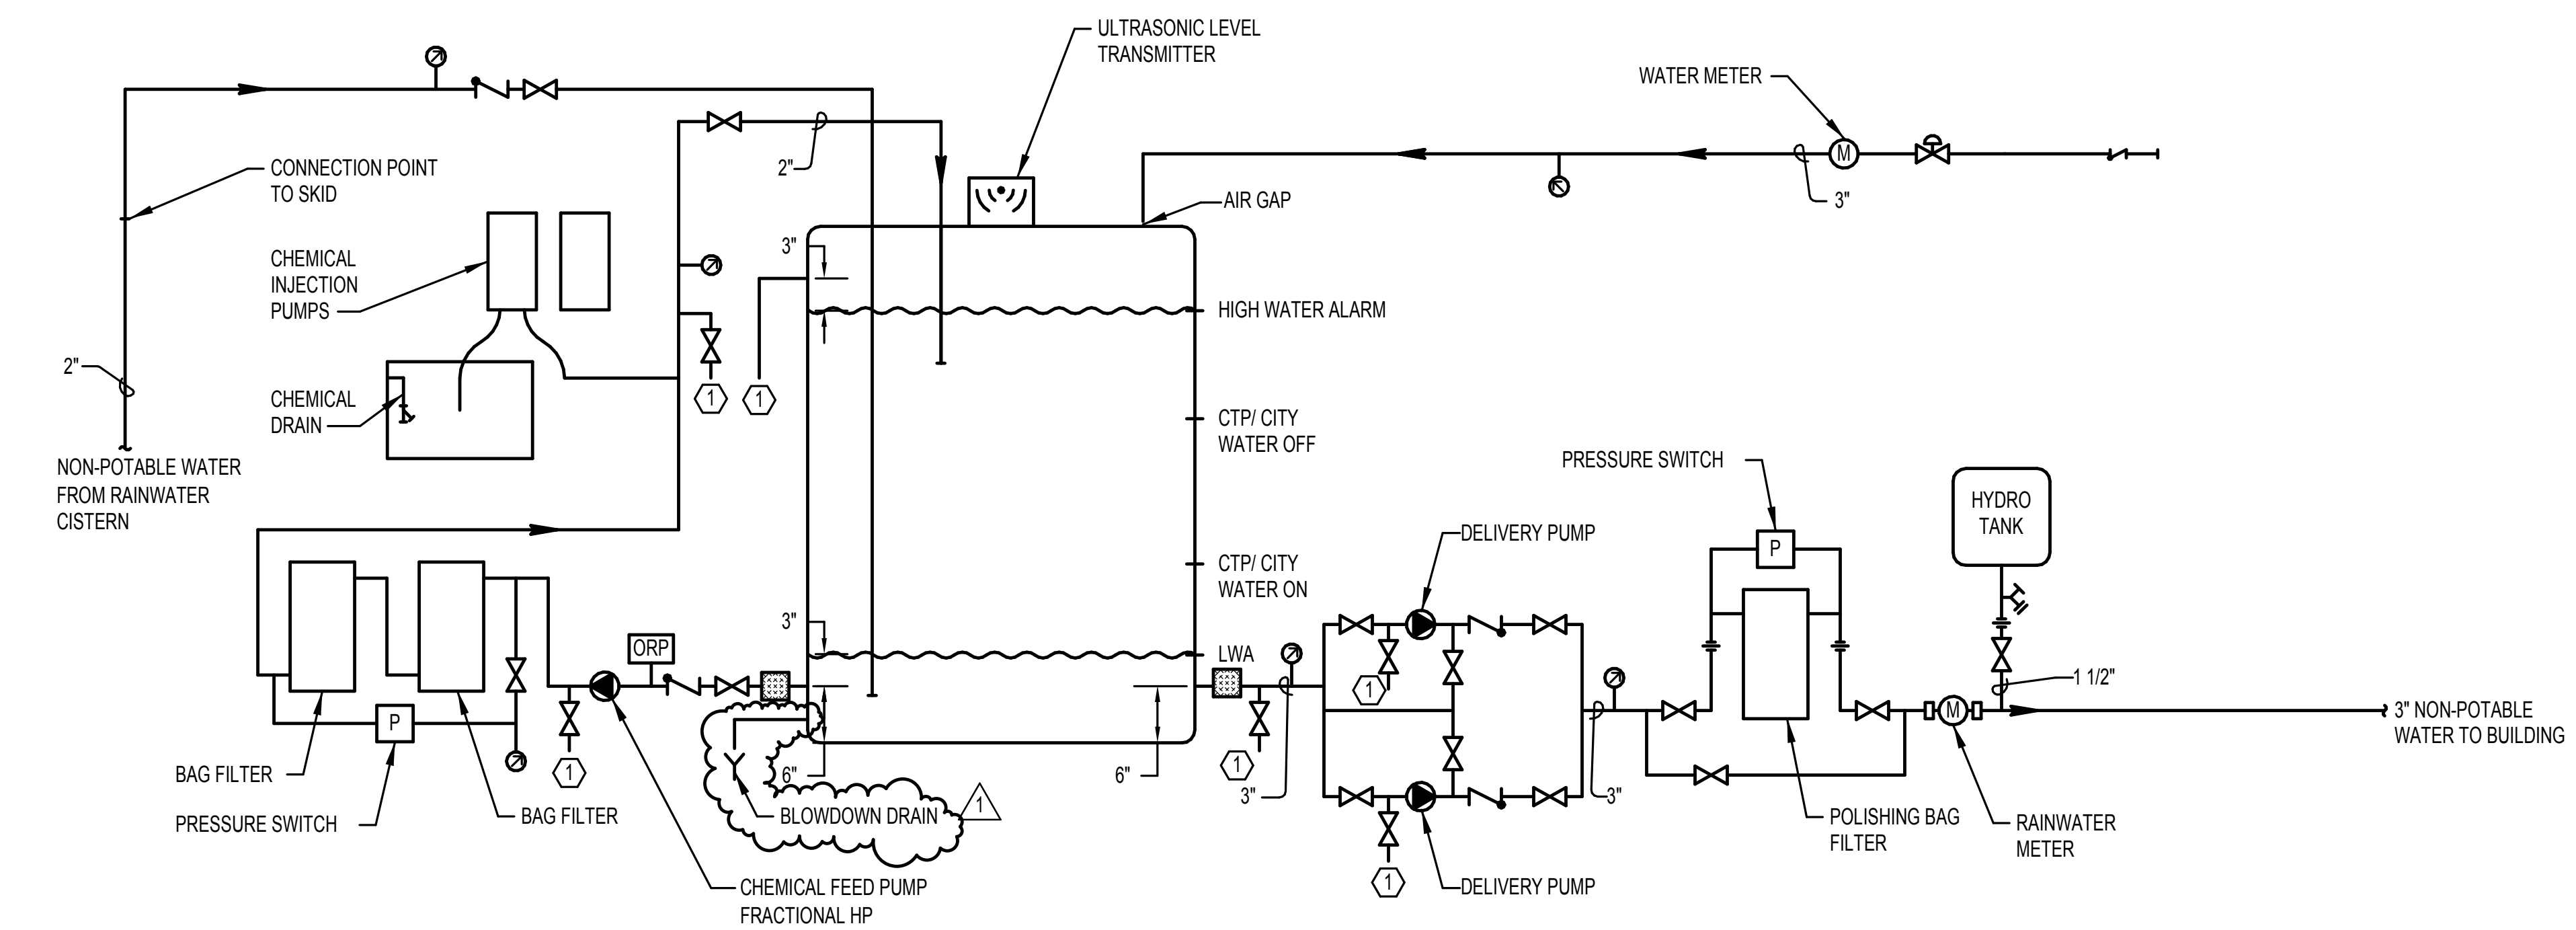

GENERAL NOTES:

- A. LOCATE RAINWATER TREATMENT SKID ON TOP OF HOUSEKEEPING PAD.

NOTES:

- 1. ROUTE TO FLOOR SINK. DRAIN INDIRECTLY.

A2 RAINWATER HARVESTING SYSTEM DIAGRAM

12" = 1'-0"

PIPE SIZING TABLE FOR GAS PRESSURE 2 PSIG FOR SCHEDULE 40 PIPE

LENGTH OF PIPE(FEET)	PIPE SIZE(INCHES) CFH		
	1"	1 1/4"	1 1/2"
10	4568	9379	14052
20	3140	6446	9658
30	2522	5176	7756
40	2158	4430	6638
50	1913	3927	5883
60	1733	3558	5331
70	1594	3273	4904
80	1483	3045	4562
90	1392	2857	4281
100	1315	2669	4044
125	1165	2392	3584
150	1056	2167	3247
175	972	1994	2987
200	904	1855	2779
250	801	1490	2463
300	726	1315	2232

BASIS OF DESIGN
NATURAL GAS SYSTEM
 BASIS OF DESIGN: 2010 OREGON MECHANICAL SPECIALTY CODE, APPENDIX C, 'FUEL GAS', SECTION C402, 'PIPE SIZING'. REFER TO TABLE C402.4(3) FOR MEDIUM PRESSURE NATURAL GAS (MPG) PIPE SIZING AND TABLE C402.4(2) FOR LOW PRESSURE NATURAL GAS (G) PIPE SIZING. MEDIUM PRESSURE GAS TO BE 2.0 PSI WITH 1.0 PSI PRESSURE DROP. LOW PRESSURE GAS TO BE LESS THAN 2.0 PSI WITH A 0.5 IN. W.C. PRESSURE DROP.
 EQUIVALENT LENGTH OF PIPE: 170 FT (MPG), 25 FT (G)

BASIS OF DESIGN
NATURAL GAS SYSTEM
 BASIS OF DESIGN: 2012 INTERNATIONAL FUEL GAS CODE, CHAPTER 4, 'FUEL-GAS PIPING'.
 EQUIVALENT LENGTH OF PIPE: 103 FT (2 PSI MPG)

GENERAL NOTES:
 A. EQUIVALENT LENGTH OF PIPE FOR "2 PSI MPG" WAS MEASURED FROM GAS METERS TO EMERGENCY GENERATOR'S GPRV.
 B. EQUIVALENT LENGTH OF PIPE FOR "G" WAS MEASURED FROM BOILER'S GPRV TO BOILER.
 C. PROVIDE GAS VENT THROUGH ROOF FROM EACH GAS PRESSURE REGULATOR. TERMINATE WITH TURN DOWN ELBOW AND BUG SCREEN.

NOTES:
 1. PROVIDE SLEEVE ON BURIED PIPING BELOW CONCRETE OR ASPHALT. PROVIDE VENT TO ATMOSPHERE AT ENDS OF SLEEVES IN ACCORDANCE WITH AHJ & LOCAL GAS COMPANY.
 2. BURIED GAS PIPING (POLYETHYLENE) BELOW CONCRETE SHALL BE INSTALLED WITHIN A SLEEVE. VENT BOTH ENDS OF BURIED SLEEVES IN ACCORDANCE WITH CODE & LOCAL AUTHORITY HAVING JURISDICTION.

mahlum
 Robertson, Sherwood Architects
 ROBERTSON/SHERWOOD/ARCHITECTS PC
 132 EAST BROADWAY, SUITE 540
 EUGENE, OREGON 97401
 541-342-8077
 www.robertsonsherwood.com


MAHLUM ARCHITECTS INC
 1231 NW HOYT, SUITE 102
 PORTLAND, OREGON 97209
 503-224-4032
 71 COLUMBIA, FLOOR 4
 SEATTLE, WASHINGTON 98104
 206-441-4151
 www.mahlum.com

PAE
 Portland | San Francisco | Seattle
 pae-engineers.com



EUGENE SCHOOL DISTRICT 4J

REPLACEMENT ROOSEVELT MIDDLE SCHOOL
 CIP NUMBER 410.566.001
 680 EAST 24TH AVENUE
 EUGENE, OREGON 97405
 CIP NO. 410.566.001

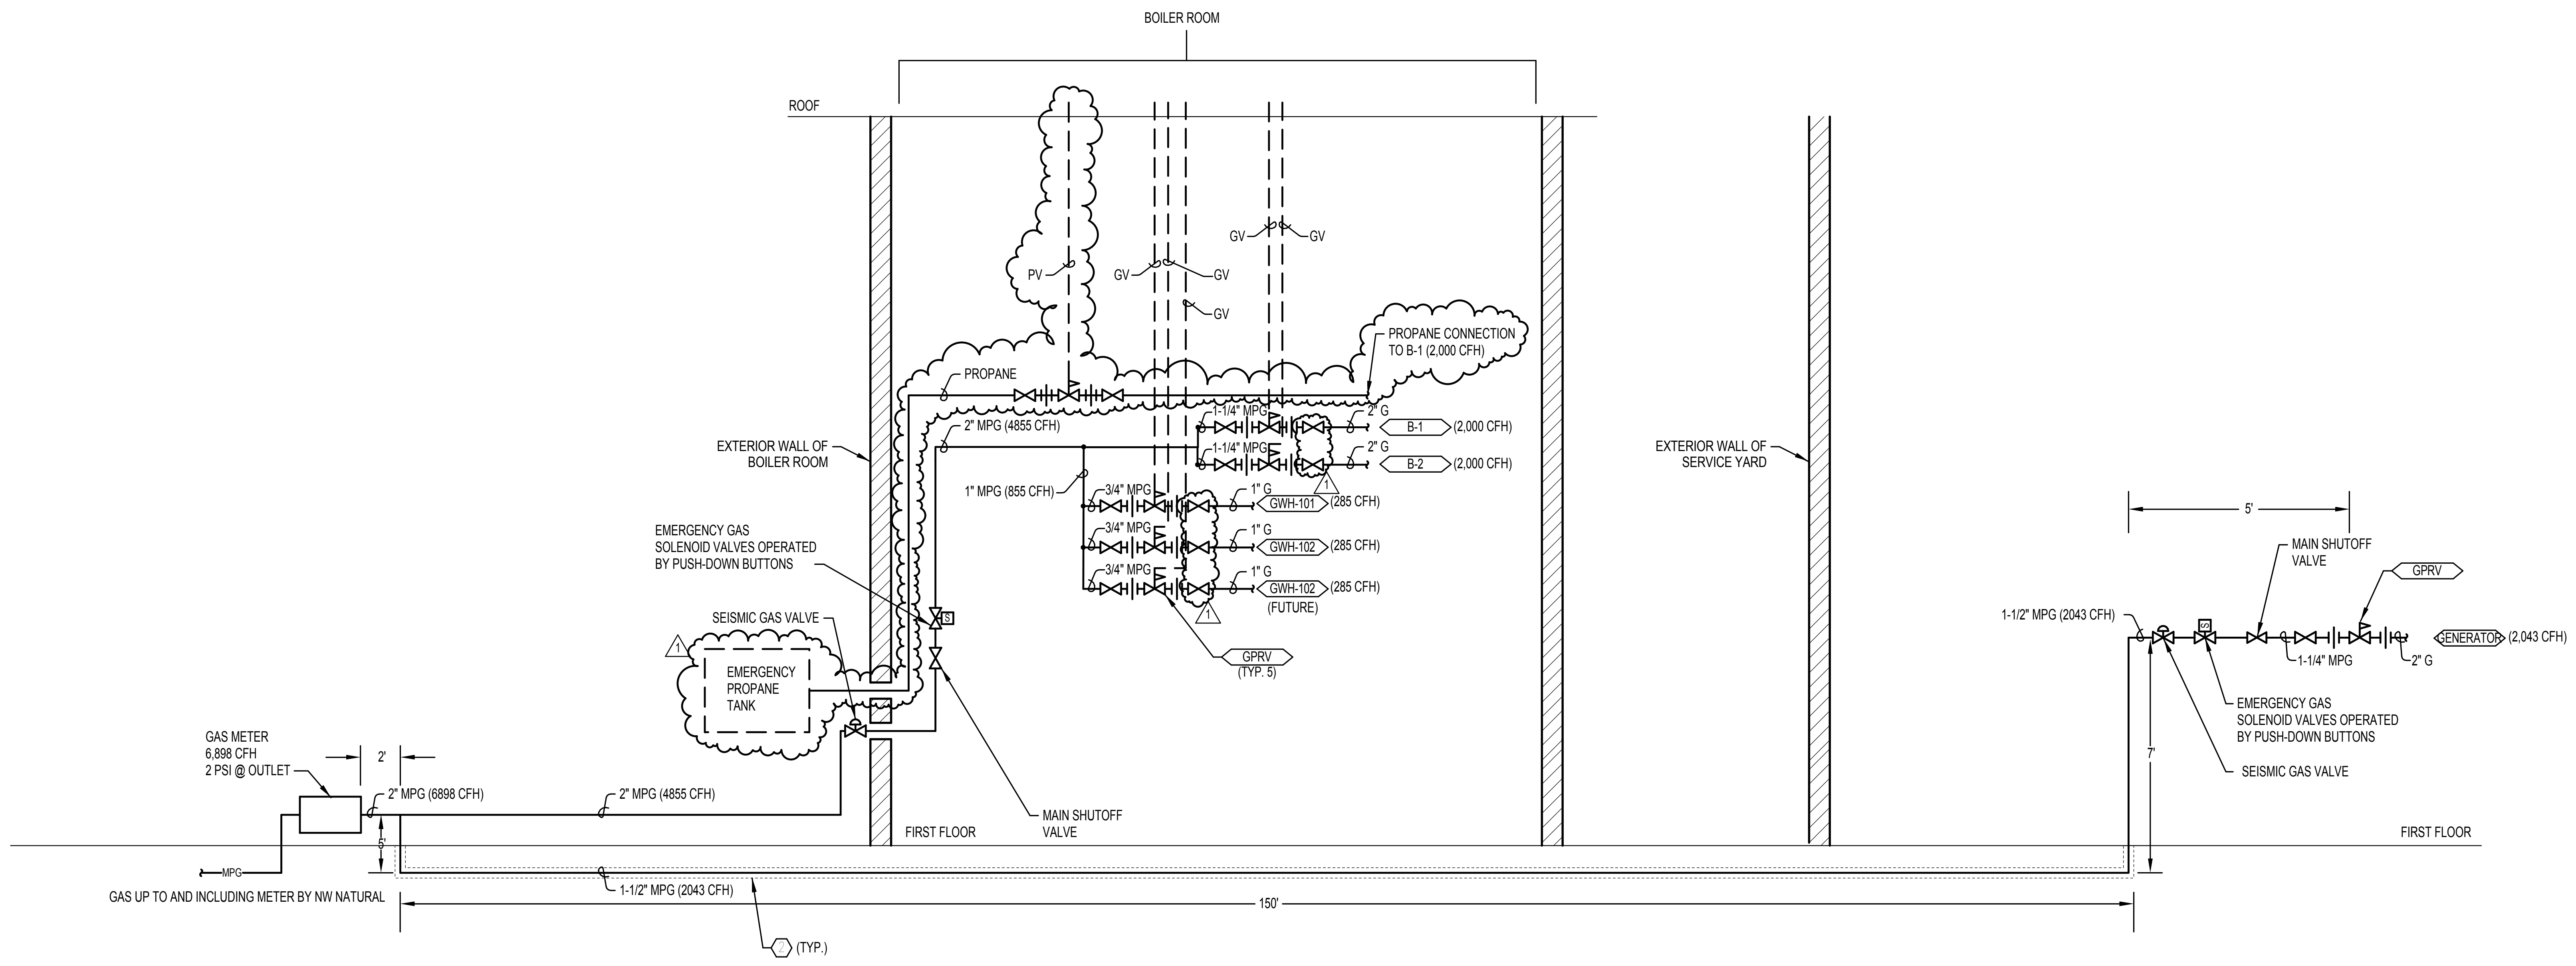






A1 GAS PIPING DIAGRAM
 12" = 1'-0"

MARK	DATE	DESCRIPTION
1	03-13-2015	ADDENDUM 6
ISSUE DATE: FEBRUARY 18, 2015		
ISSUE: CONSTRUCTION DOCUMENTS		
VOLUME: PACKAGE 2 VOLUME 2		
PROJECT NO: 2013912.00		
DRAWN BY: SG		
CHECKED BY: JCY		
COPYRIGHT MAHLUM ARCHITECTS, INC. 2014 ORIGINAL SHEET SIZE: 30"X42"		

RISER DIAGRAM - GAS


P-606

STANDARD MECHANICAL ABBREVIATIONS table listing various mechanical symbols and their corresponding text abbreviations.

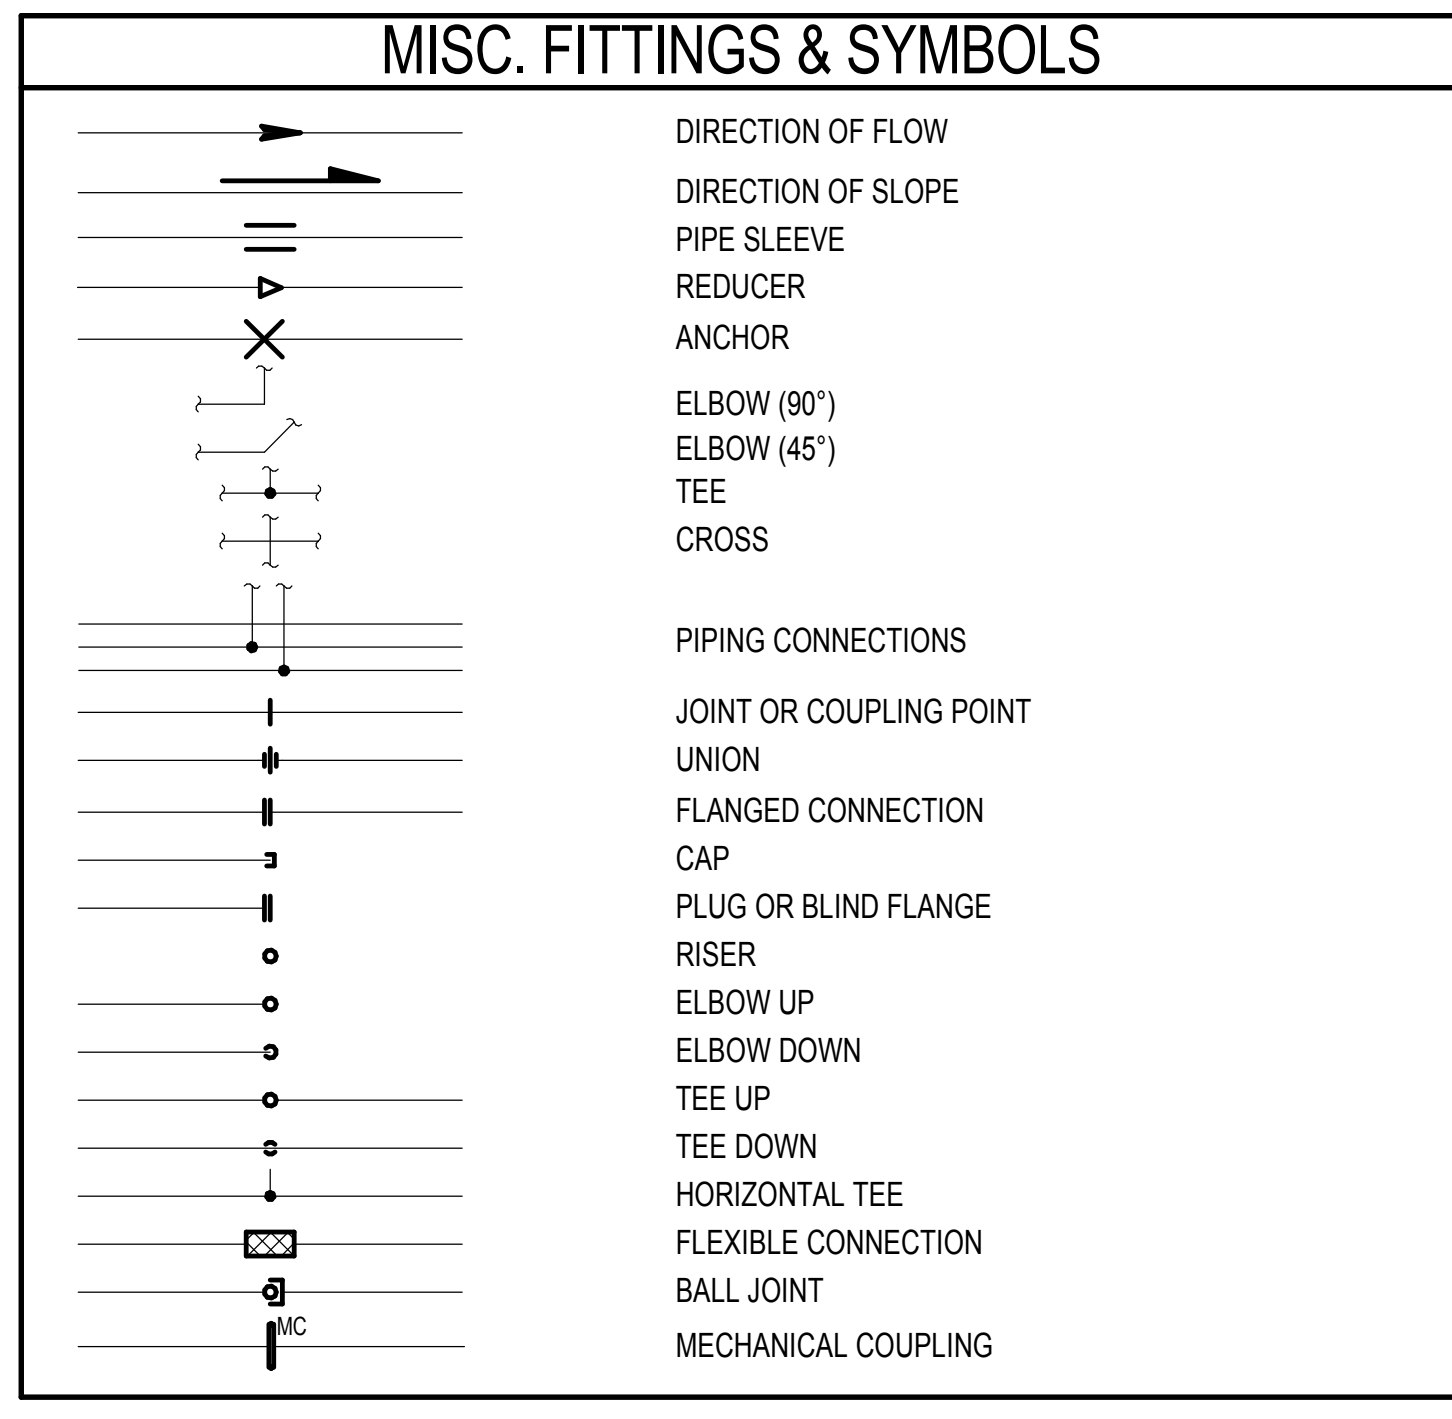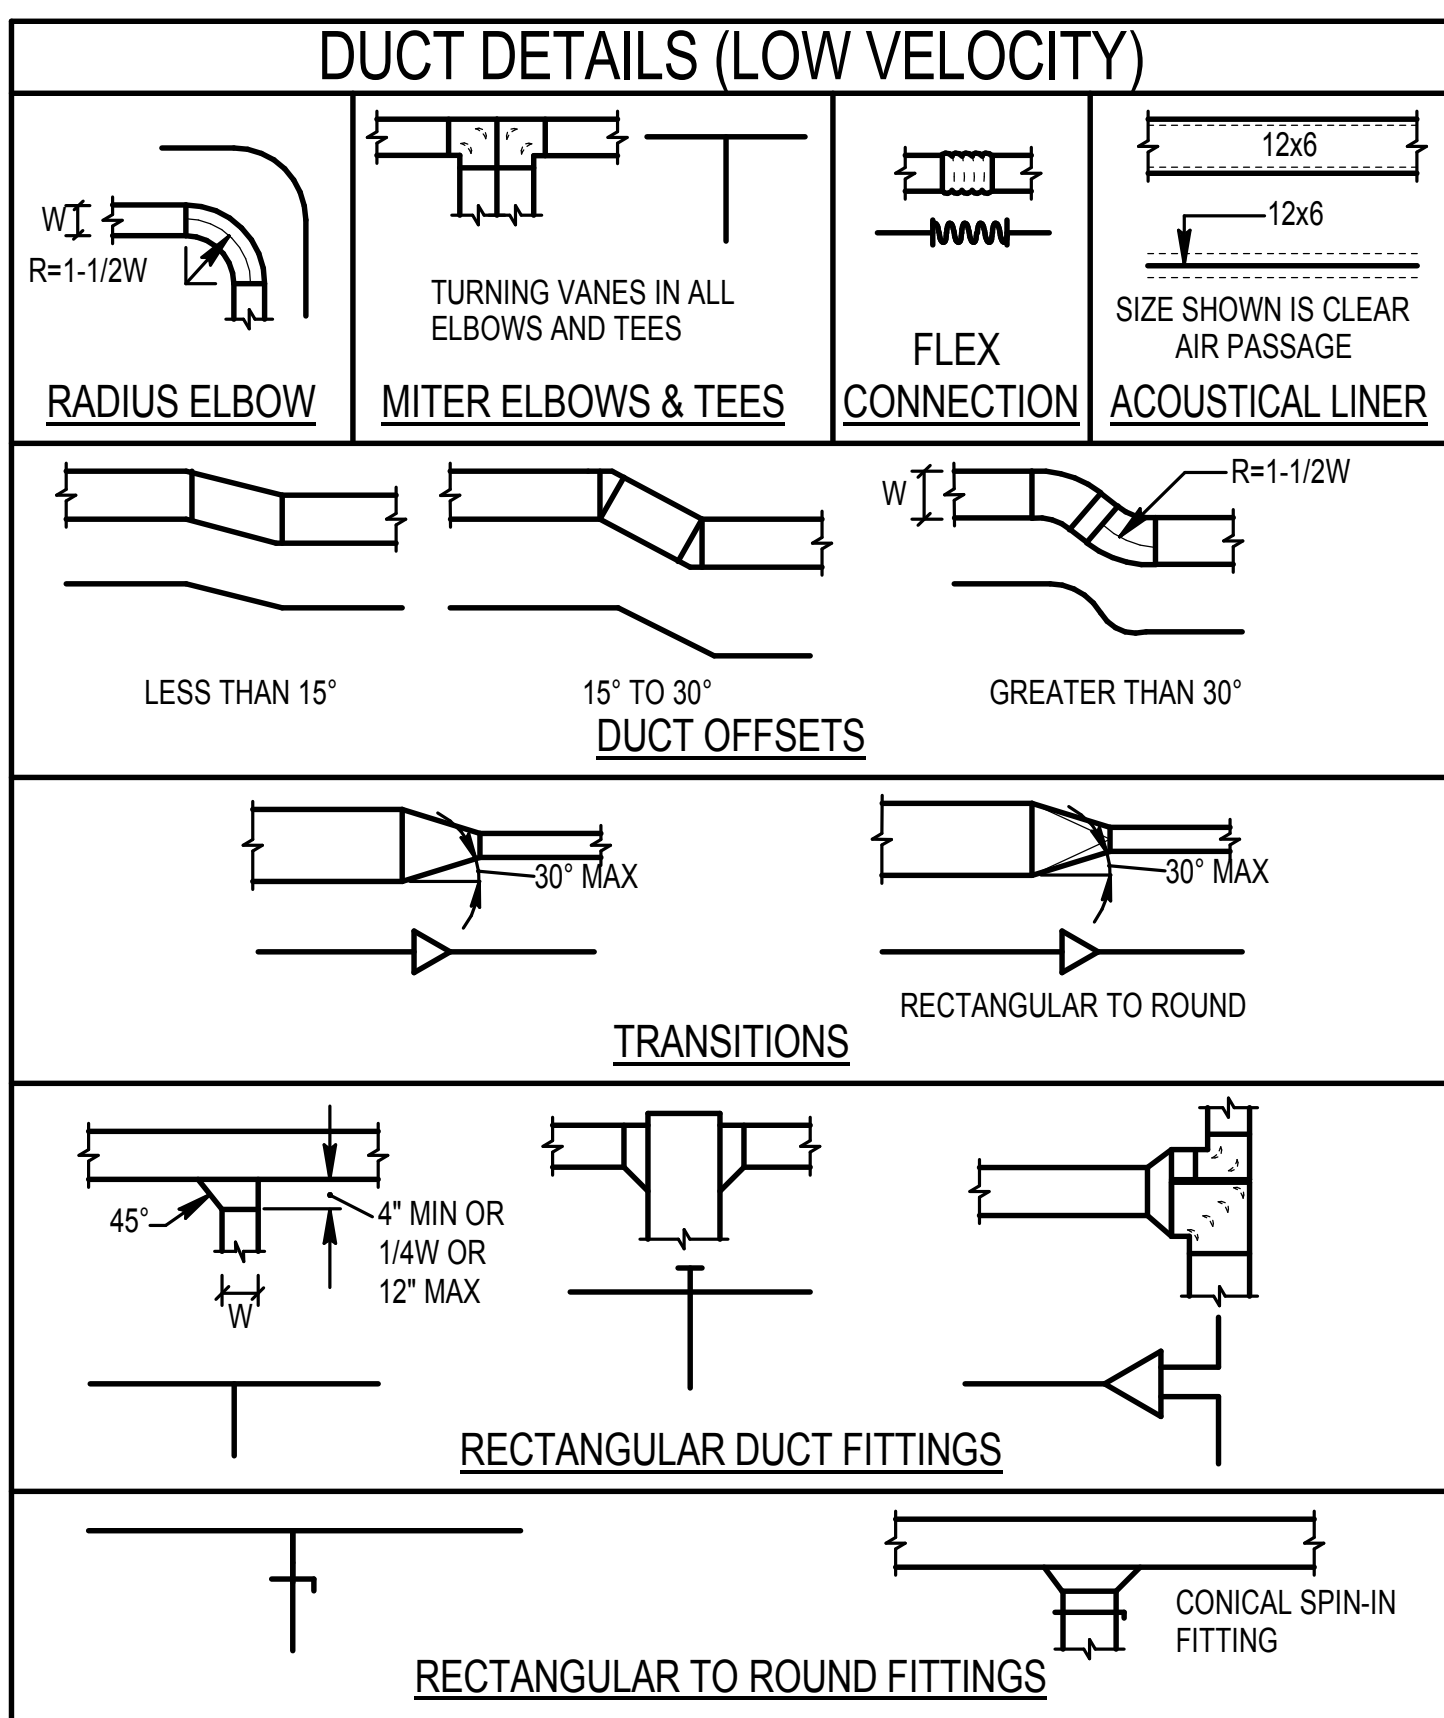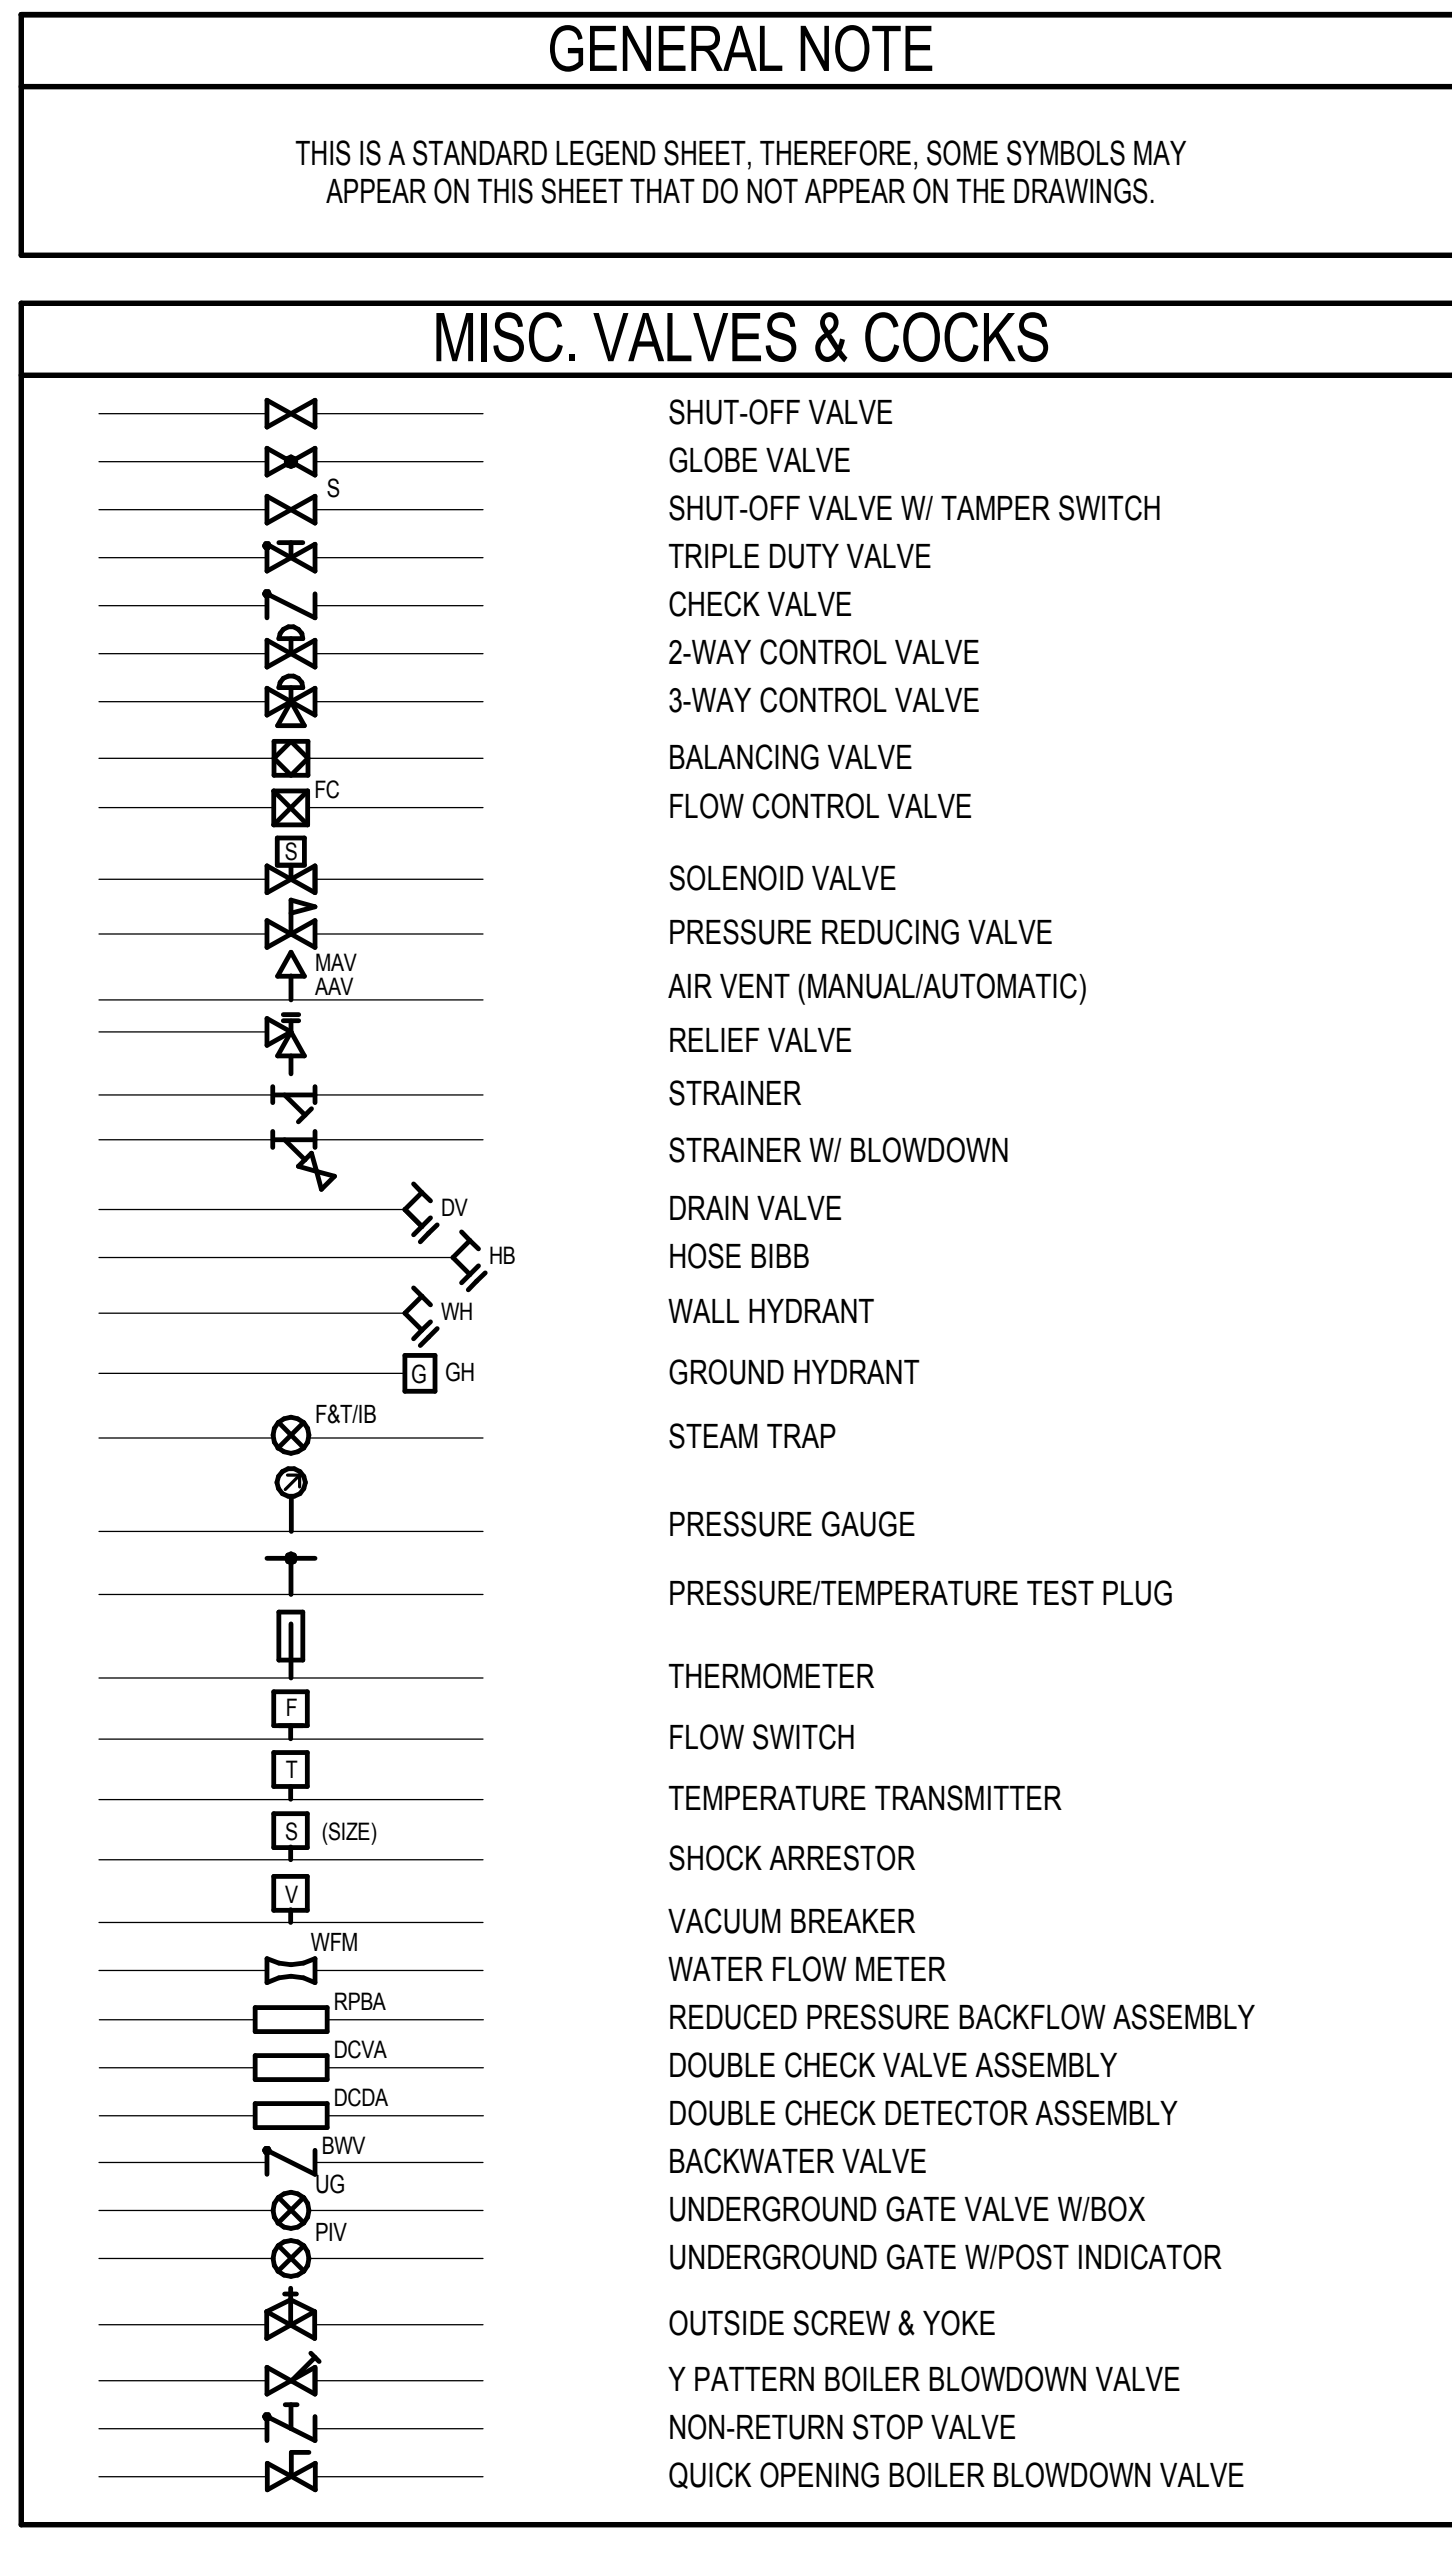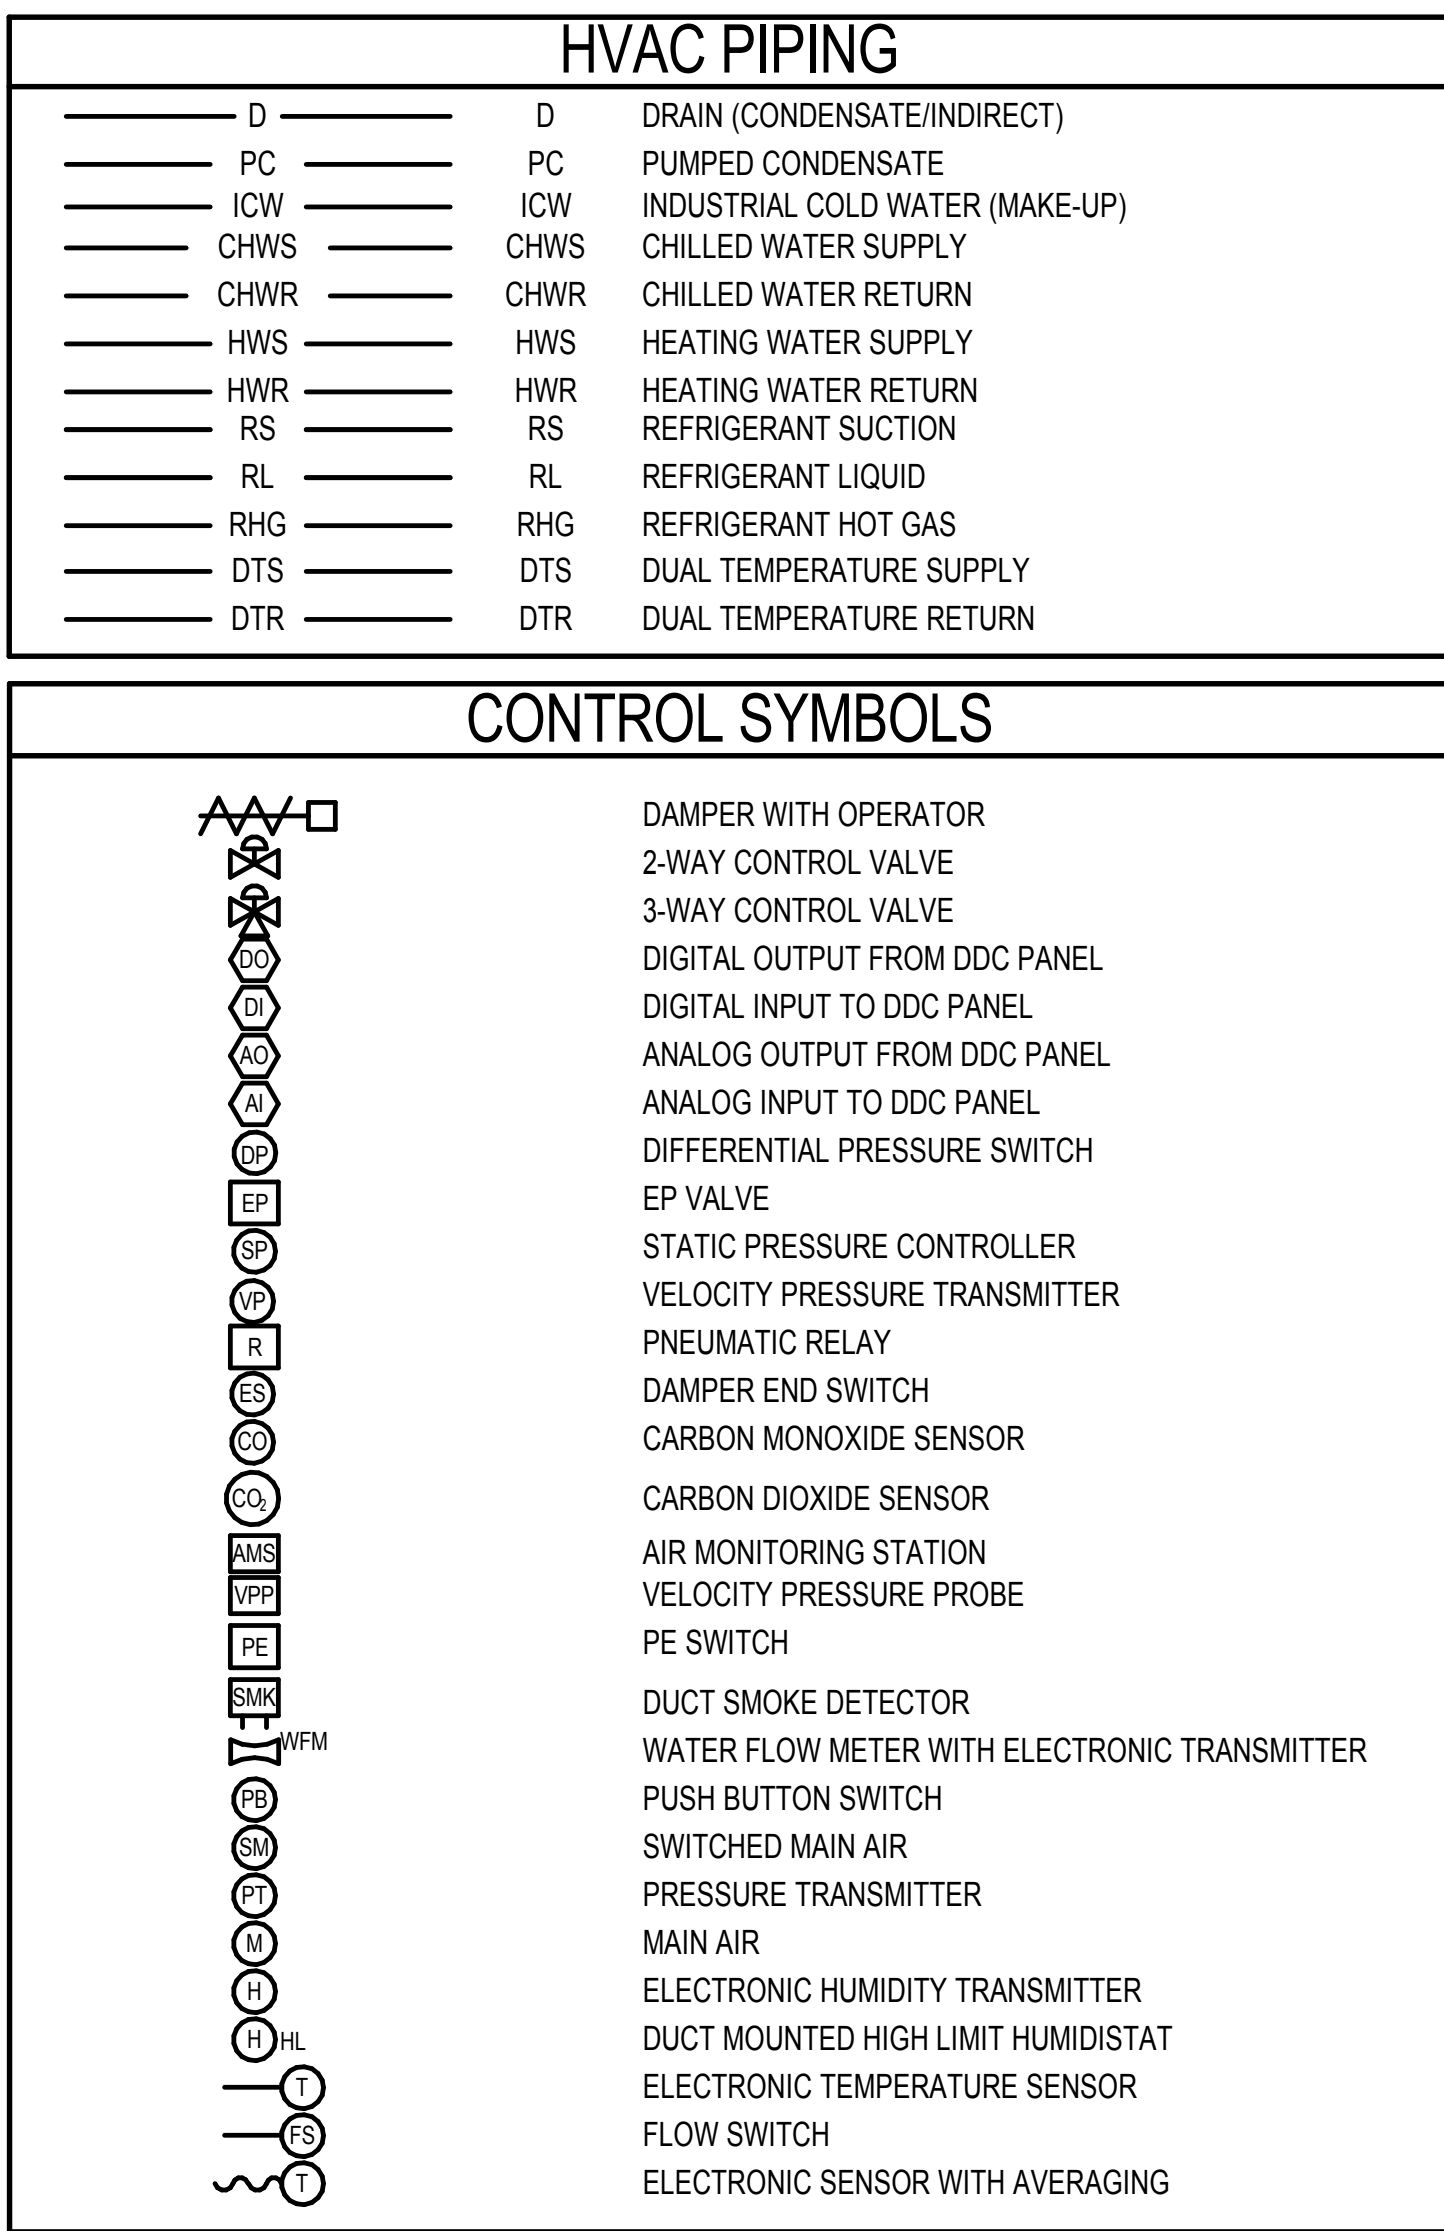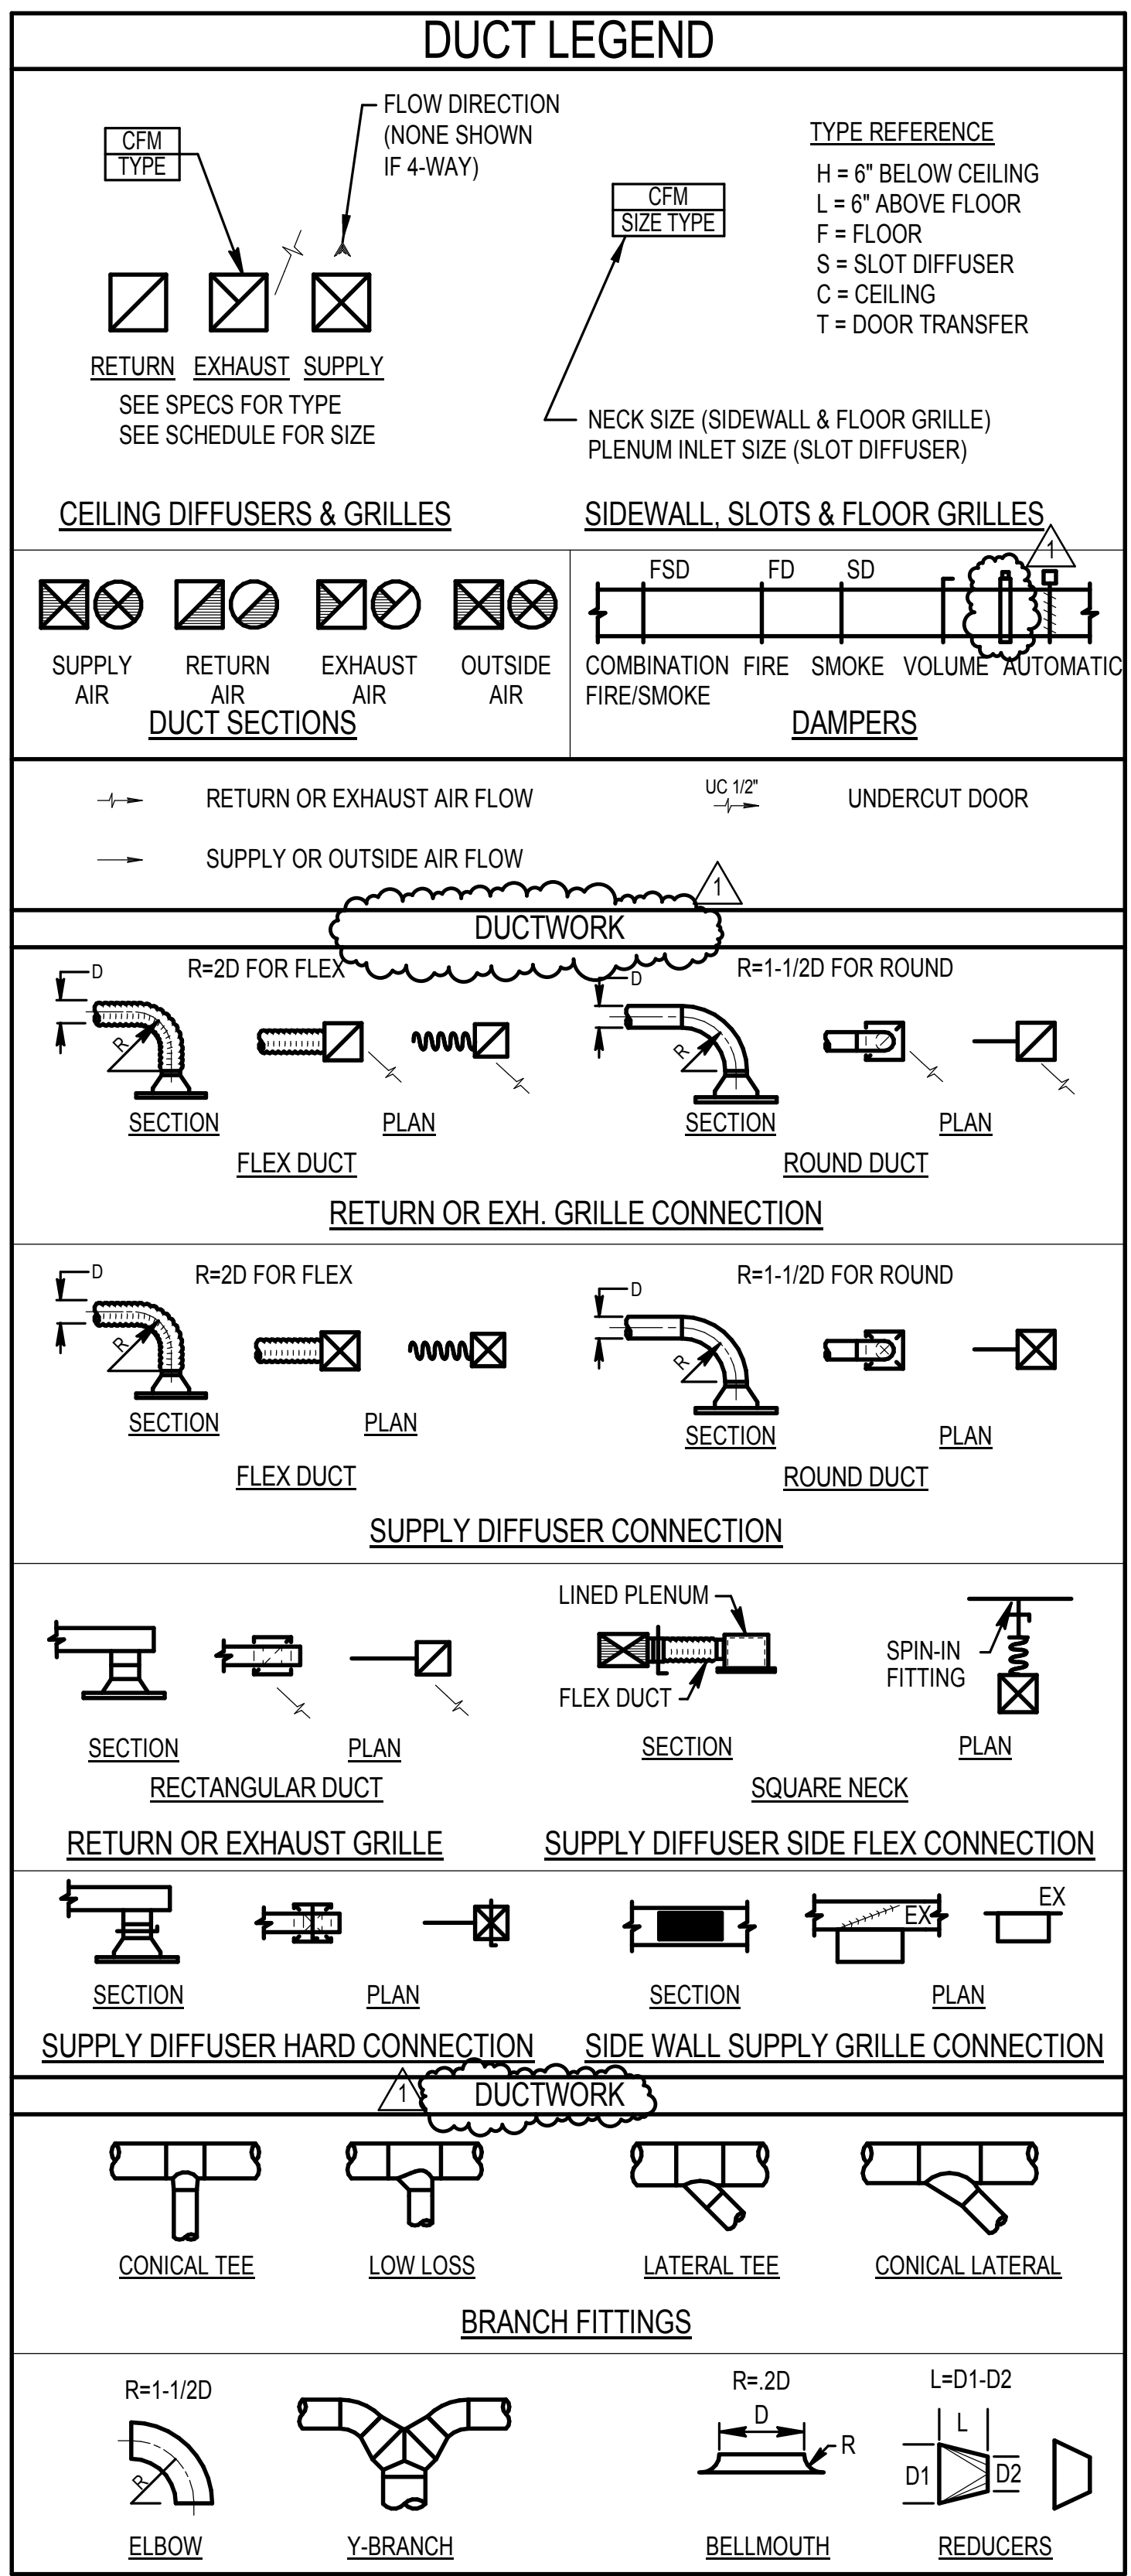


MECHANICAL DRAWING LIST - PACKAGE 2 table listing sheet numbers and sheet names for various drawing packages.

TEMPERATURE CONTROLS NOTE text providing instructions on how to design and provide a direct digital control system for temperature controls.

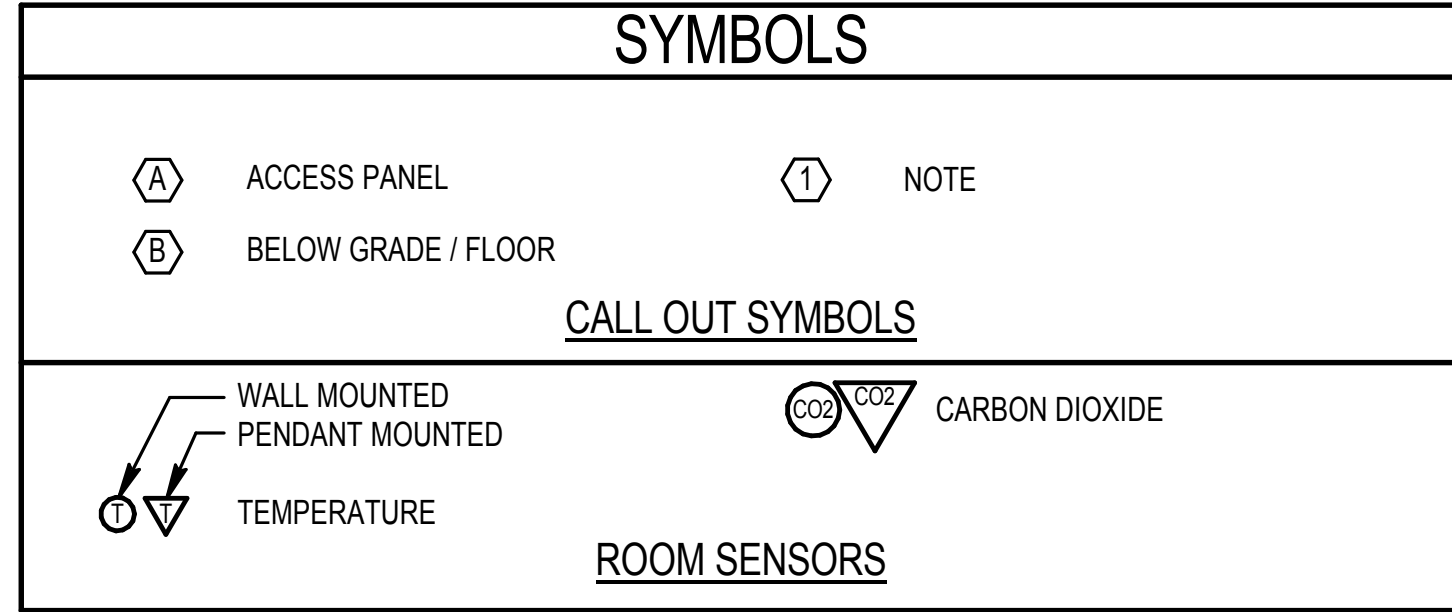

Project information including logos for mahlum, PAE, and 4J, along with contact details, project name (EUGENE SCHOOL DISTRICT 4J), and drawing title (M-001).

Vertical text on the left margin: 3/10/2015 4:05:05 PM C:\Users\mhall\OneDrive\Documents\MEP4\CENTRAL_4j.mxd

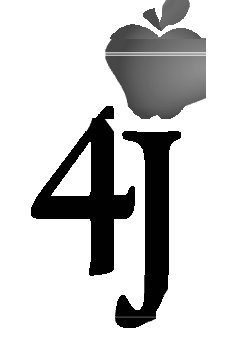

AIR COOLED CHILLER SCHEDULE

TAG NUMBER	LOCATION	SERVICE	DESIGN CAPACITY (TONS)	EVAPORATOR					ELECTRICAL					DESIGN EFFICIENCY				CODE AHRI EFFICIENCY				REFRIGERANT		APPROX. WEIGHT (LBS)	MANUFACTURER & MODEL	NOTES				
				EWT (°F)	LWT (°F)	FLUID	DESIGN FLOW RATE (GPM)	MAX WPD (FT. WG.)	MINIMUM FLOW RATE (GPM)	COMPRESSORS			FANS		SINGLE POINT CONNECTION		FULL LOAD (EER)	NPLV (EER)	FULL LOAD (COP)	IPLV/ NPLV (COP)	FULL LOAD (EER)	NPLV (EER)	FULL LOAD (COP)				IPLV/ NPLV (COP)	TYPE	QUANTITY (LBS)	
										COUNT	RLA	VFD	COUNT	FLA PER FAN	VFD	MCA														VOLT/ PHASE
ACC-1	SERVICE COURT	CHILLED WATER	130	60	44	WATER	200.0	8.8	119	4	237	N	8	3.6	N	284	460/3	10.1	15.4	2.95	15.4	10.1	-	-	15.4	R-410A	230	5,903	DAIKIN APPLIED AGZ130E	

GENERAL NOTES:
A. DESIGN EFFICIENCIES ARE AT DESIGN CONDITIONS LISTED IN THE SCHEDULE.
B. AHRI EFFICIENCIES ARE AT ARI STANDARD CONDITIONS.
C. CODE AHRI EFFICIENCY REQUIREMENTS PROVIDED FOR REFERENCE.
D. PROVIDE SCCR SUFFICIENT TO MEET THE AVAILABLE FAULT CURRENT AT THE PANELBOARD OR SWITCHBOARD FROM WHICH THE UNIT IS FED. COORDINATE WITH ELECTRICAL DRAWINGS AND ELECTRICAL CONTRACTOR.

NOTES:
1. NONE.

PUMP SCHEDULE

TAG NUMBER	LOCATION	SERVICE	TYPE	FLUID TYPE	PERFORMANCE				MOTOR				APPROX. WEIGHT (LBS)	MANUFACTURER & MODEL	NOTES		
					MAX FLOW (GPM)	MIN FLOW (GPM)	HEAD (FT. WC.)	SHUTOFF HEAD (FT. WC.)	PUMP EFFICIENCY %	TYPE	HP	RPM				VFD	VOLT/ PHASE
CP-1	BOILER 174	DUAL TEMPERATURE WATER	BASE MOUNT	WATER	200	54	125	108	70	ODP	10	3550	Y	460/3	305	B&G 1510	
CP-2	BOILER 174	DUAL TEMPERATURE WATER	BASE MOUNT	WATER	200	54	125	108	70	ODP	10	3550	Y	460/3	305	B&G 1510	
RSP-B	MECH M301	SLAB HEAT, COOL	IN-LINE	WATER	9	9	25	-	-	PSC	1/4	3250	N	120/1	12	TACO 013	
RSP-D	MECH M281A	SLAB HEAT, COOL	IN-LINE	WATER	20	20	25	-	-	PSC	1/2	3250	N	120/1	12	TACO 00	

GENERAL NOTES:
A. NONE.
NOTES:
1. NONE.

DESIGN CONDITIONS - EUGENE, OR

SPACE	WINTER		SUMMER	
	TEMPERATURE	HUMIDITY	TEMPERATURE	HUMIDITY
OUTDOOR	17° F DB	16.1° F DP / 12.6 HR / 26.9° F MCDB	91.7° F DB / 66.5° F MCWB	62.2° F DP / 84.8 HR / 74.6° F MCDB
INDOOR	70° F ± 2° F DB	50% RH MAX, NO MINIMUM	75° F ± 2° F DB	50% RH MAX, NO MINIMUM

GENERAL NOTES:
1. OUTDOOR CONDITIONS BASED ON ASHRAE FUNDAMENTALS 2013 99.6% AND 0.4% DATA.

BOILER SCHEDULE

TAG NUMBER	LOCATION	SERVICE	TYPE	FUEL		FLUID			ELECTRICAL		MINIMUM EFFICIENCY (AFUE)	APPROX. WEIGHT (LBS)	MANUFACTURER & MODEL	NOTES			
				INPUT CAPACITY (MBH)	OUTPUT CAPACITY (MBH)	SUPPLY TEMP (°F)	RETURN TEMP (°F)	DESIGN FLOW (GPM)	MIN FLOW (GPM)	MAX WPD (FT. WG.)					FLA	VOLT/ PHASE	
B-1	BOILER 174	BUILDING HEAT	CONDENSING	NAT. GAS	2,000	1,840	130	112	200	25	4.0	7	120/1	92%	3,054	LOCHINVAR CREST	1
B-2	BOILER 174	BUILDING HEAT	CONDENSING	NAT. GAS/PROPANE	2,000	1,840	130	112	200	25	4.0	7	120/1	92%	3,054	LOCHINVAR CREST	1

GENERAL NOTES:
A. UNITS MOUNTED ON HOUSEKEEPING PAD.
B. MINIMUM EFFICIENCY IS AT 100% FIRE, 100 DEG F RETURN WATER TEMPERATURE AND 140 DEG F SUPPLY WATER TEMPERATURE.
C. PROVIDE 48 INCHES CLEAR BETWEEN MULTIPLE BOILERS.
D. PROVIDE A MINIMUM SIDE CLEARANCE OF 36 INCHES FOR EACH BOILER.
E. PROVIDE 36 INCHES TOP CLEARANCE ABOVE BOILER.

NOTES:
1. MINIMUM LOW LISTED IS ABSOLUTE MINIMUM, ALL LOADS.

FAN COIL UNIT SCHEDULE

TAG NUMBER	LOCATION	SERVICE	ACCU	TYPE	SUPPLY		COOLING (MBH)	ELECTRICAL		MANUFACTURER & MODEL	NOTES
					AIRFLOW CFM	ESP (IN WG)		FLA	VOLTS/ PHASE		
FCU-IDF-A	IDF ROOM A	IDF ROOM	ACCU-IDF-A	HORIZONTAL	800	0.3	18.0	4.3	208/1	CARRIER FV4C-002	1
FCU-IDF-B	IDF ROOM B	IDF ROOM	ACCU-IDF-B	HORIZONTAL	800	0.3	18.0	4.3	208/1	CARRIER FV4C-002	1
FCU-MDF-D	MDF ROOM D	MDF ROOM	ACCU-MDF-D	HORIZONTAL	1400	0.3	36.0	4.3	208/1	CARRIER FV4C-005	1
FCU - ELEC	ELEC RM	ELEC RM	ACCU-ELEC	HORIZONTAL	800	0.3	24.0	4.3	208/1	CARRIER FV4C-003	1
FCU-ELEV	ELEV RM	ELEV RM	ACCU-ELEV	WALL-MOUNT	400	-	12.0	13	208/1	DAIKIN APPLIED AGZ130E	2,3

NOTES:
1. INCLUDE INTEGRAL MIXING BOX AND DAMPERS.
2. DUCTLESS INDOOR UNIT RECEIVES POWER FROM OUTDOOR UNIT.
3. COOLING ONLY UNIT.

AIR HANDLING UNIT

Table with columns: TAG NUMBER, LOCATION, SERVICE, DESIGN OSA CFM, MIN CO2 OSA CFM, FILTER MERV RATING, DESIGN AIRFLOW CFM, ECONOMIZER AIRFLOW CFM, FAN TYPE, SUPPLY FAN (TSP, ESP, FAN QTY, FAN RPM, MOTOR BHP, MOTOR HP, VOLTS, VFD, ECM), INTEGRAL RETURN/EXHAUST FAN (AIRFLOW CFM, FAN TYPE, TSP, FAN RPM, MOTOR BHP, MOTOR HP, VOLTS, VFD, ECM), HYDRONIC COIL - HEATING MODE (HEATING AIRFLOW CFM, EAT, LAT, GPM, EWT), HYDRONIC COIL - COOLING MODE (COOLING AIRFLOW CFM, EAT, LAT, GPM, EWT), MIN WTD, ECON COIL FACE VELOCITY, COIL RUNOUT PIPING (INCH), APPROX. WEIGHT (LBS), MANUFACTURER & MODEL, NOTES.

- GENERAL NOTES:
A. MINIMUM OSA CALCULATED BASED ON CODE AND ASHRAE STANDARD 62.
B. DUAL HEATING/COOLING COILS BASED ON MAXIMUM FACE VELOCITY OF 500 FPM, 0.5 IN WG MAXIMUM AIR PRESSURE DROP AND 12 FT WG MAXIMUM WATER PRESSURE DROP.
C. PROVIDE SCRR SUFFICIENT TO MEET THE AVAILABLE FAULT CURRENT AT THE PANELBOARD OR SWITCHBOARD FROM WHICH THE UNIT IS FED. COORDINATE WITH ELECTRICAL DRAWINGS AND ELECTRICAL CONTRACTOR.
D. ALL FANS TO BE DIRECT DRIVE UNLESS NOTED OTHERWISE.

- NOTES:
1. UNIT TO HAVE TOP SA DISCHARGE.
2. UNIT TO HAVE TOP OSA INLET, RA INLET ON THE END.
3. UNIT TO HAVE TOP RA INLET, OSA INLET ON THE END.
4. UNIT TO BE MOUNTED ON 6" BASE RAIL.
5. PROVIDE POWERED RETURN AIR SECTION.
6. SINGLE UNIT WITH TWO SUPPLY FANS.
7. UNIT TO BE MOUNTED ON 4" WOOD SLEEPER.
8. MOUNT VERTICAL FAN COIL ON MIXING PLENUM.

3/10/2015 11:48:59 AM C:\Users\Local Admin\Documents\Projects\410566\410566.dwg

GENERAL NOTES:

- A. PROVIDE VOLUME DAMPER AT EACH BRANCH OUTLET/INLET.
- B. ALL WORK SHALL BE COORDINATED WITH ALL TRADES INVOLVED. OFFSETS IN PIPING AND DUCTS (INCLUDING DIVIDED DUCTS) AND TRANSITIONS AROUND OBSTRUCTIONS SHALL BE PROVIDED AT NO ADDITIONAL COST TO THE OWNER.
- C. VERIFY ALL EQUIPMENT CONNECTIONS WITH MANUFACTURER'S CERTIFIED DRAWINGS. VERIFY AND PROVIDE DUCT TRANSITIONS TO FURNISHED EQUIPMENT. FIELD VERIFY AND COORDINATE ALL DIMENSIONS BEFORE FABRICATION.
- D. REFER TO ARCHITECTURAL REFLECTED CEILING PLANS FOR EXACT LOCATIONS OF AIR DEVICES.
- E. ALL DETAILS APPLY TO THIS SHEET WHETHER TAGGED OR NOT.
- F. PIPING SHALL BE LARGEST SIZE SHOWN UNTIL SMALLER PIPE SIZE IS INDICATED INCLUDING MAINS AND BRANCH PIPING.

NOTES:

- 1. PROVIDE CEILING RADIATION DAMPER.



ROBERTSON/SHERWOOD/ARCHITECTS PC
132 EAST BROADWAY, SUITE 540
EUGENE, OREGON 97401
541-342-8077
www.robertsonsherwood.com

MAHLUM ARCHITECTS INC
1231 NW HOYT, SUITE 102
PORTLAND, OREGON 97209
503-224-4032


71 COLUMBIA, FLOOR 4
SEATTLE, WASHINGTON 98104
206-441-4151
www.mahlum.com



Portland | San Francisco | Seattle
pae-engineers.com



EUGENE SCHOOL DISTRICT 4J

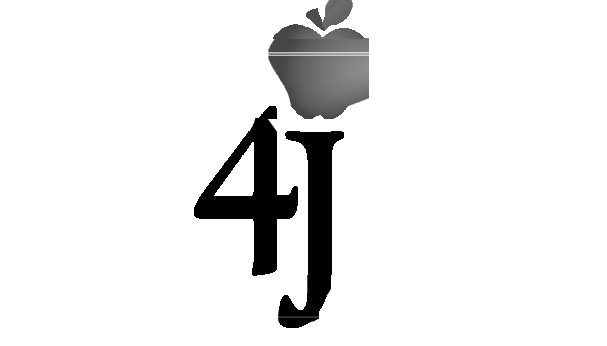


REPLACEMENT ROOSEVELT
MIDDLE SCHOOL
CIP NUMBER 410.566.001
680 EAST 24TH AVENUE
EUGENE, OREGON 97405
CIP NO. 410.566.001

MARK	DATE	DESCRIPTION
1	03-13-2015	ADDENDUM 6

ISSUE DATE:	FEBRUARY 18, 2015
ISSUE:	CONSTRUCTION DOCUMENTS
VOLUME:	PACKAGE 2 VOLUME 2
PROJECT NO.:	2013912.00
DRAWN BY:	SG
CHECKED BY:	JCY
COPYRIGHT MAHLUM ARCHITECTS, INC. 2014 ORIGINAL SHEET SIZE: 30"X42"	


FIRST FLOOR PLAN - ZONE A - MECHANICAL

M-121A

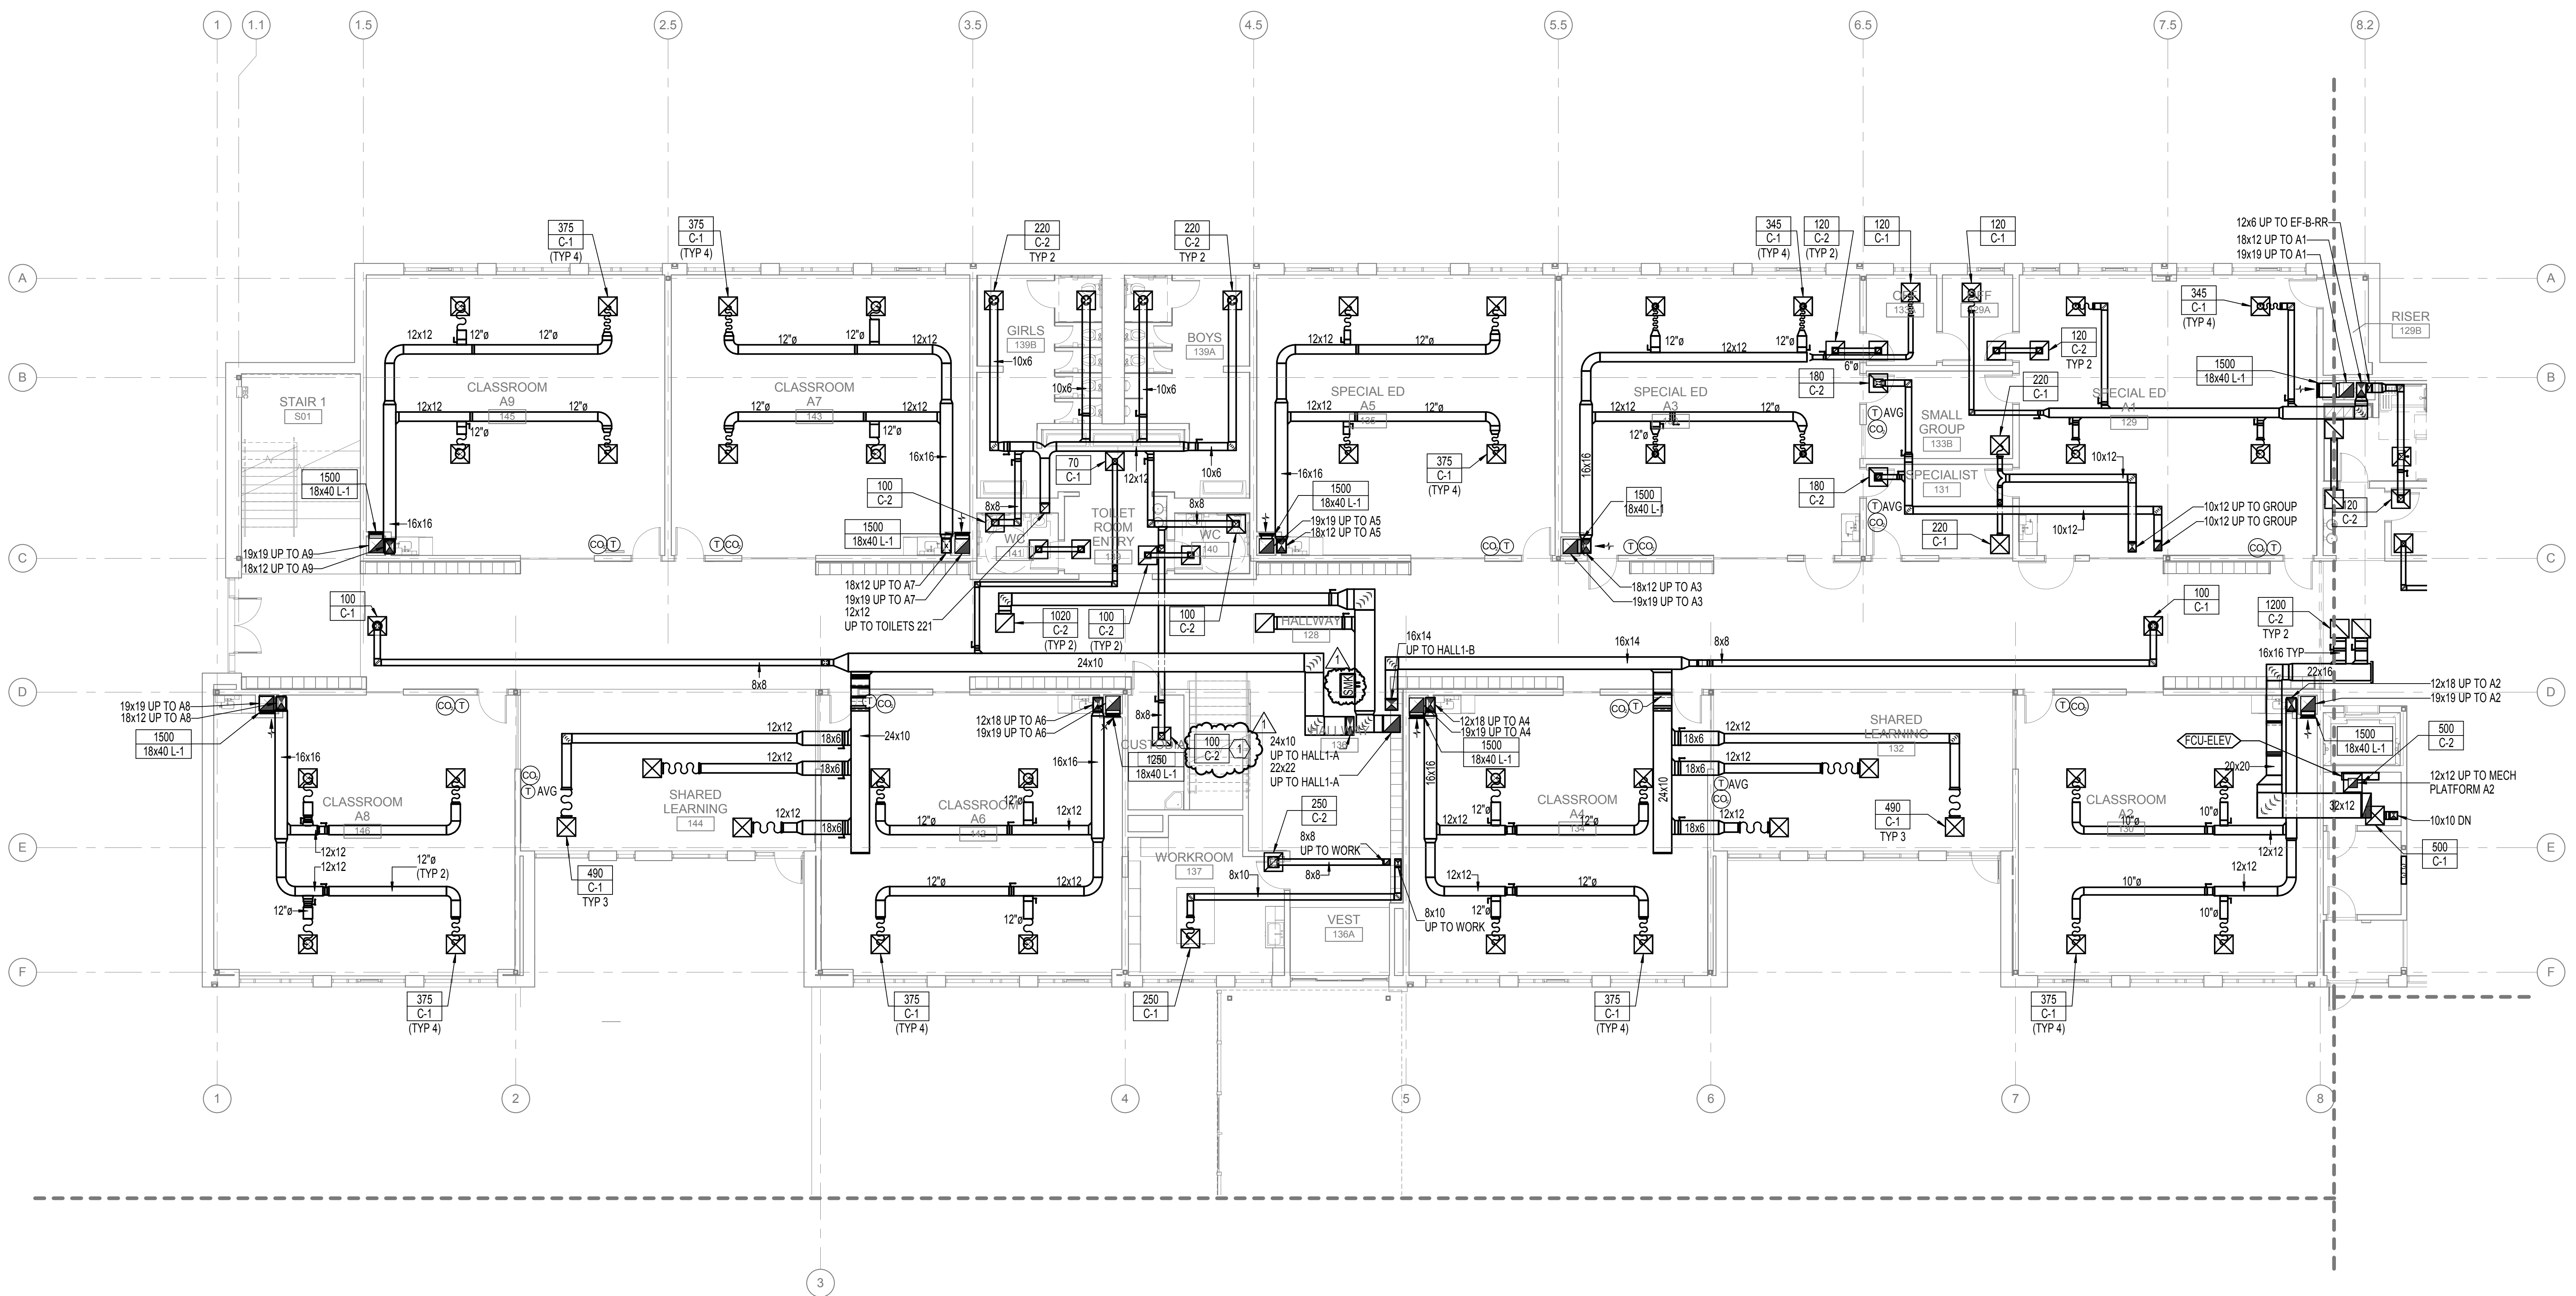

A1 FIRST FLOOR PLAN - ZONE A - MECHANICAL
1/8" = 1'-0"

3/13/2015 5:50:08 PM C:\Users\Local\Print3-138\BPA\GENERAL_Lam\meh121a

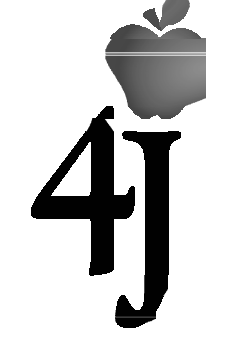


GENERAL NOTES:

- A. PROVIDE VOLUME DAMPER AT EACH BRANCH OUTLET/INLET.
- B. ALL WORK SHALL BE COORDINATED WITH ALL TRADES INVOLVED. OFFSETS IN PIPING AND DUCTS (INCLUDING DIVIDED DUCTS) AND TRANSITIONS AROUND OBSTRUCTIONS SHALL BE PROVIDED AT NO ADDITIONAL COST TO THE OWNER.
- C. VERIFY ALL EQUIPMENT CONNECTIONS WITH MANUFACTURER'S CERTIFIED DRAWINGS. VERIFY AND PROVIDE DUCT TRANSITIONS TO FURNISHED EQUIPMENT. FIELD VERIFY AND COORDINATE ALL DIMENSIONS BEFORE FABRICATION.
- D. REFER TO ARCHITECTURAL REFLECTED CEILING PLANS FOR EXACT LOCATIONS OF AIR DEVICES.
- E. ALL DETAILS APPLY TO THIS SHEET WHETHER TAGGED OR NOT.
- F. PIPING SHALL BE LARGEST SIZE SHOWN UNTIL SMALLER PIPE SIZE IS INDICATED INCLUDING MAINS AND BRANCH PIPING.
- G. PROVIDE CONDENSATE DRAIN PIPING FROM DUCT COILS TO FLOOR SINK IN IDF ROOM. WHERE GRAVITY DRAINAGE IS NOT FEASIBLE PROVIDE CONDENSATE PUMP.

NOTES:

- 1. PANEL DOOR OPENS INTO STORAGE ROOM.
- 2. OPEN ENDED DUCT, EXTERIOR AND INTERIOR TO BE PAINTED BLACK. PERFORATED WOOD CEILING BELOW TO HAVE 9 SQ. FT. FREE AREA AND NO BACKING MATERIAL DIRECTLY BELOW END OF DUCT. BALANCE TO 1625 CFM.
- 3. CONTINUES ON M-401-A2.
- 4. PUMP CONDENSATE FROM FCU TO FLOOR SINK IN MECHANICAL PLATFORM.
- 5. PROVIDE CEILING RADIATION DAMPER.

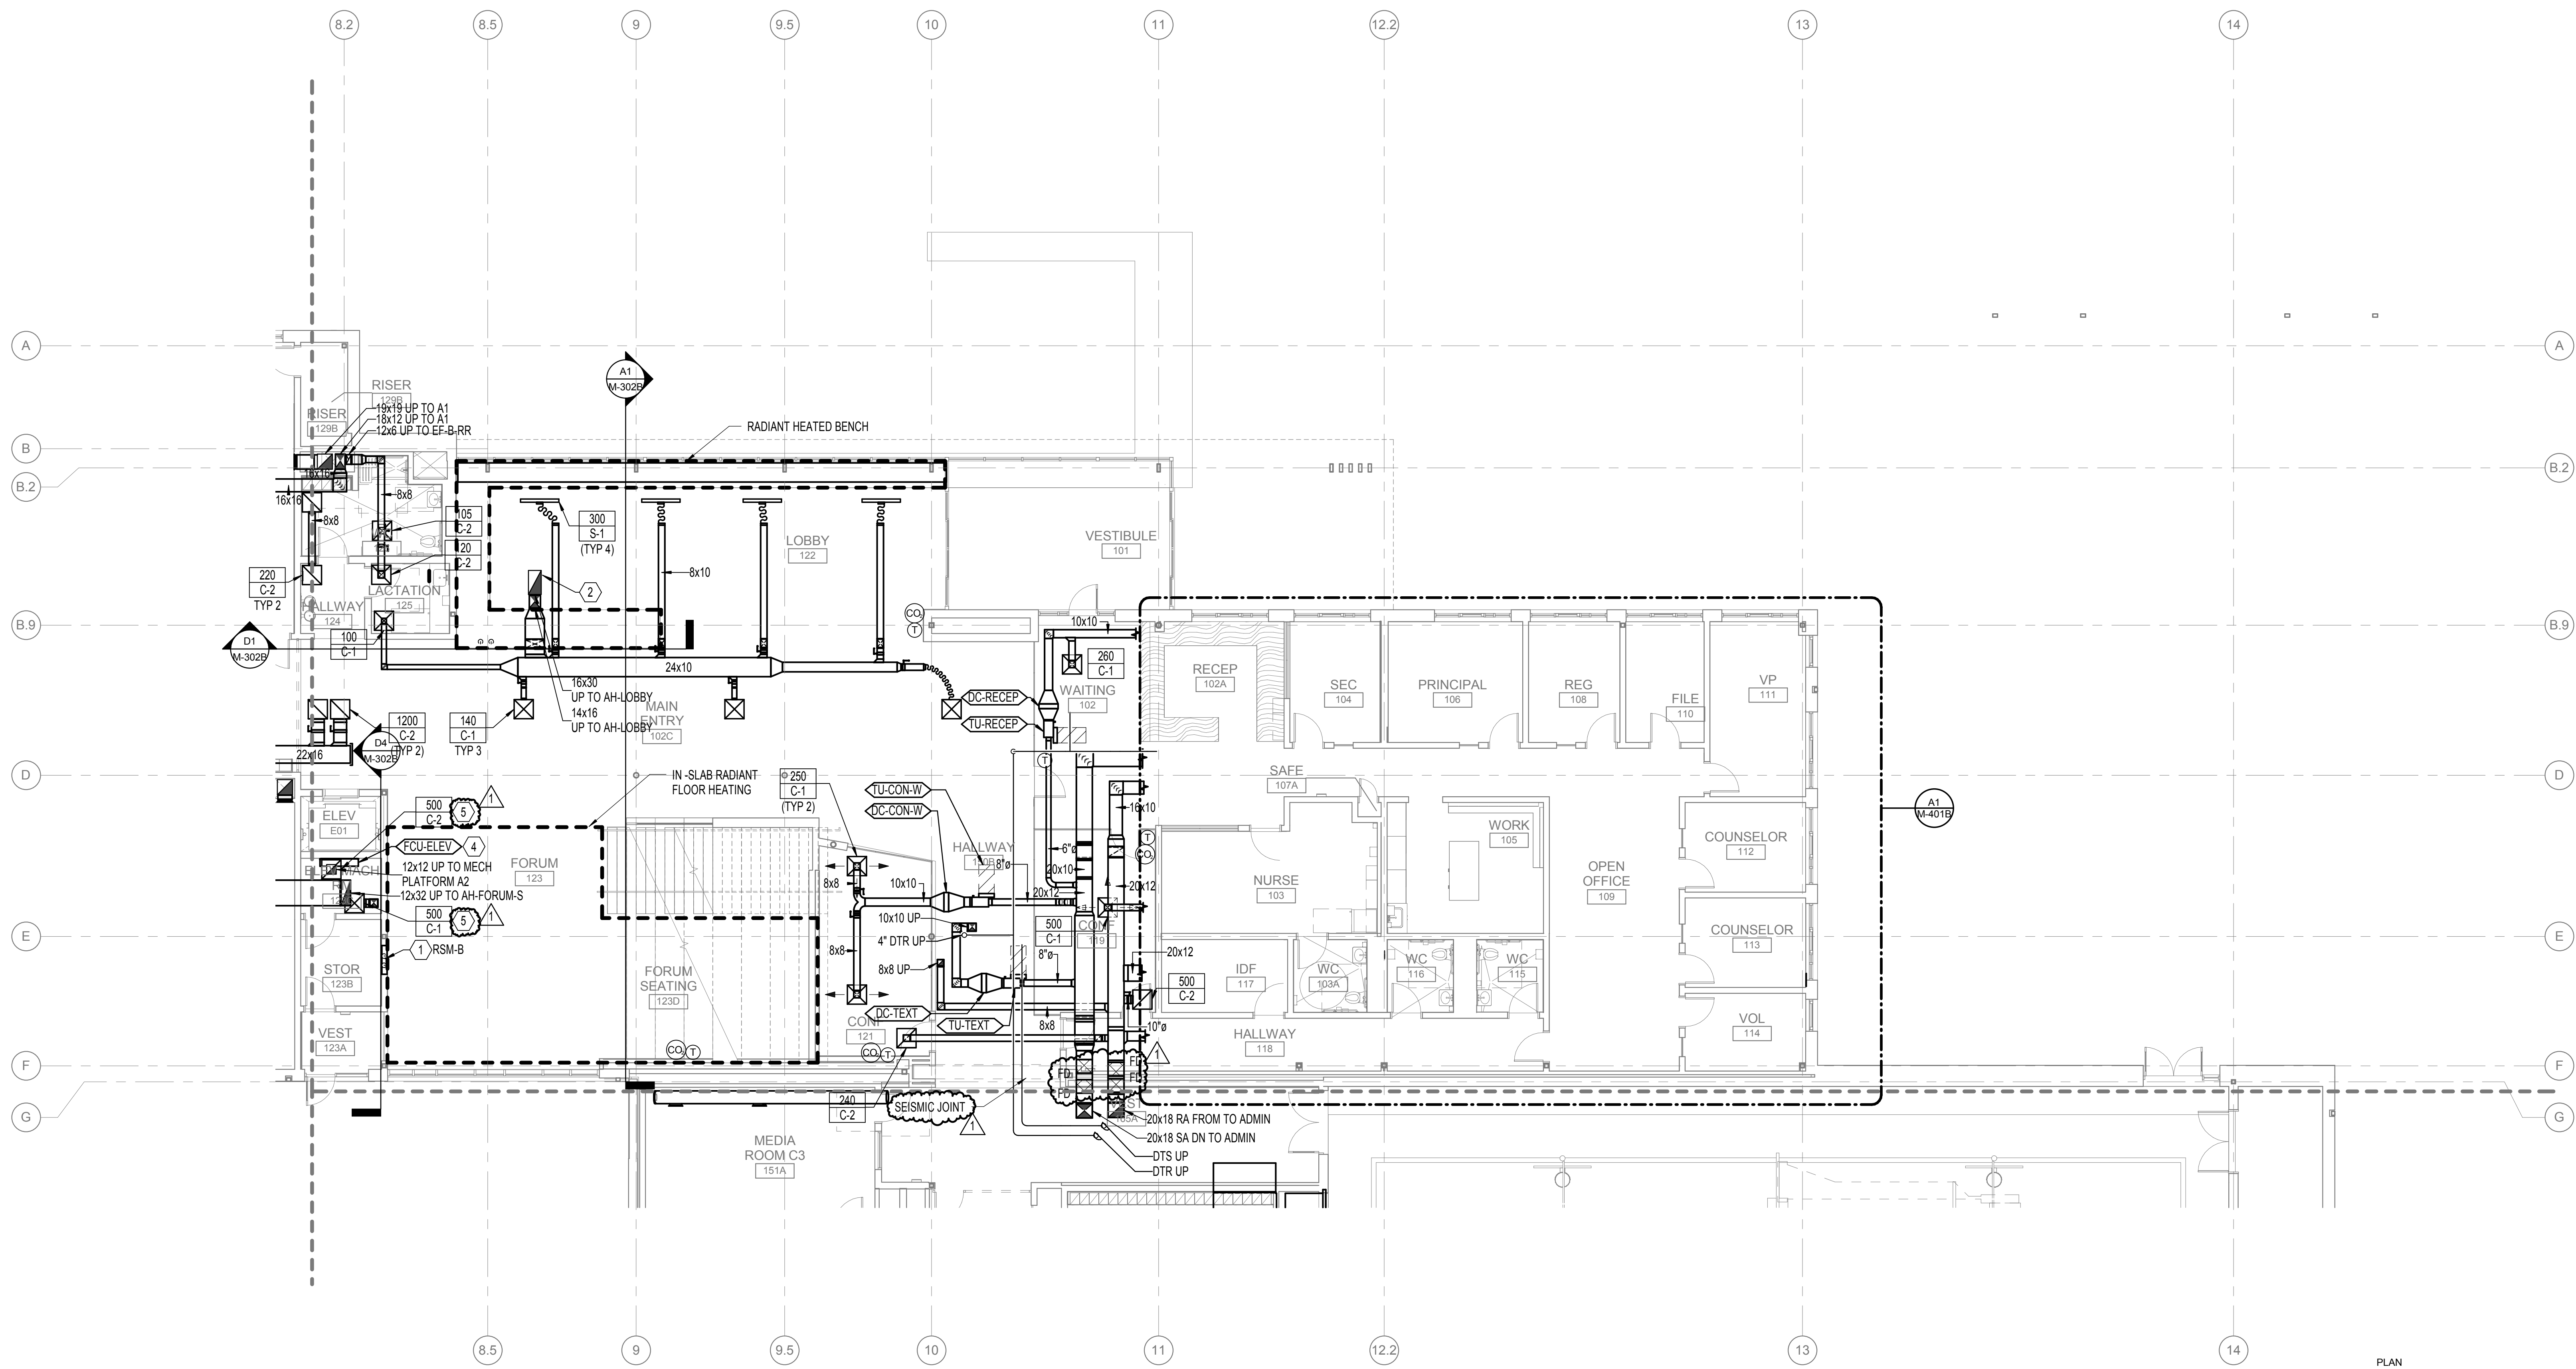

A1 FIRST FLOOR PLAN - ZONE B - MECHANICAL
1/8" = 1'-0"




MARK	DATE	DESCRIPTION
1	03-13-2015	ADDENDUM 6
ISSUE DATE: FEBRUARY 18, 2015		
ISSUE: CONSTRUCTION DOCUMENTS		
VOLUME: PACKAGE 2 VOLUME 2		
PROJECT NO.: 2013912.00		
DRAWN BY: SG		
CHECKED BY: JCY		
COPYRIGHT MAHLUM ARCHITECTS, INC. 2014 ORIGINAL SHEET SIZE: 30"x42"		

GENERAL NOTES:


- A. PROVIDE VOLUME DAMPER AT EACH BRANCH OUTLET/INLET.
- B. ALL WORK SHALL BE COORDINATED WITH ALL TRADES INVOLVED. OFFSETS IN PIPING AND DUCTS (INCLUDING DIVIDED DUCTS) AND TRANSITIONS AROUND OBSTRUCTIONS SHALL BE PROVIDED AT NO ADDITIONAL COST TO THE OWNER.
- C. VERIFY ALL EQUIPMENT CONNECTIONS WITH MANUFACTURER'S CERTIFIED DRAWINGS. VERIFY AND PROVIDE DUCT TRANSITIONS TO FURNISHED EQUIPMENT. FIELD VERIFY AND COORDINATE ALL DIMENSIONS BEFORE FABRICATION.
- D. REFER TO ARCHITECTURAL REFLECTED CEILING PLANS FOR EXACT LOCATIONS OF AIR DEVICES.
- E. ALL DETAILS APPLY TO THIS SHEET WHETHER TAGGED OR NOT.
- F. PIPING SHALL BE LARGEST SIZE SHOWN UNTIL SMALLER PIPE SIZE IS INDICATED INCLUDING MAINS AND BRANCH PIPING.

NOTES:

- 1. CONTINUES ON M-401C.
- 2. ROUTE ABOVE THROUGH TRUSS OPENINGS.
- 3. MINIMUM 18" CLEARANCE BETWEEN DUCT AND WALL.
- 4. ROUTE ABOVE BETWEEN TRUSSES.
- 5. UNDERCUT DOORS BY 1".
- 6. 4" CLOTHES DRYER EXHAUST UP IN WALL OF DUCT CHASE.

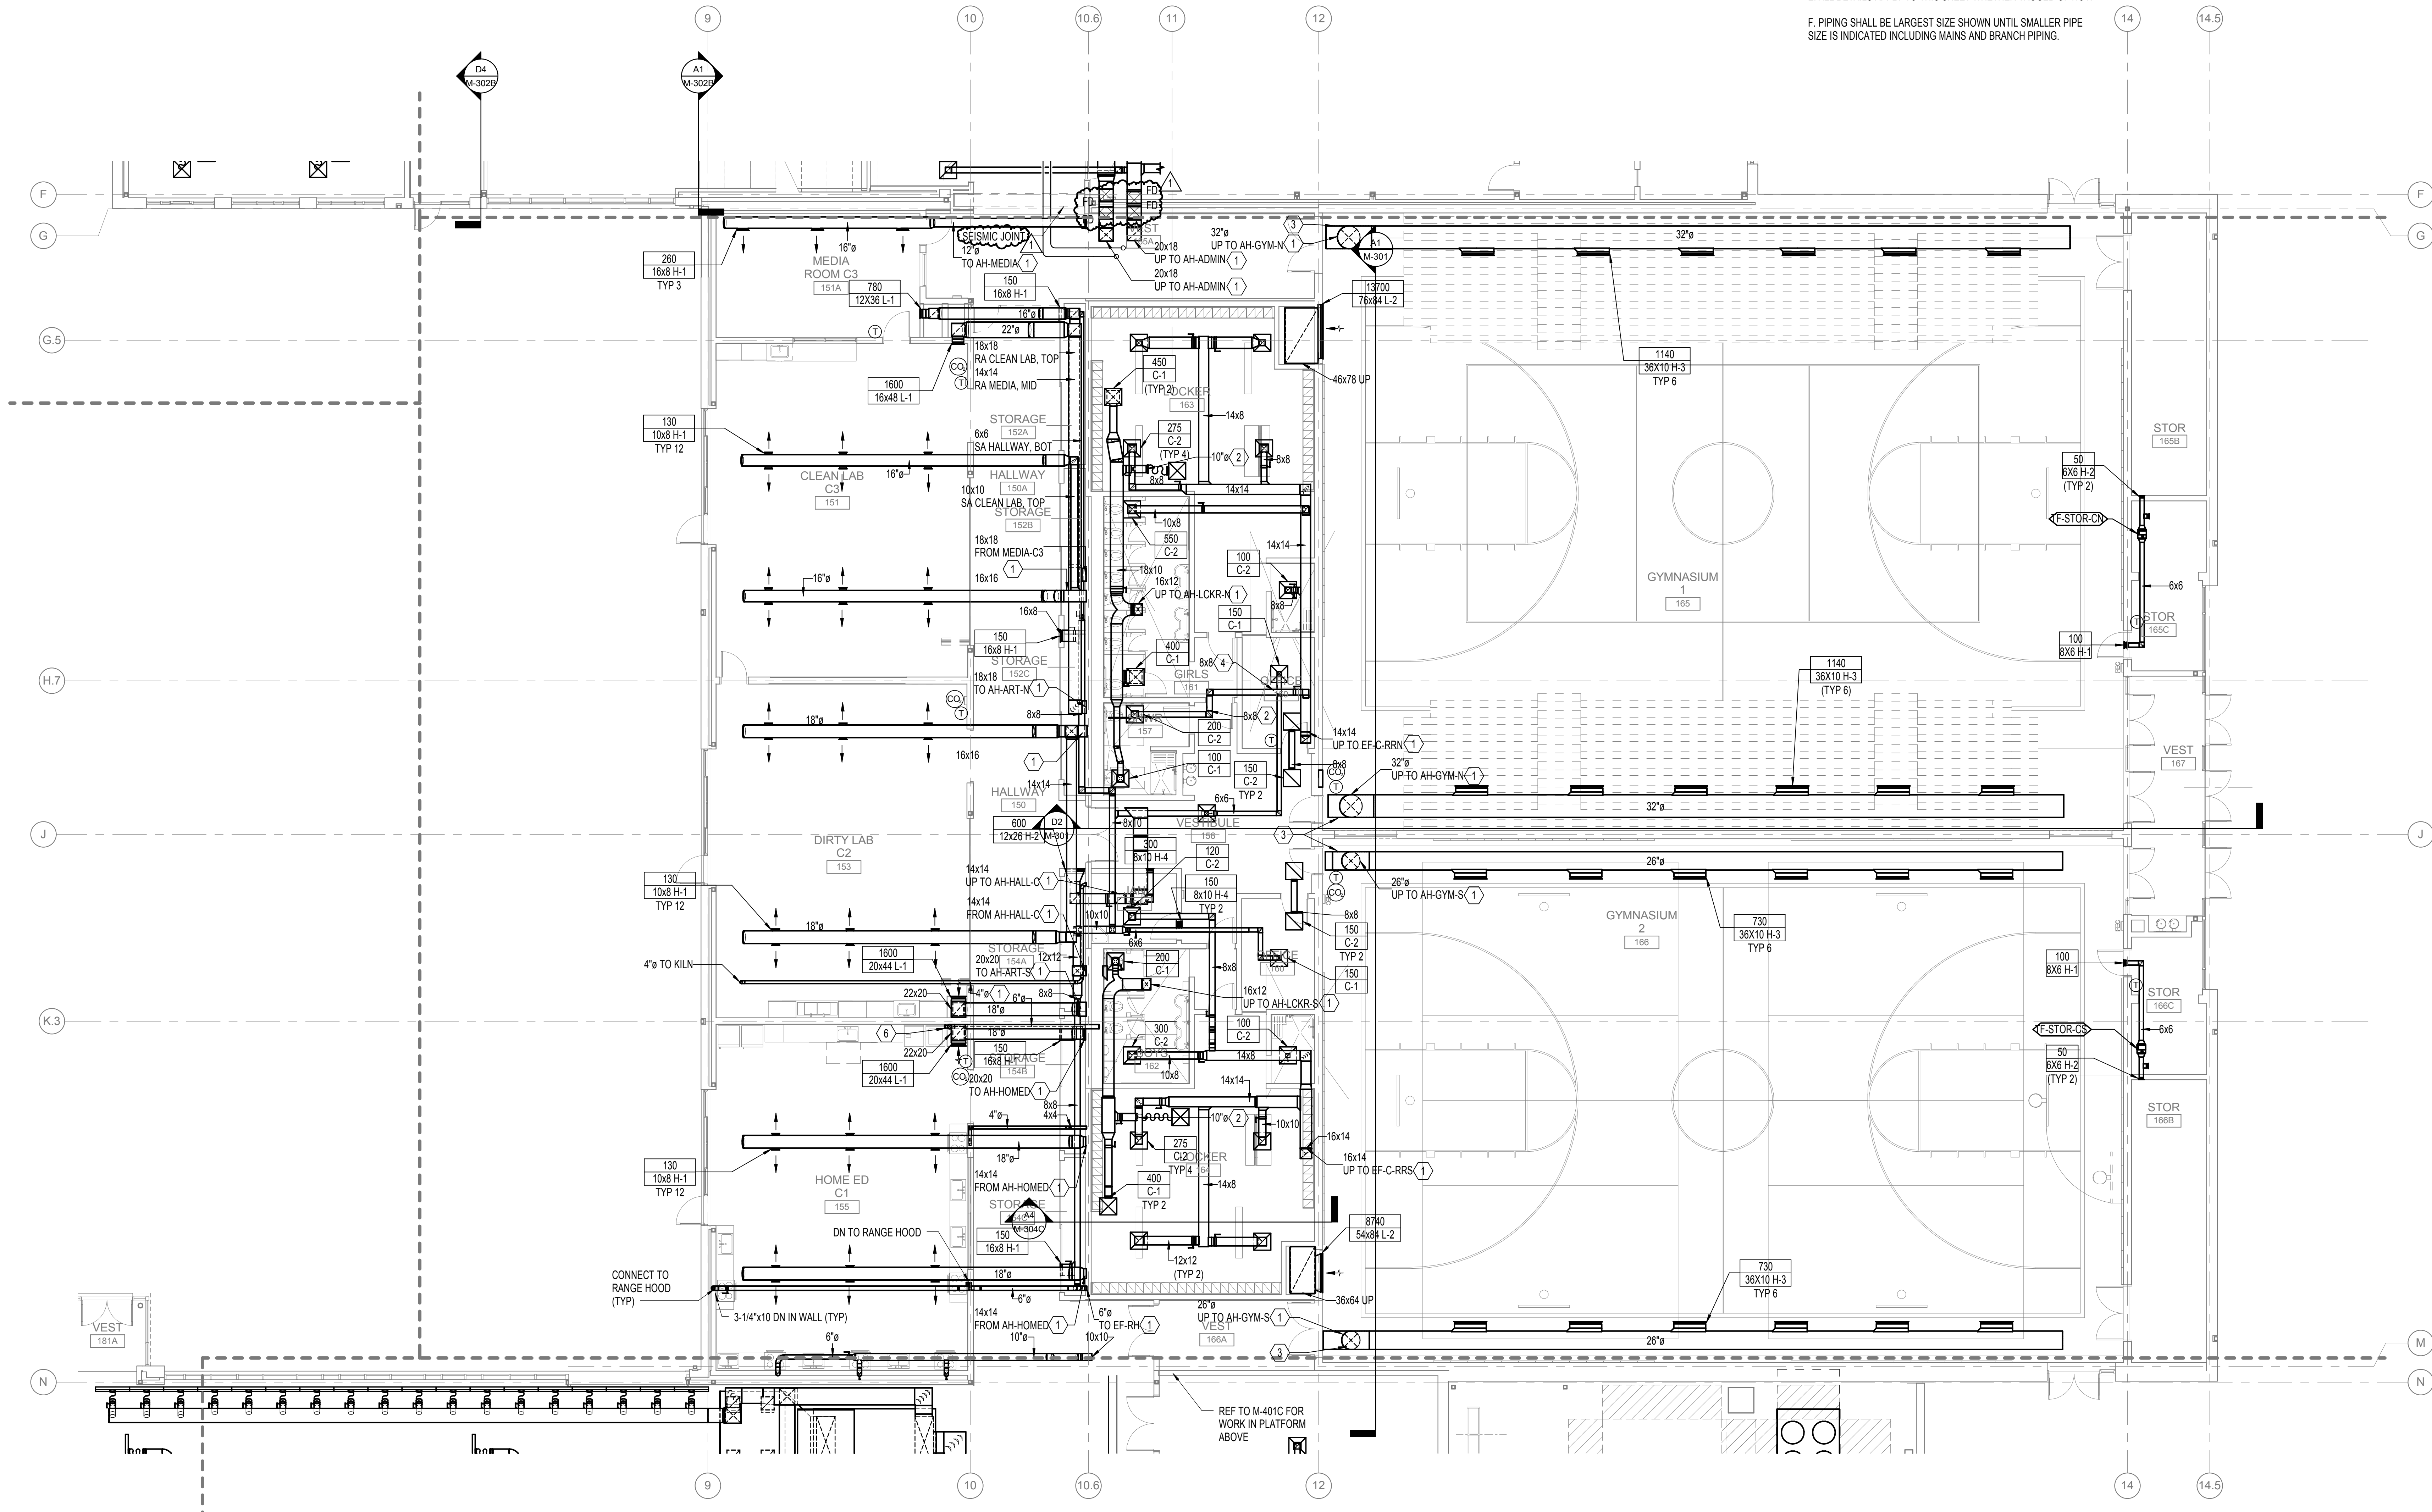

A1 FIRST FLOOR PLAN - ZONE C - MECHANICAL
1/8" = 1'-0"

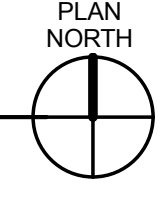



EUGENE SCHOOL DISTRICT 4J



REPLACEMENT ROOSEVELT
 MIDDLE SCHOOL
 CIP NUMBER 410.566.001
 680 EAST 24TH AVENUE
 EUGENE, OREGON 97405
 CIP NO. 410.566.001

MARK	DATE	DESCRIPTION
1	03-13-2015	ADDENDUM 6
ISSUE DATE:		FEBRUARY 18, 2015
ISSUE:		CONSTRUCTION DOCUMENTS
VOLUME:		PACKAGE 2 VOLUME 2
PROJECT NO.:		2013912.00
DRAWN BY:		SG
CHECKED BY:		JCY
COPYRIGHT MAHLUM ARCHITECTS, INC. 2014		ORIGINAL SHEET SIZE: 30"X42"

FIRST FLOOR PLAN - ZONE D - MECHANICAL


M-121D

GENERAL NOTES:

- A. PROVIDE VOLUME DAMPER AT EACH BRANCH OUTLET/INLET.
- B. ALL WORK SHALL BE COORDINATED WITH ALL TRADES INVOLVED OFFSETS IN PIPING AND DUCTS (INCLUDING DIVIDED DUCTS) AND TRANSITIONS AROUND OBSTRUCTIONS SHALL BE PROVIDED AT NO ADDITIONAL COST TO THE OWNER.
- C. VERIFY ALL EQUIPMENT CONNECTIONS WITH MANUFACTURER'S CERTIFIED DRAWINGS. VERIFY AND PROVIDE DUCT TRANSITIONS TO FURNISHED EQUIPMENT. FIELD VERIFY AND COORDINATE ALL DIMENSIONS BEFORE FABRICATION.
- D. REFER TO ARCHITECTURAL REFLECTED CEILING PLANS FOR EXACT LOCATIONS OF AIR DEVICES.
- E. ALL DETAILS APPLY TO THIS SHEET WHETHER TAGGED OR NOT.
- F. PIPING SHALL BE LARGEST SIZE SHOWN UNTIL SMALLER PIPE SIZE IS INDICATED INCLUDING MAINS AND BRANCH PIPING.

NOTES:

- 1. MOUNT ON BOTTOM OF DUCT, FACING DOWN.
- 2. ROUTE RELIEF DUCT TO ROOF VENTILATOR.
- 3. AUTO DAMPERS W/ RELIEF TO ROOF VENTILATOR AND SUPPLY TO HALL.
- 4. MIXING BOX W/ RETURN AND OSA DAMPERS.
- 5. PROVIDE HEAT TAPE ON EXPOSED CHWS/R FROM POINT WHERE PIPING DAYLIGHTS TO CHILLER CONNECTION.
- 6. OPEN ENDED DUCT TERMINATED ABOVE PERFORATED WOOD WALL PANEL. EXTERIOR AND INTERIOR TO BE PAINTED BLACK. PERFORATED WOOD PANEL TO HAVE 30 SQ. FT. FREE AREA.
- 7. 4" DRYER EXHAUST DUCT TO WALL CAP.
- 8. SEE FOOD SERVICE DRAWINGS FOR HOOD CONNECTION SIZE.
- 9. CONTINUES ON M-401D.
- 10. PROVIDE CEILING RADIATION DAMPER.

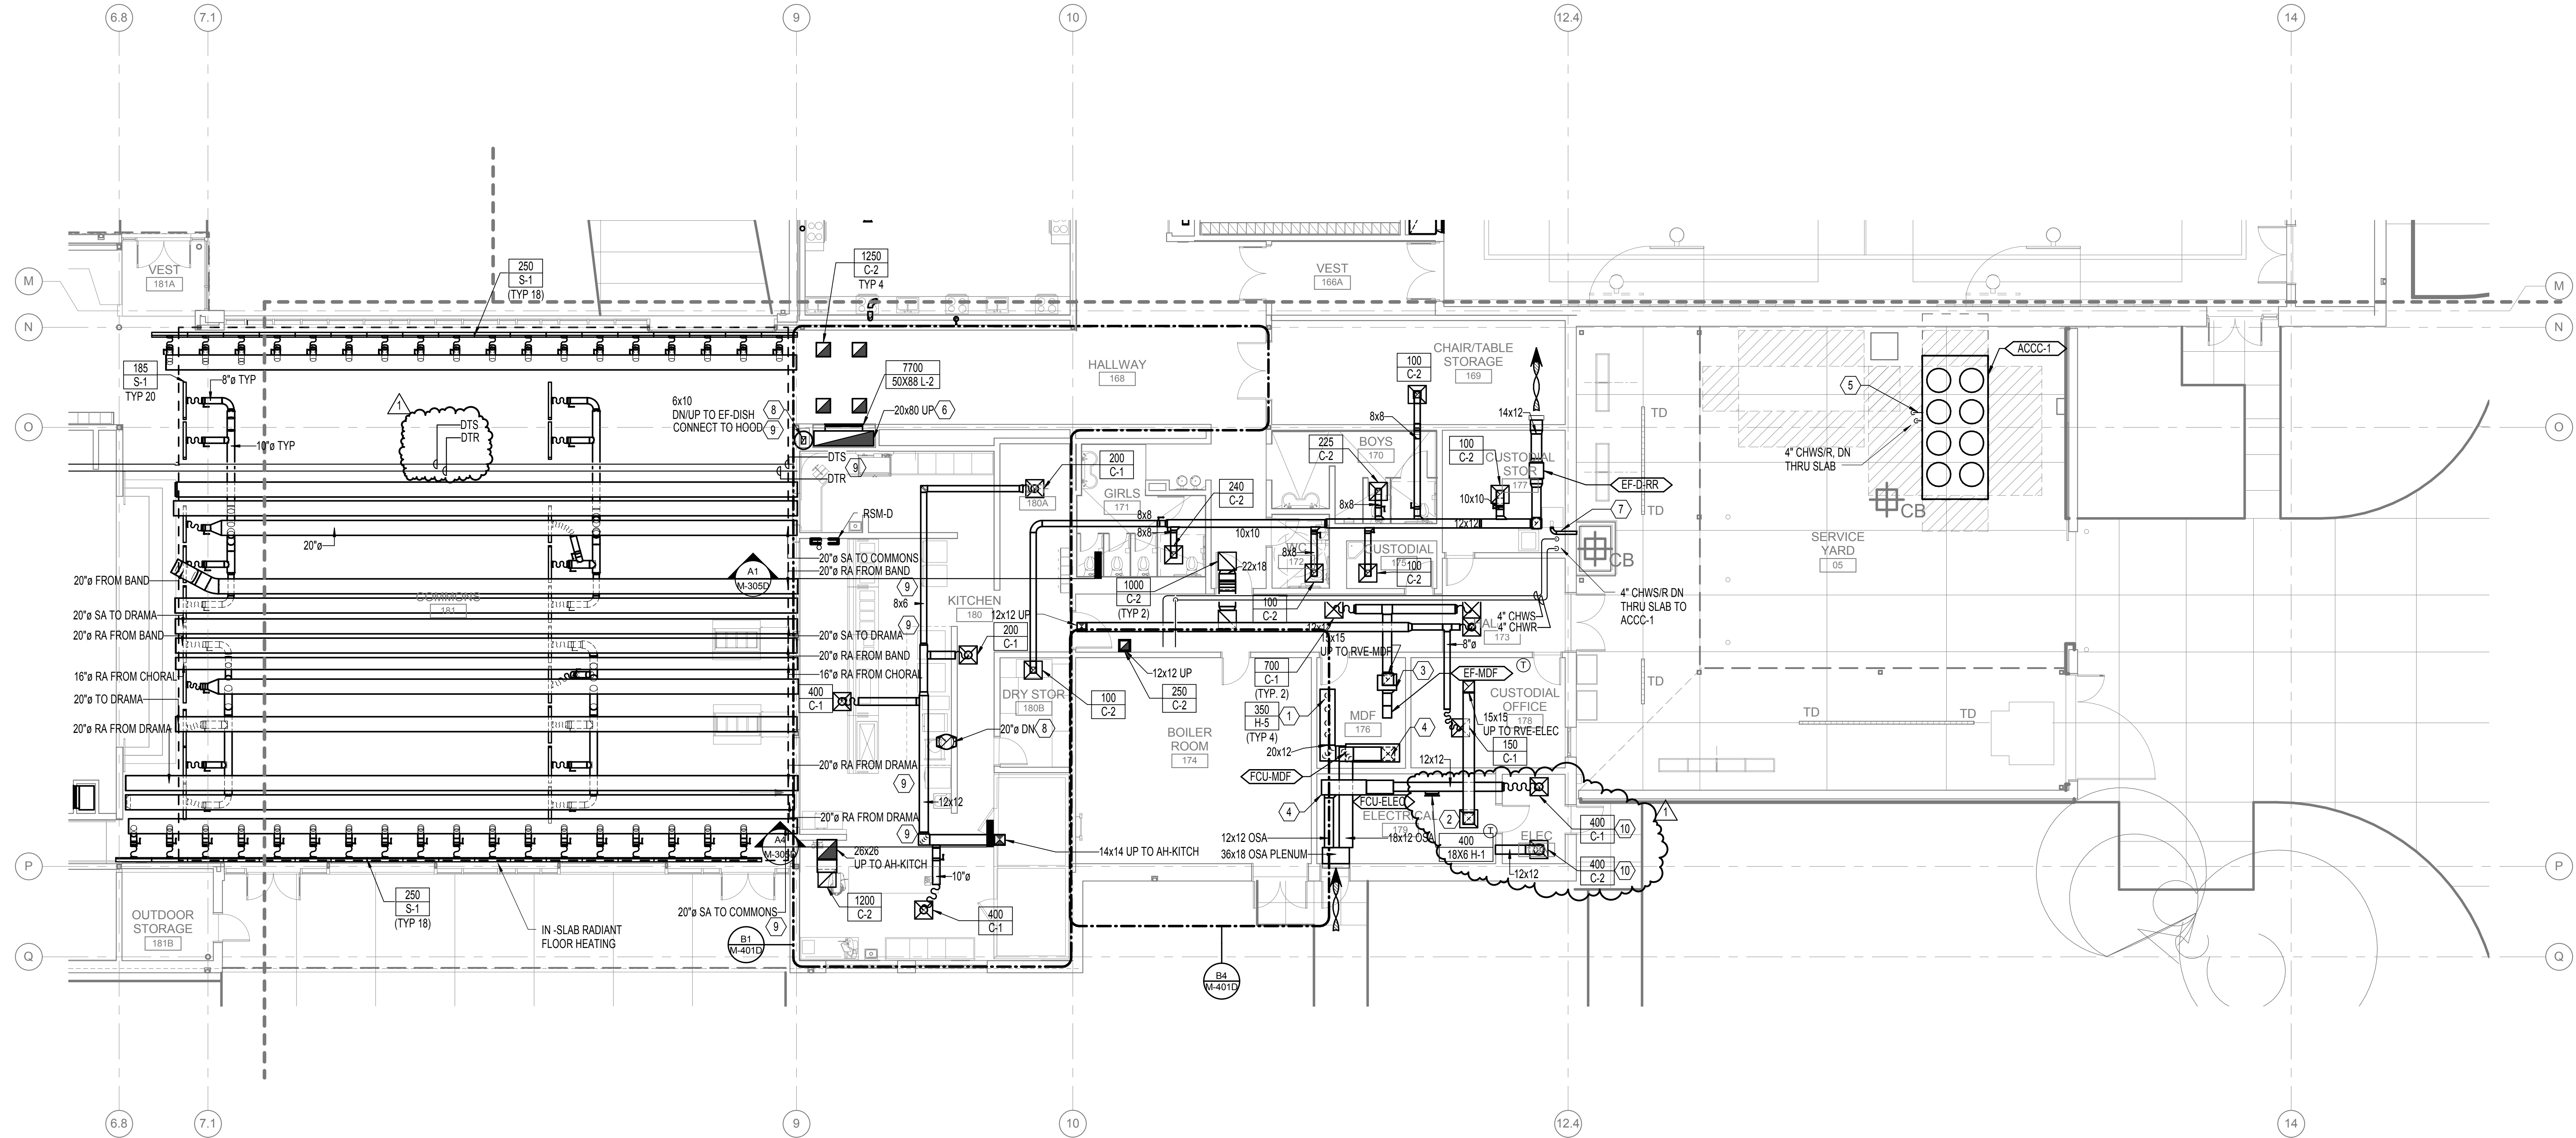


A1 FIRST FLOOR PLAN - ZONE D - MECHANICAL
 1/8" = 1'-0"

GENERAL NOTES:


A.XX

NOTES:

1. RELIEF DAMPER.
2. OPEN-ENDED RETURN DUCT ABOVE CEILING.
3. ROUTE ABOVE THROUGH TRUSS OPENINGS. COORDINATE W/ CMU SHEAR WALL PENETRATIONS AT COMMONS-DRAMA & CHORAL-BAND.
4. ROUTE ABOVE, BETWEEN TRUSSES.
5. SIDEWALL RELIEF GRILL TO BE MOUNTED 10" 6" AFF.
6. COORDINATE W/ STRUCTURAL PENETRATION, CONTINUED ON A4/M-401E.
7. NOT USED.
8. NOT USED.
9. CONNECT CONDENSATE DRAIN TO TRIPPIECE OF SINK.

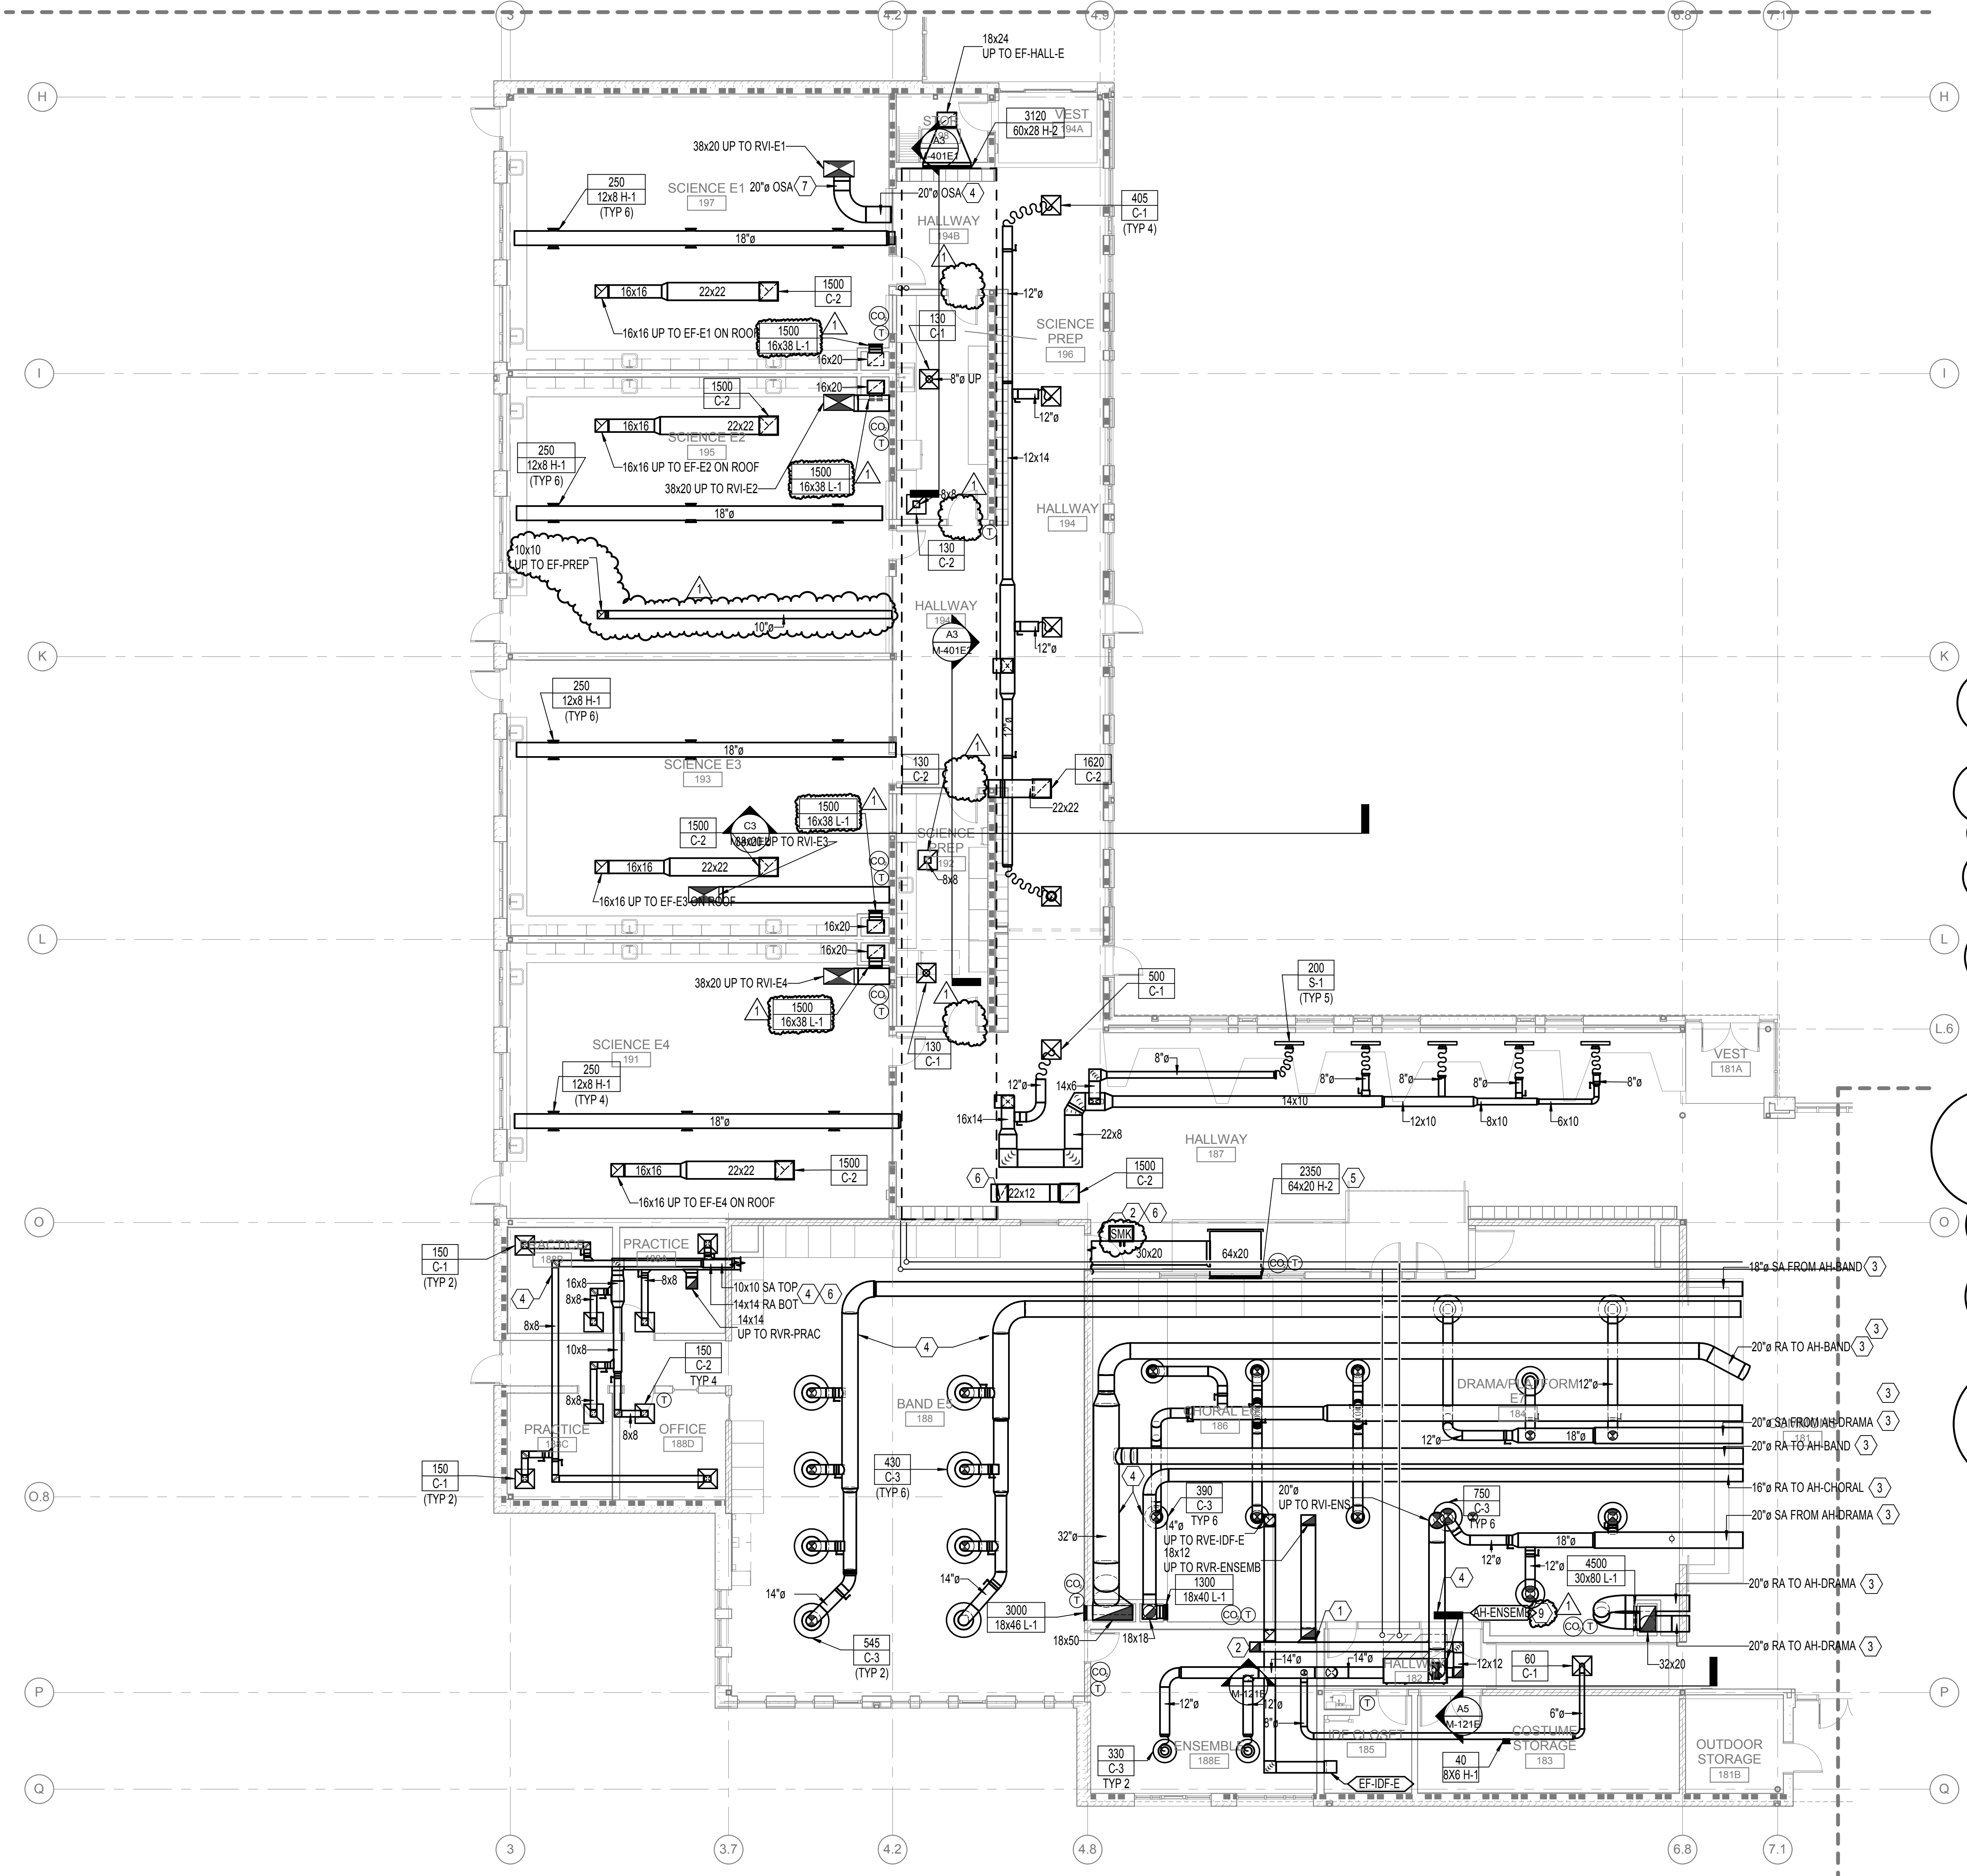

A1 FIRST FLOOR PLAN - ZONE E - MECHANICAL
1/8" = 1'-0"

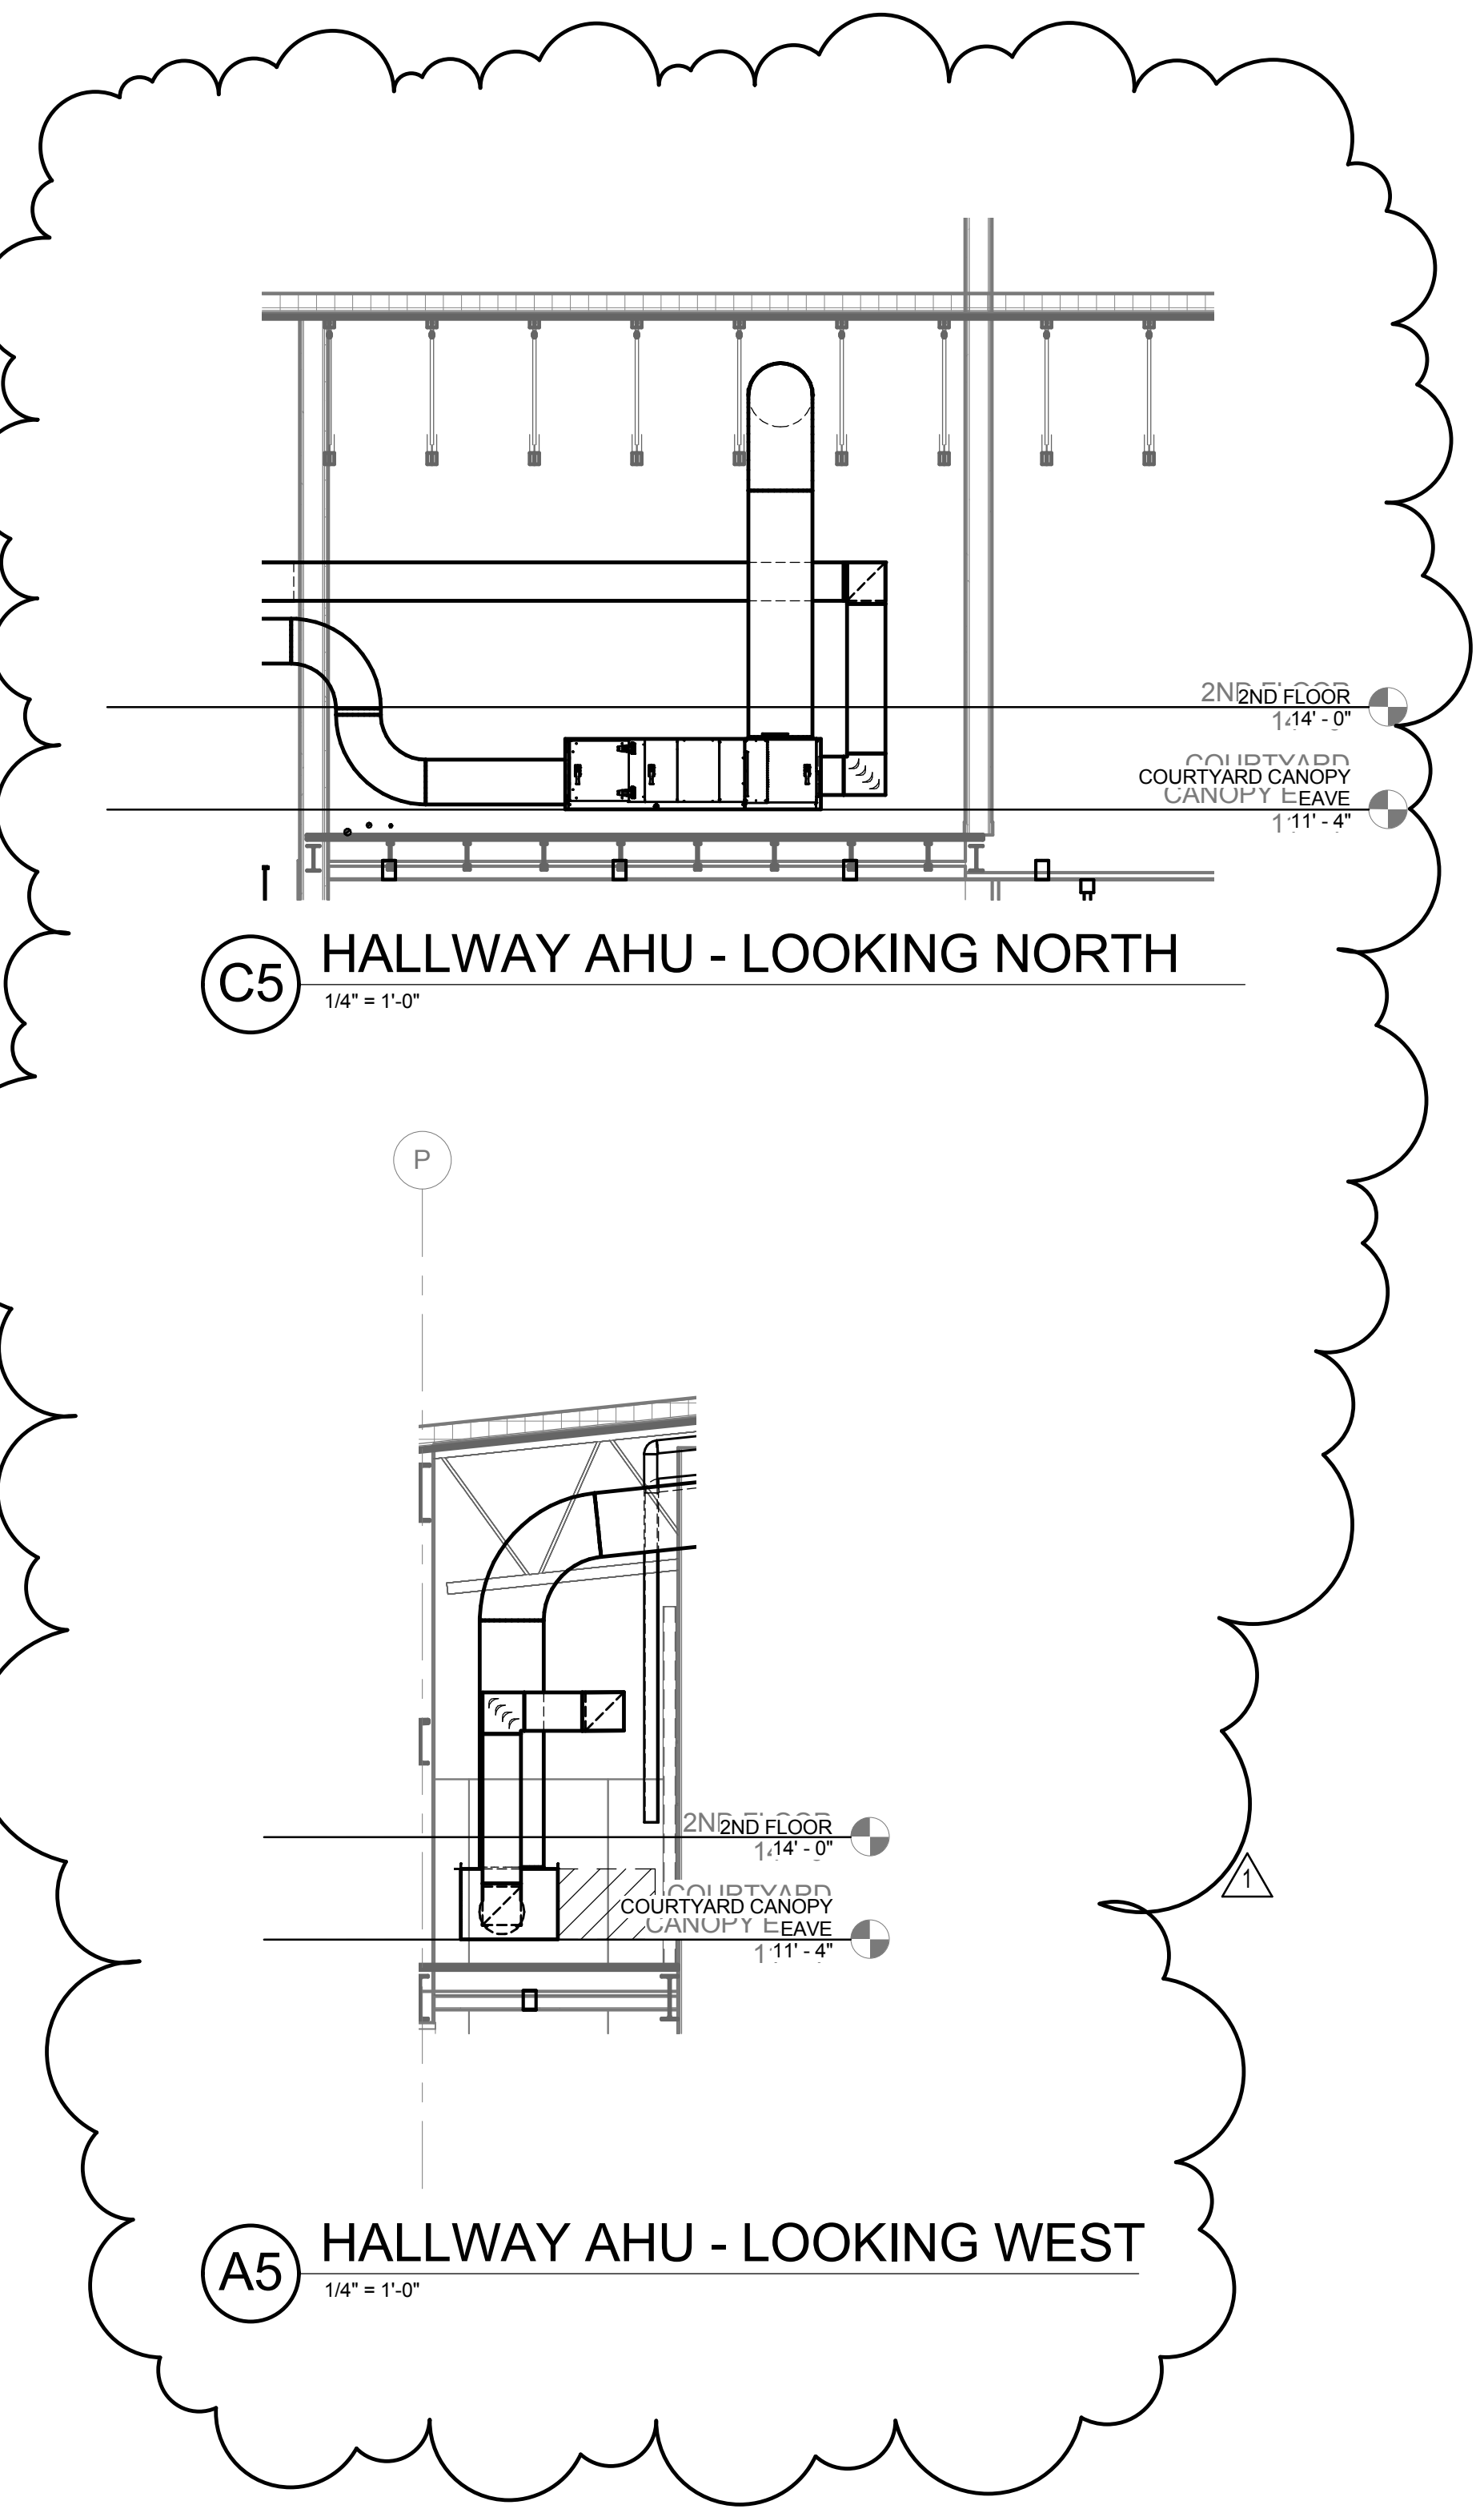

C5 HALLWAY AHU - LOOKING NORTH
1/4" = 1'-0"

A5 HALLWAY AHU - LOOKING WEST
1/4" = 1'-0"




GENERAL NOTES:

- A. PROVIDE VOLUME DAMPER AT EACH BRANCH OUTLET/INLET.
- B. ALL WORK SHALL BE COORDINATED WITH ALL TRADES INVOLVED OFFSETS IN PIPING AND DUCTS (INCLUDING DIVIDED DUCTS) AND TRANSITIONS AROUND OBSTRUCTIONS SHALL BE PROVIDED AT NO ADDITIONAL COST TO THE OWNER.
- C. VERIFY ALL EQUIPMENT CONNECTIONS WITH MANUFACTURER'S CERTIFIED DRAWINGS. VERIFY AND PROVIDE DUCT TRANSITIONS TO FURNISHED EQUIPMENT. FIELD VERIFY AND COORDINATE ALL DIMENSIONS BEFORE FABRICATION.
- D. REFER TO ARCHITECTURAL REFLECTED CEILING PLANS FOR EXACT LOCATIONS OF AIR DEVICES.
- E. ALL DETAILS APPLY TO THIS SHEET WHETHER TAGGED OR NOT.
- F. PIPING SHALL BE LARGEST SIZE SHOWN UNTIL SMALLER PIPE SIZE IS INDICATED INCLUDING MAINS AND BRANCH PIPING.

NOTES:

- 1. MOUNT NOZZLE GRILLE ON BOTTOM OF DUCT. COORDINATE LENGTH OF DUCT AND GRILLE SPACING WITH OWNER.
- 2. MIXING BOX W/ 12X12 OSAD AND RAD. 12X12 OSA UP TO MECH PLATFORM.
- 3. RELIEF DAMPER W/ 12X12 UP TO MECH PLATFORM. SAD TO HALLWAY.

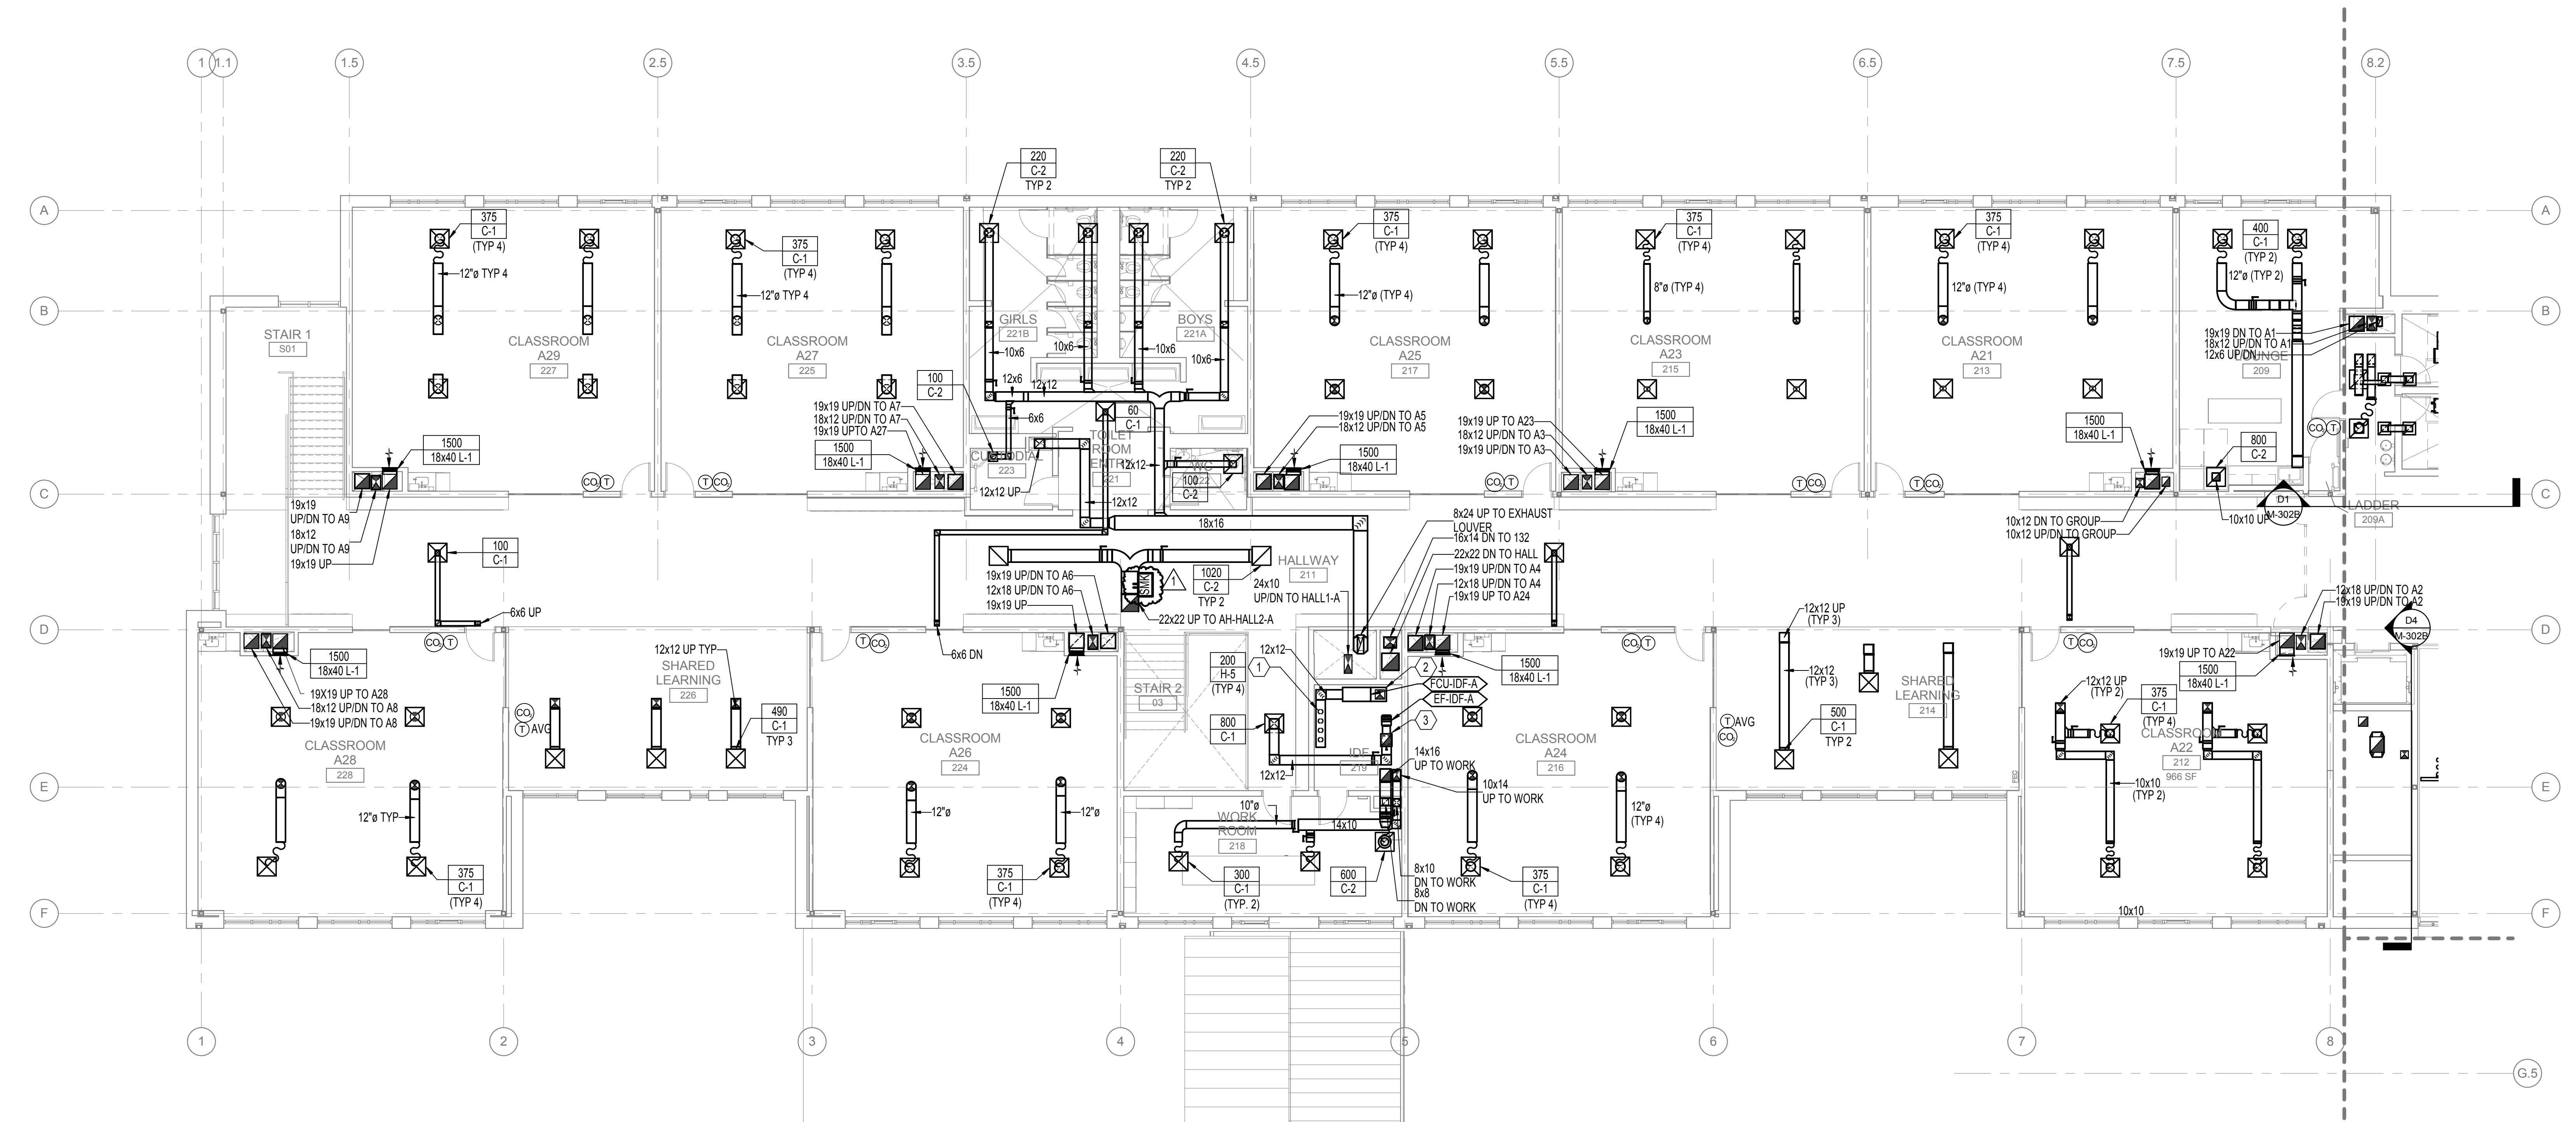

A1 SECOND FLOOR PLAN - ZONE A - MECHANICAL
1/8" = 1'-0"



MARK	DATE	DESCRIPTION
1	03-13-2015	ADDENDUM 6

ISSUE DATE:	FEBRUARY 18, 2015
ISSUE:	CONSTRUCTION DOCUMENTS
VOLUME:	PACKAGE 2 VOLUME 2
PROJECT NO.:	2013912.00
DRAWN BY:	SG
CHECKED BY:	JCY
COPYRIGHT MAHLUM ARCHITECTS, INC. 2014 ORIGINAL SHEET SIZE: 30"x42"	

SECOND FLOOR PLAN - ZONE A - MECHANICAL

M-122A

MARK	DATE	DESCRIPTION
2	03-13-2015	ADDENDUM 6
1	2-27-2015	ADDENDUM 1

ISSUE DATE: FEBRUARY 18, 2015
ISSUE: CONSTRUCTION DOCUMENTS
VOLUME: PACKAGE 2 VOLUME 2

PROJECT NO: 2013912.00
DRAWN BY: SG
CHECKED BY: JCY


MECHANICAL EQUIPMENT PLATFORM PLAN - ZONE A WEST - MECHANICAL

GENERAL NOTES:

- A. PROVIDE VOLUME DAMPER AT EACH BRANCH OUTLET/INLET.
- B. ALL WORK SHALL BE COORDINATED WITH ALL TRADES INVOLVED. OFFSETS IN PIPING AND DUCTS (INCLUDING DIVIDED DUCTS) AND TRANSITIONS AROUND OBSTRUCTIONS SHALL BE PROVIDED AT NO ADDITIONAL COST TO THE OWNER.
- C. VERIFY ALL EQUIPMENT CONNECTIONS WITH MANUFACTURER'S CERTIFIED DRAWINGS. VERIFY AND PROVIDE DUCT TRANSITIONS TO FURNISHED EQUIPMENT. FIELD VERIFY AND COORDINATE ALL DIMENSIONS BEFORE FABRICATION.
- D. REFER TO ARCHITECTURAL REFLECTED CEILING PLANS FOR EXACT LOCATIONS OF AIR DEVICES.
- E. ALL DETAILS APPLY TO THIS SHEET WHETHER TAGGED OR NOT.
- F. PIPING SHALL BE LARGEST SIZE SHOWN UNTIL SMALLER PIPE SIZE IS INDICATED INCLUDING MAINS AND BRANCH PIPING.
- G. PROVIDE CONDENSATE DRAIN PIPING FROM AH UNITS TO NEAREST FLOOR SINK.
- H. ARRANGE EQUIPMENT, PIPING, AND DUCTWORK TO MAINTAIN A 3 FOOT WIDE MAINTENANCE PARTH THRU MECH PLATFORM WITH MIN 8" HEAD CLEARANCE.

NOTES:

1. PROVIDE AUTOMATIC CONTROL DAMPER AND BDD, SIZE FOR 400 FPM.
2. CONTINUED ON M-122A.
3. OSA LOUVER 18.75 SQ. FT. FREE AREA.
4. RELIEF LOUVER 40 SQ. FT. FREE AREA.
5. OSA LOUVER 10.75 SQ. FT. FREE AREA.
6. AUTOMATIC CONTROL DAMPER AT THIS APPROX LOCATION.
7. EXHAUST LOUVER 5 SQ. FT. FREE AREA.
8. DUCT AND PLENUM TO BE ACOUSTICALLY LINED.
9. RF-A TO BE SPRING ISOLATED AND HUNG FROM CEILING.

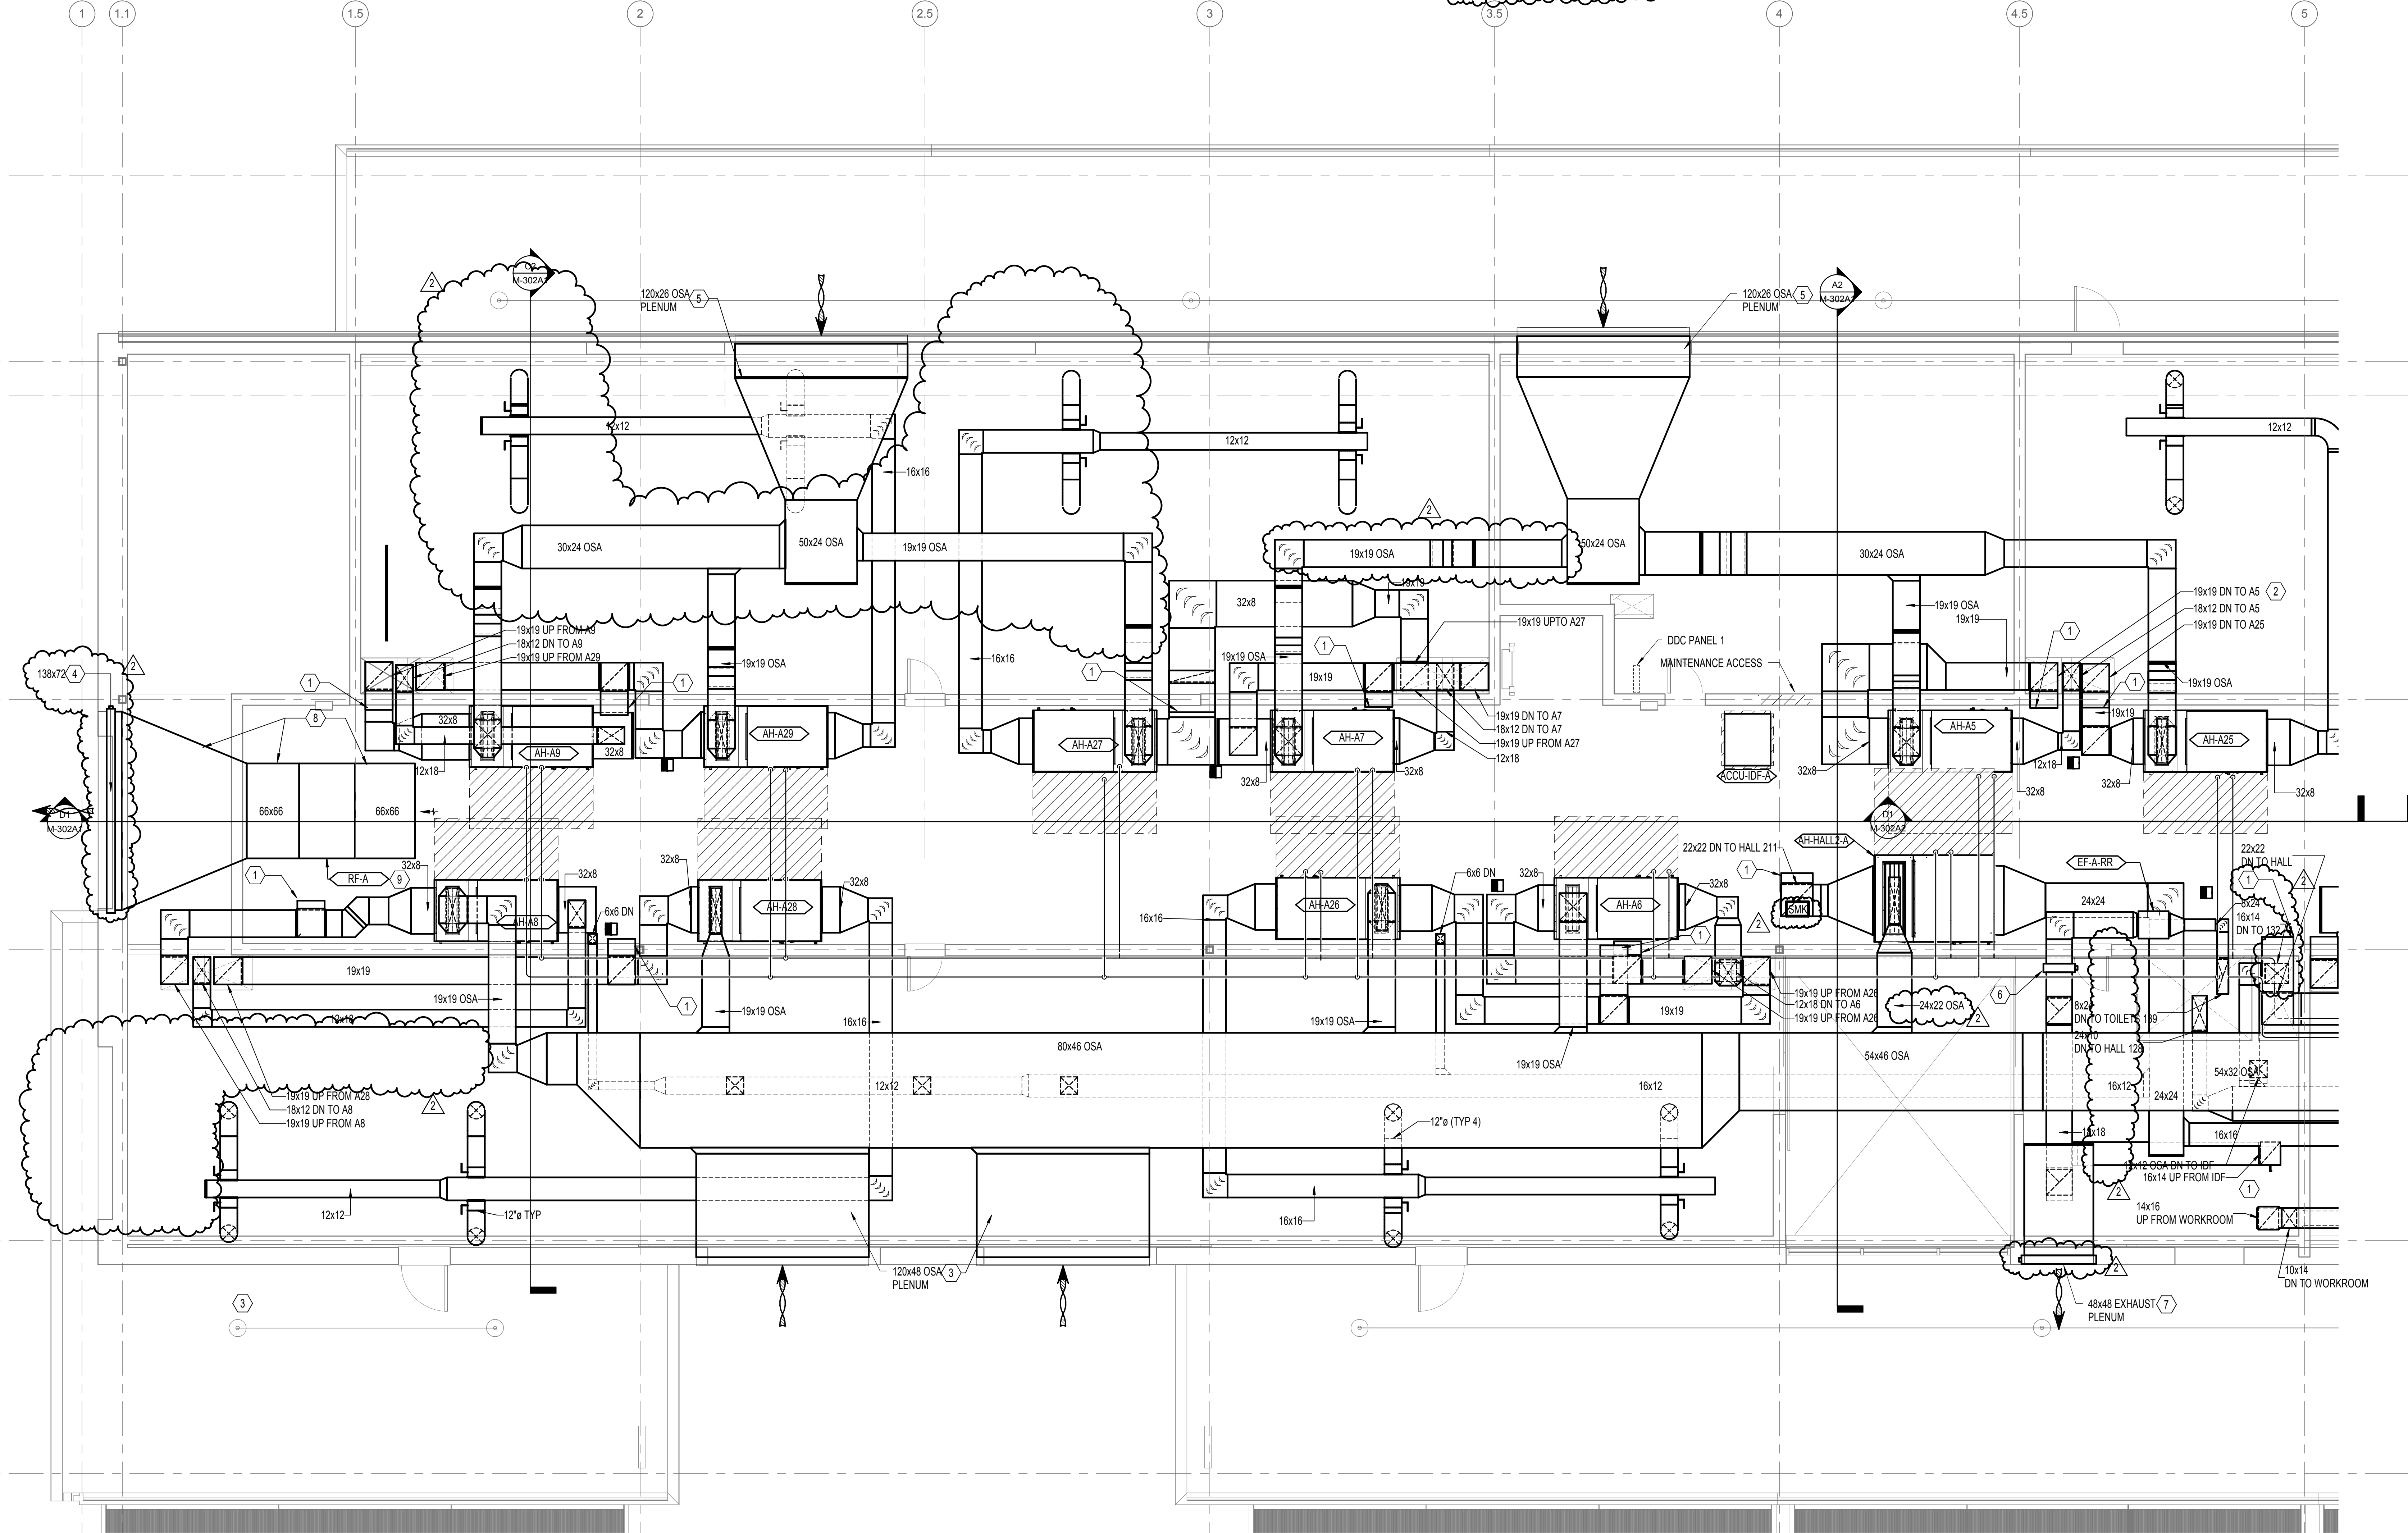

A1 MECHANICAL EQUIPMENT PLATFORM PLAN - ZONE A WEST- MECHANICAL
1/4" = 1'-0"




3/10/2015 4:42 PM C:\p\Local Files\3-108-MEP\4-CENTRAL_Lam\meh1A1

GENERAL NOTES:

- A. PROVIDE VOLUME DAMPER AT EACH BRANCH OUTLET/INLET.
- B. ALL WORK SHALL BE COORDINATED WITH ALL TRADES INVOLVED. OFFSETS IN PIPING AND DUCTS (INCLUDING DIVIDED DUCTS) AND TRANSITIONS AROUND OBSTRUCTIONS SHALL BE PROVIDED AT NO ADDITIONAL COST TO THE OWNER.
- C. VERIFY ALL EQUIPMENT CONNECTIONS WITH MANUFACTURER'S CERTIFIED DRAWINGS. VERIFY AND PROVIDE DUCT TRANSITIONS TO FURNISHED EQUIPMENT. FIELD VERIFY AND COORDINATE ALL DIMENSIONS BEFORE FABRICATION.
- D. REFER TO ARCHITECTURAL REFLECTED CEILING PLANS FOR EXACT LOCATIONS OF AIR DEVICES.
- E. ALL DETAILS APPLY TO THIS SHEET WHETHER TAGGED OR NOT.
- F. PIPING SHALL BE LARGEST SIZE SHOWN UNTIL SMALLER PIPE SIZE IS INDICATED INCLUDING MAINS AND BRANCH PIPING.
- G. PROVIDE CONDENSATE DRAIN PIPING FROM AIR HANDLERS TO NEAREST FLOOR SINK. DO NOT BLOCK WALKING PATH.
- H. ARRANGE EQUIPMENT, PIPING, AND DUCTWORK TO MAINTAIN A 3 FOOT WIDE MAINTENANCE PATH THRU MECH PLATFORM WITH MIN 6' 8" HEAD CLEARANCE.

NOTES:

- 1. COORDINATE THROUGH TRUSS OPENINGS.
- 2. PROVIDE AUTOMATIC RELIEF DAMPER AND BDD, SIZE FOR 400 FPM.
- 3. CONTINUES ON M-122B.
- 4. ROUTE ABOVE, BETWEEN JOISTS.
- 5. MINIMUM 6' 8" AFF FOR MAINTENANCE ACCESS, TYP. TO ALL EQUIPMENT.
- 6. OSA LOUVER 18.75 SQ. FT. FREE AREA.
- 7. CONTINUES ON M-121A.
- 8. OSA LOUVER 10.75 SQ. FT. FREE AREA.
- 9. AUTOMATIC CONTROL DAMPER AT THIS APPROX LOCATION.
- 10. EXHAUST LOUVER 5 SQ. FT. FREE AREA.

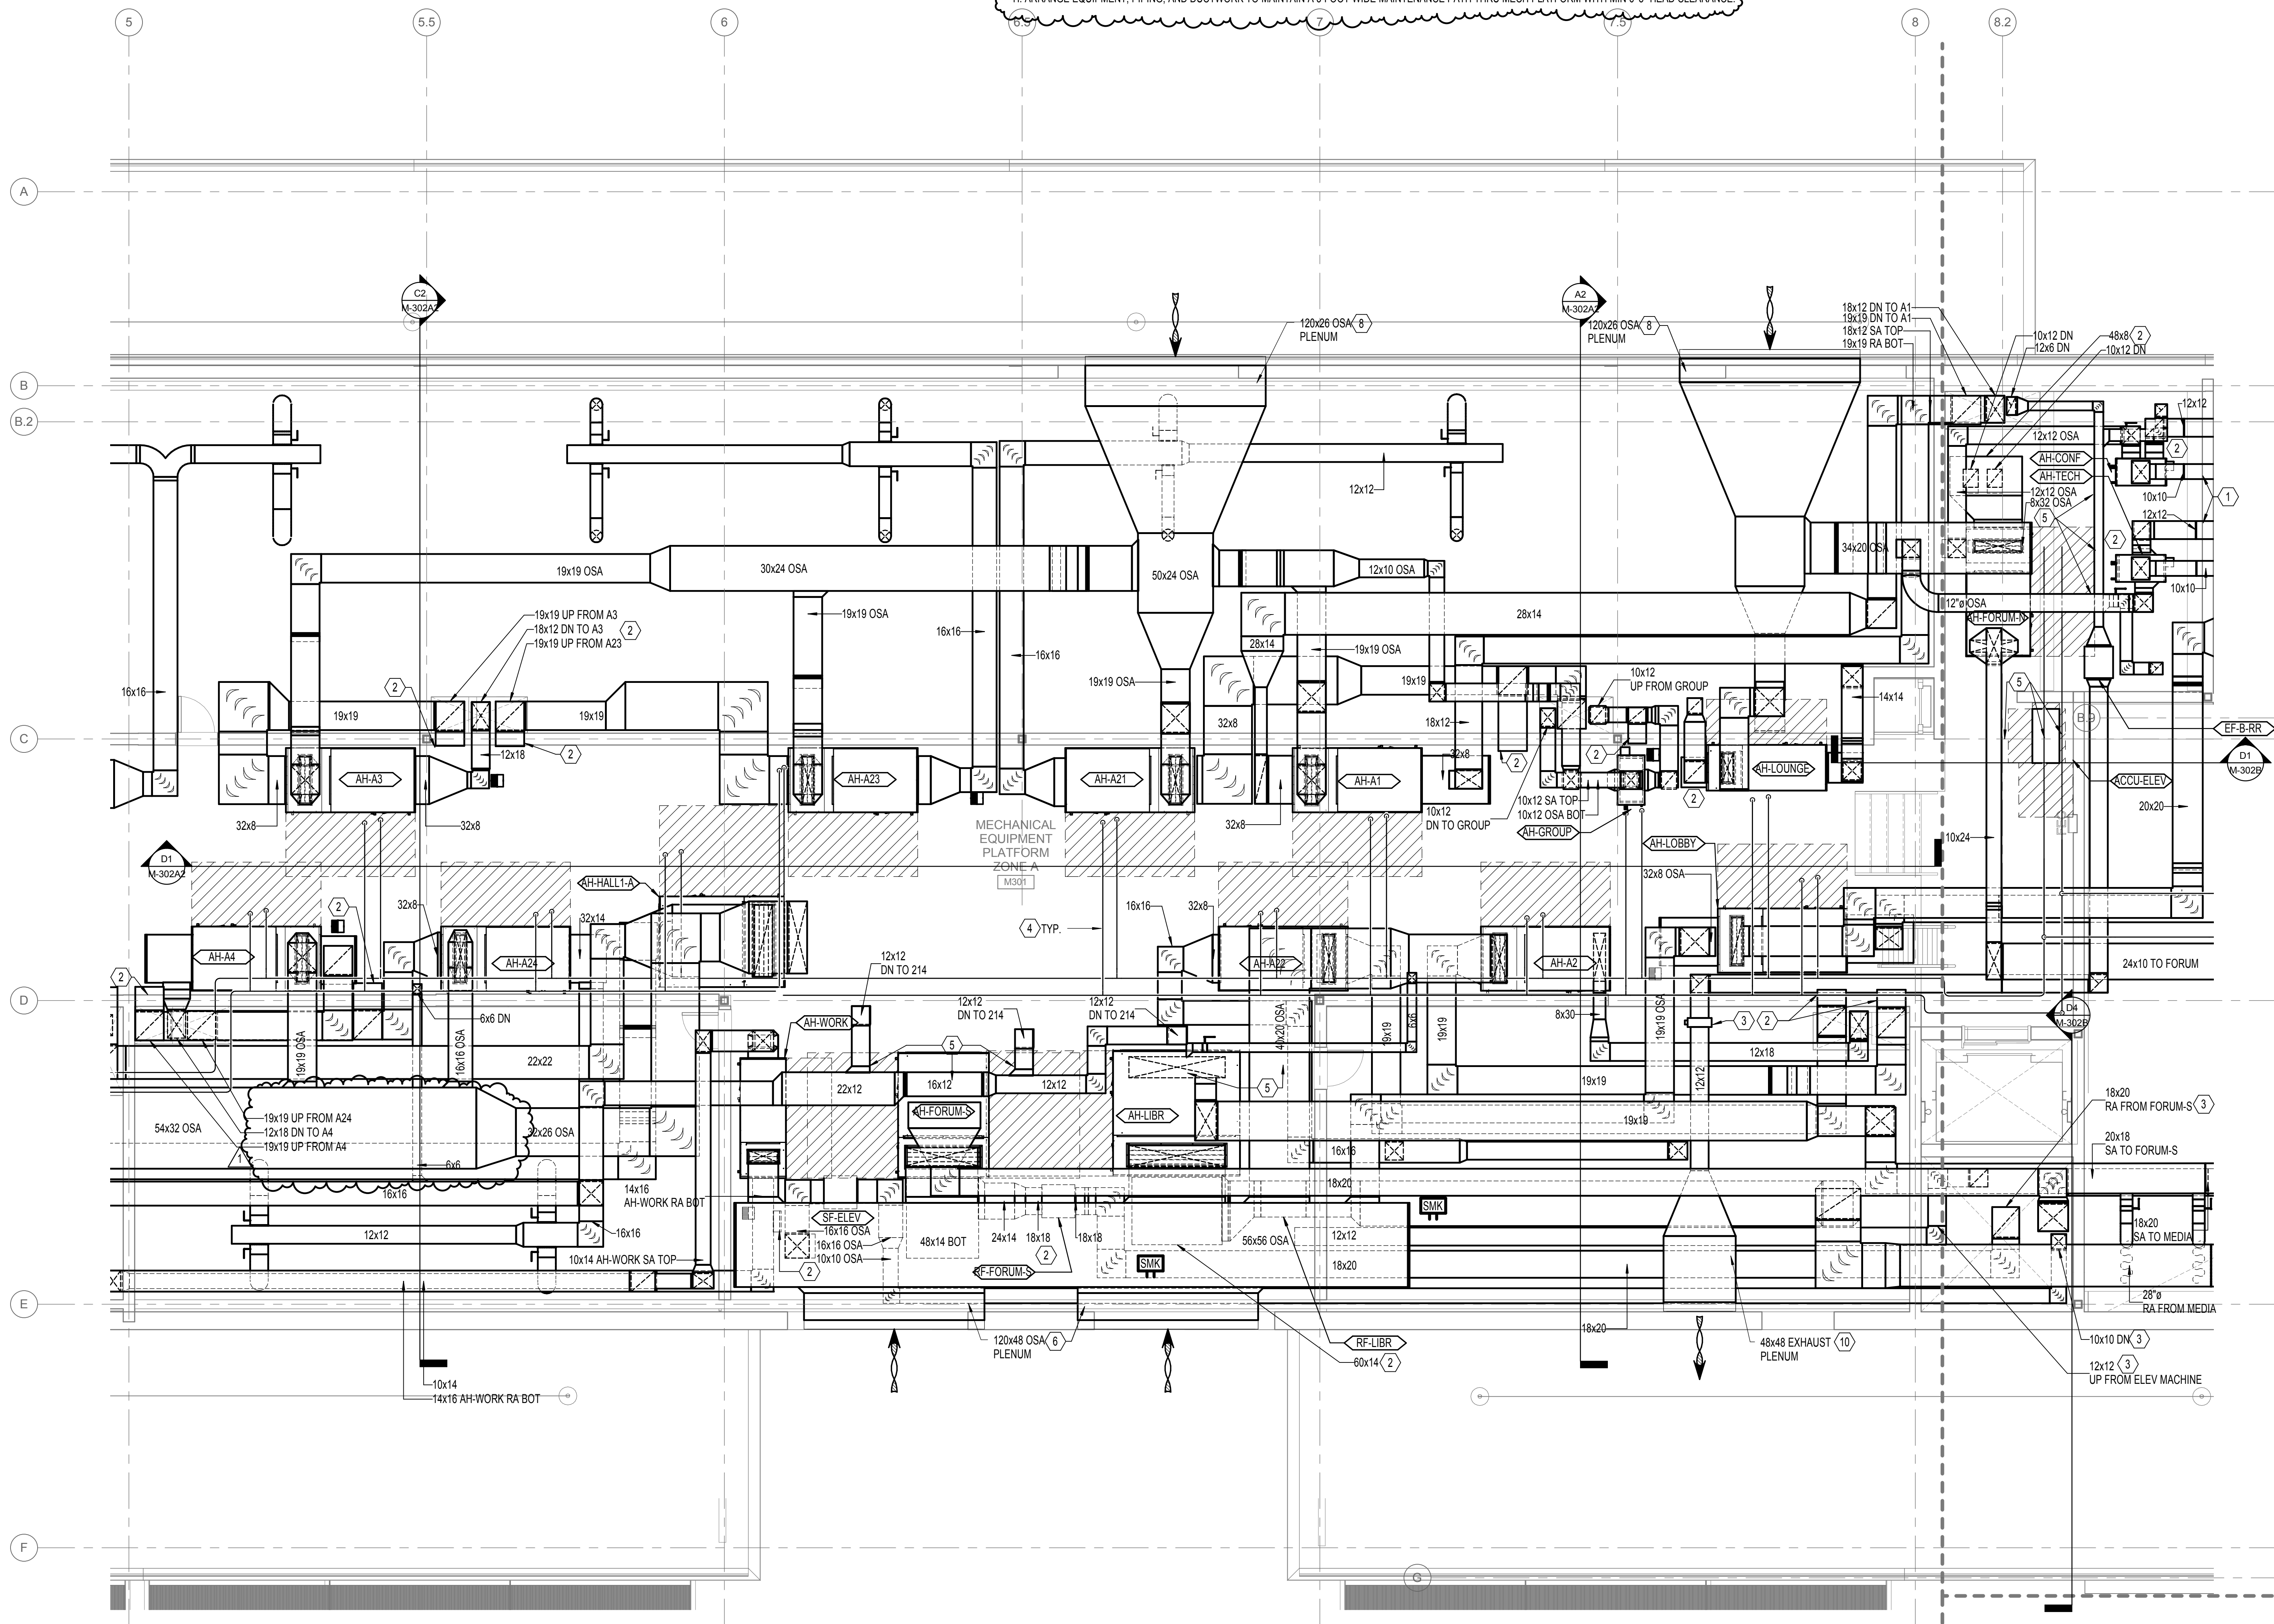

A1 MECHANICAL EQUIPMENT PLATFORM PLAN - ZONE A EAST - MECHANICAL
1/4" = 1'-0"

mahlum
ROBERTSON/SHERWOOD ARCHITECTS PC
132 EAST BROADWAY, SUITE 540
EUGENE, OREGON 97401
541-342-8077
www.robertsonsherwood.com

MAHLUM ARCHITECTS INC
1231 NW HOYT, SUITE 102
PORTLAND, OREGON 97209
503-224-4032

71 COLUMBIA FLOOR 4
SEATTLE, WASHINGTON 98104
206-441-4151
www.mahlum.com

PAE
Portland | San Francisco | Seattle
pae-engineers.com

REGISTERED PROFESSIONAL ENGINEER
18320 P.E.
MAY 15 1994
WASHINGTON STATE
EXPIRES 12-31-15

EUGENE SCHOOL DISTRICT 4J

REPLACEMENT ROOSEVELT MIDDLE SCHOOL
CIP NUMBER 410.566.001
680 EAST 24TH AVENUE
EUGENE, OREGON 97405
CIP NO. 410.566.001

MARK	DATE	DESCRIPTION
1	03-13-2015	ADDENDUM 6
ISSUE DATE:		FEBRUARY 18, 2015
ISSUE:		CONSTRUCTION DOCUMENTS
VOLUME:		PACKAGE 2 VOLUME 2
PROJECT NO.:		2013912.00
DRAWN BY:		SG
CHECKED BY:		JCY
COPYRIGHT MAHLUM ARCHITECTS, INC. 2014		ORIGINAL SHEET SIZE: 30"X42"

MECHANICAL EQUIPMENT PLATFORM PLAN - ZONE A EAST - MECHANICAL

M-401A2

3/11/2015 9:53:41 AM C:\Bentley\Local\Projects\1308\MEPH\GENERAL\mehm14.dwg


GENERAL NOTES:

A. PROVIDE CONDENSATE DRAIN PIPING FROM AIR HANDLERS TO NEAREST FLOOR SINK



B. ARRANGE EQUIPMENT, PIPING, AND DUCTWORK TO MAINTAIN A 3 FOOT WIDE MAINTENANCE PATH THRU MECH PLATFORM WITH MIN 6" 8" HEAD CLEARANCE.

NOTES:


1. OWNER PROVIDED ENVIROVENT KILN FAN MOUNTED UNDESIDE OF ROOF DECK DIV 26 TO PROVIDE DISCONNECT AT KILN LOCATION TERMINATE AT ROOF JACK
2. PROVIDE AUTOMATIC CONTROL DAMPER
3. ROUTE ABOVE THROUGH TRUSS OPENINGS.
4. ROUTE ABOVE BETWEEN TRUSSES.
5. ROUTE BELOW TRUSSES, MAINTAIN 6" 8" AFF FOR MAINTANCE ACCESS.
6. PROVIDE AUTOMATIC CONTROL DAMPER AND BDD. SIZE DAMPERS FOR 400 MAX 400 FPM

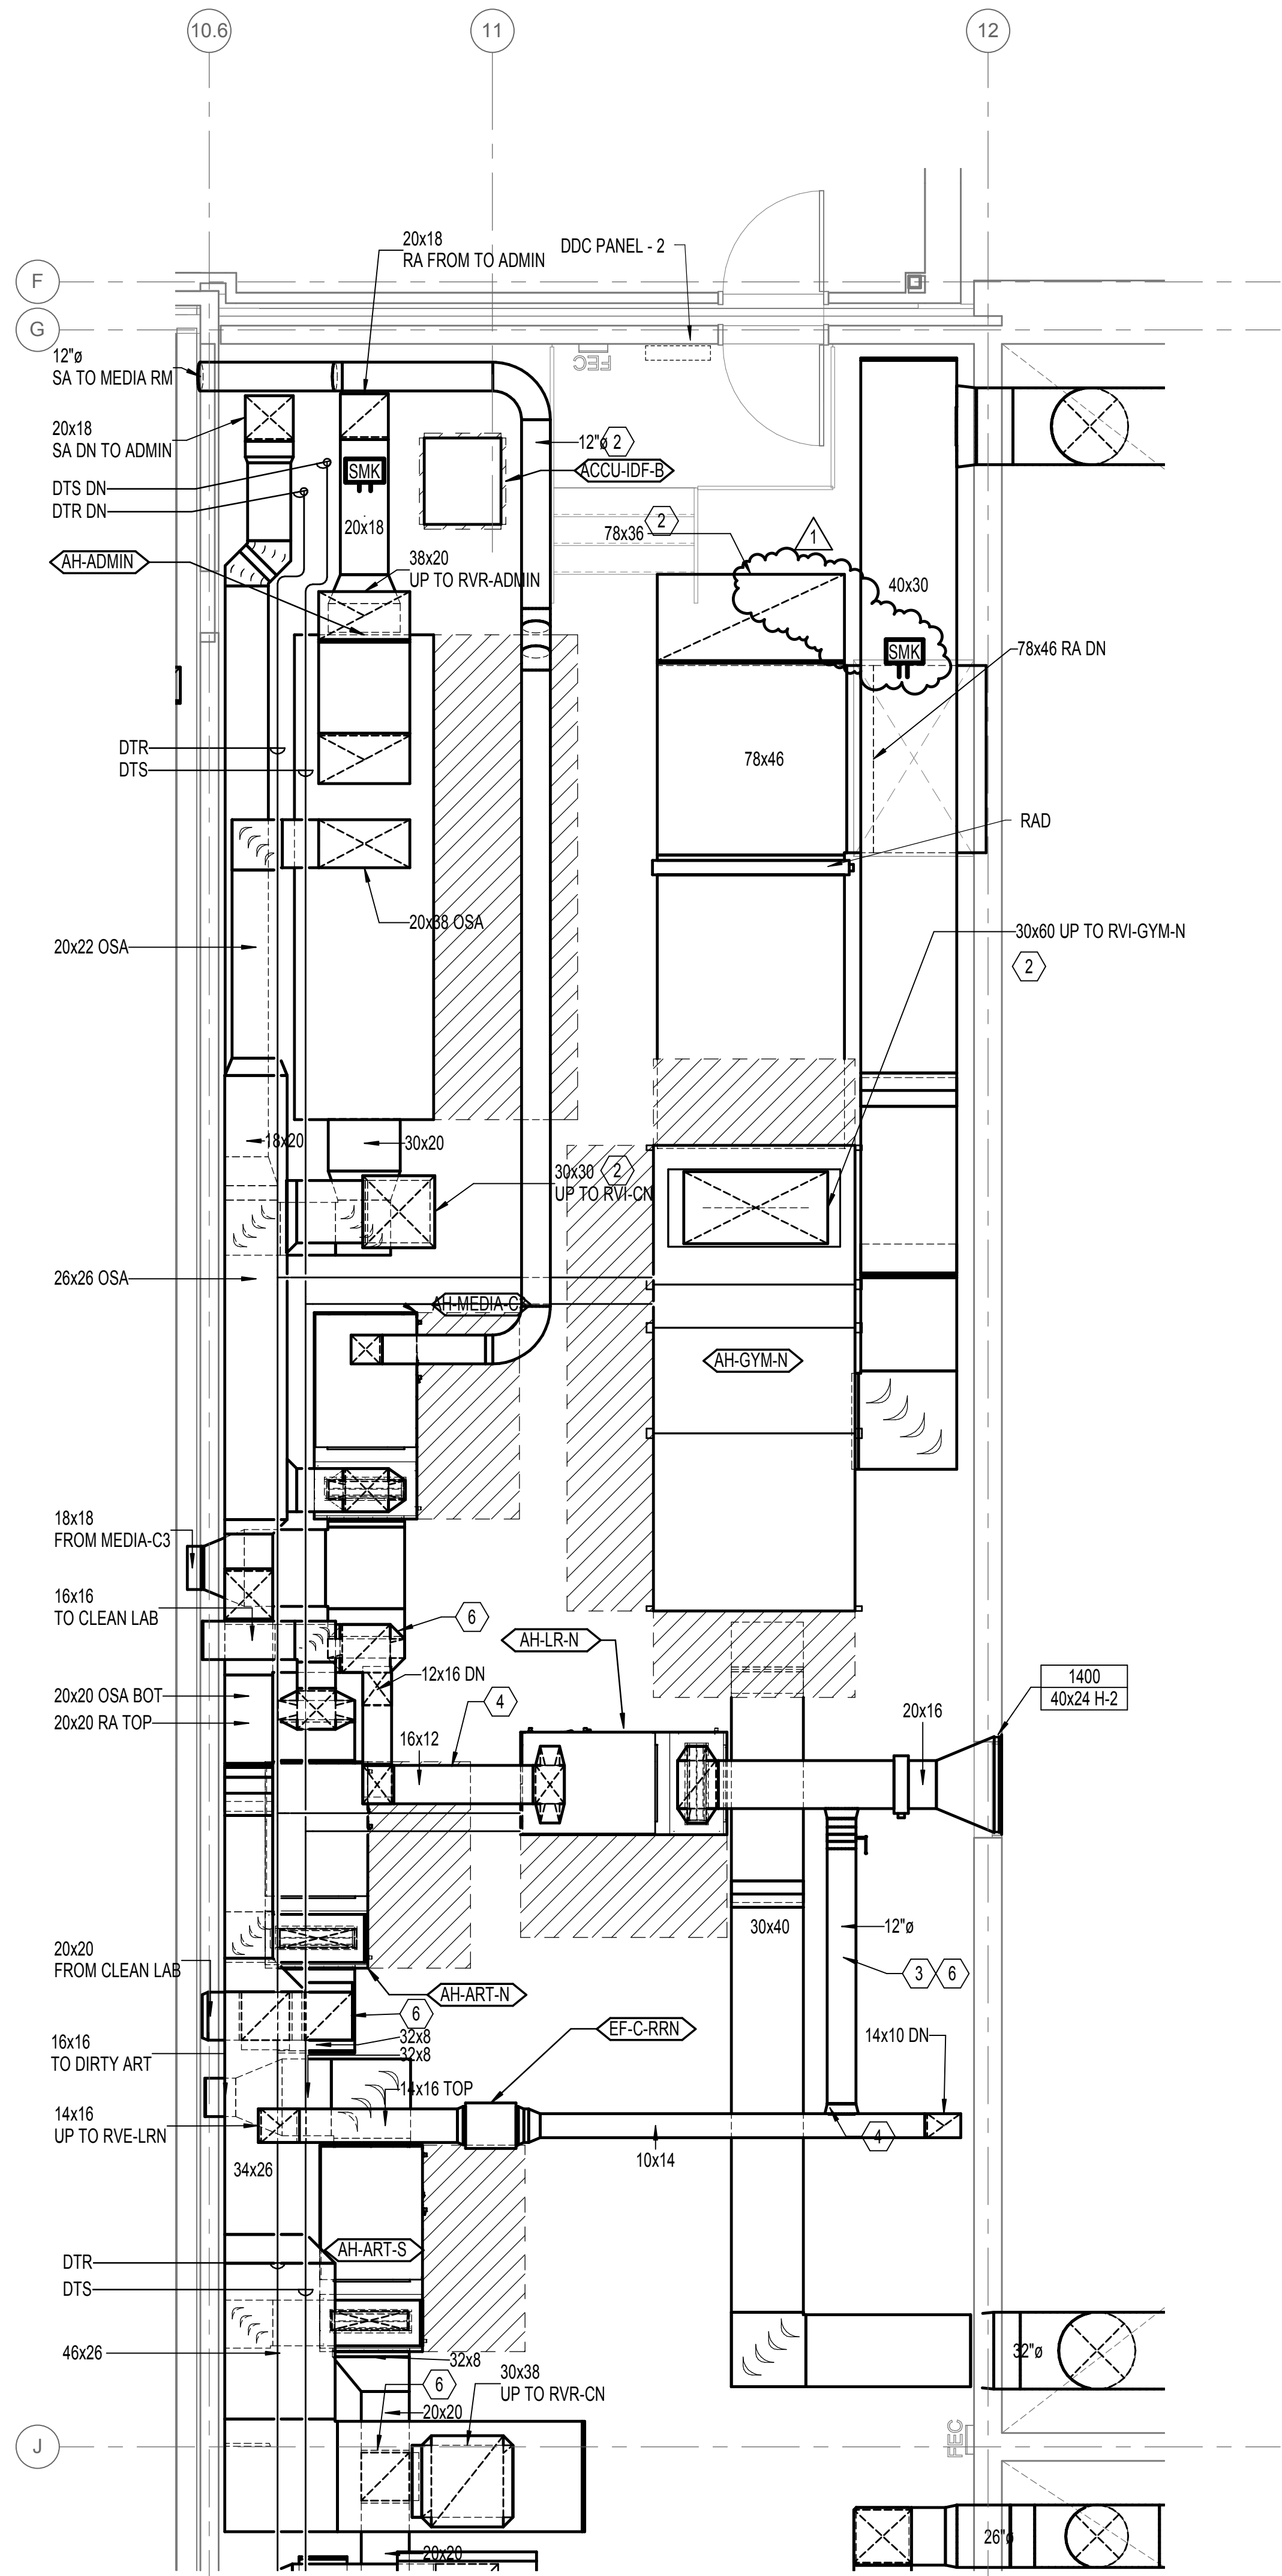


A1 MECHANICAL EQUIPMENT PLATFORM PLAN - ZONE C NORTH - MECHANICAL
1/4" = 1'-0"

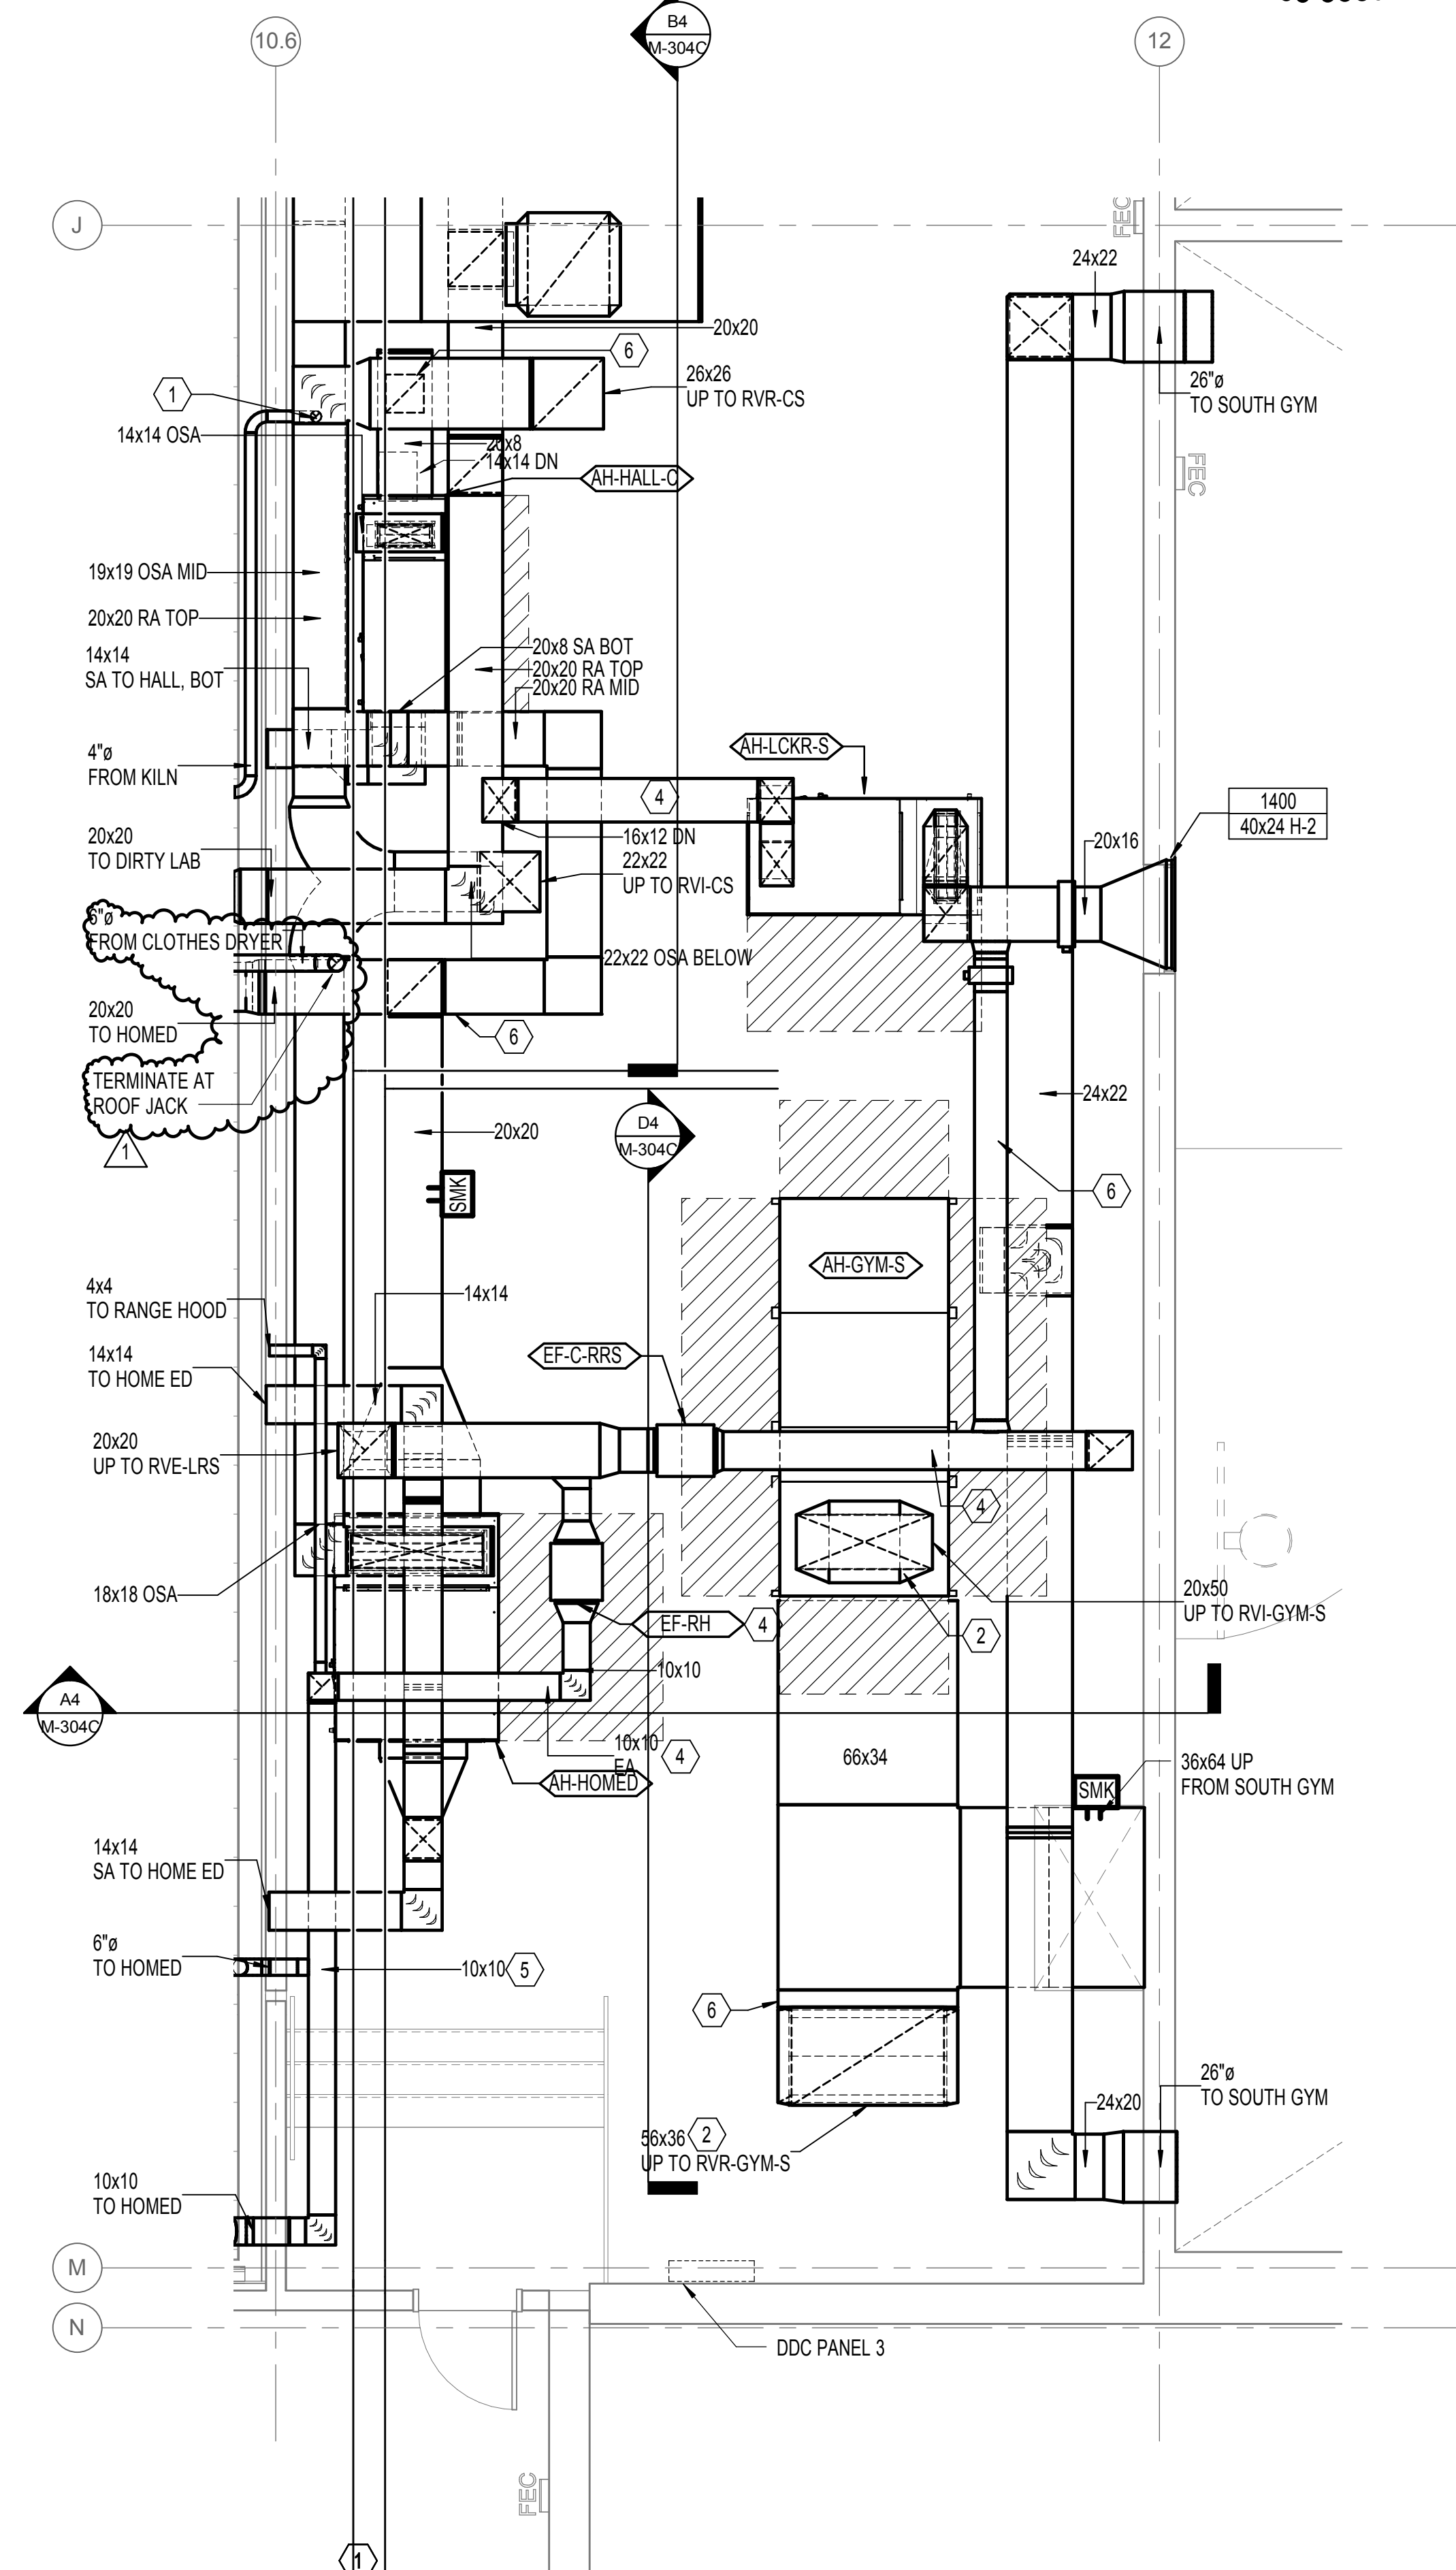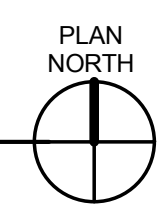


A4 MECHANICAL EQUIPMENT PLATFORM PLAN - ZONE C SOUTH - MECHANICAL
1/4" = 1'-0"

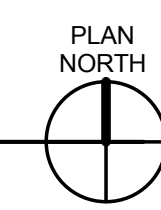

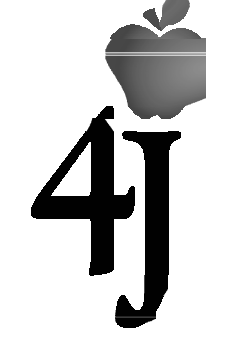


GENERAL NOTES:

- A. NOT USED
 - B. PROVIDE CONDENSATE DRAIN PIPING FROM AIR HANDLERS TO NEAREST FLOOR SINK
 - C. ARRANGE EQUIPMENT, PIPING, AND DUCTWORK TO MAINTAIN A 3 FOOT WIDE MAINTENANCE PATH THRU MECH PLATFORM WITH MIN 6" HEAD CLEARANCE
- NOTES:**
1. PROVIDE MINIMUM 6" 8" CLEARANCE AFF FOR MAINTENANCE ACCESS.
 2. PROVIDE AUTOMATIC CONTROL DAMPER.
 3. ROUTE ABOVE THROUGH TRUSS OPENINGS.
 4. ROUTE ABOVE BETWEEN TRUSSES.
 5. PROVIDE CLEANOUT.
 6. SLOPE 1/4" IN 12" BACK TO HOOD.
 7. CONTINUED ON B4/M-401D.
 8. CONTINUED ON B1/M-401D.
 9. CONTINUED ON M-121E.

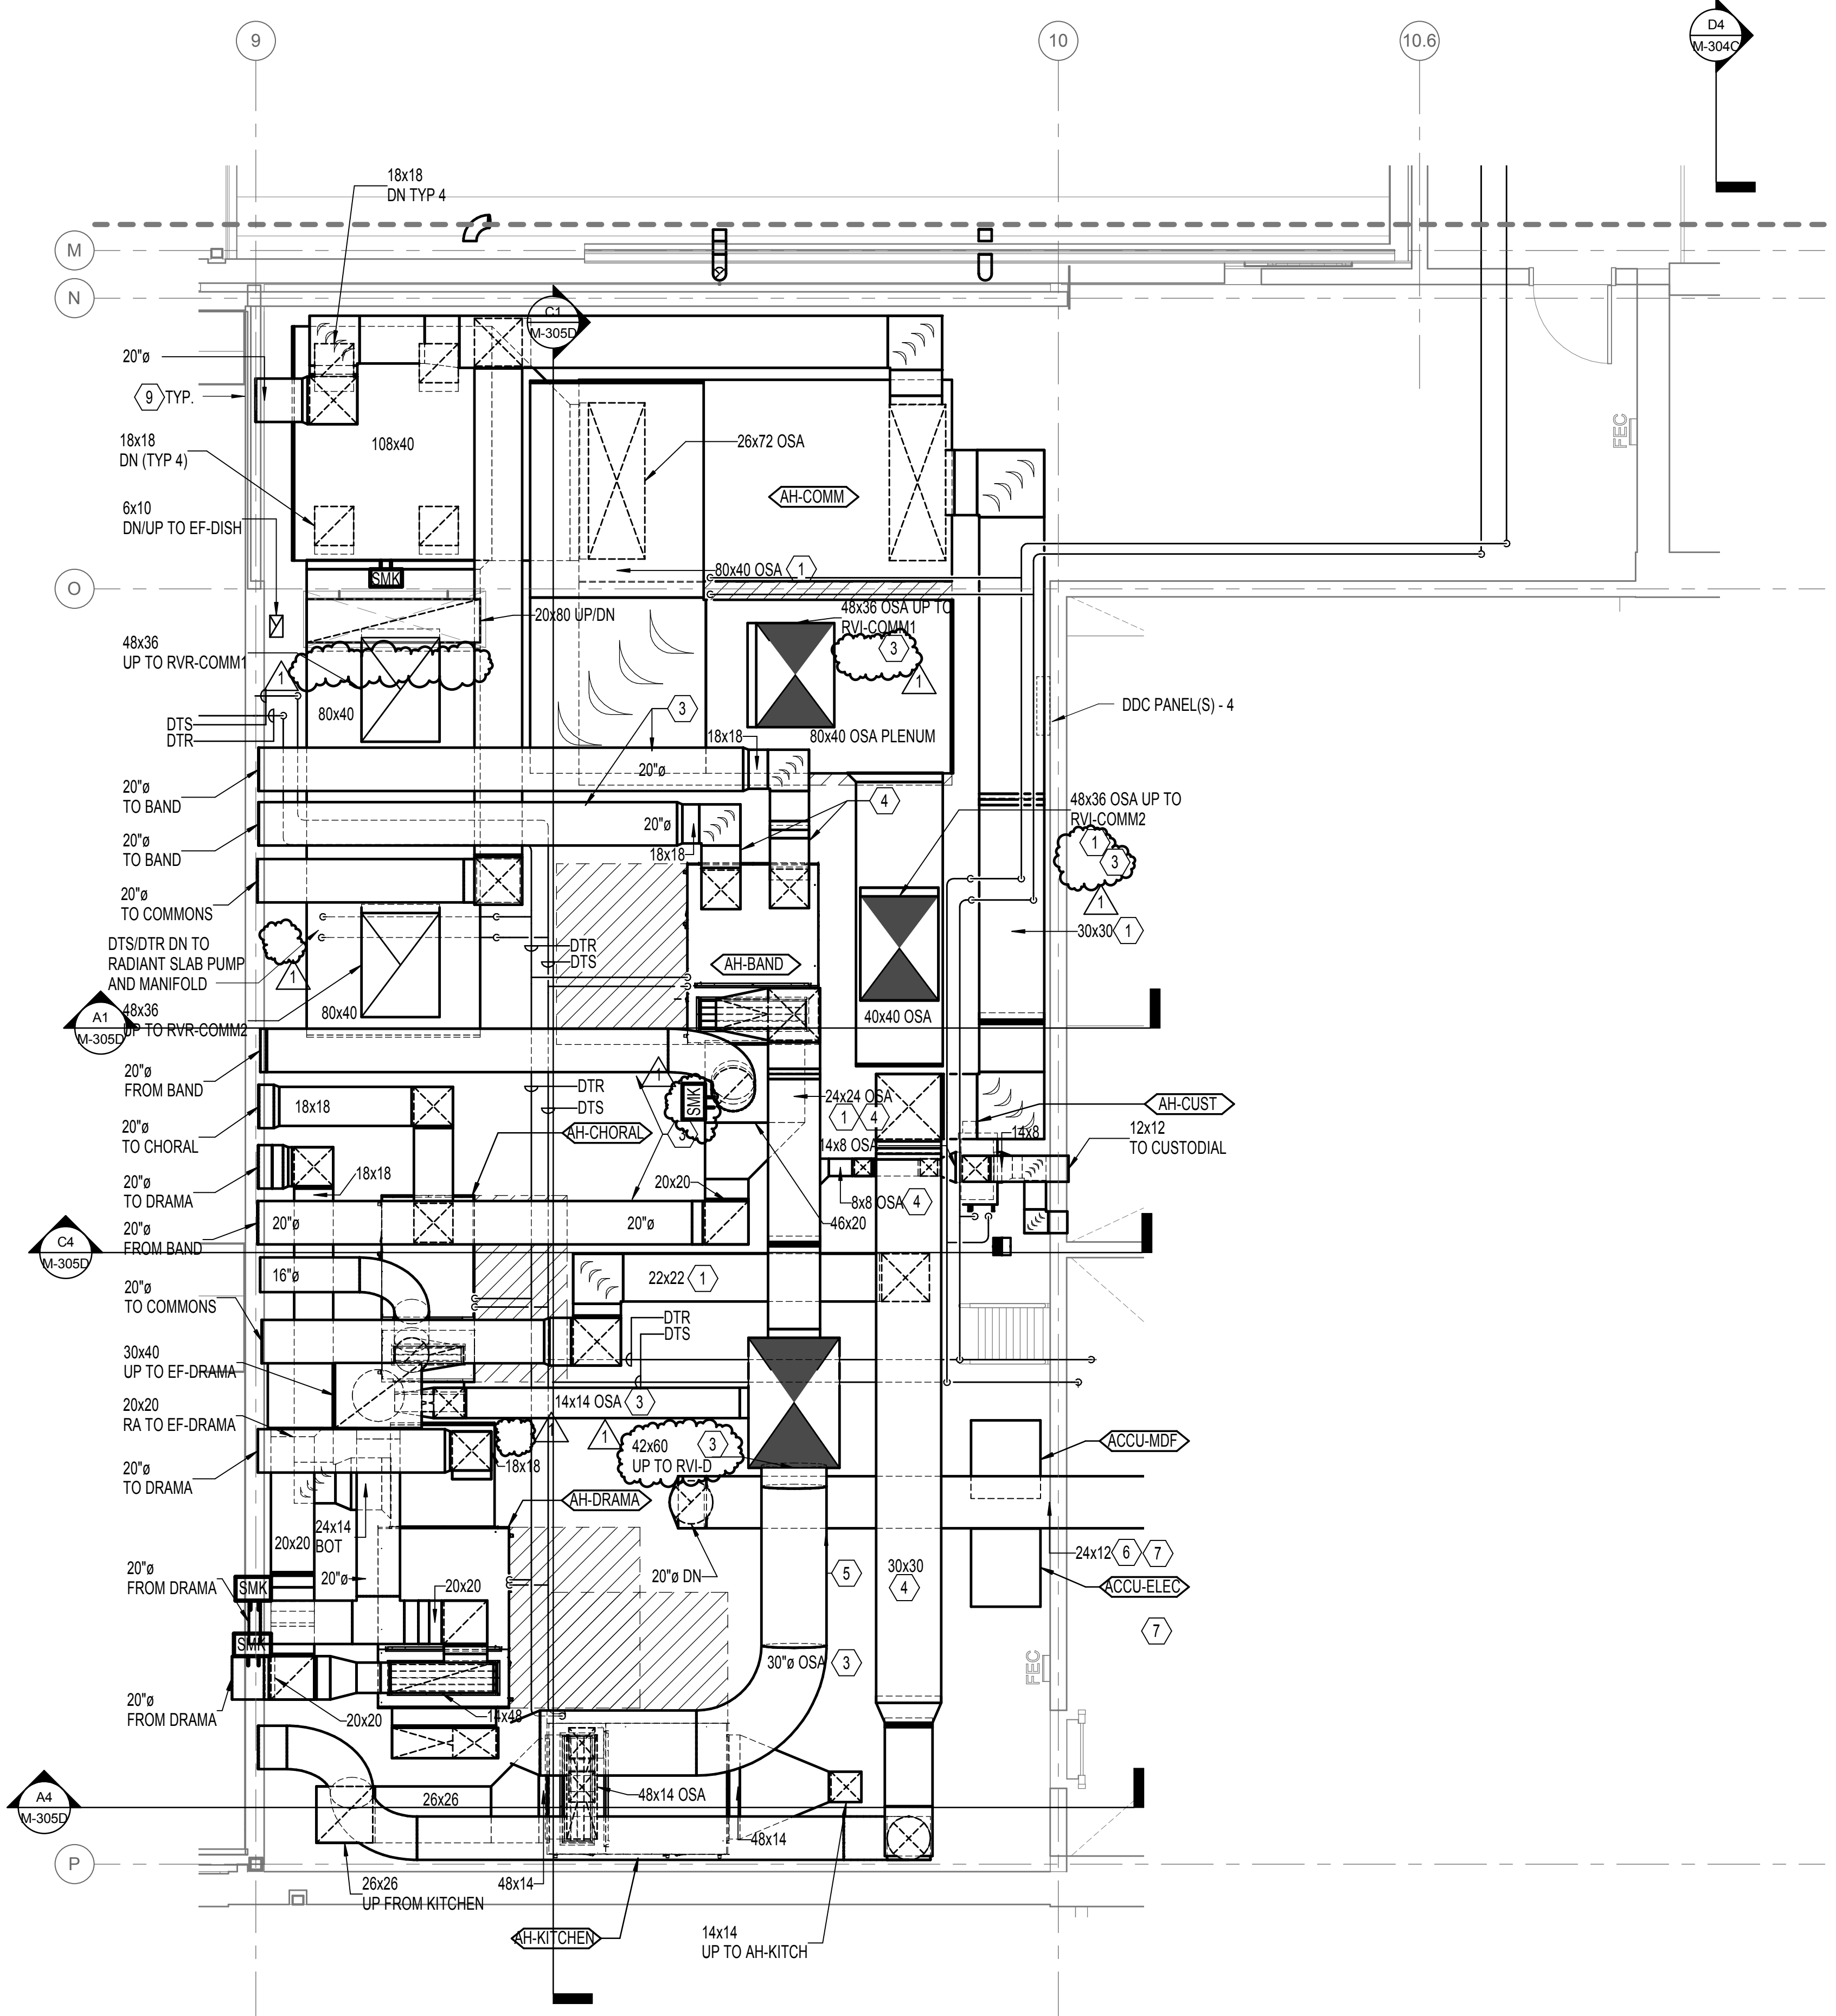

B1 MECHANICAL EQUIPMENT PLATFORM PLAN - ZONE D - MECHANICAL
 1/4" = 1'-0" PLAN NORTH

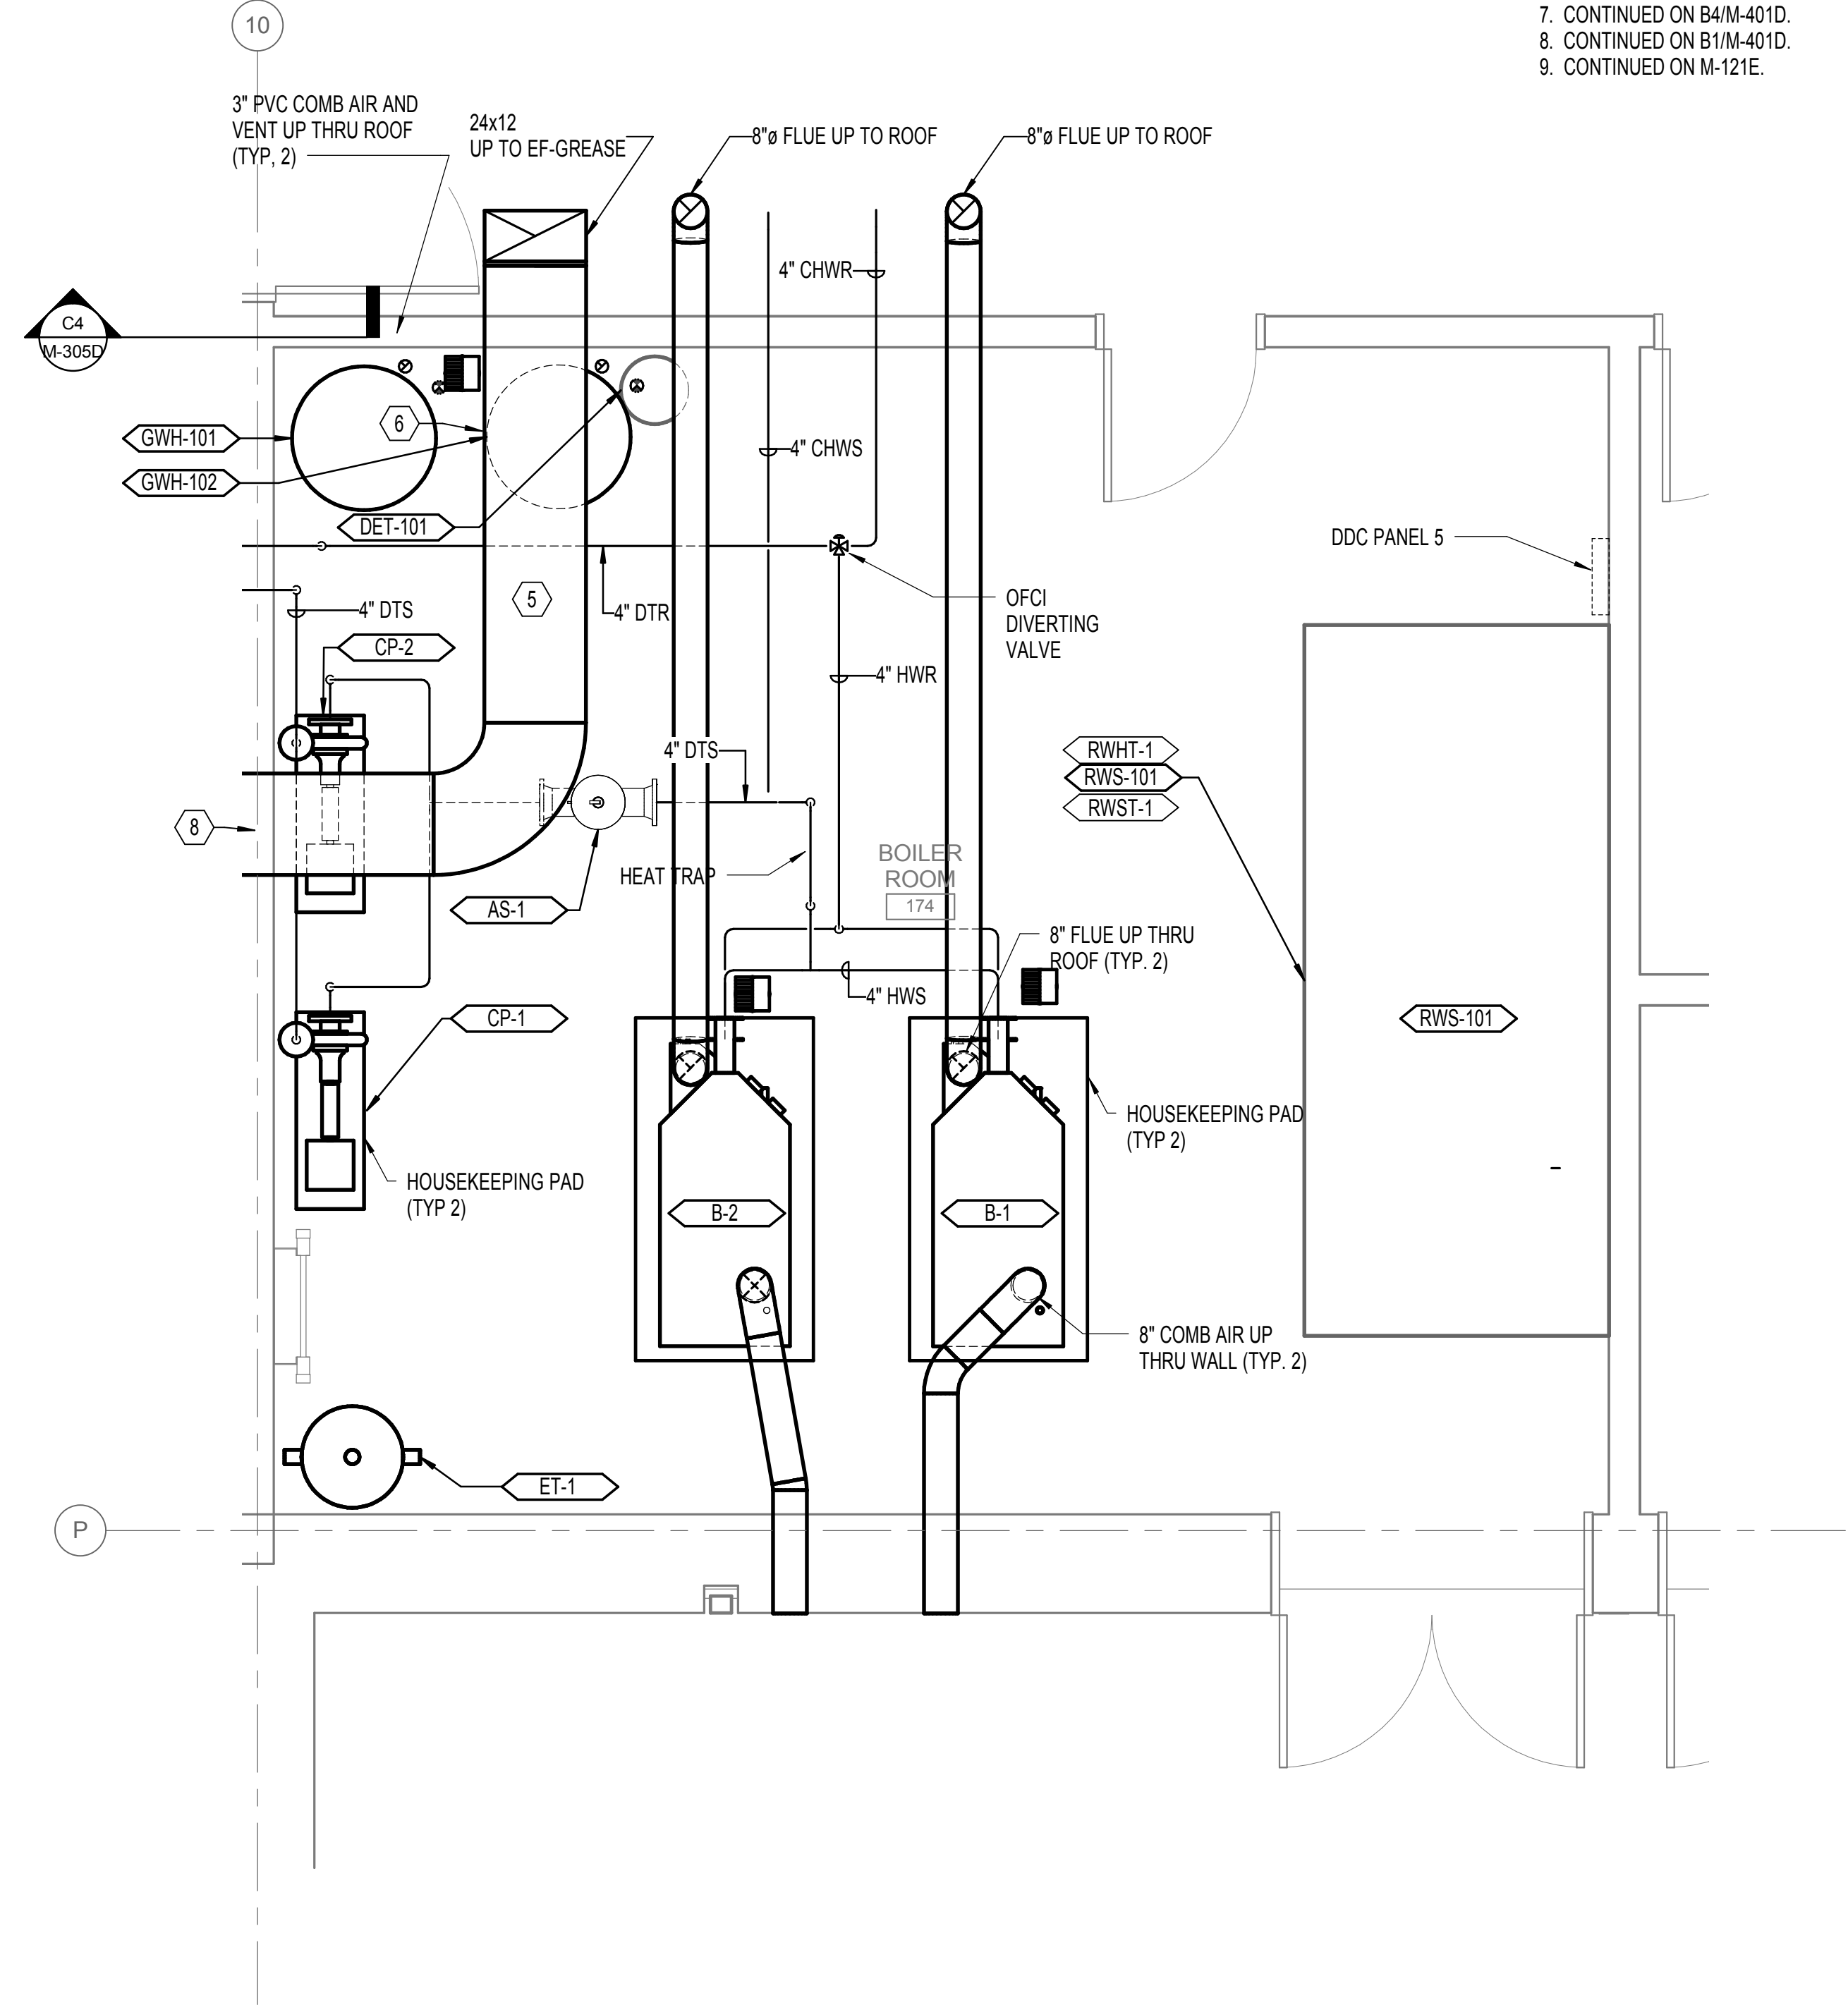

B4 ZONE D PARTIAL MECHANICAL PLAN - BOILER ROOM
 3/8" = 1'-0" PLAN NORTH

MARK	DATE	DESCRIPTION
1	03-13-2015	ADDENDUM 6

ISSUE DATE: FEBRUARY 18, 2015
 ISSUE: CONSTRUCTION DOCUMENTS
 VOLUME: PACKAGE 2 VOLUME 2
 PROJECT NO: 2013912.00
 DRAWN BY: SG
 CHECKED BY: JCY
COPYRIGHT MAHLUM ARCHITECTS, INC. 2014 ORIGINAL SHEET SIZE: 30"x42"

PARTIAL PLANS - ZONE D - MECHANICAL

MARK	DATE	DESCRIPTION
1	03-13-2015	ADDENDUM 6


ISSUE DATE: FEBRUARY 18, 2015
ISSUE: CONSTRUCTION DOCUMENTS
VOLUME: PACKAGE 2 VOLUME 2
PROJECT NO: 2013912.00
DRAWN BY: SG
CHECKED BY: JCY
COPYRIGHT MAHLUM ARCHITECTS, INC. 2014 ORIGINAL SHEET SIZE: 30"X42"

MECHANICAL EQUIPMENT PLATFORM PLAN - ZONE E NORTH - MECHANICAL


M-401E1

GENERAL NOTES:
A. NOT USED.
B. PROVIDE CONDENSATE DRAIN PIPING FROM AIR HANDLERS TO NEAREST FLOOR SINK.
C. ARRANGE EQUIPMENT, PIPING, AND DUCTWORK TO MAINTAIN A 3 FOOT WIDE MAINTENANCE PATH THRU MECH PLATFORM WITH MIN 6' 8" HEAD CLEARANCE.


NOTES:
1. RELIEF PLENUM TO BE DIVIDED HORIZONTALLY BY SHEETMETAL SEPTUM AND ACOUSTICALLY LINED. LOWER 1/3 OF PLENUM VOLUME TO SERVE CHORAL, UPPER 2/3 OF PLENUM VOLUME TO SERVE BAND.
2. PROVIDE AUTOMATIC CONTROL DAMPER.
3. DUCT ROUTE TO BE ACOUSTICALLY LINED.
4. ROUTE ABOVE BETWEEN TRUSSES.
5. POSITIONED ABOVE LEVEL OF CEILING CLOUD.
6. MAINTAIN MIN 6' 8" AFF MAINTENANCE CLEARANCE ZONE.
7. COORDINATE WITH STRUCTURAL PENETRATION, CONTINUED ON M-121E.
8. 2.25 SF LOUVER FA
9. 12.5 SF LOUVER FA
10. 6.0 SF LOUVER FA
11. 3.0 SF LOUVER FA

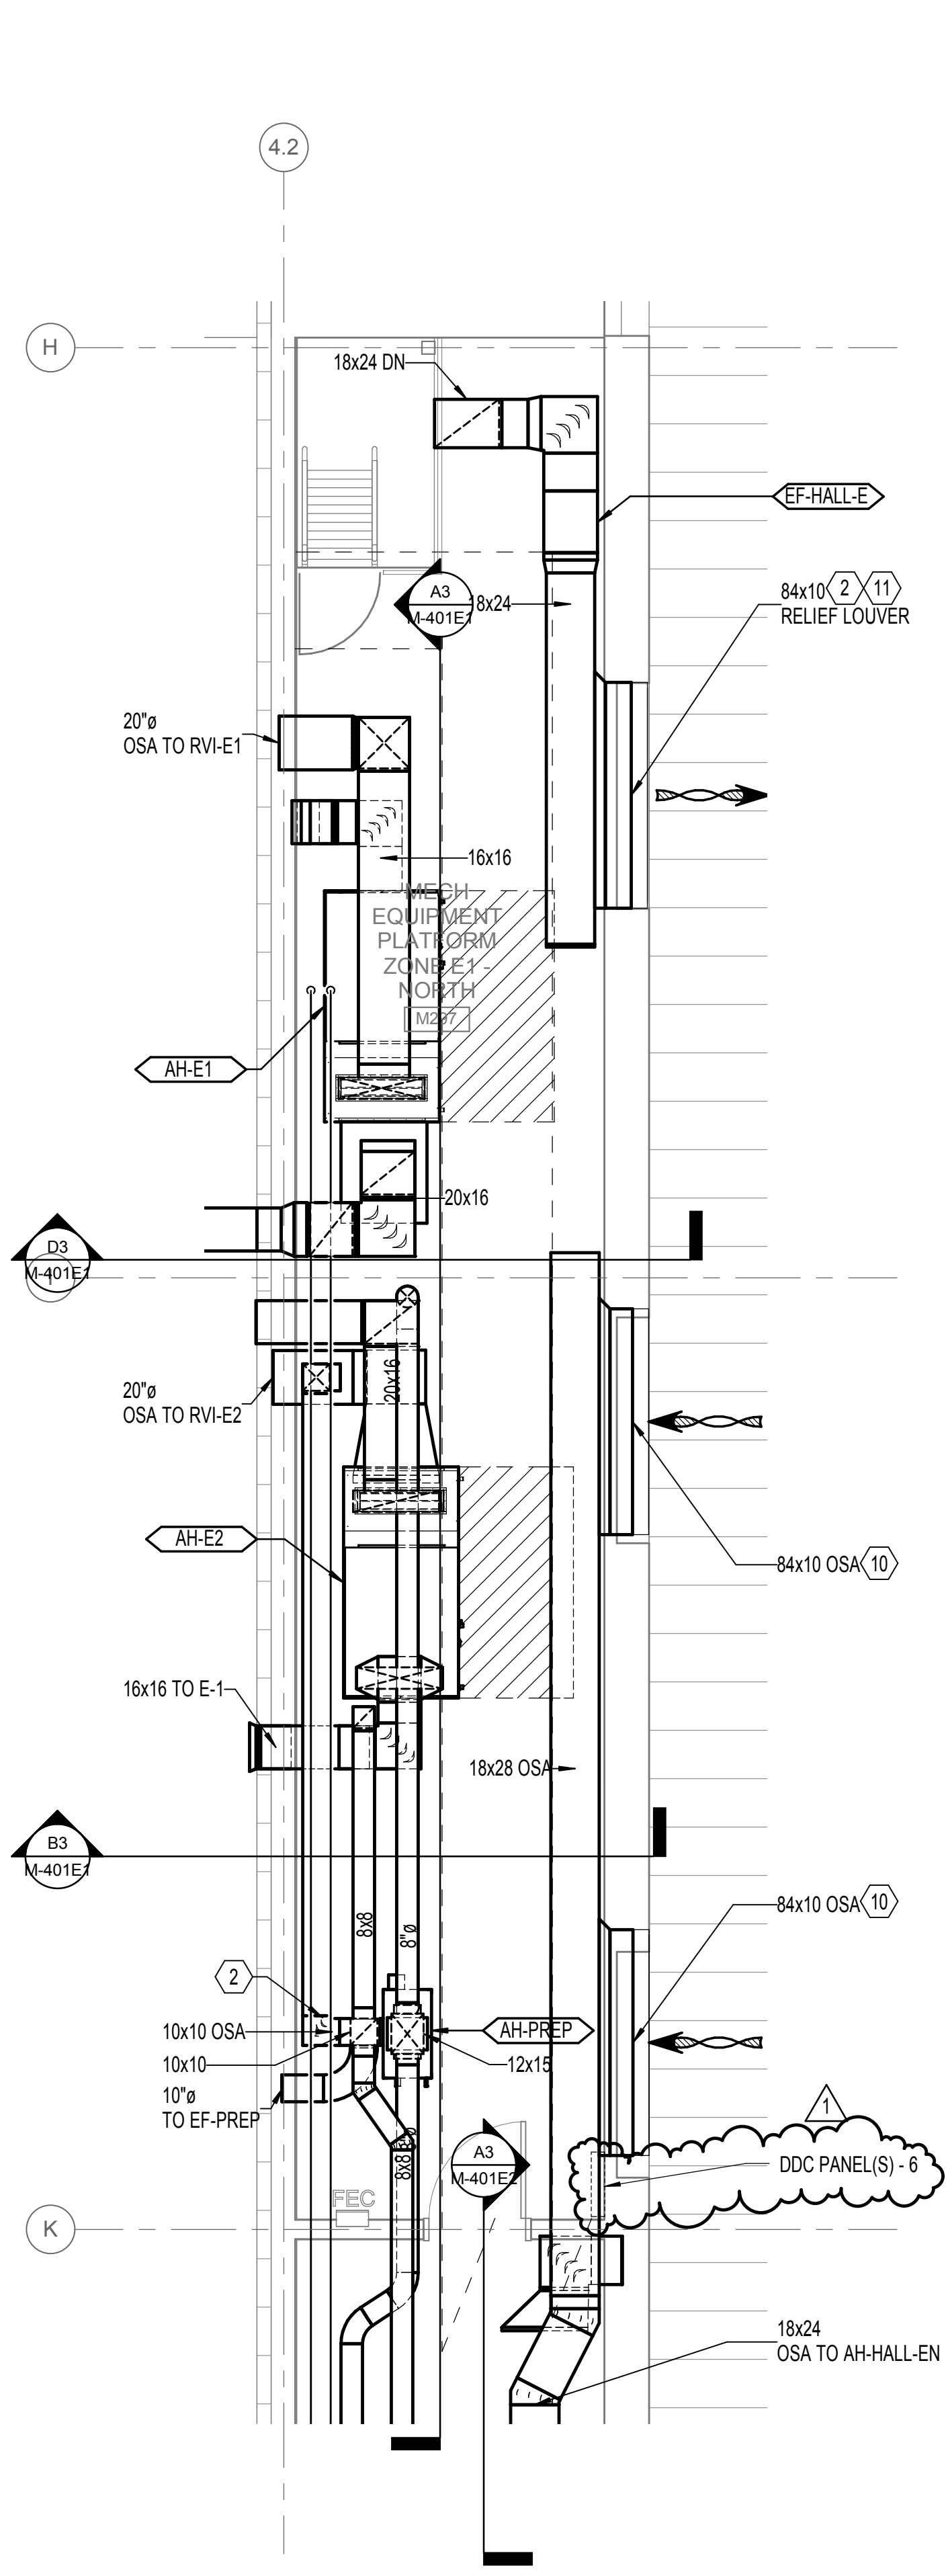


A1 MECHANICAL EQUIPMENT PLATFORM PLAN - ZONE E NORTH - MECHANICAL
1/4" = 1'-0"

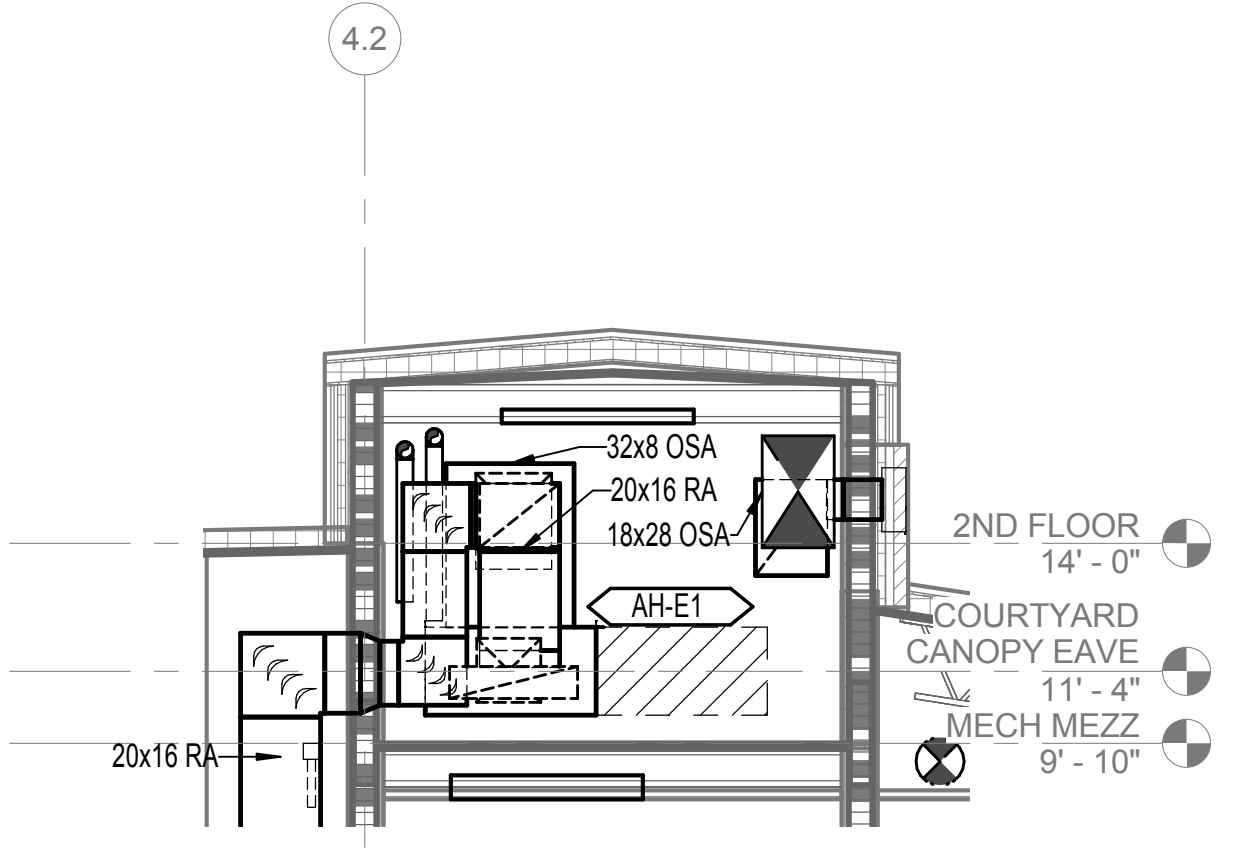

D3 MECHANICAL EQUIPMENT PLATFORM PLAN - ZONE E -LOOKING NORTH 1
1/4" = 1'-0"

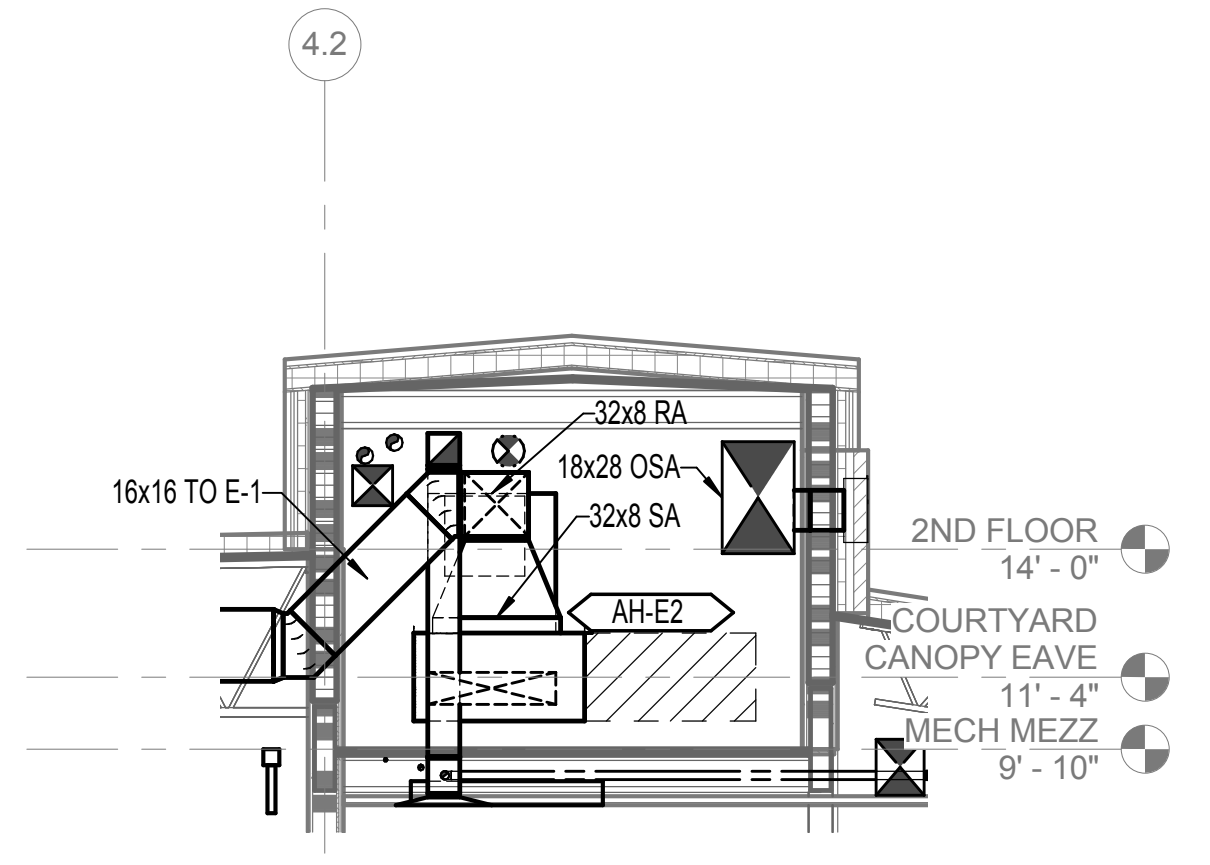

B3 MECHANICAL EQUIPMENT PLATFORM PLAN - ZONE E -LOOKING NORTH 2
1/4" = 1'-0"

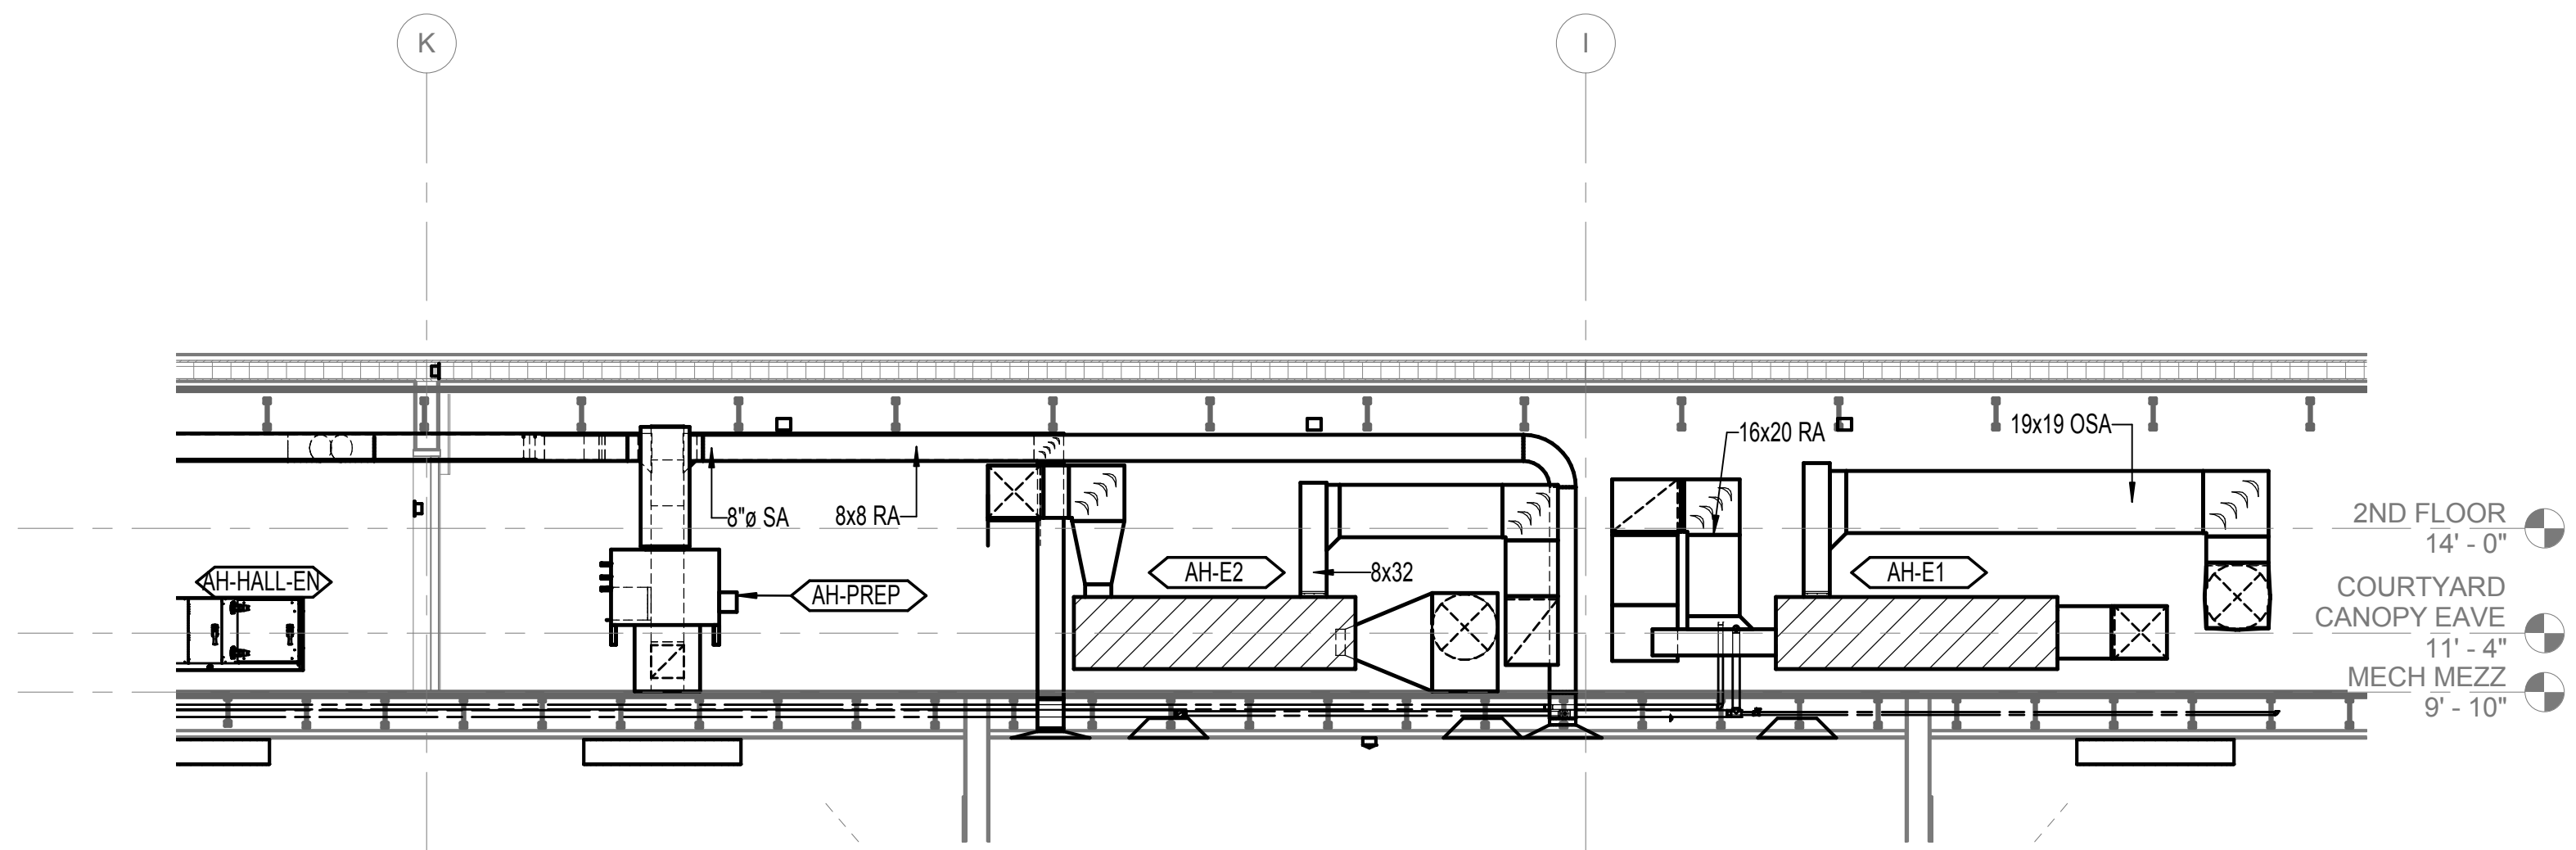

A3 MECHANICAL EQUIPMENT PLATFORM PLAN - ZONE E WEST
1/4" = 1'-0"



GENERAL NOTES:

- A. NOT USED.
- B. PROVIDE CONDENSATE DRAIN PIPING FROM AIR HANDLERS TO NEAREST FLOOR SINK.
- C. ARRANGE EQUIPMENT, PIPING, AND DUCTWORK TO MAINTAIN 3 FOOT WIDE MAINTENANCE PATH THRU MECH PLATFORM WITH MIN 6" HEAD CLEARANCE.

NOTES:

1. RELIEF PLENUM TO BE DIVIDED HORIZONTALLY BY SHEETMETAL SEPTUM AND ACOUSTICALLY LINED. LOWER 1/3 OF PLENUM VOLUME TO SERVE CHORAL, UPPER 2/3 OF PLENUM VOLUME TO SERVE BAND.
2. PROVIDE AUTOMATIC CONTROL DAMPER.
3. DUCT ROUTE TO BE ACOUSTICALLY LINED.
4. ROUTE ABOVE, BETWEEN TRUSSES.
5. POSITIONED ABOVE LEVEL OF CEILING CLOUD.
6. MAINTAIN MIN 6" AFF MAINTENANCE CLEARANCE ZONE.
7. COORDINATE WITH STRUCTURAL PENETRATION, CONTINUED ON M-121E.
8. 2.25 SF LOUVER FA.
9. 12.5 SF LOUVER FA.
10. 6.0 SF LOUVER FA.

mahlum
 Robertson/Sherwood Architects

ROBERTSON/SHERWOOD/ARCHITECTS PC
 132 EAST BROADWAY, SUITE 540
 EUGENE, OREGON 97401
 541-342-8077
 www.robertsonsherwood.com

MAHLUM ARCHITECTS INC
 1231 NW HOYT, SUITE 102
 PORTLAND, OREGON 97209
 503-224-4032


71 COLUMBIA, FLOOR 4
 SEATTLE, WASHINGTON 98104
 206-441-4151
 www.mahlum.com

P A E
 Portland | San Francisco | Seattle
 pae-engineers.com




EUGENE SCHOOL DISTRICT 4J


REPLACEMENT ROOSEVELT
 MIDDLE SCHOOL
 CIP NUMBER 410.566.001
 680 EAST 24TH AVENUE
 EUGENE, OREGON 97405
 CIP NO. 410.566.001

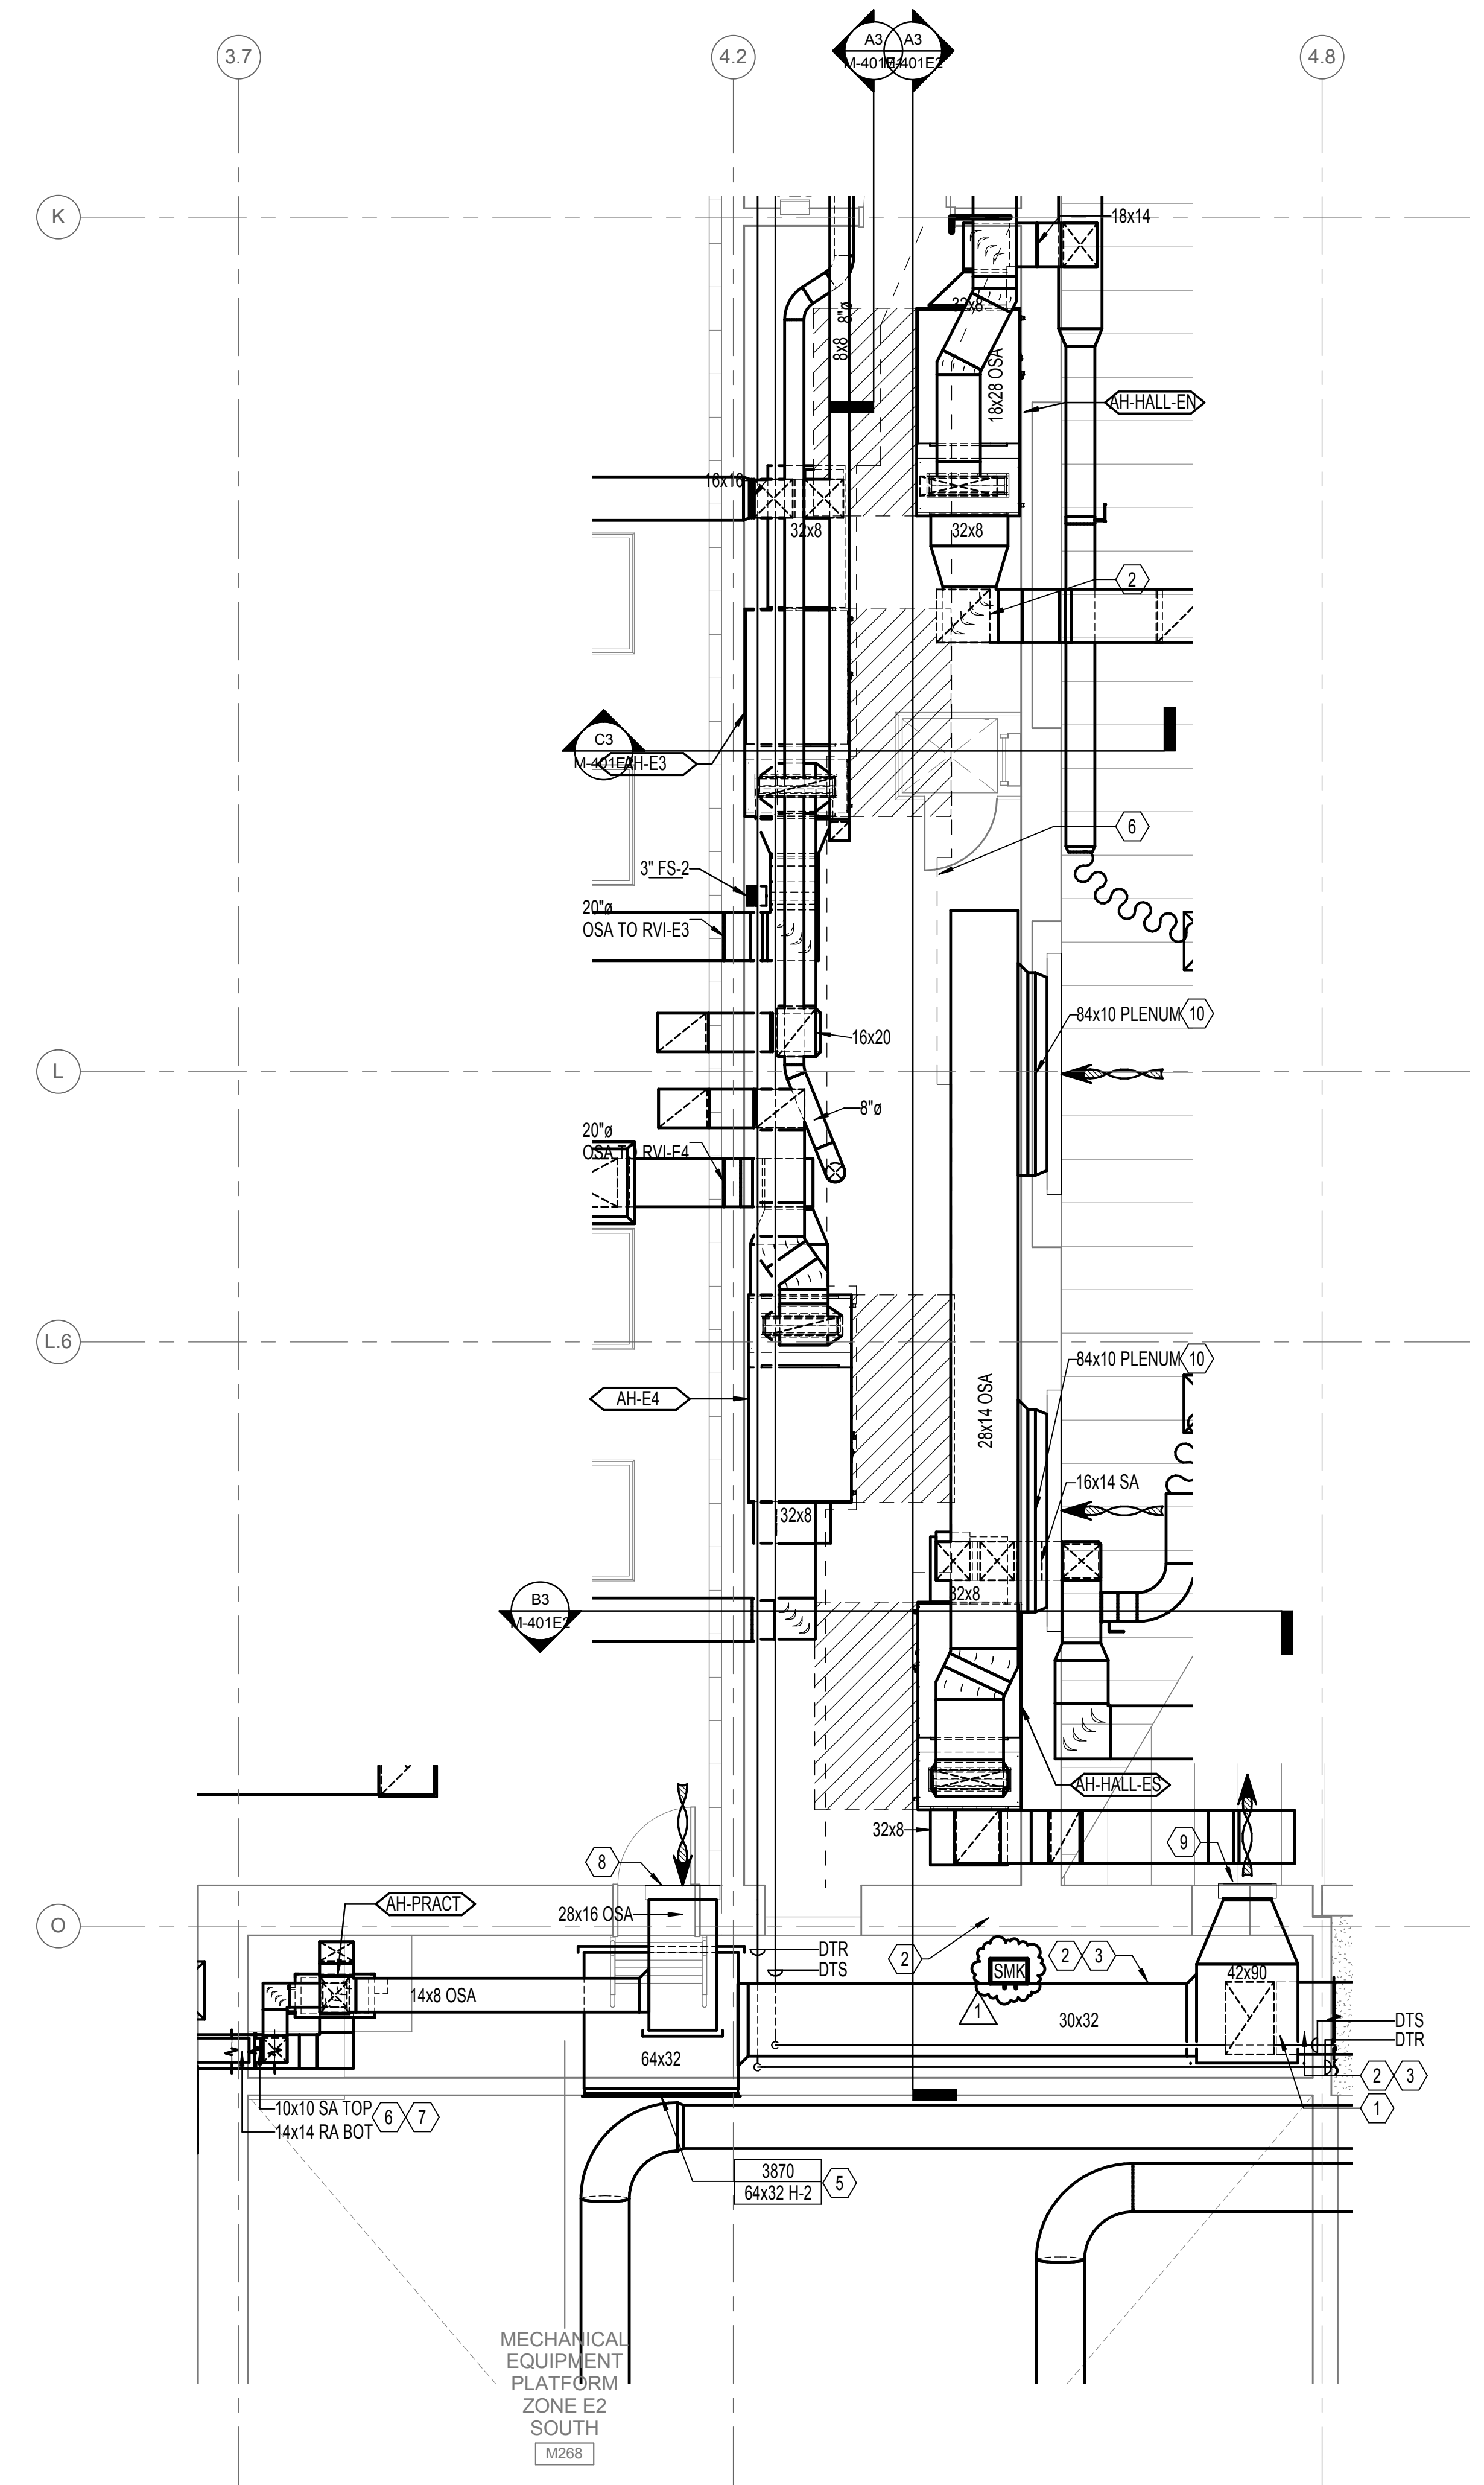


A1 MECHANICAL EQUIPMENT PLATFORM PLAN - ZONE E SOUTH - MECHANICAL
 1/4" = 1'-0"

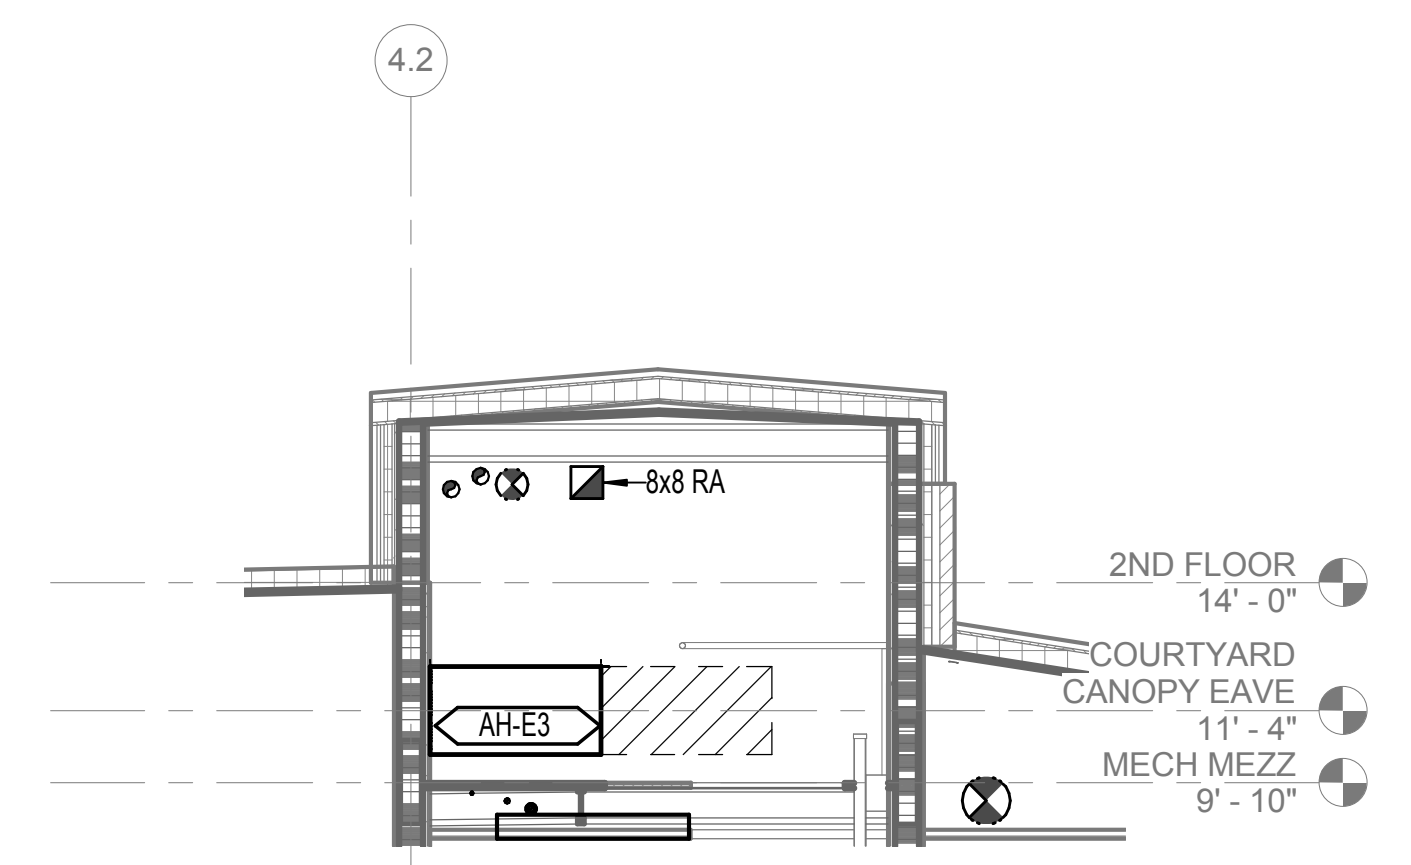

C3 MECHANICAL EQUIPMENT PLATFORM PLAN - ZONE E - LOOKING NORTH 3
 1/4" = 1'-0"

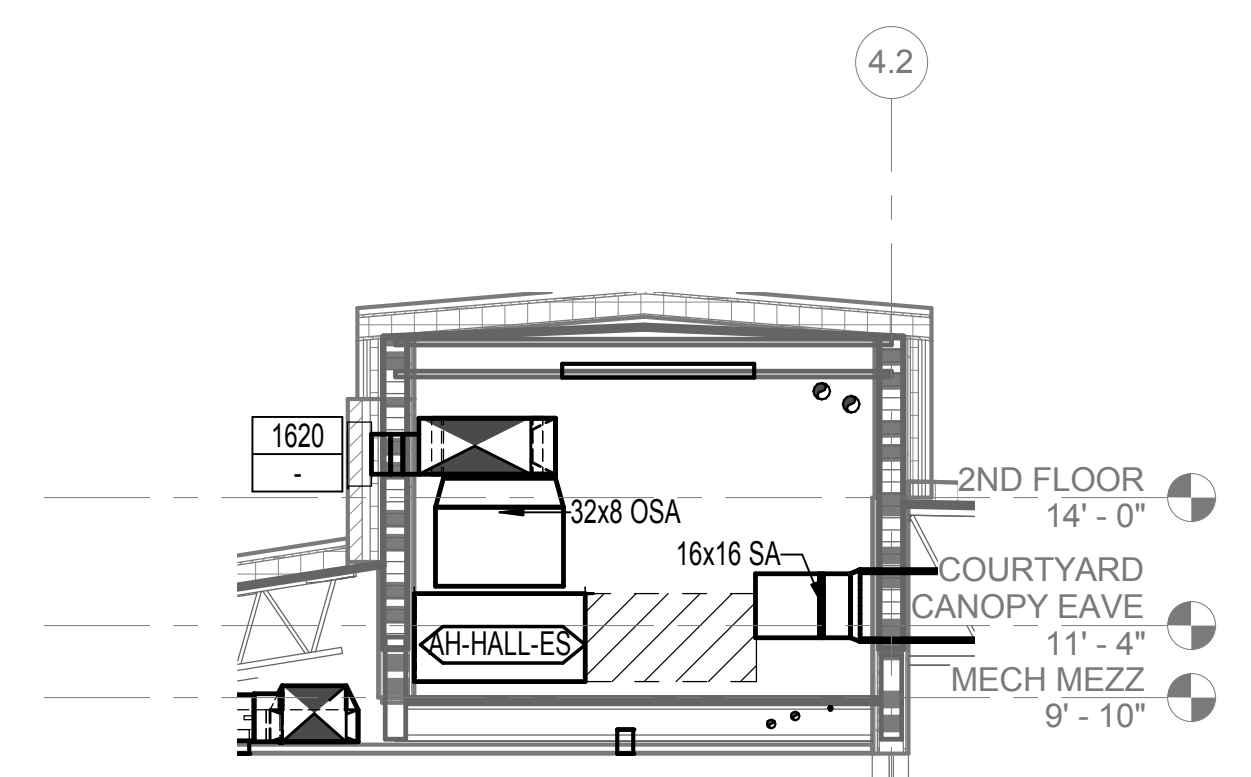

B3 MECHANICAL EQUIPMENT PLATFORM PLAN - ZONE E - LOOKING SOUTH
 1/4" = 1'-0"

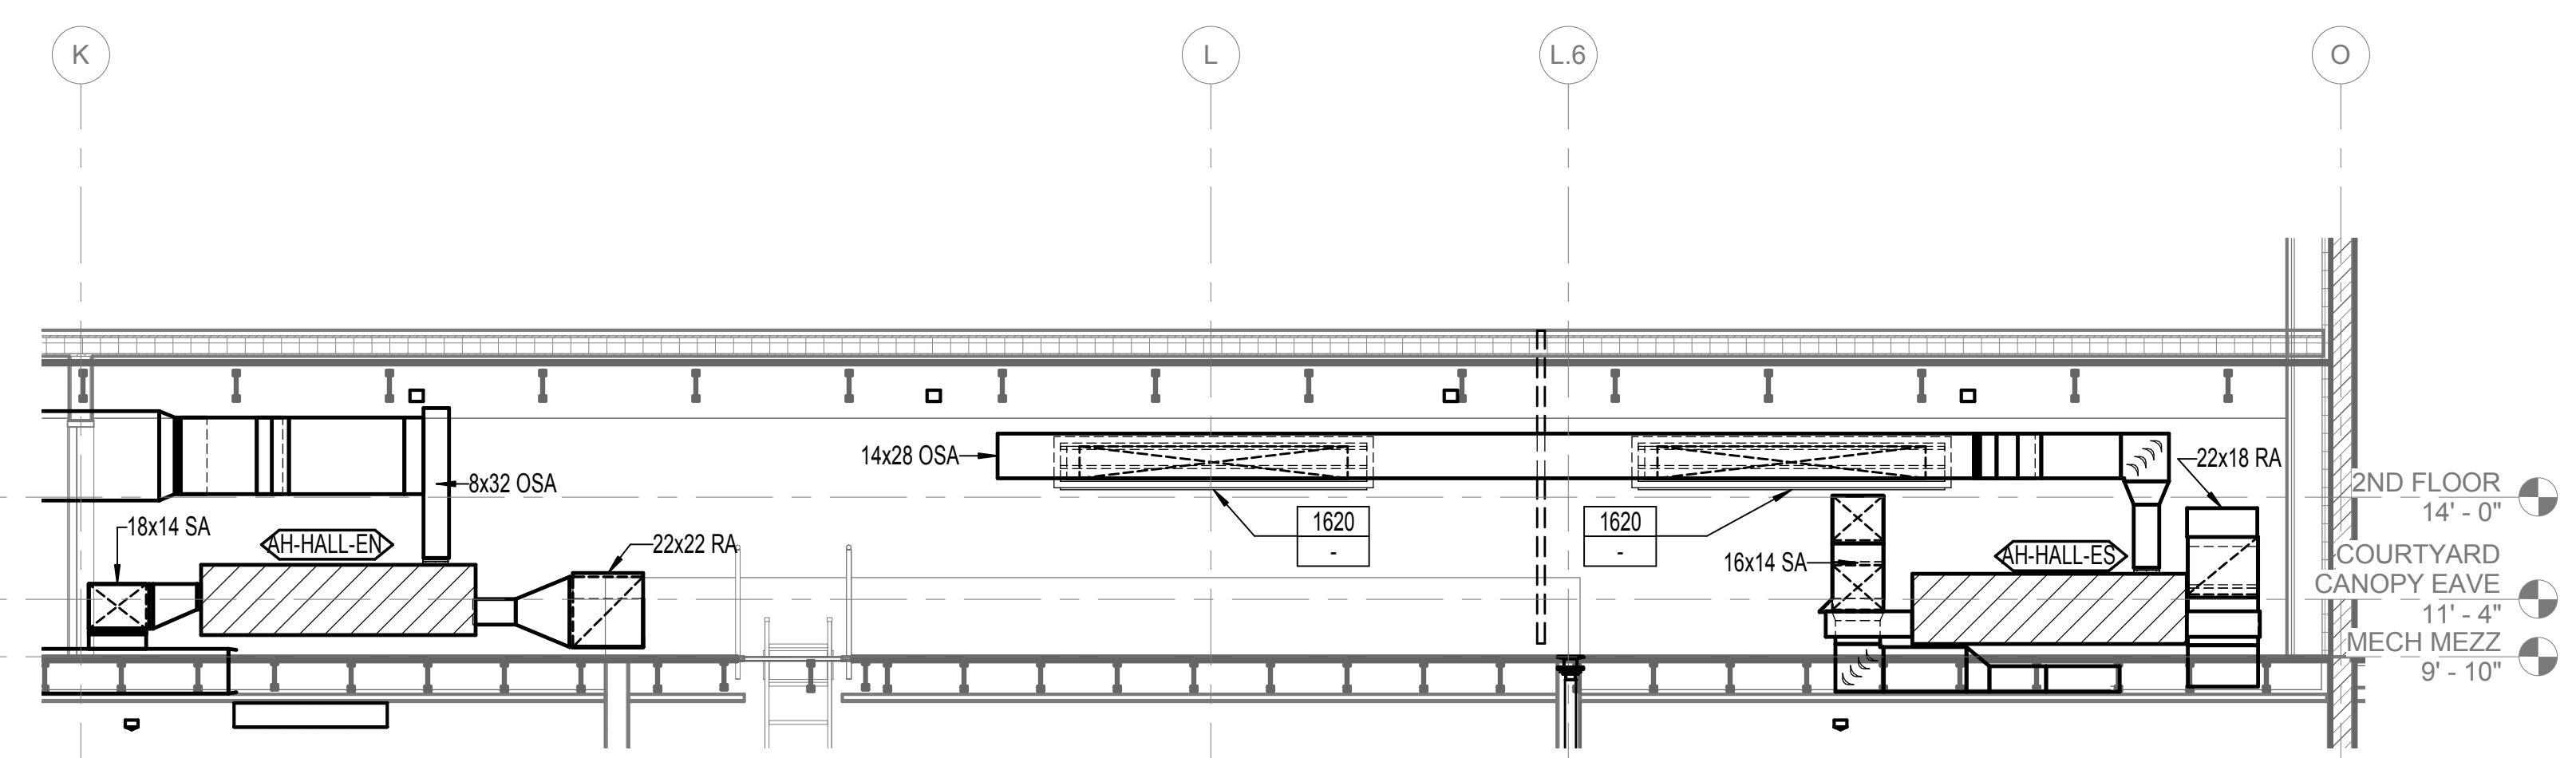


A3 MECHANICAL EQUIPMENT PLATFORM PLAN - ZONE E - LOOKING EAST
 1/4" = 1'-0"

MARK	DATE	DESCRIPTION
1	03-13-2015	ADDENDUM 6
ISSUE DATE:	FEBRUARY 18, 2015	
ISSUE:	CONSTRUCTION DOCUMENTS	
VOLUME:	PACKAGE 2 VOLUME 2	
PROJECT NO.:	2013912.00	
DRAWN BY:	SG	
CHECKED BY:	JCY	

MECHANICAL EQUIPMENT PLATFORM PLAN - ZONE E SOUTH - MECHANICAL

M-401E2


3/10/2015 3:25:21 PM C:\Users\Local\Public\3-108-MEP\4-CENTRAL\1-10-15\1-10-15.dwg

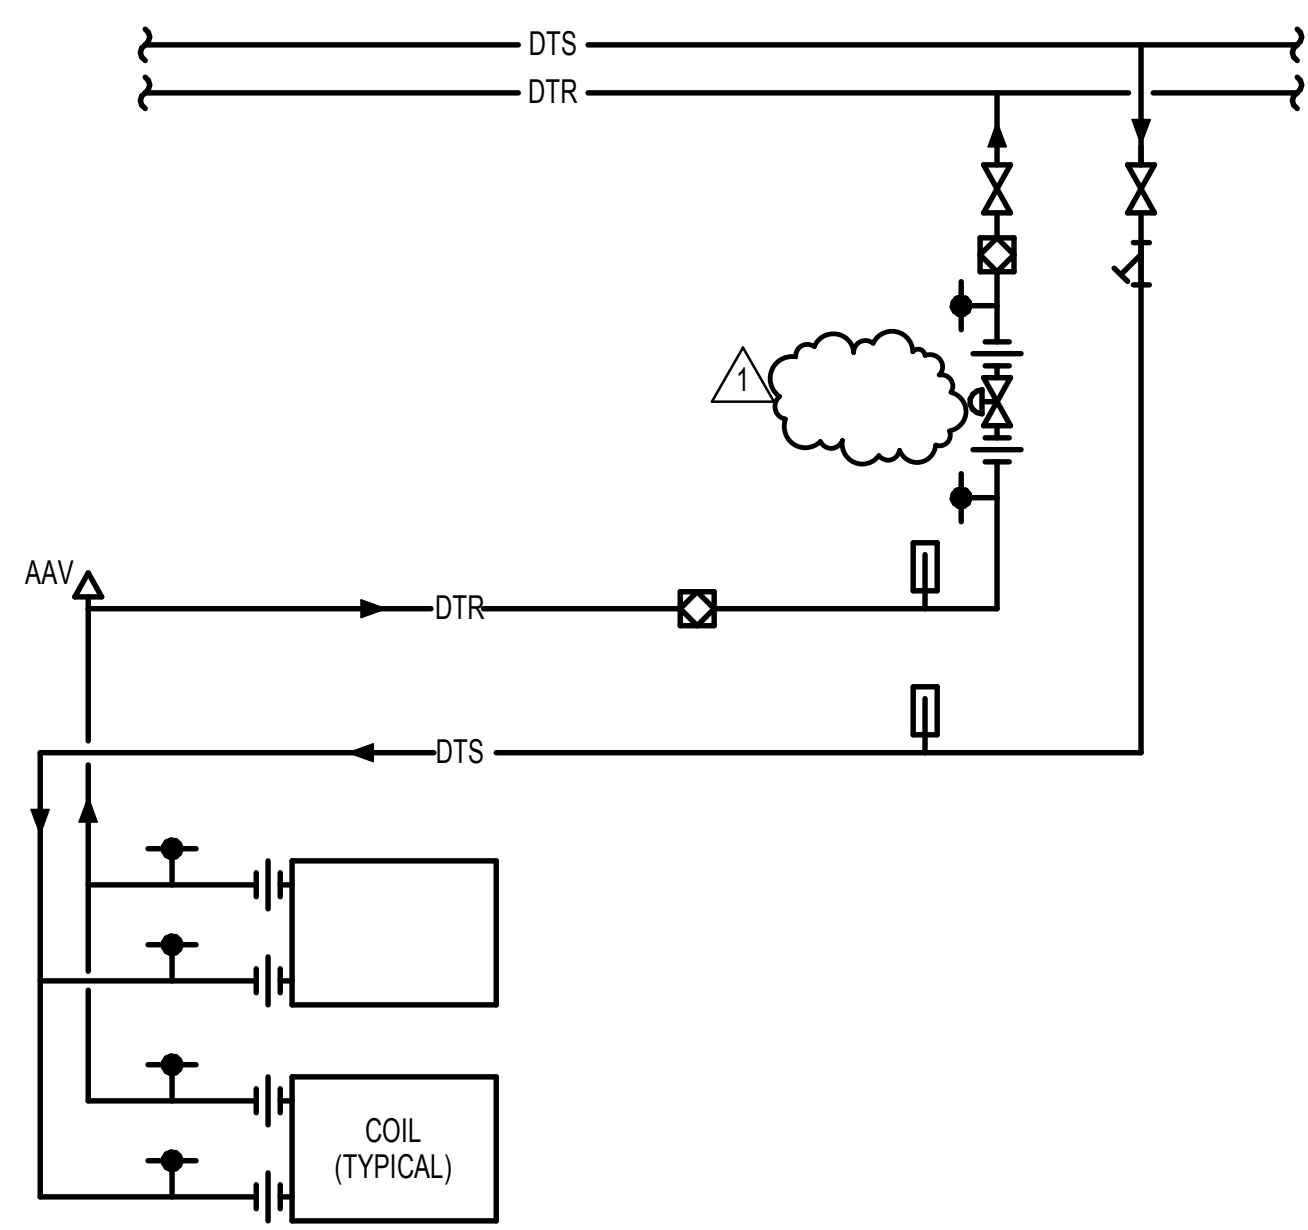

NOTES:
 1. OFFSET PIPING AT COIL ENDS TO ALLOW REMOVAL OF COILS.
 2. THREE OR MORE COILS PIPED SIMILAR.


GENERAL NOTE:
 1. TYPICAL FOR UNIT 2000 CFM AND GREATER. SEE B2/M502 FOR OTHER LOCATIONS.

D1 AHU COIL PIPING
 NONE

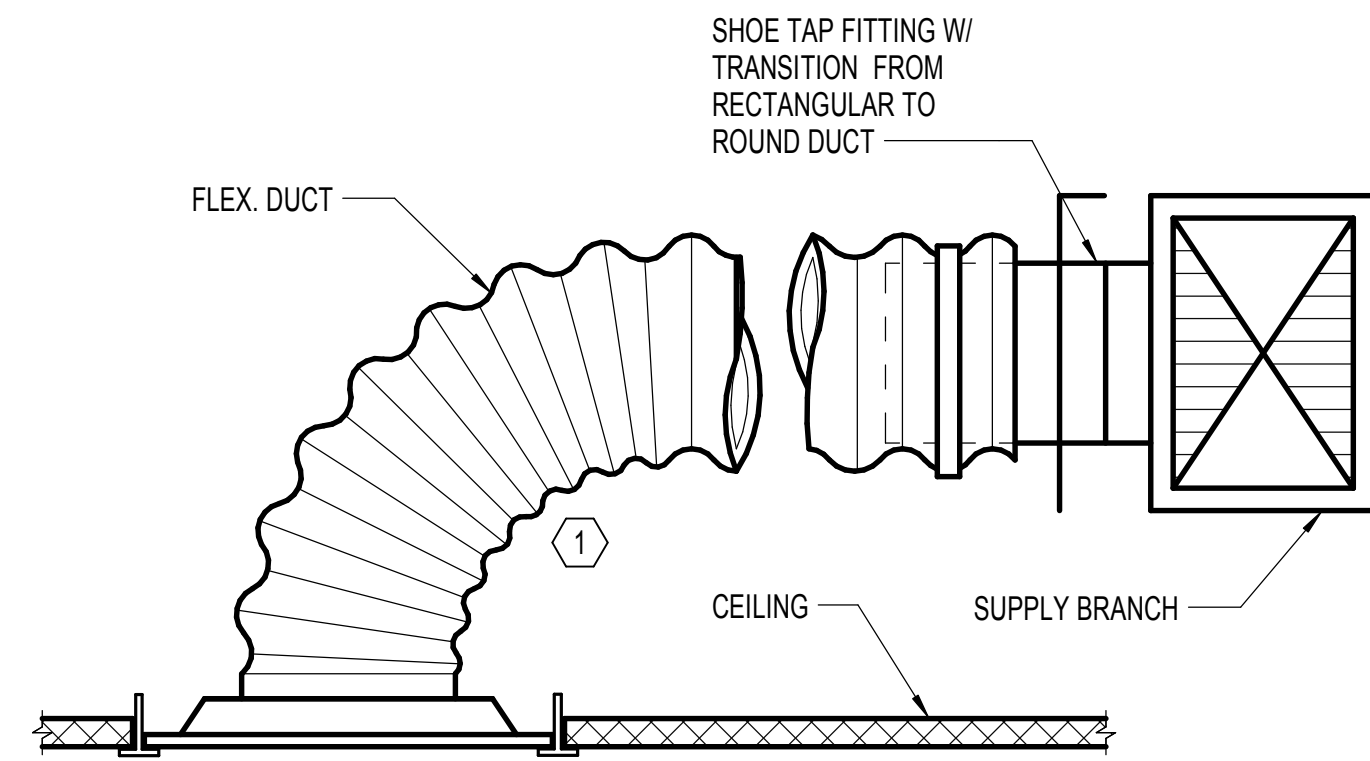


NOTES:
 1. 1.5 DIA. MINIMUM FLEX DUCT RADIUS (4' MAX LENGTH). WHERE 1.5 DIA. TURN CAN NOT BE MET USE DETAIL 9/M501

D2 TYPICAL ROUND NECK T-BAR DIFFUSER
 NONE

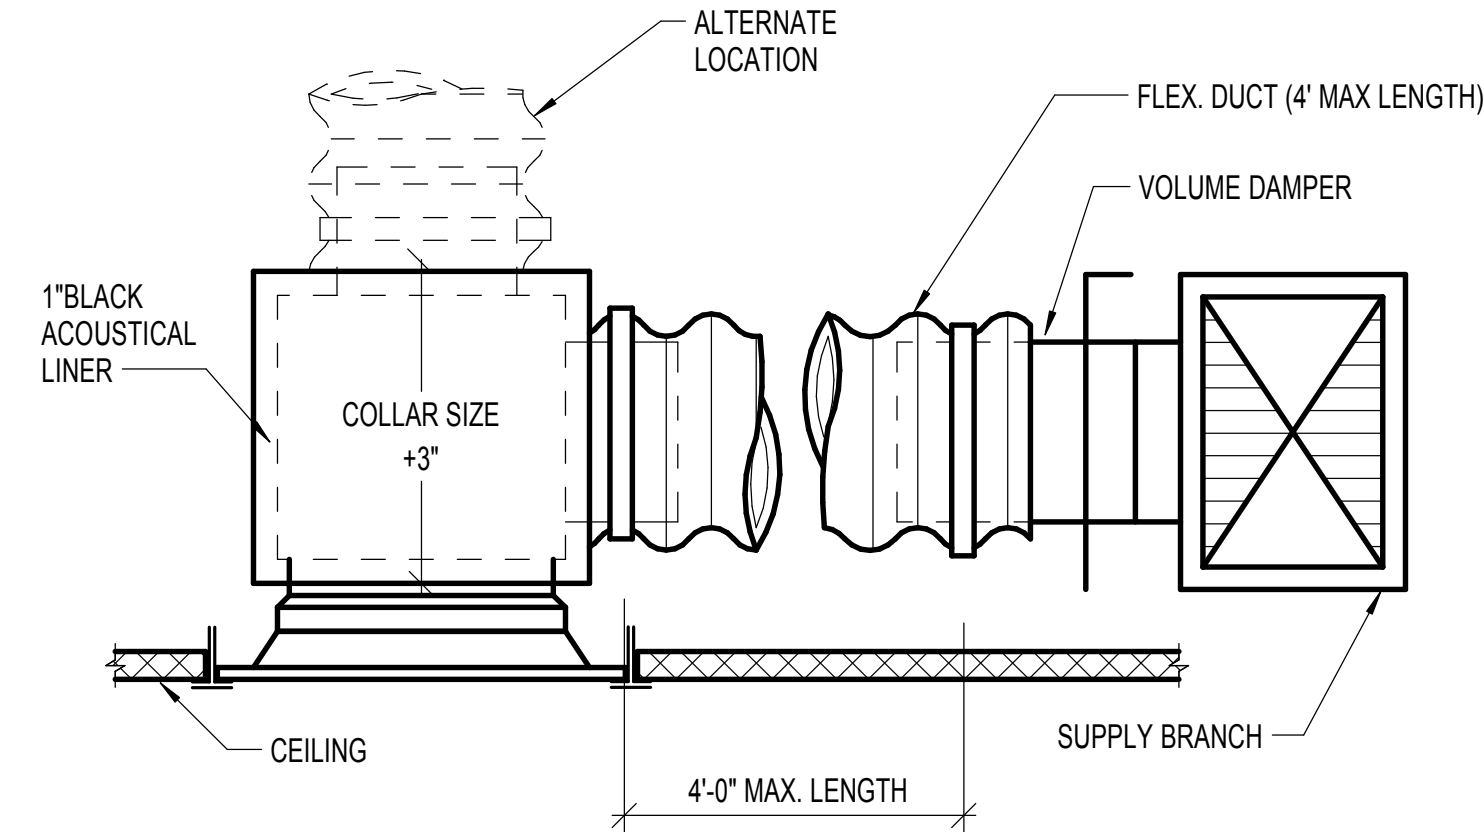


C2 TYPICAL SQUARE NECK T-BAR DIFFUSER
 NONE

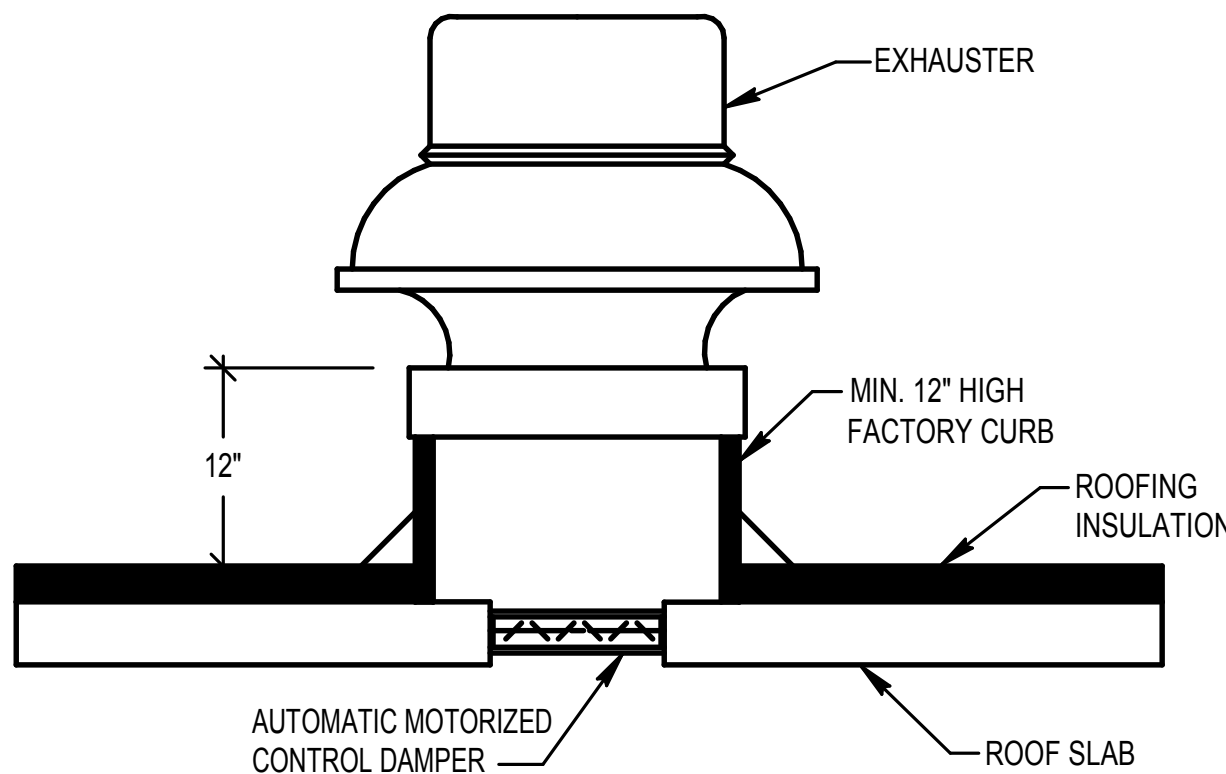


GENERAL NOTES:
 1. SEE SPECIFICATIONS FOR VIBRATION ISOLATION AND SEISMIC RESTRAINT.

B1 ROOF EXHAUSTER
 NONE

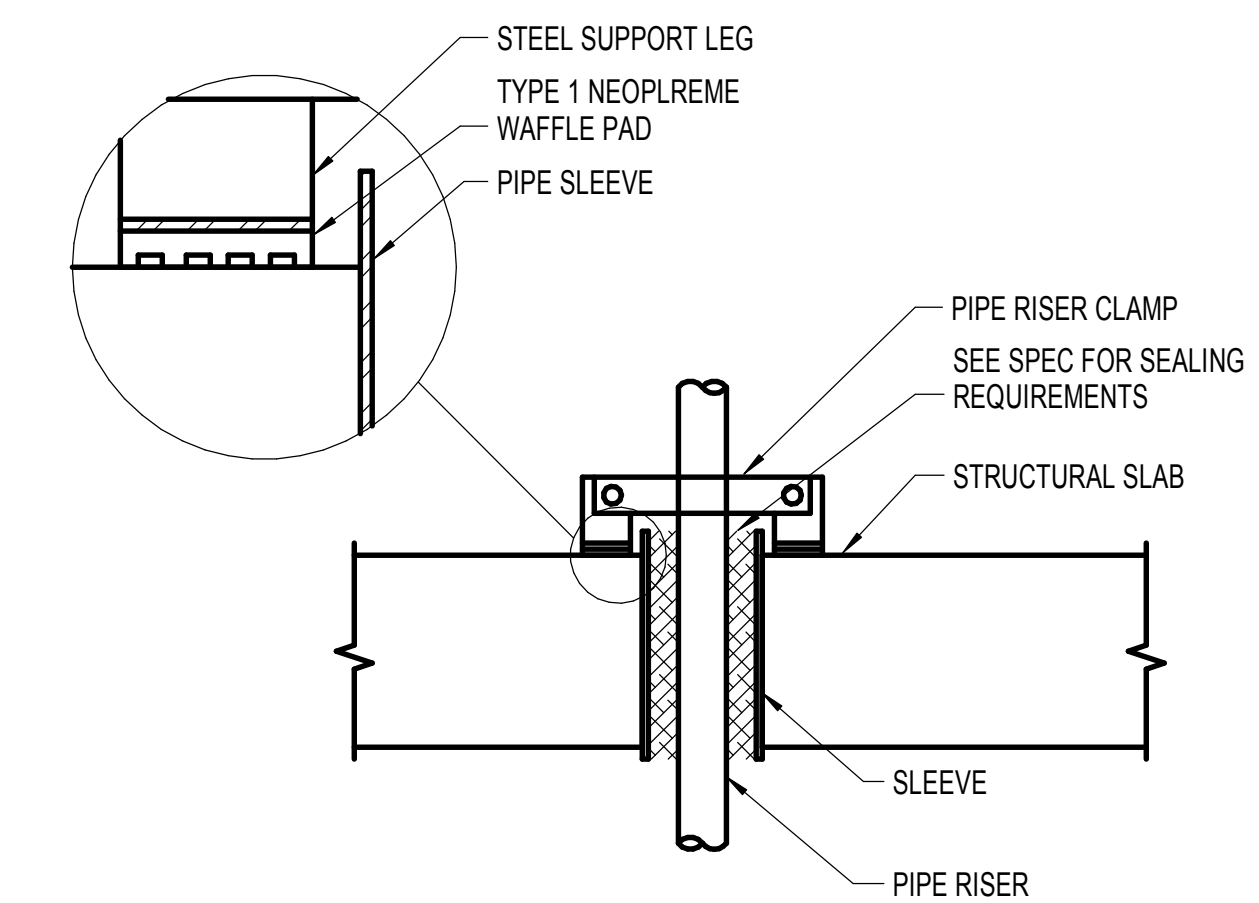


B2 PIPE RISER SUPPORT
 NONE

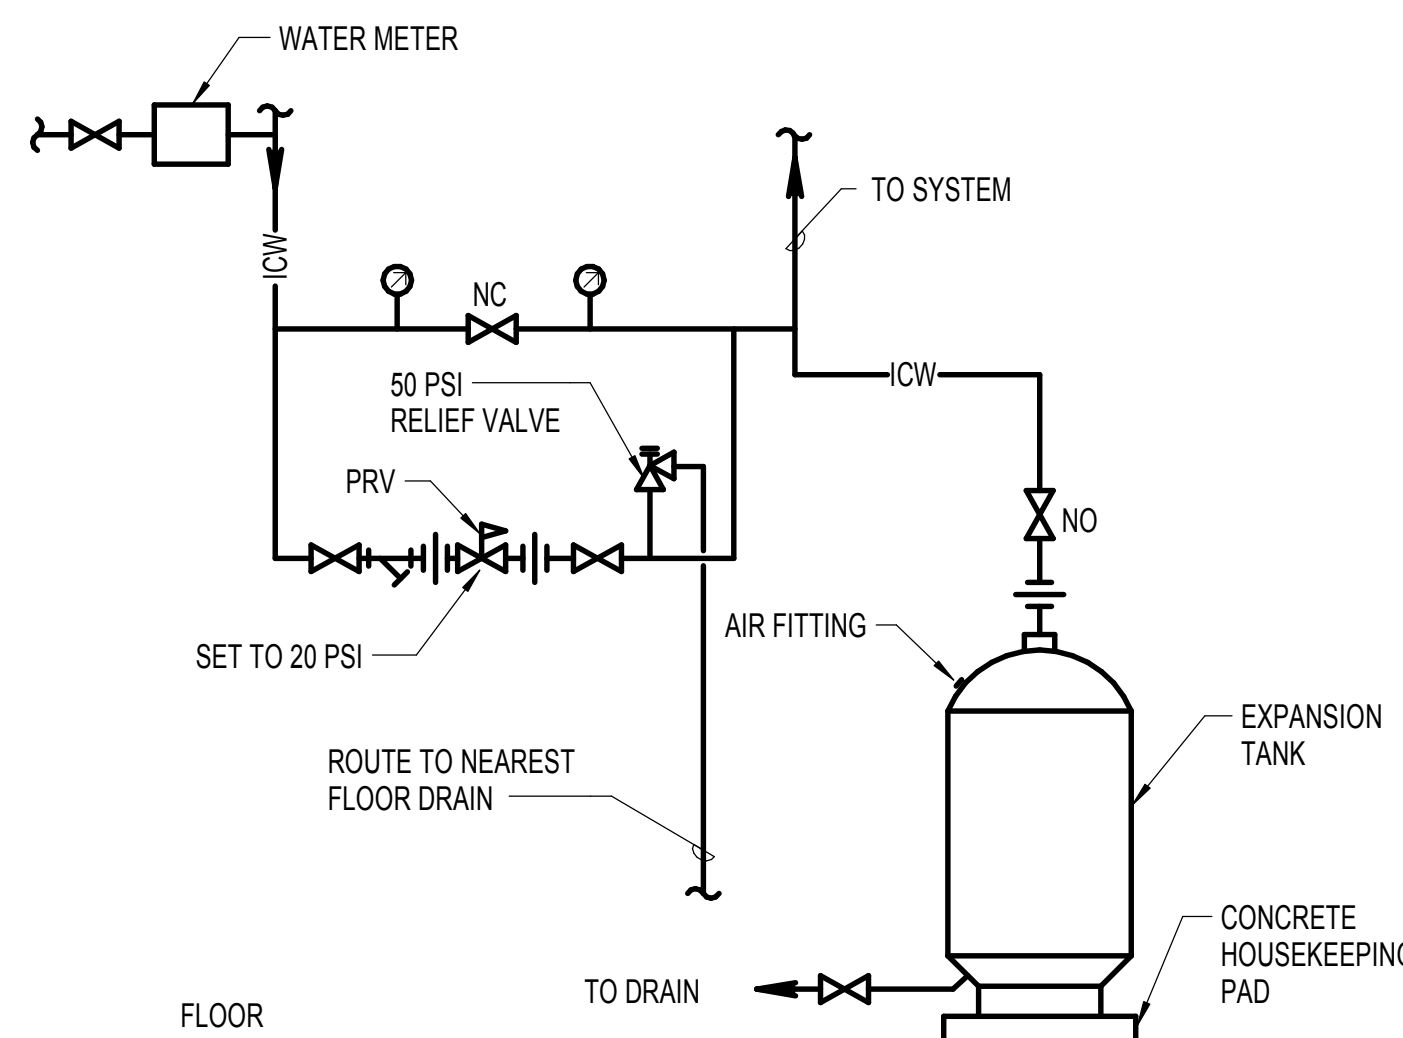


NOTES: 1. SEE SPECIFICATIONS FOR SEISMIC RESTRAINT REQUIREMENTS.

A2 EXPANSION TANK CONNECTION
 NONE

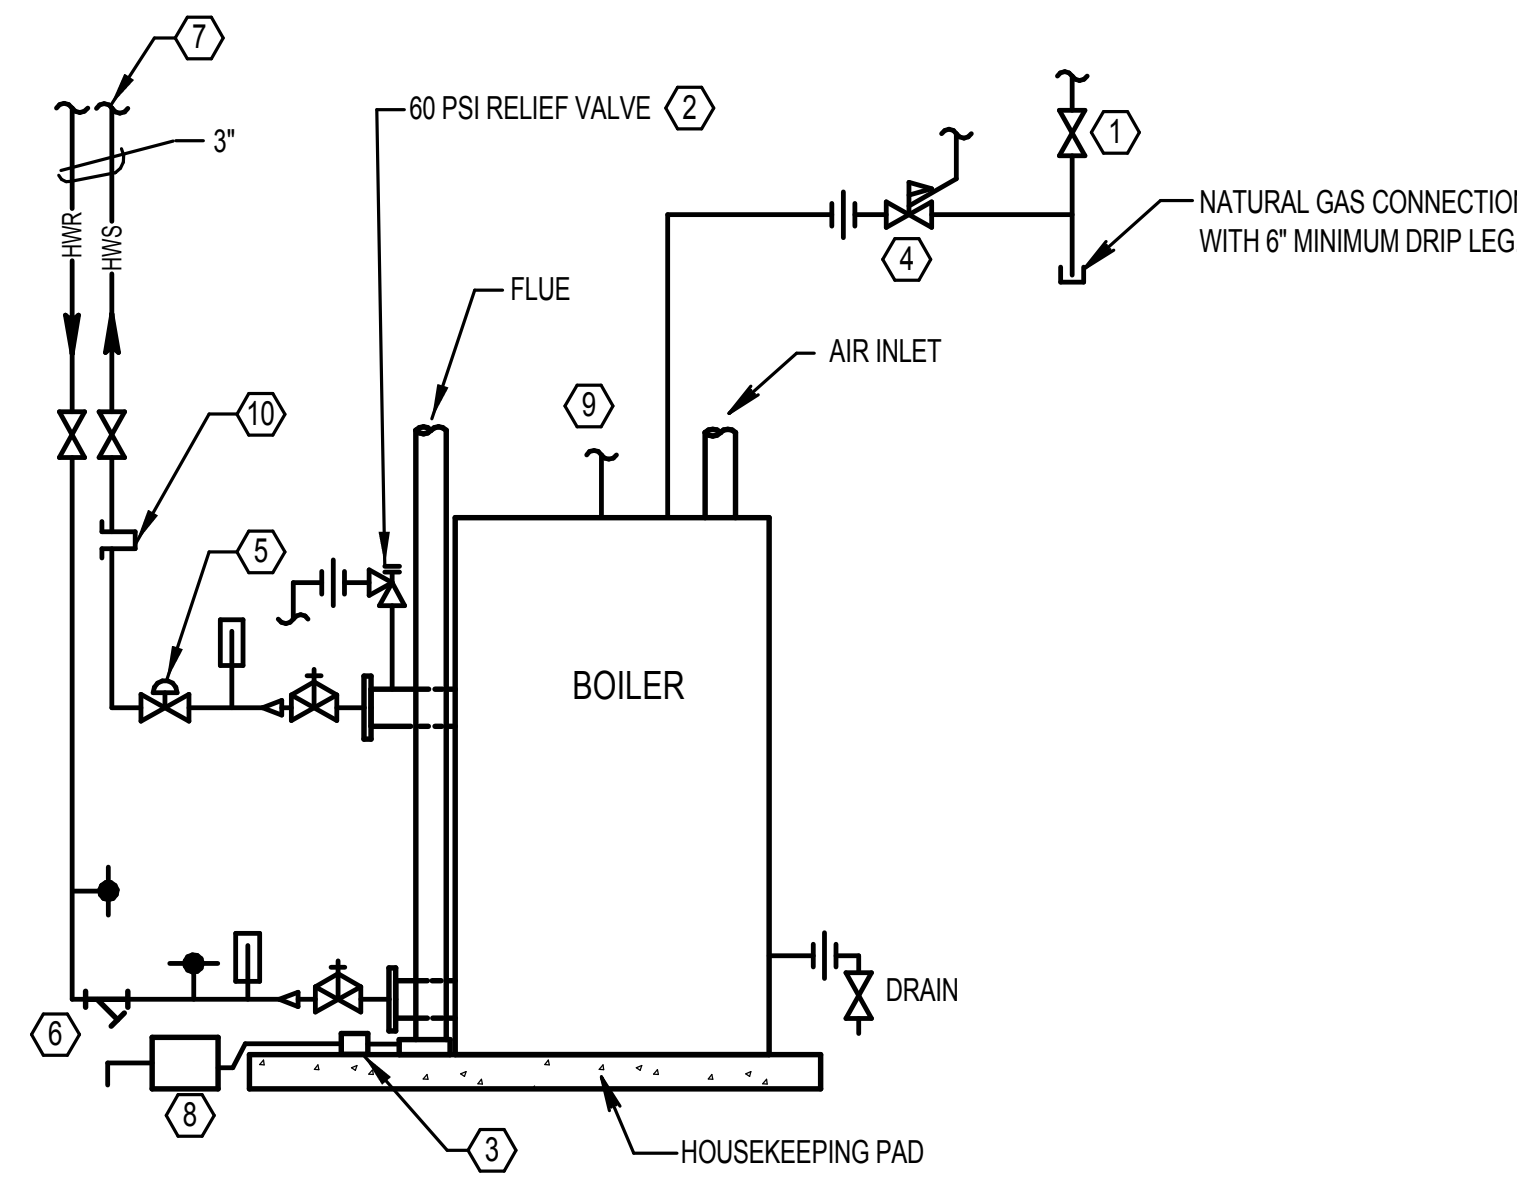


NOTES:
 1. GAS COCK
 2. ROUTE RELIEF PIPING TO WITHIN 6 INCHES OF FLOOR.
 3. CONNECT TRAP TO BOILER WITH TUBING FURNISHED WITH BOILER.
 4. PRESSURE REGULATOR - VENT TO OUTDOORS. SIZE OF VENT BY BOILER SUPPLIER. MIN. 10 FEET TO BOILER CONNECTION.
 5. MOTORIZED AUTOMATIC ISOLATION VALVE, FURNISHED WITH BOILER.
 6. PROVIDE STAINLESS STEEL 30 MESH SCREEN.
 7. PIPE ALL BOILERS IN IDENTICAL LAYOUT TO PROVIDE EQUAL PRESSURE DROPS.
 8. PH NEUTRALIZER - ROUTE OUTLET TO FLOOR SINK
 9. PROPANE PIPING SAME AS NAT GAS, BOILER B-2 ONLY.
 10. THERMOWELL FOR TEMPERATURE SENSOR.

C3 BOILER PIPING
 NONE

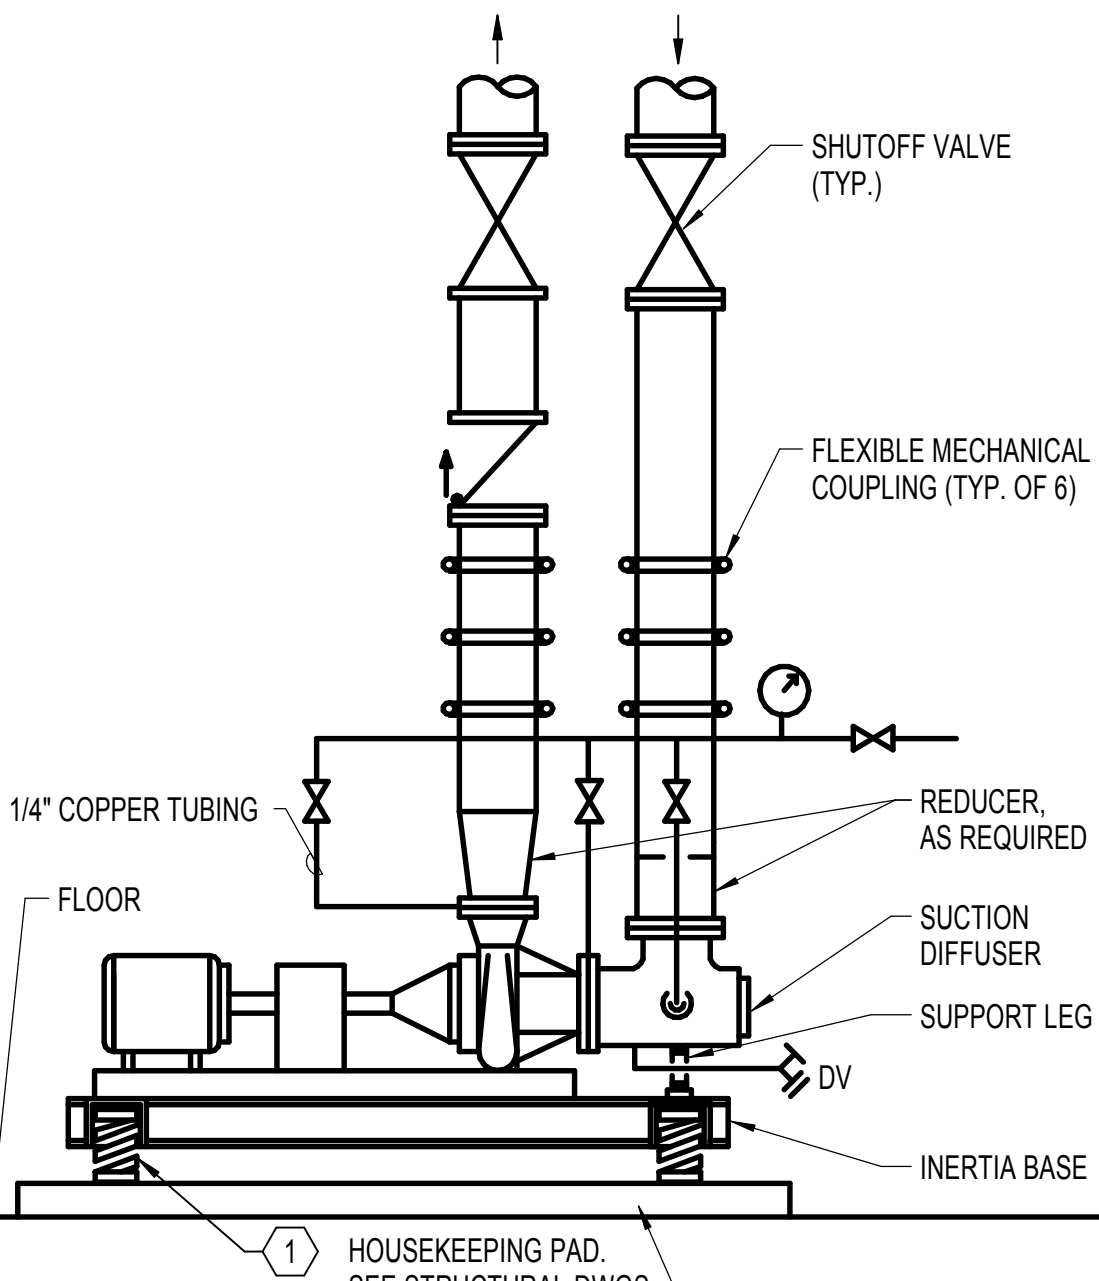


NOTE:
 1. SEE SPECIFICATIONS FOR VIBRATION ISOLATION AND SEISMIC RESTRAINT.

B3 BASE MOUNTED PUMP PIPING
 NONE

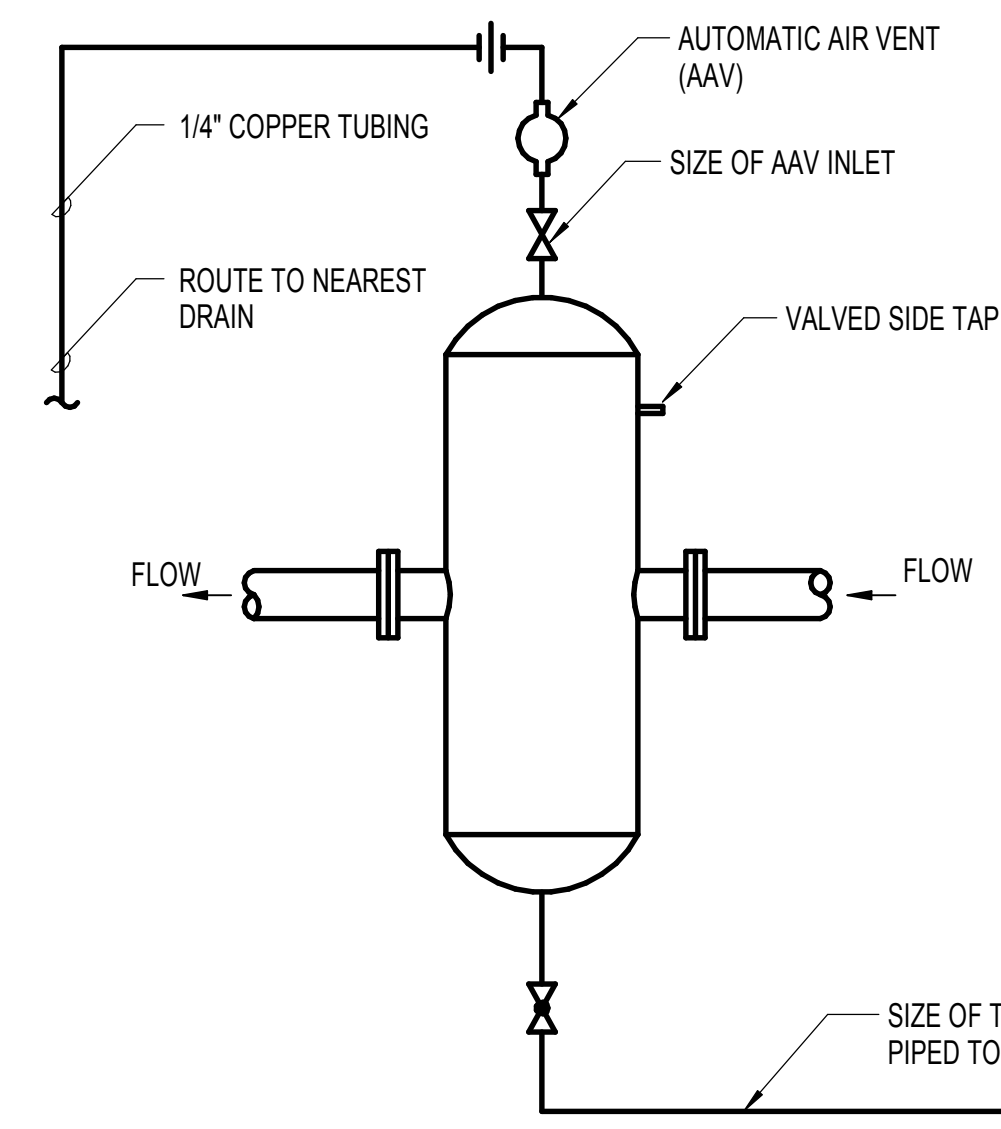


A3 AIR/DIRT SEPARATOR - HIGH EFFICIENCY COALESCING
 NONE

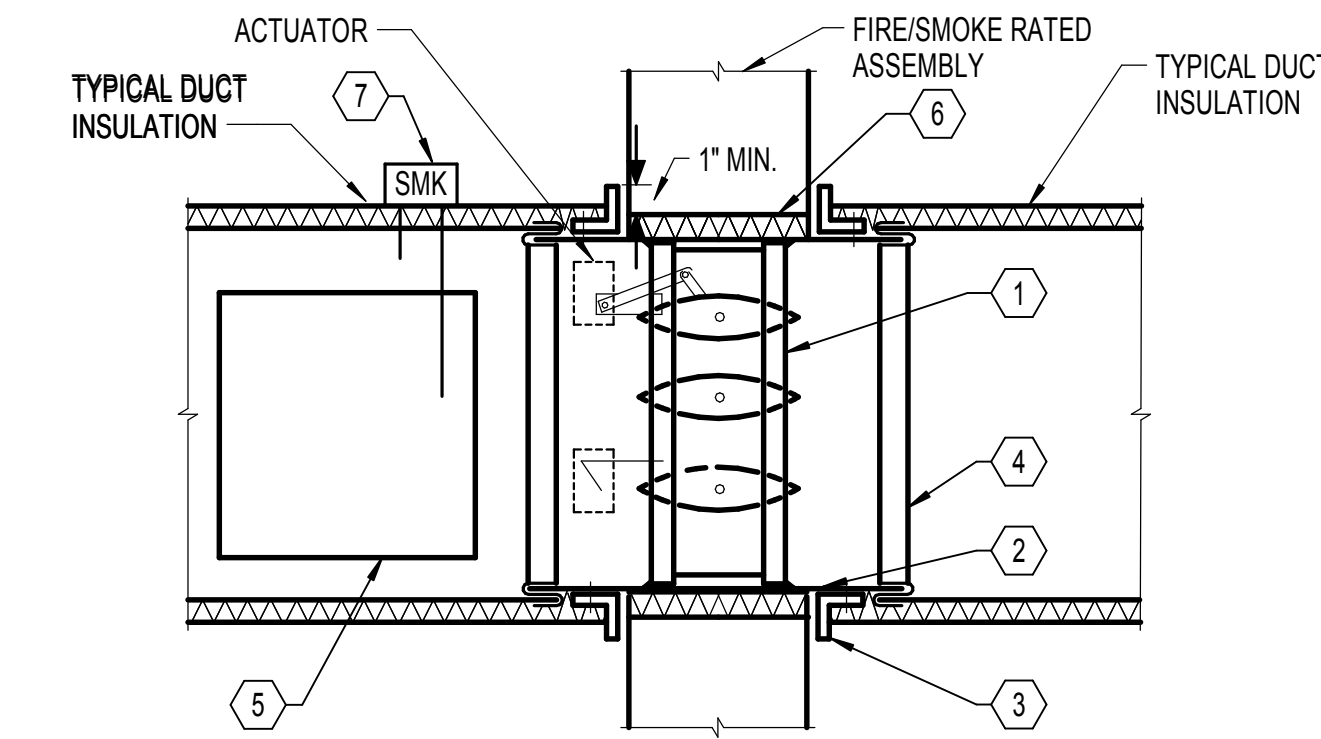


NOTES:
 1. COMBINATION FIRE AND SMOKE DAMPER.
 2. GALVANIZED STEEL SLEEVE-GAUGE NOT LESS THAN CONNECTION DUCT. FASTEN TO DAMPER FRAME AND PERIMETER ANGLES. CAULK BETWEEN DAMPER FRAME & SLEEVE.
 3. PERIMETER ANGLES-14 GA. GALVANIZED STEEL, 1 1/2" x 1 1/2" MIN. TO PROVIDE 1" MIN. OVERLAP OF OPENING ON ALL 4 SIDES. DO NOT FASTEN TO PARTITION.
 4. AIR TIGHT, BREAKAWAY DUCT CONNECTION.
 5. ACCESS PANEL SIZE & LOCATION TO PERMIT SERVICING FUSIBLE ROD AND LINK. ACTUATOR TO BE LOCATED OUT OF AIR STREAM. LOCATE PANEL WITHIN 12" OF FSD.
 6. PROVIDE 15/16" TO 1/2" CLEARANCE ON HEIGHT & WIDTH, OR AS SPECIFIED BY DAMPER MANUFACTURER. FILL OPENING WITH FIRESTOP MATERIAL.
 7. SMOKE DETECTOR FURNISHED PER DIVISION 26, INSTALLED PER DIVISION 23. POWER WIRING PER DIVISION 26, CONTROL WIRING PER DIVISION 28.

D5 COMBINATION FIRE/SMOKE DAMPER
 NONE

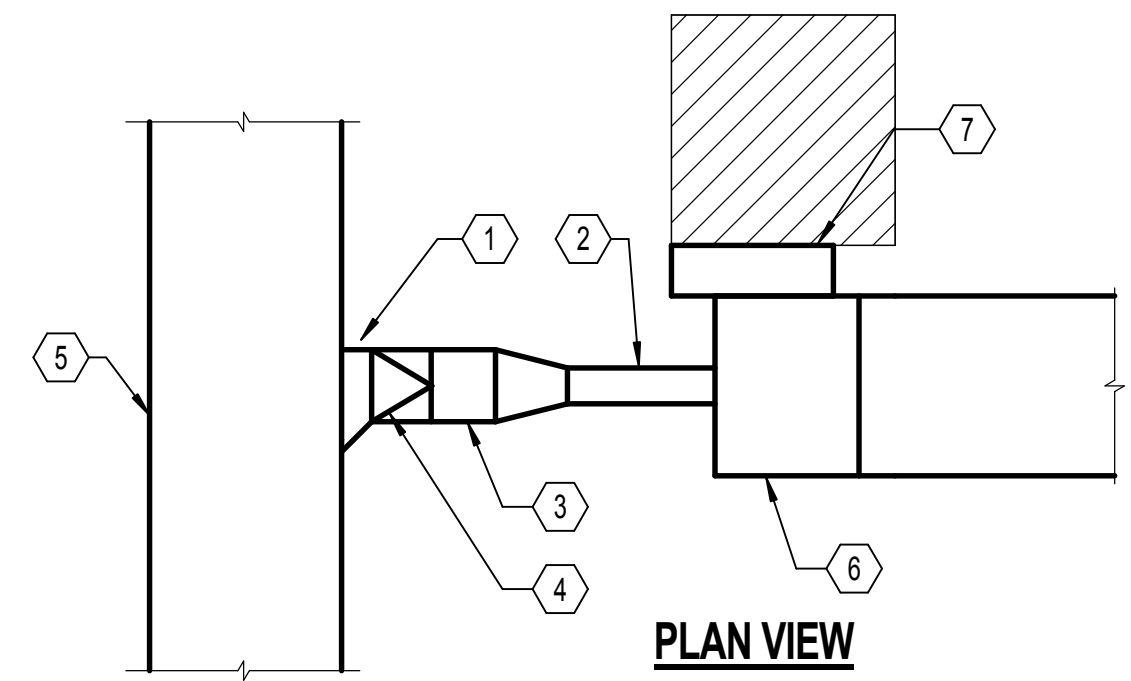


NOTES:
 1. RECTANGULAR SHOE TAP FITTING
 2. INLET DUCT. MINIMUM STRAIGHT LENGTH = 3'-0". DUCT SIZE TO BE SAME SIZE AS TERMINAL UNIT INLET. FLEXIBLE DUCT CONNECTIONS ARE NOT ALLOWED.
 3. BRANCH DUCT. IF UNDER 5'-0" IN LENGTH, DUCT SIZE TO BE SAME SIZE AS TERMINAL UNIT INLET. IF LENGTH IS 5'-0" OR OVER, DUCT SIZE TO BE AS SHOWN ON PLAN.
 4. ROUND TO RECTANGULAR TRANSITION.
 5. RECTANGULAR LOW-PRESSURE SUPPLY DUCT.
 6. TERMINAL UNIT
 7. CONTROL ENCLOSURE. PROVIDE 36" CLEARANCE DIRECTLY IN FRONT OF ENCLOSURE. MOUNT CONTROLS AND PIPING CONNECTIONS ON SAME SIDE OF UNIT.

B5 TYPICAL TERMINAL UNIT
 NONE

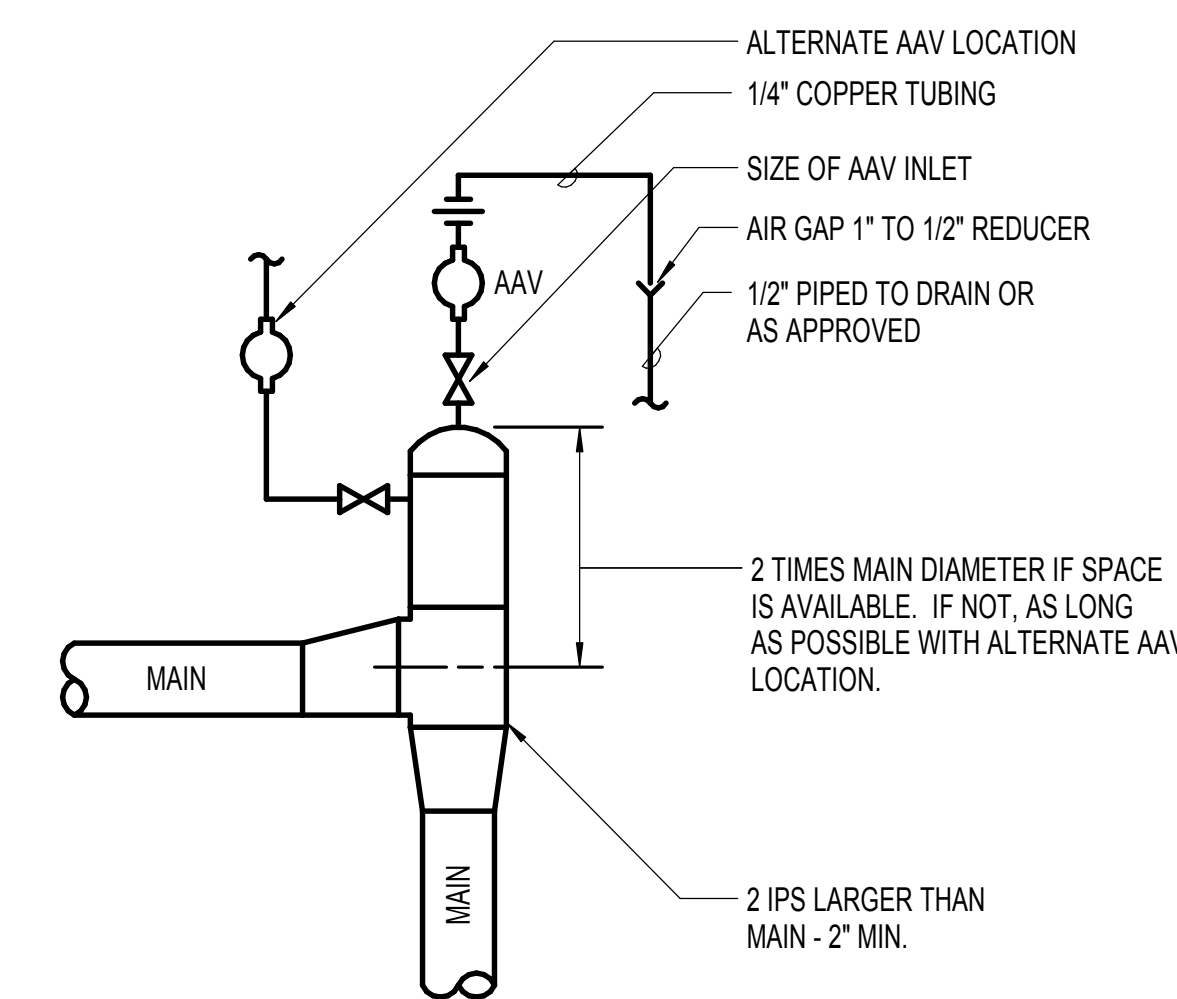


A5 AUTOMATIC AIR VENT
 NONE



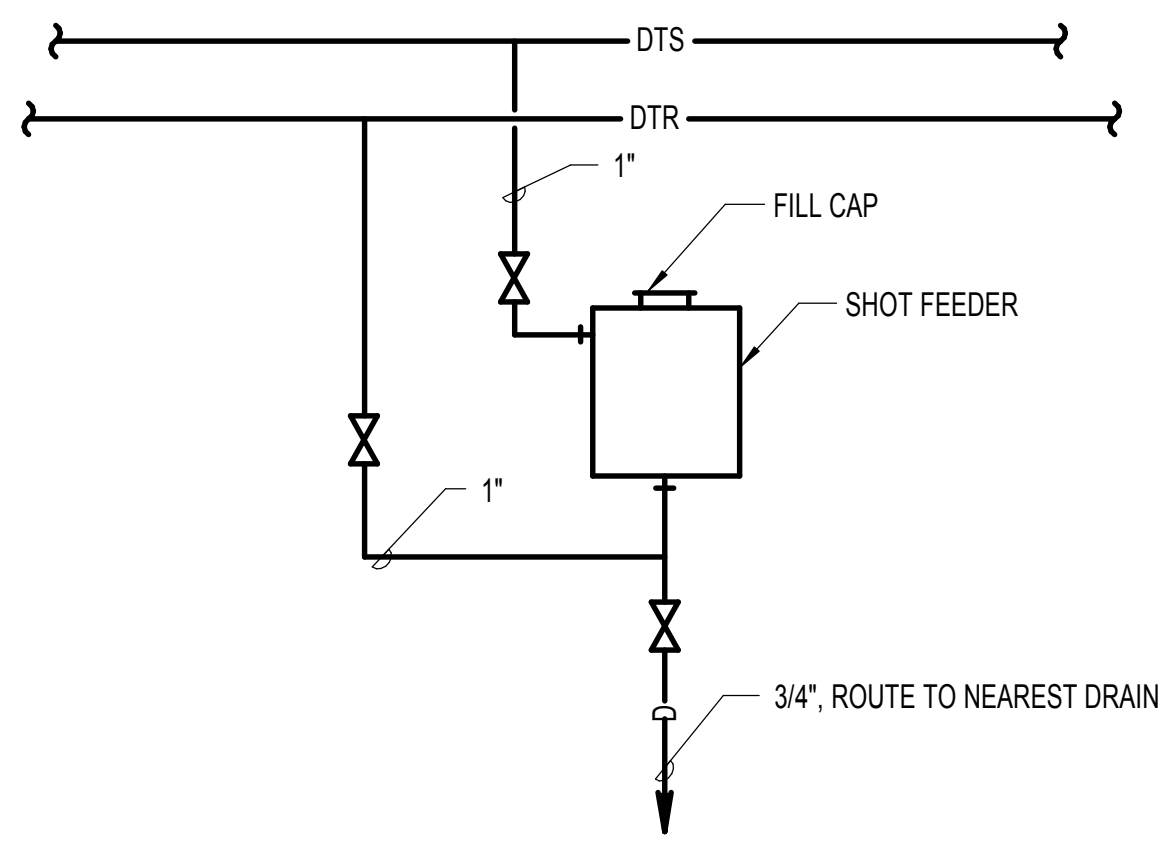


GENERAL NOTE:
1. INSULATE PIPING AND CHEMICAL FEEDER.

D1 BY-PASS CHEMICAL FEEDER
NONE

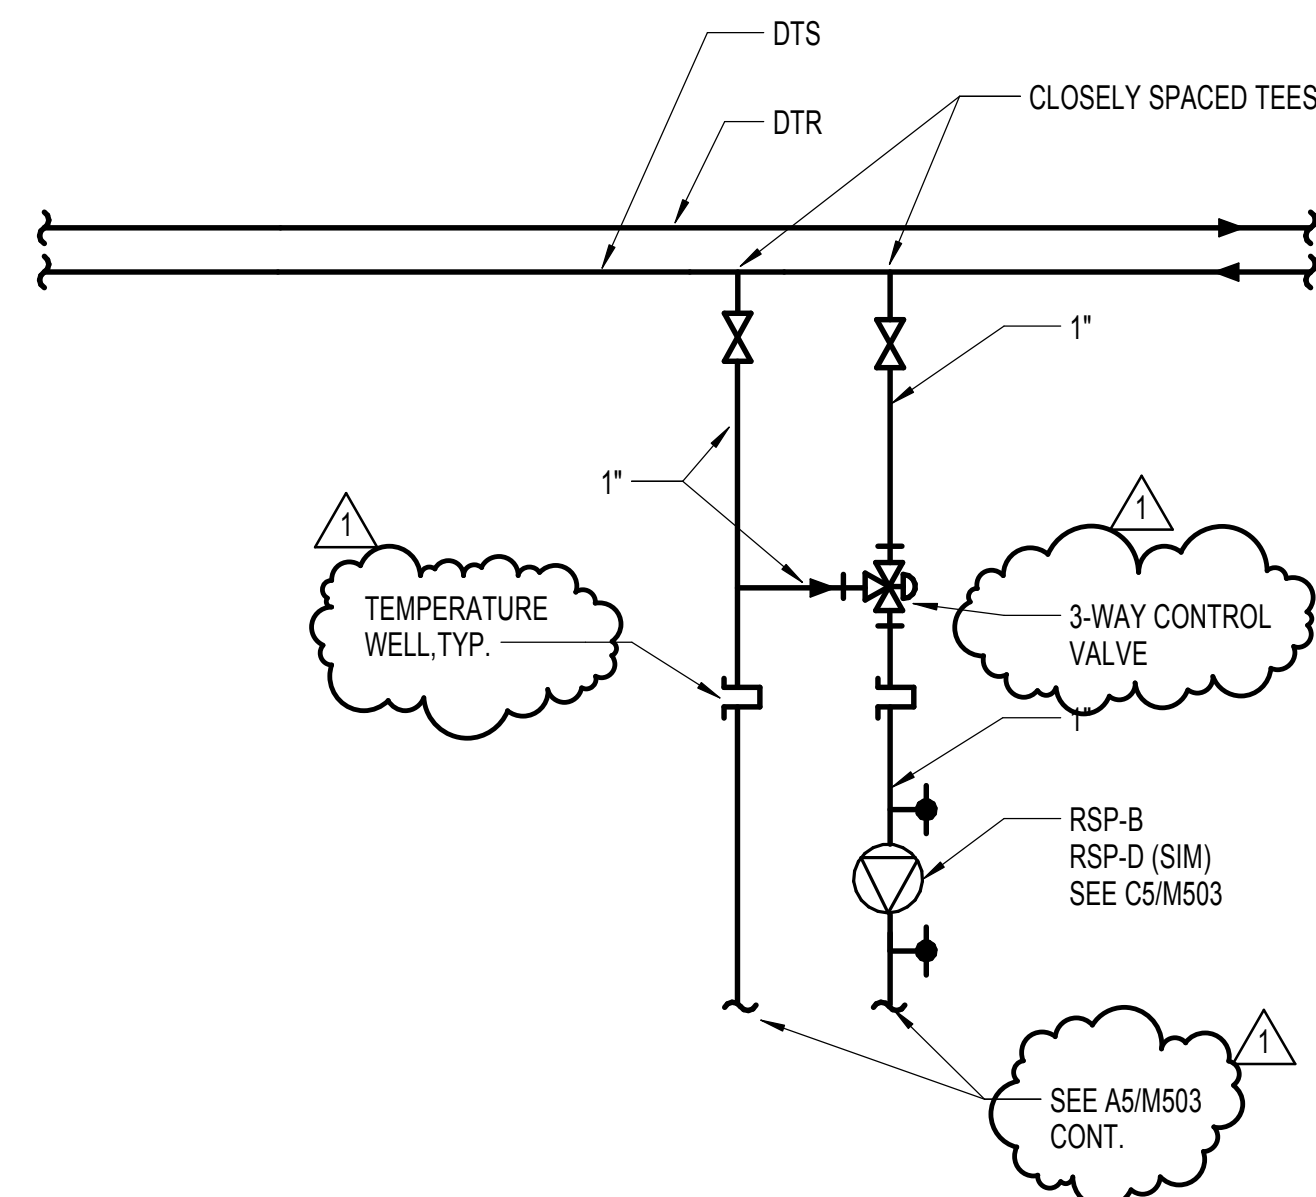


C1 RADIANT ZONE PUMPING DETAIL
NONE

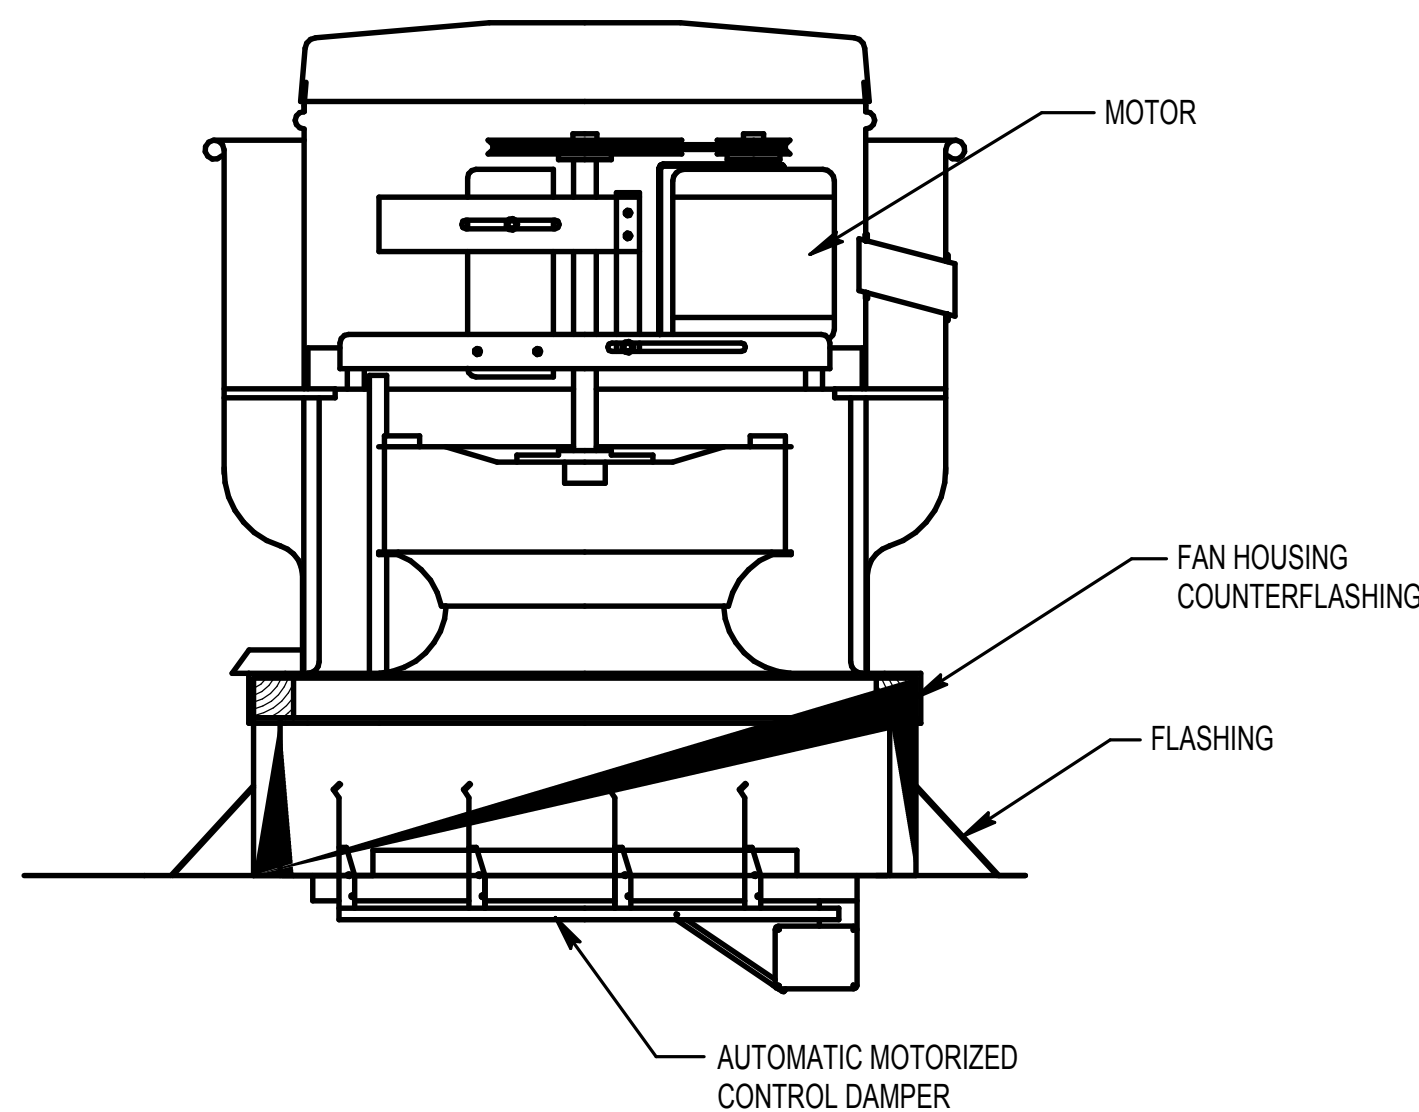


GENERAL NOTES:
1. SEE SPECIFICATIONS FOR VIBRATION ISOLATION AND SEISMIC RESTRAINT.

B1 DISHWASHER EXHAUST
1" = 0'-1"

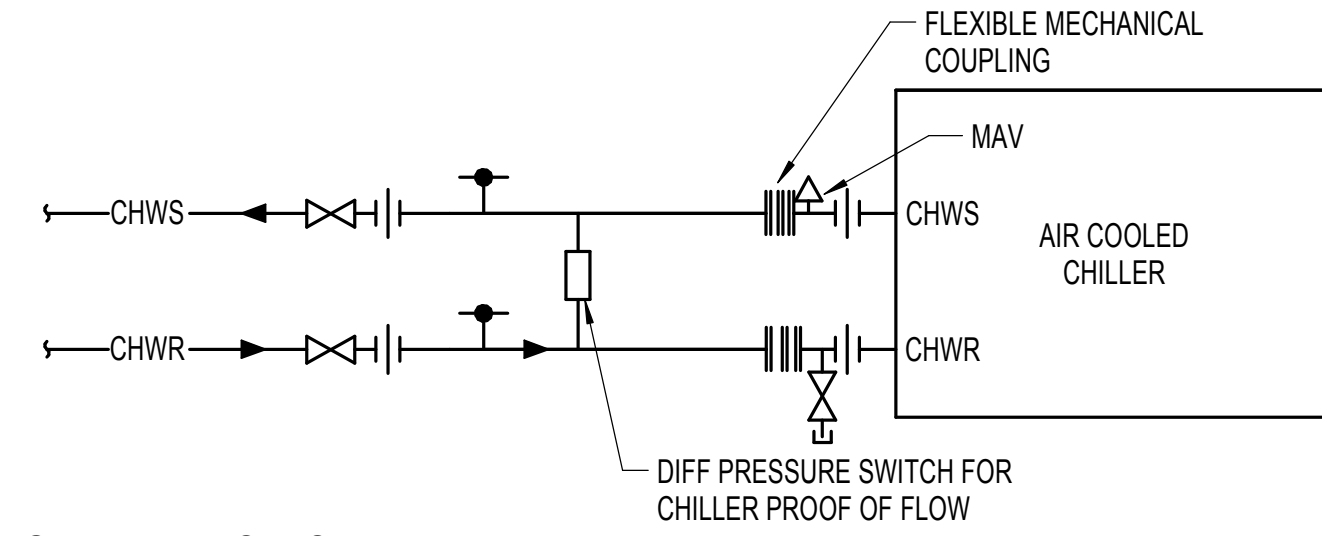


GENERAL NOTES:
1. INSTALL ALL PIPING TO ALLOW SERVICING AND REPAIR ACCESS. INCLUDE A UNION OR VICTALIC TYPE COUPLING IN PIPING AT A LOCATION IN EACH PIPE THAT ALLOWS PIPES TO BE EASILY REMOVED FOR TUBE BUNDLE MAINTENANCE.
2. VIBRATION ISOLATION AND SEISMIC RESTRAINT PER SPECS.

D2 CHILLER PIPING CONNECTIONS
NONE

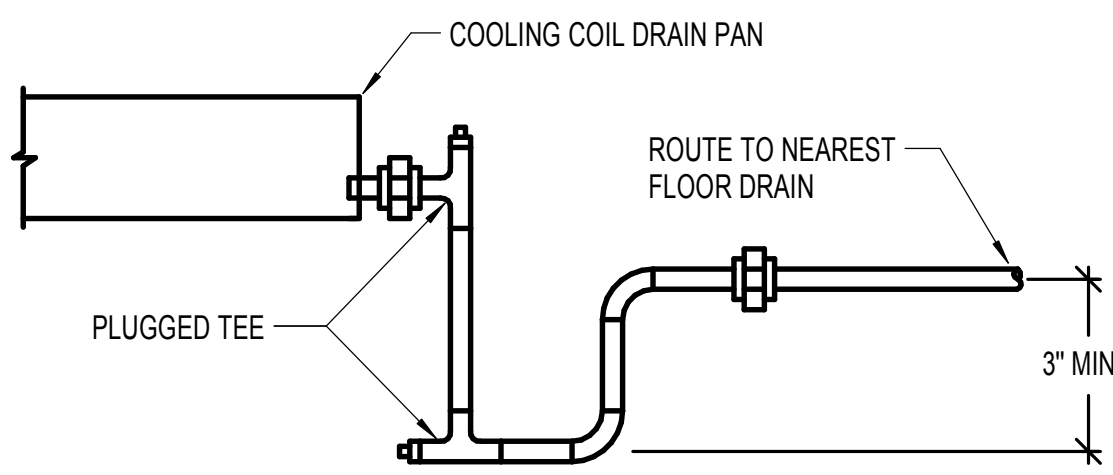


NOTES:
1. DRAIN SIZE IS OUTLET SIZE UNLESS SHOWN LARGER.

C2 COIL DRAIN PIPING
NONE


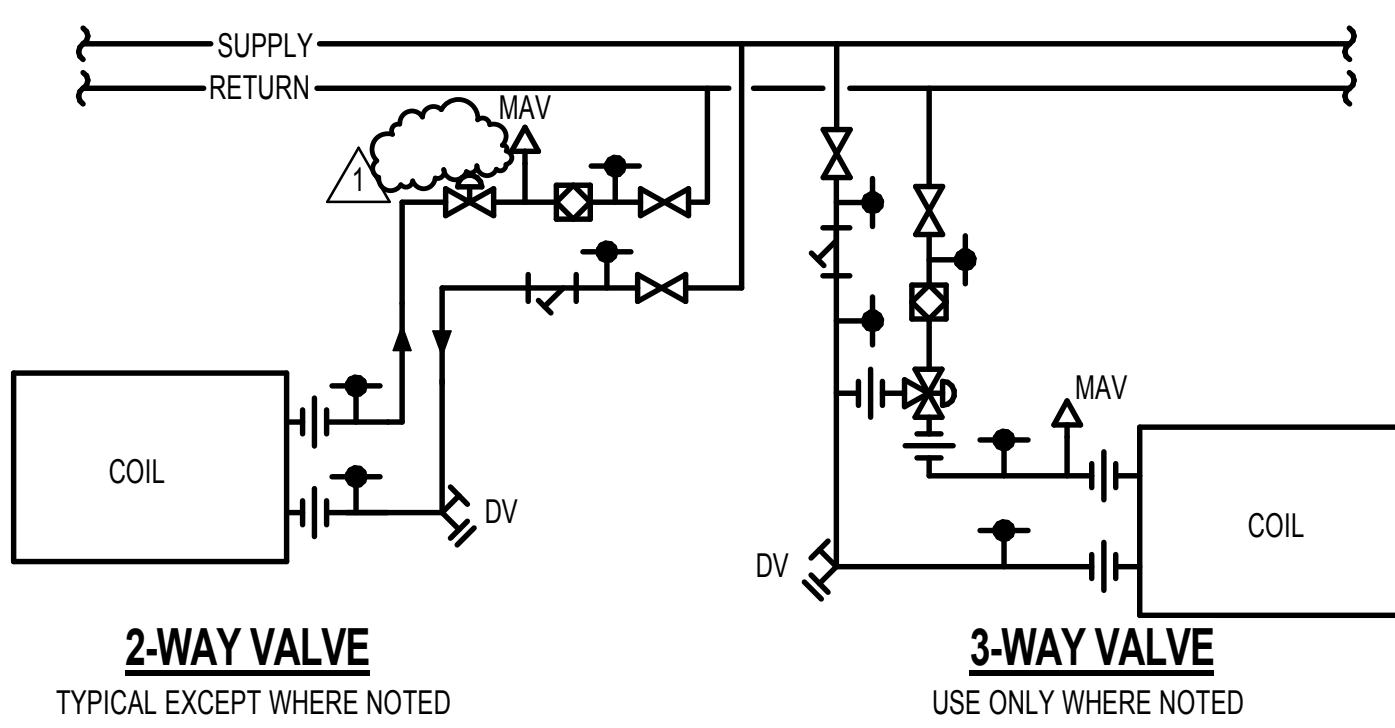


2-WAY VALVE
TYPICAL EXCEPT WHERE NOTED
NOTE:
1. TYPICAL OF DUCT COILS, SMALL AIR HANDLERS AND FAN COIL UNITS.


B2 DUAL TEMPERATURE COIL PIPING DETAIL
NONE

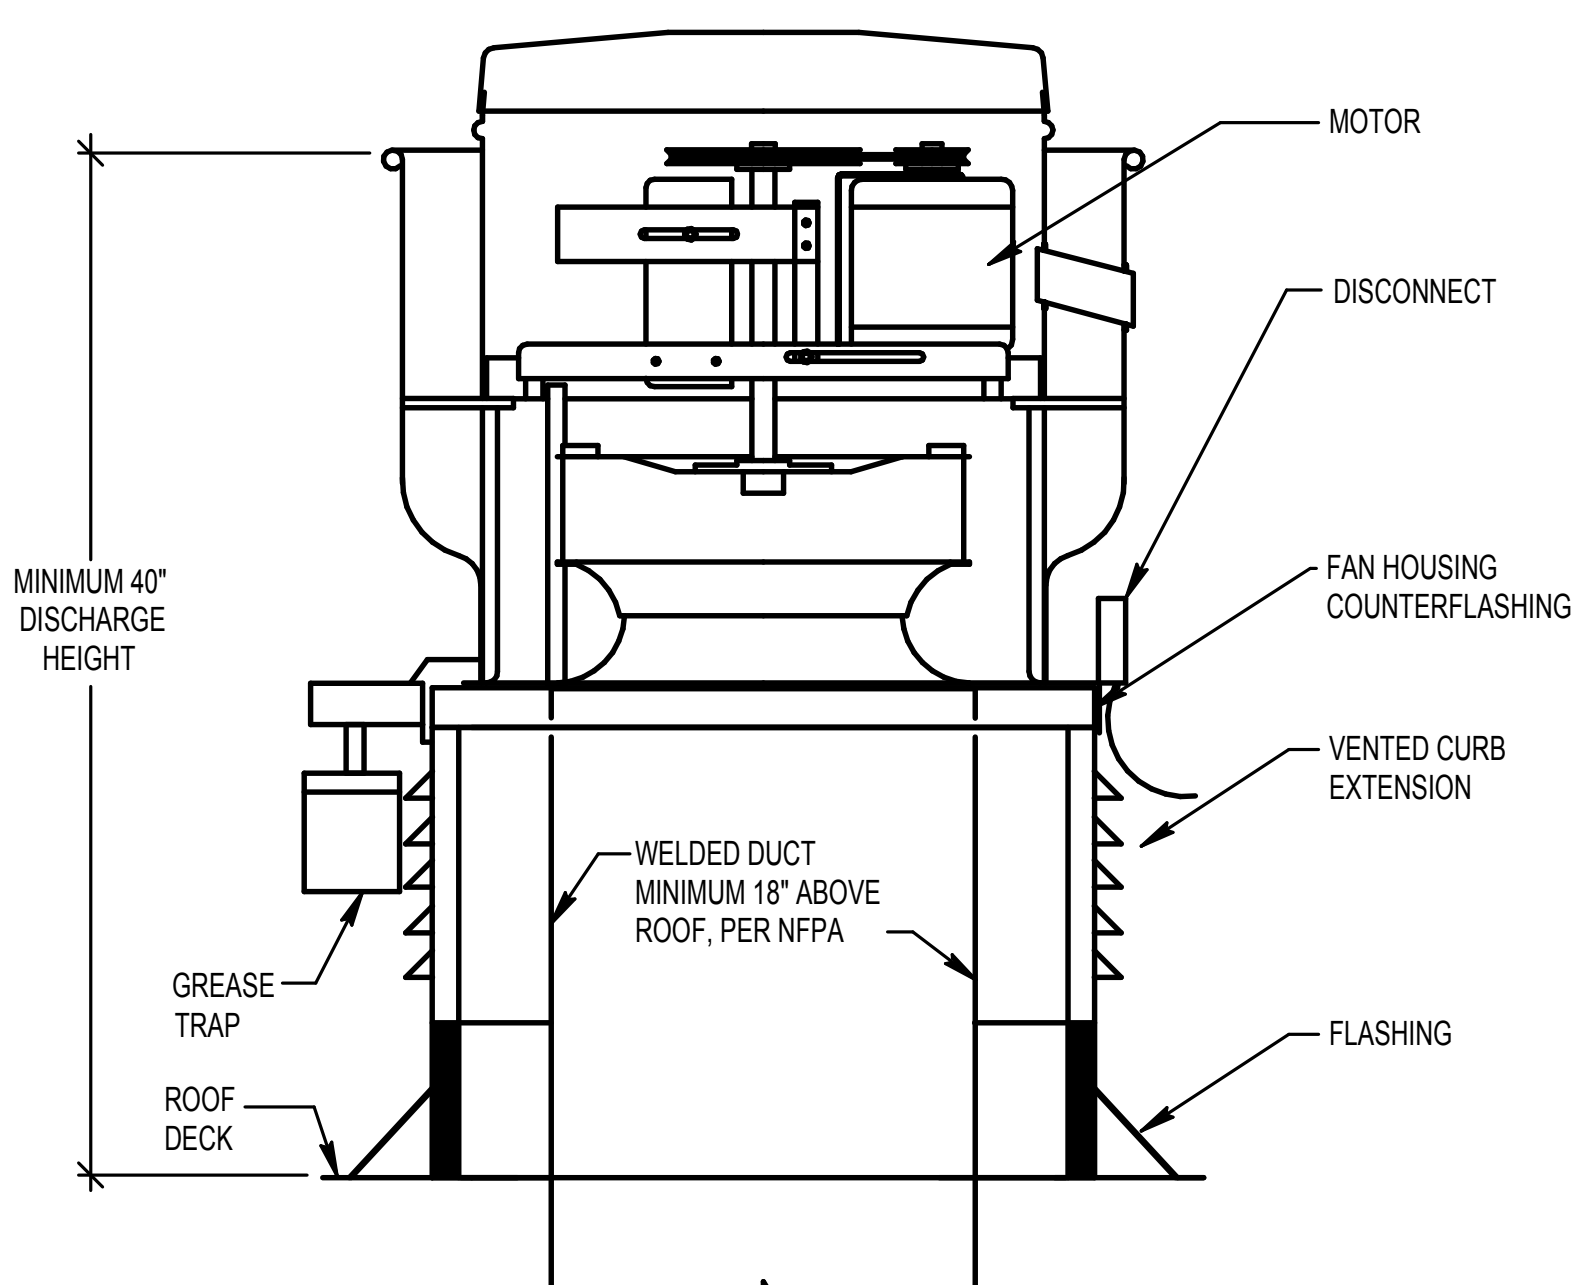

A2 KITCHEN EXHAUST FAN
NONE

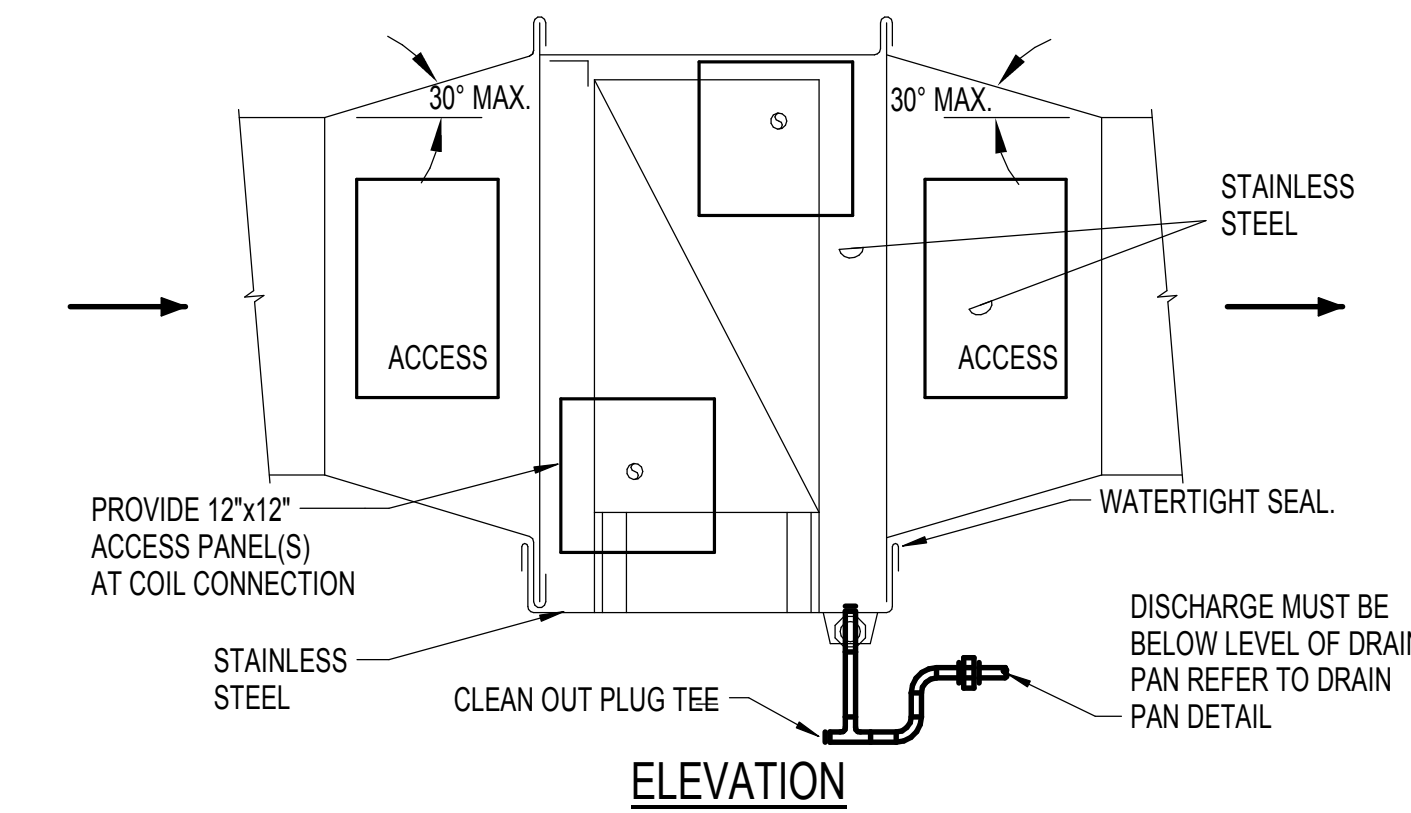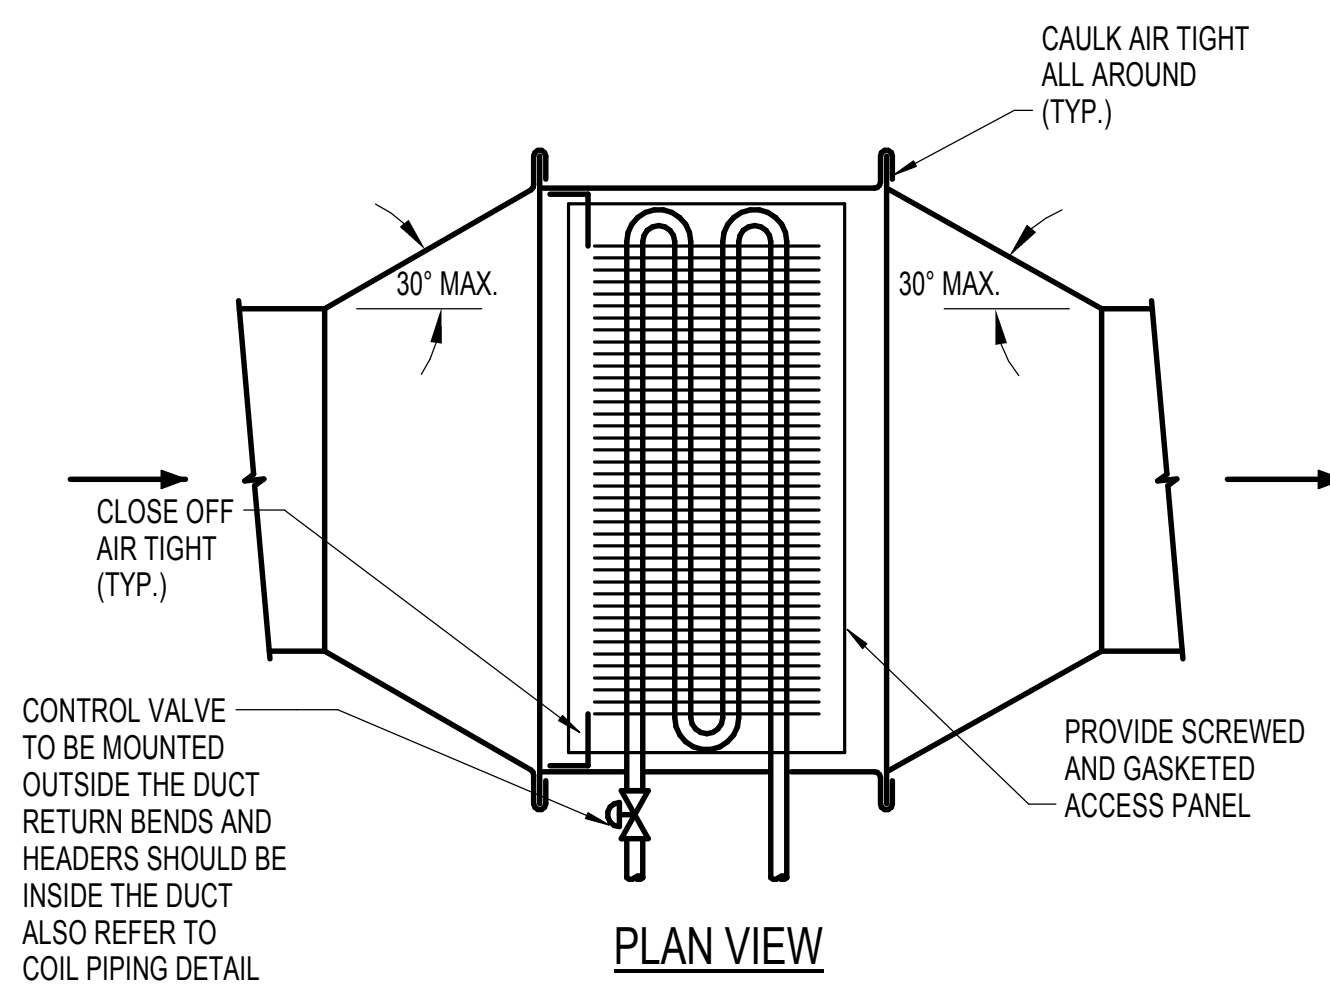

C4 DUCT COOLING COIL INSTALLATION
NONE

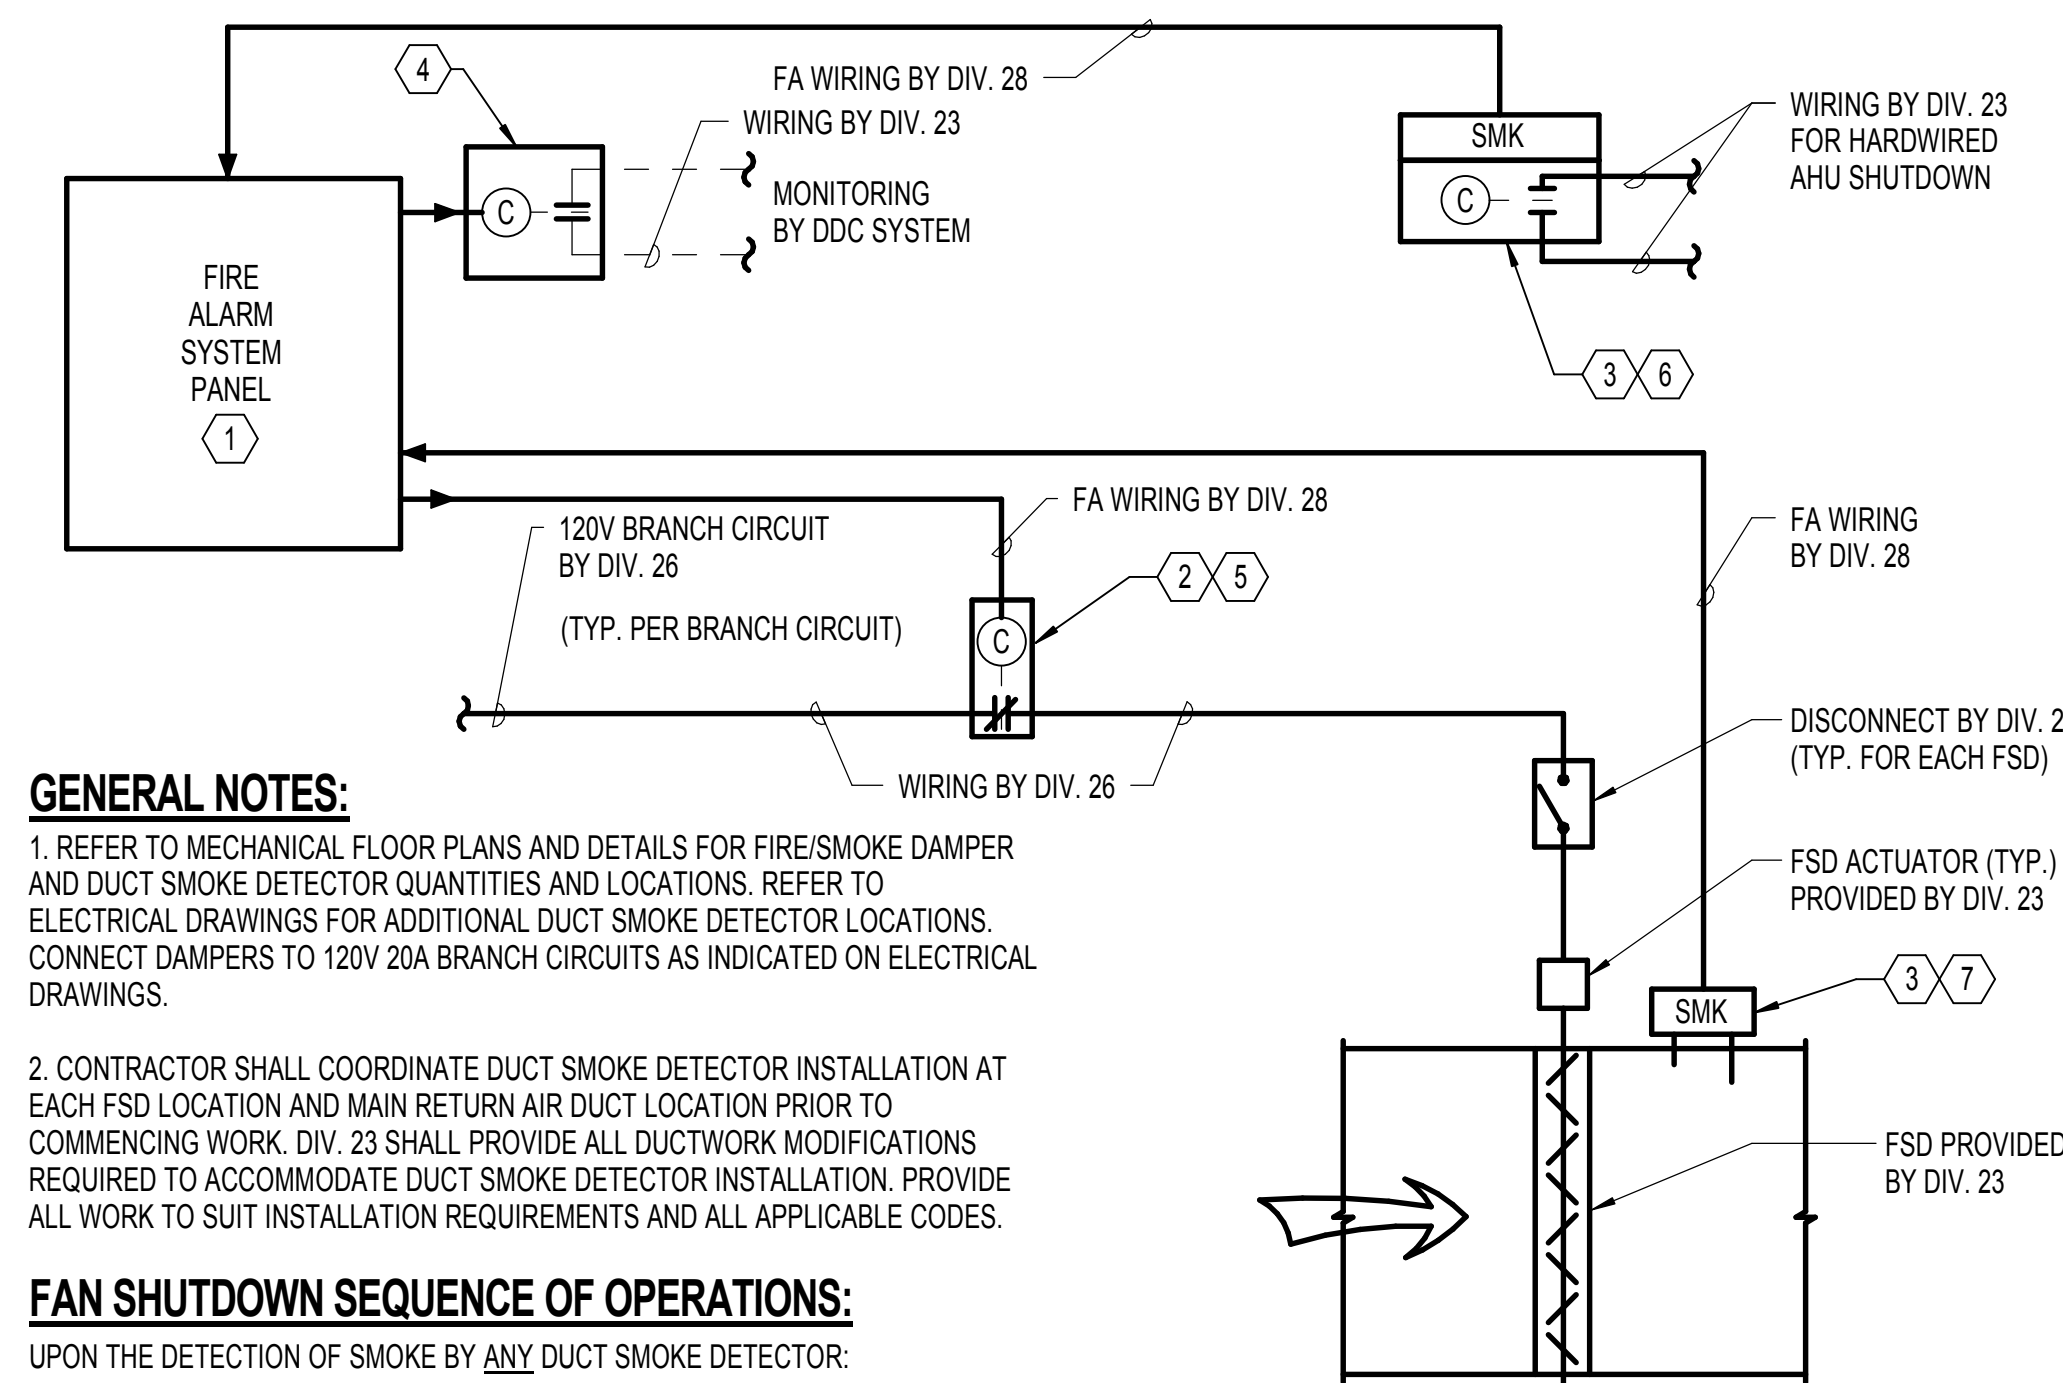

GENERAL NOTES:
1. REFER TO MECHANICAL FLOOR PLANS AND DETAILS FOR FIRE/SMOKE DAMPER AND DUCT SMOKE DETECTOR QUANTITIES AND LOCATIONS. REFER TO ELECTRICAL DRAWINGS FOR ADDITIONAL DUCT SMOKE DETECTOR LOCATIONS. CONNECT DAMPERS TO 120V 20A BRANCH CIRCUITS AS INDICATED ON ELECTRICAL DRAWINGS.
2. CONTRACTOR SHALL COORDINATE DUCT SMOKE DETECTOR INSTALLATION AT EACH FSD LOCATION AND MAIN RETURN AIR DUCT LOCATION PRIOR TO COMMENCING WORK. DIV. 23 SHALL PROVIDE ALL DUCTWORK MODIFICATIONS REQUIRED TO ACCOMMODATE DUCT SMOKE DETECTOR INSTALLATION. PROVIDE ALL WORK TO SUIT INSTALLATION REQUIREMENTS AND ALL APPLICABLE CODES.

FAN SHUTDOWN SEQUENCE OF OPERATIONS:

UPON THE DETECTION OF SMOKE BY ANY DUCT SMOKE DETECTOR:
1. THE FIRE ALARM SYSTEM SHALL SIGNAL THE AIR HANDLING UNIT IN ALARM TO SHUTDOWN VIA ADDRESSABLE CONTROL RELAY LOCATED AT EACH HANDLING UNIT.

2. THE FIRE ALARM SYSTEM SHALL PROVIDE A SIGNAL TO THE DDC SYSTEM VIA SINGLE ADDRESSABLE CONTROL RELAY TO INITIATE THE DDC SYSTEM SHUTDOWN MODE.

3. THE FIRE ALARM SYSTEM SHALL CLOSE ALL COMBINATION FIRE/SMOKE DAMPERS VIA ADDRESSABLE CONTROL RELAY(S) AFTER 20-SECOND (ADJUSTABLE) FAN SHUTDOWN SIGNAL OCCURRED.

UPON FIRE ALARM RESET AFTER THE DETECTION OF SMOKE HAS OCCURRED:
1. THE FIRE ALARM SYSTEM SHALL OPEN ALL COMBINATION FIRE/SMOKE DAMPERS VIA ADDRESSABLE CONTROL RELAY(S).


2. THE FIRE ALARM SYSTEM SHALL DISABLE FAN SHUTDOWN SIGNAL TO THE DDC SYSTEM VIA SINGLE ADDRESSABLE CONTROL RELAY.

3. THE FIRE ALARM SYSTEM SHALL DISABLE SHUTDOWN SIGNAL TO EACH AIR HANDLING UNIT VIA ADDRESSABLE CONTROL RELAY.

- NOTES:**
- ① REFER TO ELECTRICAL PLANS FOR FIRE ALARM PANEL LOCATION.
 - ② MOUNT ADJACENT TO APPROPRIATE ELECTRICAL PANEL.
 - ③ PROVIDE/MAINTAIN WORKING ACCESS TO ALL DUCT SMOKE DETECTORS.
 - ④ REMOTE ADDRESSABLE FIRE ALARM RELAY PROVIDED BY DIV. 28 (FORM C CONTACT), MOUNT ADJACENT TO FIRE ALARM PANEL.
 - ⑤ REMOTE ADDRESSABLE FIRE ALARM RELAY BY DIV. 28 (PROGRAMMED FOR 20 SECOND DELAY AFTER FAN STOP SIGNAL).
 - ⑥ AHU RETURN AIR DUCT SMOKE DETECTOR WITH SEPARATELY ADDRESSABLE RELAY BASE (FORM C CONTACT) FURNISHED BY DIV. 28. WIRED BY DIV. 28 TO FIRE ALARM SYSTEM. DETECTOR INSTALLED BY DIV. 23.
 - ⑦ DUCT SMOKE DETECTOR FURNISHED BY DIV. 28. WIRED BY DIV. 28 TO FIRE ALARM SYSTEM. INSTALLED BY DIV. 23.

A4 HVAC AND FIRE ALARM SYSTEM INTERFACE
NONE

MARK	DATE	DESCRIPTION
1	03-13-2015	ADDENDUM 6
ISSUE DATE: FEBRUARY 18, 2015		
ISSUE: CONSTRUCTION DOCUMENTS		
VOLUME: PACKAGE 2 VOLUME 2		
PROJECT NO.: 2013912.00		
DRAWN BY: SG		
CHECKED BY: JCY		
COPYRIGHT MAHLUM ARCHITECTS, INC. 2014 ORIGINAL SHEET SIZE: 30"X42"		
DIAGRAMS - MECHANICAL		

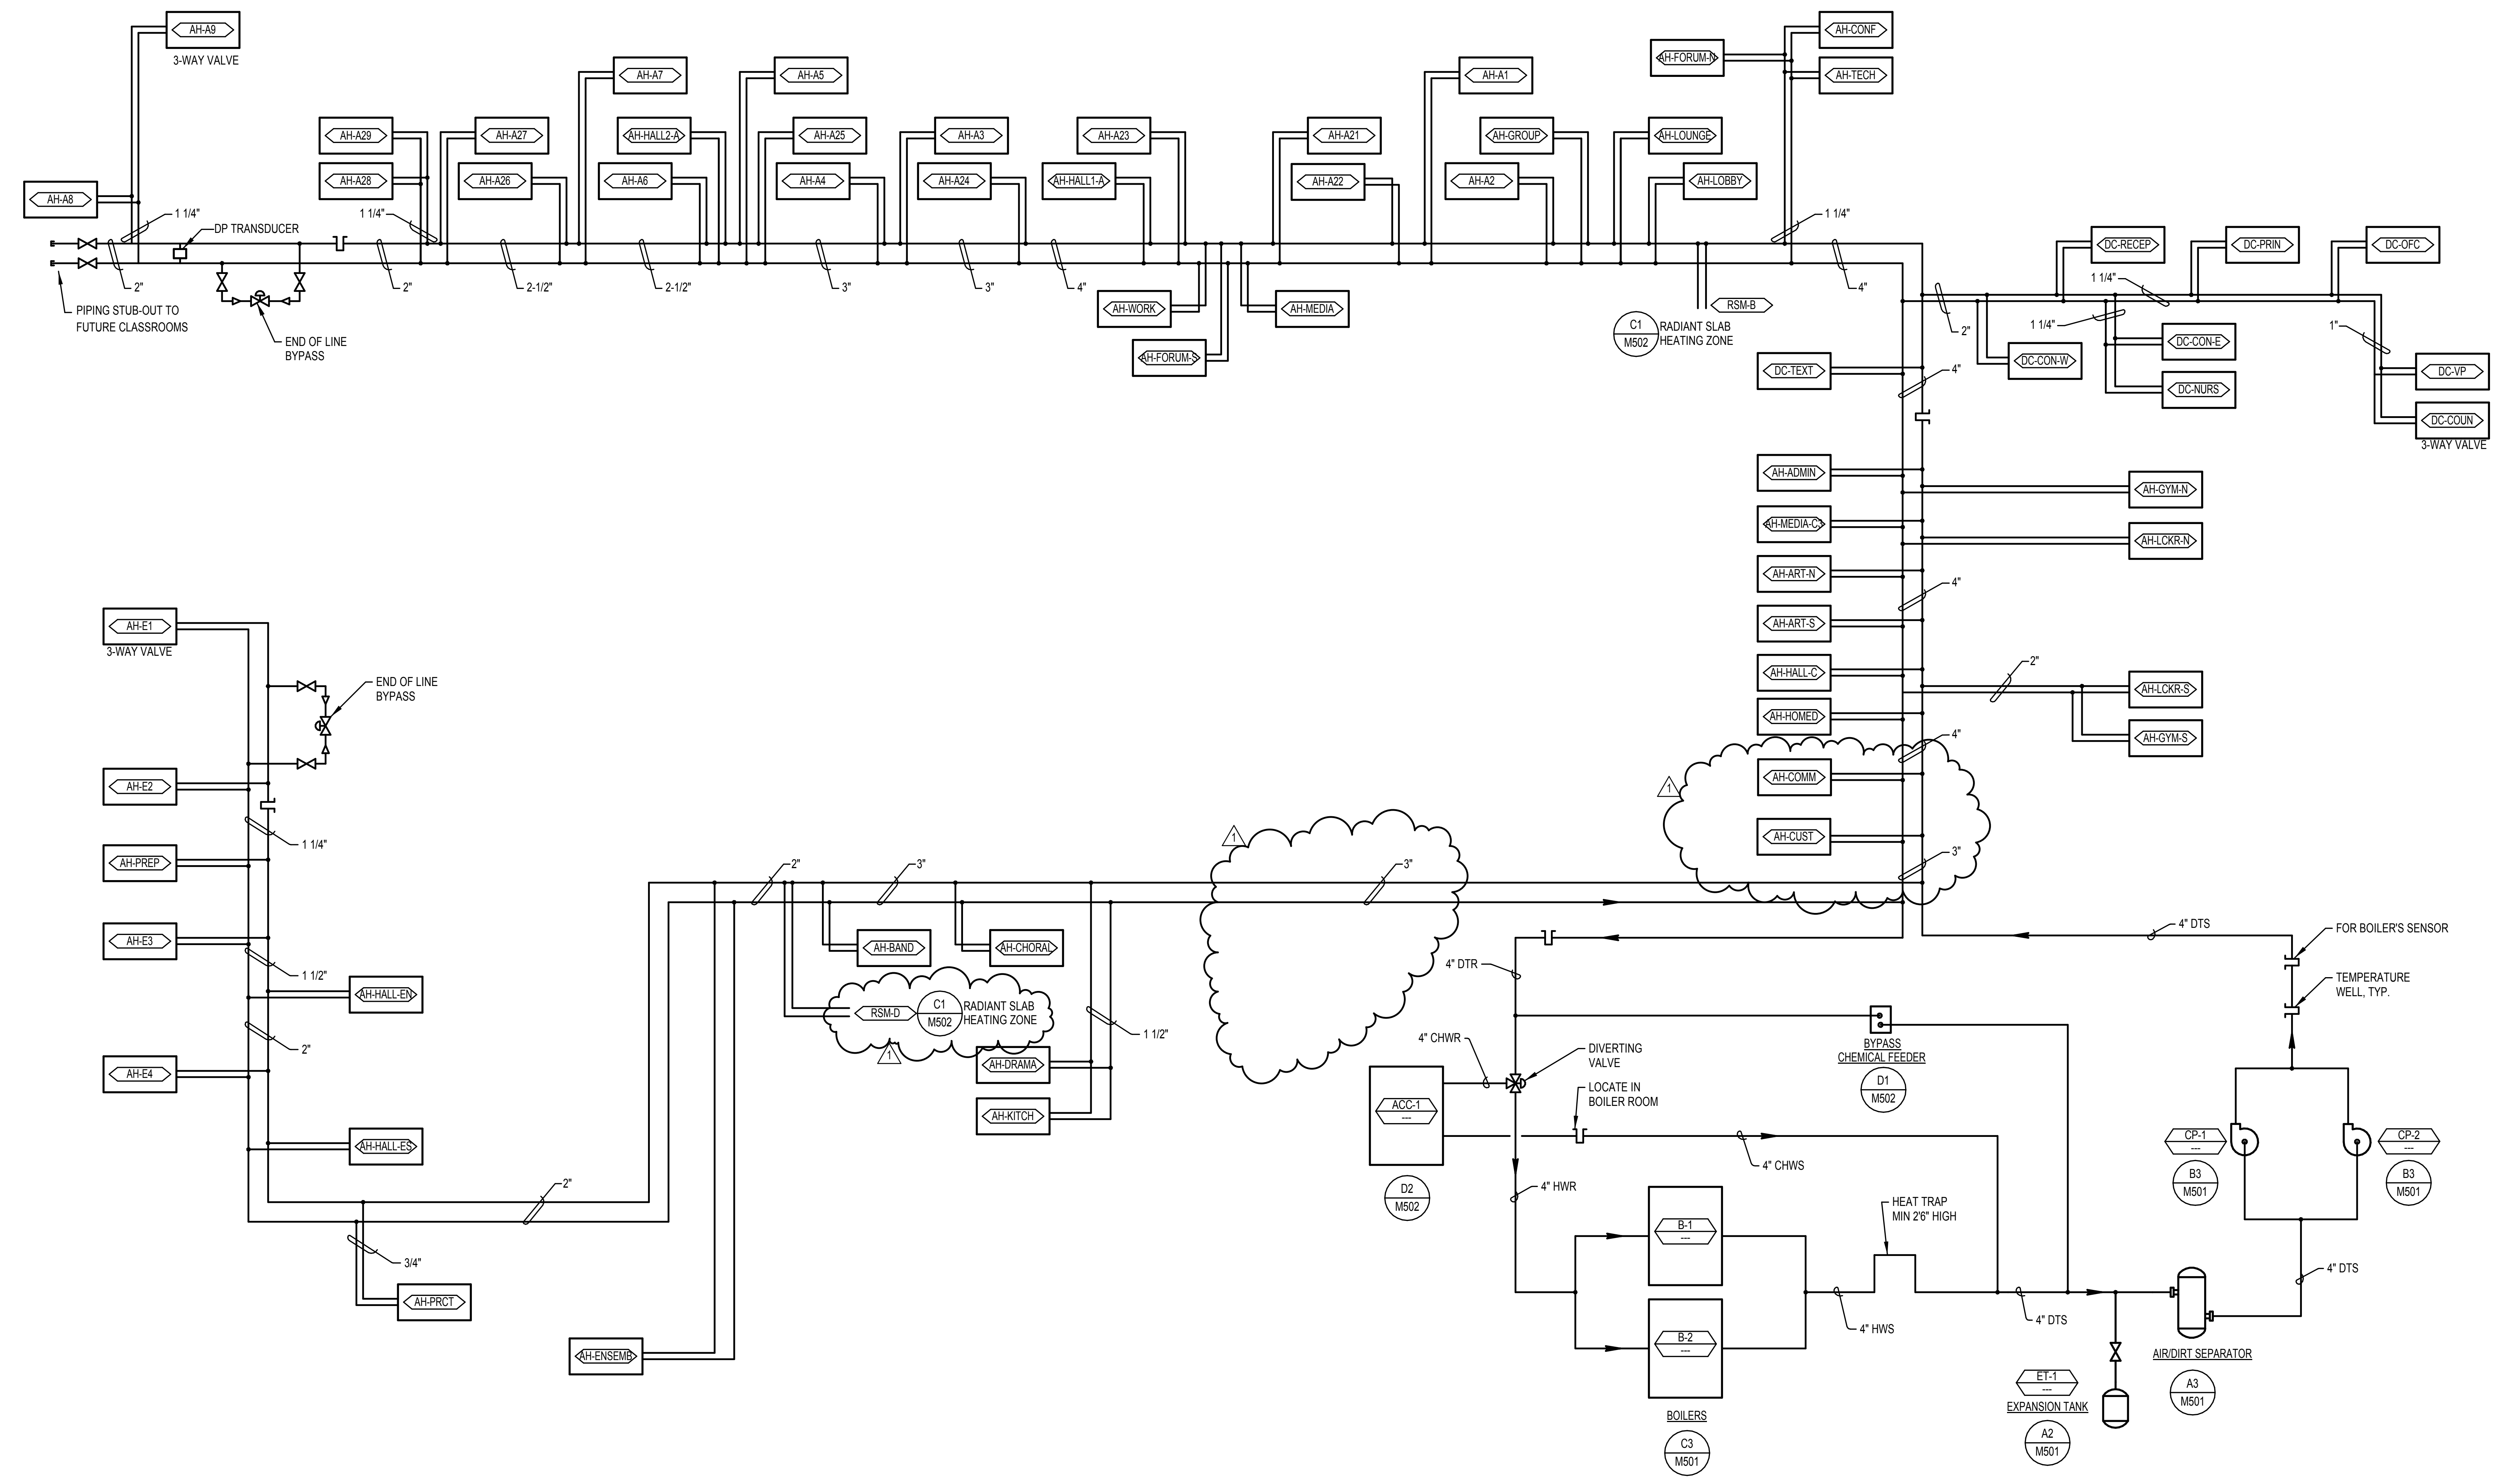

A1 DUAL TEMPERATURE WATER SYSTEM DIAGRAM
NONE

GENERAL NOTES:

- A. CONTRACTOR SHALL CONTACT EWEB TO VERIFY EASEMENT LOCATIONS AND TO OBTAIN UTILITY DESIGN/INSTALLATION DRAWINGS. EWEB INFRASTRUCTURE SHALL BE INSTALLED PER UTILITY COMPANY REQUIREMENTS. INFRASTRUCTURE SHOWN ON THESE DRAWINGS IS DIAGNOSTIC AND APPROXIMATE, AND SHALL BE VERIFIED WITH EWEB DESIGN DOCUMENTS PRIOR TO INSTALLATION.
- B. SEE THE ARCHITECTURAL DRAWINGS FOR EXACT LOCATION OF ALL DEVICES. REQUEST CLARIFICATIONS IN WRITING PRIOR TO INSTALLATION. INSTALLED, UNCOORDINATED ELEMENTS SHALL BE RELOCATED PER THE DIRECTION OF THE ARCHITECT WITHOUT ADDITIONAL COST TO THE PROJECT, OWNER OR DESIGN TEAM IF REQUIRED.
- C. EMERGENCY EGRESS LIGHTING WILL BE DESIGNATED BY 'EM' AFTER THE LUMINAIRE TYPE AND WILL BE POWERED THROUGH THE GENERATOR.
- D. LIGHTING CONTROL SHALL BE PROVIDED BY THE DISTRICT AND INSTALLED BY THE CONTRACTOR, UNLESS OTHERWISE NOTED.
- E. SEE SPECIFICATIONS FOR DETAILED SEQUENCE OF OPERATIONS.
- F. PROVIDE UL 924 RELAYS AS REQUIRED TO ALLOW DISCRETE CONTROL OF EACH EMERGENCY LUMINAIRE.

- G. SEE ZONED PLANS FOR ADDITIONAL INFORMATION.
- H. REFERENCE THE APPROPRIATE SPECIFICATION SECTION, 26-09-33 AND 26-09-43, FOR WALL STATIONS IN AREAS WITH PRE-SET SCENE CONTROL.
- I. EXIT SIGNS ARE TO BE PROVIDED TO MEET CODE REQUIREMENTS AND SHOULD BE LOCATED PER THE LIFE SAFETY DIAGRAM PROVIDED BY THE ARCHITECT IN QUANTITY TO NOT EXCEED CODE MAXIMUM DISTANCES BETWEEN SIGNS. ALL EXIT SIGNS ARE TO BE ON EMERGENCY POWER.
- J. REFER TO SHEET E602 FOR LIGHTING CONTROL DETAILS, AND SHEET E904 FOR SCHEDULE OF RELAYS, CONTROL INFORMATION AND CIRCUITING OF LUMINAIRES THAT ARE CONTROLLED BY A RELAY PANEL.
- K. REFER TO DETAIL 915-502 IN PACKAGE 1 FOR POLE BASE DETAIL OF SITE LIGHTS AT GRADE AND ABOVE GRADE.

NOTES:

- 1. APPROXIMATE LOCATION OF EXISTING JOINT UTILITY POLE. RISE EWEB PRIMARY CONDUIT AT EXISTING POLE PER UTILITY COMPANY REQUIREMENTS.
- 2. APPROXIMATE LOCATION OF EXISTING EWEB PRIMARY CONDUCTORS ROUTED UNDER 24TH AVENUE.
- 3. (NOT USED).
- 4. EWEB PRIMARY SERVICE CONDUIT INFRASTRUCTURE, SEE ONE-LINE DIAGRAM.
- 5. EWEB PRIMARY PULL VAULT PER UTILITY COMPANY REQUIREMENTS. LOCATE CLOSE AS PRACTICAL TO EXISTING PROPERTY LINE. VERIFY EXACT LOCATION WITH EWEB REPRESENTATIVE PRIOR TO INSTALLATION.
- 6. EWEB TRANSFORMER PAD/VAULT PER UTILITY COMPANY REQUIREMENTS. PROVIDE BOLLARD PROTECTION AT TRANSFORMER.
- 7. SOUTH WING PV ARRAY. SEE ONE-LINE DIAGRAM. CONTRACTOR TO COORDINATE ALL PV PANEL LOCATIONS WITH MECHANICAL ROOF PENETRATIONS AND EQUIPMENT LOCATIONS PRIOR TO DOCUMENT SUBMITTAL.
- 8. SCIENCE WING PV ARRAY. SEE ONE-LINE DIAGRAM.
- 9. GENERATOR. SEE ONE-LINE DIAGRAM.
- 10. SEE E-121A FOR BUILDING MOUNTED LIGHTING.
- 11. SEE E-121B FOR BUILDING MOUNTED LIGHTING.
- 12. SEE E-121C FOR BUILDING MOUNTED LIGHTING.
- 13. SEE E-121D FOR BUILDING MOUNTED LIGHTING.
- 14. SEE E-121E FOR BUILDING MOUNTED LIGHTING.

- 15. EWEB SECONDARY SERVICE CONDUIT INFRASTRUCTURE, SEE ONE-LINE DIAGRAM.
- 16. LUMINAIRES TO BE CONTROLLED ON LIGHTING RELAY #014, UNLESS OTHERWISE NOTED.
- 17. COORDINATE CONDUIT ROUTING IN THIS AREA WITH REMOVAL OF EXISTING TREES. COORDINATE WITH ARCHITECT AND OWNER.
- 18. NEW UTILITY INFRASTRUCTURE SHALL MAINTAIN 5 FEET CLEAR FROM EXISTING DRAIN AND PIPING AT THIS AREA. POT HOLE AND LOCATE TO VERIFY CLEARANCE.
- 19. POT HOLE AND LOCATE EXISTING UNDERGROUND UTILITIES. MAINTAIN MINIMUM REQUIRED PIPING CLEARANCE PER EWEB AND CITY OF EUGENE REQUIREMENTS.
- 20. (12'-12" C.O. STUB UP AT PARKING PLANTER, VERIFY EXACT LOCATION WITH ARCHITECT. HOMERUN TO ELEC ROOM 178, STUB UP AT NORTH WALL AVAILABLE SPACE BETWEEN ELECTRICAL EQUIPMENT.
- 21. LUMINAIRES S8 TO ILLUMINATED ENTRY SIGNAGE. CENTER LUMINAIRES ON METAL PORTION OF SIGN FOR STRAIGHT FRONT SPOTLIGHT ILLUMINATION. 3' SPACING OF LIGHTS FOR CROSS AIMING. CONTRACTOR TO COORDINATE WITH LANDSCAPE ELEMENTS AND CURB SUCH THAT LUMINAIRES HAVE A DIRECT UNOBSTRUCTED LINE OF SIGHT TO THE SIGN.
- 22. FLAG STYLE MOUNTING OF EXIT SIGN. MOUNT AT 8'-0" AFG.

mahlum
ROBERTSON/SHERWOOD/ARCHITECTS PC
132 EAST BROADWAY, SUITE 540
EUGENE, OREGON 97401
541-342-8077
www.robertsonsherwood.com

MAHLM ARCHITECTS INC
1231 NW HOYT, SUITE 102
PORTLAND, OREGON 97209
503-224-4032
71 COLUMBIA, FLOOR 4
SEATTLE, WASHINGTON 98104
206-441-4151
www.mahlum.com

PAE
Portland | San Francisco | Seattle
pae-engineers.com

Luma
Portland | San Francisco | Seattle
Lumald.com

PROFESSIONAL ENGINEER
EUGENE, OREGON
3-10-15
EXPIRES 12-31-16

EUGENE SCHOOL DISTRICT 4J

4J

REPLACEMENT ROOSEVELT MIDDLE SCHOOL
CIP NUMBER 410.566.001
680 EAST 24TH AVENUE
EUGENE, OREGON 97405
CIP NO. 410.566.001


MARK	DATE	DESCRIPTION
2	03-13-2015	ADDENDUM 6
1	2-27-2015	ADDENDUM 1

ISSUE DATE: FEBRUARY 18, 2015
ISSUE: CONSTRUCTION DOCUMENTS
VOLUME: PACKAGE 2 VOLUME 2

PROJECT NO.: 2013912.00
DRAWN BY: KAK
CHECKED BY: SPD
COPYRIGHT MAHLM ARCHITECTS, INC. 2014 ORIGINAL SHEET SIZE: 30"X42"

A SITE PLAN - ELECTRICAL

E-101

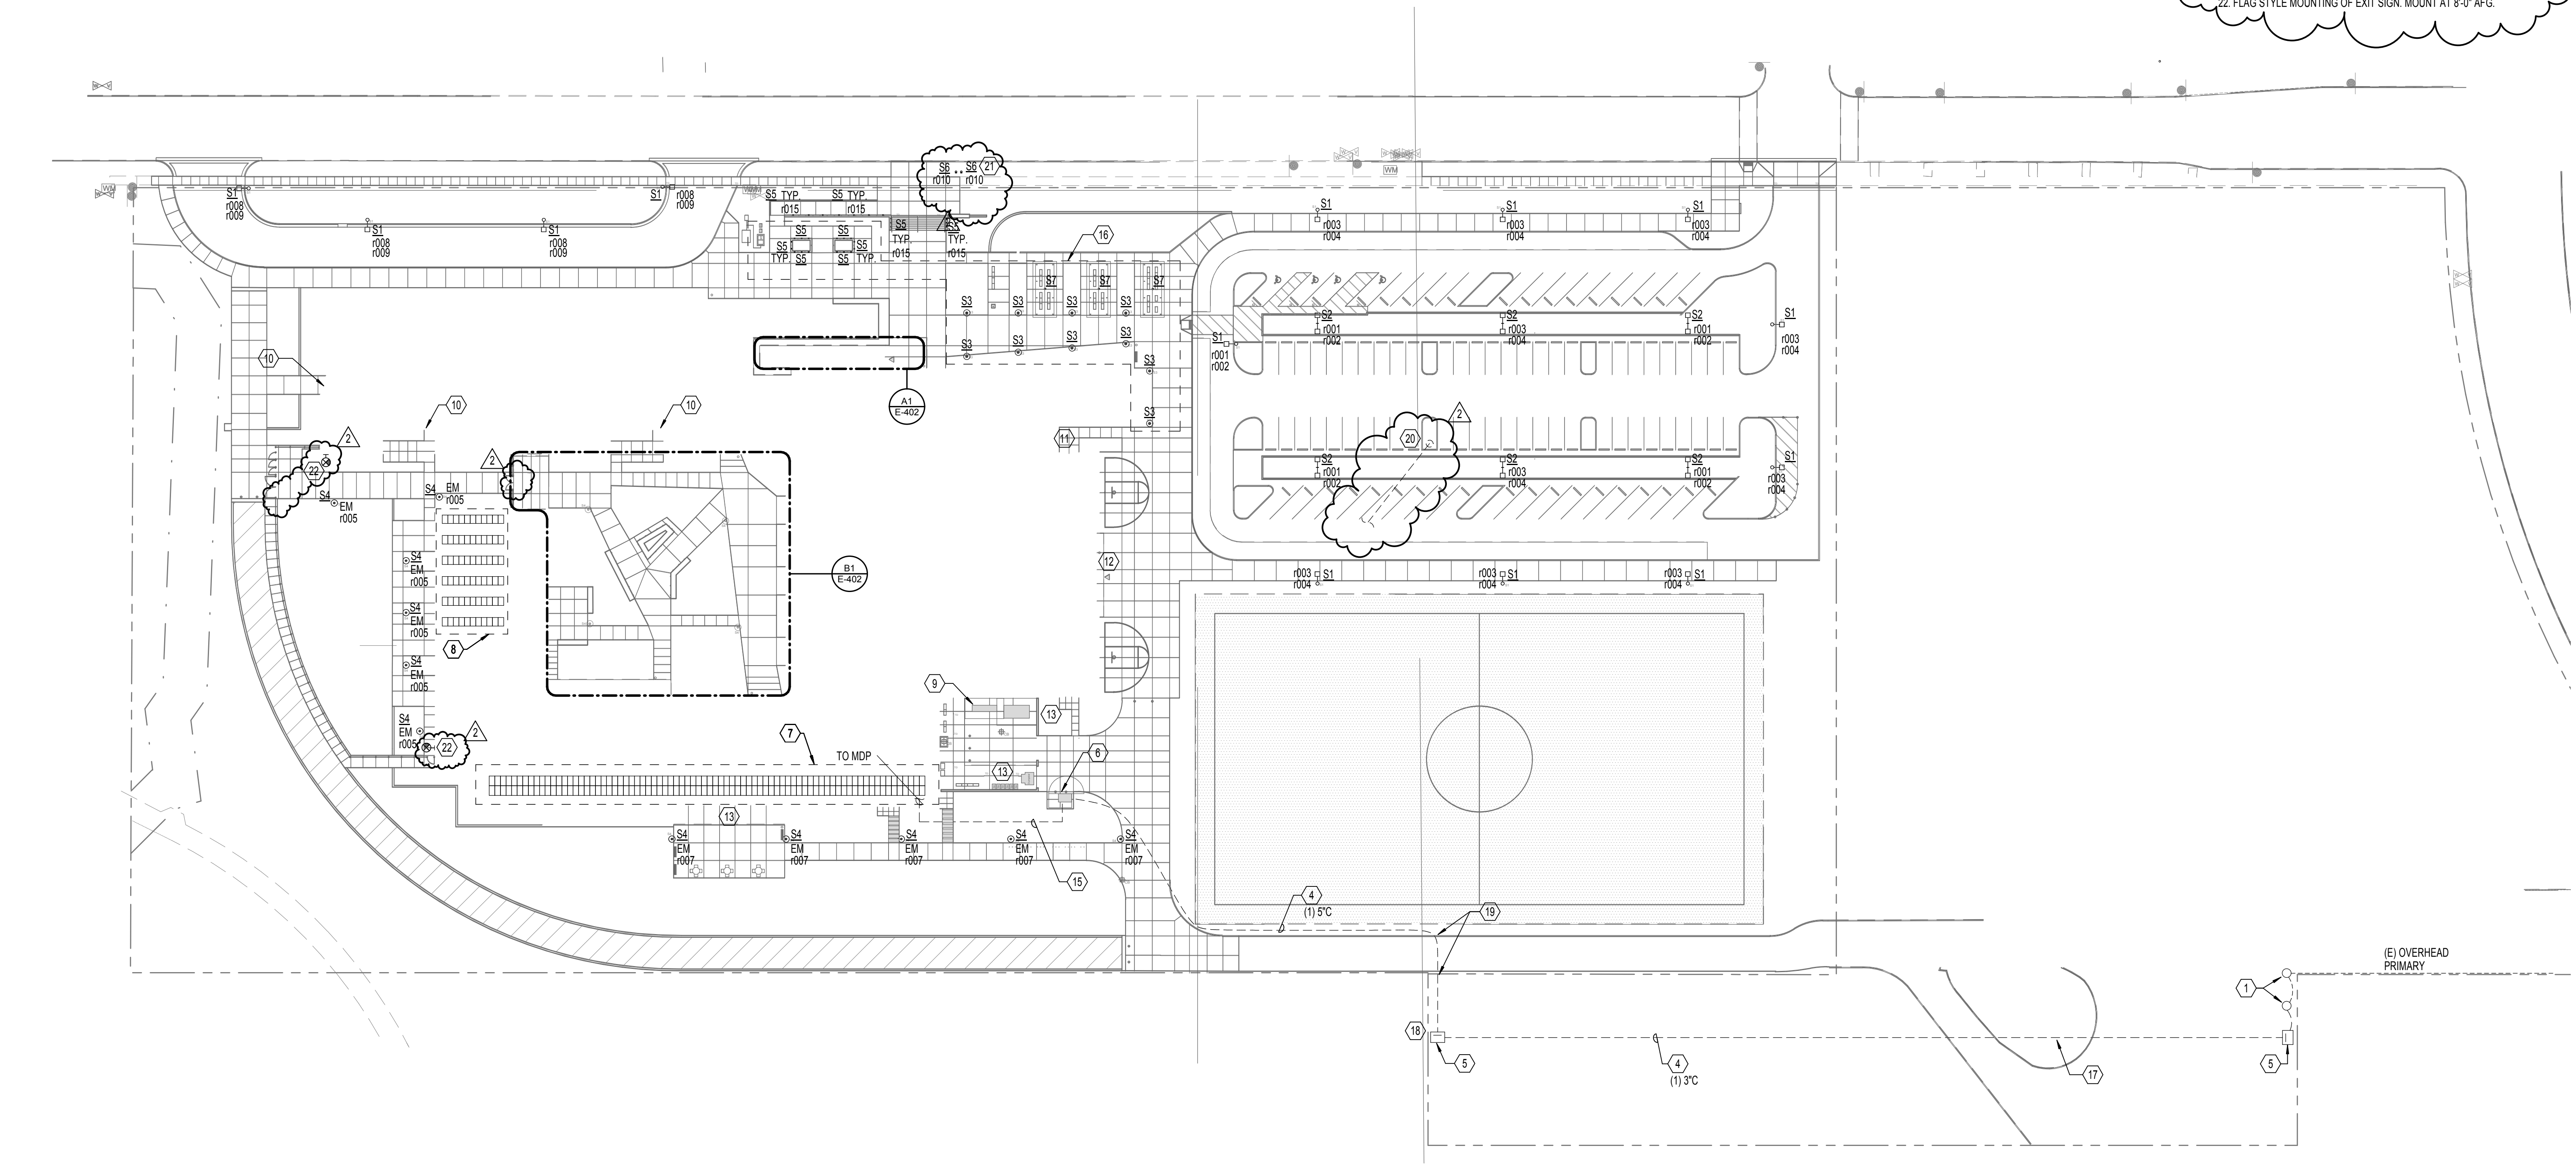

B1 SITE PLAN - UNDERGROUND - ELECTRICAL
1" = 40'-0"

3/13/2015 10:48 AM C:\Users\kash\Documents\2013912\CD\2013912_001.dwg


GENERAL NOTES:

- A. CONTRACTOR SHALL CONTACT EWEB TO VERIFY EASEMENT LOCATIONS AND TO OBTAIN UTILITY DESIGN/INSTALLATION DRAWINGS. EWEB INFRASTRUCTURE SHALL BE INSTALLED PER UTILITY COMPANY REQUIREMENTS. INFRASTRUCTURE SHOWN ON THESE DRAWINGS IS DIAGRAMATIC AND APPROXIMATE. AND SHALL BE VERIFIED WITH EWEB DESIGN DOCUMENTS PRIOR TO INSTALLATION.
- B. SEE THE ARCHITECTURAL DRAWINGS FOR EXACT LOCATION OF ALL DEVICES. REQUEST CLARIFICATIONS IN WRITING PRIOR TO INSTALLATION. INSTALLED UNCOORDINATED ELEMENTS SHALL BE RELOCATED PER THE DIRECTION OF THE ARCHITECT WITHOUT ADDITIONAL COST TO THE PROJECT, OWNER OR DESIGN TEAM IF REQUIRED.
- C. EMERGENCY EGRESS LIGHTING WILL BE DESIGNATED BY 'EM' AFTER THE LUMINAIRE TYPE AND WILL BE POWERED THROUGH THE GENERATOR.
- D. REFER TO E-602 FOR LIGHTING CONTROL SYSTEM INFORMATION.
- E. SEE SPECIFICATIONS FOR DETAILED SEQUENCE OF OPERATIONS.
- F. PROVIDE UL 924 RELAYS AS REQUIRED TO ALLOW DISCRETE CONTROL OF EACH EMERGENCY RELAY.
- G. SEE ZONED PLANS FOR ADDITIONAL INFORMATION.
- H. REFERENCE THE APPROPRIATE SPECIFICATION SECTION, 26-09-33 AND 26-09-43, FOR WALL STATIONS IN AREAS WITH PRE-SET SCENE CONTROL.
- I. ALL STANDARD NON-RELAY LIGHTS ON THIS SHEET WILL HOMERUN BACK TO 4P-1A UNLESS OTHERWISE NOTED. CIRCUIT NUMBERS ARE ADJACENT TO FIXTURES.
- J. ALL EMERGENCY NON-RELAY LIGHTS ON THIS SHEET WILL HOMERUN BACK TO E4P-1B UNLESS OTHERWISE NOTED. CIRCUIT NUMBERS ARE ADJACENT TO FIXTURES.
- K. EXIT SIGNS ARE TO BE PROVIDED TO MEET CODE REQUIREMENTS AND SHOULD BE LOCATED PER THE LIFE SAFETY DIAGRAM PROVIDED BY THE ARCHITECT IN QUANTITY TO NOT EXCEED CODE MAXIMUM DISTANCES BETWEEN SIGNS. ALL EXIT SIGNS ARE TO BE ON EMERGENCY POWER.
- L. REFER TO SHEET E904 FOR SCHEDULE OF RELAYS, CONTROL INFORMATION AND CIRCUITING OF LUMINARIES THAT ARE CONTROLLED BY A RELAY PANEL.

NOTES: MAY NOT APPLY TO ALL SHEETS.

- 1. REFER TO SHEET E-122A FOR LIGHTING ABOVE STAIR IN SECOND STORY SPACE.
- 2. PROVIDE SIGN ON BACK SIDE OF DOOR WITH THE WORDS "TURN OFF LIGHTS" IN LARGE HIGH CONTRAST FONT. PROVIDE MOCK-UP FOR ARCHITECTURAL APPROVAL PRIOR TO INSTALL.
- 3. REFER TO LIGHTING SITE PLAN E-101 FOR EXTERIOR LIGHTING AT MAIN ENTRY.
- 4. THEATRICAL LIGHTING AND CONTROLS TO BE PRICED SEPARATELY. PROVIDE UNIT PRICING FOR LUMINAIRE TYPES T1, T2, T3, AND T4 TO OWNER FOR SELECTION ON DESIRED QUANTITY OF EACH TYPE.
- 5. FOUR BUTTON WALL STATION FOR PRESET SCENE CONTROL OF HOUSE LIGHTING WITH RAISE/LOWER.
- 6. LCD TOUCH SCREEN PANEL TIED TO THE THEATRICAL LIGHTING CONTROL SYSTEM.
- 7. PROVIDE CONSOLE FOR DMX CONTROL.
- 8. LIGHTS IN GRADE AND IN EXTERIOR SOFFIT SHALL BE CONTROLLED ON LIGHTING RELAY #012. LIGHTS IN EXTERIOR SOFFIT SHALL BE CONTROLLED ON LIGHTING RELAY #013.
- 9. L20 LIGHTS TO BE CONTROLLED VIA LIGHTING RELAY #209.
- 10. LOCAL SWITCHES TO CONTROL LIGHTING ON MECHANICAL EQUIPMENT PLATFORM C. SEE SHEET E-122C FOR ADDITIONAL INFORMATION.
- 11. LOCAL SWITCHES TO CONTROL LIGHTS ON MECHANICAL PLATFORM C. EMERGENCY LIGHTS CONTROLLED SEPARATELY.
- 12. LOCAL SWITCHES TO CONTROL LIGHTS ON MECHANICAL PLATFORM C AND D. EMERGENCY LIGHTS CONTROLLED SEPARATELY.
- 13. LOCAL SWITCHES TO CONTROL LIGHTS ON MECHANICAL PLATFORM E SOUTH. EMERGENCY LIGHTS CONTROLLED SEPARATELY.
- 14. LOCAL SWITCHES TO CONTROL LIGHTS ON MECHANICAL PLATFORM E NORTH. EMERGENCY LIGHTS CONTROLLED SEPARATELY.
- 15. (5) BUTTON PRESET SCENE CONTROLLER WITH RAISE/LOWER. CONTROLLER TIES TO LIGHT DIGITAL ROOM CONTROL FOR SCENE CONTROL OF GYMNASIUM.

- 16. LIGHT FIXTURES AND CONTROLS TO BE DETERMINED.
- 17. LOCAL OVERRIDE SWITCH PROVIDED FOR EXTERIOR LIGHTING LOADS. REFER TO SHEET DETAIL C4E-602 FOR ADDITIONAL INFORMATION ON EXTERIOR LIGHTING CONTROL. LOCAL TIMER SWITCH FOR INTERIOR LIGHTING OVERRIDE.
- 18. CLOSED LOOP 0-10V PHOTOCELL CONNECTED TO LUMINAIRES IN DESIGNATED DAYLIGHT ZONE.
- 19. REFER TO CONTROL DETAIL C4E-602.
- 20. OPEN LOOP DLM PHOTOCELL MOUNTED PER MANUFACTURER'S RECOMMENDATIONS FOR OPTIMUM DAYLIGHT CONTROL.
- 21. TWO BUTTON SCENE CONTROLLER.
- 22. LIGHTING IN THIS SPACE TO BE CONTROLLED VIA LOCAL DIGITALLY DISTRIBUTED DIMMING RELAYS. COORDINATE RELAY BOX LOCATION WITH OWNER AND ARCHITECT PRIOR TO ROUGH-IN AND INSTALLATION.
- 23. ETC SMARTBAR WITH 6 OUTPUTS AND DMX CONTROL.
- 24. LUMINAIRES L6 SHALL BE WALL MOUNTED ABOVE DOOR AT 8'-0" AFF.
- 25. LOCAL SWITCH TO CONTROL LIGHTS ON MECHANICAL PLATFORM A. EMERGENCY LIGHTS CONTROLLED SEPARATELY.
- 26. REFER TO SHEET E-122A FOR LIGHTING ABOVE STAIR IN SECOND STORY SPACE.
- 27. MOUNT EXTERIOR EXIT SIGN TO WALL ABOVE FACIA, 10'-0" AFG. COORDINATE FINAL MOUNTING LOCATION WITH ARCHITECT IN FIELD PRIOR TO FINAL INSTALLATION.
- 28. PROVIDE ROTARY WHEEL SWITCH STATION FOR RGB CONTROL OF TYPE L8A PENDANT.

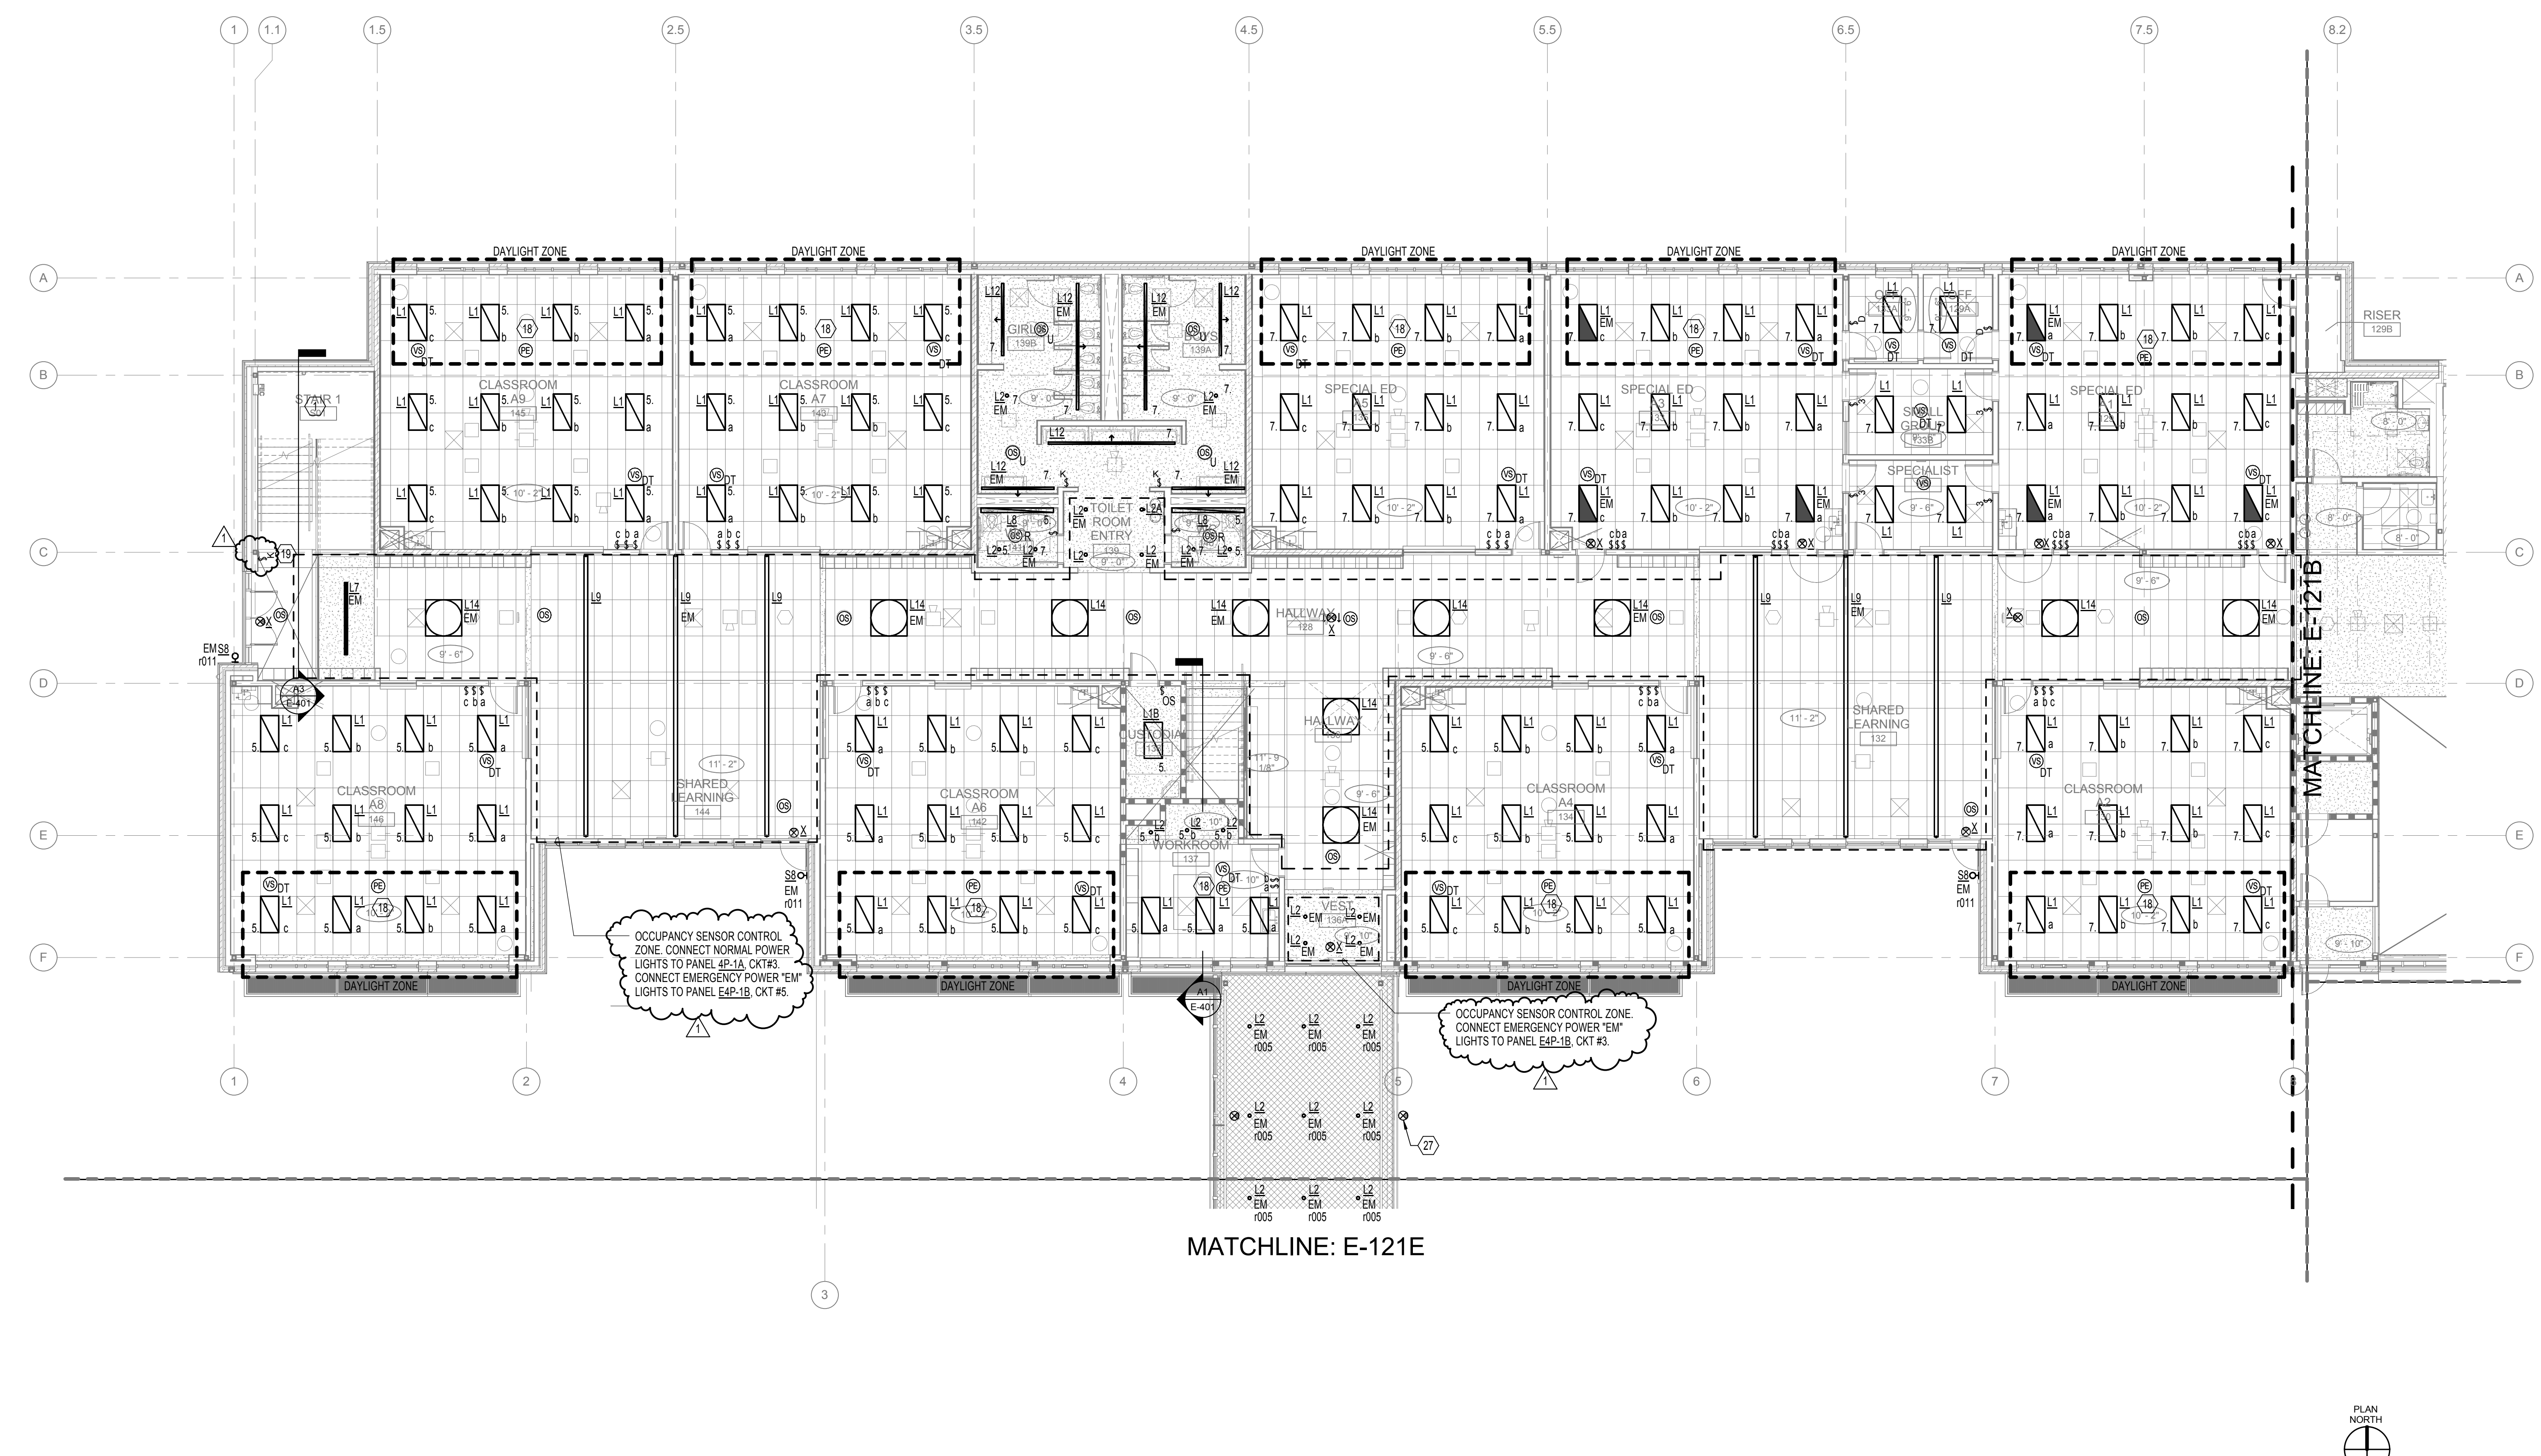


(A1) FIRST FLOOR PLAN - ZONE A - LIGHTING
1/8" = 1'-0"

mahlum
ROBERTSON/SHERWOOD/ARCHITECTS PC
132 EAST BROADWAY, SUITE 540
EUGENE, OREGON 97401
541-342-8077
www.robertsonsherwood.com

MAHLM ARCHITECTS INC
1231 NW HWY. SUITE 102
PORTLAND, OREGON 97209
503-224-4032
71 COLUMBIA FLOOR 4
SEATTLE, WASHINGTON 98104
206-441-1151
www.mahlum.com

PAE
Portland | San Francisco | Seattle
pae-engineers.com

Luma
Portland | San Francisco | Seattle
Lumald.com

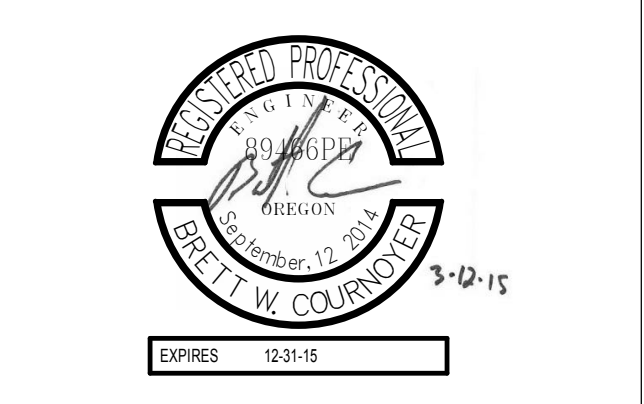

EUGENE SCHOOL DISTRICT 4J

4J

REPLACEMENT ROOSEVELT
MIDDLE SCHOOL
CIP NUMBER 410.566.001
680 EAST 24TH AVENUE
EUGENE, OREGON 97405
CIP NO. 410.566.001

MARK	DATE	DESCRIPTION
1	03-13-2015	ADDENDUM 6
ISSUE DATE: FEBRUARY 18, 2015		
ISSUE: CONSTRUCTION DOCUMENTS		
VOLUME: PACKAGE 2 VOLUME 2		
PROJECT NO.: 2013912.00		
DRAWN BY: KCB		
CHECKED BY: PJZ		
COPYRIGHT MAHLM ARCHITECTS, INC. 2014 ORIGINAL SHEET SIZE 24"X36"		

FIRST FLOOR PLAN - ZONE A - LIGHTING

E-121A

GENERAL NOTES:


- A. CONTRACTOR SHALL CONTACT EWEB TO VERIFY EASEMENT LOCATIONS AND TO OBTAIN UTILITY DESIGN/INSTALLATION DRAWINGS. EWEB INFRASTRUCTURE SHALL BE INSTALLED PER UTILITY COMPANY REQUIREMENTS. INFRASTRUCTURE SHOWN ON THESE DRAWINGS IS DIAGRAMATIC AND APPROXIMATE. AND SHALL BE VERIFIED WITH EWEB DESIGN DOCUMENTS PRIOR TO INSTALLATION.
- B. SEE THE ARCHITECTURAL DRAWINGS FOR EXACT LOCATION OF ALL DEVICES. REQUEST CLARIFICATIONS IN WRITING PRIOR TO INSTALLATION. INSTALLED UNCOORDINATED ELEMENTS SHALL BE RELOCATED PER THE DIRECTION OF THE ARCHITECT WITHOUT ADDITIONAL COST TO THE PROJECT, OWNER OR DESIGN TEAM IF REQUIRED.
- C. EMERGENCY EGRESS LIGHTING WILL BE DESIGNATED BY 'EM' AFTER THE LUMINAIRE TYPE AND WILL BE POWERED THROUGH THE GENERATOR.
- D. REFER TO E-602 FOR LIGHTING CONTROL SYSTEM INFORMATION.
- E. SEE SPECIFICATIONS FOR DETAILED SEQUENCE OF OPERATIONS.
- F. PROVIDE UL 924 RELAYS AS REQUIRED TO ALLOW DISCRETE CONTROL OF EACH EMERGENCY RELAY.

- G. SEE ZONED PLANS FOR ADDITIONAL INFORMATION.
- H. REFERENCE THE APPROPRIATE SPECIFICATION SECTION, 26-09-33 AND 26-09-43, FOR WALL STATIONS IN AREAS WITH PRE-SET SCENE CONTROL.
- I. ALL STANDARD NON-RELAY LIGHTS ON THIS SHEET WILL HOMERUN BACK TO 4P-1A UNLESS OTHERWISE NOTED. CIRCUIT NUMBERS ARE ADJACENT TO FIXTURES.
- J. ALL EMERGENCY NON-RELAY LIGHTS ON THIS SHEET WILL HOMERUN BACK TO E4P-1B UNLESS OTHERWISE NOTED. CIRCUIT NUMBERS ARE ADJACENT TO FIXTURES.
- K. EXIT SIGNS ARE TO BE PROVIDED TO MEET CODE REQUIREMENTS AND SHOULD BE LOCATED PER THE LIFE SAFETY DIAGRAM PROVIDED BY THE ARCHITECT IN QUANTITY TO NOT EXCEED CODE MAXIMUM DISTANCES BETWEEN SIGNS. ALL EXIT SIGNS ARE TO BE ON EMERGENCY POWER.
- L. REFER TO SHEET E904 FOR SCHEDULE OF RELAYS, CONTROL INFORMATION AND CIRCUITING OF LUMINAIRES THAT ARE CONTROLLED BY A RELAY PANEL.
- M. ALL STANDBY NON-RELAY LIGHTS ON THIS SHEET WILL HOMERUN BACK TO S2P-2A UNLESS OTHERWISE NOTED. CIRCUIT NUMBERS ARE ADJACENT TO FIXTURES.

NOTES: MAY NOT APPLY TO ALL SHEETS

- 1. REFER TO SHEET E-122A FOR LIGHTING ABOVE STAIR IN SECOND STORY SPACE.
- 2. PROVIDE SIGN ON BACK SIDE OF DOOR WITH THE WORDS "TURN OFF LIGHTS" IN LARGE HIGH CONTRAST FONT. PROVIDE MOCK-UP FOR ARCHITECTURAL APPROVAL PRIOR TO INSTALL.
- 3. REFER TO LIGHTING SITE PLAN E-101 FOR EXTERIOR LIGHTING AT MAIN ENTRY.
- 4. THEATRICAL LIGHTING AND CONTROLS TO BE PRICED SEPARATELY. PROVIDE UNIT PRICING FOR LUMINAIRE TYPES T1, T2, T3, AND T4 TO OWNER FOR SELECTION ON DESIRED QUANTITY OF EACH TYPE.
- 5. FOUR BUTTON WALL STATION FOR PRESET SCENE CONTROL OF HOUSE LIGHTING WITH RAISE/LOWER.
- 6. LCD TOUCH SCREEN PANEL TIED TO THE THEATRICAL LIGHTING CONTROL SYSTEM.
- 7. PROVIDE CONSOLE FOR DMX CONTROL.
- 8. LIGHTS IN GRADE AND IN EXTERIOR SOFFIT SHALL BE CONTROLLED ON LIGHTING RELAY #012. LIGHTS IN EXTERIOR SOFFIT SHALL BE CONTROLLED ON LIGHTING RELAY #013.
- 9. L20 LIGHTS TO BE CONTROLLED VIA LIGHTING RELAY #209.
- 10. LOCAL SWITCHES TO CONTROL LIGHTING ON MECHANICAL EQUIPMENT PLATFORM C. SEE SHEET E-122C FOR ADDITIONAL INFORMATION.
- 11. LOCAL SWITCHES TO CONTROL LIGHTS ON MECHANICAL PLATFORM C. EMERGENCY LIGHTS CONTROLLED SEPARATELY.
- 12. LOCAL SWITCHES TO CONTROL LIGHTS ON MECHANICAL PLATFORM E AND D. EMERGENCY LIGHTS CONTROLLED SEPARATELY.
- 13. LOCAL SWITCHES TO CONTROL LIGHTS ON MECHANICAL PLATFORM E SOUTH. EMERGENCY LIGHTS CONTROLLED SEPARATELY.
- 14. LOCAL SWITCHES TO CONTROL LIGHTS ON MECHANICAL PLATFORM E NORTH. EMERGENCY LIGHTS CONTROLLED SEPARATELY.
- 15. (5) BUTTON PRESET SCENE CONTROLLER WITH RAISE/LOWER. CONTROLLER TIES TO ALIGHT DIGITAL ROOM CONTROL FOR SCENE CONTROL OF GYMNASIUM.

- 16. LIGHT FIXTURES AND CONTROLS TO BE DETERMINED.
- 17. LOCAL OVERRIDE SWITCH PROVIDED FOR EXTERIOR LIGHTING LOADS. REFER TO SHEET DETAIL C4E-602 FOR ADDITIONAL INFORMATION ON EXTERIOR LIGHTING CONTROL. LOCAL TIMER SWITCH FOR INTERIOR LIGHTING OVERRIDE.
- 18. CLOSED LOOP 0-10V PHOTOCELL CONNECTED TO LUMINAIRES IN DESIGNATED DAYLIGHT ZONE.
- 19. REFER TO CONTROL DETAIL C4E-602.
- 20. OPEN LOOP DLM PHOTOCELL MOUNTED PER MANUFACTURER'S RECOMMENDATIONS FOR OPTIMUM DAYLIGHT CONTROL.
- 21. TWO BUTTON SCENE CONTROLLER.
- 22. LIGHTING IN THIS SPACE TO BE CONTROLLED VIA LOCAL DIGITALLY DISTRIBUTED DIMMING RELAYS. COORDINATE RELAY BOX LOCATION WITH OWNER AND ARCHITECT PRIOR TO ROUGH-IN AND INSTALLATION.
- 23. ETC SMARTBAR WITH 6 OUTPUTS AND DMX CONTROL.
- 24. LUMINAIRES L6 SHALL BE WALL MOUNTED ABOVE DOOR AT 8'-0" AFF.
- 25. LOCAL SWITCH TO CONTROL LIGHTS ON MECHANICAL PLATFORM A. EMERGENCY LIGHTS CONTROLLED SEPARATELY.
- 26. REFER TO SHEET E-122A FOR LIGHTING ABOVE STAIR IN SECOND STORY SPACE.
- 27. MOUNT EXTERIOR EXIT SIGN TO WALL ABOVE FACIA. 10'-0" AFG. COORDINATE FINAL MOUNTING LOCATION WITH ARCHITECT IN FIELD PRIOR TO FINAL INSTALLATION.
- 28. PROVIDE ROTARY WHEEL SWITCH STATION FOR RGB CONTROL OF TYPE L9A PENDANT.

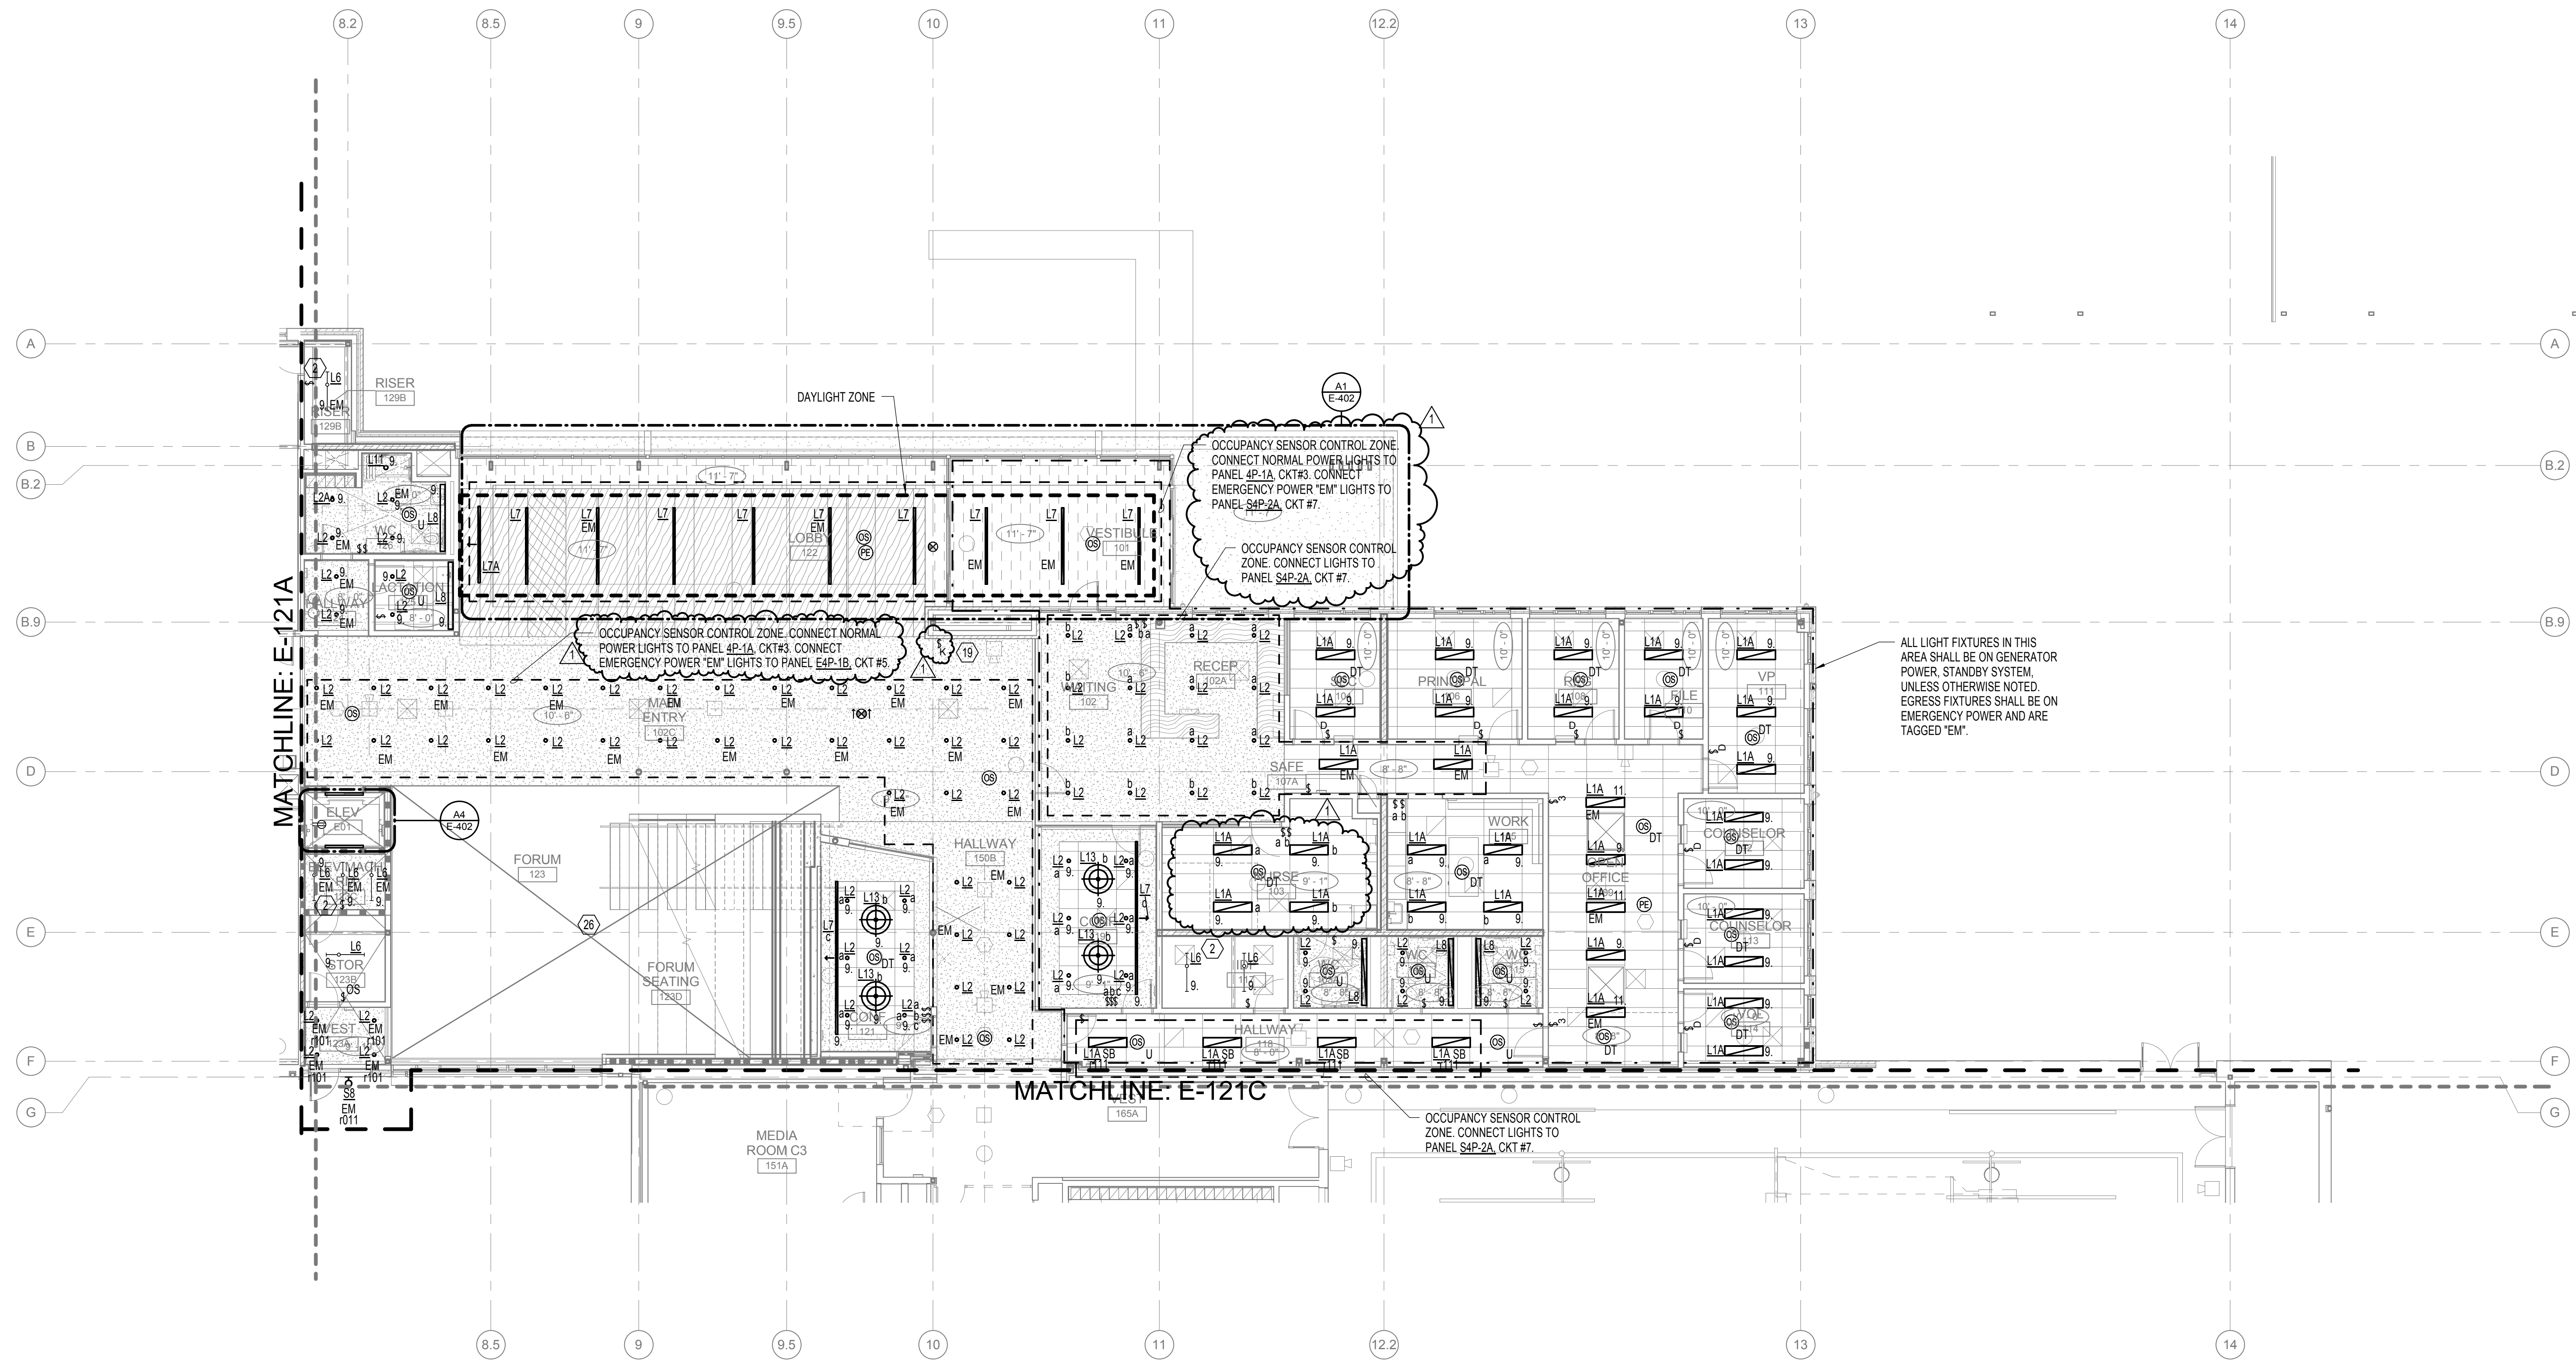

A1 FIRST FLOOR PLAN - ZONE B - LIGHTING
1/8" = 1'-0"

mahlum
ROBERTSON/SHERWOOD/ARCHITECTS PC
132 EAST BROADWAY, SUITE 540
EUGENE, OREGON 97401
541-342-8077
www.robertsonsherwood.com

MAHLUM ARCHITECTS INC
1233 NW HOYT, SUITE 102
PORTLAND, OREGON 97209
503-224-4032
71 COLUMBIA, FLOOR 4
SEATTLE, WASHINGTON 98104
206-441-4151
www.mahlum.com

P A E
Portland | San Francisco | Seattle
pae-engineers.com

Lumal
Portland | San Francisco | Seattle
Lumald.com

Professional Engineer
EUGENE, OREGON
EXPIRES 12-31-15

EUGENE SCHOOL DISTRICT 4J

4J

REPLACEMENT ROOSEVELT
MIDDLE SCHOOL
CIP NUMBER 410.566.001
680 EAST 24TH AVENUE
EUGENE, OREGON 97405
CIP NO. 410.566.001

MARK	DATE	DESCRIPTION
1	03-13-2015	ADDENDUM 6
ISSUE DATE: FEBRUARY 18, 2015		
ISSUE: CONSTRUCTION DOCUMENTS		
VOLUME: PACKAGE 2 VOLUME 2		
PROJECT NO.: 2013912.00		
DRAWN BY: KCB		
CHECKED BY: P.J.Z		
COPYRIGHT MAHLUM ARCHITECTS, INC. 2014 ORIGINAL SHEET SIZE 24"X36"		

FIRST FLOOR PLAN - ZONE B - LIGHTING


E-121B

GENERAL NOTES:

- A. CONTRACTOR SHALL CONTACT EWB TO VERIFY EASEMENT LOCATIONS AND TO OBTAIN UTILITY DESIGN/INSTALLATION DRAWINGS. EWB INFRASTRUCTURE SHALL BE INSTALLED PER UTILITY COMPANY REQUIREMENTS. INFRASTRUCTURE SHOWN ON THESE DRAWINGS IS DIAGNOSTIC AND APPROXIMATE, AND SHALL BE VERIFIED WITH EWB DESIGN DOCUMENTS PRIOR TO INSTALLATION.
- B. SEE THE ARCHITECTURAL DRAWINGS FOR EXACT LOCATION OF ALL DEVICES. REQUEST CLARIFICATIONS IN WRITING PRIOR TO INSTALLATION. INSTALLED, UNCOORDINATED ELEMENTS SHALL BE RELOCATED PER THE DIRECTION OF THE ARCHITECT WITHOUT ADDITIONAL COST TO THE PROJECT, OWNER OR DESIGN TEAM IF REQUIRED.
- C. EMERGENCY EGRESS LIGHTING WILL BE DESIGNATED BY 'EM' AFTER THE LUMINAIRE TYPE AND WILL BE POWERED THROUGH THE GENERATOR.
- D. REFER TO E-602 FOR LIGHTING CONTROL SYSTEM INFORMATION.
- E. SEE SPECIFICATIONS FOR DETAILED SEQUENCE OF OPERATIONS.
- F. PROVIDE UL 924 RELAYS AS REQUIRED TO ALLOW DISCRETE CONTROL OF EACH EMERGENCY RELAY.
- G. SEE ZONED PLANS FOR ADDITIONAL INFORMATION.
- H. REFERENCE THE APPROPRIATE SPECIFICATION SECTION, 26-09-33 AND 26-09-43, FOR WALL STATIONS IN AREAS WITH PRE-SET SCENE CONTROL.
- I. ALL STANDARD NON-RELAY LIGHTS ON THIS SHEET WILL HOMERUN BACK TO 4P-1C UNLESS OTHERWISE NOTED. CIRCUIT NUMBERS ARE ADJACENT TO FIXTURES.
- J. ALL EMERGENCY NON-RELAY LIGHTS ON THIS SHEET WILL HOMERUN BACK TO E4P-1A UNLESS OTHERWISE NOTED. CIRCUIT NUMBERS ARE ADJACENT TO FIXTURES.
- K. EXIT SIGNS ARE TO BE PROVIDED TO MEET CODE REQUIREMENTS AND SHOULD BE LOCATED PER THE LIFE SAFETY DIAGRAM PROVIDED BY THE ARCHITECT IN QUANTITY TO NOT EXCEED CODE MAXIMUM DISTANCES BETWEEN SIGNS. ALL EXIT SIGNS ARE TO BE ON EMERGENCY POWER.
- L. REFER TO SHEET E904 FOR SCHEDULE OF RELAYS, CONTROL INFORMATION AND CIRCUITING OF LUMINARIES THAT ARE CONTROLLED BY A RELAY PANEL.

NOTES: MAY NOT APPLY TO ALL SHEETS.

- 1. REFER TO SHEET E-122A FOR LIGHTING ABOVE STAIR IN SECOND STORY SPACE.
- 2. PROVIDE SIGN ON BACK SIDE OF DOOR WITH THE WORDS "TURN OFF LIGHTS" IN LARGE HIGH CONTRAST FONT. PROVIDE MOCK-UP FOR ARCHITECTURAL APPROVAL PRIOR TO INSTALL.
- 3. REFER TO LIGHTING SITE PLAN E-101 FOR EXTERIOR LIGHTING AT MAIN ENTRY.
- 4. THEATRICAL LIGHTING AND CONTROLS TO BE PRICED SEPARATELY. PROVIDE UNIT PRICING FOR LUMINAIRE TYPES T1, T2, T3, AND T4 TO OWNER FOR SELECTION ON DESIRED QUANTITY OF EACH TYPE.
- 5. FOUR BUTTON WALL STATION FOR PRESET SCENE CONTROL OF HOUSE LIGHTING WITH RAISE/LOWER.
- 6. LCD TOUCH SCREEN PANEL TIED TO THE THEATRICAL LIGHTING CONTROL SYSTEM.
- 7. PROVIDE CONSOLE FOR DMX CONTROL.
- 8. LIGHTS IN GRADE AND IN EXTERIOR SOFFIT SHALL BE CONTROLLED ON LIGHTING RELAY #012. LIGHTS IN EXTERIOR SOFFIT SHALL BE CONTROLLED ON LIGHTING RELAY #013.
- 9. L20 LIGHTS TO BE CONTROLLED VIA LIGHTING RELAY #209.
- 10. LOCAL SWITCHES TO CONTROL LIGHTING ON MECHANICAL PLATFORM C. SEE SHEET E-122C FOR ADDITIONAL INFORMATION.
- 11. LOCAL SWITCHES TO CONTROL LIGHTS ON MECHANICAL PLATFORM C. EMERGENCY LIGHTS CONTROLLED SEPARATELY.
- 12. LOCAL SWITCHES TO CONTROL LIGHTS ON MECHANICAL PLATFORM C AND D. EMERGENCY LIGHTS CONTROLLED SEPARATELY.
- 13. LOCAL SWITCHES TO CONTROL LIGHTS ON MECHANICAL PLATFORM E SOUTH. EMERGENCY LIGHTS CONTROLLED SEPARATELY.
- 14. LOCAL SWITCHES TO CONTROL LIGHTS ON MECHANICAL PLATFORM E NORTH. EMERGENCY LIGHTS CONTROLLED SEPARATELY.
- 15. (5) BUTTON PRESET SCENE CONTROLLER WITH RAISE/LOWER. CONTROLLER TIES TO LIGHT DIGITAL ROOM CONTROL FOR SCENE CONTROL OF GYMNASIUM.
- 16. LIGHT FIXTURES AND CONTROLS TO BE DETERMINED.
- 17. LOCAL OVERRIDE SWITCH PROVIDED FOR EXTERIOR LIGHTING LOADS. REFER TO SHEET DETAIL C4E-602 FOR ADDITIONAL INFORMATION ON EXTERIOR LIGHTING CONTROL. LOCAL TIMER SWITCH FOR INTERIOR LIGHTING OVERRIDE.
- 18. CLOSED LOOP 0-10V PHOTOCELL CONNECTED TO LUMINAIRES IN DESIGNATED DAYLIGHTZONE.
- 19. REFER TO CONTROL DETAIL C4E-602.
- 20. OPEN LOOP DIMM PHOTOCELL MOUNTED PER MANUFACTURER'S RECOMMENDATIONS FOR OPTIMUM DAYLIGHT CONTROL.
- 21. TWO BUTTON SCENE CONTROLLER.
- 22. LIGHTING IN THIS SPACE TO BE CONTROLLED VIA LOCAL DIGITALLY DISTRIBUTED DIMMING RELAYS. COORDINATE RELAY BOX LOCATION WITH OWNER AND ARCHITECT PRIOR TO ROUGH-IN AND INSTALLATION.
- 23. ETC SMARTBAR WITH 6 OUTPUTS AND DMX CONTROL.
- 24. LUMINAIRES L6 SHALL BE WALL MOUNTED ABOVE DOOR AT 8'-0" AFF.
- 25. LOCAL SWITCH TO CONTROL LIGHTS ON MECHANICAL PLATFORM A. EMERGENCY LIGHTS CONTROLLED SEPARATELY.
- 26. REFER TO SHEET E-122A FOR LIGHTING ABOVE STAIR IN SECOND STORY SPACE.
- 27. MOUNT EXTERIOR EXIT SIGN TO WALL ABOVE FACIA, 10'-0" AFF. COORDINATE FINAL MOUNTING LOCATION WITH ARCHITECT IN FIELD PRIOR TO FINAL INSTALLATION.
- 28. PROVIDE ROTARY WHEEL SWITCH STATION FOR RGB CONTROL OF TYPE L8A PENDANT.

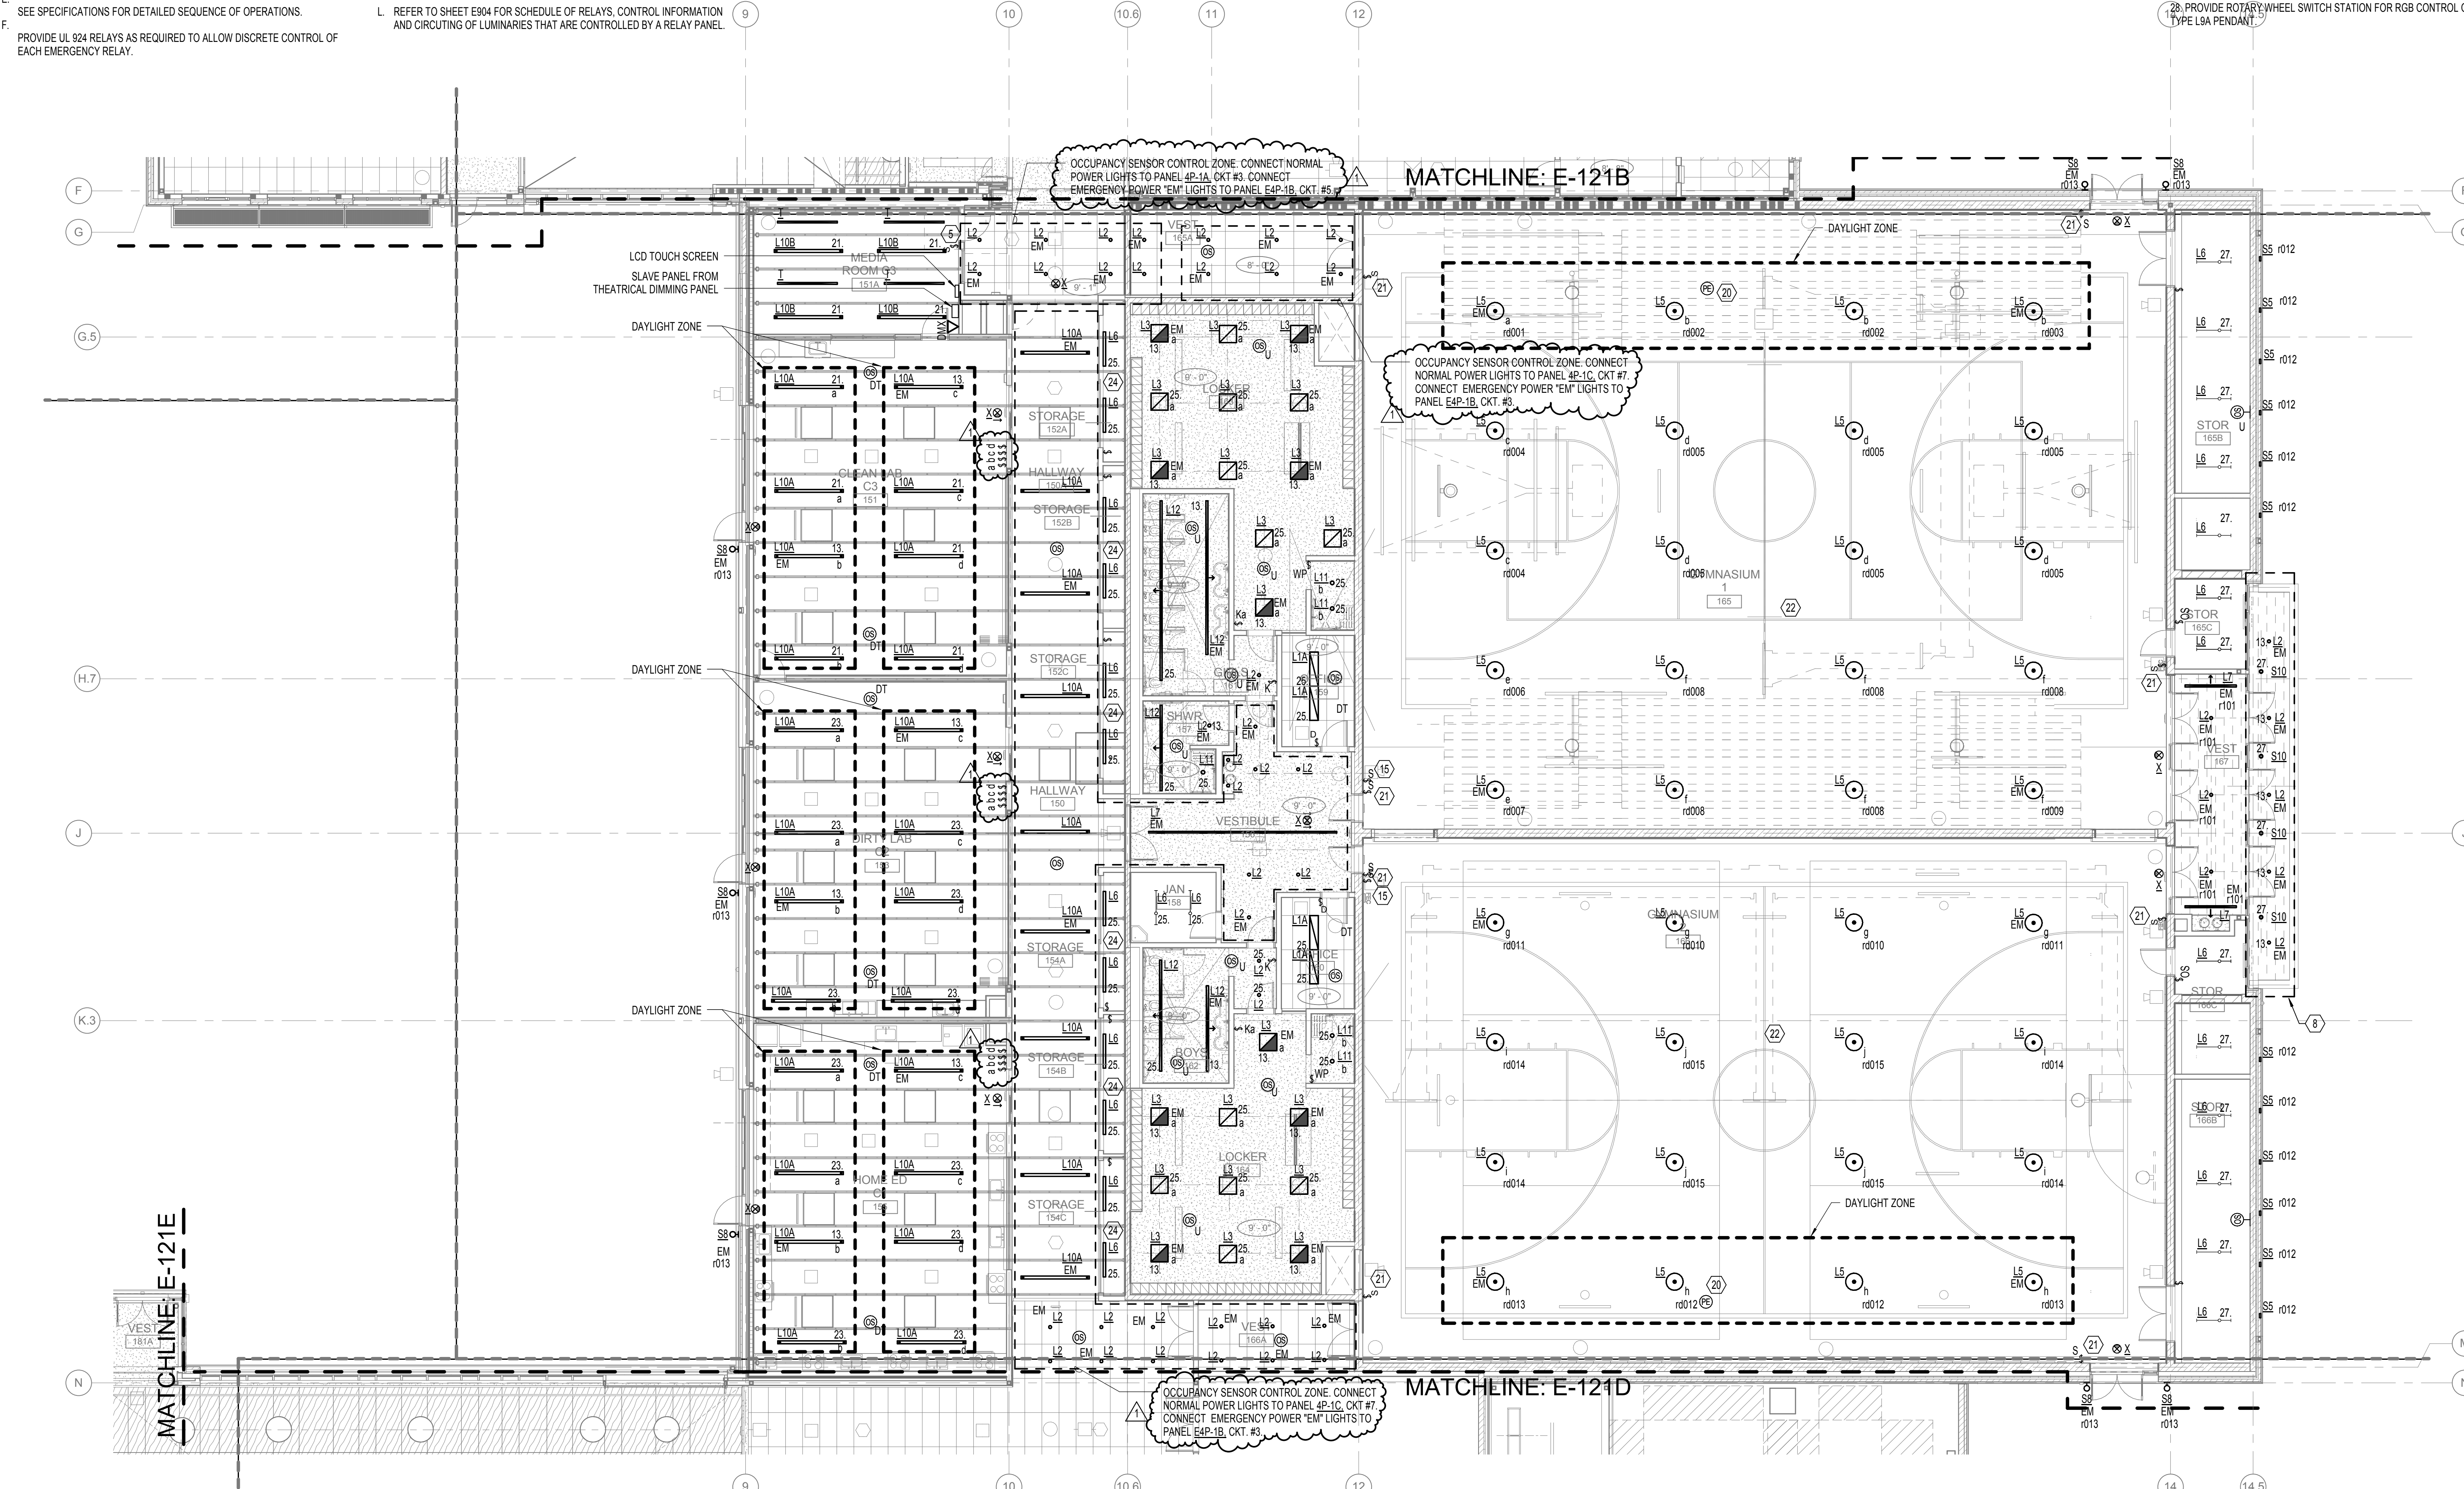

A1 FIRST FLOOR PLAN - ZONE C - LIGHTING
1/8" = 1'-0"

mahlum
ROBERTSON/SHERWOOD/ARCHITECTS PC
132 EAST BROADWAY, SUITE 540
EUGENE, OREGON 97401
541-342-8077
www.robertsonsherwood.com

MAHlum ARCHITECTS INC
1231 NW HOYT, SUITE 102
PORTLAND, OREGON 97209
503-224-4032
71 COLUMBIA, FLOOR 4
SEATTLE, WASHINGTON 98104
206-441-4151
www.mahlum.com

PAE
Portland | San Francisco | Seattle
pae-engineers.com

Luma
Portland | San Francisco | Seattle
Lumald.com

Professional Engineer
EUGENE, OREGON
EXPIRES 12-31-15

EUGENE SCHOOL DISTRICT 4J

4J

REPLACEMENT ROOSEVELT
MIDDLE SCHOOL
CIP NUMBER 410.566.001
680 EAST 24TH AVENUE
EUGENE, OREGON 97405
CIP NO. 410.566.001

MARK	DATE	DESCRIPTION
1	03-13-2015	ADDENDUM 6
		ISSUE DATE: FEBRUARY 18, 2015
		ISSUE: CONSTRUCTION DOCUMENTS
		VOLUME: PACKAGE 2 VOLUME 2
		PROJECT NO: 2013912.00
		DRAWN BY: KCB
		CHECKED BY: PJZ
		ORIGINAL SHEET SIZE: 30"X42"

FIRST FLOOR PLAN - ZONE C - LIGHTING

E-121C

GENERAL NOTES:


- A. CONTRACTOR SHALL CONTACT EWB2 TO VERIFY EASEMENT LOCATIONS AND TO OBTAIN UTILITY DESIGN/INSTALLATION DRAWINGS. EWB2 INFRASTRUCTURE SHALL BE INSTALLED PER UTILITY COMPANY REQUIREMENTS. INFRASTRUCTURE SHOWN ON THESE DRAWINGS IS DIAGRAMATIC AND APPROXIMATE. AND SHALL BE VERIFIED WITH EWB2 DESIGN DOCUMENTS PRIOR TO INSTALLATION.
- B. SEE THE ARCHITECTURAL DRAWINGS FOR EXACT LOCATION OF ALL DEVICES. REQUEST CLARIFICATIONS IN WRITING PRIOR TO INSTALLATION. INSTALLED, UNCOORDINATED ELEMENTS SHALL BE RELOCATED PER THE DIRECTION OF THE ARCHITECT WITHOUT ADDITIONAL COST TO THE PROJECT, OWNER OR DESIGN TEAM IF REQUIRED.
- C. EMERGENCY EGRESS LIGHTING WILL BE DESIGNATED BY "EM" AFTER THE LUMINAIRE TYPE AND WILL BE POWERED THROUGH THE GENERATOR.
- D. REFER TO E-602 FOR LIGHTING CONTROL SYSTEM INFORMATION.
- E. SEE SPECIFICATIONS FOR DETAILED SEQUENCE OF OPERATIONS.
- F. PROVIDE UL 924 RELAYS AS REQUIRED TO ALLOW DISCRETE CONTROL OF EACH EMERGENCY RELAY.
- G. SEE ZONED PLANS FOR ADDITIONAL INFORMATION.
- H. REFERENCE THE APPROPRIATE SPECIFICATION SECTION, 26-09-33 AND 26-09-43, FOR WALL STATIONS IN AREAS WITH PRE-SET SCENE CONTROL.
- I. ALL STANDARD NON-RELAY LIGHTS ON THIS SHEET WILL HOMERUN BACK TO 4P-1C UNLESS OTHERWISE NOTED. CIRCUIT NUMBERS ARE ADJACENT TO FIXTURES.
- J. ALL EMERGENCY NON-RELAY LIGHTS ON THIS SHEET WILL HOMERUN BACK TO 4P-1A UNLESS OTHERWISE NOTED. CIRCUIT NUMBERS ARE ADJACENT TO FIXTURES.
- K. EXIT SIGNS ARE TO BE PROVIDED TO MEET CODE REQUIREMENTS AND SHOULD BE LOCATED PER THE LIFE SAFETY DIAGRAM PROVIDED BY THE ARCHITECT IN QUANTITY TO NOT EXCEED CODE MAXIMUM DISTANCES BETWEEN SIGNS. ALL EXIT SIGNS ARE TO BE ON EMERGENCY POWER.
- L. REFER TO SHEET E904 FOR SCHEDULE OF RELAYS, CONTROL INFORMATION AND CIRCUITING OF LUMINARIES THAT ARE CONTROLLED BY A RELAY PANEL.

NOTES: MAY NOT APPLY TO ALL SHEETS.

- 1. REFER TO SHEET E-122A FOR LIGHTING ABOVE STAIR IN SECOND STORY SPACE.
- 2. PROVIDE SIGN ON BACK SIDE OF DOOR WITH THE WORDS "TURN OFF LIGHTS" IN LARGE HIGH CONTRAST FONT. PROVIDE MOCK-UP FOR ARCHITECTURAL APPROVAL PRIOR TO INSTALL.
- 3. REFER TO LIGHTING SITE PLAN E-101 FOR EXTERIOR LIGHTING AT MAIN ENTRY.
- 4. THEATRICAL LIGHTING AND CONTROLS TO BE PRICED SEPARATELY. PROVIDE UNIT PRICING FOR LUMINAIRE TYPES T1, T2, T3, AND T4 TO OWNER FOR SELECTION ON DESIRED QUANTITY OF EACH TYPE.
- 5. FOUR BUTTON WALL STATION FOR PRESET SCENE CONTROL OF HOUSE LIGHTING WITH RAISE/LOWER.
- 6. LCD TOUCH SCREEN PANEL TIED TO THEATRICAL LIGHTING CONTROL SYSTEM.
- 7. PROVIDE CONSOLE FOR DMX CONTROL.
- 8. LIGHTS IN GRADE AND IN EXTERIOR SOFFIT SHALL BE CONTROLLED ON LIGHTING RELAY #012. LIGHTS IN EXTERIOR SOFFIT SHALL BE CONTROLLED ON LIGHTING RELAY #013.
- 9. L20 LIGHTS TO BE CONTROLLED VIA LIGHTING RELAY #209.
- 10. LOCAL SWITCHES TO CONTROL LIGHTING ON MECHANICAL EQUIPMENT PLATFORM C. SEE SHEET E-122C FOR ADDITIONAL INFORMATION.

- 11. LOCAL SWITCHES TO CONTROL LIGHTS ON MECHANICAL PLATFORM C. EMERGENCY LIGHTS CONTROLLED SEPARATELY.
- 12. LOCAL SWITCHES TO CONTROL LIGHTS ON MECHANICAL PLATFORM C AND D. EMERGENCY LIGHTS CONTROLLED SEPARATELY.
- 13. LOCAL SWITCHES TO CONTROL LIGHTS ON MECHANICAL PLATFORM E SOUTH. EMERGENCY LIGHTS CONTROLLED SEPARATELY.
- 14. LOCAL SWITCHES TO CONTROL LIGHTS ON MECHANICAL PLATFORM E NORTH. EMERGENCY LIGHTS CONTROLLED SEPARATELY.
- 15. (5) BUTTON PRESET SCENE CONTROLLER WITH RAISE/LOWER. CONTROLLER TIES TO LIGHT DIGITAL ROOM CONTROL FOR SCENE CONTROL OF GYMNASIUM.
- 16. LIGHT FIXTURES AND CONTROLS TO BE DETERMINED.
- 17. LOCAL OVERRIDE SWITCH PROVIDED FOR EXTERIOR LIGHTING LOADS. REFER TO SHEET DETAIL C4E-602 FOR ADDITIONAL INFORMATION ON EXTERIOR LIGHTING CONTROL. LOCAL TIMER SWITCH FOR INTERIOR LIGHTING OVERRIDE.
- 18. CLOSED LOOP 0-10V PHOTOCELL CONNECTED TO LUMINAIRES IN DESIGNATED DAYLIGHTZONE.
- 19. REFER TO CONTROL DETAIL C4E-602.
- 20. OPEN LOOP DIM PHOTOCELL MOUNTED PER MANUFACTURER'S RECOMMENDATIONS FOR OPTIMUM DAYLIGHT CONTROL.
- 21. TWO BUTTON SCENE CONTROLLER.

- 22. LIGHTING IN THIS SPACE TO BE CONTROLLED VIA LOCAL DIGITALLY DISTRIBUTED DIMMING RELAYS. COORDINATE RELAY BOX LOCATION WITH OWNER AND ARCHITECT PRIOR TO ROUGH-IN AND INSTALLATION.
- 23. ETC SMARTBAR WITH 6 OUTPUTS AND DMX CONTROL.
- 24. LUMINAIRES L6 SHALL BE WALL MOUNTED ABOVE DOOR AT 8'-0" AFF.
- 25. LOCAL SWITCH TO CONTROL LIGHTS ON MECHANICAL PLATFORM A. EMERGENCY LIGHTS CONTROLLED SEPARATELY.
- 26. REFER TO SHEET E-122A FOR LIGHTING ABOVE STAIR IN SECOND STORY SPACE.
- 27. MOUNT EXTERIOR EXIT SIGN TO WALL ABOVE FACIA. 10'-0" AFS. COORDINATE FINAL MOUNTING LOCATION WITH ARCHITECT IN FIELD PRIOR TO FINAL INSTALLATION.
- 28. PROVIDE ROTARY WHEEL SWITCH STATION FOR RGB CONTROL OF TYPE L9A PENDANT.

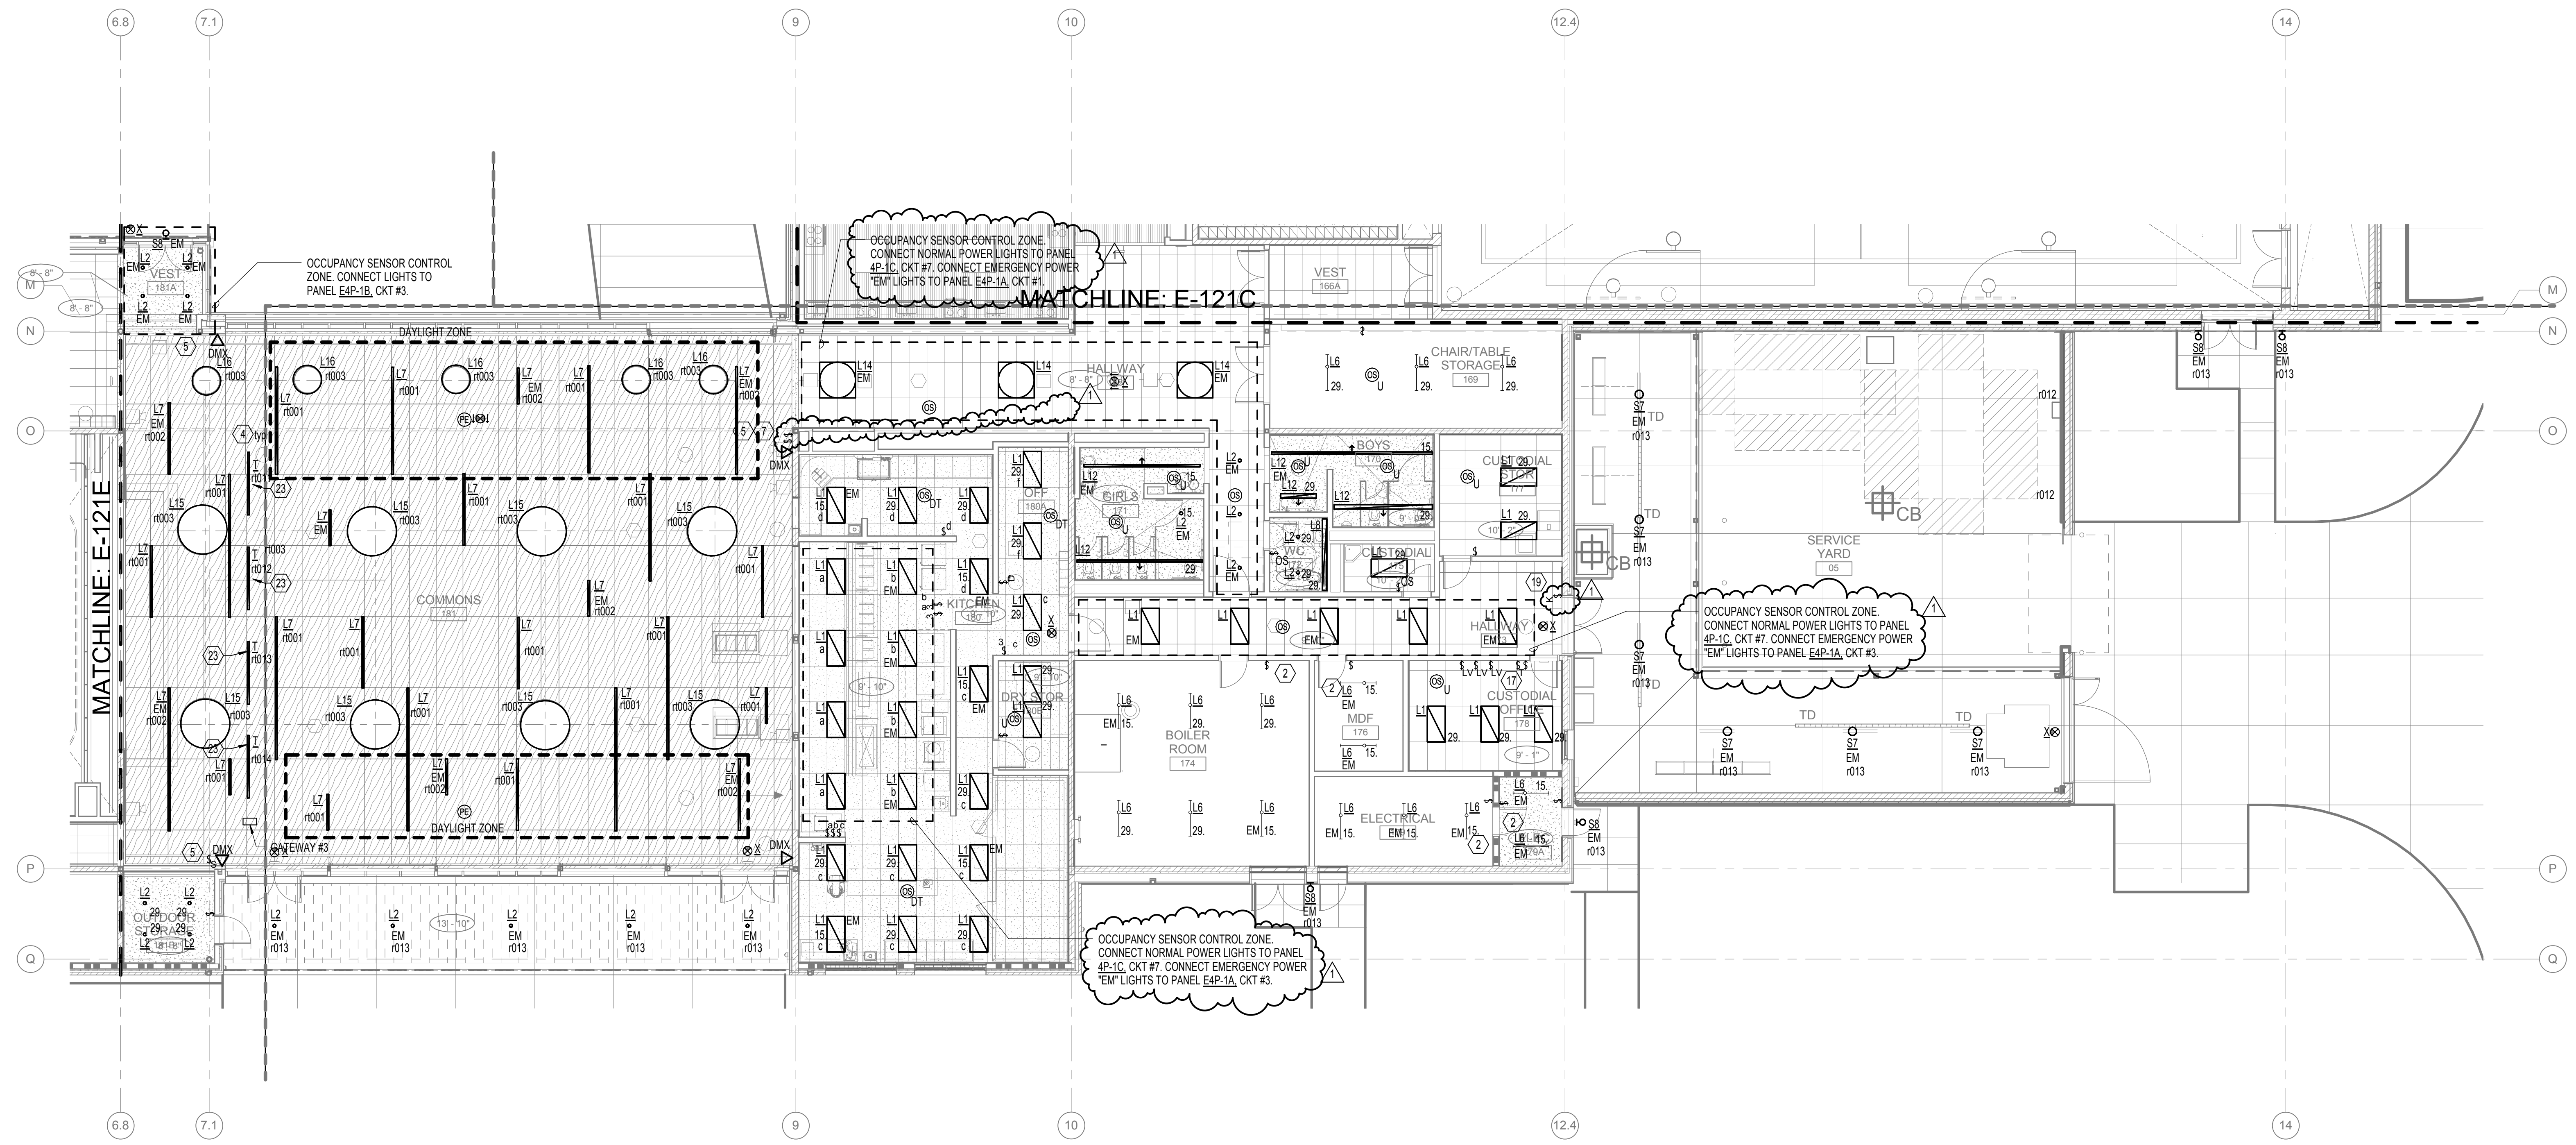

A1 FIRST FLOOR PLAN - ZONE D - LIGHTING
1/8" = 1'-0"

mahlum
Robertson, Sherwood Architects


ROBERTSON/SHERWOOD/ARCHITECTS PC
132 EAST BROADWAY, SUITE 540
EUGENE, OREGON 97401
541-342-8077
www.robertsonsherwood.com

MAHLUM ARCHITECTS INC
1231 NW HOYT, SUITE 102
PORTLAND, OREGON 97209
503-224-4032


71 COLUMBIA FLOOR 4
SEATTLE, WASHINGTON 98104
206-441-1151
www.mahlum.com

PAE
Portland | San Francisco | Seattle
pae-engineers.com

Lumal
Portland | San Francisco | Seattle
Lumald.com

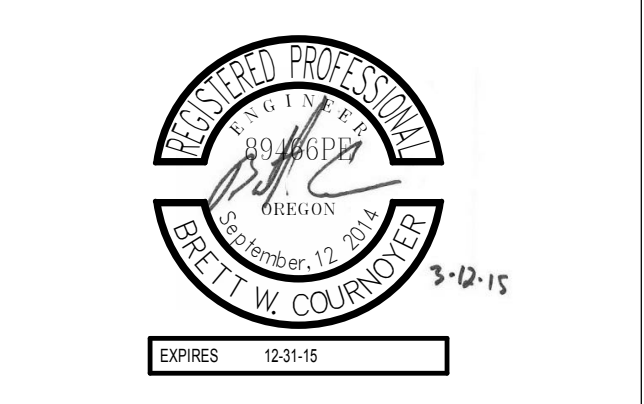

EUGENE SCHOOL DISTRICT 4J

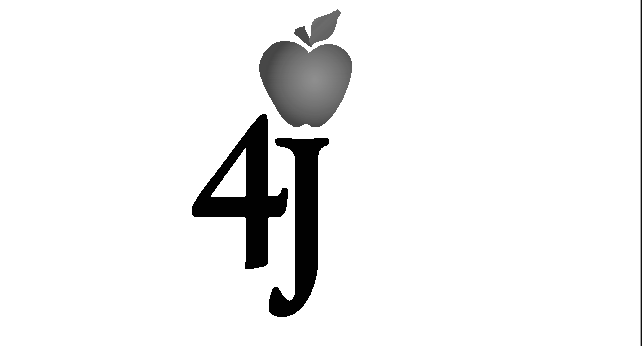

REPLACEMENT ROOSEVELT MIDDLE SCHOOL
CIP NUMBER 410.566.001
680 EAST 24TH AVENUE
EUGENE, OREGON 97405
CIP NO. 410.566.001

MARK	DATE	DESCRIPTION
1	03-13-2015	ADDENDUM 6
ISSUE DATE: FEBRUARY 18, 2015		
ISSUE: CONSTRUCTION DOCUMENTS		
VOLUME: PACKAGE 2 VOLUME 2		
PROJECT NO: 2013912.00		
DRAWN BY: KCB		
CHECKED BY: PJZ		
COPYRIGHT MAHLUM ARCHITECTS, INC. 2014 ORIGINAL SHEET SIZE 24"X36"		

A FIRST FLOOR PLAN - ZONE D - LIGHTING


E-121D

GENERAL NOTES:

- A. CONTRACTOR SHALL CONTACT EWEB TO VERIFY EASEMENT LOCATIONS AND TO OBTAIN UTILITY DESIGN/INSTALLATION DRAWINGS. EWEB INFRASTRUCTURE SHALL BE INSTALLED PER UTILITY COMPANY REQUIREMENTS. INFRASTRUCTURE SHOWN ON THESE DRAWINGS IS DIAGRAMATIC AND APPROXIMATE, AND SHALL BE VERIFIED WITH EWEB DESIGN DOCUMENTS PRIOR TO INSTALLATION.
- B. SEE THE ARCHITECTURAL DRAWINGS FOR EXACT LOCATION OF ALL DEVICES. REQUEST CLARIFICATIONS IN WRITING PRIOR TO INSTALLATION. UNCOORDINATED ELEMENTS SHALL BE RELOCATED PER THE DIRECTION OF THE ARCHITECT WITHOUT ADDITIONAL COST TO THE PROJECT. OWNER OR DESIGN TEAM IF REQUIRED.
- C. EMERGENCY EGRESS LIGHTING WILL BE DESIGNATED BY 'EM' AFTER THE LUMINAIRE TYPE AND WILL BE POWERED THROUGH THE GENERATOR.
- D. REFER TO E-602 FOR LIGHTING CONTROL SYSTEM INFORMATION.
- E. SEE SPECIFICATIONS FOR DETAILED SEQUENCE OF OPERATIONS.
- F. PROVIDE UL 924 RELAYS AS REQUIRED TO ALLOW DISCRETE CONTROL OF EACH EMERGENCY RELAY.
- G. SEE ZONED PLANS FOR ADDITIONAL INFORMATION.
- H. ALL STANDARD NON-RELAY LIGHTS ON THIS SHEET WILL HOMERUN BACK TO 4P-1B UNLESS OTHERWISE NOTED. CIRCUIT NUMBERS ARE ADJACENT TO FIXTURES.
- I. ALL EMERGENCY NON-RELAY LIGHTS ON THIS SHEET WILL HOMERUN BACK TO E4P-1A UNLESS OTHERWISE NOTED. CIRCUIT NUMBERS ARE ADJACENT TO FIXTURES.
- J. EXIT SIGNS ARE TO BE PROVIDED TO MEET CODE REQUIREMENTS AND SHOULD BE LOCATED PER THE LIFE SAFETY DIAGRAM PROVIDED BY THE ARCHITECT IN QUANTITY TO NOT EXCEED CODE MAXIMUM DISTANCES BETWEEN SIGNS. ALL EXIT SIGNS ARE TO BE ON EMERGENCY POWER.
- K. REFER TO SHEET E904 FOR SCHEDULE OF RELAYS, CONTROL INFORMATION AND CIRCUITING OF LUMINARIES THAT ARE CONTROLLED BY A RELAY PANEL.

NOTES: MAY NOT APPLY TO ALL SHEETS

- 1. REFER TO SHEET E-122A FOR LIGHTING ABOVE STAIR IN SECOND STORY SPACE.
- 2. PROVIDE SIGN ON BACK SIDE OF DOOR WITH THE WORDS "TURN OFF LIGHTS" IN LARGE HIGH CONTRAST FONT. PROVIDE MOCK-UP FOR ARCHITECTURAL APPROVAL PRIOR TO INSTALL.
- 3. REFER TO LIGHTING SITE PLAN E-101 FOR EXTERIOR LIGHTING AT MAIN ENTRY.
- 4. THEATRICAL LIGHTING AND CONTROLS TO BE PRICED SEPARATELY. PROVIDE UNIT PRICING FOR LUMINAIRE TYPES T1, T2, T3, AND T4 TO OWNER FOR SELECTION ON DESIRED QUANTITY OF EACH TYPE.
- 5. FOUR BUTTON WALL STATION FOR PRESET SCENE CONTROL OF HOUSE LIGHTING WITH RAISE/LOWER.
- 6. LCD TOUCH SCREEN PANEL TIED TO THE THEATRICAL LIGHTING CONTROL SYSTEM.
- 7. PROVIDE CONSOLE FOR DMX CONTROL.
- 8. LIGHTS IN GRADE AND IN EXTERIOR SOFFIT SHALL BE CONTROLLED ON LIGHTING RELAY #12. LIGHTS IN EXTERIOR SOFFIT SHALL BE CONTROLLED ON LIGHTING RELAY #13.
- 9. L20 LIGHTS TO BE CONTROLLED VIA LIGHTING RELAY #209.
- 10. LOCAL SWITCHES TO CONTROL LIGHTING ON MECHANICAL EQUIPMENT PLATFORM C. SEE SHEET E-122C FOR ADDITIONAL INFORMATION.
- 11. LOCAL SWITCHES TO CONTROL LIGHTS ON MECHANICAL PLATFORM C. EMERGENCY LIGHTS CONTROLLED SEPARATELY.
- 12. LOCAL SWITCHES TO CONTROL LIGHTS ON MECHANICAL PLATFORM C AND D. EMERGENCY LIGHTS CONTROLLED SEPARATELY.
- 13. LOCAL SWITCHES TO CONTROL LIGHTS ON MECHANICAL PLATFORM E SOUTH. EMERGENCY LIGHTS CONTROLLED SEPARATELY.
- 14. LOCAL SWITCHES TO CONTROL LIGHTS ON MECHANICAL PLATFORM E NORTH. EMERGENCY LIGHTS CONTROLLED SEPARATELY.
- 15. (5) BUTTON PRESET SCENE CONTROLLER WITH RAISE/LOWER CONTROLLER TIES TO LIGHT DIGITAL ROOM CONTROL FOR SCENE CONTROL OF GYMNASIUM.
- 16. LIGHT FIXTURES AND CONTROLS TO BE DETERMINED.
- 17. LOCAL OVERRIDE SWITCH PROVIDED FOR EXTERIOR LIGHTING LOADS. REFER TO SHEET DETAIL C4E-602 FOR ADDITIONAL INFORMATION ON EXTERIOR LIGHTING CONTROL. LOCAL TIMER SWITCH FOR INTERIOR LIGHTING OVERRIDE.
- 18. CLOSED LOOP 0-10V PHOTOCELL CONNECTED TO LUMINAIRES IN DESIGNATED DAYLIGHTZONE.
- 19. REFER TO CONTROL DETAIL C4E-602.
- 20. OPEN LOOP DLM PHOTOCELL MOUNTED PER MANUFACTURER'S RECOMMENDATIONS FOR OPTIMUM DAYLIGHT CONTROL.
- 21. TWO BUTTON SCENE CONTROLLER.
- 22. LIGHTING IN THIS SPACE TO BE CONTROLLED VIA LOCAL DIGITALLY DISTRIBUTED DIMMING RELAYS. COORDINATE RELAY BOX LOCATION WITH OWNER AND ARCHITECT PRIOR TO ROUGH-IN AND INSTALLATION.
- 23. ETC SMARTBAR WITH 6 OUTPUTS AND DMX CONTROL.
- 24. LUMINAIRE L6 SHALL BE WALL MOUNTED ABOVE DOOR AT 8'-0" AFF.
- 25. LOCAL SWITCH TO CONTROL LIGHTS ON MECHANICAL PLATFORM A. EMERGENCY LIGHTS CONTROLLED SEPARATELY.
- 26. REFER TO SHEET E-122A FOR LIGHTING ABOVE STAIR IN SECOND STORY SPACE.
- 27. MOUNT EXTERIOR EXIT SIGN TO WALL ABOVE FACIA. 10'-0" AFF. COORDINATE FINAL MOUNTING LOCATION WITH ARCHITECT IN FIELD PRIOR TO FINAL INSTALLATION.
- 28. PROVIDE ROTARY WHEEL SWITCH STATION FOR RGB CONTROL OF TYPE L5A PENDANT.

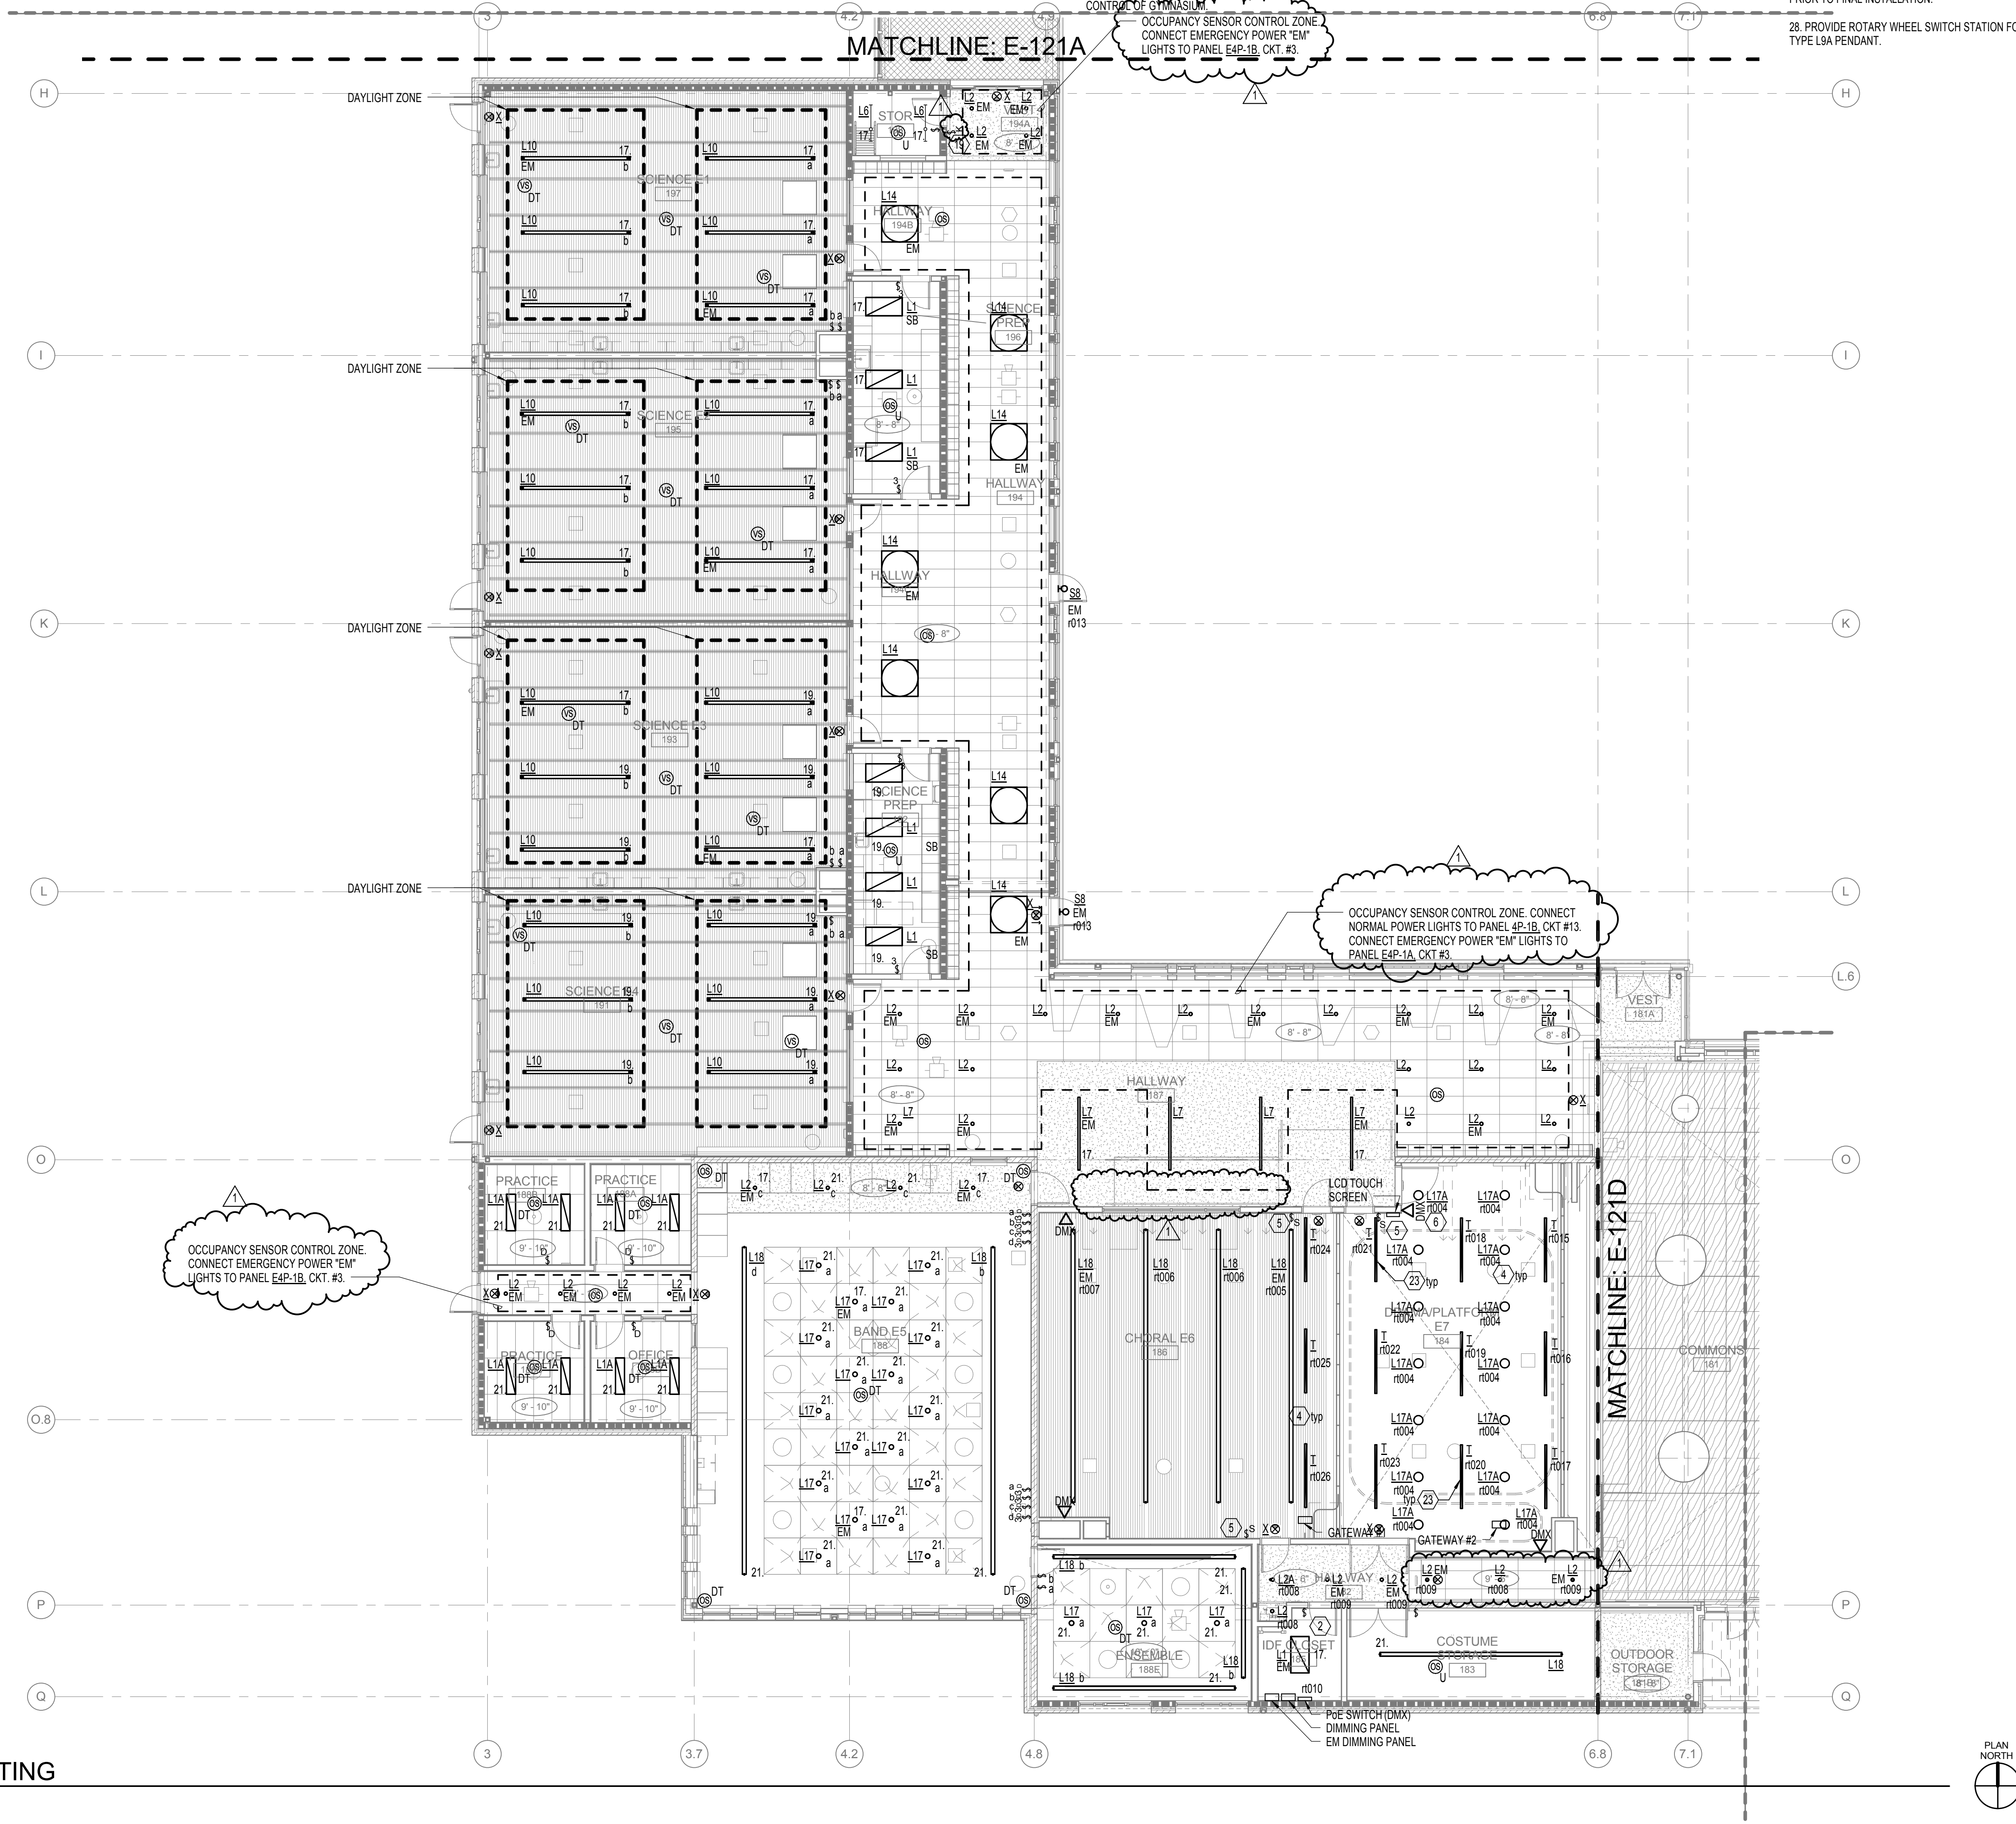

A1 FIRST FLOOR PLAN - ZONE E - LIGHTING
1/8" = 1'-0"

mahlum
ROBERTSON/SHERWOOD/ARCHITECTS PC
132 EAST BROADWAY, SUITE 540
EUGENE, OREGON 97401
541-342-8077
www.robertsonsherwood.com

MAHLUM ARCHITECTS INC
1231 NW HOYT, SUITE 102
PORTLAND, OREGON 97209
503-224-4032

71 COLUMBIA, FLOOR 4
SEATTLE, WASHINGTON 98104
206-441-6151
www.mahlum.com

PAE
Portland | San Francisco | Seattle
pae-engineers.com

Luma
Portland | San Francisco | Seattle
Lumald.com

Professional Engineer
EUGENE, OREGON
7-0-15
EXPIRES 12-31-16

EUGENE SCHOOL DISTRICT 4J
4J

REPLACEMENT ROOSEVELT
MIDDLE SCHOOL
CIP NUMBER 410.566.001
680 EAST 24TH AVENUE
EUGENE, OREGON 97405
CIP NO. 410.566.001

MARK	DATE	DESCRIPTION
1	03-13-2015	ADDENDUM 6
ISSUE DATE:	FEBRUARY 18, 2015	
ISSUE:	CONSTRUCTION DOCUMENTS	
VOLUME:	PACKAGE 2 VOLUME 2	
PROJECT NO.:	2013912.00	
DRAWN BY:	KCB	
CHECKED BY:	PJZ	ORIGINAL SHEET SIZE 30"X42"

FIRST FLOOR PLAN - ZONE E - LIGHTING

E-121E

GENERAL NOTES:

- A. CONTRACTOR SHALL CONTACT EWB TO VERIFY EASEMENT LOCATIONS AND TO OBTAIN UTILITY DESIGN/INSTALLATION DRAWINGS. EWB INFRASTRUCTURE SHALL BE INSTALLED PER UTILITY COMPANY REQUIREMENTS. INFRASTRUCTURE SHOWN ON THESE DRAWINGS IS DIAGRAMATIC AND APPROXIMATE. AND SHALL BE VERIFIED WITH EWB DESIGN DOCUMENTS PRIOR TO INSTALLATION.
- B. SEE THE ARCHITECTURAL DRAWINGS FOR EXACT LOCATION OF ALL DEVICES. REQUEST CLARIFICATIONS IN WRITING PRIOR TO INSTALLATION. INSTALLED UNCOORDINATED ELEMENTS SHALL BE RELOCATED PER THE DIRECTION OF THE ARCHITECT WITHOUT ADDITIONAL COST TO THE PROJECT, OWNER OR DESIGN TEAM IF REQUIRED.
- C. EMERGENCY EGRESS LIGHTING WILL BE DESIGNATED BY 'EM' AFTER THE LUMINAIRE TYPE AND WILL BE POWERED THROUGH THE GENERATOR.
- D. REFER TO E-602 FOR LIGHTING CONTROL SYSTEM INFORMATION.
- E. SEE SPECIFICATIONS FOR DETAILED SEQUENCE OF OPERATIONS.
- F. PROVIDE UL 924 RELAYS AS REQUIRED TO ALLOW DISCRETE CONTROL OF EACH EMERGENCY RELAY.


- G. SEE ZONED PLANS FOR ADDITIONAL INFORMATION.
- H. REFERENCE THE APPROPRIATE SPECIFICATION SECTION, 26-09-33 AND 26-09-43, FOR WALL STATIONS IN AREAS WITH PRE-SET SCENE CONTROL.
- I. ALL STANDARD NON-RELAY LIGHTS ON THIS SHEET WILL HOMERUN BACK TO 4P-1C UNLESS OTHERWISE NOTED. CIRCUIT NUMBERS ARE ADJACENT TO FIXTURES.
- J. ALL EMERGENCY NON-RELAY LIGHTS ON THIS SHEET WILL HOMERUN BACK TO E4P-1A UNLESS OTHERWISE NOTED. CIRCUIT NUMBERS ARE ADJACENT TO FIXTURES.
- K. EXIT SIGNS ARE TO BE PROVIDED TO MEET CODE REQUIREMENTS AND SHOULD BE LOCATED PER THE LIFE SAFETY DIAGRAM PROVIDED BY THE ARCHITECT IN QUANTITY TO NOT EXCEED CODE MAXIMUM DISTANCES BETWEEN SIGNS. ALL EXIT SIGNS ARE TO BE ON EMERGENCY POWER.
- L. REFER TO SHEET E904 FOR SCHEDULE OF RELAYS, CONTROL INFORMATION AND CIRCUITING OF LUMINAIRES THAT ARE CONTROLLED BY A RELAY PANEL.

NOTES: MAY NOT APPLY TO ALL SHEETS.

- 1. REFER TO SHEET E-122A FOR LIGHTING ABOVE STAIR IN SECOND STORY SPACE.
- 2. PROVIDE SIGN ON BACK SIDE OF DOOR WITH THE WORDS "TURN OFF LIGHTS" IN LARGE HIGH CONTRAST FONT. PROVIDE MOCK-UP FOR ARCHITECTURAL APPROVAL PRIOR TO INSTALL.
- 3. REFER TO LIGHTING SITE PLAN E-101 FOR EXTERIOR LIGHTING AT MAIN ENTRY.
- 4. THEATRICAL LIGHTING AND CONTROLS TO BE PRICED SEPARATELY. PROVIDE UNIT PRICING FOR LUMINAIRE TYPES T1, T2, T3, AND T4 TO OWNER FOR SELECTION ON DESIRED QUANTITY OF EACH TYPE.
- 5. FOUR BUTTON WALL STATION FOR PRESET SCENE CONTROL OF HOUSE LIGHTING WITH RAISE/LOWER.
- 6. LCD TOUCH SCREEN PANEL TIED TO THE THEATRICAL LIGHTING CONTROL SYSTEM.
- 7. PROVIDE CONSOLE FOR DMX CONTROL.
- 8. LIGHTS IN GRADE AND IN EXTERIOR SOFFIT SHALL BE CONTROLLED ON LIGHTING RELAY '012. LIGHTS IN EXTERIOR SOFFIT SHALL BE CONTROLLED ON LIGHTING RELAY '013.
- 9. L20 LIGHTS TO BE CONTROLLED VIA LIGHTING RELAY '209.
- 10. LOCAL SWITCHES TO CONTROL LIGHTING ON MECHANICAL EQUIPMENT PLATFORM C. SEE SHEET E-122C FOR ADDITIONAL INFORMATION.
- 11. LOCAL SWITCHES TO CONTROL LIGHTS ON MECHANICAL PLATFORM C. EMERGENCY LIGHTS CONTROLLED SEPARATELY.
- 12. LOCAL SWITCHES TO CONTROL LIGHTS ON MECHANICAL PLATFORM E SOUTH. EMERGENCY LIGHTS CONTROLLED SEPARATELY.
- 13. LOCAL SWITCHES TO CONTROL LIGHTS ON MECHANICAL PLATFORM E NORTH. EMERGENCY LIGHTS CONTROLLED SEPARATELY.
- 14. LOCAL SWITCHES TO CONTROL LIGHTS ON MECHANICAL PLATFORM E SOUTH. EMERGENCY LIGHTS CONTROLLED SEPARATELY.
- 15. (5) BUTTON PRESET SCENE CONTROLLER WITH RAISE/LOWER. CONTROLLER TIES TO ALIGHT DIGITAL ROOM CONTROL FOR SCENE CONTROL OF GYMNASIUM.

- 16. LIGHT FIXTURES AND CONTROLS TO BE DETERMINED.
- 17. LOCAL OVERRIDE SWITCH PROVIDED FOR EXTERIOR LIGHTING LOADS. REFER TO SHEET DETAIL C4E-602 FOR ADDITIONAL INFORMATION ON EXTERIOR LIGHTING CONTROL. LOCAL TIMER SWITCH FOR INTERIOR LIGHTING OVERRIDE.
- 18. CLOSED LOOP 0-10V PHOTOCELL CONNECTED TO LUMINAIRES IN DESIGNATED DAYLIGHT ZONE.
- 19. REFER TO CONTROL DETAIL C4E-602.
- 20. OPEN LOOP DLM PHOTOCELL MOUNTED PER MANUFACTURER'S RECOMMENDATIONS FOR OPTIMUM DAYLIGHT CONTROL.
- 21. TWO BUTTON SCENE CONTROLLER.

- 22. LIGHTING IN THIS SPACE TO BE CONTROLLED VIA LOCAL DIGITALLY DISTRIBUTED DIMMING RELAYS. COORDINATE RELAY BOX LOCATION WITH OWNER AND ARCHITECT PRIOR TO ROUGH-IN AND INSTALLATION.
- 23. ETC SMARTBAR WITH 6 OUTPUTS AND DMX CONTROL.
- 24. LUMINAIRES L6 SHALL BE WALL MOUNTED ABOVE DOOR AT 8'-0" AFF.
- 25. LOCAL SWITCH TO CONTROL LIGHTS ON MECHANICAL PLATFORM A. EMERGENCY LIGHTS CONTROLLED SEPARATELY.
- 26. REFER TO SHEET E-122A FOR LIGHTING ABOVE STAIR IN SECOND STORY SPACE.
- 27. MOUNT EXTERIOR EXIT SIGN TO WALL ABOVE FACIA. 10'-0" AFF. COORDINATE FINAL MOUNTING LOCATION WITH ARCHITECT IN FIELD PRIOR TO FINAL INSTALLATION.
- 28. PROVIDE ROTARY WHEEL SWITCH STATION FOR RGB CONTROL OF TYPE L9A PENDANT.

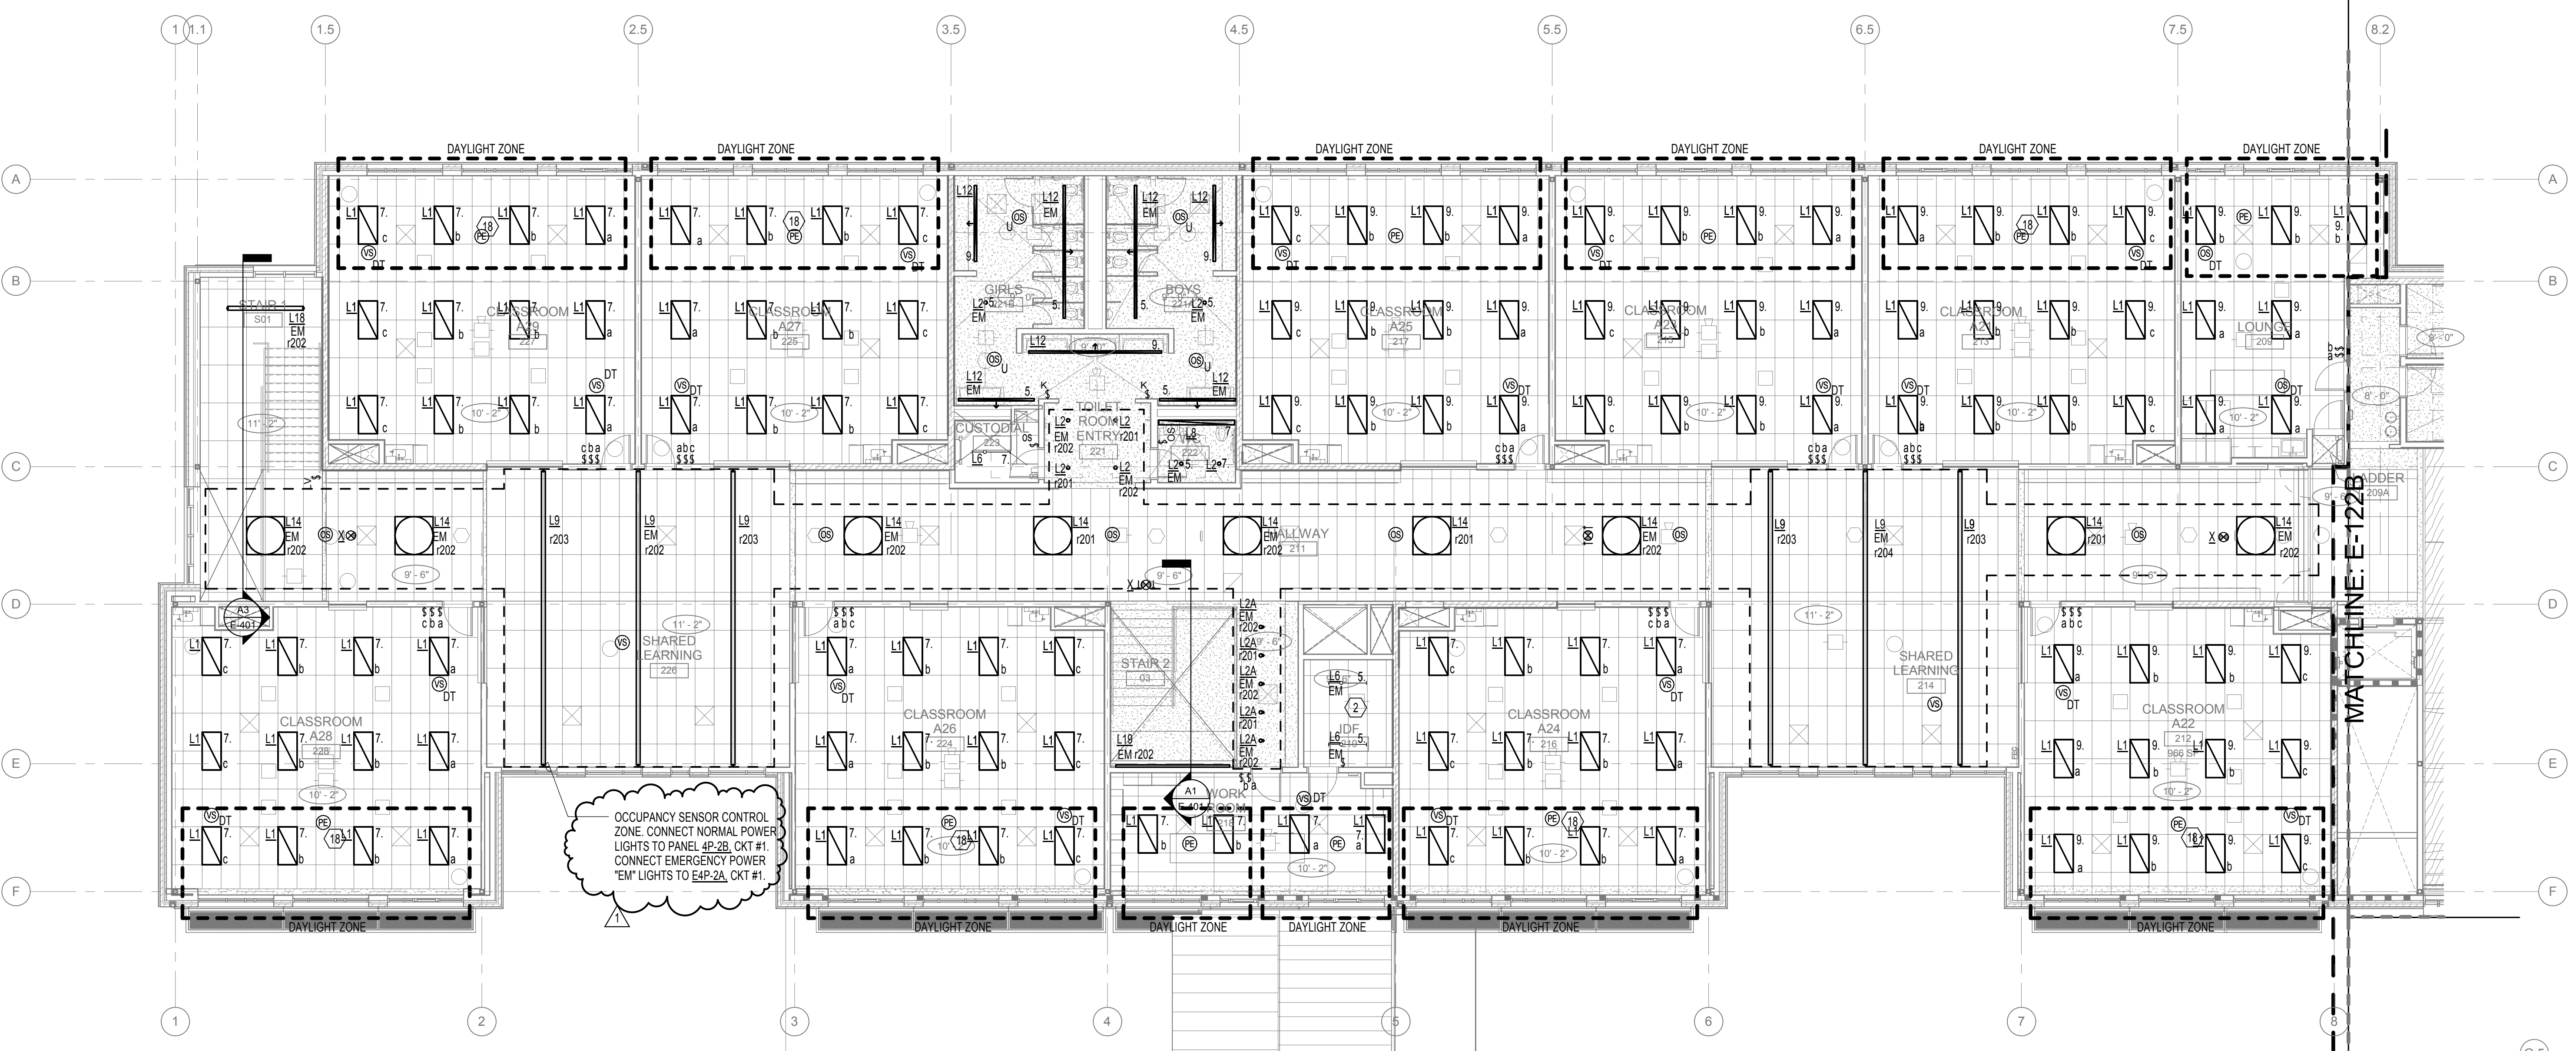


(A1) SECOND FLOOR PLAN - ZONE A - LIGHTING
1/8" = 1'-0"

mahlum
ROBERTSON/SHERWOOD/ARCHITECTS PC
132 EAST BROADWAY, SUITE 540
EUGENE, OREGON 97401
541-342-8077
www.robertsonsherwood.com

PAE
Portland | San Francisco | Seattle
pae-engineers.com

Luma
Portland | San Francisco | Seattle
Lumald.com

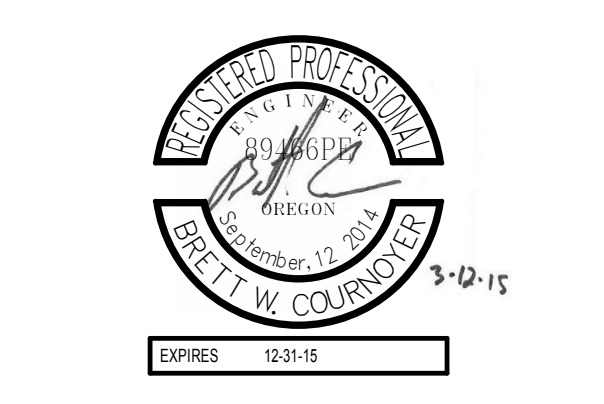

EUGENE SCHOOL DISTRICT 4J

4J

JUPPER FORUM
2011
REPLACEMENT ROOSEVELT MIDDLE SCHOOL
CIP NUMBER 410.566.001
680 EAST 24TH AVENUE
EUGENE, OREGON 97405
CIP NO. 410.566.001

MARK	DATE	DESCRIPTION
1	03-13-2015	ADDENDUM 6
ISSUE DATE: FEBRUARY 18, 2015		
ISSUE: CONSTRUCTION DOCUMENTS		
VOLUME: PACKAGE 2 VOLUME 2		
PROJECT NO.: 2013912.00		
DRAWN BY: KCB		
CHECKED BY: P.J.Z.		
COPYRIGHT MAHLUM/ARCHITECTS, INC. 2014 ORIGINAL SHEET SIZE 24"X36"		

SECOND FLOOR PLAN - ZONE A - LIGHTING

E-122A

NOTES: MAY NOT APPLY TO ALL SHEETS

- REFER TO SHEET E-122A FOR LIGHTING ABOVE STAIR IN SECOND STORY SPACE.
- PROVIDE SIGN ON BACK SIDE OF DOOR WITH THE WORDS "TURN OFF LIGHTS" IN LARGE HIGH CONTRAST FONT. PROVIDE MOCK-UP FOR ARCHITECTURAL APPROVAL PRIOR TO INSTALL.
- REFER TO LIGHTING SITE PLAN E-101 FOR EXTERIOR LIGHTING AT MAIN ENTRY.
- THEATRICAL LIGHTING AND CONTROLS TO BE PRICED SEPARATELY. PROVIDE UNIT PRICING FOR LUMINAIRE TYPES T1, T2, T3, AND T4 TO OWNER FOR SELECTION ON DESIRED QUANTITY OF EACH TYPE.
- FOUR BUTTON WALL STATION FOR PRESET SCENE CONTROL OF HOUSE LIGHTING WITH RAISE/LOWER.

6. LCD TOUCH SCREEN PANEL TIED TO THEATRICAL LIGHTING CONTROL SYSTEM.
7. PROVIDE CONSOLE FOR DMX CONTROL.
8. LIGHTS INGRADE AND IN EXTERIOR SOFFIT SHALL BE CONTROLLED ON LIGHTING RELAY #12. LIGHTS IN EXTERIOR SOFFIT SHALL BE CONTROLLED ON LIGHTING RELAY #13.
9. L20 LIGHTS TO BE CONTROLLED VIA LIGHTING RELAY #20.
10. LOCAL SWITCHES TO CONTROL LIGHTING ON MECHANICAL EQUIPMENT PLATFORM C. SEE SHEET E-122C FOR ADDITIONAL INFORMATION.

11. LOCAL SWITCHES TO CONTROL LIGHTS ON MECHANICAL PLATFORM C. EMERGENCY LIGHTS CONTROLLED SEPARATELY.
12. LOCAL SWITCHES TO CONTROL LIGHTS ON MECHANICAL PLATFORM C AND D. EMERGENCY LIGHTS CONTROLLED SEPARATELY.
13. LOCAL SWITCHES TO CONTROL LIGHTS ON MECHANICAL PLATFORM E SOUTH. EMERGENCY LIGHTS CONTROLLED SEPARATELY.
14. LOCAL SWITCHES TO CONTROL LIGHTS ON MECHANICAL PLATFORM E NORTH. EMERGENCY LIGHTS CONTROLLED SEPARATELY.
15. (B) BUTTON PRESET SCENE CONTROLLER WITH RAISE/LOWER CONTROLLER TIES TO FLIGHT DIGITAL ROOM CONTROL FOR SCENE CONTROL OF GYMNASIUM.

16. LIGHT FIXTURES AND CONTROLS TO BE DETERMINED.
17. LOCAL OVERRIDE SWITCH PROVIDED FOR EXTERIOR LIGHTING LOADS. REFER TO SHEET DETAIL C4E-602 FOR ADDITIONAL INFORMATION ON EXTERIOR LIGHTING CONTROL. LOCAL TIMER SWITCH FOR INTERIOR LIGHTING OVERRIDE.
18. CLOSED LOOP 0-10V PHOTOCELL CONNECTED TO LUMINAIRES IN DESIGNATED DAYLIGHT ZONE.
19. REFER TO CONTROL DETAIL C4E-602.
20. OPEN LOOP DIM PHOTOCELL MOUNTED PER MANUFACTURER'S RECOMMENDATIONS FOR OPTIMUM DAYLIGHT CONTROL.

21. TWO BUTTON SCENE CONTROLLER.
22. LIGHTING IN THIS SPACE TO BE CONTROLLED VIA LOCAL DIGITALLY DISTRIBUTED DIMMING RELAYS. COORDINATE RELAY BOX LOCATION WITH OWNER AND ARCHITECT PRIOR TO ROUGH-IN AND INSTALLATION.
23. ETC SMARTBAR WITH 6 OUTPUTS AND DMX CONTROL.
24. LUMINAIRE L6 SHALL BE WALL MOUNTED ABOVE DOOR AT 8'-0" AFF.
25. LOCAL SWITCH TO CONTROL LIGHTS ON MECHANICAL PLATFORM A. EMERGENCY LIGHTS CONTROLLED SEPARATELY.
26. REFER TO SHEET E-122A FOR LIGHTING ABOVE STAIR IN SECOND STORY SPACE.
27. PROVIDE ROTARY WHEEL SWITCH STATION FOR RGB CONTROL OF TYPE L8A PENDANT.

GENERAL NOTES:


- CONTRACTOR SHALL CONTACT EWB TO VERIFY EASEMENT LOCATIONS AND TO OBTAIN UTILITY DESIGN/INSTALLATION DRAWINGS. EWB INFRASTRUCTURE SHALL BE INSTALLED PER UTILITY COMPANY REQUIREMENTS. INFRASTRUCTURE SHOWN ON THESE DRAWINGS IS DIAGNOSTIC AND APPROXIMATE, AND SHALL BE VERIFIED WITH EWB DESIGN DOCUMENTS PRIOR TO INSTALLATION.
 - SEE THE ARCHITECTURAL DRAWINGS FOR EXACT LOCATION OF ALL DEVICES. REQUEST CLARIFICATIONS IN WRITING PRIOR TO INSTALLATION. INSTALLED UNCOORDINATED ELEMENTS SHALL BE RELOCATED PER THE DIRECTION OF THE ARCHITECT WITHOUT ADDITIONAL COST TO THE PROJECT. OWNER OR DESIGN TEAM IF REQUIRED.
 - EMERGENCY EGRESS LIGHTING WILL BE DESIGNATED BY "EM" AFTER THE LUMINAIRE TYPE AND WILL BE POWERED THROUGH THE GENERATOR.
 - REFER TO E-602 FOR LIGHTING CONTROL SYSTEM INFORMATION.
 - SEE SPECIFICATIONS FOR DETAILED SEQUENCE OF OPERATIONS.
 - PROVIDE UL 824 RELAYS AS REQUIRED TO ALLOW DISCRETE CONTROL OF EACH EMERGENCY RELAY.
- SEE ZONED PLANS FOR ADDITIONAL INFORMATION.
 - REFERENCE THE APPROPRIATE SPECIFICATION SECTION 26-05-33 AND 26-05-34 FOR WALL STATIONS IN AREAS WITH PRESET SCENE CONTROL.
 - ALL STANDARD NON-RELAY LIGHTS ON THIS SHEET WILL HOMERUN BACK TO 4P-10 UNLESS OTHERWISE NOTED. CIRCUIT NUMBERS ARE ADJACENT TO FIXTURES.
 - ALL EMERGENCY NON-RELAY LIGHTS ON THIS SHEET WILL HOMERUN BACK TO 4P-10 UNLESS OTHERWISE NOTED. CIRCUIT NUMBERS ARE ADJACENT TO FIXTURES.
 - EXIT SIGNS ARE TO BE PROVIDED TO MEET CODE REQUIREMENTS AND SHOULD BE LOCATED PER THE LIFE SAFETY DIAGRAM PROVIDED BY THE ARCHITECT IN QUANTITY TO NOT EXCEED CODE MAXIMUM DISTANCES BETWEEN SIGNS. ALL EXIT SIGNS ARE TO BE ON EMERGENCY POWER.
 - REFER TO SHEET E804 FOR SCHEDULE OF RELAYS, CONTROL INFORMATION AND CIRCUITING OF LUMINAIRES THAT ARE CONTROLLED BY A RELAY PANEL.

NOTES: MAY NOT APPLY TO ALL SHEETS

- REFER TO SHEET E-122A FOR LIGHTING ABOVE STAIR IN SECOND STORY SPACE.
- PROVIDE SIGN ON BACK SIDE OF DOOR WITH THE WORDS "TURN OFF LIGHTS" IN LARGE HIGH CONTRAST FONT. PROVIDE MOCK-UP FOR ARCHITECTURAL APPROVAL PRIOR TO INSTALL.
- REFER TO LIGHTING SITE PLAN E-101 FOR EXTERIOR LIGHTING AT MAIN ENTRY.
- THEATRICAL LIGHTING AND CONTROLS TO BE PRICED SEPARATELY. PROVIDE UNIT PRICING FOR LUMINAIRE TYPES T1, T2, T3, AND T4 TO OWNER FOR SELECTION ON DESIRED QUANTITY OF EACH TYPE.
- FOUR BUTTON WALL STATION FOR PRESET SCENE CONTROL OF HOUSE LIGHTING WITH RAISE/LOWER.
6. LCD TOUCH SCREEN PANEL TIED TO THEATRICAL LIGHTING CONTROL SYSTEM.
7. PROVIDE CONSOLE FOR DMX CONTROL.
8. LIGHTS INGRADE AND IN EXTERIOR SOFFIT SHALL BE CONTROLLED ON LIGHTING RELAY #12. LIGHTS IN EXTERIOR SOFFIT SHALL BE CONTROLLED ON LIGHTING RELAY #13.
9. L20 LIGHTS TO BE CONTROLLED VIA LIGHTING RELAY #20.
10. LOCAL SWITCHES TO CONTROL LIGHTING ON MECHANICAL EQUIPMENT PLATFORM C. SEE SHEET E-122C FOR ADDITIONAL INFORMATION.
11. LOCAL SWITCHES TO CONTROL LIGHTS ON MECHANICAL PLATFORM C. EMERGENCY LIGHTS CONTROLLED SEPARATELY.
12. LOCAL SWITCHES TO CONTROL LIGHTS ON MECHANICAL PLATFORM C AND D. EMERGENCY LIGHTS CONTROLLED SEPARATELY.
13. LOCAL SWITCHES TO CONTROL LIGHTS ON MECHANICAL PLATFORM E SOUTH. EMERGENCY LIGHTS CONTROLLED SEPARATELY.
14. LOCAL SWITCHES TO CONTROL LIGHTS ON MECHANICAL PLATFORM E NORTH. EMERGENCY LIGHTS CONTROLLED SEPARATELY.
15. (B) BUTTON PRESET SCENE CONTROLLER WITH RAISE/LOWER CONTROLLER TIES TO FLIGHT DIGITAL ROOM CONTROL FOR SCENE CONTROL OF GYMNASIUM.

16. LIGHT FIXTURES AND CONTROLS TO BE DETERMINED.
17. LOCAL OVERRIDE SWITCH PROVIDED FOR EXTERIOR LIGHTING LOADS. REFER TO SHEET DETAIL C4E-602 FOR ADDITIONAL INFORMATION ON EXTERIOR LIGHTING CONTROL. LOCAL TIMER SWITCH FOR INTERIOR LIGHTING OVERRIDE.
18. CLOSED LOOP 0-10V PHOTOCELL CONNECTED TO LUMINAIRES IN DESIGNATED DAYLIGHT ZONE.
19. REFER TO CONTROL DETAIL C4E-602.
20. OPEN LOOP DIM PHOTOCELL MOUNTED PER MANUFACTURER'S RECOMMENDATIONS FOR OPTIMUM DAYLIGHT CONTROL.

21. TWO BUTTON SCENE CONTROLLER.
22. LIGHTING IN THIS SPACE TO BE CONTROLLED VIA LOCAL DIGITALLY DISTRIBUTED DIMMING RELAYS. COORDINATE RELAY BOX LOCATION WITH OWNER AND ARCHITECT PRIOR TO ROUGH-IN AND INSTALLATION.
23. ETC SMARTBAR WITH 6 OUTPUTS AND DMX CONTROL.
24. LUMINAIRE L6 SHALL BE WALL MOUNTED ABOVE DOOR AT 8'-0" AFF.
25. LOCAL SWITCH TO CONTROL LIGHTS ON MECHANICAL PLATFORM A. EMERGENCY LIGHTS CONTROLLED SEPARATELY.
26. REFER TO SHEET E-122A FOR LIGHTING ABOVE STAIR IN SECOND STORY SPACE.
27. MOUNT EXTERIOR EXIT SIGN TO WALL ABOVE FACIA. 10" AFF. COORDINATE FINAL MOUNTING LOCATION WITH ARCHITECT IN FIELD PRIOR TO FINAL INSTALLATION.
28. PROVIDE ROTARY WHEEL SWITCH STATION FOR RGB CONTROL OF TYPE L8A PENDANT.

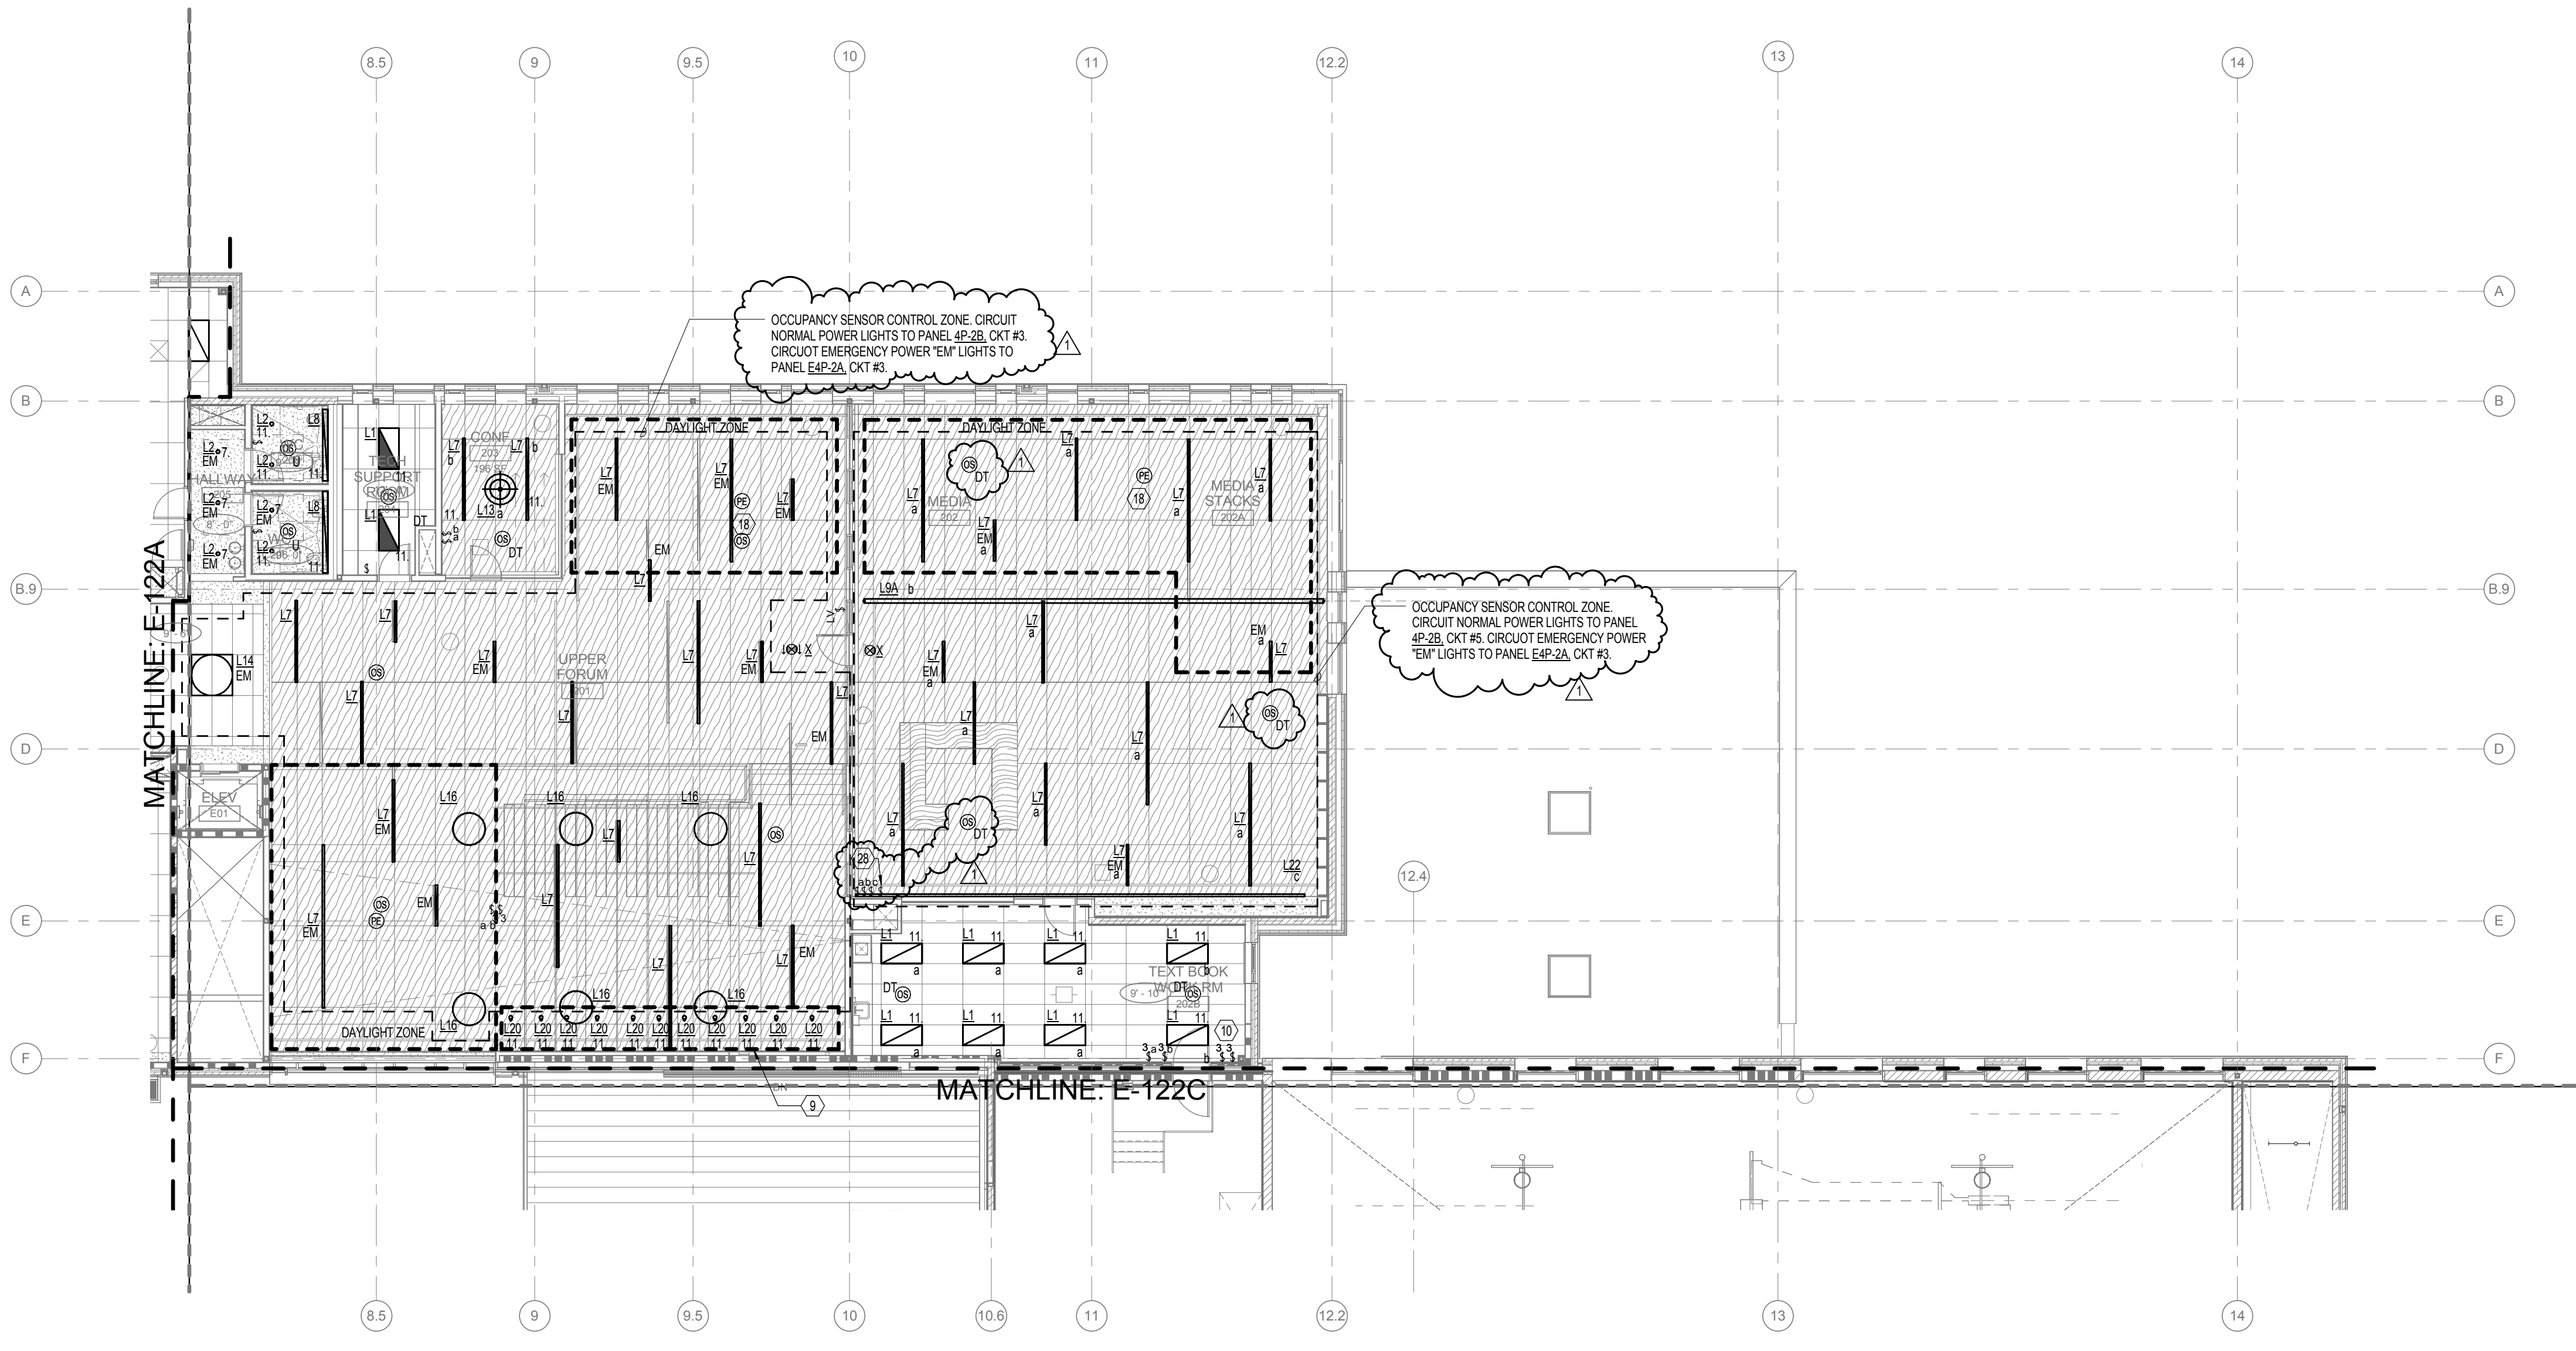

A1 SECOND FLOOR PLAN - ZONE B - LIGHTING
1/8" = 1'-0"



mahlum
ROBERTSONSHAWWOODARCHITECTS PC
132 EAST BROADWAY, SUITE 840
EUGENE, OREGON 97401
541.342.8077
www.robertsonshawwood.com

MAHLUM ARCHITECTS INC
1231 NW HAYFE, SUITE 102
PORTLAND, OREGON 97209
503.224.4032
71 COLUMBIA, FLOOR 4
SEATTLE, WASHINGTON 98104
206.444.1415
www.mahlum.com

PAE
Portland | San Francisco | Seattle
pae-engineers.com

Luma
Portland | San Francisco | Seattle
Lumald.com



EUGENE SCHOOL DISTRICT 4J


4J

REPLACEMENT ROOSEVELT
MIDDLE SCHOOL
CIP NUMBER 410.566.001
680 EAST 26TH AVENUE
EUGENE, OREGON 97405
CIP NO. 410.566.001

MARK	DATE	DESCRIPTION
1	03-13-2015	ADDENDUM 6
ISSUE DATE:	FEBRUARY 18, 2015	
ISSUE:	CONSTRUCTION DOCUMENTS	
VOLUME:	PACKAGE 2 VOLUME 2	
PROJECT NO.:	2013912.00	
DRAWN BY:	KCB	
CHECKED BY:	PLZ	
DATE:	02/18/15	

A SECOND FLOOR PLAN - ZONE B - LIGHTING

E-122B

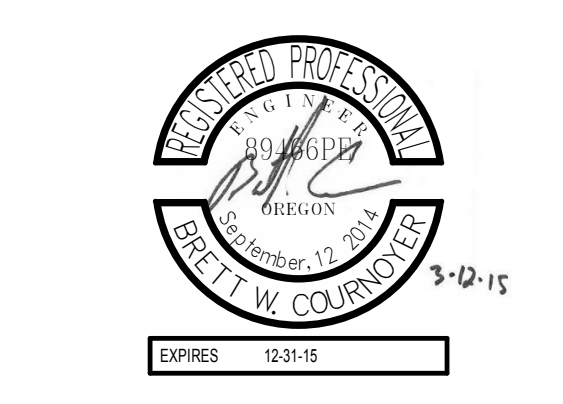

EUGENE SCHOOL DISTRICT 4J



JPPER
FORUM
2011
REPLACEMENT ROOSEVELT
MIDDLE SCHOOL
CIP NUMBER 410.566.001
680 EAST 24TH AVENUE
EUGENE, OREGON 97405
CIP NO. 410.566.001

MARK	DATE	DESCRIPTION
1	03-13-2015	ADDENDUM 6
ISSUE DATE: FEBRUARY 18, 2015		
ISSUE: CONSTRUCTION DOCUMENTS		
VOLUME: PACKAGE 2 VOLUME 2		
PROJECT NO.: 2013912.00		
DRAWN BY: KAK		
CHECKED BY: SPD		
COPYRIGHT MAHLUM ARCHITECTS, INC. 2014 ORIGINAL SHEET SIZE: 30"X42"		

SECOND FLOOR PLAN - ZONE A - POWER


E-222A

GENERAL NOTES:

- A. CONTRACTOR TO PROVIDE SEPARATE NEUTRALS FOR EACH 120V BRANCH CIRCUIT.
- B. WIRING AND TICK MARKS HAVE BEEN OMITTED FROM THE DRAWINGS FOR CLARITY.
- C. PROVIDE DISCONNECTING MEANS FOR ALL EQUIPMENT, MOTORS, CONTROLLERS, FIRE/SMOKE DAMPERS, AND APPLIANCES. DISCONNECTING MEANS SHALL COMPLY WITH REQUIREMENTS OF CHAPTER 4 OF THE NEC.
- D. ALL INTERIOR RACEWAY TO BE CONCEALED WHEN LOCATED WITHIN FINISHED SPACES UNLESS OTHERWISE NOTED.
- E. DEVICE AND EQUIPMENT CONNECTION LOCATIONS ARE SHOWN SCHEMATIC AND APPROXIMATE. REFER TO ARCHITECTURAL CEILING PLANS, FLOOR PLANS, ELEVATIONS AND SECTIONS FOR ADDITIONAL INFORMATION IMPACTING DEVICE ROUGH-IN. TYPICAL DIMENTIONED DEVICE LOCATIONS SHALL BE CONFIRMED WITH THE ARCHITECT PRIOR TO ROUGH-IN. WHERE CONFLICT OCCURS, DECISION OF THE ARCHITECT SHALL GOVERN.
- F. SPACE BACK-TO-BACK RECEPTACLES ON COMMON WALLS A MINIMUM OF 24" BETWEEN ADJACENT BOXES. WHENEVER POSSIBLE, USE ACOUSTICAL BOX PADS AROUND ENTIRE ASSEMBLY WHEN RECEPTACLES ARE LOCATED LESS THAN 24".
- G. MECHANICAL AND PLUMBING EQUIPMENT LOCATIONS SHOWN ARE FOR REFERENCE ONLY. REFER TO MECHANICAL AND PLUMBING SHEETS FOR EXACT LOCATION OF ALL EQUIPMENT.

NOTES:

1. RECEPTACLE FOR SHORT THROW PROJECTOR. VERIFY LOCATION WITH ARCHITECTURAL ELEVATIONS.
2. RECEPTACLE FOR TABLE CHARGING. COORDINATE EXACT LOCATION WITH ARCHITECT.
3. RECEPTACLE ROUGH-IN FOR FUTURE MONITOR. COORDINATE INSTALLATION WITH WHITEBOARD INSTALLATION AND USABLE WRITING/SCREEN AREA. VERIFY LOCATION WITH ARCHITECTURAL ELEVATIONS. ROUGH-IN SHALL BE APPROVED BY ARCHITECT PRIOR TO INSTALLATION.
4. CONNECT TO ELECTRICAL HAND DRYER. PROVIDE CIRCUIT BREAKER WITH PAD-LOCKABLE "LOCKED OFF" PROVISIONS.
5. RECEPTACLE DEVICE TO BE ROUGHED INTO ARCHITECTURAL CASE WORK. STUB CONDUIT UP FROM BELOW GRADE AND MOUNT DEVICE BOX WITHIN CASE WORK. COORDINATE WITH ARCHITECTURAL DOCUMENTS FOR ADDITIONAL INFORMATION.
6. MOTORIZED SHADE CONTROL SWITCH. SHARE GANG BOX AND FACEPLATE WITH LIGHT SWITCH CONTROLLING LUMINAIRES IN THIS AREA WHERE APPLICABLE. ALL BLINDS WITHIN A SPACE TO BE CONTROLLED FROM SINGLE SWITCH.
7. MOTORIZED SHADE CONNECTION POINT. REFER TO MANUFACTURER'S SPECIFICATIONS FOR EXACT REQUIREMENTS PRIOR TO WORK.
8. MOTORIZED SHADE POWER SUPPLIES AND ASSOCIATED EQUIPMENT TO BE MOUNTED HERE. REFER TO STANDBY POWER PANEL SCHEDULES FOR CIRCUITS DEDICATED TO SHADE POWER.

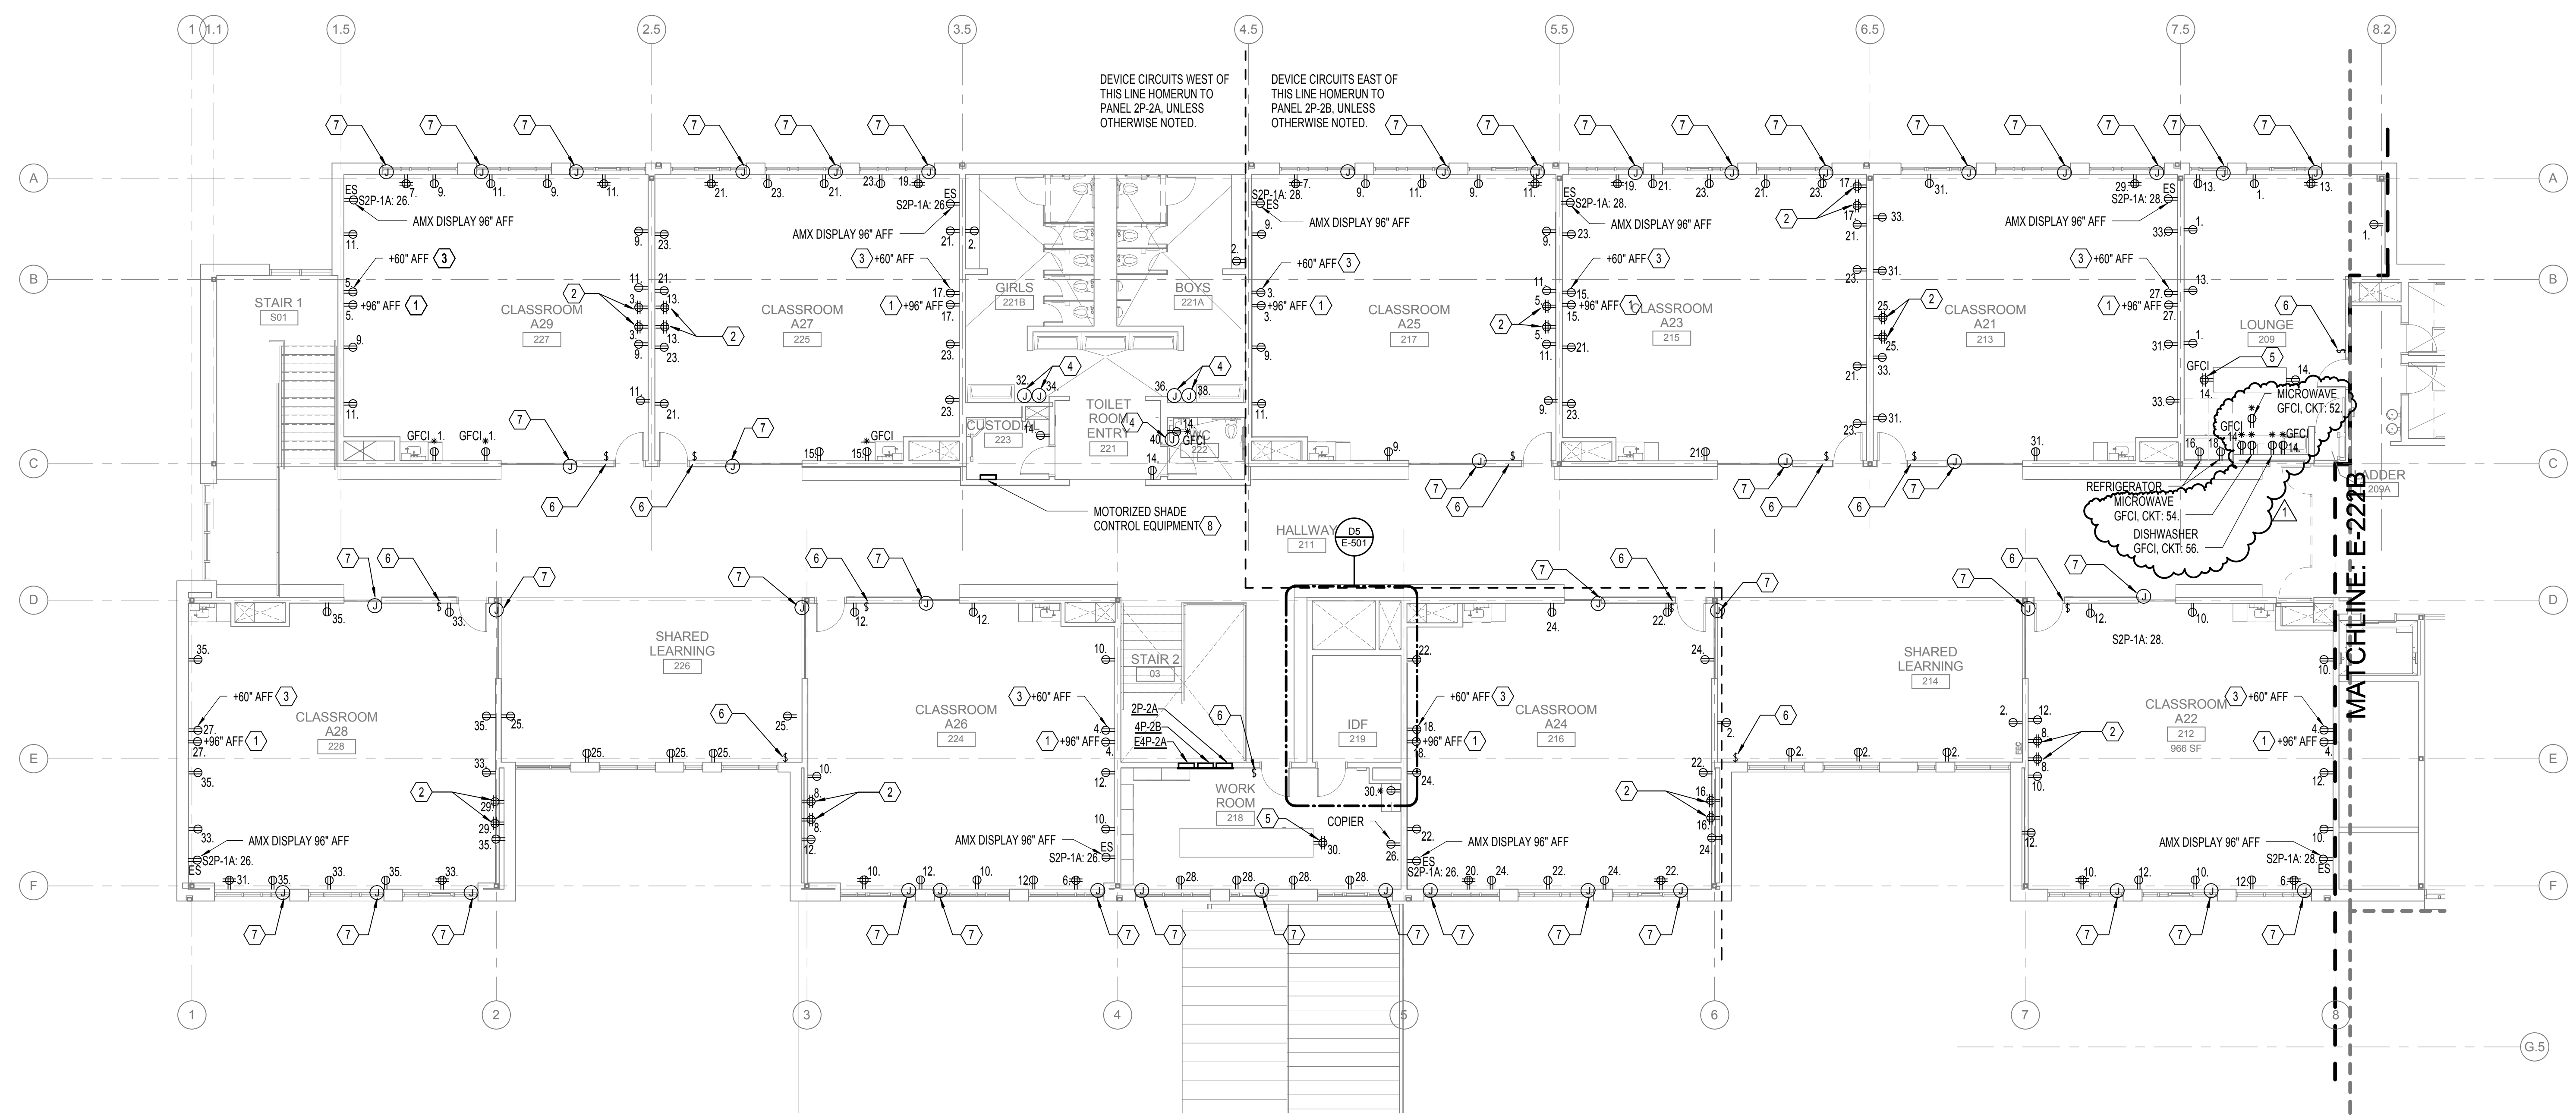


(A1) SECOND FLOOR PLAN - ZONE A - POWER
1/8" = 1'-0"



3/15/2015 1:03:00 PM C:\Users\ksherman\Documents\CENTRAL_ARCH\MAHLUM\...

GENERAL LIGHTING CONTROL NOTES:


- A. AUTOMATIC ON/OFF BY ASTRONOMICAL TIMECLOCK FOR EXTERIOR SITE LIGHTING CONTROLLED VIA DDC.
- B. INTERIOR LIGHTING VIA DDC SHALL TURN ON/OFF BY TIMECLOCK DURING NORMAL OPERATING HOURS. AFTER HOURS, CARD SWIPE TO ACTIVE RELAYS TIED TO THE EMERGENCY PANEL, WITH LOCAL OVERRIDE SWITCHES TO CONTROL RELAYS TIED TO THE NORMAL PANEL.
- C. BMS LIGHTING CONTROL EQUIPMENT IS TO BE PROVIDED BY OWNER OR OWNER'S DESIGNATED CONTROLS CONTRACTOR AND INSTALLED BY THE ELECTRICAL CONTRACTOR. ELECTRICAL CONTRACTOR TO PROVIDE AND INSTALL ALL COMPONENTS REQUIRED TO MAKE THE SYSTEM FUNCTION AS DESIGNED IN 260923, 260933, 260943, AND 265000.
- D. THE ETC THEATRICAL AND HOUSE LIGHTING SYSTEM, AND THE GYMNASIUM DIGITAL CONTROL SYSTEM IS TO BE PROVIDED BY AND INSTALLED BY THE ELECTRICAL CONTRACTOR.

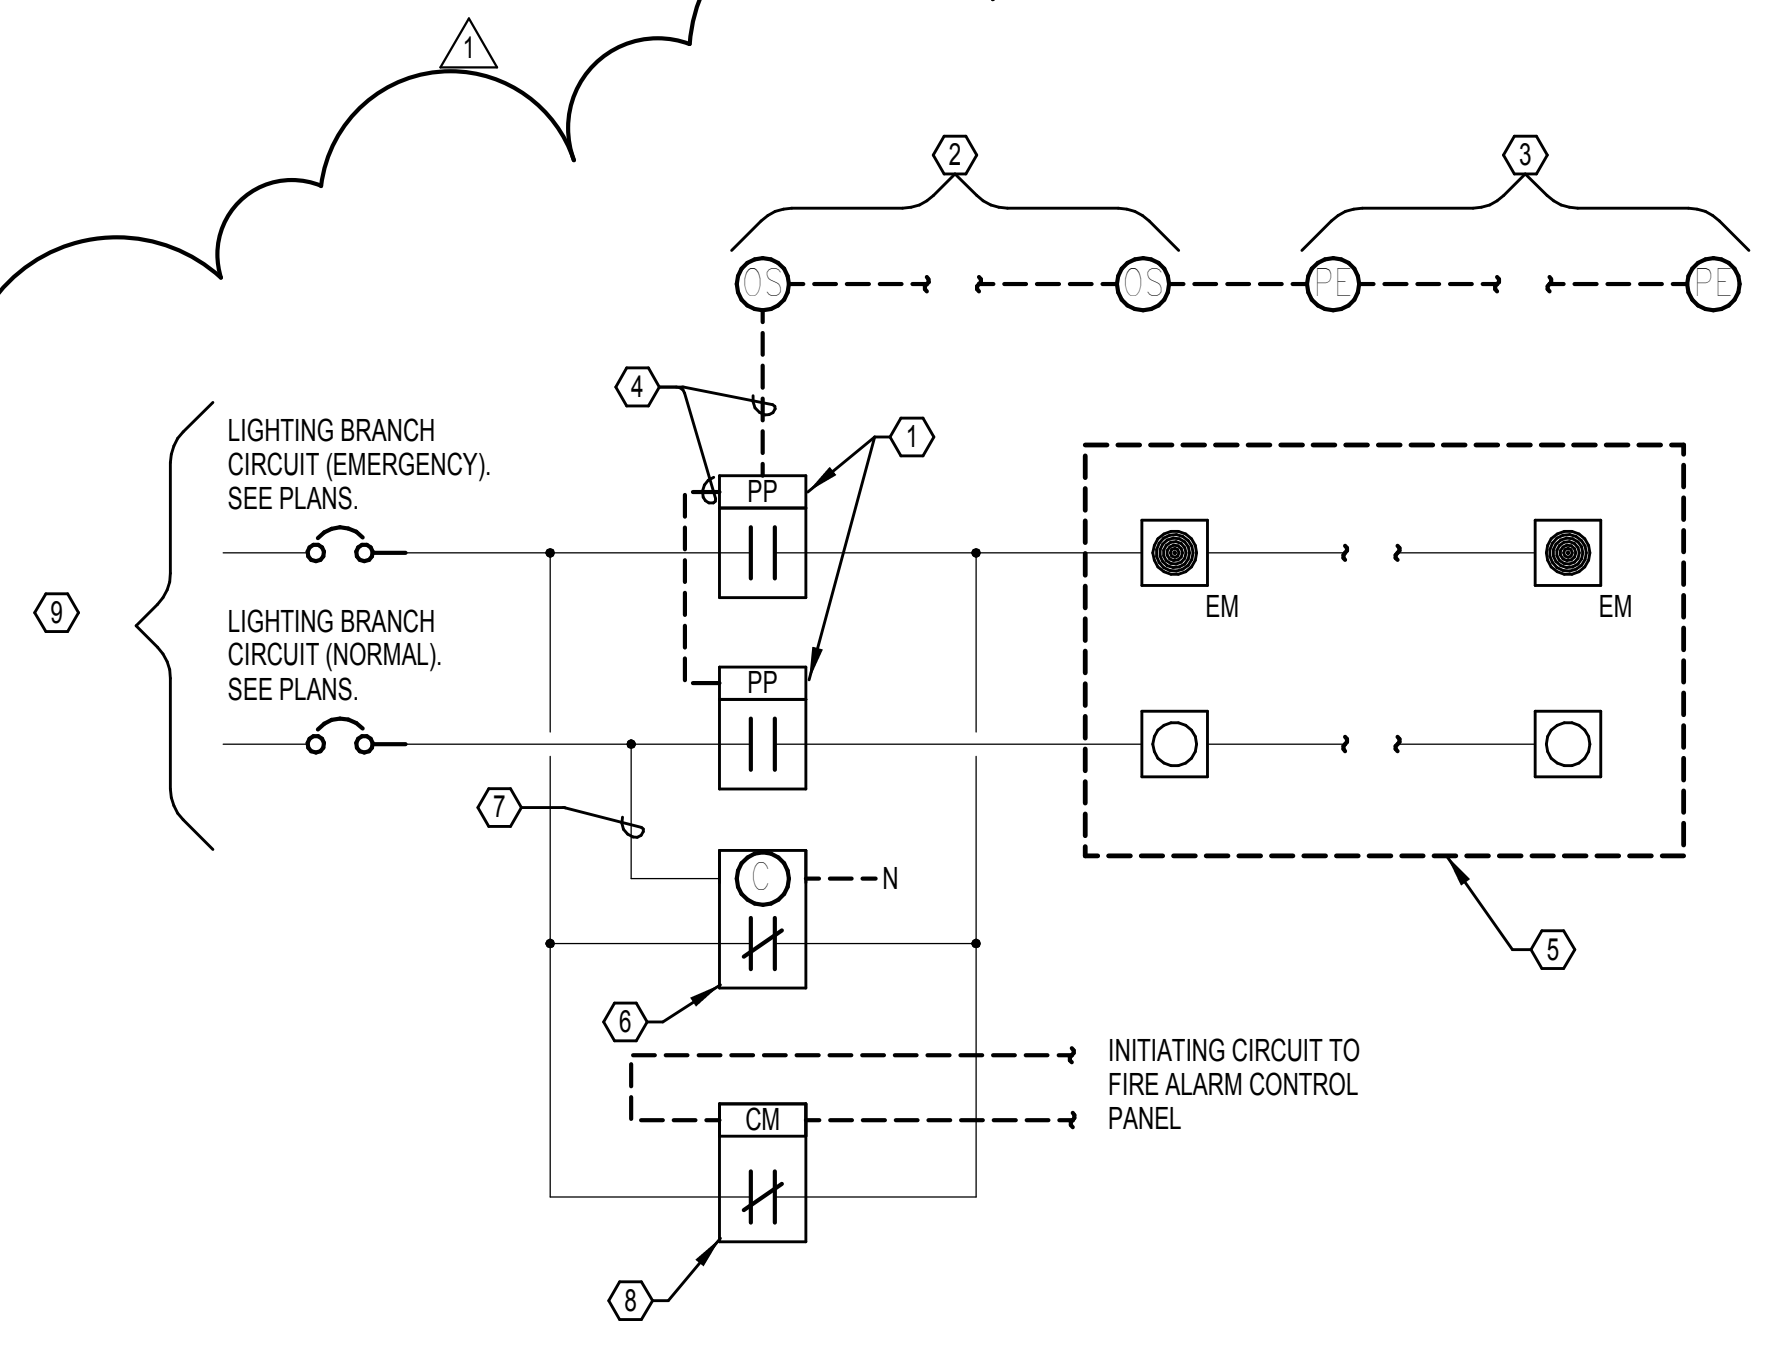


C3 TYPICAL LIGHTING CONTROL IN COMMON SPACES AND CORRIDORS
SCALE: NONE

NOTES:

1. LOCAL LIGHTING CONTROL POWER PACK RELAY, CAPABLE OF INPUT FROM MULTIPLE CONTROL DEVICES. EMERGENCY LIGHTING AND NORMAL LIGHTING POWER PACKS SERVING THE SAME ZONE/AREA SHALL WORK TOGETHER TO CONTROL AS ONE ZONE DURING NORMAL CONDITIONS.
2. CEILING OCCUPANCY SENSOR(S) AS REQUIRED FOR COVERAGE OF THE ZONE/AREA.
3. CEILING PHOTOCELL DAYLIGHT SENSOR (S) AS REQUIRED FOR DAYLIT AREAS.
4. LOW VOLTAGE CONTROLS CABLING BETWEEN SENSORS AND POWER PACKS PER MANUFACTURER'S WIRING REQUIREMENTS.
5. EMERGENCY AND NORMAL POWER LIGHTING FIXTURES LOCATED IN THE SAME ZONE/AREA. SEE LIGHTING PLANS FOR FIXTURE TYPE, LOCATIONS, AND QUANTITIES.
6. BYPASS SHUNT RELAY LISTED UL924. LOSS OF NORMAL SHALL TURN ON EMERGENCY POWER LIGHTING.
7. BYPASS RELAY SHALL BE PROVIDED WITH UNSWITCHED NORMAL POWER BRANCH CIRCUIT SERVING THE ZONE/AREA.
8. FIRE ALARM CONTROL MODULE/RELAY. ACTUATION OF FIRE ALARM SYSTEM NOTIFICATION SHALL TURN ON EMERGENCY POWER LIGHTING.
9. CIRCUITING SHOWN DIAGRAMMATICALLY. SEE LIGHTING PLANS, PANEL SCHEDULES, AND RELAY SCHEDULES FOR CIRCUITING REQUIREMENTS, LOAD INFORMATION, AND FIXTURE QUANTITIES.

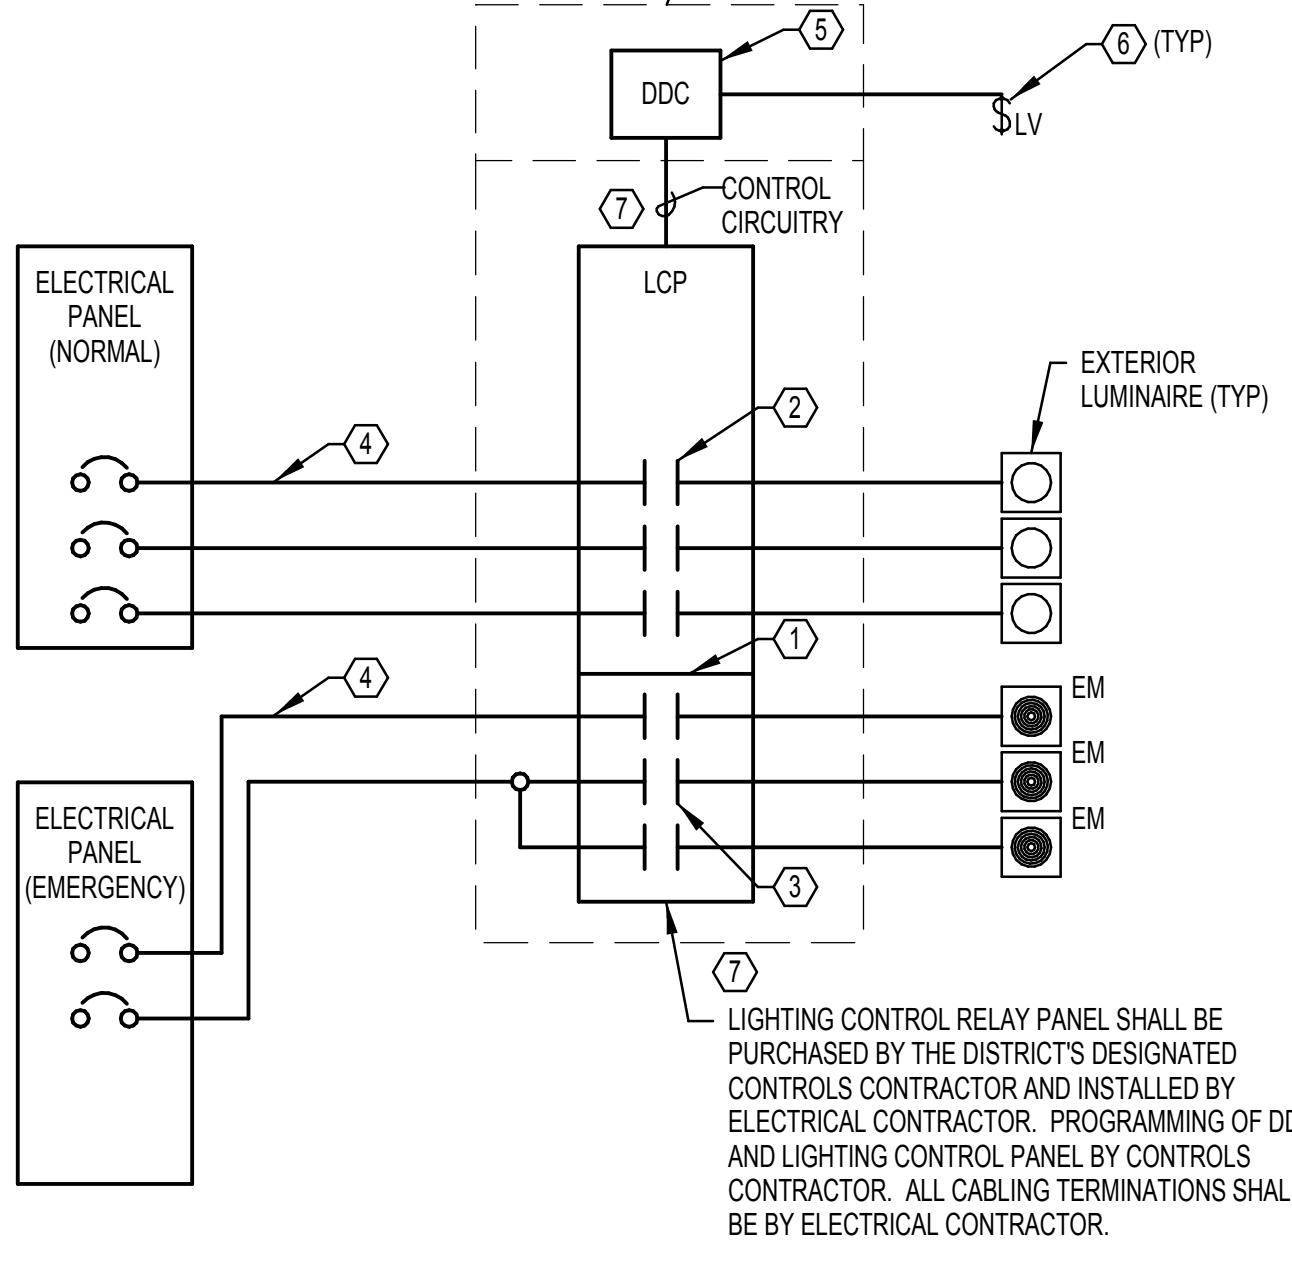

C4 DETAIL - LIGHTING CONTROL INTERFACE

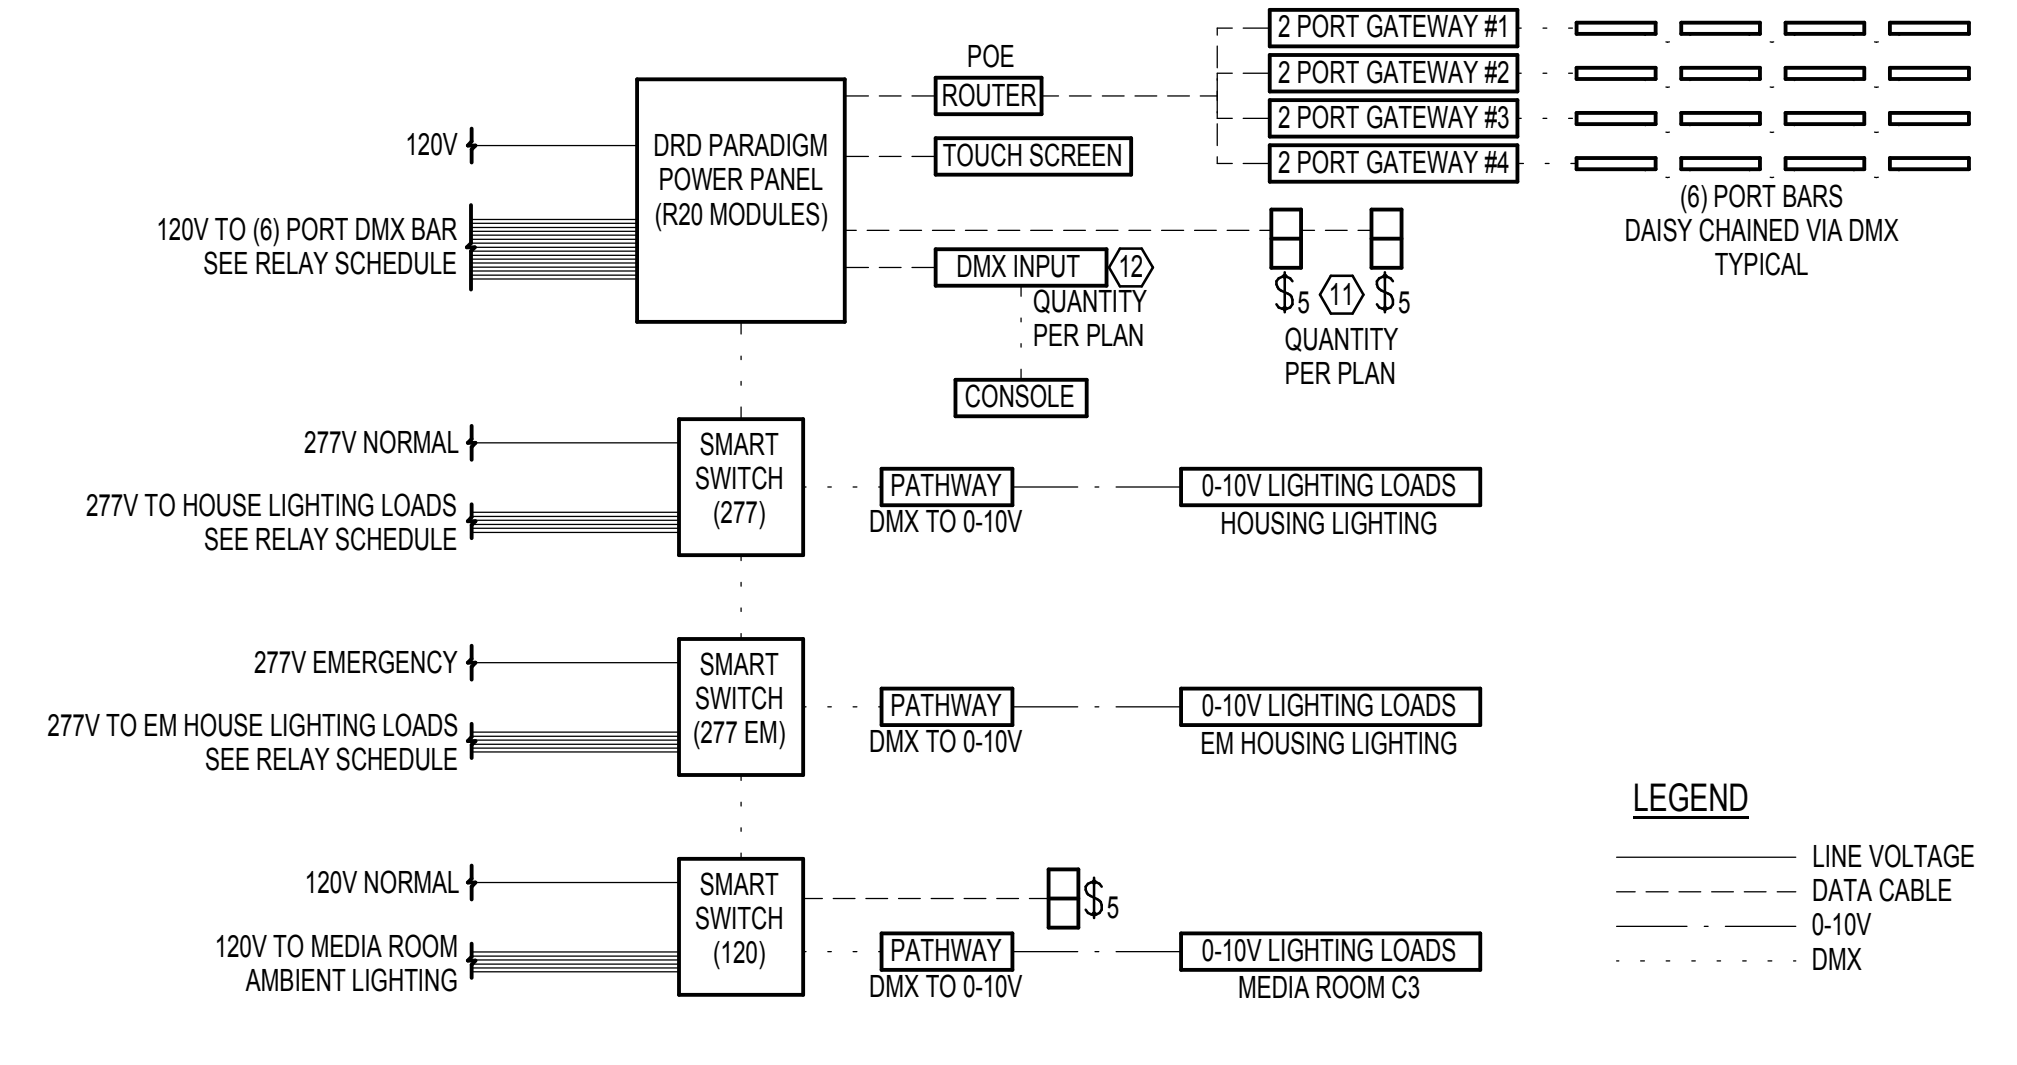

B4 DETAIL - THEATRICAL DIMMING CONTROL SYSTEM

NOTES:


1. ENCLOSURE SHALL CONTAIN SEPARATION BETWEEN NORMAL AND EMERGENCY CIRCUITS PER NEC.
2. RELAYS SHALL BE UL LISTED FOR USE IN LIGHTING APPLICATIONS AND BE ADEQUATELY BRACED FOR THE AVAILABLE FAULT CURRENT. RELAYS SHALL HAVE A SCOR LABELED ON THEM. AVAILABLE FAULT CURRENT CAN BE FOUND ON PANEL SCHEDULES. PROVIDE LIGHTING CONTROL RELAYS AND CONTROL PANEL COMPATIBLE WITH DDC SYSTEM. COORDINATE RELAY SELECTION WITH THE CONTROLS CONTRACTOR FOR APPROVAL.
3. CONTROL DEVICES SWITCHING EMERGENCY EGRESS CIRCUITS SHALL BE LISTED WITH AN APPROVED UL924 SHUNTING DEVICE THAT WILL TURN EMERGENCY LIGHTING TO "ON" IN THE EVENT OF A NORMAL POWER FAILURE.
4. CIRCUITING IS SHOWN DIAGRAMMATICALLY. SEE LIGHTING PLANS, PANEL SCHEDULES, AND RELAY SCHEDULES FOR CIRCUITING REQUIREMENTS, LOAD INFORMATION, AND FIXTURE QUANTITIES.
5. TIME CLOCK/ASTRONOMICAL FUNCTION AND TIME OF DAY SCHEDULING TO BE PROGRAMMED WITHIN THE DDC/LIGHTING CONTROL SYSTEM. LOW VOLTAGE SWITCHES ARE TO BE PROGRAMMED BY THE CONTROL CONTRACTOR.
6. 2-HOUR BYPASS OVERRIDE SWITCH. FOR EXTERIOR LIGHTING. INSTALL AT CUSTODIAL OFFICE 128. VERIFY LOCATION WITH DISTRICT PRIOR TO INSTALLATION.
7. CONNECTIONS TO DDC AND LIGHTING SYSTEM WILL BE THE RESPONSIBILITY OF THE ELECTRICAL CONTRACTOR. COORDINATE RELAY LOCATION, CABLING REQUIREMENTS, AND CONNECTION DETAILS WITH CONTROL CONTRACTOR.




ROBERTSON/SHERWOOD/ARCHITECTS PC
132 EAST BROADWAY, SUITE 540
EUGENE, OREGON 97401
541-342-8077
www.robertsonsherwood.com

MAHLUM ARCHITECTS INC
1233 NW HOVEY, SUITE 102
PORTLAND, OREGON 97209
503-224-4032

71 COLUMBIA, FLOOR 4
SEATTLE, WASHINGTON 98104
206-441-4151
www.mahlum.com

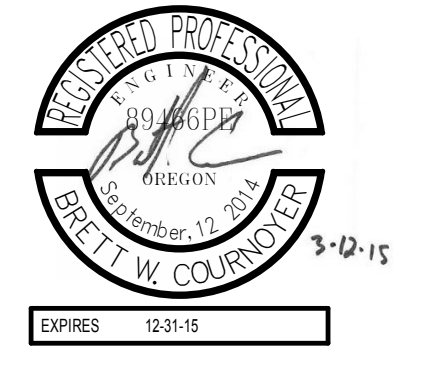

EUGENE SCHOOL DISTRICT 4J

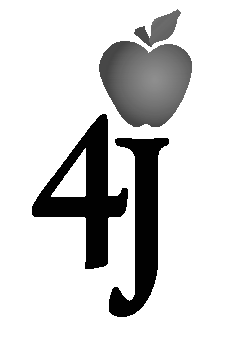

REPLACEMENT ROOSEVELT MIDDLE SCHOOL
CIP NUMBER 410.566.001
680 EAST 24TH AVENUE
EUGENE, OREGON 97405
CIP NO. 410.566.001

MARK	DATE	DESCRIPTION
1	03-13-2015	ADDENDUM 6
ISSUE DATE: FEBRUARY 18, 2015		
ISSUE: CONSTRUCTION DOCUMENTS		
VOLUME: PACKAGE 2 VOLUME 2		
PROJECT NO.: 2013912.00		
DRAWN BY: KAK		
CHECKED BY: SPD		
COPYRIGHT MAHLUM ARCHITECTS, INC. 2014 ORIGINAL SHEET SIZE: 30"X42"		

DETAILS - LIGHTING CONTROL

E-602

FEEDER SCHEDULE COPPER, 3 PHASE, 3 WIRE + GROUND				FEEDER SCHEDULE COPPER, 3 PHASE, 4 WIRE + GROUND				
NOMINAL AMPACITY	TAG	CONDUIT SIZE (MIN)	PHASE CONDUCTORS	GROUND CONDUCTOR	TAG	CONDUIT SIZE (MIN)	PHASE & NEUTRAL CONDUCTORS	GROUND CONDUCTOR
20	203	1/2"	(3) #12	#12	204	1/2"	(4) #12	#12
30	303	1/2"	(3) #10	#10	304	3/4"	(4) #10	#10
40	403	3/4"	(3) #8	#8	404	3/4"	(4) #8	#8
50	503	3/4"	(3) #6	#6	504	1"	(4) #6	#6
60	603	1"	(3) #4	#4	604	1 1/4"	(4) #4	#4
70	703	1"	(3) #4	#8	704	1 1/4"	(4) #4	#8
80	803	1 1/4"	(3) #3	#8	804	1 1/4"	(4) #3	#8
90	903	1 1/4"	(3) #2	#8	904	1 1/4"	(4) #2	#8
100	1003	1 1/4"	(3) #1	#8	1004	1 1/2"	(4) #1	#8
110	1103	1 1/4"	(3) #1	#6	1104	1 1/2"	(4) #1	#6
125	1253	1 1/4"	(3) #1	#6	1254	2"	(4) #1/0	#4
150	1503	1 1/2"	(3) #1/0	#6	1504	2"	(4) #2/0	#4
175	1753	1 1/2"	(3) #2/0	#6	1754	2"	(4) #3/0	#4
200	2003	2"	(3) #2/0	#6	2004	2 1/2"	(4) #4/0	#4
225	2253	2"	(3) #4/0	#4	2254	2 1/2"	(4) 250KCM	#3
250	2503	2 1/2"	(3) 250KCM	#4	2504	3"	(4) 350KCM	#2
300	3003	2 1/2"	(3) 350KCM	#4	3004	3 1/2"	(4) 500KCM	#2
350	3503	3"	(3) 500KCM	#3	3504	(2) 2"	(8) #3/0	(2) #3
400	4003	(2) 2"	(8) #3/0	(2) #2	4004	(2) 2 1/2"	(8) #4/0	(2) #2
450	4503	(2) 2"	(8) #4/0	(2) #2	4504	(3) 3"	(8) 250KCM	(2) #1
500	5003	(2) 2 1/2"	(8) 250KCM	(2) #2	5004	(3) 2 1/2"	(12) #3/0	(3) #1
600	6003	(2) 3"	(8) 350KCM	(2) #1	6004	(3) 2 1/2"	(8) 500KCM	(2) #2/0
800	8003	(3) 3"	(8) 350KCM	(3) #1/0	8004	(2) 3 1/2"	(12) 350KCM	(3) #2/0
1000	10003	(3) 3"	(8) 500KCM	(3) #2/0	10004	(4) 3"	(16) 350KCM	(3) #2/0
1200	12003	(3) 3"	(8) 350KCM	(4) #3/0	12004	(4) 3 1/2"	(16) 500KCM	(4) 250KCM
1600	16003	(5) 3"	(15) 500KCM	(5) #4/0	16004	(6) 3"	(24) 350KCM	(8) 250KCM
2000	20003	(6) 3"	(18) 500KCM	(6) 250KCM	20004	(6) 3 1/2"	(24) 500KCM	(8) 250KCM
2500	25003	(6) 4"	(18) 750KCM	(6) 350KCM	25004	(8) 4"	(32) 500KCM	(8) 350KCM
3000	30003	(7) 4"	(21) 750KCM	(7) 500KCM	30004	(8) 4"	(36) 500KCM	(8) 500KCM
4000	40003	(9) 4"	(27) 750KCM	(9) 500KCM	40004	(12) 4"	(48) 500KCM	(12) 500KCM


- NOTES:**
- REFER TO SPECIFICATIONS FOR INSULATION TYPE PER WIRE SIZE.
 - MINIMUM CONDUIT SIZES IDENTIFIED MEET MAXIMUM 40% FILL FOR EMT, RMC AND PVC SCHEDULE 40.
 - FOR FEEDER RATINGS 100AMPS OR LESS, ACTUAL AMPACITY IS CALCULATED BY THOSE GIVEN IN NEC 310.15(B)(16), 90DEG C.
 - FOR FEEDER RATINGS GREATER THAN 100AMPS, ACTUAL AMPACITY IS CALCULATED BY THOSE GIVEN IN NEC 310.15(B)(16), 75DEG C.
- NOTES:**
- REFER TO SPECIFICATIONS FOR INSULATION TYPE PER WIRE SIZE.
 - MINIMUM CONDUIT SIZES IDENTIFIED MEET MAXIMUM 40% FILL FOR EMT, RMC AND PVC SCHEDULE 40.
 - ALL NEUTRAL CONDUCTORS ARE CONSIDERED CURRENT CARRYING. THEREFORE AMPACITY ADJUSTMENTS HAVE BEEN INCLUDED IN ACCORDANCE WITH NEC TABLE 310.15(B)(3)(a) TO ACCOMMODATE FOUR (4) CURRENT CARRYING CONDUCTORS IN A SINGLE RACEWAY.
 - ADJUSTED CONDUCTOR AMPACITIES ARE CALCULATED BASED ON THOSE GIVEN FOR 90DEG C CONDUCTORS IN ACCORDANCE WITH NEC 310.15(B) AND TABLE NEC 310.15(B)(16). FOR FEEDER RATINGS 100AMPS OR LESS, THE ADJUSTED AMPACITY SHALL NOT EXCEED THE 90DEG C RATING. FOR FEEDER RATINGS GREATER THAN 100AMPS, ACTUAL AMPACITY SHALL NOT EXCEED THE 75DEG C RATING.

GENERAL NOTES:

- FOR FEEDER SCHEDULE, SEE E-702.
- THE ELECTRIC UTILITY COMPANY SERVICE INFRASTRUCTURE REQUIREMENTS SHOWN ON THESE PLANS ARE APPROXIMATE. UTILITY COMPANY SERVICE INFRASTRUCTURE, SUCH AS PRIMARY AND SECONDARY CONDUITS, PULL ROPES, PULL BOXES, VAULTS, CONCRETE PADS, GROUNDING, AND OTHER REQUIREMENTS NECESSARY FOR UTILITY SERVICE INSTALLATION SHALL BE INSTALLED PER UTILITY COMPANY DESIGN DRAWINGS (HANDOUT). CONTRACTOR SHALL BE RESPONSIBLE FOR CONTACTING THE UTILITY COMPANY REPRESENTATIVE FOR THE PROJECT SITE TO OBTAIN THEIR DESIGN DRAWINGS AND INSTALLATION REQUIREMENTS, AND TO SCHEDULE UTILITY COMPANY INSPECTOR TO JOB SITE FOR MILESTONES AS DESIGNATED BY THE UTILITY COMPANY.
- GROUNDING ELECTRODE CONDUCTORS AT TRANSFORMERS SHALL BE SIZED MINIMUM PER NEC TABLE 250.66, BASED ON SIZE OF THE TRANSFORMER SECONDARY CONDUCTORS.
- ELECTRICAL SYSTEM EQUIPMENT DESIGN IS BASED ON EATON PRODUCTS. SUBSTITUTIONS SHALL BE SUBJECT TO REVIEW AND APPROVAL BY THE ENGINEER. SEE SPECIFICATIONS FOR ADDITIONAL REQUIREMENTS.
- GROUNDING ELECTRODE SYSTEM INSTALLATION SHALL COMPLY WITH THE REQUIREMENTS OF NEC ARTICLE 250. BOND THE GROUNDING BUS OF THE MAIN SWITCHBOARD TO ALL AVAILABLE GROUNDING ELECTRODES AS DESCRIBED IN THE NEC, INCLUDING BUT NOT NECESSARILY LIMITED TO CONCRETE REBAR, COLD WATER PIPING, BUILDING STRUCTURAL STEEL, GROUND RODS, ETC. ALL AVAILABLE GROUNDING ELECTRODES AT THE BUILDING SHALL BE BONDED TOGETHER WITH A GROUNDING ELECTRODE CONDUCTOR TO FORM A CONTINUOUS ELECTRICAL GROUNDING PATH.
- SOLAR PHOTOVOLTAIC SYSTEM REQUIREMENTS ARE SHOWN SCHEMATIC. CONTRACTOR SHALL PROVIDE COMPLETE SOLAR PHOTOVOLTAIC SYSTEM DESIGN, APPROVAL AND INSTALLATION. SEE SPECIFICATIONS FOR ADDITIONAL REQUIREMENTS. LOCATIONS OF SOLAR PV EQUIPMENT SHALL BE COORDINATED AND VERIFIED WITH THE ARCHITECT.
- ALL SPACES PROVIDED IN DISTRIBUTION PANELS SHALL BE FULLY PROVISIONED.

NOTES:

- CONTRACTOR SHALL PROVIDE SOLAR PHOTOVOLTAIC SYSTEM DESIGN AND INSTALLATION. COORDINATE WITH SOLAR PV DESIGN DRAWINGS FOR EXACT EQUIPMENT REQUIREMENTS.
- LOCATE NEAR SOLAR PV SYSTEM INVERTER EQUIPMENT. VERIFY LOCATION WITH APPROVED PV SYSTEM PLANS.
- REFER TO GROUNDING DETAILS ON SHEET E604 FOR ADDITIONAL INFORMATION.
- PROVIDE TERMINATION LUGS SECTION FOR FUTURE KIRK-KEY TIED, GENERATOR CIRCUIT BREAKER, AND RELATED FUTURE CABLING. MINIMUM (8) SETS OF #4 - 500 KCMIL TERMINATIONS PROVISIONS.
- UTILITY TERMINATION SECTION AND METERING PROVISIONS SHALL MEET EWEB REQUIREMENTS. VERIFY UTILITY COMPANY REQUIREMENTS ARE MET PRIOR TO INSTALLATION.
- POWER BLOCK TO BE CONNECTED WITH FEED-THROUGH LUGS IN ROADSHOW PANEL.

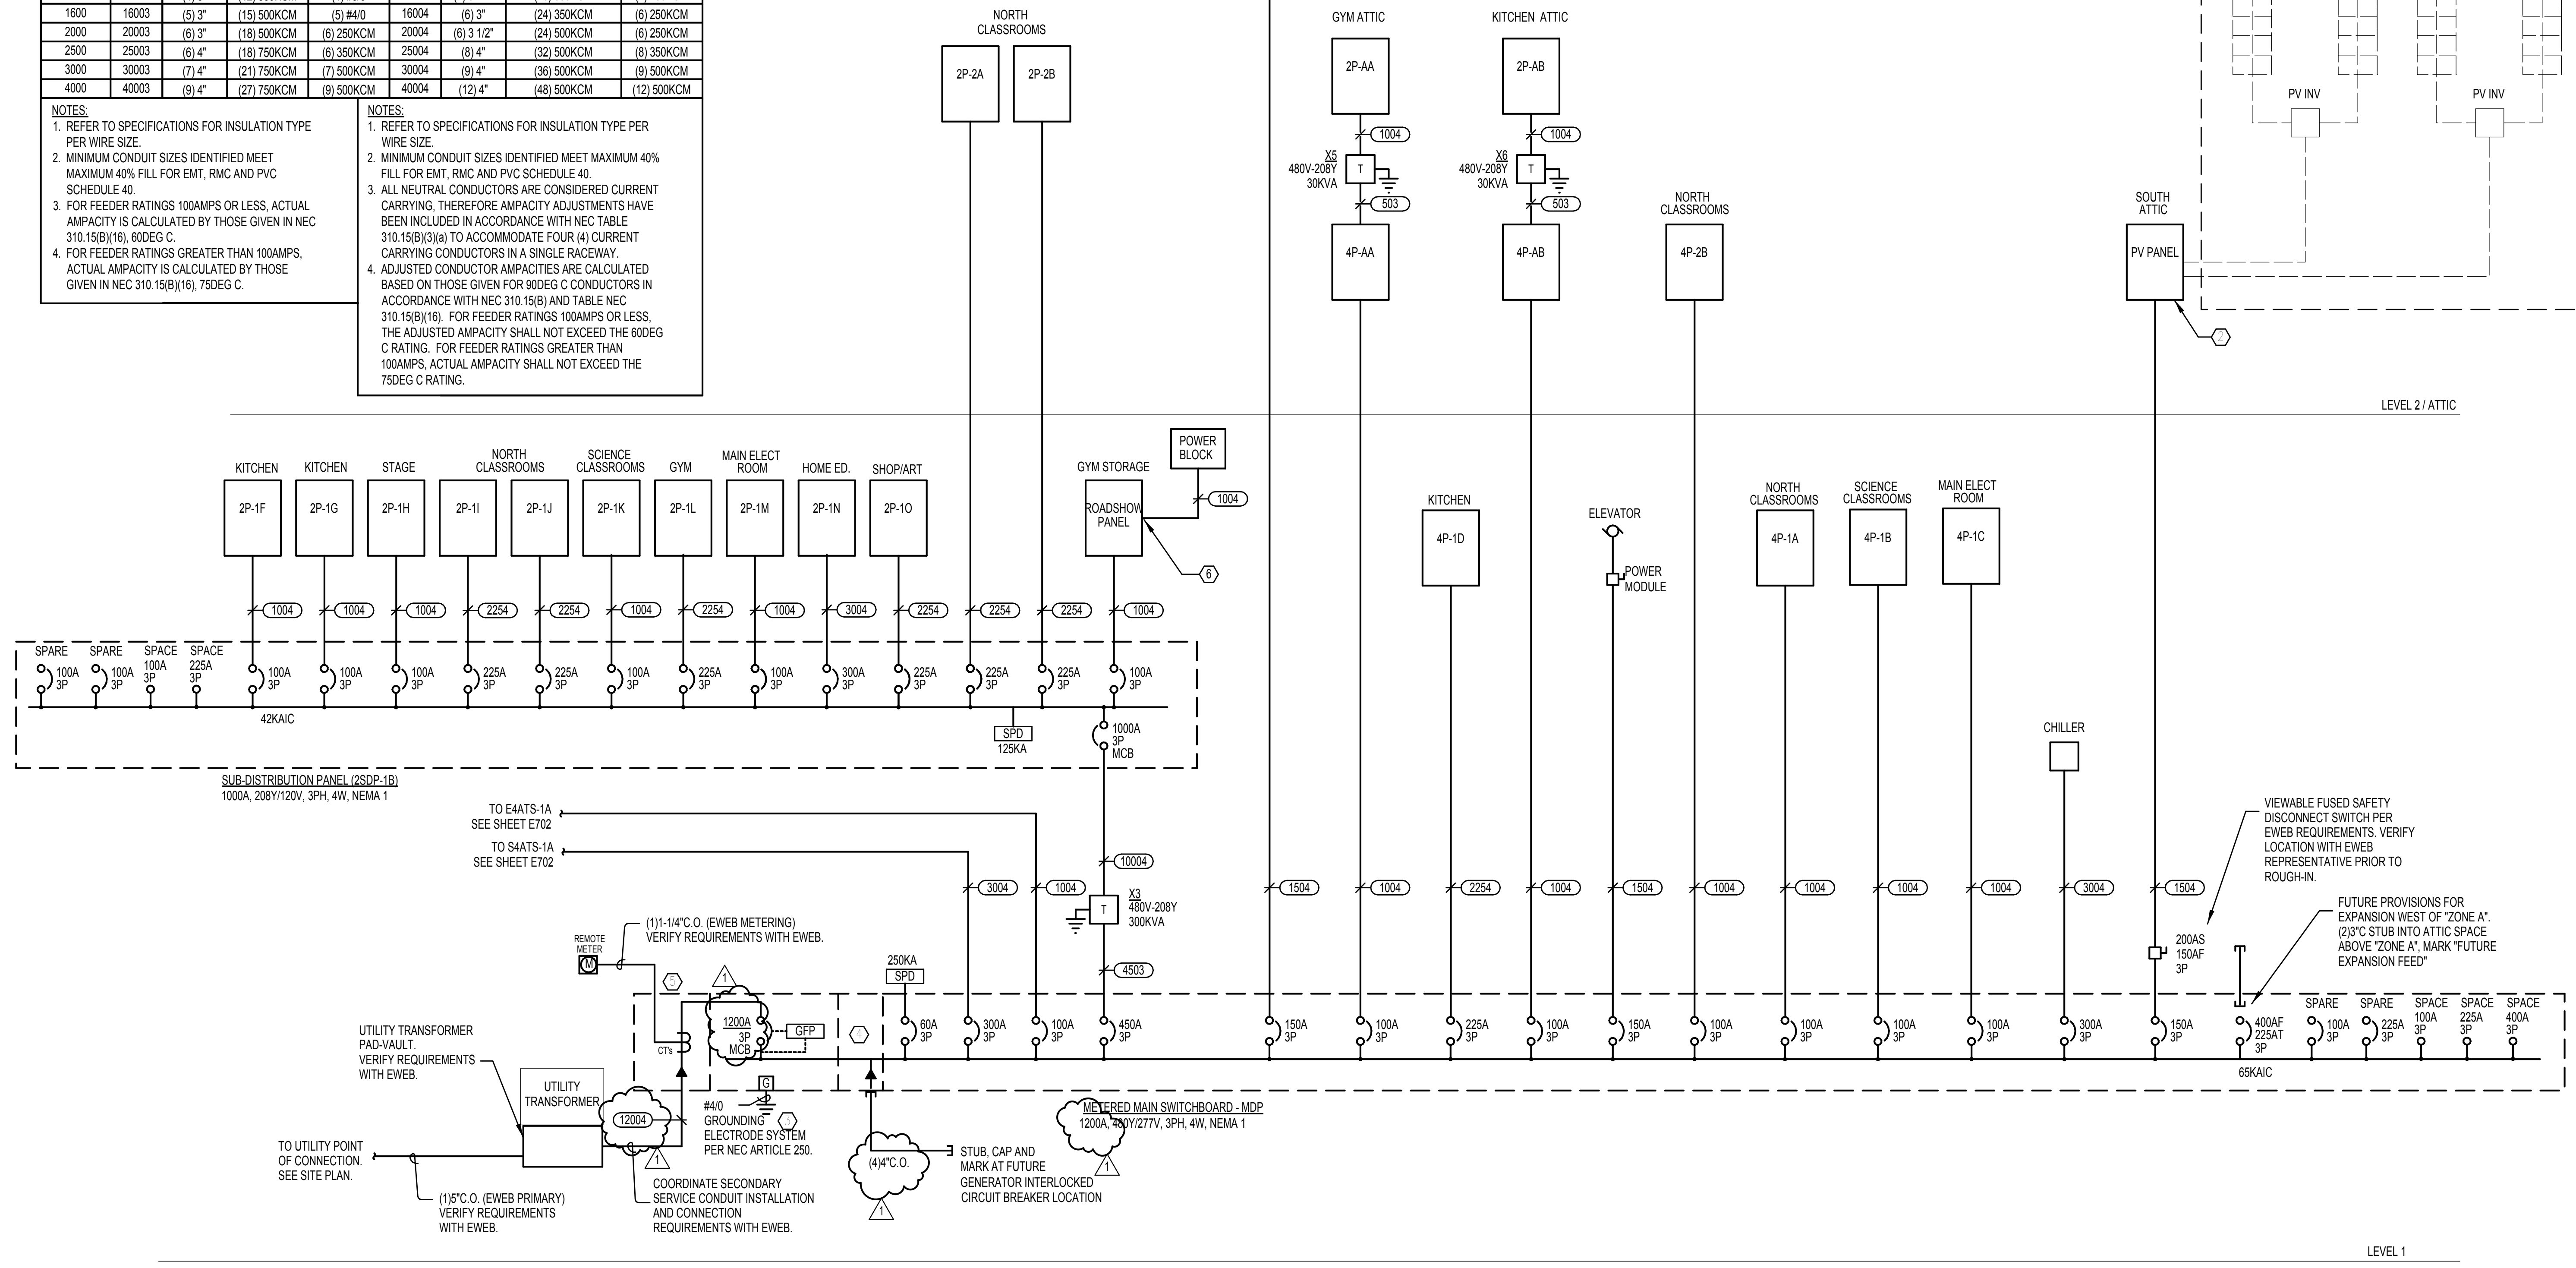

1 ELECTRICAL ONE-LINE DIAGRAM - NORMAL POWER

mahlum
ROBERTSON/SHERWOOD ARCHITECTS PC
132 EAST BROADWAY, SUITE 540
EUGENE, OREGON 97401
541-342-8077
www.robertsonsherwood.com

MAHLUM ARCHITECTS INC
1231 NW HOYT, SUITE 102
PORTLAND, OREGON 97209
503-224-4032

71 COLUMBIA, FLOOR 4
SEATTLE, WASHINGTON 98104
206-441-1151
www.mahlum.com

P A E
Portland | San Francisco | Seattle
pae-engineers.com





EUGENE SCHOOL DISTRICT 4J

4J

REPLACEMENT ROOSEVELT
MIDDLE SCHOOL
CIP NUMBER 410.566.001
680 EAST 24TH AVENUE
EUGENE, OREGON 97405
CIP NO. 410.566.001

MARK	DATE	DESCRIPTION
ISSUE DATE:	FEBRUARY 18, 2015	
ISSUE:	CONSTRUCTION DOCUMENTS	
VOLUME:	PACKAGE 2 VOLUME 2	
PROJECT NO.:	2013912.00	
DRAWN BY:	KAK	
CHECKED BY:	SPD	

DIAGRAMS - ELECTRICAL ONE-LINE DIAGRAM - NORMAL POWER

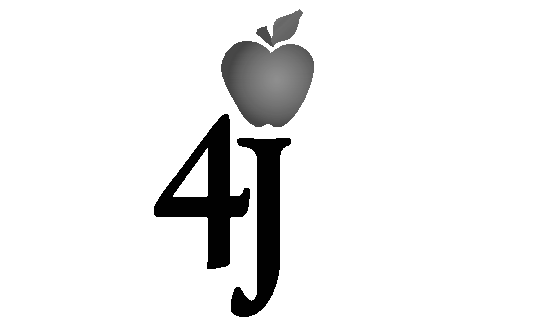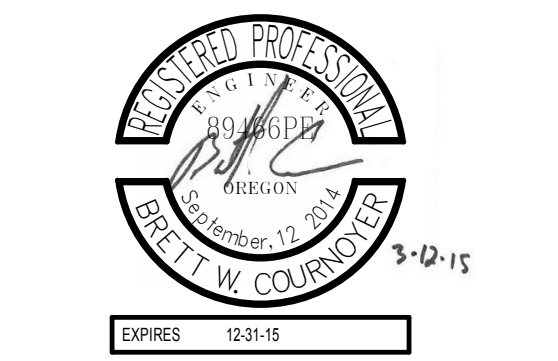

MECHANICAL EQUIPMENT CONNECTION SCHEDULE. Table with columns: EQUIPMENT DESCRIPTIONS, ELECTRICAL CHARACTERISTICS, CONNECTION CHARACTERISTICS, FEEDER CHARACTERISTICS, PANEL INFORMATION, NOTES.

- GENERAL NOTES:
1. REFER TO ONE-LINE DIAGRAM OR PANEL SCHEDULES FOR OVERCURRENT PROTECTION CHARACTERISTICS AND CIRCUIT NUMBERS.
2. COORDINATE ALL EQUIPMENT CONNECTION REQUIREMENTS WITH INSTALLING CONTRACTOR PRIOR TO THE INSTALLATION OF ANY ELECTRICAL WORK.
3. VFD'S ARE FURNISHED BY DIVISION 23. INSTALL VFD AND PROVIDE PROVIDE LINE AND LOAD SIDE FEEDERS IN ELECTRICAL WORK.
4. COMBINATION STARTER/DISCONNECTS AND DISCONNECT SWITCHES SHALL BE LOCATED WITHIN SIGHT OF AND ADJACENT TO EQUIPMENT SERVED. COORDINATE INSTALLATION WITH EQUIPMENT INSTALLER.
5. NOT ALL EQUIPMENT IDENTIFIED HERE IS SHOWN ON FLOOR PLANS. REFER TO DRAWINGS IN OTHER DISCIPLINES FOR EQUIPMENT LOCATIONS.

- NOTES: (SOME MAY NOT BE USED ON THIS SHEET)
1. MULTIPLE UNITS CONNECTED TO ONE CIRCUIT BREAKER. REFER TO PANEL SCHEDULES FOR EQUIPMENT CIRCUITS.

MECHANICAL COORDINATION SCHEDULE PART ONE

1/4" = 1'-0"

1/4" = 1'-0" 03/13/2015 11:10 AM C:\Projects\03-13-15\4J\03-13-15-001\03-13-15-001-001.dwg



ISSUE DATE: FEBRUARY 18, 2015

ISSUE: CONSTRUCTION DOCUMENTS

VOLUME: PACKAGE 2 VOLUME 2

PROJECT NO: 2013912.00

DRAWN BY: JAR

CHECKED BY: SPD

COPYRIGHT MAHLUM ARCHITECTS, INC. 2014 ORIGINAL SHEET SIZE: 36x48"

PANEL SCHEDULES

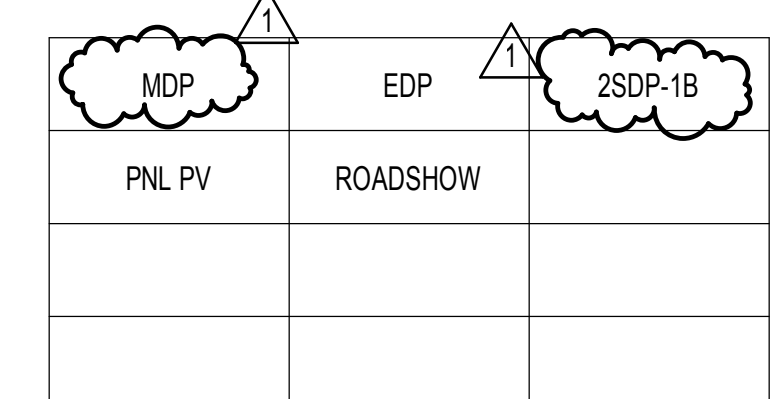


Table for DESIGNATION: 2SDP-1B, TYPE: Switchboard, PROJECT NAME: ROOSEVELT MS. Includes columns for FEEDER ID, TYPE, TRIP RATING (A), CONNECTED (Amprs), DESIGN (Amprs), and NOTES. Lists various feeders like 2P-1K, 2P-1L, etc.


Table for DESIGNATION: EDP, TYPE: Switchboard, PROJECT NAME: ROOSEVELT MS. Includes columns for FEEDER ID, TYPE, TRIP RATINGS (A), CONNECTED (kVA), DESIGN (kVA), and NOTES. Lists panels like E4ATS-1A, S4ATS-1A.

Table for DESIGNATION: MDP, TYPE: Switchboard, PROJECT NAME: ROOSEVELT MS. Includes columns for FEEDER ID, TYPE, TRIP RATING (A), CONNECTED (Amprs), DESIGN (Amprs), and NOTES. Lists feeders for E4ATS-1A-N, CHILLER, etc.

Total Design Load = 1135 Amps
Per NEC 220.86, Optional Calculation Method for Schools.
LOAD JUSTIFICATION:
Total building square footage: 97,300
1,159,768VA/97,300sf = 11.82VA/sf (connected load per square foot)
1sf 3VA/sf @ 100% = 291,900 VA
3-20VA/sf (remaining) @ 75%:
(1,159,768 - 291,900) x 0.75 = 650,901 VA
TOTAL CALCULATED LOAD = 942,801VA (1135 Amps @ 480V 3ph)


Table for DESIGNATION: PANEL PNL-PV, VOLTAGE: 480Y/277V - 3 Ph - 4 Wire. Includes columns for DEMAND CATEGORY, VA, BKR A/P, CKT, PH, CKT, BKR A/P, VA, DEMAND CATEGORY, and DESCRIPTION. Lists categories like Equipment, Receptacles, etc.

 Table for DESIGNATION: PANEL ROADSHOW, VOLTAGE: 208Y/120V - 3 Ph - 4 Wire. Includes columns for DEMAND CATEGORY, VA, BKR A/P, CKT, PH, CKT, BKR A/P, VA, DEMAND CATEGORY, and DESCRIPTION. Lists SPARE categories.




ROBERTSON/SHERWOOD/ARCHITECTS PC
 132 EAST BROADWAY, SUITE 540
 EUGENE, OREGON 97401
 541-342-8077
 www.robertsonsherwood.com

MAHLUM ARCHITECTS INC
 1231 NW HDYK, SUITE 102
 PORTLAND, OREGON 97209
 503-224-4032
 71 COLUMBIA, FLOOR 4
 SEATTLE, WASHINGTON 98104
 206-441-1151
 www.mahlum.com

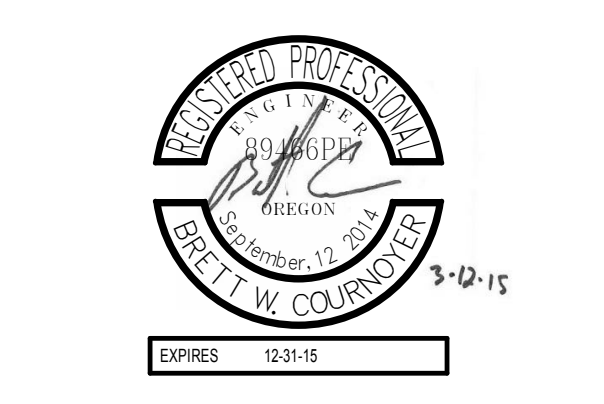

EUGENE SCHOOL DISTRICT 4J

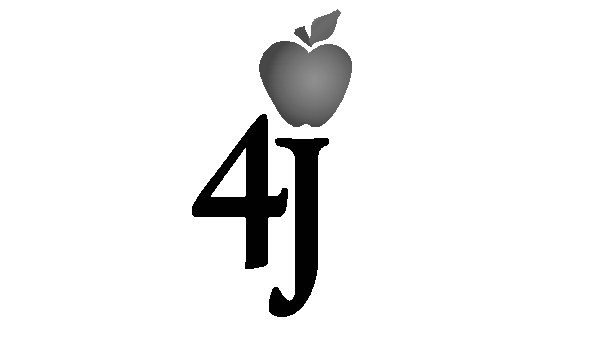


REPLACEMENT ROOSEVELT MIDDLE SCHOOL
 CIP NUMBER 410.566.001
 680 EAST 24TH AVENUE
 EUGENE, OREGON 97405
 CIP NO. 410.566.001


MARK	DATE	DESCRIPTION
1	03-13-2015	ADDENDUM 6

ISSUE DATE: FEBRUARY 18, 2015
 ISSUE: CONSTRUCTION DOCUMENTS
 VOLUME: PACKAGE 2 VOLUME 2
 PROJECT NO: 2013912.00
 DRAWN BY: JAR
 CHECKED BY: SPD
Copyright Mahlum Architects, Inc. 2014 ORIGINAL SHEET SIZE: 30"X42"

LIGHTING RELAY SCHEDULES

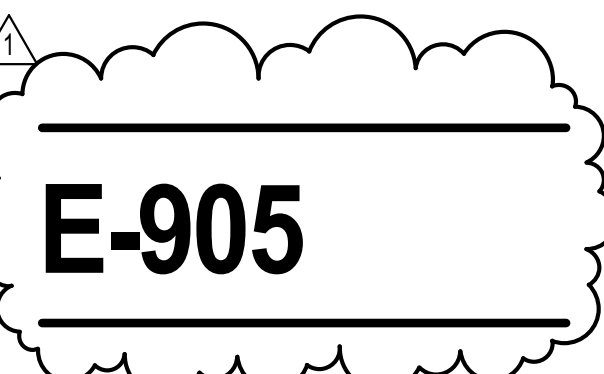

3/13/2015 1:03:58 PM C:\Users\lisa.fisher\Desktop\4J\CONTR\4J-905.rvt

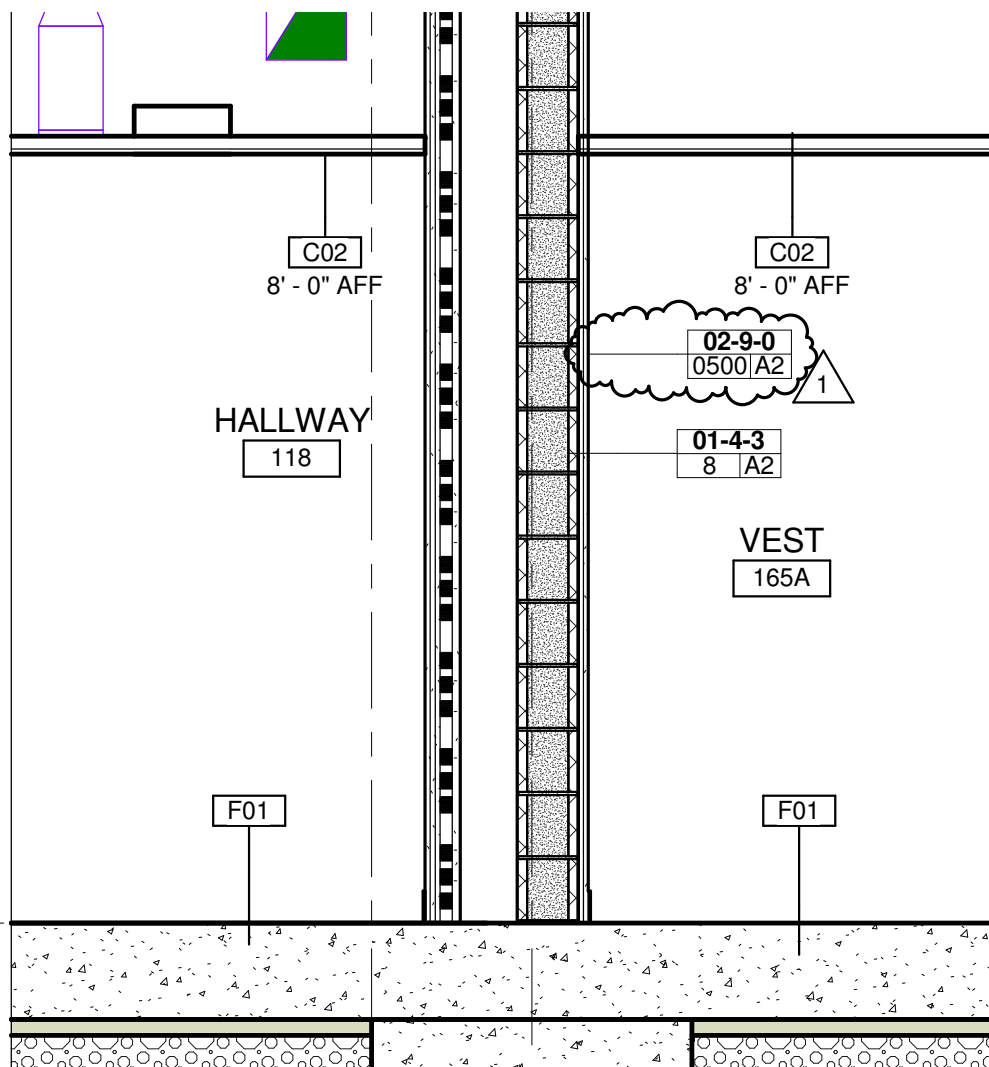

SECTION (N/S) AT ADMIN TO LOCKER ROOM FIREWALL

A1

1/2" = 1'-0"

\\SERVER\Users\lanal\My Documents\2013913-Arch-V14_v7_lana1.rvt


3/13/2015 1:28:05 PM

mahlum

REPLACEMENT ROOSEVELT MIDDLE SCHOOL
CIP NUMBER 410.566.001
680 EAST 24TH AVENUE
EUGENE, OREGON 97405
EUGENE SCHOOL DISTRICT 4J

DETL/SHT: **A1/A-325**
REF: **ADDENDUM 6**

PROJECT NO: **2013912.00**
DATE: **3/13/15**
ADD-A-325-01

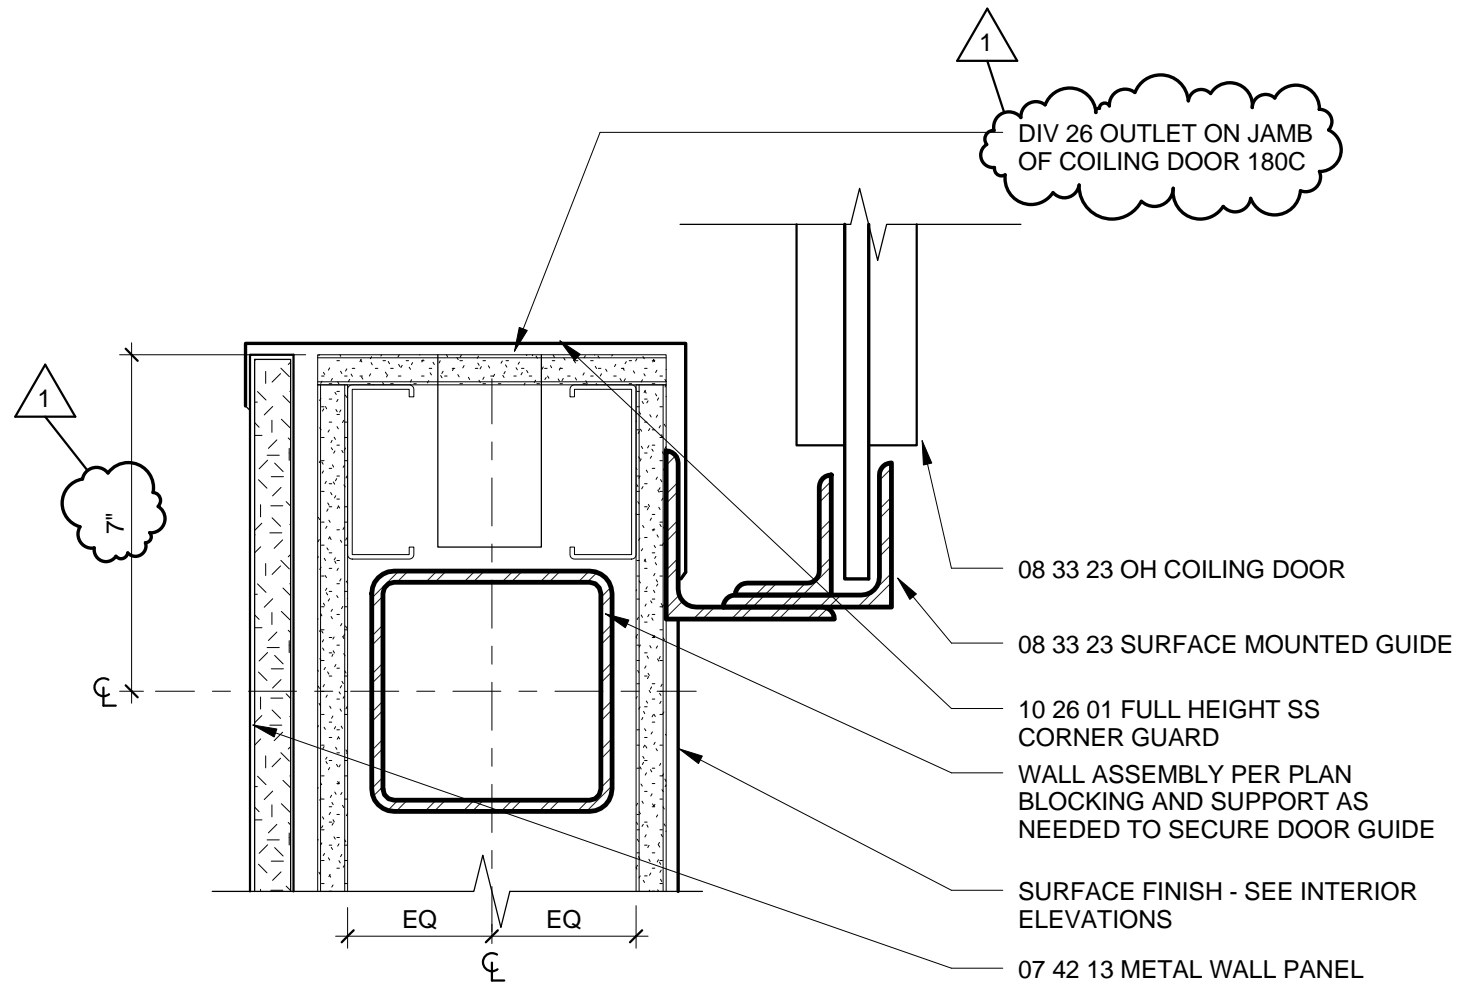

A6 OH DOOR JAMB
3" = 1'-0"




C:\-RevitLocalFiles\2013913-Arch-V14_vsr_acopeland.rvt 3/12/2015 4:55:23 PM

mahlum


REPLACEMENT ROOSEVELT MIDDLE SCHOOL
CIP NUMBER 410.566.001
680 EAST 24TH AVENUE
EUGENE, OREGON 97405
EUGENE SCHOOL DISTRICT 4J

DETL/SHT: **A6/A-555**
REF: **ADDENDUM 6**

PROJECT NO: **2013912.00**
DATE: **3/13/15**
ADD-A-555-01

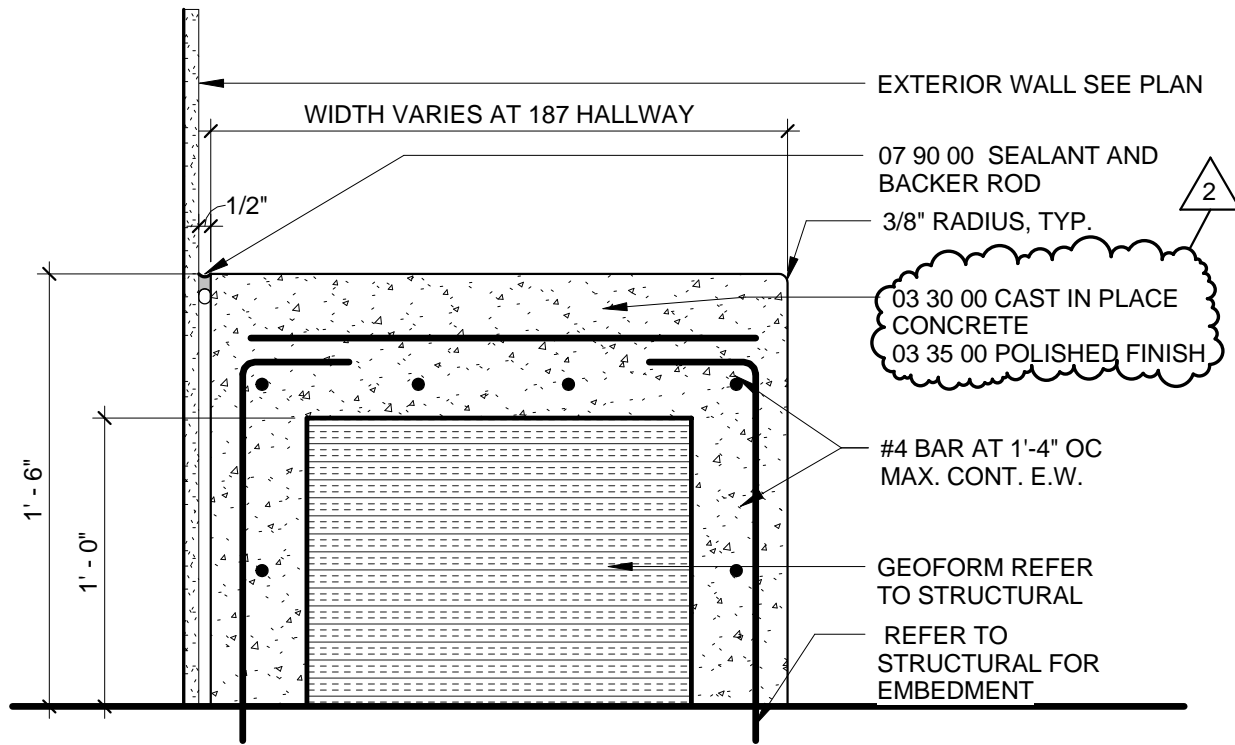

C4 BENCH SECTION @ WALL
 1 1/2" = 1'-0"

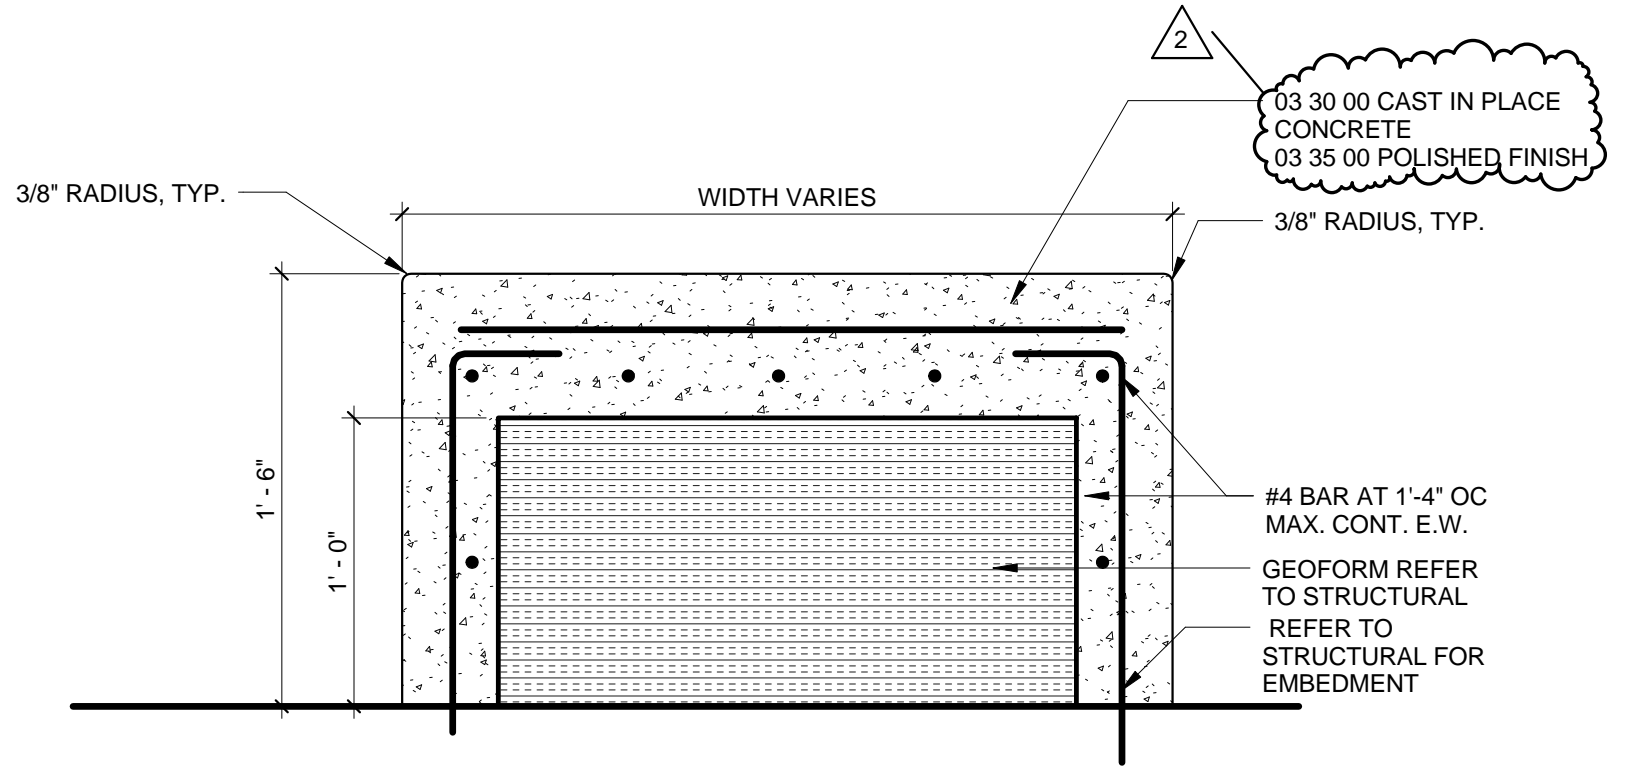

C5 BENCH SECTION
 1 1/2" = 1'-0"



C:\-RevitLocalFiles\2013913-Arch-V14_vst_acopeland.rvt


3/12/2015 4:57:48 PM

mahlum

REPLACEMENT ROOSEVELT MIDDLE SCHOOL
 CIP NUMBER 410.566.001
 680 EAST 24TH AVENUE
 EUGENE, OREGON 97405
 EUGENE SCHOOL DISTRICT 4J

DETL/SHT: **C4&C5/A-559**
 REF: **ADDENDUM 6**

PROJECT NO: **2013912.00**
 DATE: **3/12/15**
ADD-A-559-01

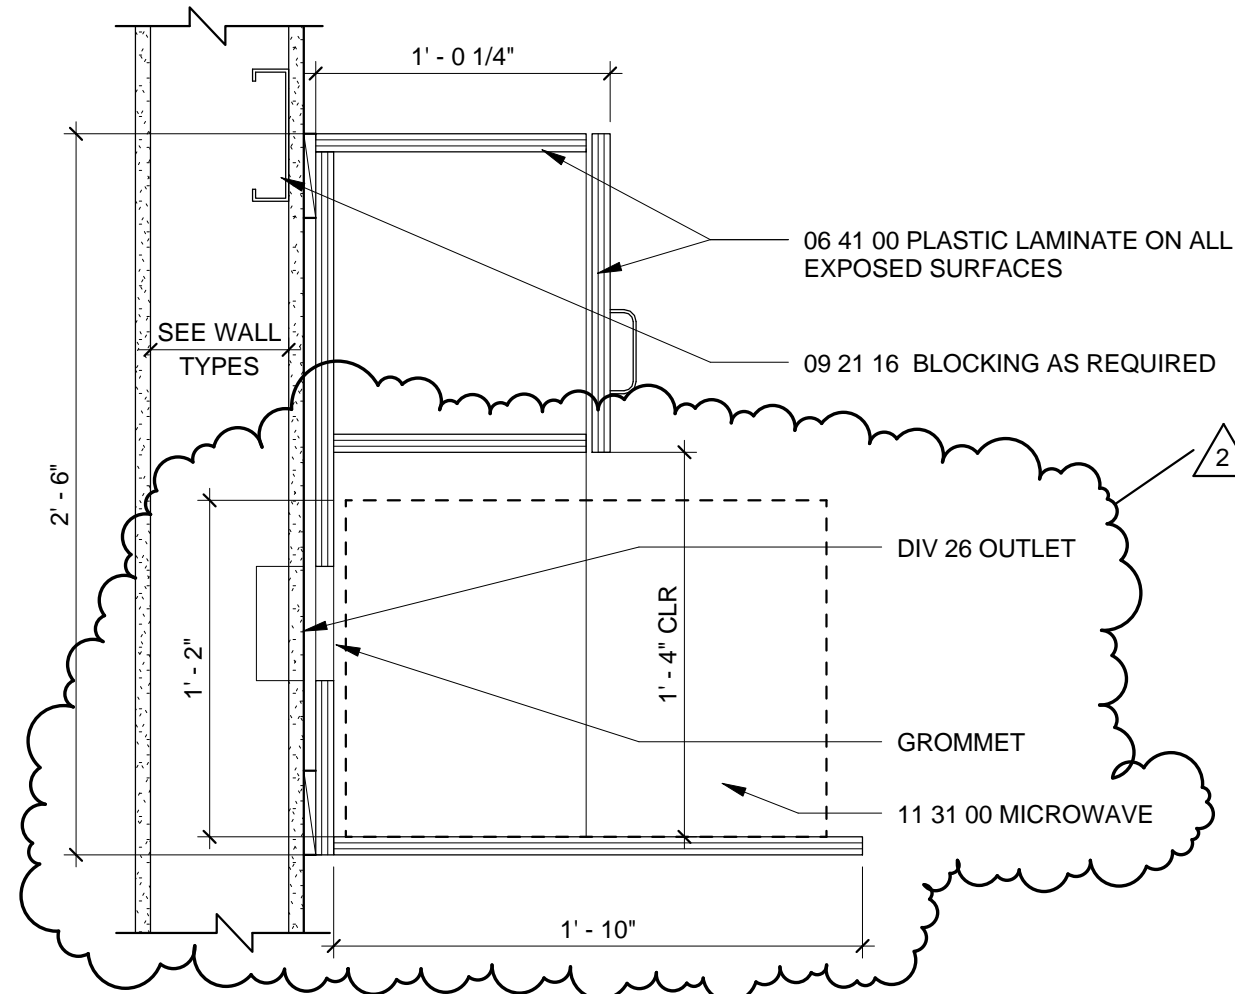

**UPPER CABINET W/
MICROWAVE**

C4

1 1/2" = 1'-0"



C:\-RevitLocalFiles\2013913-Arch-V14_vsr_acopeland.rvt

3/12/2015 4:56:55 PM

mahlum

REPLACEMENT ROOSEVELT MIDDLE SCHOOL
CIP NUMBER 410.566.001
680 EAST 24TH AVENUE
EUGENE, OREGON 97405
EUGENE SCHOOL DISTRICT 4J

DETL/SHT: **C4/A-582**
REF: **ADDENDUM 6**

PROJECT NO: **2013912.00**
DATE: **3/13/15**
ADD-A-582-02

