

18 March 2020

ADDENDUM #1

PROJECT: Kelly Middle School Improvements & North Eugene High School Improvements

PROJECT NUMBERS: District CIP# 461.524.003

The following deletions and additions are hereby made a part of Bidding and Contract Documents, effective this date.

PROJECT MANUAL

Item

1. Reference Document 00 01 10, Project Manual Table of Contents, Kelly Middle School Improvements, Division 07:

Delete: 07 31 00 Asphalt Shingle Roofing. Add: 07 31 13 Asphalt Shingle Roofing.

2. Reference Document 00 01 10, Project Manual Table of Contents, Kelly Middle School Improvements, Division 23:

Add: 23 82 00 Convection Heating and Cooling Units.

3. Reference Document 00 01 10, Project Manual Table of Contents, North Eugene High School Improvements, Division 23:

Delete: Section 23 05 14 Variable Frequency Drives for HVAC Equipment

Add: Section 23 05 48 Vibration and Seismic Controls for HVAC Piping and

Equipment

4. Reference Document 00 01 10, Project Manual Table of Contents, Drawings:

Add: COV, Cover.

Kelly Middle School Improvements Drawings

Add: Sheet ED.2, Partial Demolition Plans – Electrical.
Add: Sheet E1.5, Enlarged Partial Electrical Floor Plan.

North Eugene High School Drawings

Add: Sheet M1.3, Enlarged Partial Floor Plan – Mechanical.

Add: Sheet E8.01, Panel Schedules.

5. Reference Document 00 11 13, Invitation to Bid:

Delete: "Sealed bids will be received [...] Late Bids will not be considered." in

entirety.

Add: "Bids will be received by 4J Facilities and Capital Improvement Program

(CIP) staff for the Kelly Middle School Improvements and North Eugene High School Improvements project on Tuesday, April 7, 2020 until the Deadline for Bid Submission at 2:00pm. Due to the current environment, staff will be working remotely, and the Facilities Office will not be open

to receive Bids. Required Bid Documents must be submitted

electronically as one (1) pdf file (maximum file size 10 MB) by e-mail to:

CIP@4j.lane.edu. Late Bids will not be considered."

6. Reference Document 00 41 13, Bid Form, Bid Deadline:

Delete: March 26th, 2020. Add: April 7th, 2020.

7. Reference Section 01 60 00, Product Requirements, Substitution Request Form, Deadline:

Delete: March 14th, 2020. Add: March 28th, 2020.

8. Reference Document 01 11 00, Summary of Work, 1.6 Work Under Separate Contracts, A:

Add: 7. Smart Boards and Projectors.

9. Reference Document 01 11 00, Summary of Work, 1.6 Work Under Separate Contracts:

Add: C. Site work for Playgrounds must be complete by July 20th for

Playground work by Others. Engineered wood fiber installation shall

occur after Playground work by Others is complete.

10. Reference Document 01 11 00, Summary of Work, 1.8 Owner-Furnished Products, 3:

Delete: Smart Boards and Projectors.

KELLY MIDDLE SCHOOL IMPROVEMENTS

11. Reference Section 07 62 00, Flashing and General Sheet Metal, 2.1 Sheet Materials:

Add: E. Stainless Steel: ASTM A167 Type 304, 16 gauge, 2-inch minimum leg

each side. Height as indicated in Drawings.

12. Reference Section 07 72 00, Roof Accessories, 1.1.B Related Requirements:

Delete: Section 07 62 00 – Sheet Metal Flashing and Trim.

Add: Section 07 60 00 – Flashing and General Sheet Metal.

13. Reference Section 08 71 00, Door Hardware, 2.1 Acceptable Manufacturers, C:

Add: Lock Sets: Schlage ND Series, Rhodes Lever.

14. Reference Section 08 73 01, Door Hardware Types:

Delete: Section in entirety.

Add: Revised Section 08 73 01, Door Hardware Types, attached.

15. Reference 10 28 13, Toilet Accessories, 2.4.A.4:

Add: Dyson AirBlade V.

16. Reference Section 22 40 00, Plumbing Fixtures:

Delete: Section in entirety.

Add: Revised Section 22 40 00, Plumbing Fixtures, attached.

17. Reference Section 23 05 48, Vibration and Seismic Controls for HVAC Piping and Equipment:

Delete: Section in entirety.

Add: Revised Section 23 05 48, Vibration and Seismic Controls for HVAC Piping

and Equipment, attached.

18. Reference Section 23 34 00, HVAC Fans:

Delete: Section in entirety.

Add: Revised Section 23 34 00, HVAC Fans, attached.

19. Reference Section 23 81 00, Decentralized Unitary HVAC Equipment:

Delete: Section in entirety.

Add: Revised Section 23 81 00, Decentralized Unitary HVAC Equipment,

attached.

20. Reference Section 23 82 00, Convection Heating and Cooling Units:

Delete: Section in entirety.

Add: Revised Section 23 82 00, Convection Heating and Cooling Units,

attached.

NORTH EUGENE HIGH SCHOOL IMPROVEMENTS

21. Reference Section 05 50 00, Fabricated Steel, Part 2 – Products:

Add: 2.7 STEEL PIPE HANDRAILS

- A. General: Fabricate pipe handrails to comply with requirements indicated for dimensions, details, finish, and member sizes, including wall thickness of pipe, post spacings, and anchorage.
- B. Interconnect handrail members by butt-welding or welding with internal connectors, at fabricator's option, unless otherwise indicated. At tee and cross intersections, cope ends of intersecting members to fit contour of pipe to which end is joined, weld all around and grind smooth.
- C. Form changes in directions of railing members as follows:
 - 1. By use of welded prefabricated steel elbow fittings.
 - 2. By bending, of radius indicated.
 - 3. By mitering at elbow bends.
- D. Form simple and compound curves by bending pipe in jigs to produce uniform curvature for each repetitive configuration required; maintain cylindrical cross-section of pipe throughout entire bend without buckling, twisting, cracking, or otherwise deforming exposed surfaces of pipe.
- E. Returns: Return ends to adjacent wall or nearest vertical support unless otherwise indicated on drawings.
- F. Close exposed ends of pipe by welding 3/16 inch thick steel plate in place or by use of prefabricated fittings, except where clearance of end of pipe and adjoining wall surface is ¼ inch or less.
- G. Toe Boards: Where indicated, provide toe boards at railings around openings and at edge of open-sided floors and platforms. Fabricate to dimensions and details indicated, or if not indicated, use 4 inches high x ¼ inch steel bar welded to each railing post.
- H. Brackets, Flanges, Fittings, and Anchors: Provide wall brackets, end closures, flanges, miscellaneous fittings, and anchors for interconnections of pipe and attachment of guardrails and handrails to other work. Furnish inserts and other anchorage devices for connecting guardrails and handrails to concrete or masonry work.
- J. Fillers: Provide steel sheet or plate fillers of thickness and size indicated or required to support structural loads of handrails where needed to transfer wall bracket loads through wall finishes to structural supports. Size fillers to suit wall finish thicknesses. Size fills to produce adequate bearing to prevent bracket rotation and overstressing of substrate.
- 22. Reference Section 07 62 00, Flashing and General Sheet Metal, 2.1 Sheet Materials:

Add: E. Stainless Steel: ASTM A167 Type 304, 16 gauge, 2-inch minimum leg

each side. Height as indicated in Drawings.

23. Reference Section 07 72 00, Roof Accessories, 1.1.B Related Requirements:

Delete: Section 07 62 00 – Sheet Metal Flashing and Trim.

Add: Section 07 60 00 – Flashing and General Sheet Metal.

24. Reference Section 08 73 01, Door Hardware Types:

HARDWARE SET 1, LOCKSET

Delete: ND75PD. Add: ND95PD.

HARDWARE SET 2, LOCKSET

Delete: ND75PD. Add: ND95PD.

HARDWARE SET 3, LOCKSET

Delete: ND50PD. Add: ND91PD.

25. Reference Section 08 73 01, Door Hardware Types:

Add: HARDWARE SET 5: DOOR E302A

QtyDescriptionCatalog NumberFinishMfr1EXTERIOR TRIMV4908A626PHI

Add: HARDWARE SET 6: DOOR E304A

QtyDescriptionCatalog NumberFinishMfr1LOCKSETND95PD626SCH

26. Reference 09 51 00, Acoustical Ceilings, 2.2 Acoustical Ceiling Units:

Add: ACT-3: Glue On 12" x 12" Perforated Wood Fiber Acoustic Ceiling Tiles, Silent Source #58780 Bevel Butt Joint Random Drill, or approved.

27. Reference 10 28 13, Toilet Accessories, 2.4.A.4:

Add: Dyson AirBlade V.

28. Reference Section 22 40 00, Plumbing Fixtures:

Delete: Section in entirety.

Add: Revised Section 22 40 00, Plumbing Fixtures, attached.

29. Reference Section 23 05 14, Variable Frequency Drives for HVAC Equipment:

Delete: Section in entirety.

30. Reference Section 23 05 48, Vibration and Seismic Controls for HVAC Piping and Equipment:

Add: 23 05 48, Vibration and Seismic Controls for HVAC Piping and Equipment,

attached.

31. Reference Section 23 81 00, Decentralized Unitary HVAC Equipment:

Delete: Section in entirety.

Add: Revised Section 23 81 00, Decentralized Unitary HVAC Equipment,

attached.

DRAWINGS

Item

1. Reference Drawings:

Delete: Kelly Middle School Improvements and North Eugene High School

Improvements Drawing Set in entirety.

Add: Kelly Middle School Improvements and North Eugene High School

Improvements Drawing Set with Revision 1, attached.

CLARIFICATIONS

Item

- 1. While adequate supervision is expected at both sites to complete the Work as specified, one Superintendent is acceptable for both sites.
- 2. Bid Submission deadline is now 2:00pm, April 7, 2020. Bids must be received electronically as noted above under Section 00 11 13.

PRODUCT APPROVALS

Add the following to the list of acceptable manufacturers and products as noted: None at this time.

Attachments:

- 1. Mandatory Pre-Bid Sign-In Sheet (for reference)
- 2. Revised KMS Specification Sections 08 73 01, 22 40 00, 23 05 48, 23 34 00, 23 81 00, and 23 82 00
- 3. Revised NEHS Specification Sections 22 40 00, 23 05 48, and 23 81 00
- 4. Revised Drawing Set with Revision 1

END OF ADDENDUM ONE



Mandatory Pre-Bid Sign-In Sheet Eugene School District 4J Kelly MS and NEHS Improvements

Mandatory Pre-Bid Conference March 12, 2020 3:00 p.m.

	Company	Name	E-mail	Phone
1	V		Construction · com	
	Luna Design and Construction	Scot Swage	Scottalunadesignand	541-514-1901
2			Jerry Ve bridgerous contracting.com	541-606-2571
	Bridgeway Contracting Bineham construction Inc.	Jarry Valengi		
3	Bineham construction Inc.	TREVUR BINEHAM	trevor binehama bine ham construction.com	541-514-4126
4		c	Madison @ hermanson, com	541-225-8098 503-258-688
	Hermanson	Leoward Mandisch		
5	2G CONSTRUCTION	Doug Jost	djost@lgconstruction.co	7541)689-3850
6				
	GBC construction	Joel Freeman	Loel C BBC CONSTRUCTION	541 224 1501
7	Anderson Construction.	Ryen Krox	Thox Cantersen-cons d. com	

	Company	Name	E-mail	Phone
8	FM Sheet Metal	Pack Tillotson	ZTillotson@fMSheetmetalicom	
		-		541 726 3000
9	Bridgeway Contracting	Bob Buss	contracting, con	541.501.9020
10	CHAMBERS GNOTRUCTION	BHAN ANDERSON	bidgechambers-gc.com	(541)868.8519
11	HATHAWAYS INC	KEVIN DAVIS	KEUIND @HATHAWAYS ENC	(54) 734-8601
12	Northwest Community Builders	Mary Gustafen	ericg@nwcbuilders.com	541-8029245
13	WILDISH BUILDING CO	ACEX KING	ALEX K @ WILDISH . COM	541-255-7755
14	ESSEX CENERAL CONST. W.C.	CHUCH CONDIT	CHULA. CONDITTO BSSEXCC. COM	503-421.7548

	Company	Name	E-mail	Phone
15	L.R. Brabham, Inc.	- Jordan Brabham	gordan@lrbrabham.com	541-747-6638
16	Prestige Concrete	Yair Buendia	Prestige concrete 14@gmails	541-505-61/8 m
17	Dorman Construction	Brad Anderson	brad@domanconstruction.com	5419535872
18				
19				
20				
21				

SECTION 08 73 01 DOOR HARDWARE TYPES

MANUFACTURERS

SEL – SELECT

CAM – CAMDEN

GLY – GLYNN JOHNSON

PHI – PRECISION

LCN - LCN

SCH – SCHLAGE

PEM – PEMKO

VD – VON DUPRIN

IVE – IVES

MCK – MCKINNEY

HES – HES

ALV – AIR LOUVERS

RIX - RIXSON

HARDWARE SET 1: DOOR NRR1A

<u>Qty</u>	<u>Description</u>	Catalog Number	<u>Finish</u>	<u>Mfr</u>
3	HINGE	T4B3386 5½X4 NRP	606	MCK
1	MORTISE LOCKSET	L9496	606	SCH
1	ADA THUMBTURN	09-509XL583-363	606	SCH
1	CLOSER	4111 EDA WMS	606	LCN
1	KICKPLATE	8400 10"X2"LDW B4E CS	606	IVE
1	WALL STOP	WS407CCV	606	IVE
1	SEAL	S88	GRAY	PEM

HARDWARE SET 2: CLASSROOM DOORS - N1A, N4A, N6A, N8A, N9A, N9AA

Qty	<u>Description</u>	Catalog Number	<u>Finish</u>	<u>Mfr</u>
3	HINGE	T4B3386 5½X4 NRP	626	MCK
1	LOCKSET	ND95PD	626	SCH
1	KICKPLATE	8400 10"X2"LDW B4E CS	626	IVE
1	WALL STOP	WS407CCV	626	IVE
3	SILENCERS	SR 64	GR	IVE

HARDWARE SET 3: OFFICE DOORS – NTECHA, NLIBBA, NLIBAA, N35A

<u>Qty</u>	<u>Description</u>	Catalog Number	<u>Finish</u>	<u>Mfr</u>
3	HINGE	T4B3386 5½X4 NRP	626	MCK
1	LOCKSET	ND91PD	626	SCH
1	WALL STOP	WS407CCV	626	IVE
3	SILENCERS	SR 64	GRAY	IVE

HARDWARE SET 4: DOOR NRR4A, NRR8A

<u>Qty</u>	<u>Description</u>	Catalog Number	<u>Finish</u>	Mfr
3	HINGE	T4B3386 5½X4 NRP	626	MCK
1	PUSH PLATE	8200	626	IVE
1	PULL BAR	8302	626	IVE
1	CLOSER	4111 EDA WMS	ALUM	LCN
1	KICKPLATE	8400 10"X2"LDW B4E CS	626	IVE
1	WALL STOP	WS407CCV	626	IVE
1	SEAL	S88	GRAY	PEM

DOOR HARDWARE TYPES 08 73 43 - 1

SECTION 08 73 01 DOOR HARDWARE TYPES

HARDWARE SET 4A: DOOR NLKR1A

<u>Qty</u>	<u>Description</u>	Catalog Number	<u>Finish</u>	Mfr
3	HINGE	T4B3386 5½X4 NRP	626	MCK
1	PUSH PLATE	8200	626	IVE
1	PULL BAR	8302	626	IVE
1	CLOSER	4111 EDA WMS	ALUM	LCN
1	KICKPLATE	8400 10"X2"LDW B4E CS	626	IVE
1	OVERHEAD STOP	100S ADJ	626	GLY
1	SEAL	S88	GRAY	PEM

HARDWARE SET 5: DOOR ERR5A

<u>Qty</u>	<u>Description</u>	<u>Catalog Number</u>	<u>Finish</u>	<u>Mfr</u>
1	LOCKSET	L9496	606	SCH
1	ADA THUMBTURN	09-509XL583-363	606	SCH

DOOR HARDWARE TYPES 08 73 43 - 2

SECTION 22 40 00

PLUMBING FIXTURES

PART 1 GENERAL

1.1 SUMMARY

- A. This Section includes:
 - 1. Fixture Trim
 - 2. Plumbing Fixtures
 - 3. Drainage Products
 - 4. related sections
- B. Division 01, General Requirements
- C. Division 22, Plumbing

1.2 QUALITY ASSURANCE

- A. Water Closets: Maximum Performance (MaP) score of no less than 800
- B. Faucets: Certify to NSF/ANSI 61 and California AB1953
- C. Electric Water Coolers and Drinking Fountains: Certified to NSF/ANSI 61 and California AB1953
- D. SUBMITTALS
- E. Submit the following:
 - 1. Product data for each item specified.
 - 2. Operating and Maintenance Data:
 - a. Mounting heights for fixtures.

PART 2 PRODUCTS

2.1 MANUFACTURERS

- A. Manufacturers are stated for each fixture specified. The following manufacturers are also acceptable, except when indicated only.
- B. Fixture Trim:
 - 1. Supply Stops:
 - a. Chicago
 - b. NPT McGuire (LK series)
 - c. Brasscraft (SCR series)
 - 2. Traps:
 - a. McGuire
 - b. Kenney
 - c. Brasscraft

PLUMBING FIXTURES - SECTION 22 40 00

- 3. Support Rims:
 - a. Hudee
- 4. Vacuum Breakers:
 - a. Chicago Faucet
 - b. A.W. Cash
 - c. Febco, chrome plated
- C. Drainage Products and Carrier Products:
 - 1. J.R. Smith
 - 2. Josam
 - 3. Sioux Chief
 - 4. Zurn
 - 5. Wade
 - 6. Watts Drainage
 - 7. Woodford
 - 8. Mifab
- D. Fixtures:
 - 1. American Standard
 - 2. Kohler
 - 3. Sloan
 - 4. Toto
- E. Seats:
 - 1. Olsonite
 - 2. Church
 - 3. Beneke
 - 4. Bemis
- F. Mixing Valves:
 - 1. Powers
 - 2. Leonard
 - 3. Symmons
 - 4. Chicago
- G. Faucets:
 - 1. Chicago
 - 2. Delta Commercial
 - 3. Kohler
 - 4. Symmons
 - 5. Moen Commercial
- H. Flush Valves:
 - 1. Sloan
 - 2. Zurn
- I. Shock Arrestors:
 - 1. PPP
 - 2. J.R. Smith

- J. Trap Primer Stations:
 - 1. PPP
- K. Exposed Waste and Supply Piping Insulation Kits:
 - 1. Truebro
 - 2. McGuire
- L. Other Manufacturers: Submit substitution request.

2.2 FIXTURE TRIM

- A. Supply Stops: Chicago cast brass rigid riser supplies with loose key angle stops, wall flanges, NPT female inlet, chrome plate finish; equivalent NPT McGuire (LK series), Brasscraft (SCR series), or NPT stops by fixture supplier.
- B. Traps:
 - 1. For floor drains, provide coated cast iron P-trap; recessed, screw jointed or bell and spigot.
 - 2. For other fixtures, provide 17 gauge, chrome plated cast brass P-Traps with solder bushings, and clean-out.
- C. Support Rims: Hudee stainless steel rims, if sink not furnished with integral rim.
- D. Vacuum Breakers:
 - 1. Chicago Faucet
 - 2. A.W. Cash
 - 3. Febco, chrome plated

2.3 PLUMBING FIXTURES

- A. WC-1 Water Closet:
 - 1. Kohler Kingston American Standard AFWALL with Everclean surface, vitreous china, wall hung, elongated bowl, siphon jet action, 1-1/2-inch top spud, white color finish.
 - 2. Complete with Sloan Royal manual flush valve with dual filtered fixed bypass diaphragm. (1.28 GPF).
 - 3. Bemis 1600 series white open-front seat, less cover with external check hinge including 300 series stainless steel post and pintles to stop seat at 11 degrees beyond vertical.
 - 4. J.R. Smith Series 200 chair carrier.
- B. WC-2 Water Closet (ADA): Same at WC-1, except mounted at ADA mounting height.
- C. U-1 Urinal (ADA):
 - 1. Kohler Bardon, vitreous china, wall mounted wash down urinal with ¾-inch top spud, white color finish
 - 2. Complete with Sloan Royal manual flush valve with dual filtered fixed bypass diaphragm. (0.5 GPF)
 - 3. J. R. Smith Series 600 floor mounted urinal support.
- D. U-2 Urinal: Same as U-1, except mounted with rim at ADA mounting height.

E.D. L-1 Lavatory (Commercial - ADA):

- 1. Kohler Kingston 21-1/4-inch by 18-1/8-inch, vitreous china, self-draining deck, backsplash, 4-inch centers, wall hung, concealed arm support, grid drain, white color finish. Holes as required for faucet.
- 2. Chicago 802-V665ABCP faucet with polished chrome plated solid brass body construction, 4-inch spout, vandal proof metering push handles, 2.2 gpm pressure compensating aerator, adjustable cycle time closure cartridge, vandal resistant complete.

F.E. WS-1 Wash Station (ADA):

- Bradley, Model MG series Express Deck EXD-2N, 2 station, wall-hung, equipped with Chicago 802-V665ABCP faucets with polished chrome plated solid brass body construction, 4-inch spout, vandal proof metering push handles, 2.2 gpm pressure compensating aerator, adjustable cycle time closure cartridge, vandal resistant complete.
- 2. Mixing Valve (Point-of-Use):
- 3. Leonard 270 series thermostatic point-of-use mixing valve.
- 4. ASSE 1070 certified.
- 5. Bronze body.
- 6. Locked temperature adjustment cap (vandal resistant).
- 7. Integral check valves on hot and cold inlets.
- 8. Minimum flow 0.5 GPM.
- 9. Maximum flow 3.5 GPM at 5 PSI loss.
- G.F. Exposed Waste and Supply Piping Insulation Kits: McGuire Prowrap insulation kit for exposed supplies and waste piping below ADA lavatories and ADA sinks.

2.4 DRAINAGE PRODUCTS

- A. FD-1 Floor Drain: J.R. Smith 2005 Series, round nickel bronze vandal resistant grate, cast iron body with flashing collar and adjustable strainer head and no-hub outlet.
- B. WCO Wall Cleanout: J.R. Smith 4530 Series, round stainless steel vandal resistant cover and screw.
- C. FCO Floor Cleanout: J.R. Smith 4020 Series, round vandal resistant, nickel bronze top.
- D. Trap Priming Valves:
 - 1. Sioux Chief Prime-Perfect mechanical automatic trap primer valve.
 - D.2. Activates with a 10 psig pressure drop between 30-150psig.
 - 1. Precision Plumbing Products Prime time electronic trap priming manifold including but not limited to: atmospheric vacuum breaker, pre-set 24 hour clock, manual over ride, 120V slow closing solenoid valve, calibrated manifold for equal water distribution.
 - 2. Components pre-installed in recessed steel cabinet with SS access door.
- E. Water Hammer Arrester: Precision Plumbing Products Model SC (Maintenance-Free).

PART 3 EXECUTION

3.1 FIXTURE TRIM

A. Provide plumbing fixture trim where applicable on fixtures, including but not limited to supply stops, traps, support rims, flush valve, and vacuum breakers.

- B. Provide rough-in and final piping connection to fixtures. Carefully review all construction documents to assure that all fixtures are provided with necessary services for a complete operating system.
- C. Rigidly secure rough-in piping, carriers and supports, and other service piping to structure.

3.2 PLUMBING FIXTURES

- A. Americans with Disabilities Act:
 - 1. Those fixtures indicated by ADA complies with and be installed in accordance with Americans with Disabilities Act Guidelines (ADAAG). Where applicable building code requirements are more stringent than ADAAG guidelines, building code requirements followed.
 - 2. Water Closets:
 - a. Mounting height of ADA water closet 17-inches to 19-inches from floor to top of the toilet seat.
 - b. Mount flush valve for ADA water closets on wide side of enclosure.
 - Lavatories:
 - a. Mounting height of ADA lavatories at a maximum height of 34 inches from floor to rim.
 - b. Provide insulation kits on exposed hot water and waste piping beneath ADA lavatories.
 - 4. Urinals: Mounting height of ADA water closet at a maximum height of 17-inches from floor to top rim.
- B. Fixture Mounting Heights: Fixtures standard rough-in catalogued heights unless shown otherwise on the Architectural Drawings.
- C. Water Supplies: When both hot and cold water to a fixture is required, connect the hot on the left and the cold on the right.
- D. Floor Mounted Supports and Chair Carriers:
 - 1. Secure floor mounted supports and chair carriers to slab with a minimum of 1/2-inch bolts.
 - 2. Install supports and carriers per manufacturer's installation instructions.

E. Lavatories:

- Public Toilet Room: Grid strainers.
- 2. Private Toilet Room: Pop-up waste assemblies.
- 3.2. Those lavatories indicated as ADA are ADA compatible. Coordinate with Architect to verify if all wall hung lavatories are to be installed at ADA height.
- F. Floor Drain and Floor Sinks:
 - 1. Set top flush with finished floor.
 - 2. Provide flashing clamp for all drain bodies installed in floors provided with waterproof membranes.
- G. Cleanout:
 - 1. Where shown or required.
 - 2. Cover set flush with finished surface.
- H. Water Hammer Arresters: Provide where shown and where recommended by Plumbing Drainage Institute (PDI).
- I. Mixing Valves: Provide piping connections per manufacturer's installation instructions.

- J. Wall hung lavatories with pop-up waste assemblies: Verify there is no vertical pull rod assembly conflict with lavatory backsplash prior to submitting product data.
- 3.3 PRIMING VALVES
 - A. All floor drains, floor sinks, and similar traps primed. Use minimum 3/8-inch type K annealed copper tubing. Primer line to be continuous and without joints.
 - B. Where priming valves are installed in finished rooms, conceal in wall and provide access panel.
 - C.—Coordinate locations of electronic trap primer stations with electrical contractor for 120V service.

END OF SECTION

SECTION 23 05 48

VIBRATION AND SEISMIC CONTROLS FOR HVAC

PART 1 GENERAL

1.1 RELATED DOCUMENTS

- A. Drawings and general provisions of the Contract, including General and Supplementary Conditions and Division 01, General Requirements Specification Sections, apply to this Section.
- B. The provisions of Division 23, Heating, Ventilation and Air Conditioning (HVAC) Section 23 05 00, Common Work Results for HVAC, apply to work specified in this Section.

1.2 SUMMARY

- A. This Section includes:
 - 1. Neoprene Waffle Pad
 - 2. Restrained Neoprene Mount
 - 3. Spring Isolators
 - 4. Springs with Restraints
 - 5. Base with Springs
 - 6. Inertia Base
 - 7. Isolating Spring Hangers
 - 8. Isolating Neoprene Hangers
 - 9. Rooftop Air Handling Unit Isolation Curb
 - 10. Isolating Sleeves
 - 11. Seismic Restraints
 - 12. Flexible Sphere Connector
 - 13. Flexible Hose Connector
- B. Isolation of mechanical equipment as indicated on the Drawings and specified herein.
- C. Seismic restraint of equipment, piping, and ductwork.

1.3 RELATED SECTIONS:

- A. Division 01, General Requirements
- B. Division 23, Heating, Ventilating, and Air Conditioning (HVAC)
- C. Section 23 05 29, Hangers, Supports and Anchors for HVAC
- D. Section 23 31 01, HVAC Ducts and Casing-Low Pressure
- E. Section 23 31 02, HVAC Ducts and Casing-Medium Pressure

1.4 QUALITY ASSURANCE

- A. Single manufacturer select and furnish isolation required, except packaged equipment with integral isolators meeting all the isolation and seismic requirements of this Specification.
- B. System of vibration isolators and seismic controls designed, detailed, and bear the seal of a professional engineer registered in the State having jurisdiction.
- C. Isolation performance requirements are indicated in the specifications. Deflections indicated are nominal static deflections for specific equipment supported.
- D. Seismic snubbers, restrained isolator housings, and cable system components have anchorage preapproval OPM number from OSHPD in the State of California verifying the maximum certified load ratings.
- E. Isolator Stability and Rated Capacity:
 - 1. Spring diameters not less than 0.8 of the compressed height of the spring at rated load.
 - 2. Springs have a minimum additional travel to solid equal to 50 percent of the rated deflection.

F. Seismic Restraints:

- 1. Restraint of equipment, piping, and ductwork to be in accordance with the current state and local Building Code.
- 2. Calculations in accordance with current state and local Building Code.

1.5 SUBMITTALS

A. Submit the following:

- 1. Submit Shop Drawings showing complete details of construction for steel and concrete bases including:
 - a. Equipment mounting holes.
 - b. Dimensions
 - c. Isolation selected for each support point.
 - d. Details of mounting brackets for isolator.
 - e. Weight distribution for each isolator.
 - f. Code number assigned to each isolator.
- 2. Submit product data and calculation sheets for isolators, showing:
 - a. Size, type, load rating, and rated deflection of each required isolator.
 - b. Percent of vibration transmitted based on the lowest disturbing frequency of the equipment.
- 3. Structural Details and Calculations substantiating that building structure, anchorages, and fabricated steel braces can safely withstand maximum calculated loads stamped and signed by a registered structural engineer.
- 4. Installation report as specified in PART 3 of this Section.
- 5. Operation and maintenance data.

1.6 EQUIPMENT VIBRATION ISOLATION

- A. Provide a balanced set of vibration isolators for each piece of equipment listed in the Equipment Schedules.
- B. Isolation work to include, but not necessarily be limited to, the following:
 - 1. Isolation support of motor-driven equipment.
 - 2. Inertia base frames in conjunction with isolation.

VIBRATION AND SEISMIC CONTROLS FOR HVAC - SECTION 23 05 48

- 3. Isolation support of air-handling housings.
- 4. Isolation support of piping, piping risers, and ductwork.
- 5. Penetration isolation of pipework, ductwork, and conduits through walls, floors, or ceilings.
- 6. Flexible connections of ductwork and piping to equipment.
- C. Each piece of rotating equipment must meet a reasonable criterion for maximum vibration levels at each bearing, while in operation. The criteria for varying operating speeds are given as follows:
 - 1. Rotating equipment operating at peak vibration velocities must not exceed 0.08-inch/second.
 - 2. If it is discovered that the operating vibration velocities exceed this criteria, the equipment repaired or replaced at no expense to the owner until approval of the equipment is given by the Engineer.
- D. Provide components or materials not specially mentioned herein, but necessary to the proper vibration isolation of the equipment.

1.7 CONTRACTOR RESPONSIBILITY

- A. Vibration isolation devices, including auxiliary steel bases and pouring forms, design and furnish by a single manufacturer or supplier.
- B. Adequately restrain all equipment, piping, and ductwork to resist seismic forces. Design and select restraint devices to meet seismic requirements as defined in the latest issue of the International Building Code under Earthquake Loads and applicable state and local codes.
- C. Have the following responsibilities:
 - 1. Selection, installation, adjustment, and performance of vibration isolators which will meet the requirements given on the plans or in the Specifications.
 - 2. Provide Engineering drawings, details, supervision, and instruction to assure proper installation and performance.
 - 3. Provide whatever assistance necessary to ensure correct installation and adjustment of the isolators.

PART 2 PRODUCTS

2.1 MANUFACTURERS

- A. Type 1 Neoprene Waffle Pad:
 - 1. Mason Type Super W or Super WM and HG Grommet
 - 2. Kinetics Noise Control
- A. Type 7 Isolating Spring Hangers:
 - 1. Mason 30N, similar Amber-Booth
 - 2. Kinetics Noise Control
 - 3. Vibrex

2.2 TYPE 1 - NEOPRENE WAFFLE PAD

- A. 3/4-inch thick neoprene waffle pads with pattern repeating on 1/2-inch centers.
- B. Select Duro rating for recommended deflection at average load rating.

- C. Include load distribution steel plate as required.
- D. Include anchor bolt grommet as required.

2.22.3 TYPE 7 - ISOLATING SPRING HANGERS

- A. Combination rubber-in shear and steel spring isolators installed on the hanger rods.
- B. Isolators shall have the proper deflection to allow the piping to deflect as a unit with the equipment isolators.
- C. Neoprene element and the cup shall have neoprene bushing bushings projecting through the steel box.
- D. Hangers designed for 30 degree angular movement.
- E. Minimum Deflection: 1-inch

2.32.4 SEISMIC RESTRAINTS

A. General Requirements:

- 1. Provided for equipment, piping and ductwork, both supported and suspended.
- 2. Bracing of piping shall be in accordance with state and local code requirements and ASCE 7 Seismic Design Requirements for Nonstructural Components, whichever is most stringent.
- 3. Bracing of ductwork shall be in accordance with the state and local code requirements, ASCE 7
 Seismic Design Requirements for Nonstructural Components, and with the provisions set forth in the SMACNA seismic restraint manual.
- 4. The structural requirements for the restraints, including their attachment to the building structure, shall be reviewed and approved by the Structural Engineer.
- 5. Attachments to supported or suspended equipment must be coordinated with the equipment manufacturer.

B. Supported Equipment:

- 1. All-directional Seismic Rubbers: Interlocking steel members restrained by a one-piece molded neoprene bushing of bridge bearing neoprene.
- 2. Replaceable bushing and minimum of 1/4-inch thick. Rated loadings not to exceed 1000 psi.
- 3. An air gap of 1/4-inch shall be incorporated in the snubber design in all directions before contact is made between the rigid and resilient surfaces.
- 4. Snubber End Caps:
 - a. Removable to allow inspection of internal clearances.
 - b. Rotated neoprene bushings be rotated to ensure no short circuits exist before systems are activated.
- 5. Snubber: Mason Industries, Inc. Type Z-1225

C. Bracing of Pipes:

- 1. Provide seismic bracing of piping as detailed below to meet the building code requirements:
 - Exception: Piping suspended by individual hangers need not be braced where the following criteria are met.
 - 1) Distance between the top of the pipe to the bottom of the support structure is 12-inches or less.

- 2) Seismic braces are not required on high deformability piping when the lp=1.0 and provisions are made to avoid impact with larger pipe or mechanical components or to protect the pipe in the event of such impact and the nominal pipe size is 3-inch diameter or less.
- 3) Seismic braces are not required on high deformability piping when the lp=1.5 and provisions are made to avoid impact with larger pipe or mechanical components or to protect the pipe in the event of such impact and the nominal pipe size is 1-inch diameter or less.
- 2. Seismic braces for pipes on trapeze hangers may be used.
- 3. Provide flexibility in joints where pipes pass through building seismic joints or expansion joints, or where pipes connect to equipment.
- 4. Cast iron pipe of all types, glass pipe, and any other pipe joined with a shield and clamp assembly, where the top of the pipe is 12-inches or more from the supporting structure, shall be braced on each side of a change in direction of 90 degrees or more. Riser joints on unsupported sections of piping shall be braced or stabilized between floors.
- 5. Vertical risers shall be laterally supported with a riser clamp at each floor. For buildings greater than six stories high or for piping subject to thermal change all risers shall be engineered individually.

D. Bracing of Ductwork:

- Brace rectangular ducts with cross sectional areas of 6 square feet and larger. Brace flat oval ducts in the same manner as rectangular ducts. Brace round ducts with diameters of 28-inches and larger. Brace flat oval ducts the same as rectangular ducts of the same nominal size.
- 2. Exception: No bracing is required if the duct is suspended by hangers 12-inches or less in length, as measured from the top of the duct to the bottom of the support where the hanger is attached.
- 3. Transverse bracing shall occur at the interval specified in the SMACNA tables or at both ends if the duct run is less than the specified interval. Transverse bracing shall be installed at each duct turn and at each end of a duct run, with a minimum of one brace at each end.
- 4. Longitudinal bracing shall occur at the interval specified in the SMACNA tables with at least one brace per duct run. Transverse bracing for one duct section may also act as longitudinal bracing for a duct section connected perpendicular to it if the bracing is installed within four feet of the intersection of the ducts and if the bracing is sized for the larger duct. Duct joints shall conform to SMACNA duct construction standards.
- 5. Install duct flex connections at equipment connections to accept expected differential displacement and protect the equipment connection from damage.

E. Suspended Equipment and Piping and Ductwork:

- 1. Seismic cable restraints shall consist of galvanized steel aircraft cables sized to resist seismic loads with a minimum safety factor of two and arranged to provide all-directional restraint.
- 2. Cable must be pre-stretched to achieve a certified minimum modulus of elasticity. Cable end connections shall be steel assemblies that swivel to final installation angle and utilize two clamping bolts to provide proper cable engagement.
- 3. Cable assemblies shall be type SCB at the ceiling and at the clevis bolt, SCBH between the hanger rod and the clevis or SCBV if clamped to a beam, all as manufactured by Mason Industries, Inc.
- 4. Steel angles or strut, sized to prevent buckling, shall be clamped to pipe or equipment rods utilizing a minimum of three ductile iron clamps at each restraint location when required. Welding of a minimum of three ductile iron clamps at each restraint location when required. Welding of support rods is not acceptable. Rod clamp assemblies shall be type SRC or UCC as manufactured by Mason Industries, Inc.
- 5. Pipe clevis cross-bolt braces are required in all restraint locations. They shall be special purpose preformed channels deep enough to be held in place by bolts passing over the cross bolt. Clevis cross brace shall be type CCB as manufactured by Mason Industries, Inc.

VIBRATION AND SEISMIC CONTROLS FOR HVAC - SECTION 23 05 48

PART 3 EXECUTION

3.1 GENERAL

- Do not install any equipment or pipe which makes rigid contact with the building.
- B. The installation or use of vibration isolators must not cause any change of position of equipment or piping which would result in stresses in piping connections or misalignment of shafts or bearings. In order to meet this objective, equipment and piping shall be maintained in a rigid position during installation. The load shall not be transferred to the isolator until the installation is complete and under full operational load.
- C. Correct, at no additional cost, all installations which are defective in workmanship or materials.

3.2 PREPARATION

- A. Treat all isolators, including springs, hardware, and housing, with a corrosion protective coating of epoxy powder or electro galvanizing.
- B. Coat steel frames exposed to weather with a rustproof metal primer.
- C. Provide hot dipped galvanizing on steel frames as indicated on the plans for corrosion protection in severe conditions.

3.3 INSTALLATION

A. General:

- 1. Install isolation where indicated on the Drawings by type and location and where indicated below.
- 2. The assigned code number shall be marked on the isolators and bases to assure placement in the proper location.
- 3. Anchor isolator seismic housing baseplate to floor.
- 4. Rubber grommets and washers shall be provided to isolate the bolt from the building structure. Under no circumstances shall the isolation efficiency be destroyed when bolting the isolators to the building structure.

B. Type 1 - Neoprene Waffle Pad:

- 1. Service:
 - a. Floor Mounted Indoor Heating and Ventilation Units
- B.C. Type 7 Isolating Spring Hangers:
 - 1. Service:
 - a. Inline Centrifugal Fans
 - a. Fan Coil Units

3.4 SEISMIC RESTRAINTS

A. General:

1. Install and adjust seismic restraints so that the equipment, piping, and ductwork support is not degraded by the restraints.

2. Restraints must not short circuit vibration isolation systems or transmit objectionable vibration or noise.

B. Supported Equipment:

- Each vibration isolation frame for supported equipment shall have a minimum of four seismic snubbers mounted as close as possible to the vibration isolators and/or the frame extremities.
- Care must be taken so that the 1/4-inch air gap in the seismic restraint snubber is preserved on all
 sides in order that the vibration isolation potential of the isolator is not compromised. This requires
 that the final snubber adjustment be completed after the vibration isolators are properly installed
 and the installation approved.

C. Bracing of Pipes:

- 1. Branch lines may not be used to brace main lines.
- 2. Transverse bracing shall be at 40-feet maximum, except where a lesser spacing is indicated in the SMACNA Seismic Restraint Manual for bracing of pipes.
- 3. Longitudinal bracing shall be at 80-feet maximum except where a lesser spacing is indicated in the tables. In pipes where thermal expansion is a consideration, an anchor point may be used as the specified longitudinal brace provided that it has a capacity to resist both the seismic load and the additional force induced by expansion and contraction.
- 4. Fuel oil, gas, cast iron pipe of all types, glass pipe and any other pipes joined with four band shield and clamp assembly shall be braced at 1/2 the spacings shown above.
- 5. A rigid piping system shall not be braced to dissimilar parts of the building or to two dissimilar building systems that may respond differently during an earthquake.
- 6. Transverse bracing for one pipe section may also act as longitudinal bracing for a pipe section of the same size connected perpendicular to it if the bracing is installed within 24-inches of the elbow or tee.
- 7. Branch lines may not be used to restrain main lines.
- 8. Where thermal expansion is a consideration, guides and anchors may be used as transverse and longitudinal restraints provided they have a capacity equal to or greater than the restraint loads in addition to the loads induced by expansion or contraction.
- 9. Subject to confirmation by field inspection, seismic bracing is not required on piping when the piping is supported by rod hangers and the hangers in the entire run are 12-inches or less in length from the top of the pipe to the supporting structure, hangers are detailed to avoid bending of the hangers and their attachments and provisions are made for piping to accommodate expected deflections.

D. Bracing of Ductwork:

- Transverse restraints shall occur at 30-foot intervals or at both ends of the duct run if less than the specified interval. Transverse restraints shall be installed at each duct turn and at each end of a duct run.
- 2. Longitudinal restraints shall occur at 60-foot intervals with at least one restraint per duct run. Transverse restraints for one duct section may also act as a longitudinal restraint for a duct section connected perpendicular to it if the restraints are installed within 4-feet of the intersection of the ducts and if the restraints are sized for the larger duct. Duct joints shall conform to SMACNA duct construction standards.
- 3. Hanger straps must be positively attached to the duct within 2-inches of the top of the duct with a minimum of two number 10 sheet metal screws.
- 4. A group of ducts may be combined in a larger frame so that the combined weights and dimensions of the ducts are less than or equal to the maximum weight and dimensions of the duct for which bracing details are selected.

VIBRATION AND SEISMIC CONTROLS FOR HVAC - SECTION 23 05 48

- 5. Walls, including gypsum board nonbearing partitions, which have ducts running through them, may replace a typical transverse brace. Provide solid blocking around duct penetrations at stud wall construction.
- 6. Unbraced ducts shall be installed with a 6-inch minimum clearance to vertical ceiling hanger wires.
- E. Suspended Equipment, Piping, and Ductwork Cable Method:
 - 1. The cables shall be adjusted to a degree of slackness approved by the Structural Engineer.
 - 2. The uplift and downward restraint nuts and Mason type RW neoprene covered steel rebound washers for the Type 6 hangers adjusted so there is a maximum 1/4-inch clearance.
 - 3. C-clamps for attachment to the bottom of I-beams must incorporate a restraining strap.

3.5 FIELD QUALITY CONTROL

A. Installation Report: Isolation manufacturer's representative shall confirm that all isolation is installed correctly and submit report stating that isolators are installed as shown on Shop Drawings, isolators are free to work properly, and that installed deflections are as scheduled and as specified.

END OF SECTION

SECTION 23 34 00

HVAC FANS

PART 1 GENERAL

1.1 SUMMARY

- A. This Section includes:
 - 1. Inline Centrifugal Fans
 - 2. related sections
- B. Division 01, General Requirements
- C. Division 23, Heating, Ventilating, and Air Conditioning (HVAC)

1.2 SUBMITTALS

- A. Submit the following:
 - 1. Shop Drawings: Showing dimensions, details of construction.
 - 2. Product Data: Showing performance of fans.
 - 3. Operation and Maintenance Data
 - 4. Submit certified sound power ratings for each fan.

PART 2 PRODUCTS

2.1 MANUFACTURERS

- A. Inline Centrifugal Fans:
 - 1. Greenheck
 - 2. Penn
 - 3. Cook
 - 4. Acme
 - 5. Carnes
 - 6. Twin City
 - 7. Other Manufacturers: Submit substitution request.

B. INLINE CENTRIFUGAL FANS

- General Description: Inline centrifugal, belt driven, cabinet fan, AMCA rated, backward inclined wheel, heavy gauge steel housing adequately braced with edges sealed, externally mounted 1800 rpm motor, hinged access doors.
- 2. Refer to Section 23 05 00, Common Work Results for HVAC for energy efficient motor requirements.
- C.—Smoke Control Fans: Provide UL listing as "Power Ventilators for Smoke Control Systems" where used as a smoke control fan.

D.C. Drive:

- 1. Direct: Beltless, with EC motor as scheduled.
- 1. Multiple belt with fixed sheave and OSHA approved metal guard.

- 2. Size drive for 150 percent of motor horsepower.
- 3. Fans used as part of a life safety system, provide 1-1/2- times the number of belts required, with a minimum of 2.
- E.D. Vibration Isolation: Provide vibration isolation as indicated on drawings and in accordance with Section 23 05 48, Vibration and Seismic Controls for HVAC Piping and Equipment.

PART 3 EXECUTION

- 3.1 INSTALLATION, GENERAL
 - A. Provide flexible connections on inlet and discharge duct connection. Flexible connection for vane axial fans to be barium loaded vinyl.
- 3.2 INLINE CENTRIFUGAL FAN
 - A. Mount in ductwork using Vibration Isolation as specified in Section 23 05 48 Vibration and Seismic Controls for HVAC Piping and Equipment, and as indicated on drawings.
 - B. Connect ductwork using flexible connections.
 - C. Arrange for unobstructed access to access door.

END OF SECTION

SECTION 23 81 00

DECENTRALIZED UNITARY HVAC EQUIPMENT

PART 1 GENERAL

1.1 SUMMARY

- A. This Section includes:
 - Fan Coil Unit
 - Related Sections
- B. Division 01, General Requirements
- C. Division 23, Heating, Ventilating, and Air Conditioning (HVAC)
- D. Section 23 05 48, Vibration and Seismic Controls for HVAC Piping and Equipment
- E. Section 23 82 00, Convection and Heating and Cooling Units
- F. SUBMITTALS
- G. Submit the following:
 - Shop drawings showing details of construction, dimensions, arrangement of components, isolation, filters, etc.
 - 2. Product data showing performance data, standard items, and accessories, operating weight.
 - 3. Flow diagrams and pipe sizing for refrigerant systems.
 - 4. Operating and maintenance data.
 - 5. Testing Submittals:
 - a. Provide test plan and test procedures for approval.
 - b. Explain in detail, step-by-step, actions and expected results to demonstrate compliance with the requirements of this specification and methods for simulating necessary conditions of operation to demonstrate performance of the system.
 - c. Test plan and test procedures demonstrate capability of system to monitor and control equipment and to accomplish control and monitoring specified.

1.2 ACCEPTANCE TESTING AND TRAINING

A. Site Testing:

- 1. General:
 - a. Provide personnel, equipment, instrumentation, and supplies necessary to perform testing by a representative authorized by the manufacturer.
 - b. Owner or Owner's representative will witness and sign off on acceptance testing.
- 2. Acceptance Test:
 - a. Demonstrate compliance of completed control system with contract documents.
 - b. Use approved test plan, physical and functional requirements of project
- B. Training:
 - 1. General:

DECENTRALIZED UNITARY HVAC EQUIPMENT - SECTION 23 81 00

- a. A representative authorized by the manufacturer conduct training courses for designated personnel in operation and maintenance of system.
- b. Orient training to specific system being installed under this contract.
- c. Provide training manuals for each trainee, with two additional copies provided for archival at project site.
- d. Manuals include detailed description of the subject matter for each lesson.
- e. Copies of audiovisuals delivered to Owner.
- f. Training day is defined as 8 hours of classroom instruction, including two 15-minute breaks and excluding lunchtime, Monday through Friday, during normal first shift in effect at training facility.
- g. Notification of planned training given to the Owner's representative at least 15 days prior to the training.
- 2. Operator's Training I:
 - a. Teach at a convenient location for a period of one training day.
 - Upon completion, each student, using appropriate documentation, should be able to perform elementary operations with guidance and describe general hardware architecture and functionality of system.

PART 2 PRODUCTS

2.1 MANUFACTURERS

- A. Fan Coil Unit:
 - 1. Daikin
 - 2. Trane
 - 3. Carrier
 - 4. York
 - 5. Enviro-Tech
 - 5. Other Manufacturers: Submit substitution request.

2.2 HEATING AND VENTILATION UNIT (HV-20, 21)

- A. Description:
 - 1. Furnish complete unit including cabinet, fan, and motor assembly, heating water coil and filter.
 - 2. Unit UL approved for application and wired per NEC.
- B. Cabinet: 18 gauge steel, removable panels for access to components.
- C. Fan and Motor: Centrifugal type, direct drive, brushless DC electronically commutated motor.
- D. Filters: 2" Pleated MERV 11.
- E. Heating Coil: Non-ferrous construction with aluminum fins mechanically bonded to seamless copper tubing with brazed joints.
- F. Configuration: Horizontal unit, ducted inlet, and outlet connection.
- G. Electrical:
 - 1. Furnish magnetic contactors.
 - 2. Arrange for single point electrical connection.

DECENTRALIZED UNITARY HVAC EQUIPMENT - SECTION 23 81 00

- 3. Provide field wiring.
- 4. Provide internal control panel to accept low voltage and power. Adequate space shall be provided for the DDC controller to be field installed in the panel.
- 5. Factory install 24V control circuit transformer.

6.

B. FAN COIL UNIT

C. Description:

- 1. Furnish complete unit including cabinet, fan, and motor assembly, electric heating, cooling coil and filter.
- 2. Unit UL approved for application and wired per NEC.
- D. Cabinet: 18 gauge steel, removable panels for access to components.
- E. Fan and Motor: Centrifugal type, belt driven, permanently lubricated motor.
- F. Filters: Throwaway type, 1-inch thick fiberglass.
- G. Heating Coil: Non-ferrous construction with aluminum fins mechanically bonded to seamless copper tubing with brazed joints.

H. Drain Pan:

- 1. Galvanized steel drain pan with copper drain connection.
- 2. Pan to extend under coil for proper drainage of condensate.
- I. Configuration: Horizontal unit, ducted inlet, and outlet connection.

J. Electrical:

- 1. Furnish magnetic contactors.
- 2. Arrange for single point electrical connection.
- 3. Provide field wiring.

PART 3 EXECUTION

3.1 HEATING AND VENTILATION UNIT

A. Installation:

- 1. Install in location shown on the Drawings. Level unit and secure to structure via two six-inch-high 12-gauge sheet metal sleepers secured to floor.
- 2. Make piping connection and unit installation per manufacturer's recommendations and installation guides.

B. Flexible Connections:

1. Provide flexible duct connections, with accurate alignment between fan and duct.

C. Start-Up:

- 1. General: Comply with manufacturer's instructions.
- 2. Install filters before operating unit.

DECENTRALIZED UNITARY HVAC EQUIPMENT - SECTION 23 81 00

3.1 FAN COIL UNIT

A. Installation:

- 1. Install in location shown on the Drawings. Level unit and secure to structure.
- 2. Make piping connection and unit installation per manufacturer's recommendations and installation guides.
- 3. Pipe condensate pan to floor drain per manufacturer's installation guide. Provide minimum 2-inch trap seal on condensate drain connections.

B. Start-Up:

- 1. General: Comply with manufacturer's instructions.
- 2. Install filters before operating unit.
- 3. Ensure proper refrigerant and airflow before operating unit compressor.

END OF SECTION

SECTION 23 82 00

CONVECTION HEATING AND COOLING UNITS

PART 1 GENERAL

- 1.1 SUMMARY
 - A. This Section includes:
 - 1. Panel Radiator Finned Tube Radiator
- 1.2 RELATED SECTIONS
 - A. Division 01, General Requirements
 - B. Division 23, Heating, Ventilating, and Air Conditioning (HVAC)
- 1.3 SUBMITTALS
 - A. Submit the following:
 - 1. Catalog data showing dimensions and performance.
 - 2. Computer calculations for coil performance.
 - 3.2. Operation and Maintenance Data: radiant panels.

PART 2 PRODUCTS

- 2.1 MANUFACTURERS
 - 1. Finned Tube Radiator:
 - a. Jaga
 - b. Other Manufacturers: Submit substitution request.
 - 1.—Finned tube radiator (ftr-1)Panel Radiators:
 - a. Jaga
 - b. Runtal
 - c. Rittling
 - d. Other Manufacturers: Submit substitution request.
- 2.2 FINNED TUBE RADIATORS (FTR-1)
 - A. Jaga Brizza 22 Model 55 Wall Mount 2-pipe radiator. Length and capacity as indicated on drawings.
 - B. Cabinet:
 - 1. 16-guage electrolytic galvanized steel, coated epoxy baked finish. Architect to select from manufacturer's standard colors.
 - 2. Top grille supply and bottom grille return.
 - C. Provide ¾" pipe connections, locations as indicated on mechanical drawings.

CONVECTION HEATING AND COOLING UNITS - SECTION 23 82 00

2.2 PANEL RADIATORS (PR)

- A. Panel radiator. Length, height and depth as indicated on drawings. Minimum Capacity in Btuh per lineal foot at 135°F average water temperature as scheduled.
- B. Mounts: Wall mounting brackets.
- C. Provide 12" side cover plate to conceal piping connections at side of radiator. Cover shall conceal piping from front view as well as from above. Cover piece shall be adjustable from side to side to provide varying lengths of cover.
- D. Provide 3/" pipe connections. Connection locations as indicated on mechanical drawings.
- E. Finish: Gloss powder coat finish of color to be selected by Architect. Architect to select from manufacturer's standard colors.

PART 3 EXECUTION

3.1 INSTALLATION

- A. Finned Tube Radiator: Mount according to manufacturer's recommendations and architectural details.
- A. Panel Radiators: Mount according to manufacturer's recommendations and architectural details.

END OF SECTION

SECTION 22 40 00

PLUMBING FIXTURES

PART 1 GENERAL

1.1 SUMMARY

- A. This Section includes:
 - 1. Fixture Trim
 - 2. Plumbing Fixtures
 - 3. Drainage Products
 - 4. related sections
- B. Division 01, General Requirements
- C. Division 22, Plumbing

1.2 QUALITY ASSURANCE

- A. Water Closets: Maximum Performance (MaP) score of no less than 800
- B. Faucets: Certify to NSF/ANSI 61 and California AB1953
- C. Electric Water Coolers and Drinking Fountains: Certified to NSF/ANSI 61 and California AB1953
- D. SUBMITTALS
- E. Submit the following:
 - 1. Product data for each item specified.
 - 2. Operating and Maintenance Data:
 - a. Mounting heights for fixtures.

PART 2 PRODUCTS

2.1 MANUFACTURERS

- A. Manufacturers are stated for each fixture specified. The following manufacturers are also acceptable, except when indicated only.
- B. Fixture Trim:
 - 1. Supply Stops:
 - a. Chicago
 - b. NPT McGuire (LK series)
 - c. Brasscraft (SCR series)
 - 2. Traps:
 - a. McGuire
 - b. Kenney
 - c. Brasscraft

- 3. Support Rims:
 - a. Hudee
- 4. Vacuum Breakers:
 - a. Chicago Faucet
 - b. A.W. Cash
 - c. Febco, chrome plated
- C. Fixtures:
 - 1. Bradley
 - 2. American Standard
 - 3. Kohler
 - 4. Sloan
 - 5. Toto
- D. Mixing Valves:
 - 1. Powers
 - 2. Leonard
 - 3. Symmons
 - 4. Chicago
- E. Faucets:
 - 1. Chicago
 - 2. Delta Commercial
 - 3. Kohler
 - 4. Symmons
 - 5. Moen Commercial
- F. Shock Arrestors:
 - 1. PPP
 - 2. J.R. Smith
- G. Trap Primer Stations:
 - 1. PPP
- H. Exposed Waste and Supply Piping Insulation Kits:
 - 1. Truebro
 - 2. McGuire
- I. Other Manufacturers: Submit substitution request.

2.2 FIXTURE TRIM

- A. Supply Stops: Chicago cast brass rigid riser supplies with loose key angle stops, wall flanges, NPT female inlet, chrome plate finish; equivalent NPT McGuire (LK series), Brasscraft (SCR series), or NPT stops by fixture supplier.
- B. Traps:
 - 1. For floor drains, provide coated cast iron P-trap; recessed, screw jointed or bell and spigot.

- For other fixtures, provide 17 gauge, chrome plated cast brass P-Traps with solder bushings, and clean-out.
- C. Support Rims: Hudee stainless steel rims, if sink not furnished with integral rim.
- D. Vacuum Breakers:
 - 1. Chicago Faucet
 - 2. A.W. Cash
 - 3. Febco, chrome plated

2.3 PLUMBING FIXTURES

A. WS-1 Wash Station (ADA):

- Bradley Express Deck EXD-2N, , Model MG series, 2 station, wall hung, equipped with Chicago 802-V665ABCP faucets with polished chrome plated solid brass body construction, 4-inch spout, vandal proof metering push handles, 2.2 gpm pressure compensating aerator, adjustable cycle time closure cartridge, vandal resistant complete.
- 2. Mixing Valve (Point-of-Use):
- 3. Leonard 270 series thermostatic point-of-use mixing valve.
- 4. ASSE 1070 certified.
- 5. Bronze body.
- 6. Locked temperature adjustment cap (vandal resistant).
- 7. Integral check valves on hot and cold inlets.
- 8. Minimum flow 0.5 GPM.
- 9. Maximum flow 3.5 GPM at 5 PSI loss.
- B. Exposed Waste and Supply Piping Insulation Kits: McGuire Prowrap insulation kit for exposed supplies and waste piping below ADA lavatories and ADA sinks.

PART 3 EXECUTION

3.1 FIXTURE TRIM

- A. Provide plumbing fixture trim where applicable on fixtures, including but not limited to supply stops, traps, support rims, flush valve, and vacuum breakers.
- B. Provide rough-in and final piping connection to fixtures. Carefully review all construction documents to assure that all fixtures are provided with necessary services for a complete operating system.
- C. Rigidly secure rough-in piping, carriers and supports, and other service piping to structure.

3.2 PLUMBING FIXTURES

A. Americans with Disabilities Act:

- 1. Those fixtures indicated by ADA complies with and be installed in accordance with Americans with Disabilities Act Guidelines (ADAAG). Where applicable building code requirements are more stringent than ADAAG guidelines, building code requirements followed.
- 2. Lavatories:
 - a. Mounting height of ADA lavatories at a maximum height of 34 inches from floor to rim.
 - b. Provide insulation kits on exposed hot water and waste piping beneath ADA lavatories.

PLUMBING FIXTURES - SECTION 22 40 00

- B. Fixture Mounting Heights: Fixtures standard rough-in catalogued heights unless shown otherwise on the Architectural Drawings.
- C. Water Supplies: When both hot and cold water to a fixture is required, connect the hot on the left and the cold on the right.
- D. Floor Mounted Supports and Chair Carriers:
 - 1. Secure floor mounted supports and chair carriers to slab with a minimum of 1/2-inch bolts.
 - 2. Install supports and carriers per manufacturer's installation instructions.
- E. Mixing Valves: Provide piping connections per manufacturer's installation instructions.

END OF SECTION

SECTION 23 05 48

VIBRATION AND SEISMIC CONTROLS FOR HVAC

PART 1 GENERAL

1.1 RELATED DOCUMENTS

- A. Drawings and general provisions of the Contract, including General and Supplementary Conditions and Division 01, General Requirements Specification Sections, apply to this Section.
- B. The provisions of Division 23, Heating, Ventilation and Air Conditioning (HVAC) Section 23 05 00, Common Work Results for HVAC, apply to work specified in this Section.

1.2 SUMMARY

- A. This Section includes:
 - 1. Neoprene Waffle Pad
 - 2. Restrained Neoprene Mount
 - 3. Spring Isolators
 - 4. Springs with Restraints
 - 5. Base with Springs
 - 6. Inertia Base
 - 7. Isolating Spring Hangers
 - 8. Isolating Neoprene Hangers
 - 9. Rooftop Air Handling Unit Isolation Curb
 - 10. Isolating Sleeves
 - 11. Seismic Restraints
 - 12. Flexible Sphere Connector
 - 13. Flexible Hose Connector
- B. Isolation of mechanical equipment as indicated on the Drawings and specified herein.
- C. Seismic restraint of equipment, piping, and ductwork.

1.3 RELATED SECTIONS:

- A. Division 01, General Requirements
- B. Division 23, Heating, Ventilating, and Air Conditioning (HVAC)
- C. Section 23 05 29, Hangers, Supports and Anchors for HVAC
- D. Section 23 31 01, HVAC Ducts and Casing-Low Pressure
- E. Section 23 31 02, HVAC Ducts and Casing-Medium Pressure

1.4 QUALITY ASSURANCE

- A. Single manufacturer select and furnish isolation required, except packaged equipment with integral isolators meeting all the isolation and seismic requirements of this Specification.
- B. System of vibration isolators and seismic controls designed, detailed, and bear the seal of a professional engineer registered in the State having jurisdiction.
- C. Isolation performance requirements are indicated in the specifications. Deflections indicated are nominal static deflections for specific equipment supported.
- D. Seismic snubbers, restrained isolator housings, and cable system components have anchorage preapproval OPM number from OSHPD in the State of California verifying the maximum certified load ratings.
- E. Isolator Stability and Rated Capacity:
 - 1. Spring diameters not less than 0.8 of the compressed height of the spring at rated load.
 - 2. Springs have a minimum additional travel to solid equal to 50 percent of the rated deflection.

F. Seismic Restraints:

- Restraint of equipment, piping, and ductwork to be in accordance with the current state and local Building Code.
- 2. Calculations in accordance with current state and local Building Code.

1.5 SUBMITTALS

A. Submit the following:

- 1. Submit Shop Drawings showing complete details of construction for steel and concrete bases including:
 - a. Equipment mounting holes.
 - b. Dimensions
 - c. Isolation selected for each support point.
 - d. Details of mounting brackets for isolator.
 - e. Weight distribution for each isolator.
 - f. Code number assigned to each isolator.
- 2. Submit product data and calculation sheets for isolators, showing:
 - a. Size, type, load rating, and rated deflection of each required isolator.
 - b. Percent of vibration transmitted based on the lowest disturbing frequency of the equipment.
- 3. Structural Details and Calculations substantiating that building structure, anchorages, and fabricated steel braces can safely withstand maximum calculated loads stamped and signed by a registered structural engineer.
- 4. Installation report as specified in PART 3 of this Section.
- 5. Operation and maintenance data.

1.6 EQUIPMENT VIBRATION ISOLATION

- A. Provide a balanced set of vibration isolators for each piece of equipment listed in the Equipment Schedules.
- B. Isolation work to include, but not necessarily be limited to, the following:
 - 1. Isolation support of motor-driven equipment.
 - 2. Inertia base frames in conjunction with isolation.

- 3. Isolation support of air-handling housings.
- 4. Isolation support of piping, piping risers, and ductwork.
- 5. Penetration isolation of pipework, ductwork, and conduits through walls, floors, or ceilings.
- 6. Flexible connections of ductwork and piping to equipment.
- C. Each piece of rotating equipment must meet a reasonable criterion for maximum vibration levels at each bearing, while in operation. The criteria for varying operating speeds are given as follows:
 - Rotating equipment operating at peak vibration velocities must not exceed 0.08-inch/second.
 - 2. If it is discovered that the operating vibration velocities exceed this criteria, the equipment repaired or replaced at no expense to the owner until approval of the equipment is given by the Engineer.
- D. Provide components or materials not specially mentioned herein, but necessary to the proper vibration isolation of the equipment.

1.7 CONTRACTOR RESPONSIBILITY

- A. Vibration isolation devices, including auxiliary steel bases and pouring forms, design and furnish by a single manufacturer or supplier.
- B. Adequately restrain all equipment, piping, and ductwork to resist seismic forces. Design and select restraint devices to meet seismic requirements as defined in the latest issue of the International Building Code under Earthquake Loads and applicable state and local codes.
- C. Have the following responsibilities:
 - 1. Selection, installation, adjustment, and performance of vibration isolators which will meet the requirements given on the plans or in the Specifications.
 - 2. Provide Engineering drawings, details, supervision, and instruction to assure proper installation and performance.
 - 3. Provide whatever assistance necessary to ensure correct installation and adjustment of the isolators.

PART 2 PRODUCTS

2.1 MANUFACTURERS

- A. Type 7 Isolating Spring Hangers:
 - 1. Mason 30N, similar Amber-Booth
 - 2. Kinetics Noise Control
 - 3. Vibrex

2.2 TYPE 7 - ISOLATING SPRING HANGERS

- A. Combination rubber-in shear and steel spring isolators installed on the hanger rods.
- B. Isolators shall have the proper deflection to allow the piping to deflect as a unit with the equipment isolators.
- C. Neoprene element and the cup shall have neoprene bushings projecting through the steel box.
- D. Hangers designed for 30 degree angular movement.

2.32.1 SEISMIC RESTRAINTS

A. General Requirements:

- 1. Provided for equipment, piping and ductwork, both supported and suspended.
- 2. Bracing of piping shall be in accordance with state and local code requirements and ASCE 7 Seismic Design Requirements for Nonstructural Components, whichever is most stringent.
- 3. Bracing of ductwork shall be in accordance with the state and local code requirements, ASCE 7 Seismic Design Requirements for Nonstructural Components, and with the provisions set forth in the SMACNA seismic restraint manual.
- 4. The structural requirements for the restraints, including their attachment to the building structure, shall be reviewed and approved by the Structural Engineer.
- 5. Attachments to supported or suspended equipment must be coordinated with the equipment manufacturer.

B. Supported Equipment:

- 1. All-directional Seismic Rubbers: Interlocking steel members restrained by a one-piece molded neoprene bushing of bridge bearing neoprene.
- 2. Replaceable bushing and minimum of 1/4-inch thick. Rated loadings not to exceed 1000 psi.
- 3. An air gap of 1/4-inch shall be incorporated in the snubber design in all directions before contact is made between the rigid and resilient surfaces.
- 4. Snubber End Caps:
 - a. Removable to allow inspection of internal clearances.
 - Rotated neoprene bushings be rotated to ensure no short circuits exist before systems are activated.
- 5. Snubber: Mason Industries, Inc. Type Z-1225

C. Bracing of Pipes:

- 1. Provide seismic bracing of piping as detailed below to meet the building code requirements:
 - a. Exception: Piping suspended by individual hangers need not be braced where the following criteria are met.
 - 1) Distance between the top of the pipe to the bottom of the support structure is 12-inches or less.
 - 2) Seismic braces are not required on high deformability piping when the Ip=1.0 and provisions are made to avoid impact with larger pipe or mechanical components or to protect the pipe in the event of such impact and the nominal pipe size is 3-inch diameter or less.
 - 3) Seismic braces are not required on high deformability piping when the lp=1.5 and provisions are made to avoid impact with larger pipe or mechanical components or to protect the pipe in the event of such impact and the nominal pipe size is 1-inch diameter or less.
- 2. Seismic braces for pipes on trapeze hangers may be used.
- 3. Provide flexibility in joints where pipes pass through building seismic joints or expansion joints, or where pipes connect to equipment.
- 4. Cast iron pipe of all types, glass pipe, and any other pipe joined with a shield and clamp assembly, where the top of the pipe is 12-inches or more from the supporting structure, shall be braced on each side of a change in direction of 90 degrees or more. Riser joints on unsupported sections of piping shall be braced or stabilized between floors.
- 5. Vertical risers shall be laterally supported with a riser clamp at each floor. For buildings greater than six stories high or for piping subject to thermal change all risers shall be engineered individually.

D. Bracing of Ductwork:

- Brace rectangular ducts with cross sectional areas of 6 square feet and larger. Brace flat oval ducts in the same manner as rectangular ducts. Brace round ducts with diameters of 28-inches and larger. Brace flat oval ducts the same as rectangular ducts of the same nominal size.
- 2. Exception: No bracing is required if the duct is suspended by hangers 12-inches or less in length, as measured from the top of the duct to the bottom of the support where the hanger is attached.
- 3. Transverse bracing shall occur at the interval specified in the SMACNA tables or at both ends if the duct run is less than the specified interval. Transverse bracing shall be installed at each duct turn and at each end of a duct run, with a minimum of one brace at each end.
- 4. Longitudinal bracing shall occur at the interval specified in the SMACNA tables with at least one brace per duct run. Transverse bracing for one duct section may also act as longitudinal bracing for a duct section connected perpendicular to it if the bracing is installed within four feet of the intersection of the ducts and if the bracing is sized for the larger duct. Duct joints shall conform to SMACNA duct construction standards.
- 5. Install duct flex connections at equipment connections to accept expected differential displacement and protect the equipment connection from damage.

E. Suspended Equipment and Piping and Ductwork:

- 1. Seismic cable restraints shall consist of galvanized steel aircraft cables sized to resist seismic loads with a minimum safety factor of two and arranged to provide all-directional restraint.
- Cable must be pre-stretched to achieve a certified minimum modulus of elasticity. Cable end
 connections shall be steel assemblies that swivel to final installation angle and utilize two clamping
 bolts to provide proper cable engagement.
- 3. Cable assemblies shall be type SCB at the ceiling and at the clevis bolt, SCBH between the hanger rod and the clevis or SCBV if clamped to a beam, all as manufactured by Mason Industries, Inc.
- 4. Steel angles or strut, sized to prevent buckling, shall be clamped to pipe or equipment rods utilizing a minimum of three ductile iron clamps at each restraint location when required. Welding of a minimum of three ductile iron clamps at each restraint location when required. Welding of support rods is not acceptable. Rod clamp assemblies shall be type SRC or UCC as manufactured by Mason Industries, Inc.
- 5. Pipe clevis cross-bolt braces are required in all restraint locations. They shall be special purpose preformed channels deep enough to be held in place by bolts passing over the cross bolt. Clevis cross brace shall be type CCB as manufactured by Mason Industries, Inc.

PART 3 EXECUTION

3.1 GENERAL

- A. Do not install any equipment or pipe which makes rigid contact with the building.
- B. The installation or use of vibration isolators must not cause any change of position of equipment or piping which would result in stresses in piping connections or misalignment of shafts or bearings. In order to meet this objective, equipment and piping shall be maintained in a rigid position during installation. The load shall not be transferred to the isolator until the installation is complete and under full operational load.
- C. Correct, at no additional cost, all installations which are defective in workmanship or materials.

NFHS

3.2 PREPARATION

- A. Treat all isolators, including springs, hardware, and housing, with a corrosion protective coating of epoxy powder or electro galvanizing.
- B. Coat steel frames exposed to weather with a rustproof metal primer.
- C. Provide hot dipped galvanizing on steel frames as indicated on the plans for corrosion protection in severe conditions.

3.3 INSTALLATION

A. General:

- 1. Install isolation where indicated on the Drawings by type and location and where indicated below.
- 2. The assigned code number shall be marked on the isolators and bases to assure placement in the proper location.
- 3. Anchor isolator seismic housing baseplate to floor.
- 4. Rubber grommets and washers shall be provided to isolate the bolt from the building structure. Under no circumstances shall the isolation efficiency be destroyed when bolting the isolators to the building structure.

B. Type 7 – Isolating Spring Hangers: 1.— Service:

a. Fan Coil Units

3.4 SEISMIC RESTRAINTS

A. General:

- 1. Install and adjust seismic restraints so that the equipment, piping, and ductwork support is not degraded by the restraints.
- 2. Restraints must not short circuit vibration isolation systems or transmit objectionable vibration or noise.

B. Supported Equipment:

- Each vibration isolation frame for supported equipment shall have a minimum of four seismic snubbers mounted as close as possible to the vibration isolators and/or the frame extremities.
- Care must be taken so that the 1/4-inch air gap in the seismic restraint snubber is preserved on all
 sides in order that the vibration isolation potential of the isolator is not compromised. This requires
 that the final snubber adjustment be completed after the vibration isolators are properly installed
 and the installation approved.

C. Bracing of Pipes:

- 1. Branch lines may not be used to brace main lines.
- 2. Transverse bracing shall be at 40-feet maximum, except where a lesser spacing is indicated in the SMACNA Seismic Restraint Manual for bracing of pipes.
- 3. Longitudinal bracing shall be at 80-feet maximum except where a lesser spacing is indicated in the tables. In pipes where thermal expansion is a consideration, an anchor point may be used as the specified longitudinal brace provided that it has a capacity to resist both the seismic load and the additional force induced by expansion and contraction.

- 4. Fuel oil, gas, cast iron pipe of all types, glass pipe and any other pipes joined with four band shield and clamp assembly shall be braced at 1/2 the spacings shown above.
- 5. A rigid piping system shall not be braced to dissimilar parts of the building or to two dissimilar building systems that may respond differently during an earthquake.
- Transverse bracing for one pipe section may also act as longitudinal bracing for a pipe section of the same size connected perpendicular to it if the bracing is installed within 24-inches of the elbow or tee.
- 7. Branch lines may not be used to restrain main lines.
- 8. Where thermal expansion is a consideration, guides and anchors may be used as transverse and longitudinal restraints provided they have a capacity equal to or greater than the restraint loads in addition to the loads induced by expansion or contraction.
- 9. Subject to confirmation by field inspection, seismic bracing is not required on piping when the piping is supported by rod hangers and the hangers in the entire run are 12-inches or less in length from the top of the pipe to the supporting structure, hangers are detailed to avoid bending of the hangers and their attachments and provisions are made for piping to accommodate expected deflections.

D. Bracing of Ductwork:

- 1. Transverse restraints shall occur at 30-foot intervals or at both ends of the duct run if less than the specified interval. Transverse restraints shall be installed at each duct turn and at each end of a duct run
- 2. Longitudinal restraints shall occur at 60-foot intervals with at least one restraint per duct run. Transverse restraints for one duct section may also act as a longitudinal restraint for a duct section connected perpendicular to it if the restraints are installed within 4-feet of the intersection of the ducts and if the restraints are sized for the larger duct. Duct joints shall conform to SMACNA duct construction standards.
- 3. Hanger straps must be positively attached to the duct within 2-inches of the top of the duct with a minimum of two number 10 sheet metal screws.
- 4. A group of ducts may be combined in a larger frame so that the combined weights and dimensions of the ducts are less than or equal to the maximum weight and dimensions of the duct for which bracing details are selected.
- Walls, including gypsum board nonbearing partitions, which have ducts running through them, may replace a typical transverse brace. Provide solid blocking around duct penetrations at stud wall construction.
- 6. Unbraced ducts shall be installed with a 6-inch minimum clearance to vertical ceiling hanger wires.

E. Suspended Equipment, Piping, and Ductwork Cable Method:

- 1. The cables shall be adjusted to a degree of slackness approved by the Structural Engineer.
- 2. The uplift and downward restraint nuts and Mason type RW neoprene covered steel rebound washers for the Type 6 hangers adjusted so there is a maximum 1/4-inch clearance.
- 3. C-clamps for attachment to the bottom of I-beams must incorporate a restraining strap.

3.5 FIELD QUALITY CONTROL

A. Installation Report: Isolation manufacturer's representative shall confirm that all isolation is installed correctly and submit report stating that isolators are installed as shown on Shop Drawings, isolators are free to work properly, and that installed deflections are as scheduled and as specified.

END OF SECTION

SECTION 23 81 00

DECENTRALIZED UNITARY HVAC EQUIPMENT

PART 1 GENERAL

1.1 SUMMARY

- A. This Section includes:
 - Rooftop Mounted Packaged HVAC Unit

1.2 RELATED SECTIONS

- A. Division 01, General Requirements
- B. Division 23, Heating, Ventilating, and Air Conditioning (HVAC)
- C. Section 23 05 48, Vibration and Seismic Controls for HVAC Piping and Equipment

1.3 SUBMITTALS

A. Submit the following:

- Shop drawings showing details of construction, dimensions, arrangement of components, isolation, filters, etc.
- 2. Product data showing performance data, standard items, and accessories, operating weight.
- 3. Flow diagrams and pipe sizing for refrigerant systems.
- 4. Operating and maintenance data.
- 5. Testing Submittals:
 - a. Provide test plan and test procedures for approval.
 - b. Explain in detail, step-by-step, actions and expected results to demonstrate compliance with the requirements of this specification and methods for simulating necessary conditions of operation to demonstrate performance of the system.
 - c. Test plan and test procedures demonstrate capability of system to monitor and control equipment and to accomplish control and monitoring specified.

1.4 ACCEPTANCE TESTING AND TRAINING

A. Site Testing:

- General:
 - a. Provide personnel, equipment, instrumentation, and supplies necessary to perform testing by a representative authorized by the manufacturer.
 - b. Owner or Owner's representative will witness and sign off on acceptance testing.
- 2. Acceptance Test:
 - a. Demonstrate compliance of completed control system with contract documents.
 - b. Use approved test plan, physical and functional requirements of project

B. Training:

General:

- a. A representative authorized by the manufacturer conduct training courses for designated personnel in operation and maintenance of system.
- b. Orient training to specific system being installed under this contract.
- c. Provide training manuals for each trainee, with two additional copies provided for archival at project site.
- d. Manuals include detailed description of the subject matter for each lesson.
- e. Copies of audiovisuals delivered to Owner.
- f. Training day is defined as 8 hours of classroom instruction, including two 15-minute breaks and excluding lunchtime, Monday through Friday, during normal first shift in effect at training facility.
- g. Notification of planned training given to the Owner's representative at least 15 days prior to the training.

2. Operator's Training I:

- a. Teach at a convenient location for a period of one training day.
- Upon completion, each student, using appropriate documentation, should be able to perform elementary operations with guidance and describe general hardware architecture and functionality of system.

PART 2 PRODUCTS

2.1 MANUFACTURERS

- A. Rooftop Mounted Packaged HVAC Unit:
 - 1. Trane
 - 2. Daikin
 - 3. Carrier
 - 4. York
 - AAON
 - 6. Other Manufacturers: Submit substitution request.

2.2 ROOFTOP MOUNTED PACKAGED HVAC UNIT (RTU-305, 600, 600A)

- A. Description (RTU-305): Roof-mounted, single zone packaged heat pump designed for full curb mounting, electric auxiliary heat, capacities as indicated, factory assembled, wired, piped, tested and shipped in one piece with UL listing.
- B. Description (RTU-600, 600A): Roof-mounted, single zone packaged air conditioning unit, natural gas heat, capacities as indicated, factory assembled, wired, piped, tested and shipped in one piece with UL listing.

C. Unit Casing:

- 1. Heavy gauge galvanized steel, phosphatized and coated with baked enamel finish, gasketed and insulated with 1-inch 1 pound density glass fiber insulation.
- D. Air Conditioning Refrigeration:
 - 1. Air-cooled with refrigerant line filter drier, thermostatic expansion valve, factory refrigerant charge, high and low pressure cutouts, and loss of charge protection.
 - 2. Low ambient operation to 40 degrees F.
 - 3. Provide refrigerant sight glass.

E. Heat Pump Refrigeration (RTU-305):

- 1. Air-cooled with heating and cooling refrigerant line filter driers, dual thermostatic expansion valves, factory refrigerant charge, high and low pressure cutouts, loss of charge protection.
- 2. Suction line accumulator, refrigerant check valves, heavy duty, high capacity, four-way reversing valve.
- 3. Low ambient operation to 20 degrees F.
- 4. Activate defrost cycle upon demand only.

F. Compressors:

- 1. Hermetic type compressor with positive constant pressure lubrication, current and thermal overloads, crankcase heater, time delay, and anti-recycle relays.
- 2. Provide compressor isolation valves.

G. Cooling Coils:

- Provide indoor and outdoor coils of non-ferrous construction with aluminum fins mechanically bonded to seamless copper tubing with joints brazed.
- 2. Protect coils with plywood covers during shipment and installation.
- 3. Evaporator Coil Drain Pan: Stainless steel internally sealed and insulated.

H. Natural Gas Heating (RTU-600, 600A):

- 1. AGA approved for intended application and fuel, completely assembled, wired, piped, and tested with threaded gas connections.
- 2. Provide stainless steel heat exchanger and burners, forced draft combustion blower, and electronic ignition.
- 3. Provide 2 stages of heating.
- I. Electric Heating (RTU-305): Factory installed, with capacity and stages as indicated on the drawings, heavy duty nickel chromium elements, internally delta connected on three phase units, automatically resetting high limit controls on each heating unit contactor, individual fusing, conforming to NEC requirements.

J. Fans:

- 1. Indoor Fan: Centrifugal type, permanently lubricated, belt driven by a permanently lubricated motor.
- 2. Outdoor Fan: Propeller type direct driven by a permanently lubricated motor.

K. Filters:

- 1. Provide medium efficiency pleated filters.
- 2. Provide one extra set of filters for each unit.

L. Dampers:

- 1. Provide motor-operated outside air and return air dampers with spring-return actuators, capable of supplying 0 percent-100 percent outside air.
- 2. Outside air damper minimum position adjustable independently of return damper position.

M. Economizer:

- 1. Dry bulb controlled type.
- 2. Outside air and return air dampers modulate to maintain discharge temperature on call for cooling.
- 3. Provide adjustable minimum outside air damper position.
- 4. Outside air and relief air dampers, close when indoor fan shuts down.
- 5. Provide relief capability equal to 100 percent of supply air with barometric relief damper and weather hood.

- N. Powered Exhaust: Provide relief air capability equal to 100 percent of supply air with exhaust fan, counterbalanced backdraft damper, and weather hood.
- Q.N. Controls: Configure unit for field installation of DDC control panel and sensors as follows:
 - 1. Provide valves and dampers, actuators, variable frequency drives, starters, compressor capacity controllers, condenser capacity controllers, gas furnace controllers, electric heat staging controllers, and other operating and safety controls for each component. Wire to terminal strip for connection to DDC control panel.
 - 2. Temperature and pressure sensors will be owner furnished, owner installed.

P.O. Electrical:

- 1. Furnish magnetic contactors (starters), separate fusing for compressors, condenser fans, evaporator fans and exhaust fans, and control transformer.
- 2. Arrange unit for single point electrical connection with integral unit mounted disconnect.

Q.P. Service Outlet:

- Provide 115 VAC circuit with ground fault interrupter electrical outlet mounted in the unit controls cabinet.
- Outlet circuit rated at 15A and factory wired to a step down transformer, fuse block, and 115V disconnect.
- 3. Wire circuit to line side of power block or power switch permitting use of the outlet while power to the unit is shut off.

R.Q. Roof Curb:

- 1. Formed, 16 gauge galvanized steel with wood nailer strip capable of supporting entire unit weight.
- 2. Account for roof slope to provide level mounting service for equipment.
- Provide spring isolated roof curbs where indicated or if fans and compressors are not internally isolated.
- 4. Curb height accounts for roof insulation depth and flashing requirements.
- S.R. Warranty: One-year on parts.

PART 3 EXECUTION

3.1 ROOFTOP MOUNTED AIR CONDITIONING UNIT AND HEAT PUMP

A. Installation:

- 1. Coordinate roof penetration with others.
- 2. Install curb.
- 3. Furnish 2-inch thick, 2 pcf density insulation along inside of curb. Installation per Section 23 07 00, Insulation for HVAC.
- 4. Install unit where shown, with air filters in place before operating unit. Comply with manufacturer's recommendation.
- 5. Provide minimum of 3-inch trap seal on condensate drain connections.
- 6. Keep access door to roof mounted equipment closed to prevent wind and weather damage.

B. Start-Up:

- 1. General: Comply with manufacturer's instructions.
- 2. Start-up of units provided under the direct supervision of the manufacturer's representative with factory-trained personnel.

- C. Testing and Adjusting/Performance Test:
 - 1. Except where initial unit operation clearly shows the performance meets or exceeds the requirements, test to show compliance.
 - 2. Perform tests by the manufacturer's representative in the presence of the Engineer.

END OF SECTION

EUGENE SCHOOL DISTRICT 4J

KELLY MIDDLE SCHOOL IMPROVEMENTS & NORTH EUGENE HIGH SCHOOL IMPROVEMENTS

PROJECT INFORMATION

SITE ADDRESS KELLY MIDDLE SCHOOL 850 HOWARD AVE EUGENE, OR 97404

NORTH EUGENE HIGH SCHOOL 200 SILVER LANE EUGENE, OR 97404

MAP + TAXLOT KELLY MIDDLE SCHOOL MAP: 17041434 TAX LOT: 00100

NORTH EUGENE HIGH SCHOOL MAP: 17041434 TAX LOT: 00100

OWNER
EUGENE SCHOOL DISTRICT 4J
200 N MONROE ST
EUGENE, OR 97402
UNITED STATES

GMA ARCHITECTS
860 WEST PARK ST, SUITE #300
EUGENE, OREGON 97401
(541) 344-9157
POC: BOB NICHOLLS
BNICHOLLS@ GMA-ARCH.COM
ARCHITECT OF RECORD:
JOSEPH E. MOORE, AIA
JMOORE@GMA-ARCH.COM

800 WILLAMETTE ST. SUITE 400 EUGENE, OREGON 97401 POC: ANNA BACKUS (541) 684-4902 ENGINEER OF RECORD: MATTHEW KEENAN

KPFF CONSULTING ENGINEERS


PAE ENGINEERS

44 WEST BROADWAY, SUITE 430
EUGENE, OREGON 97401
POC: SYDNEY MILLS
(541) 735-6222

STRUCTURAL ENGINEER
MORTIER ANG ENGINEERS
1355 OAK STREET, SUITE 200
EUGENE, OREGON 97401
POC: JOK ANG
(541) 484-9080

```
PROJECT SHEET INDEX
         COVER SHEET
KELLY MIDDLE SCHOOL SHEET INDEX
                                                         NORTH EUGENE HIGH SCHOOL SHEET INDEX
 GENERAL INFORMATION
                                                            GENERAL INFORMATION
         GENERAL INFORMATION
                                                            G100 GENERAL INFORMATION
                                                                    CIVIL NOTES AND ABBREVIATIONS
          CIVIL NOTES AND ABBREVIATIONS
          CIVIL MATERIAL SPECIFICATIONS
                                                                    SITE DEMOLITION PLAN
          EXISTING CONDITIONS
                                                           C2.0
                                                                    SITE & GRADING PLAN
C1.2
C2.0
          CIVIL SITE PLANS
                                                           C2.1
                                                                    SITE & GRADING PLAN DETAIL
C2.1
          CIVIL SITE PLANS
                                                                    CIVIL DETAILS
63,0
                                                           C3.1
          CIVIL DETAILS
                                                                    CIVIL DETAILS
C3.1
          CIVIL DETAILS
                                                           ARCHITECTURAL
 ARCHITECTURAL
                                                           A100
                                                                     ARCHITECTURAL SITE PLAN
          ARCHITECTURAL SITE PLAN
                                                           A110
                                                                    OVERALL DEMOLITION
          DEMOLITION
                                                                    PARTIAL DEMOLITION
                                                           A111
          PARTIAL DEMOLITION
                                                                    PARTIAL DEMOLITION
A210
          OVERALL FLOOR PLAN
                                                                    ENLARGED SITE PLAN
A211
          PARTIAL FLOOR PLAN
                                                           A210
                                                                    FLOOR PLAN
          PARTIAL FLOOR PLAN
A212
                                                           A211
                                                                    PARTIAL FLOOR PLAN
A213
          PARTIAL FLOOR PLAN
                                                           A212
                                                                    ENLARGED FLOOR PLAN
A214
          PARTIAL FLOOR PLAN
                                                           A213
                                                                    PARTIAL FLOOR PLAN
A220
          REFLECTED CEILING PLAN
                                                           A220
                                                                    PARTIAL REFLECTED CEILING PLAN
          PARTIAL REFLECTED CEILING PLAN
                                                                    INTERIOR ELEVATIONS & SECTIONS
                                                           A310
A310
          INTERIOR ELEVATIONS
                                                           A700
                                                                    DOOR & FINISH SCHEDULE
A700
          DOOR SCHEDULE
A800
          DETAILS
                                                                     SYMBOLS, LEGENDS, AND ABBREVIATIONS - MECHANICAL
                                                                    EQUIPMENT SCHEDULE - MECHANICAL
          SYMBOLS, LEGENDS AND ABBREVIATIONS - PLUMBING
                                                           MD.0
                                                                    OVERALL DEMOLITION PLAN - MECHANICAL
          OVERALL DEMOLITION PLAN - PLUMBING
                                                           MD.1
                                                                    PARTIAL DEMOLITION - MECHANICAL
         PARTIAL DEMOLITION - PLUMBING
                                                                    PARTIAL DEMOLITION - MECHANICAL
                                                           MD.2
          OVERALL FLOOR PLAN - PLUMBING
                                                                    OVERALL FLOOR PLAN - HVAC
          ENLARGED PARTIAL FLOOR PLAN - PLUMBING
                                                                    ENLARGED PARTIAL FLOOR PLAN - MECHANICAL
                                                           M12 ENLARGED PARTIAL FLOOR PLAN MECHANICAL
                                                                   ENLARGED PARTIAL FLOOR PLAN - MECHANICAL
 MECHANICAL
                                                           M5:01 DETAILS - MECHANICAL
          SYMBOLS, LEGENDS, AND ABBREVIATIONS - MECHANICAL
          EQUIPMENT SCHEDULE - MECHANICAL
          OVERALL DEMOLITION PLAN - MECHANICAL
MD.1
         PARTIAL DEMOLITION - MECHANICAL
                                                                     SYMBOLS, LEGENDS, AND ABBREVIATIONS - ELECTRICAL
         PARTIAL DEMOLITION - MECHANICAL
                                                           E0.02
                                                                    LUMINAIRE AND MECHANICAL EQUIPMENT SCHEDULE
          PARTIAL DEMOLITION - MECHANICAL
                                                           ED.0
                                                                    OVERALL DEMOLITION PLAN
          OVERALL FLOOR PLAN - HVAC
                                                           ED.1
                                                                    PARTIAL DEMOLITION PLANS
          ENLARGED PARTIAL FLOOR PLAN - MECHANICAL
                                                           ED.2
                                                                    PARTIAL DEMOLITION PLANS
         ENLARGED PARTIAL FLOOR PLAN - MECHANICAL
                                                           E1.0
                                                                    OVERALL ELECTRICAL PLAN
         ENLARGED PARTIAL FLOOR PLAN - MECHANICAL
                                                           E1.1
                                                                    ENLARGED PARTIAL ELECTRICAL FLOOR PLAN
          ENLARGED PARTIAL FLOOR PLAN - MECHANICAL
                                                           E1.2
                                                                    ENLARGED PARTIAL ELECTRICAL FLOOR PLAN
         SECTIONS - MECHANICAL
                                                           E2.0
                                                                    OVERALL LIGHTING PLAN
         DETAILS - MECHANICAL
M5.01
                                                           E2.1
                                                                    ENLARGED PARTIAL LIGHTING REFLECTED CEILING PLAN
                                                           EZ,01 DIAGRAMS ELECTRICAL
ELECTRICAL
                                                                   PANEL SCHEDULES
         SYMBOLS, LEGENDS, AND ABBREVIATIONS - ELECTRICAL
                                                           LUMINAIRE AND MECHANICAL EQUIPMENT SCHEDULE
ED.0
         OVERALL DEMOLITION PLAN - ELECTRICAL
ED.1 PARTIAL DEMOLITION PLANS - ELECTRICAL
ED.2 PARTIAL DEMOLITION PLANS - ELECTRICAL 1
         ENLARGED PARTIAL ELECTRICAL FLOOR PLAN - A
         ENLARGED PARTIAL ELECTRICAL FLOOR PLAN - B
         ENLARGED PARTIAL ELECTRICAL FLOOR PLAN - C
E1.4 ENLARGED PARTIAL ELECTRICAL ELOOR PLAN - D
         ENLARGED PARTIAL ELECTRICAL FLOOR PLAN - F
         ^ ENCARGED PARTIAL LIGHTING REFLECTED CEILING PLAN - A
          ENLARGED PARTIAL LIGHTING REFLECTED CEILING PLAN - B
          ENLARGED PARTIAL LIGHTING REFLECTED CEILING PLAN - C
          ENLARGED PARTIAL LIGHTING REFLECTED CEILING PLAN - D
          ENLARGED PARTIAL LIGHTING REFLECTED CEILING PLAN - F
E7.01
          DIAGRAMS - ELECTRICAL
E8.01
          PANEL SCHEDULES
```



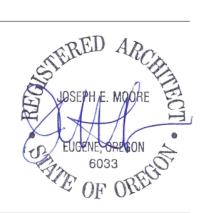

REVISIONS

3/17/2020 ADD. 1

EUGENE SCHOOL DISTRICT 4J
YUJIN GAKUEN RELOCATION TO KELLY MIDE
CORRIDOR ELEMENTARY RELOCATION TO N

Ŏ

#


COV

ONSTRU

19188 & 19189

3/3/2020

EUGENE SCHOOL DISTRICT 4J KELLY MIDDLE SCHOOL IMPROVEMENTS

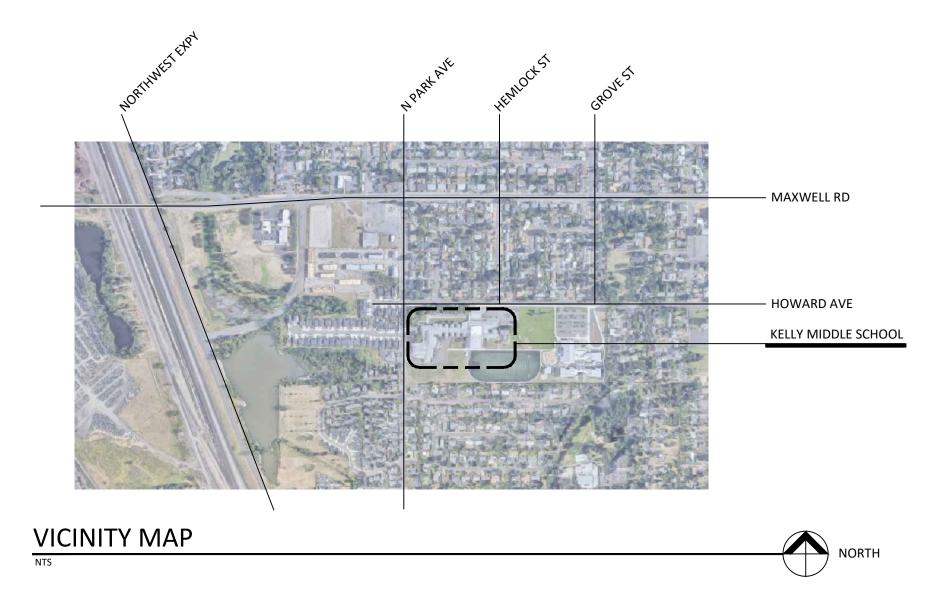



GENERAL NOTES

SUMMARY OF WORK

- PROTECT (E) ITEMS TO REMAIN & SALVAGED ITEMS DURING CONSTRUCTION
- DEMOLISH FINISHED AS REQUIRED BY (N) WORK 3. DEMOLISH WALL MOUNT ITEMS, FIXTURES, PIPING, CONDUIT, & CABLING AT WALLS
- SCHEDULED FOR DEMOLITION, UON 4. DIMENSIONS TO FACE OF FINISH UON - FIELD VFY, (E) ITEMS SHOWN IN APPROX.
- LOCATION 5. PREP & PATCH (E) SURFACES TO REMAIN AS REQUIRED TO MATCH (N) PROJECT STANDARDS WHERE DEMOLITION OCCURS & AS REQ'D FOR (N) WORK
- 6. CLEAN CONSTRUCTION CAVITIES PRIOR TO ENCLOSING W/ (N) MATERIALS, INCLUDING
- ABOVE CEILING & W/IN STUD CAVITIES 7. CLEAN WORK AREA AS REQUIRED FOR (N) WORK PER INDUSTRY STDS
- 8. PATCH SURFACES AS REQ'D FOR (N) FINISHES WHERE ELECTRICAL ITEMS DEMOLISHED 9. FURNISHINGS & EQUIPMENT BY OWNER, TYP UON
- 10. CASEWORK NOTED AS (R) TO BE DELIVERED BY 4J TO SITE PRIOR TO CONSTRUCTION, VERIFY (N) LOCATION W/ ARCHITECT PRIOR TO INSTALLATION 11. REFER TO MECH, ELECT, PLUMB'G FOR COMPREHENSIVE SYMBOL LEGEND & ADD'L
- SCOPE OF WORK 12. ITEMS EXISTING UNLESS OTHERWISE NOTED

DEMOLITION LEGEND

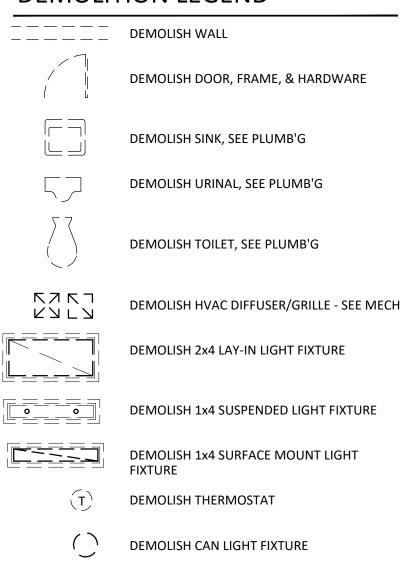

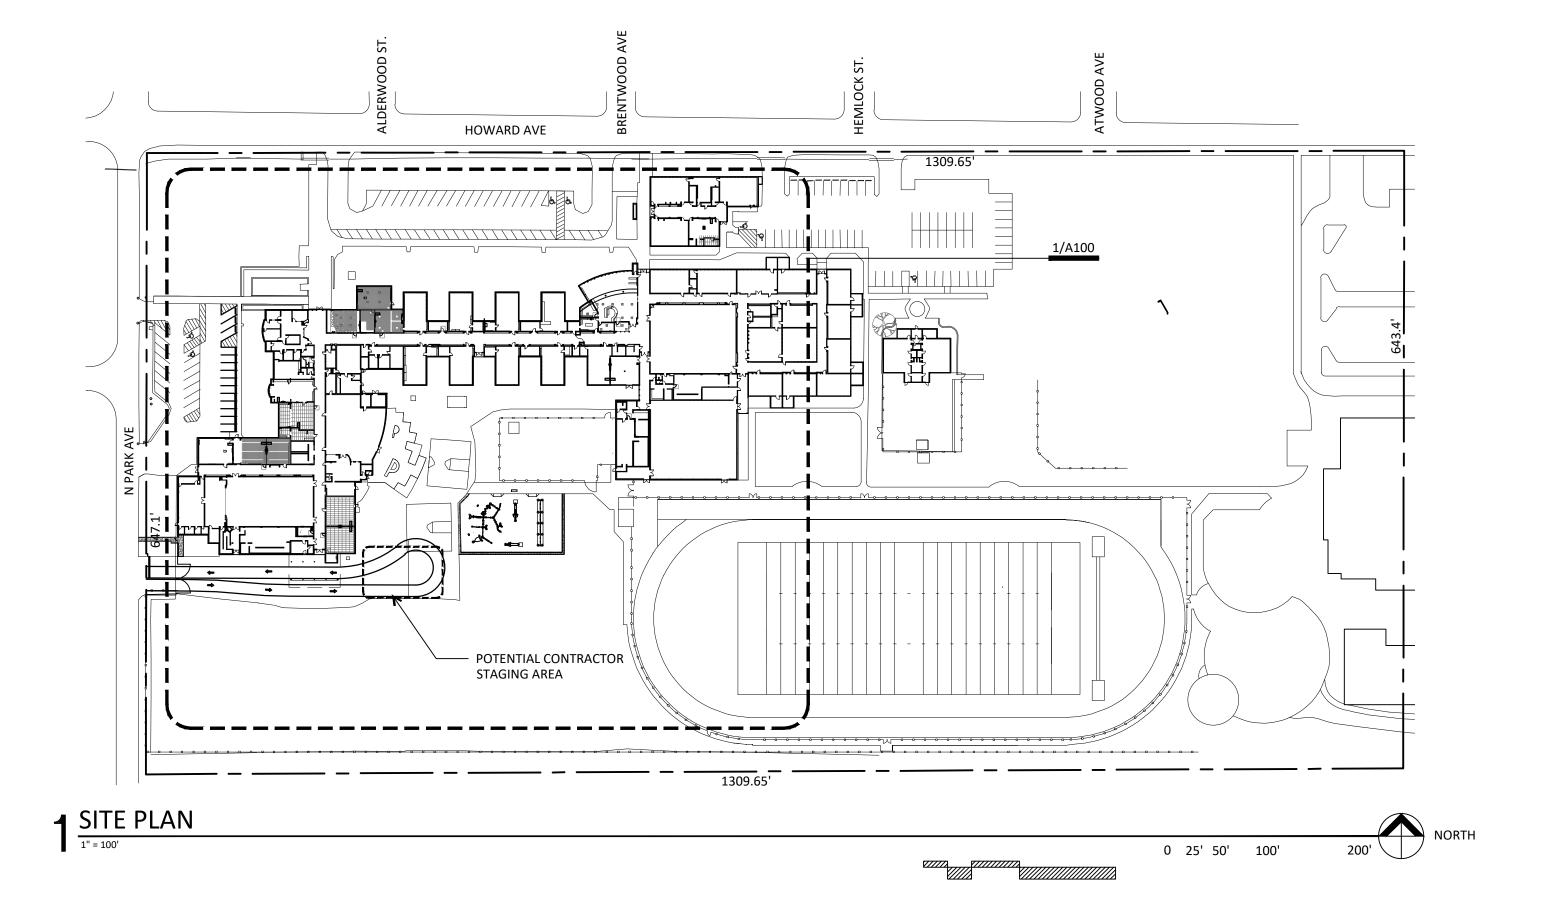

LEGEND

(E) WALL TO REMAIN

(N) PARTIAL HEIGHT WALL, SEE ELEVATIONS & SECTIONS FOR ADDITIONAL INFORMATION

(E) URINAL, UON, SEE PLUMB'G

(E) SINK, UON, SEE PLUMB'G

(E) TOILET, UON, SEE PLUMB'G

(E) DOOR TO REMAIN

(N) DOOR W/ LEVER HARDWARE TO MATCH BUILDING STANDARDS, INDICATED BY NUMBER

OCCUPANCY SENSOR

(N) GYPSUM BOARD CEILING ASSEMBLY

12" x 12" GLUE ON CEILING TILE FINISH

2'x4' SUSPENDED ACOUSTIC CEILING ASSEMBLY

SUSPENDED LIGHT FIXTURE, UON, SEE ALSO ELECTRICAL

1x4 SURFACE MOUNT LIGHT FIXTURE, UON, SEE ALSO ELECTRICAL 2x4 LAY IN LIGHT FIXTURE, SEE ALSO

SURFACE MOUNT VANITY LIGHT FIXTURE, UON, SEE ALSO ELECTRICAL

NOTE: FIXTURE CALCULATIONS DO NOT INCLUDED SINGLE USER RESTROOMS. TOTAL SINGLE USER RESTROOMS PROVIDED = 8

EXHAUST FAN, SEE MECHANICAL

HVAC DIFFUSER/GRILLE SEE ALSO MECHANICAL

NEW EXISTING

RELOCATE

UON UNLESS OTHERWISE NOTED

SUMMARY OF WORK & CODE ANALYSIS

SUMMARY OF WORK RELOCATE YUJIN GAKUEN ELEMENTARY SCHOOL PROGRAM TO KELLY MIDDLE SCHOOL. RECONFIGURE CLASSROOMS AND SUPPORT SPACES TO ACCOMMODATE PROGRAM AND OPERATIONAL CHANGES. WORK INCLUDES SELECTIVE DEMOLITION, EARTHWORK, PAVING, CONCRETE & CONCRETE REINFORCING, METALWORK, ROUGH CARPENTRY, FINISH CARPENTRY, CASEWORK, FLASHING, ROOF PATCHING, INSULATION, OPENINGS, FINISHES, SIGNAGE, PLUMBING, MECHANICAL, ELECTRICAL, AND PAVEMENT MARKINGS. NO CHANGE OF USE NO BUILDING ADDITION NO NEW IMPERVIOUS SURFACE FIRE ALARM SYSTEM FIRE SPRINKLER SYSTEM STRUCTURAL ENGINEERING SCHOOL CAPACITY CURRENT KELLY MIDDLE SCHOOL CAPACITY: 840 STUDENTS POST-ALTERATION: KELLY MIDDLE SCHOOL CAPACITY = 600 STUDENTS

TOTAL PROPOSED STUDENT CAPACITY = 924. INCREASE OF 84 STUDENTS TO SCHOOL CAPACITY

CHAPTER 3 - PROVISIONS FOR ALL COMPLIANCE METHODS

YUJIN GAKUEN CAPACITY = 324 STUDENTS

2018 INTERNATIONAL EXISTING BUILDING CODE

301.3.1 PRESCRIPTIVE COMPLIANCE METHOD: CHAPTER 5 OF THIS CODE **305.6 ALTERATIONS**

A FACILITY THAT IS ALTERED SHALL COMPLY WITH THE APPLICABLE PROVISIONS IN OSSC CH 11, UNLESS TECHNICALLY

EXCEPTIONS: THE ALTERED ELEMENT OR SPACE IS NOT REQUIRED TO BE ON AN ACCESSIBLE ROUTE, UNLESS IT IS A ACCESSIBLE MEANS OF EGRESS REQ'D BY OSSC CH 10 ARE NOT REQUIRED TO BE PROVIDED IN EXISTING FACILITIES.

ALTERATION OF EXISTING TOILET AND BATHING ROOMS TO BE ACCESSIBLE IN ACCORDANCE WITH OSSC CH 11. AND ANSI

CHAPTER 5 PRESCRIPTIVE COMPLIANCE METHOD 503.1, ALTERATION TO ANY BUILDING OR STRUCTURE SHALL COMPLY WITH THE REQUIREMENTS OF THE OSSC FOR NEW CONSTRUCTION. ALTERATIONS SHALL BE SUCH THAT THE EXISTING BUILDING OR STRUCTURE IS NOT LESS COMPLYING WITH THE PROVISIONS OF THE OSSC THAN THE EXISTING BUILDING OR STRUCTURE WAS PRIOR TO THE ALTERATIONS

2019 OREGON STRUCTURAL SPECIALTY CODE FOR NEW CONSTRUCTION WITHIN ALTERATION

CHAPTER 1 - SCOPE AND ADMINISTRATION

PER 102.6 EXISTING STRUCTURES, 102.6.1 COMPLIANCE, THE REPAIR, ALTERATION, CHANGE OF OCCUPANCY, AND ADDITION TO EXISTING BUILDINGS SHALL COMPLY WITH THE INTERNATIONAL EXISTING BUILDING CODE AS AMENDED BY CHAPTER 34 OF THIS

PER 3401.4, REFERENCES TO THE INTERNATIONAL BUILDING CODE OR THE BUILDING CODE SHALL MEAN THE OREGON STRUCTURAL SPECIALTY CODE AS ADOPTED BY OAR 918-460-0010

CHAPTER 3 - USE & OCCUPANCY

EXISTING OCCUPANCY: GROUP E, EDUCATION USE. NO PROPOSED CHANGE TO USE/OCCUPANCY

CHAPTER 5 - GENERAL BUILDING HEIGHTS & AREAS TYPE VB CONSTRUCTION, FIRE SPRINKLED NO CHANGE TO EXISTING BUILDING HEIGHT NO CHANGE TO EXISTING BUILDING NUMBER OF STORIES NO CHANGE TO EXISTING BUILDING AREA

CHAPTER 6 - TYPES OF CONSTRUCTION PER 602 - VB CONSTRUCTION, FIRE SPRINKLED

CHAPTER 8 - INTERIOR FINISHES CLASS C FINISHES ALLOWED PER TABLE 803.13

CHAPTER 9 - FIRE PROTECTION SYSTEMS EXISTING FIRE SPRINKLERS THROUGHOUT, FIRE ALARM THROUGHOUT, TYPE 2A10BC FIRE EXTINGUISHERS AT 75' INTERVALS MAX, SEE FLOOR PLAN FOR LOCATIONS

CHAPTER 10 - MEANS OF EGRESS

NO CHANGE TO BUILDING OCCUPANT LOAD PER 1006.2.1, MAX COMMON PATH OF EGRESS TRAVEL 75 MAX @ (N) ALTERATIONS NUMBER OF EXITS PROVIDED PER TABLE 1006.3.3(2) PER OCCUPANCY OF SPACE

EMERGENCY EGRESS LIGHTING PROVIDED @ (N) ALTERATIONS EGRESS LIGHTING AND EXIT SIGNS WITH EMERGENCY BATTERY BACKUP PROVIDED @ (N) ALTERATIONS

PER 1016.2, EXIT ACCESS DOES NOT PASS THROUGH ADJOINING OR INTERVENING ROOMS

PER 1017.2, MAX EXIT ACCESS TRAVEL DISTANCE 250' NO CHANGE TO MAX EXIT ACCESS TRAVEL DISTANCE IN (N) ALTERATIONS, EXCEPT CLASSROOM 5. CLASSROOM 5 (N) MAX EXIT ACCESS TRAVEL DISTANCE = ±110'-0"

PER TABLE 1020.1, 0 HOUR FIRE RATED CORRIDOR WALL REQUIRED AT E AND A OCCUPANCIES

CHAPTER 11 - ACCESSIBILITY

SEE PLANS FOR ACCESSIBILITY COMPLIANCE @ (N) ALTERATION SCOPE

CHAPTER 29 - PLUMBING SYSTEMS SEE TABLE BELOW FOR NUMBER/PLUMBING FIXTURES REQ'D AND PROVIDED POST ALTERATION _____

CHAPTER 34 - ACCESSIBILITY FOR EXISTING STRUCTURES PER 3411.6, ALTERATIONS SHALL COMPLY W/ CURRENT OSSC & ANSI PROVISIONS FOR ACCESSIBILITY. IN ADDITION, UP TO 25% OF THE COST OF CONSTRUCTION HAS BEEN IDENTIFIED TO REMOVE ARCHITECTURAL BARRIERS AS FOLLOWS, UNLESS OTHERWISE

NOTED AS EXISTING: a. ACCESSIBLE PARKING - EXISTING

b. ACCESSIBLE ENTRANCE - EXISTING ACCESSIBLE ROUTE TO ALTERED AREA - PROVIDED

d. ACCESSIBLE RESTROOMS - EXISTING/ PROVIDED e. ACCESSIBLE TELEPHONES - NOT REQUIRED PER USE ACCESSIBLE DRINKING FOUNTAINS - EXISTING g. ACCESSIBLE STORAGE - EXISTING

CITY OF EUGENE LAND USE CODE & ZONING REQUIREMENTS ZONE:PL PUBLIC LAND

OVERLAY/ SPECIAL AREA ZONE: NONE

NO PROPOSED CHANGE TO BICYCLE PARKING

VEHICLE PARKING PER TABLE 9.6410 324 ELEMENTARY STUDENTS/8 = 41 SPACES REQ'D

600 MIDDLE SCHOOL STUDENTS/9 = 67 SPACES REQ'D 108 TOTAL SPACES REQ'D * LESS 25% REDUCTION = 81 TOTAL SPACES REQ'D

98 SPACES PROVIDED, SEE SITE PLAN

PER OSSC 1106.1, 4 ACCESSIBLE SPACES INCLUDING 1 VAN ACCESSIBLE SPACE REQ'D 7 ACCESSIBLE SPACES PROVIDED PER TRAFFIC ENGINEER MEMO, PEAK HOUR TRAFFIC INCREASE OF 78 TRIPS. THRESHOLD OF 100 INCREASED TRIPS TO REQUIRE T.I.A. NOT

PLUMBING FIXTURE REQUIREMENTS KELLY MIDDLE SCHOOL														
		WATER CLOSETS					LAVATORIES					DRINKING		
DESCRIPTION OCCUPANT LOAD		MALE			FEMALE		MALE		FEMALE			FOUNTAINS		
•		OCC LOAD	OCC FACTOR	FIXT REQ	OCC LOAD	OCC FACTOR	FIXT REQ	OCC LOAD	OCC FACTOR	FIXT REQ	OCC LOAD	OCC FACTOR	FIXT REQ	TOONTAINS
ASSEMBLY A-3, GYM, CAFETERIA, LIBRARY	946	473	1 PER 125	3.78	473	1 PER 65	7.27	473	1 PER 250 FOR THE FIRST 750 AND 1 PER 500 FOR THE REMAINDER EXCEEDING 750	1.89	473	1 PER 250 FOR THE FIRST 750 AND 1 PER 500 FOR THE REMAINDER EXCEEDING 750	1.89	
STAFF USE: ADMIN, WORKROOMS, KITCHEN	105	53	1 PER 50	1.06	53	1 PER 50	1.06	53	1 PER 50	1.06	53	1 PER 50	1.06	1 EACH FLOOR EXISTING
EDUCATIONAL USE	924 (SCHOOL CAPACITY)	462	1 PER 50	9.24	462	1 PER 50	9.24	462	1 PER 50	9.24	462	1 PER 50	9.24	
TOTAL REQUIRED				15			18			13			13	
·	UP TO 2/3 OF W	/C CAN BE S	UBSTITUDED											
ACTUAL PROVIDED FOR URINIALS; 11 URINALS PROVIDED = 7				20			22			15			17	

MET. THEREFORE NO T.I.A. REQ'D.

GMA ARCHITECTS 860 West Park Street / Ste 300 Eugene / Oregon / 97401 p 541.344.9157 gma-arch.com



REVISIONS 3/17/2020 ADD. 1

OVEME

 \circ ∞ \bigcirc

ISSUE DATE: 3/3/2020

19189

GENERAL **INFORMATION**

JOB NO:

GENERAL NOTES

- 2. CONSTRUCTION LAYOUT (ALL ACTUAL LINES AND GRADES) SHALL BE STAKED BY A PROFESSIONAL SURVEYOR, REGISTERED IN THE STATE OF OREGON, BASED ON COORDINATES, DIMENSIONS, BEARINGS, AND ELEVATIONS, AS SHOWN, ON THE PLANS
- PROJECT CONTROL SHALL BE FIELD VERIFIED AND CHECKED FOR RELATIVE HORIZONTAL POSITION PRIOR TO BEGINNING CONSTRUCTION LAYOUT. SEE SHEET C1.1 FOR PROJECT CONTROL INFORMATION.
- 4. PROJECT CONTROL SHALL BE FIELD VERIFIED AND CHECKED FOR RELATIVE VERTICAL POSITION BASED ON THE BENCHMARK STATED HEREON, PRIOR TO BEGINNING CONSTRUCTION LAYOUT.
- 5. WHEN DIMENSIONS AND COORDINATE LOCATIONS ARE REPRESENTED DIMENSION\$ SHALL HOLD OVER COORDINATE LOCATION. NOTIFY THE CIVIL ENGINEER OF RECORD IMMEDIATELY UPON DISCOVERY OF ANY DISCREPANCIES.
- 6. BUILDING SETBACK DIMENSIONS FROM PROPERTY LINES SHALL HOLD OVER ALL OTHER CALLOUTS. PROPERTY LINES AND ASSOCIATED BUILDING SETBACKS SHALL BE VERIFIED PRIOR TO CONSTRUCTION LAYOUT.
- 7. CONTRACTOR SHALL PRESERVE AND PROTECT FROM DAMAGE ALL EXISTING MONUMENTATION DURING CONSTRUCTION. THE CONTRACTOR IS RESPONSIBLE FOR COORDINATING AND PAYING FOR THE REPLACEMENT OF ANY MONUMENTS DAMAGED OR REMOVED DURING CONSTRUCTION. NEW MONUMENTS SHALL BE REESTABLISHED BY A LICENSED SURVEYOR.
- 8. SOME SITE DEMOLITION AND UTILITY RELOCATION HAS BEEN PERFORMED. SURVEY MAY NOT BE COMPLETE OR ACCURATE. CONTRACTOR TO VERIFY EXISTING SITE CONDITIONS PRIOR TO CONSTRUCTION. CONTRACTOR SHALL BRING ANY DISCREPANCIES TO THE ATTENTION OF THE ENGINEER PRIOR TO BEGINNING CONSTRUCTION.
- ALL CONSTRUCTION AND MATERIALS SHALL CONFORM TO THESE PLANS, THE PROJECT SPECIFICATIONS AND THE APPLICABLE REQUIREMENTS OF THE 2018 OREGON STANDARD SPECIFICATIONS FOR CONSTRUCTION, THE 2017 OREGON PLUMBING SPECIALTY CODE AND REQUIREMENTS OF THE CITY OF EUGENE.
- 10. THE COMPLETED INSTALLATION SHALL CONFORM TO ALL APPLICABLE FEDERAL, STATE AND LOCAL CODES, ORDINANCES AND REGULATIONS. ALL PERMITS, LICENSES AND) INSPECTIONS REQUIRED BY THE GOVERNING AUTHORITIES FOR THE EXECUTION AND COMPLETION OF WORK SHALL BE SECURED BY THE CONTRACTOR PRIOR TO COMMENCING CONSTRUCTION.
- 11. ATTENTION: OREGON LAW REQUIRES YOU TO FOLLOW RULES ADOPTED BY THE OREGON UTILITY NOTIFICATION CENTER. THOSE RULES ARE SET FORTH IN OAR 952-001-0010) THROUGH OAR 952-001-0090. YOU MAY OBTAIN COPIES OF THE RULES BY CALLING THE CENTER. (NOTE: THE TELEPHONE NUMBER FOR THE OREGON UTILITY NOTIFICATION) CENTER IS (503) 232-1987). EXCAVATORS MUST NOTIFY ALL PERTINENT COMPANIES OR AGENCIES WITH UNDERGROUND UTILITIES IN THE PROJECT AREA AT LEAST 48 BUSINESS-DAY HOURS, BUT NOT MORE THAN 10 BUSINESS DAYS PRIOR TO COMMENCING AN EXCAVATION, SO UTILITIES MAY BE ACCURATELY LOCATED.
- 12. THE LOCATION OF EXISTING UNDERGROUND UTILITIES SHOWN ON THE PLANS ARE FOR INFORMATION ONLY AND ARE NOT GUARANTEED TO BE COMPLETE OR ACCURATE. \preceq CONTRACTOR SHALL VERIFY ELEVATIONS, PIPE SIZE, AND MATERIAL TYPES OF ALL-UNDERGROUND UTILITIES PRIOR TO COMMENCING WITH CONSTRUCTION AND SHALL BRING ANY DISCREPANCIES TO THE ATTENTION OF KPFF CONSULTING ENGINEERS, HOURS PRIOR TO START OF CONSTRUCTION TO PREVENT GRADE AND ALIGNMENT CONFLICTS.
- 13. THE ENGINEER OR OWNER IS NOT RESPONSIBLE FOR THE SAFETY OF THE CONTRACTOR OR HIS CREW. ALL O.S.H.A. REGULATIONS SHALL BE STRICTLY ADHERED TO IN THE PERFORMANCE OF THE WORK.
- 14. TEMPORARY AND PERMANENT EROSION CONTROL MEASURES SHALL BE IMPLEMENTED. THE CONTRACTOR SHALL ADHERE TO CITY OF EUGENE FOR MINIMUM EROSION CONTROL MEASURES. THE ESC FACILITIES SHOWN IN THESE PLANS ARE THE MINIMUM REQUIREMENTS FOR ANTICIPATED SITE CONDITIONS. DURING THE CONSTRUCTION✓ PERIOD, ESC FACILITIES SHALL BE UPGRADED AS NEEDED FOR UNEXPECTED STORM EVENTS AND TO ENSURE THAT SEDIMENT AND SEDIMENT LADEN WATER DO NOT LEAVE
- 15. THE CONTRACTOR IS RESPONSIBLE FOR MAINTAINING ALL ROADWAYS, KEEPING TH€M CLEAN AND FREE OF CONSTRUCTION MATERIALS AND DEBRIS, AND PROVIDING DUST CONTROL AS REQUIRED.
- 16. TRAFFIC CONTROL SHALL BE PROVIDED BY THE CONTRACTOR THROUGHOUT CONSTRUCTION. CONTRACTOR SHALL PROVIDE A TRAFFIC CONTROL PLAN TO CITY OF EUGENE AND 4J SCHOOL DISTRICT FOR REVIEW AND APPROVAL PRIOR TO COMMENCING
- 17. THE CONTRACTOR SHALL BE RESPONSIBLE FOR COORDINATING AND SCHEDULING ALL WORK WITH THE OWNER.

CONSTRUCTION NOTES

- 1. CONSTRUCTION LAYOUT (ALL ACTUAL LINES AND GRADES) SHALL BE STAKED BY A PROFESSIONAL SURVEYOR, REGISTERED IN THE STATE OF OREGON, BASED ON COORDINATES, DIMENSIONS, BEARINGS, AND ELEVATIONS, AS SHOWN, ON THE PLANS.
- 2. SUBGRADE AND TRENCH BACKFILL SHALL BE COMPACTED TO AT LEAST 95% OF THE MAXIMUM DRY DENSITY AS DETERMINED BY ASTM D-698. FLOODING OR JETTING THE BACKFILLED TRENCHES WITH WATER IS NOT PERMITTED.
- 3. SPECIAL INSPECTION REQUIRED FOR ALL COMPACTION TESTING.

- 1. THE CONTRACTOR SHALL BE RESPONSIBLE FOR DEMOLITION AND DISPOSAL OF EXISTING AC, CURBS, SIDEWALKS AND OTHER SITE ELEMENTS WITHIN THE SITE AREA IDENTIFIED IN THE
- 2. EXCEPT FOR MATERIALS INDICATED TO BE STOCKPILED OR TO REMAIN ON OWNER'S PROPERTY, CLEARED MATERIALS SHALL BECOME CONTRACTOR'S PROPERTY, REMOVED FROM THE SITE, AND DISPOSED OF PROPERLY.
- 3. ITEMS INDICATED TO BE SALVAGED SHALL BE CAREFULLY REMOVED AND DELIVERED STORED AT THE PROJECT SITE AS DIRECTED BY THE OWNER.
- 4. ALL LANDSCAPING, PAVEMENT, CURBS AND SIDEWALKS, BEYOND THE IDENTIFIED SITE AREA, DAMAGED DURING THE CONSTRUCTION SHALL BE REPLACED TO THEIR ORIGINAL CONDITION
- 5. CONCRETE SIDEWALKS SHOWN FOR DEMOLITION SHALL BE REMOVED TO THE NEAREST EXISTING CONSTRUCTION JOINT.
- 6. SAWCUT STRAIGHT MATCHLINES TO CREATE A BUTT JOINT BETWEEN THE EXISTING AND NEW

UTILITIES

- 1. ADJUST ALL INCIDENTAL STRUCTURES, MANHOLES, VALVE BOXES, CATCH BASINS, FRAMES AND COVERS, ETC. TO FINISHED GRADE.
- 2. CONTRACTOR SHALL ADJUST ALL EXISTING AND/OR NEW FLEXIBLE UTILITIES (WATER, TV, TELEPHONE, ELEC., ETC.) TO CLEAR ANY EXISTING OR NEW GRAVITY DRAIN UTILITIES (STORM DRAIN, SANITARY SEWER, ETC.) IF CONFLICT OCCURS.
- CONTRACTOR SHALL COORDINATE WITH PRIVATE UTILITY COMPANIES FOR THE INSTALLATION OF OR ADJUSTMENT TO GAS, ELECTRICAL, POWER AND TELEPHONE SERVICE.
- 4. BEFORE BACKFILLING ANY SUBGRADE UTILITY IMPROVEMENTS CONTRACTOR SHALL SURVEY AND RECORD MEASUREMENTS OF EXACT LOCATION AND DEPTH AND SUBMIT TO ENGINEER
- 5. ALL WORK TO CONFORM TO THE 2017 OREGON PLUMBING SPECIALTY CODE

STORM AND SANITARY

- 1. CONNECTIONS TO EXISTING STORM AND SANITARY SEWERS SHALL CONFORM TO THE 2018 OREGON STANDARD SPECIFICATIONS FOR CONSTRUCTION, SECTION 00490, "WORK ON EXISTING SEWERS AND STRUCTURES".
- BEGIN LAYING STORM DRAIN AND SANITARY SEWER PIPE AT THE LOW POINT OF THE SYSTEM, TRUE TO GRADE AND ALIGNMENT INDICATED WITH UNBROKEN CONTINUITY OF INVERT. THE CONTRACTOR SHALL ESTABLISH LINE AND GRADE FOR THE STORM AND SANITARY SEWER PIPE USING A LASER.
- 3. ALL ROOF DRAIN AND CATCH BASIN LEADERS SHALL HAVE A MINIMUM SLOPE OF 2 PERCENT UNLESS NOTED OTHERWISE IN THE PLANS.
- 4. ALL HORIZONTAL CONNECTIONS TO THE SANITARY OR STORM SEWERS SHALL BE OF THE 'WYE' BRANCH TYPE.

EARTHWORKS

- 1. CONTRACTOR SHALL PREVENT SEDIMENTS AND SEDIMENT LADEN WATER FROM ENTERING THE STORM DRAINAGE SYSTEM.
- 2. TRENCH BEDDING AND BACKFILL SHALL BE AS SHOWN ON THE PIPE BEDDING AND BACKFILL DETAIL, THE PROJECT SPECIFICATIONS AND AS REQUIRED IN THE SOILS REPORT. FLOODING OR JETTING THE BACKFILLED TRENCHES WITH WATER WILL NOT BE PERMITTED.

SEPARATION STATEMENT

ALL WATER MAIN CROSSINGS SHALL CONFORM TO THE OREGON STATE HEALTH DEPARTMENT, CHAPTER 333. WATER MAINS SHALL CROSS OVER SANITARY SEWERS WITH A 18" MINIMUM CLEARANCE BETWEEN OUTSIDE DIAMETERS OF PIPE WITH ALL PIPE JOINTS EQUIDISTANT FROM CROSSING. HORIZONTAL SEPARATION BETWEEN WATER MAINS AND SANITARY SEWERS IN PARALLEL INSTALLATIONS SHALL BE 10'. MAINTAIN 12" MINIMUM VERTICAL DISTANCE FOR ALL OTHER UTILITY CROSSINGS AND 12" HORIZONTAL PARALLEL DISTANCE. IN CASES WHERE IT IS NOT POSSIBLE TO MAINTAIN THE MINIMUM 10' HORIZONTAL SEPARATION, THE WATER MAIN SHALL BE LAID ON A SEPARATE SHELF IN THE TRENCH 18" INCHES ABOVE THE SEWER.

MATERIAL NOTES

- 1. GENERAL: MATERIALS SHALL BE NEW. THE USE OF MANUFACTURER'S NAMES, MODELS, AND NUMBERS IS INTENDED TO ESTABLISH STYLE, QUALITY, APPEARANCE, AND USEFULNESS. PROPOSED SUBSTITUTIONS WILL REQUIRE WRITTEN APPROVAL FROM ARCHITECT PRIOR TO INSTALLATION.
- 2. STORM AND SANITARY SEWER PIPING SHALL BE 3034 SDR 35 PVC PIPE.
- 3. CONCRETE FOR CURBS, SIDEWALK AND DRIVEWAYS SHALL HAVE A MINIMUM COMPRESSIVE STRENGTH OF 3,300 PSI AT 28 DAYS.

ABBREVIATIONS

AC	ASPHALT CONCRETE	OVH/OH	OVERHEAD
AD	AREA DRAIN	P/L	PROPERTY LINE
APPROX	APPROXIMATE	PED	PEDESTRIAN
BLDG	BUILDING	PIV	POST INDICATOR VALVE
СВ	CATCH BASIN	PM	PARKING METER
CL	CENTERLINE	POC	POINT ON CURVE
CO	CLEANOUT	PP	POWER POLE
CONC.	CONCRETE	PRC	POINT OF REVERSE CURVAT
COTG	CLEANOUT TO GRADE	PT	POINT OF TANGENT
CP	CONTROL POINT	P.U.E	PUBLIC UTILITY EASEMENT
Δ	DELTA	PVC	POLYVINYL CHLORIDE
D/W	DRIVEWAY	PVMT	PAVEMENT
DIA.,Ø	DIAMETER	PVT	PRIVATE
DIP	DUCTILE IRON PIPE	R	RIM
E	EASTING	RD	ROOF DRAIN
EXIST./EX	EXISTING	R.O.W	RIGHT-OF-WAY
FG	FINISH GRADE	SD	STORM DRAIN
FH	FIRE HYDRANT	SDMH	STORM DRAIN MANHOLE
FL	FLOWLINE	SHT	SHEET
G	GUTTER	SS	SANITARY SEWER
GB	GRADE BREAK	SSMH	SANITARY SEWER MANHOLE
GL	GAS LINE	ST	STREET
GV	GATE VALVE	STD	STANDARD
Н	HEIGHT	S/W	SIDEWALK
HCP	HANDICAP PARKING SPACE	TC	TOP OF CURB
HP	HIGH POINT	TG	TOP OF GROUND
ID	INSIDE DIAMETER	TP	TOP OF PAVEMENT
IE	INVERT ELEVATION	TRANS.	TRANSFORMER
INV	INVERT	TS	TOP OF STAIR
IRR.	IRRIGATION	TYP	TYPICAL
LP	LIGHT POLE	W	WATER
MH	MANHOLE	W/	WITH
MIN	MINIMUM	WCR	WHEEL CHAIR RAMP
N	NORTHING	WM	WATER METER
O.D	OUTSIDE DIAMETER	WV	WATER VALVE
OF	OUTFALL		

NOTICE TO EXCAVATORS: ATTENTION: OREGON LAW REQUIRES YOU TO FOLLOW RULES ADOPTED BY THE OREGON UTILITY NOTIFICATION CENTER. THOSE RULES ARE SET FORTH IN OAR 952-001-0010 THROUGH OAR 952-001-0090. YOU MAY OBTAIN COPIES OF THE RULES BY CALLING THE CENTER. (NOTE: THE TELEPHONE NUMBER FOR

THE OREGON UTILITY NOTIFICATION CENTER IS (503)-232-1987).

POTENTIAL UNDERGROUND FACILITY OWNERS

Dig Safely.

Call the Oregon One-Call Center 1-800-332-2344

SHEET INDEX

Sheet	Sheet Description					
Title	Sheet Description					
C1.0	CIVIL NOTES AND ABBREVIATIO					
C1.1	CIVIL MATERIAL SPECIFICATION					
C1.2	EXISTING CONDITIONS					
C2.0	CIVIL SITE PLANS					
C2.1	CIVIL SITE PLANS					
C3.0	CIVIL DETAILS					
C3.1	CIVIL DETAILS					

GMA ARCHITECTS 860 West Park Street / Ste 300 Eugene / Oregon / 97401 p 541.344.9157 gma-arch.com





REVISIONS 17 MARCH 2020

_

SIL 00 EN **8**

JOB NO: ISSUE DATE:

> CIVIL NOTES **ABBREVIATIONS**

19189

3/13/2020

ADDENDUM 1

SOIL MATERIALS

A. GENERAL: PROVIDE BORROW SOIL MATERIALS WHEN SUFFICIENT SATISFACTORY SOIL MATERIALS ARE NOT AVAILABLE FROM EXCAVATIONS.

- B. SATISFACTORY SOILS: SOIL CLASSIFICATION GROUPS GW, GP, GM, SW, SP, AND SM ACCORDING TO ASTM D 2487, OR A COMBINATION OF THESE GROUPS; FREE OF ROCK OR GRAVEL LARGER THAN 3 INCHES IN ANY DIMENSION, DEBRIS, WASTE, FROZEN MATERIALS, VEGETATION, AND OTHER DELETERIOUS MATTER.
- C. UNSATISFACTORY SOILS: SOIL CLASSIFICATION GROUPS GC, SC, CL, ML, OL, CH, MH, OH, AND PT ACCORDING TO ASTM D 2487, OR A COMBINATION OF THESE GROUPS.
- 1. UNSATISFACTORY SOILS ALSO INCLUDE SATISFACTORY SOILS NOT MAINTAINED WITHIN 2 PERCENT OF OPTIMUM MOISTURE CONTENT AT TIME OF COMPACTION.
- D. BASE COURSE: USE OREGON STANDARD SPECIFICATIONS FOR CONSTRUCTION 3/4-INCH-0-INCH BASE
- E. ENGINEERED FILL: NATURALLY OR ARTIFICIALLY GRADED MIXTURE OF NATURAL OR CRUSHED GRAVEL CRUSHED STONE, AND NATURAL OR CRUSHED SAND; ASTM D 2940; WITH AT LEAST 90 PERCENT PASSING A 3-INCH SIEVE AND NOT MORE THAN 12 PERCENT PASSING A NO. 200 SIEVE.
- F. BEDDING COURSE AND PIPE ZONE BACKFILL: USE OREGON STANDARD SPECIFICATIONS FOR CONSTRUCTION 3/4-INCH-0-INCH BASE AGGREGATE.
- G. BACKFILL AND FILL:
- 1. SATISFACTORY SOIL MATERIALS
- 2. INITIAL TRENCH BACKFILL:USE OREGON STANDARD SPECIFICATIONS FOR CONSTRUCTION 3/4-INCH-0-INCH BASE AGGREGATE.
- H. ENGINEERED WOOD FIBER FOR SOFTPLAY: PROVIDE GT IMPAX ENGINEERED WOOD FIBER OR APPROVED

ACCESSORIES

EQUAL.

- A. DETECTABLE WARNING TAPE: ACID- AND ALKALI-RESISTANT, POLYETHYLENE FILM WARNING TAPE MANUFACTURED FOR MARKING AND IDENTIFYING UNDERGROUND UTILITIES, A MINIMUM OF 6 INCHES WIDE AND 4 MILS THICK, CONTINUOUSLY INSCRIBED WITH A DESCRIPTION OF THE UTILITY, WITH METALLIC CORE ENCASED IN A PROTECTIVE JACKET FOR CORROSION PROTECTION, DETECTABLE BY METAL DETECTOR WHEN TAPE IS BURIED UP TO 30 INCHES DEEP; COLORED TO COMPLY WITH LOCAL PRACTICE OR REQUIREMENTS OF AUTHORITIES HAVING JURISDICTION OR AS FOLLOWS:
- 1. RED: ELECTRIC.
- 2. YELLOW: GAS, OIL, STEAM, AND DANGEROUS MATERIALS.
- 3. ORANGE: TELEPHONE AND OTHER COMMUNICATIONS.
- 4. BLUE: WATER SYSTEMS.
- 5. GREEN: SEWER SYSTEMS.
- B. TRACER WIRE: 12 AWG MINIMUM SOLID COPPER INSULATED HIGH MOLECULAR WEIGHT POLYETHYLENE (HMW)
 PE) TRACER WIRE OR APPROVED EQUAL. THE TRACER WIRE INSULATION SHALL BE GREEN FOR SEWER PIPE
 AND BLUE FOR WATERLINES AND BE A MINIMUM OF 45 MIL. THICK. JOINTS OR SPLICES SHALL BE
 WATERPROOF. THE WIRE SHALL BE RATED FOR 30 VOLT.
- C. DRAINAGE FABRIC: NONWOVEN GEOTEXTILE, SPECIFICALLY MANUFACTURED AS A DRAINAGE GEOTEXTILE, MADE FROM POLYOLEFINS, POLYESTERS, OR POLYAMIDES; AND WITH THE FOLLOWING MINIMUM PROPERTIES
- DETERMINED ACCORDING TO ASTM D 4759 AND REFERENCED STANDARD TEST METHODS:

 1. GRAB TENSILE STRENGTH: 110 LBF (490N); ASTM D 4632.
- 2. TEAR STRENGTH: 40 LBF (178 N); ASTM D 4533.
- 3. PUNCTURE STRENGTH: 220 LBF (979 N); ASTM D 4833.
- 4. APPARENT OPENING SIZE: NO. 40 (??MM); ASTM D 4751.
- 5. PERMATIVITY (MINIMUM): .5 SEC-1; ASTM D 4491.
- E. SEPARATION FABRIC: WOVEN GEOTEXTILE, SPECIFICALLY MANUFACTURED AS A SEPARATION GEOTEXTILE, MADE FROM POLYOLEFINS, POLYESTERS, OR POLYAMIDES; AND WITH THE FOLLOWING MINIMUM PROPERTIES DETERMINED ACCORDING TO ASTM D 4759 AND REFERENCED STANDARD TEST METHODS:
- 1. GRAB TENSILE STRENGTH: 180 LBF (800 N); ASTM D 4632.
- 2. TEAR STRENGTH: 68 LBF (302 N); ASTM D 4533.
- 3. PUNCTURE STRENGTH: 371 LBF (1650 N); ASTM D 4833.
- 4. APPARENT OPENING SIZE: NO. 30; ASTM D 4751.

CONCRETE PAVING

- 1.1 FORMS
- A. FORM MATERIALS: PLYWOOD, METAL, METAL-FRAMED PLYWOOD, OR OTHER APPROVED PANEL-TYPE MATERIALS TO PROVIDE FULL-DEPTH, CONTINUOUS, STRAIGHT, SMOOTH EXPOSED SURFACES.
- 1. USE FLEXIBLE OR CURVED FORMS FOR CURVES WITH A RADIUS 100 FEET OR LESS.
- B. FORM-RELEASE AGENT: COMMERCIALLY FORMULATED FORM-RELEASE AGENT THAT WILL NOT BOND WITH STAIN, OR ADVERSELY AFFECT CONCRETE SURFACES AND WILL NOT IMPAIR SUBSEQUENT TREATMENTS OF CONCRETE SURFACES.
- 1.2 CONCRETE MATERIALS
- A. CEMENTITIOUS MATERIAL: USE THE FOLLOWING CEMENTITIOUS MATERIALS, OF SAME TYPE, BRAND, AND SOURCE THROUGHOUT PROJECT:
- 1. PORTLAND CEMENT: ASTM C 150, GRAY PORTLAND CEMENT TYPE I
- a. FLY ASH: ASTM C 618, CLASS C.
- B. NORMAL-WEIGHT AGGREGATES: ASTM C 33, CLASS 4M, UNIFORMLY GRADED. PROVIDE AGGREGATES FROM A SINGLE SOURCE.
- 1. MAXIMUM COARSE-AGGREGATE SIZE: 1 INCH NOMINAL.
- 2. FINE AGGREGATE: FREE OF MATERIALS WITH DELETERIOUS REACTIVITY TO ALKALI IN CEMENT.
- C. WATER: POTABLE AND COMPLYING WITH ASTM C 94/C 94M.
- D. AIR-ENTRAINING ADMIXTURE: ASTM C 260.
- E. CHEMICAL ADMIXTURES: ADMIXTURES CERTIFIED BY MANUFACTURER TO BE COMPATIBLE WITH OTHER ADMIXTURES AND TO CONTAIN NOT MORE THAN 0.1 PERCENT WATER-SOLUBLE CHLORIDE IONS BY MASS OF CEMENTITIOUS MATERIAL.
- 1. WATER-REDUCING ADMIXTURE: ASTM C 494/C 494M, TYPE A.
- 2. WATER-REDUCING AND RETARDING ADMIXTURE: ASTM C 494/C 494M, TYPE D.
- 3. HIGH-RANGE, WATER-REDUCING ADMIXTURE: ASTM C 494/C 494M, TYPE F.
- 1.4 CURING MATERIALS
- A. ABSORPTIVE COVER: AASHTO M 182, CLASS 3, BURLAP CLOTH MADE FROM JUTE OR KENAF, WEIGHING APPROXIMATELY 9 OZ./SQ. YD. DRY.

- C. WATER: POTABLE.
- D. EVAPORATION RETARDER: WATERBORNE, MONOMOLECULAR, FILM FORMING, MANUFACTURED FOR APPLICATION TO FRESH CONCRETE.
- E. CLEAR, WATERBORNE, MEMBRANE-FORMING CURING COMPOUND: ASTM C 309, TYPE 1, CLASS B.
- F. WHITE, WATERBORNE, MEMBRANE-FORMING CURING COMPOUND: ASTM C 309, TYPE 2, CLASS B.
- 1.5 RELATED MATERIA
- A. JOINT FILLERS: ASTM D 1751, ASPHALT-SATURATED CELLULOSIC FIBER IN PREFORMED STRIPS.
- C. EPOXY BONDING ADHESIVE: ASTM C 881, TWO-COMPONENT EPOXY RESIN, CAPABLE OF HUMID CURING AND BONDING TO DAMP SURFACES, OF CLASS SUITABLE FOR APPLICATION TEMPERATURE AND OF GRADE TO REQUIREMENTS.
- 1.6 CONCRETE MIXTURES
- A. PREPARE DESIGN MIXTURES, PROPORTIONED ACCORDING TO ACI 301, WITH THE FOLLOWING PROPERTIES:
- 1. COMPRESSIVE STRENGTH (28 DAYS): 3300 PSI .
- 2. MAXIMUM WATER-CEMENTITIOUS MATERIALS RATIO AT POINT OF PLACEMENT: 0.50.
- 3. SLUMP LIMIT: 4 INCHES, PLUS OR MINUS 1 INCH.
- 4. AIR CONTENT: 4-1/2]PERCENT PLUS OR MINUS 1.5 PERCENT FOR 1-INCH NOMINAL MAXIMUM AGGREGATE
- B. CHEMICAL ADMIXTURES: USE ADMIXTURES ACCORDING TO MANUFACTURER'S WRITTEN INSTRUCTIONS.
- 1.7 CONCRETE MIXING
- A. READY-MIXED CONCRETE: MEASURE, BATCH, AND MIX CONCRETE MATERIALS AND CONCRETE ACCORDING TO ASTM C 94/C 94M. FURNISH BATCH CERTIFICATES FOR EACH BATCH DISCHARGED AND USED IN THE
- 1. WHEN TEMPERATURE IS BETWEEN 85 DEG F AND 90 DEG F, REDUCE MIXING AND DELIVERY TIME FROM 1-1/2 HOURS TO 75 MINUTES; WHEN AIR TEMPERATURE IS ABOVE 90 DEG F, REDUCE MIXING AND DELIVERY TIME TO 60 MINUTES.
- 1.8 PAVEMENT MARKINGS
- A. PAVEMENT-MARKING PAINT: ALKYD-RESIN TYPE, LEAD AND CHROMATE FREE, READY MIXED, COMPLYING WITH FS TT-P-115, TYPE I OR AASHTO M 248, TYPE N.
- 1. COLOR: AS INDICATED.

COLOR: AS INDICATED.

- B. PAVEMENT-MARKING PAINT: LATEX, WATERBORNE EMULSION, LEAD AND CHROMATE FREE, READY MIXED,
- COMPLYING WITH FS TT-P-1952, TYPE II, WITH DRYING TIME OF LESS THAN 45 MINUTES.
- C. PAVEMENT-MARKING PAINT: MPI #97 LATEX TRAFFIC MARKING PAINT.
- 1. COLOR: AS INDICATED.



860 West Park Street / Ste 300
Eugene / Oregon / 97401
p 541.344.9157
gma-arch.com



REVISIONS

17 MARCH 2020

F: 541.684.4909

www.kpff.com

ELLY MIDDLE SCHOOL IMPROVEN

JOB NO: 19189
ISSUE DATE: 3/13/2020

CIVIL
MATERIAL

<u>S</u>_


ADDENDUM 1

COPYRIGHT GMA ARCHITECTS

SPECIFICATIONS





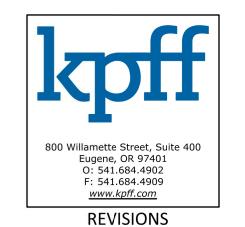

BALZHISER

& Hubbard

ENGINEERS

100 WEST 13TH AVENUE EUGENE, OR 97401

P: 541-686-8478 F: 541-345-5303

REGISTERED /PROFES610NAL

EXPIRES DECEMBER 31, 2014

Ш \propto

LAST REVISION: 09/18/2013 4 FIELD APD / HDM

PROJECT 3900-002-13 FILENAME 3900-02-13 TOPO.dwg

SHEET No.

ISSUED:

DRAFTING

JSM / ASD

SHEET 1 OF 2

3/2/2020 ISSUE DATE: **EXISTING CONDITIONS**

200 REN

19189

JOB NO:



GMA ARCHITECTS 860 West Park Street / Ste 300 Eugene / Oregon / 97401 p 541.344.9157 gma-arch.com





17 MARCH 2020

3/13/2020

JOB NO: ISSUE DATE:

CIVIL SITE PLANS

SCALE: 1" = 20'

Current and the second second

SHEET NOTES

- 1. ALL DIMENSIONS ARE TO FACE OF CURB OR FACE OF WALL 2. PIPE BEDDING AND BACKFILL FOR ALL UTILITIES SHALL BE DONE PER DETAIL 1/C3.1.
- EMULSIFIED ASPHALT FOG COAT WITHOUT AGGREGATE. MATERIALS INSTALLATION TO BE PER SECTION 705 OF THE ODOT STANDARD SPECIFICATIONS.

KEY NOTES

<u>DESCRIPTION</u>

CHAIN LINK FENCE. REMOVE EXISTING AND REPLACE AS 3./C3.0 1b 16' SWING GATE 1c 3' SWING GATE 1d CONNECT TO EXISTING FENCE 4/C3.1 2 MOW STRIP 2/C3.0 3 WHEEL STOP 1/C3.0 4a 'NO PARKING" ZONE STRIPING 1/C3.0 4b 4" WIDE WHITE STRIPE 4/C3.0 COMPACT STRIPING MATCH EXISTING GRADE AT EDGE OF PLAY AREA MATCH EXISTING GRADE AT EDGE OF SIDEWALK 5/C3.1 INSTALL RAMPS INTO SOFTPLAY AREA

11 STOP BAR: 12" WIDE WHITE THERMOPLASTIC BAR 12 STOP SIGN 6/C3.0 BENCH. SEE ARCHITECTURAL PAINT BLACK OVER EXISTING STRIPING WITHIN PROPOSED DRIVE LOOP




DIRECTIIONAL ARROW

10 "PAUSE PARKING ONLY" STRIPING

COAT. SEE NOTE 3



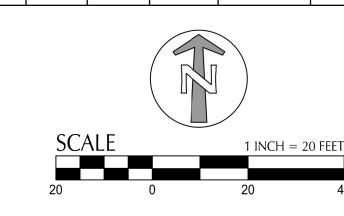

SCHOOL IMPROVE 200 SILVER LN, E RENOVATIONS JOB NO: 3/13/2020 ISSUE DATE:

GMA ARCHITECTS

860 West Park Street / Ste 300

Eugene / Oregon / 97401

p 541.344.9157

gma-arch.com

800 Willamette Street, Suite 400 Eugene, OR 97401 O: 541.684.4902

F: 541.684.4909

www.kpff.com

REVISIONS

17 MARCH 2020

DETAIL

5/C3.0


CIVIL SITE PLANS


ADDENDUM 1

COPYRIGHT GMA ARCHITECTS

SHEET LEGEND PROPERTY LINE EMULSIFIED ASPHALT FOG SIDEWALK. CROSS-SLOPE TO 2 RF I FSS THAN 1.8%. BE LESS THAN 1.8%. UTILITY LABEL LEGEND STRUCTURE LABEL UTILITY TYPE (SD=STORM DRAINAGE) STRUCTURE TYPE CALLOUT ID NUMBER (WHERE APPLICABLE) XX XX-XX X+XX.X RT X.X' ← LOCATION (WHERE APPLICABLE) IE IN = XX.XSTRUCTURE INFO (WHERE APPLICABLE) IE OUT = XX.X PIPE LABEL — UTILITY LENGTH ----- UTILITY SIZE ----- UTILITY TYPE XXLF - XX" XX S=X.XX% SLOPE (WHERE APPLICABLE) STRUCTURE TYPE <u>CALLOUT</u> <u>DESCRIPTION</u> DETAIL REF. 3/C3.1 SUBGRADE DECK DRAIN Curve Table Delta Start Location End Location C1 49.289 488.000 005.7870 N 122/52.50 E 170036.03 N 122752.50 N 122749.86 N 122749.86 N 122747.10 E 170085.23 E 170137.17 C2 | 52.036 | 512.000 | 005.8232 N 122746.78 N 122800.04 C3 | 114.830 | 30.000 | 219.3087 E 170268.63 E 170249.76 N 122800.04 N 122777.57 C4 | 68.667 | 100.000 | 039.3431 E 170249.76 E 170186.29




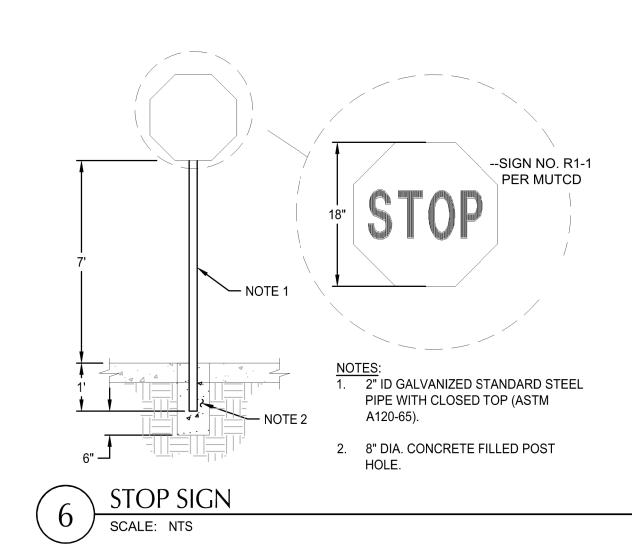

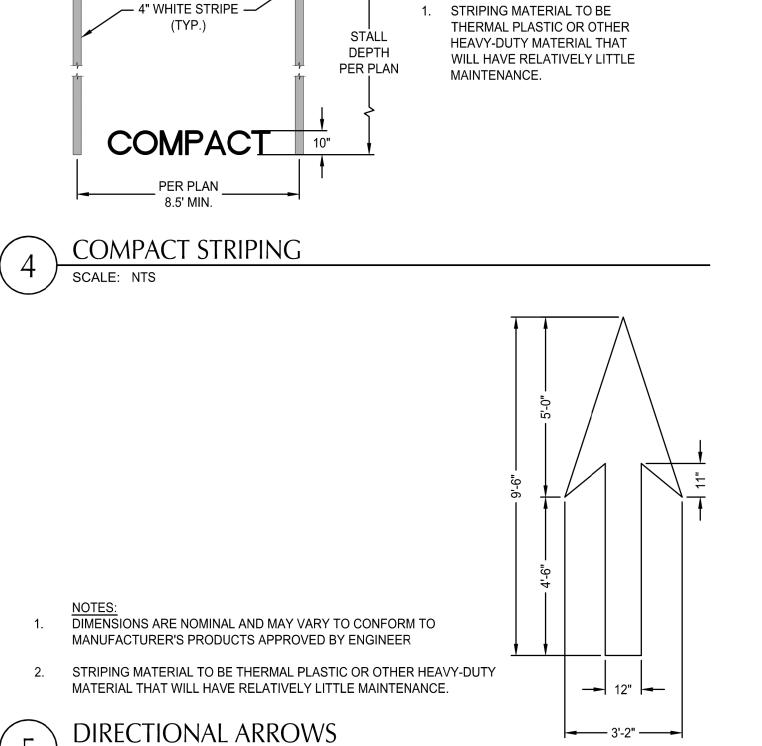


SCALE: NTS

NOTES:

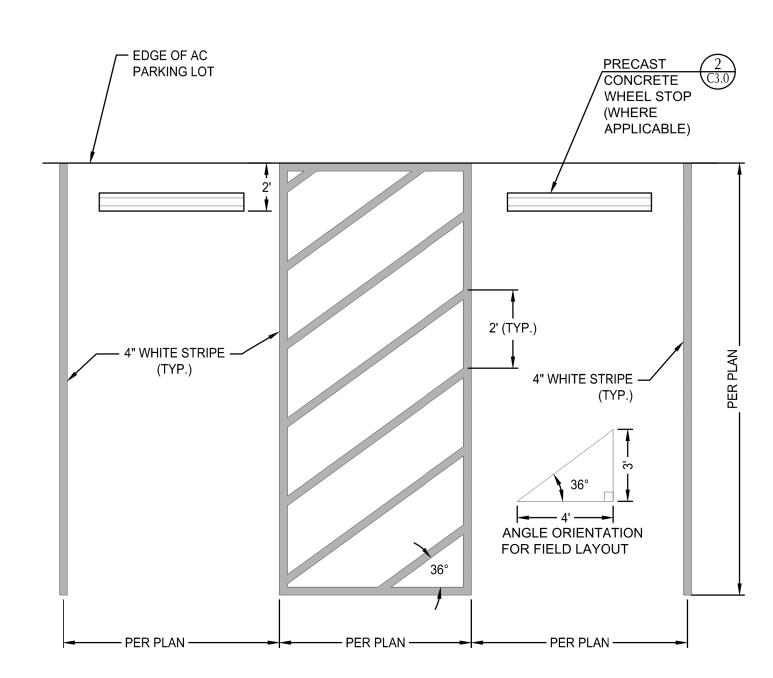

TYPICAL PARKING LAYOUT SCALE: NTS

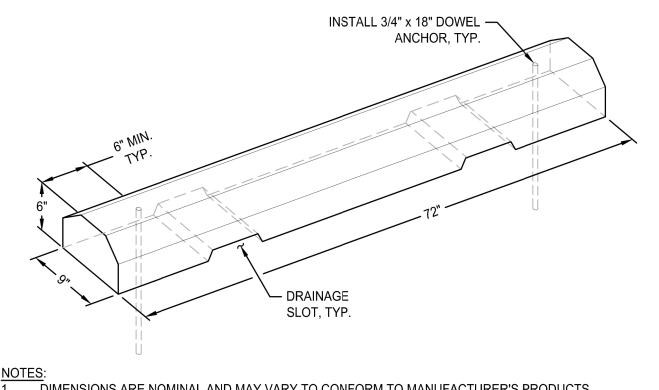

DIMENSIONS ARE NOMINAL AND MAY VARY TO CONFORM TO MANUFACTURER'S PRODUCTS APPROVED BY ENGINEER.

PRECAST CONCRETE WHEEL STOP SCALE: NTS

SCHOOL IMPROVE

MENTS

200 SIL' RENOV,

GMA ARCHITECTS

860 West Park Street / Ste 300

Eugene / Oregon / 97401

p 541.344.9157

gma-arch.com

800 Willamette Street, Suite 400

Eugene, OR 97401 O: 541.684.4902

F: 541.684.4909

www.kpff.com

REVISIONS

17 MARCH 2020

JOB NO: 3/13/2020 **ISSUE DATE:**

CIVIL DETAILS


19189

ADDENDUM 1

NOTES:

- CONSTRUCT SCORE JOINTS AT 3' MAX. SPACING AND CONTRACTION JOINTS AT 12' MAX. SPACING.
- PROVIDE MEDIUM TO COARSE BROOM FINISH.
 SLOPE AT 2% MINIMUM AWAY FROM BUILDING.

4 MOW BAND & WOODCHIP CONTAINMENT EDGE

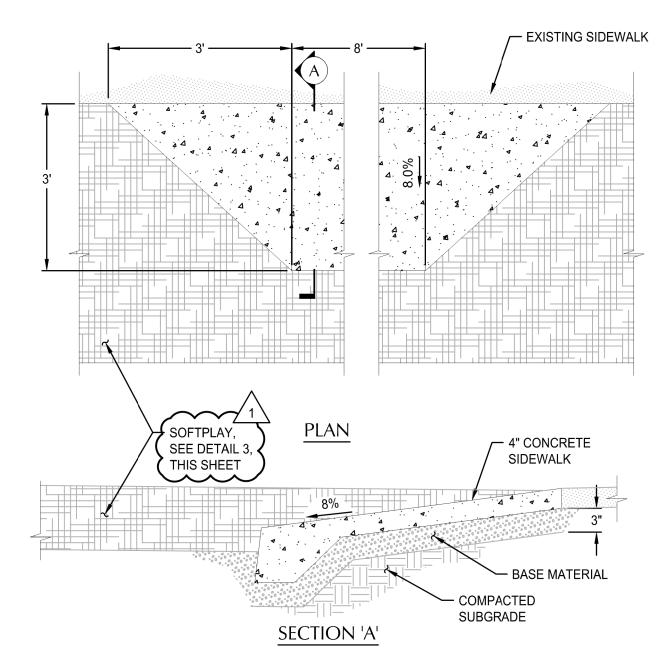

NOTES:


1. PROVIDE RAMP TEXTURING WITH AN EXPANDED METAL GRATE PLACED ON AND REMOVED FROM WET CONCRETE TO LEAVE A DIAMOND PATTERN. EACH DIAMOND SHALL BE 1½" LONG BY ½" WIDE WITH

THE LONG SECTION AXIS ORIENTED PERPENDICULAR TO THE CURB. THE GROOVES SHALL BE 1/8" DEEP

BY ¼" WIDE.


5 SOFTPLAY RAMP

SCALE: NTS

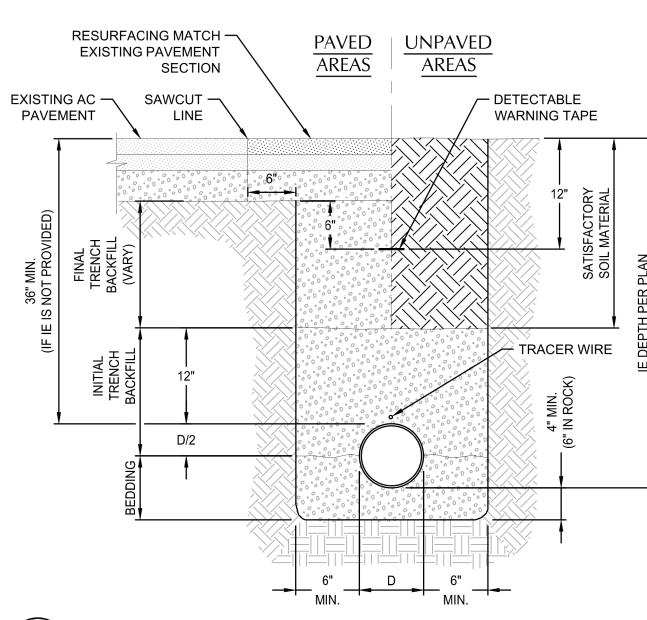

1 TYPICAL PIPE BEDDING AND BACKFILL

SCALE: NTS

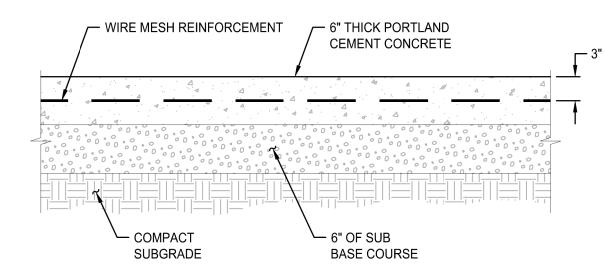


NOTES:

- CONSTRUCT CONTRACTION JOINTS AT 15' MAX. SPACING AND AT RAMPS.
- CONSTRUCT EXPANSION JOINTS AT 200' MAX. SPACING AT POINTS OF TANGENCY AND AT ENDS OF EACH DRIVEWAY.

2. PROVIDE MEDIUM TO COARSE BROOM FINISH.

2 REINFORCED SIDEWALK SECTION SCALE: NTS

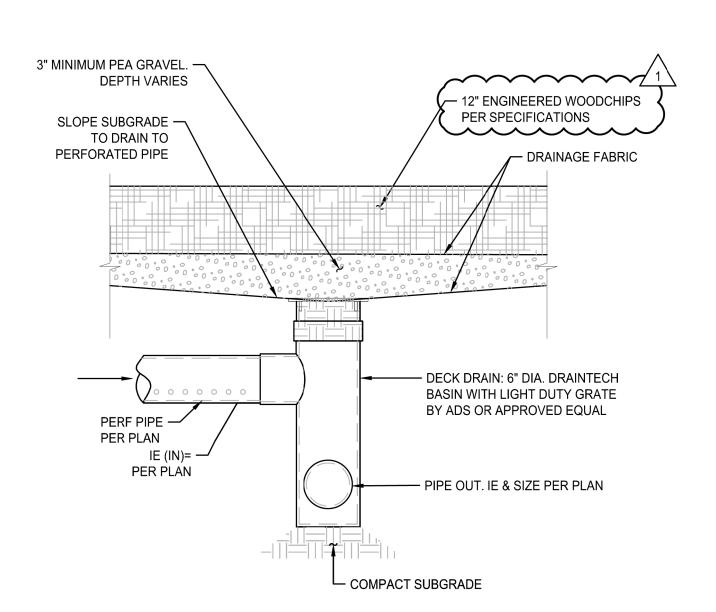

3 SOFTPLAY SCALE: NTS

GMA ARCHITECTS

860 West Park Street / Ste 300

Eugene / Oregon / 97401

p 541.344.9157

gma-arch.com



REVISIONS

17 MARCH 2020

800 Willamette Street, Suite 400 Eugene, OR 97401 O: 541.684.4902 F: 541.684.4909

SCHOOL IMPROVEMENTS


200 SILVER LN, EUGENE, OR 97404 RENOVATIONS

JOB NO: 19189
ISSUE DATE: 3/13/2020


CIVIL DETAILS

X - **S** -

ADDENDUM 1

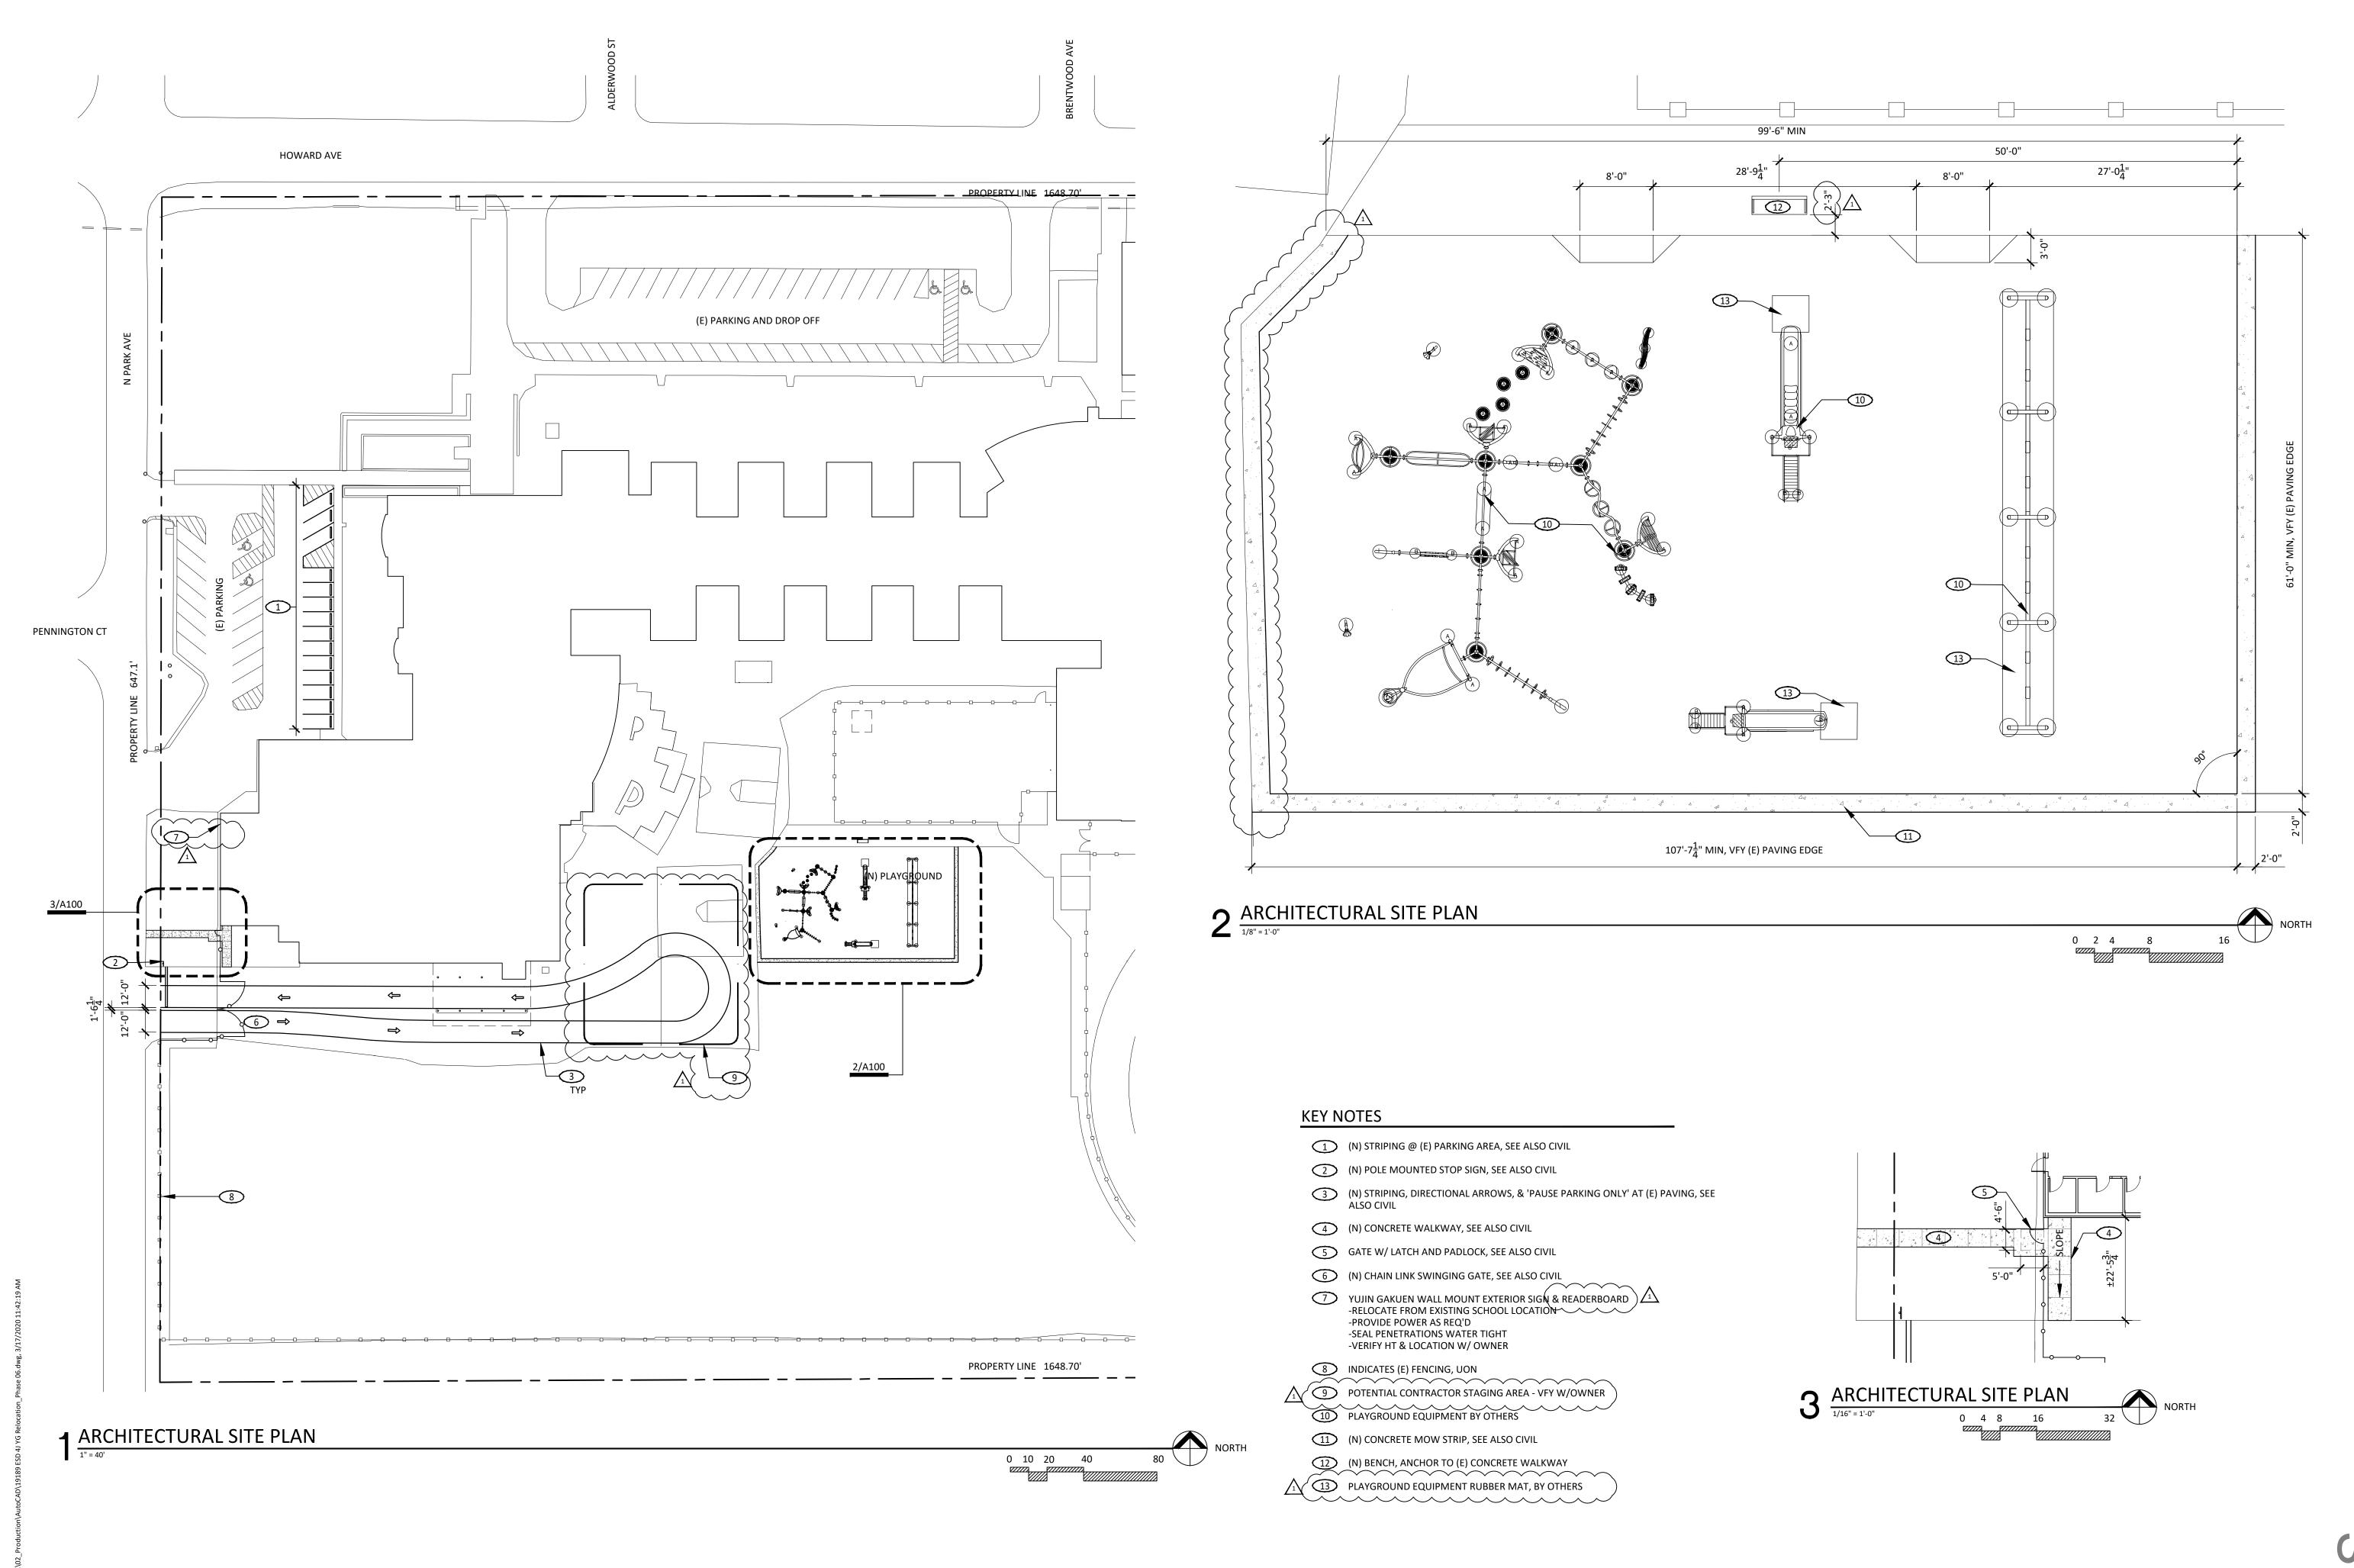

GMA ARCHITECTS 860 West Park Street / Ste 300 Eugene / Oregon / 97401 p 541.344.9157 gma-arch.com

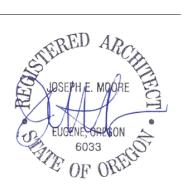

REVISIONS

3/17/2020 ADD. 1

JOB NO:

SITE PLAN

ARCHITECTURAL

19189

3/3/2020

A100

ISSUE DATE:

DEMOLISH MARKER BOARD, PATCH WALL TO MATCH (N) PROJECT STANDARD

4/A111

14

11

2/A111

13

LIB

19 19A

TAOHE TAOHE DEN

3→


LKR1

RR6

2 DEMOLISH FENCE & GATE AS REQ'D BY (N) WORK

3 DEMOLISH WOOD WALL CAP



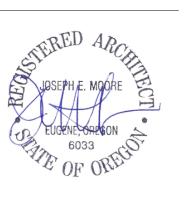

REVISIONS 3/17/2020 ADD. 1


PROVEMENTS

JOB NO: ISSUE DATE: 3/3/2020

DEMOLITION

1 OVERALL DEMOLITION PLAN


1/32" = 1'-0"

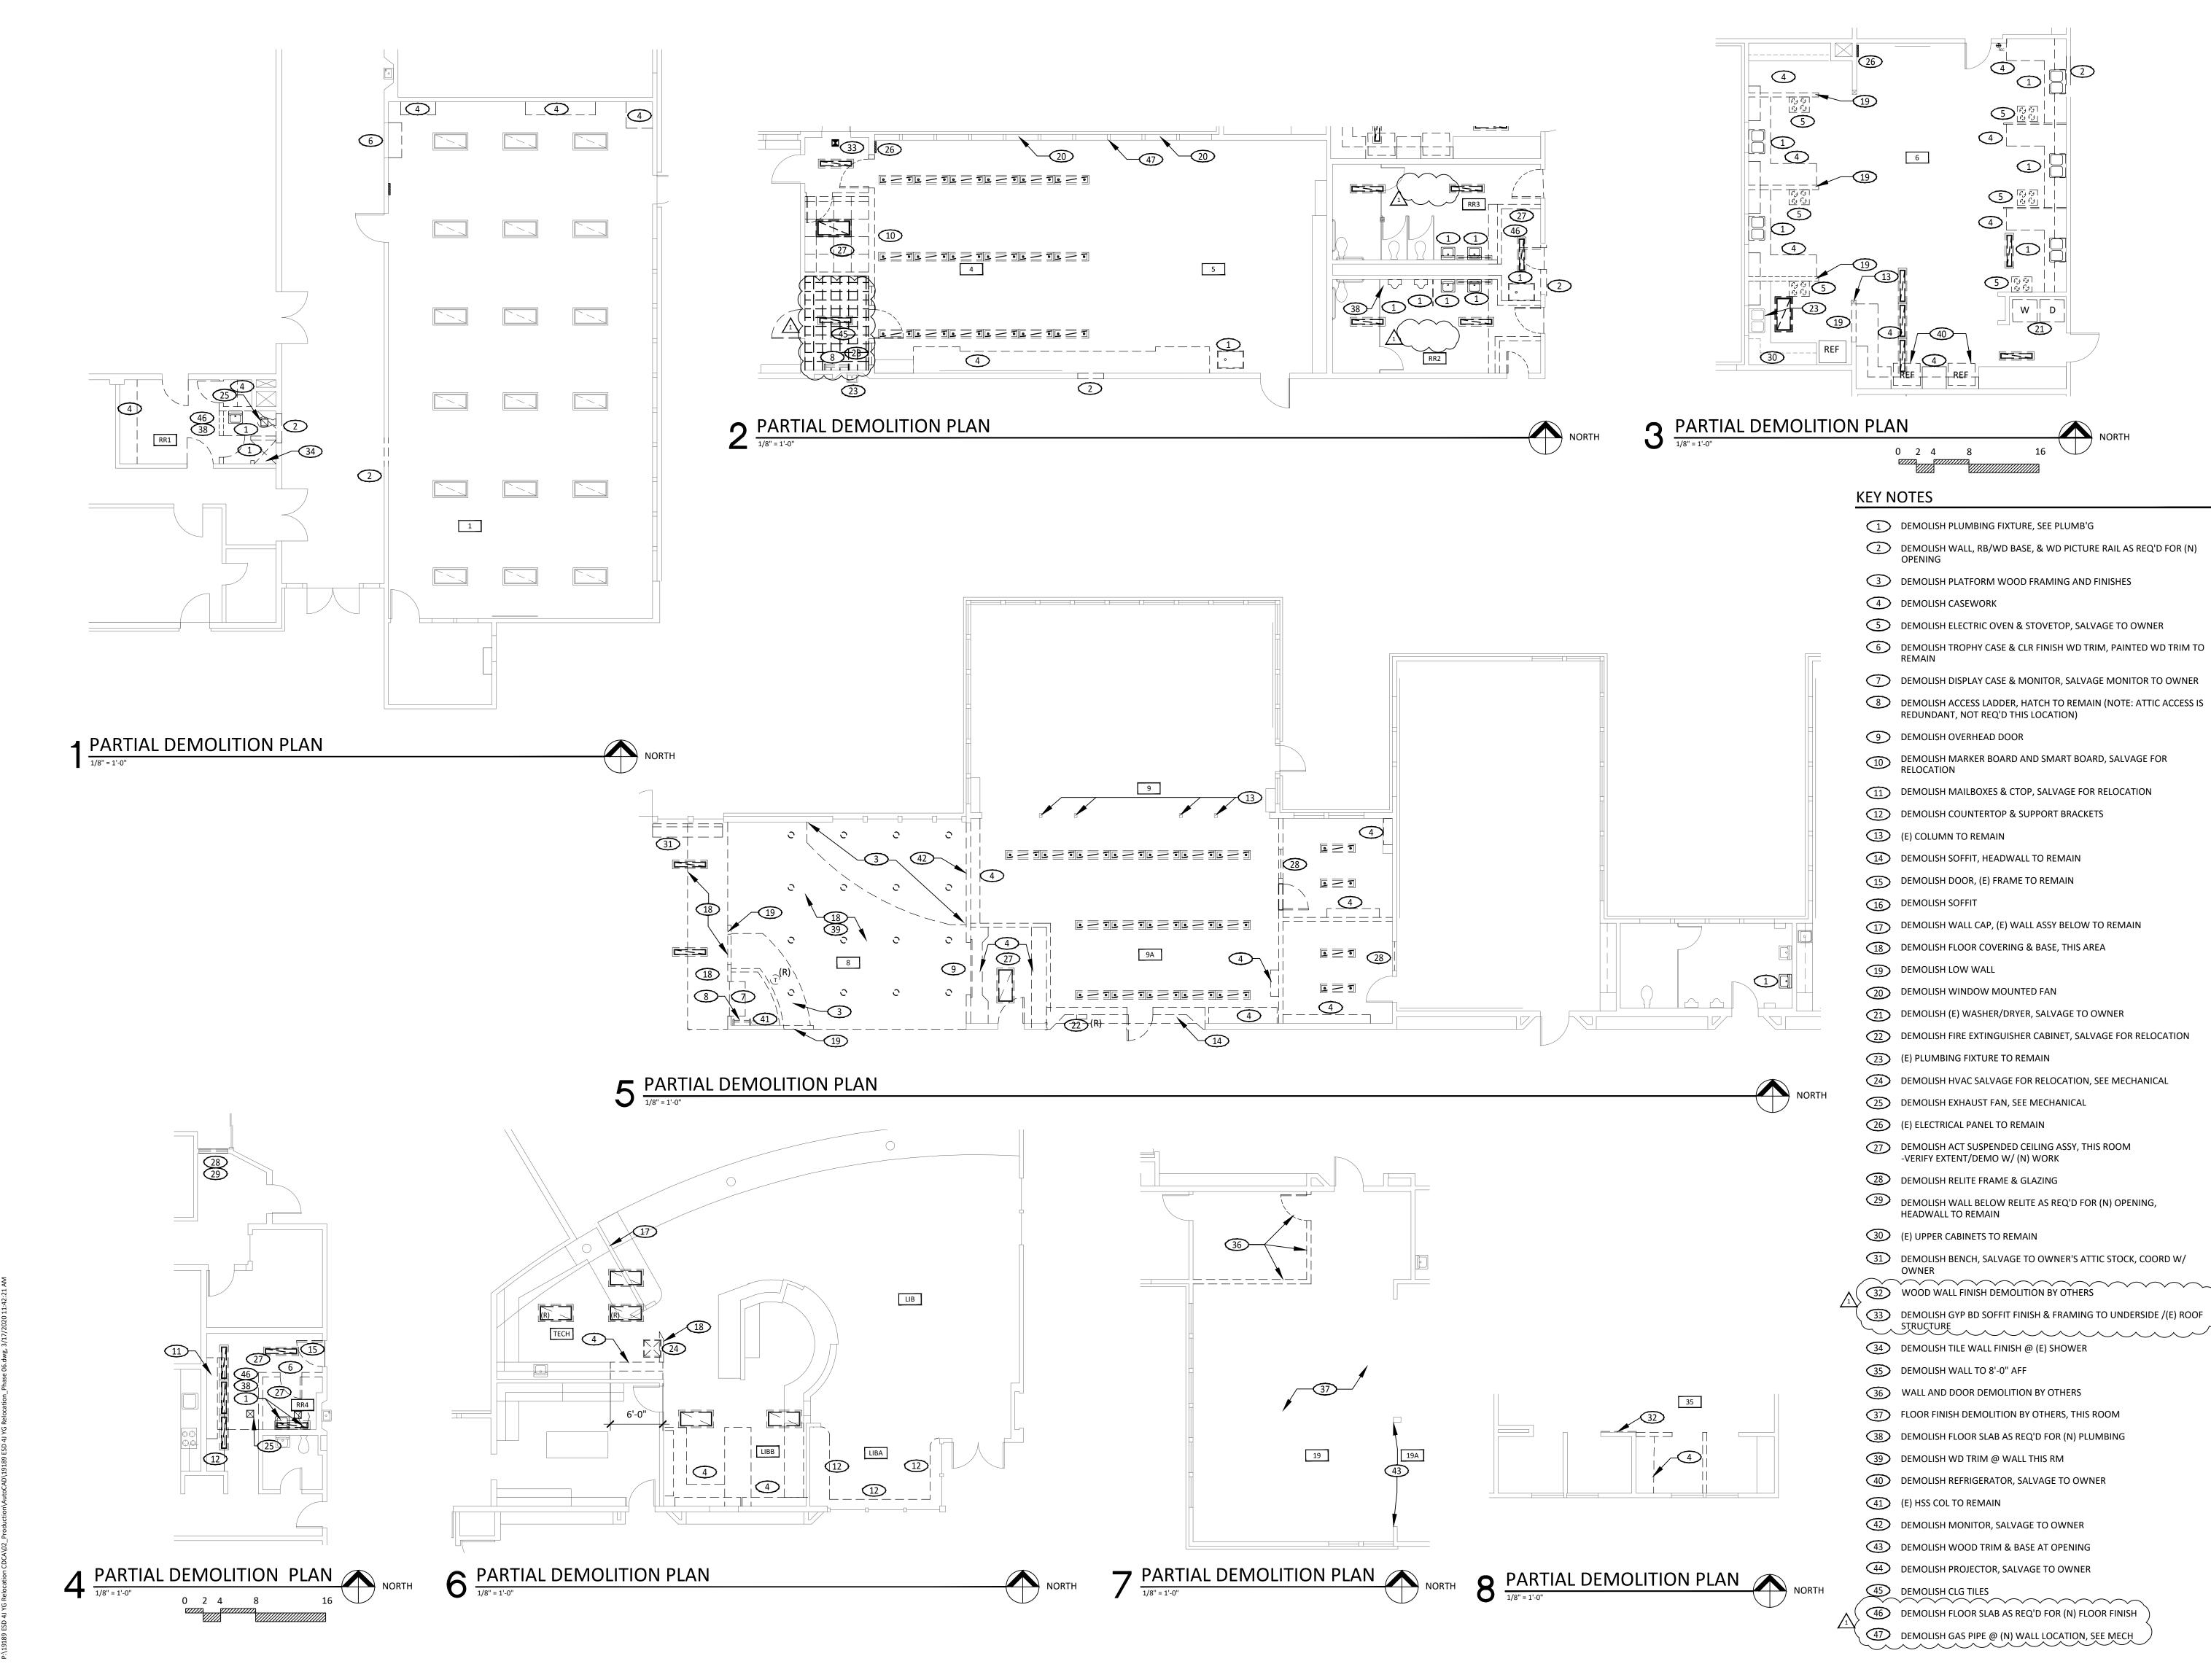



Eugene / Oregon / 97401

p 541.344.9157 gma-arch.com

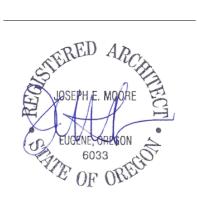

REVISIONS

3/17/2020 ADD. 1

PROVEMENT

4

EUGENE OR S 850 HOWARD AV CONSTRUCTION I

JOB NO: 19189 ISSUE DATE: 3/3/2020

> PARTIAL DEMOLITION









850 HOWARD AVE, EUGENE OR 97404 CONSTRUCTION DOCUMENTS

ESD JOB NO: ISSUE DATE: 19189 3/3/2020

OVERALL

FLOOR PLAN

LIB

19A

7/A214

GYMNASIUM

10

13


CASEWORK STAGING AREA
 -OWNER WILL DEPOSIT
 CASEWORK @ CAFETERIA FOR
 REINSTALLATION BY
 CONTRACTOR

1

KEY NOTES


- 1 NO WORK THIS ROOM
- 2 (E) CASEWORK
- (E) MARKER BOARD TO REMAIN
- (E) SMART BOARD
- (E) PROJECTOR SCREEN
- (N) 1" INSULATED GLAZING W/ WD STOPS, PS FINISH)
- 7 DASHED LINE INDICATES EXTENT/VCT FLOOR FINISH PATCH WHERE CASEWORK DEMOLISHED
- 8 (N) CPT-1 FLOOR FINISH & RB-1 BASE
- (R) SMART BOARD
- (N) WALL MOUNT SHORT THROW PROJECTOR CHAMFER & PAINT EXPOSED ENDS OF WD BASE & WD PICTURE RAIL TO
- (N) PLUMBING FIXTURE, SEE PLUMBING

- PROVIDE (N) PAINT SYSTEM THIS ROOM, SEE ALSO FINISH SCHEDULE
- (N) WALL MOUNTED SMART BOARD
- (N) PAPER TOWEL DISPENSER
- (E) DRINKING FOUNTAIN
- 17 FURR OUT ELECTRICAL DEVICES TO BACK/CASEWORK WHERE CASEWORK RELOCATE OCCURS, SEE ALSO SCHEDULE
- (E) CEILING MOUNTED PROJECTOR
- (N) MARKER BOARD, SEE 5/A800 FOR TYP DIMENSIONS & MOUNTING
- (E) ELECTRICAL PANEL
- (R) WD RAIL W/ COAT HOOKS
- -VFY HEIGHT & LOCATION W/ OWNER
- (N) OWNER FURNISHED SLIM JIM RESIN TYPE TRASH CAN -PROVIDE PAINTED METAL FRENCH CLEAT ATTACHMENT BAR W/ CONCEALED FASTENERS
- 23 PROVIDE BACKING AS REQ'D TO FURR CASEWORK BEYOND (E) ELECTRICAL RACEWAY WHERE CASEWORK RELOCATE OCCURS, SEE ALSO ELECTRICAL AND SCHEDULE
- 24 PATCH FLOOR & BASE WHERE CASEWORK DEMOLISHED
- 25 INFILL WALL WHERE TROPHY CASE DEMOLISHED -PAINTED TRIM TO REMAIN
- (N) CLG MOUNT PROJECTOR @ (E) POLE MOUNT
- (E) TACK BOARD
- (N) FLOOR FINISH AS REQ'D BY DEMOLITION, SEE ALSO FINISH
- (R) OFCI CASEWORK, SEE SCHEDULE REFER TO DETAIL 4-A800 FOR TYP INSTALLATION REQ'S

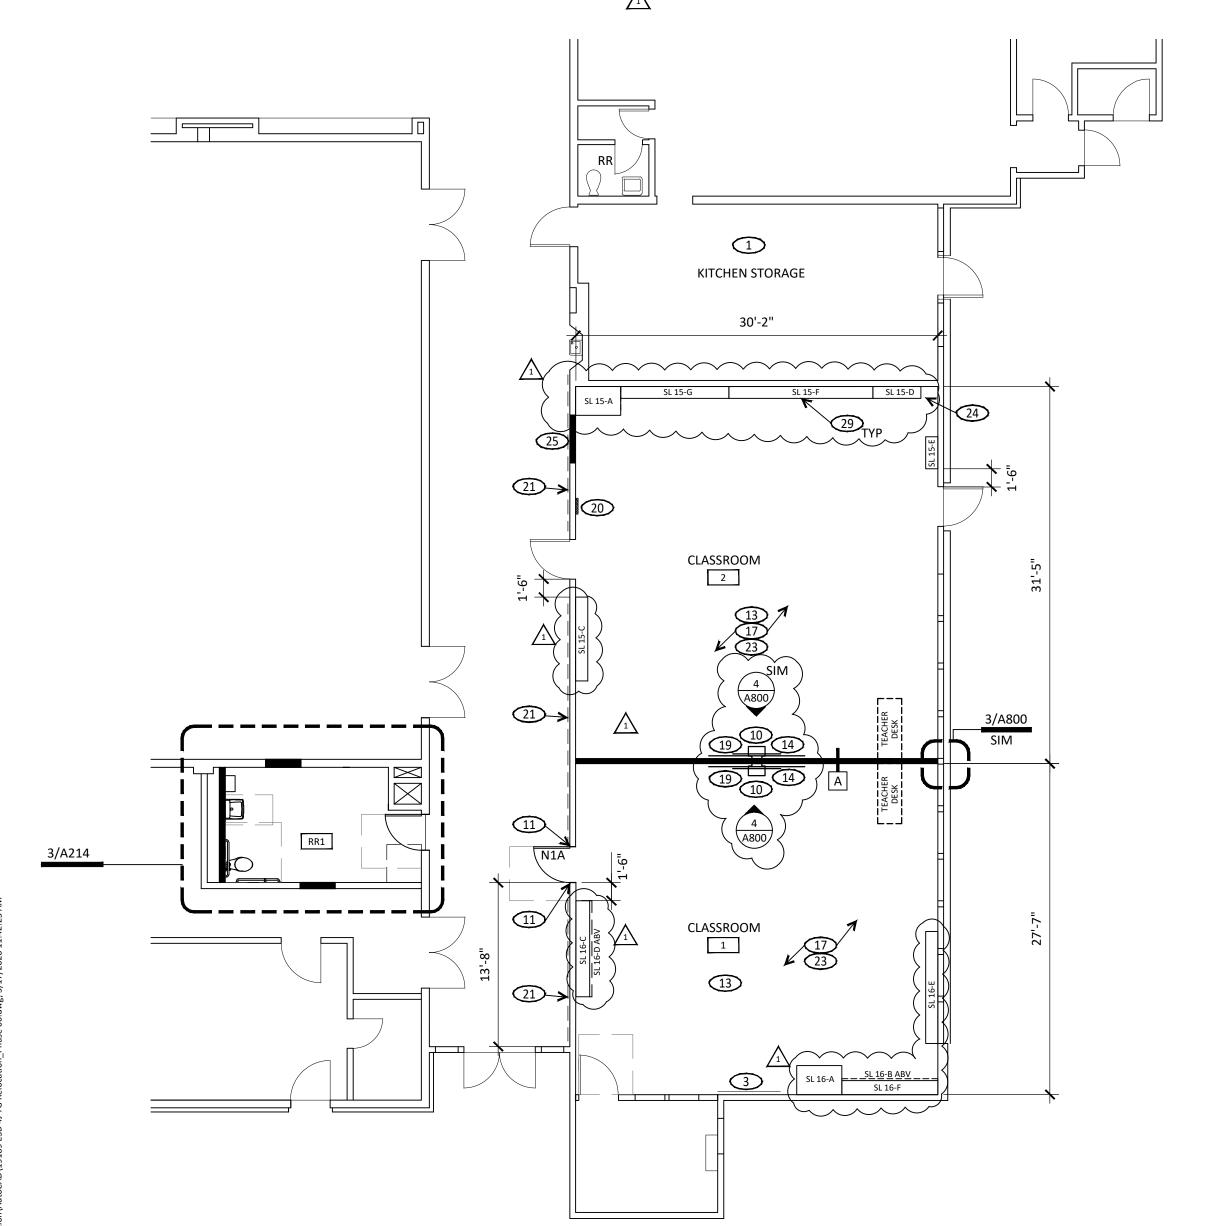


1 ENLARGED PARTIAL FLOOR PLAN

1/8" = 1'-0"

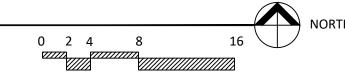






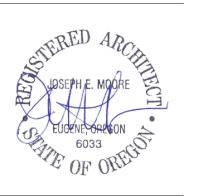

REVISIONS 3/17/2020 ADD. 1

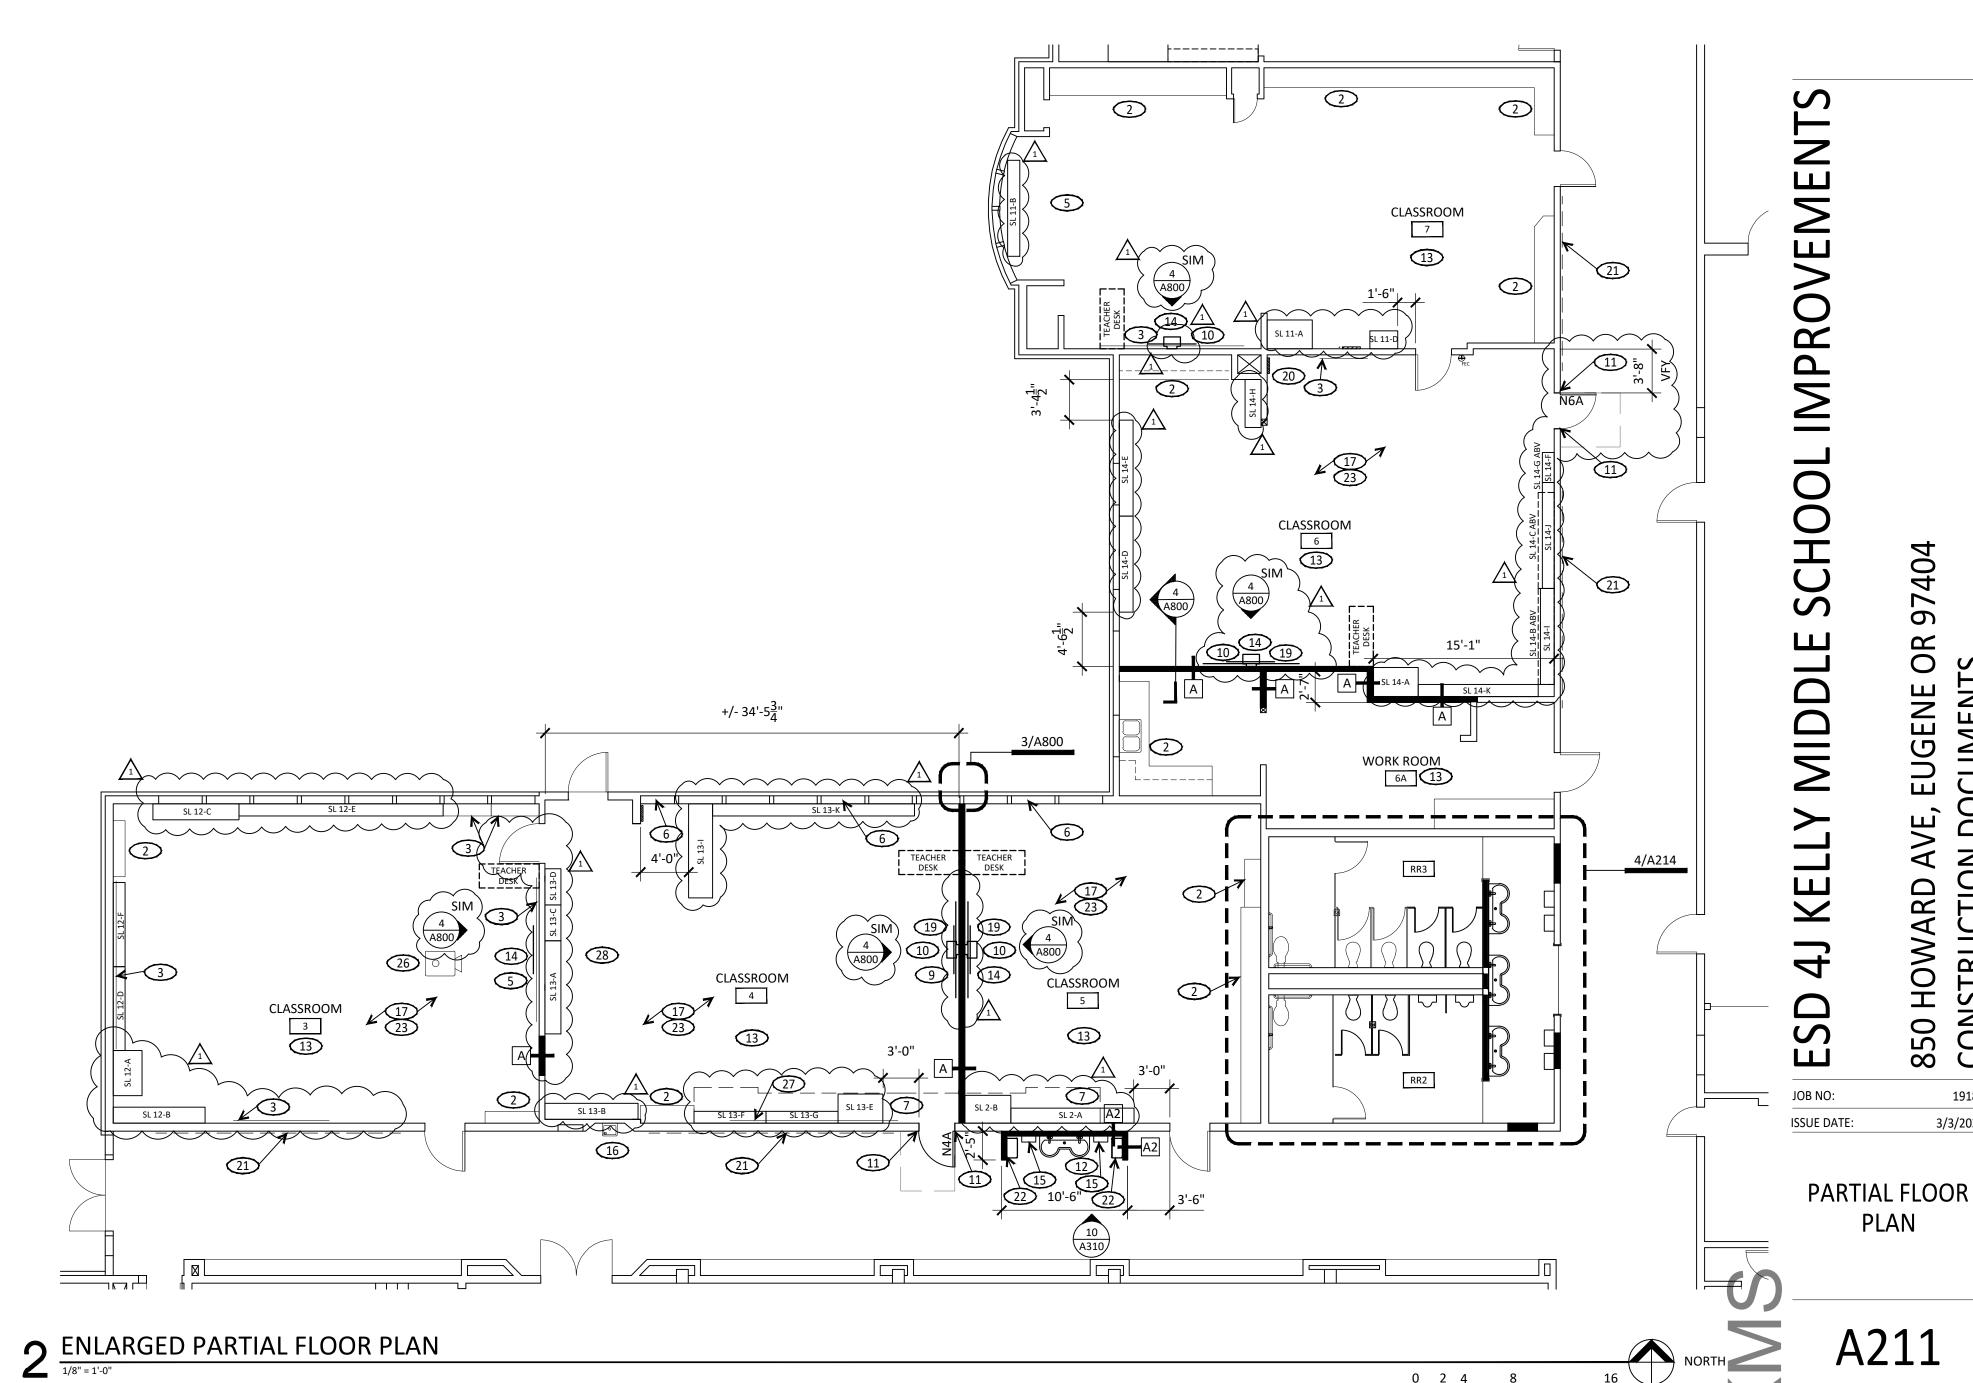

PLAN

3/3/2020

- 1 NO WORK THIS ROOM
- (E) CASEWORK
- (E) MARKER BOARD
- 4 (E) SMART BOARD
- (E) PROJECTOR SCREEN
- (R) MAILBOXES & CTOP
 -PROVIDE (N) HEAVY DUTY ANGLE BRACKET @ 36" OC MAX
- 7 CENTER (N) WALL ASSY ON (E) MULLION
- 8 INFILL WALL WHERE OPENING DEMOLISHED TO MATCH ADJACENT ASSEMBLY
- (N) HM CASED OPENING, SEE ALSO DOOR SCHEDULE
- 10 PATCH FLOOR AS REQ'D BY DEMOLITION
- (R) WD RAIL W/ COAT HOOKS -VFY HEIGHT & LOCATION W/ OWNER
- (N) CPT FLOOR FINISH & RB THIS ROOM, SEE ALSO FINISH SCHEDULE
- (N) MARKER BOARD
- (E) COLUMN TO REMAIN, ALIGN FINISHES THIS SIDE/COLUMN
- (N) CLG MOUNT PROJECTOR @ (E) POLE MOUNT
- 16 (E) DRINKING FOUNTAIN
- PROVIDE (N) PAINT SYSTEM THIS ROOM, SEE ALSO FINISH SCHEDULE
- PROVIDE RB/WD BASE & WD PICTURE RAIL W/PS FINISH TO MATCH ADJACENT CORRIDOR WALL ASSEMBLY

OFFICE 1

OFFICE 1

NURSE

1

RESTROOM 1

- 19 ALIGN (N) FINISHES W/(E) ASSY
- (N) GYP BD & PS WALL FINISH THIS SIDE/(E) WALL
- 21) WRAP (E) PIPE COLUMN W/(N) WALL TYPE A
- FURR OUT ELECTRICAL DEVICES TO BACK/CASEWORK WHERE CASEWORK RELOCATE OCCURS, SEE ALSO SCHEDULE

- (N) WALL MOUNTED SHORT THROW PROJECTOR
- (N) 5'-0" X 8'-0" MARKER BOARD
- (E) CEILING MOUNT PROJECTOR
- (N) WALL MOUNT SMART BOARD
- 27 PROVIDE BACKING AS REQ'D TO FURR CASEWORK BEYOND (E) ELECTRICAL RACEWAY WHERE CASEWORK RELOCATE OCCURS, SEE ALSO
- **ELECTRICAL AND SCHEDULE**
- (E) RELITE TO REMAIN (E) TACKBOARD TO REMAIN 1

OFFICE \bigcirc

CONF 1

1

1

STAFF ROOM

6 -----

OFFICE 1

2

(30) (N) WD VENEER CASEWORK W/ ADJUSTABLE SHELVES & PLAM CLAD CTOP & BACKSPLASH

H1

18

TEACHER DESK

 $\overline{3}$

SL P4-R

13

OFFICE 1

1

12 1

SL P4-J SL P4-K

SL P4-G

SL P4-E

BOILER

1

UTIL 1

SL P4-I


SL P4-F

1

1

(N) WD VENEER UPPER CABINETS W/ ADJUSTABLE SHELVES



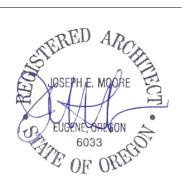

gma-arch.com

REVISIONS <u>√</u>1 3/17/2020 ADD. 1

850 HOWARD AVE, EUGENE OR 97404 CONSTRUCTION DOCUMENTS JOB NO: 19189

3/3/2020

PARTIAL FLOOR PLAN

ISSUE DATE:

~~~<u>~~</u>

CLASSROOM

12

17

27

27

CLASSROOM

13

25 17

3

4

OFFICE

1

SL 9-D

(3)

RESTROOM

OFFICE

1

RR5

25

27

CLASSROOM

11

17

SL 17-A SL 17-C SL 17-B

2

28 OFFICE

2>

4

3 **←**2

**←**2

OFFICE 1

29

CLASSROOM

18 7

1

OFFICE

1

OFFICE

 $\bigcirc$ 

1 ENLARGED PARTIAL FLOOR PLAN

1/8" = 1'-0"

1 NO WORK THIS ROOM

(E) SMART BOARD

PROVIDE PLAM CLAD END PANEL WHERE CASEWORK DEMOLISHED -MODIFY CTOP & BACKSPLASH AS REQ'D

4 EXTEND (E) LOW WALL TO UNDERSIDE/CEILING, SEE ALSO ELEVATIONS & DETAILS

(N) WALL MOUNT SHORT THROW PROJECTOR

6 (E) ELEC PANEL

(E) MARKER BOARD

8 (N) MARKER BOARD

9 (E) DRINKING FOUNTAIN

NOT USED NOT USED

(N) WALL MOUNT SMART BOARD

(E) CASEWORK

PROVIDE (N) PAINT SYSTEM & RESILIENT BASE TO MATCH (E) THIS WALL

PROVIDE (N) PAINT SYSTEM THIS ROOM, SEE ALSO FINISH SCHEDULE

(N) FLOOR COVERING & BASE, SEE FINISH SCHEDULE

(E) CEILING MOUNT PROJECTOR

SUPPORT CUT END/CTOP @ (N) WALL W/ (N) WD LEDGER

18) PATCH WALL WHERE CASEWORK DEMOLISHED

(N) HORIZONTAL LOUVER BLINDS



gma-arch.com



**REVISIONS** 3/17/2020 ADD. 1

LIBRARY LIB

RR 1

CLASSROOM

19A

14

RR 1

JOB NO: 19189 ISSUE DATE: 3/3/2020

PARTIAL FLOOR PLAN

COPYRIGHT GMA ARCHITECTS

1 ENLARGED PARTIAL FLOOR PLAN

1/8" = 1'-0"

BEST 1

CLASSROOM

OFFICE 1

OFFICE JAN 1

OFFICE 1

CLASSROOM

19
15
14

1

CLASSROOM 1

CLASSROOM 1

OFFICE 1

OFFICE 1

- (N) PLUMBING FIXTURE, SEE PLUMB'G
- 2 NO WORK THIS ROOM
- (N) INFILL WALL WHERE OPENING DEMOLISHED
  -PROVIDE RB/WD BASE & WD PICTURE RAIL W/PS FINISH TO MATCH
  ADJACENT CORRIDOR WALL ASSEMBLY
- (N) TOILET COMPARTMENT, SEE ELEVATIONS
- (N) FLOOR DRAIN, SEE PLUMB'G
- 6 (N) FLOOR COVERING & BASE, SEE FINISH SCHEDULE
- (N) ELECTRIC HAND DRYER, SEE ALSO ELEVATIONS
- 8 PROVIDE (N) PAINT SYSTEM THIS ROOM, SEE ALSO FINISH SCHEDULE
- 9 CHAMFER & PAINT EXPOSED ENDS OF WD BASE & WD PICTURE RAIL TO MATCH EXISTING
- (N) 18" DEEP URINAL PARTITION, SEE ALSO ELEVATIONS
- 11 PATCH SUBFLOOR WHERE SHOWER DEMOLISHED
- 12 PATCH GYP BD WHERE TILE DEMOLISHED
- OMIT GYP BD AND RC CHANNEL THIS SIDE/WALL
- WHERE CONCRETE DEMOLITION OCCURS FOR (N) TRENCHING, INFILL SLAB OVER VAPOR BARRIER TO MATCH EXISTING DEPTH, 12" LONG #4 DOWELS TO (E) SLAB 24" OC, 6" EMBED TO (E)
- 15 PATCH FLOOR TILING FINISH WHERE DEMOLITION OCCURS
- 16 PATCH WALL WHERE WD FINISH DEMOLISHED
- (N) MARKER BOARD
- (N) WALL MOUNT SMART BOARD
- (N) MORTISE LOCKSET W/ OCCUPANCY INDICATOR -PREP (E) SCWD AS REQ'D, SEE ALSO DOOR SCHEDULE
- 20 INFILL TO UNDERSIDE OF CEILING ABOVE CMU LOW WALL
- 21 PROVIDE (N) PAINT SYSTEM EA SIDE/THIS WALL, SEE FINISH SCHEDULE
- (N) ACCESS PANEL
- (N) PAPER TOWEL DISPENSER
- RE-ESTABLISH MORTAR BED AS REQ'D BY FLOOR DEMOLITION
- (N) HEAVY DUTY ANGLE BRACKETS @ 36" MAX OC @ (E) CTOP -REGLUE PLAM FACE/(E) CTOP
- (E) TEMPERED GLAZING TO REMAIN


(E) HAND DRYER TO REMAIN


- (E) MÅRKER BÖARD
- (N) POLE MOUNT CLG PROJECTOR
- 30 PROVIDE RESTROOM SIGNAGE W/BRAILLE & UNIVERSAL SYMBOL FOR ACCESSIBILITY 48" MIN A.F.F & 9" OFF DOOR JAMB


4 RESTROOM 2 & 3 ENLARGED FLOOR PLAN

1/4" = 1'-0"


- 31 FULL HEIGHT STAINLESS STEEL CORNER GUARD
- 32 FLUSH TRANSITION TO (E) FLR FINISH

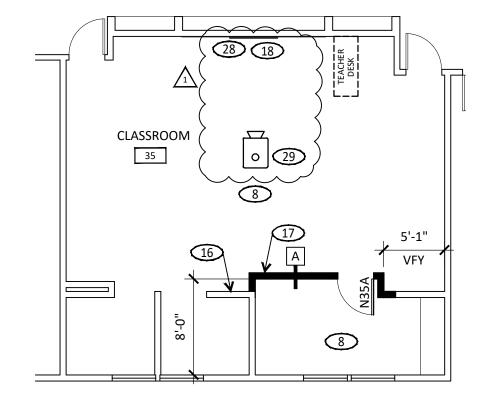


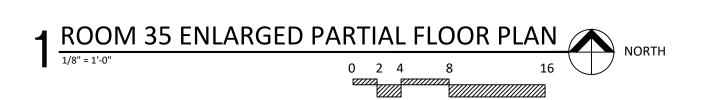


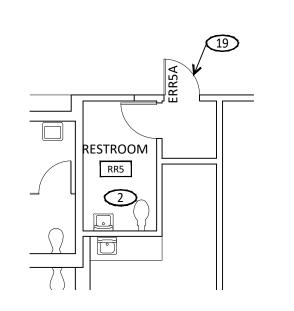




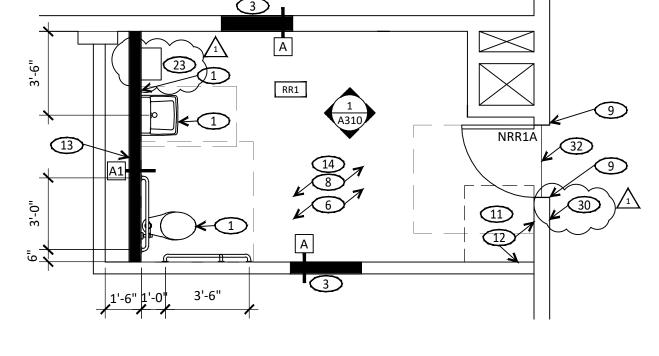


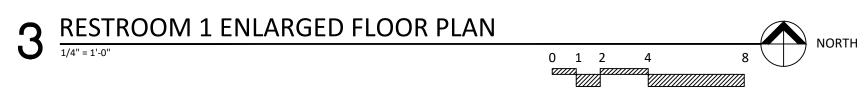

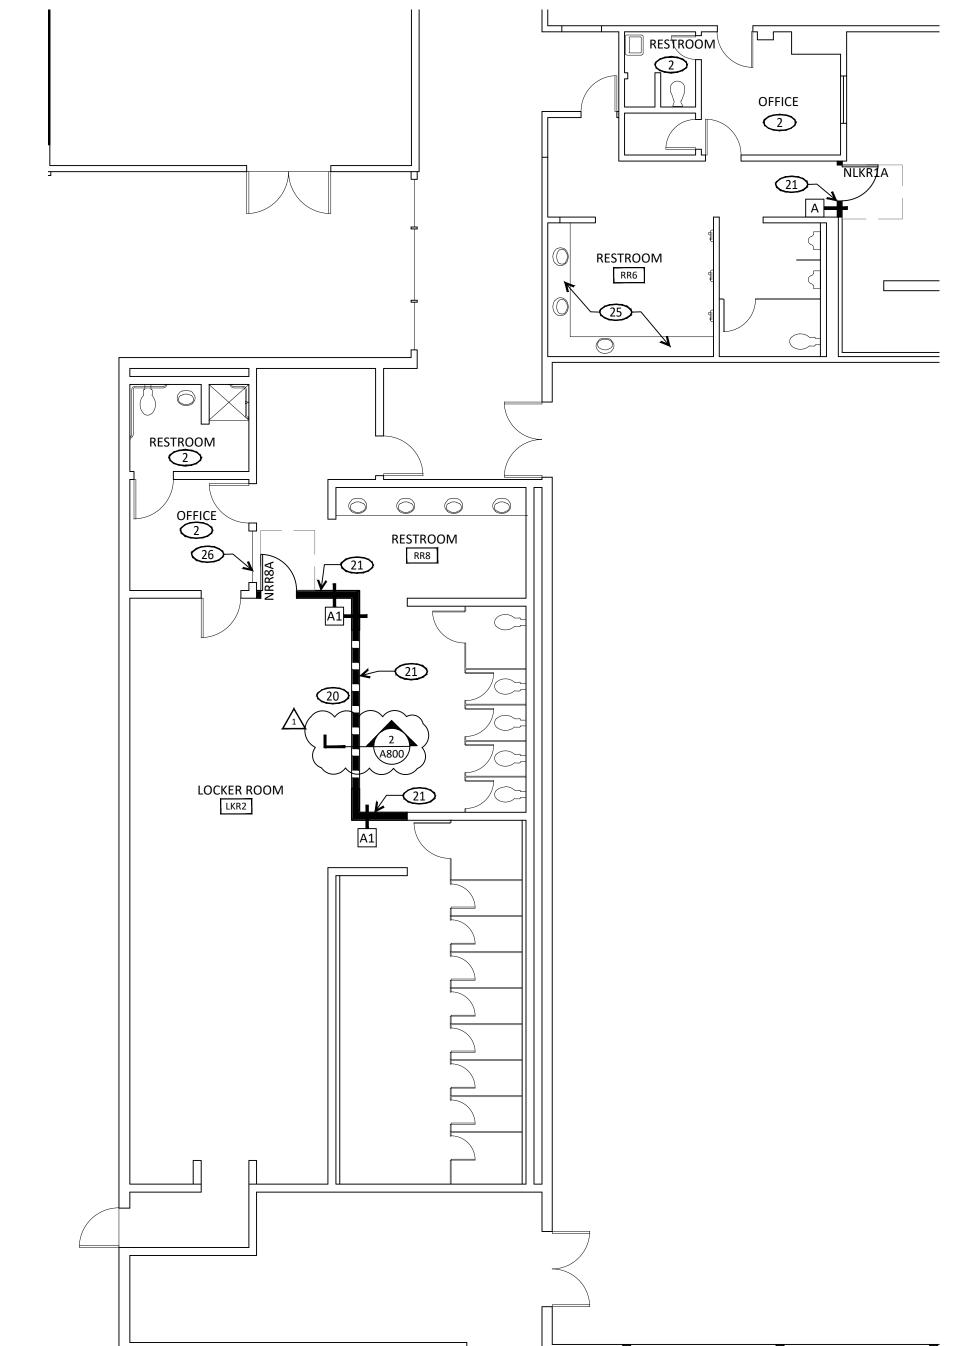

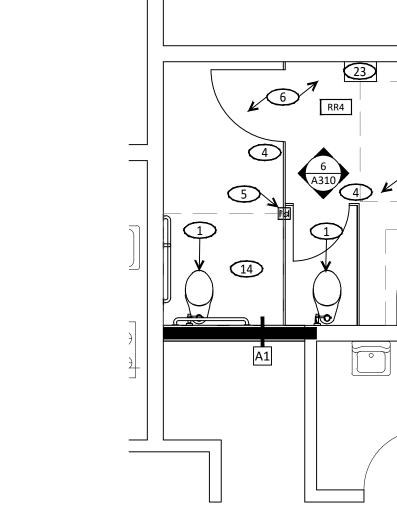



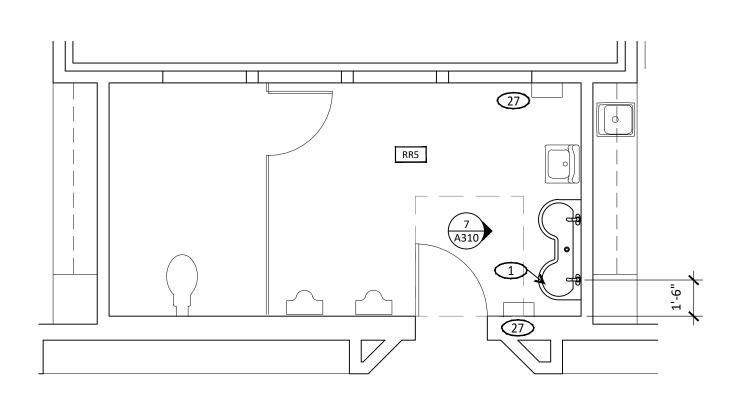


6 RESTROOM 5 ENLARGED FLOOR PLAN

1/4" = 1'-0"



7 ENLARGED PARTIAL FLOOR PLAN

1/8" = 1'-0"

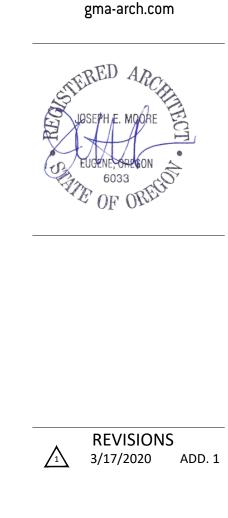

**GMA ARCHITECTS** 

860 West Park Street / Ste 300

Eugene / Oregon / 97401

p 541.344.9157

**PROVEMENT** 

ISSUE DATE: 3/3/2020 PARTIAL FLOOR PLAN

JOB NO:

- 1 PATCH CEILING TILE AS REQ'D FOR (N) WORK, MATCH (E)
- 2 MODIFY (E) HVAC SYSTEM AS REQ'D BY (N) WORK THIS AREA

14

11

13

19

1 2 19A

LKR2






REVISIONS


4) KELLY MIDDLE SCHOOL IMPROVEMENTS

HOWARD AVE, EUGENE OR 97404

JOB NO: 19189
ISSUE DATE: 3/3/2020


REFLECTED CEILING PLAN

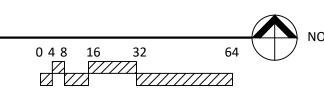

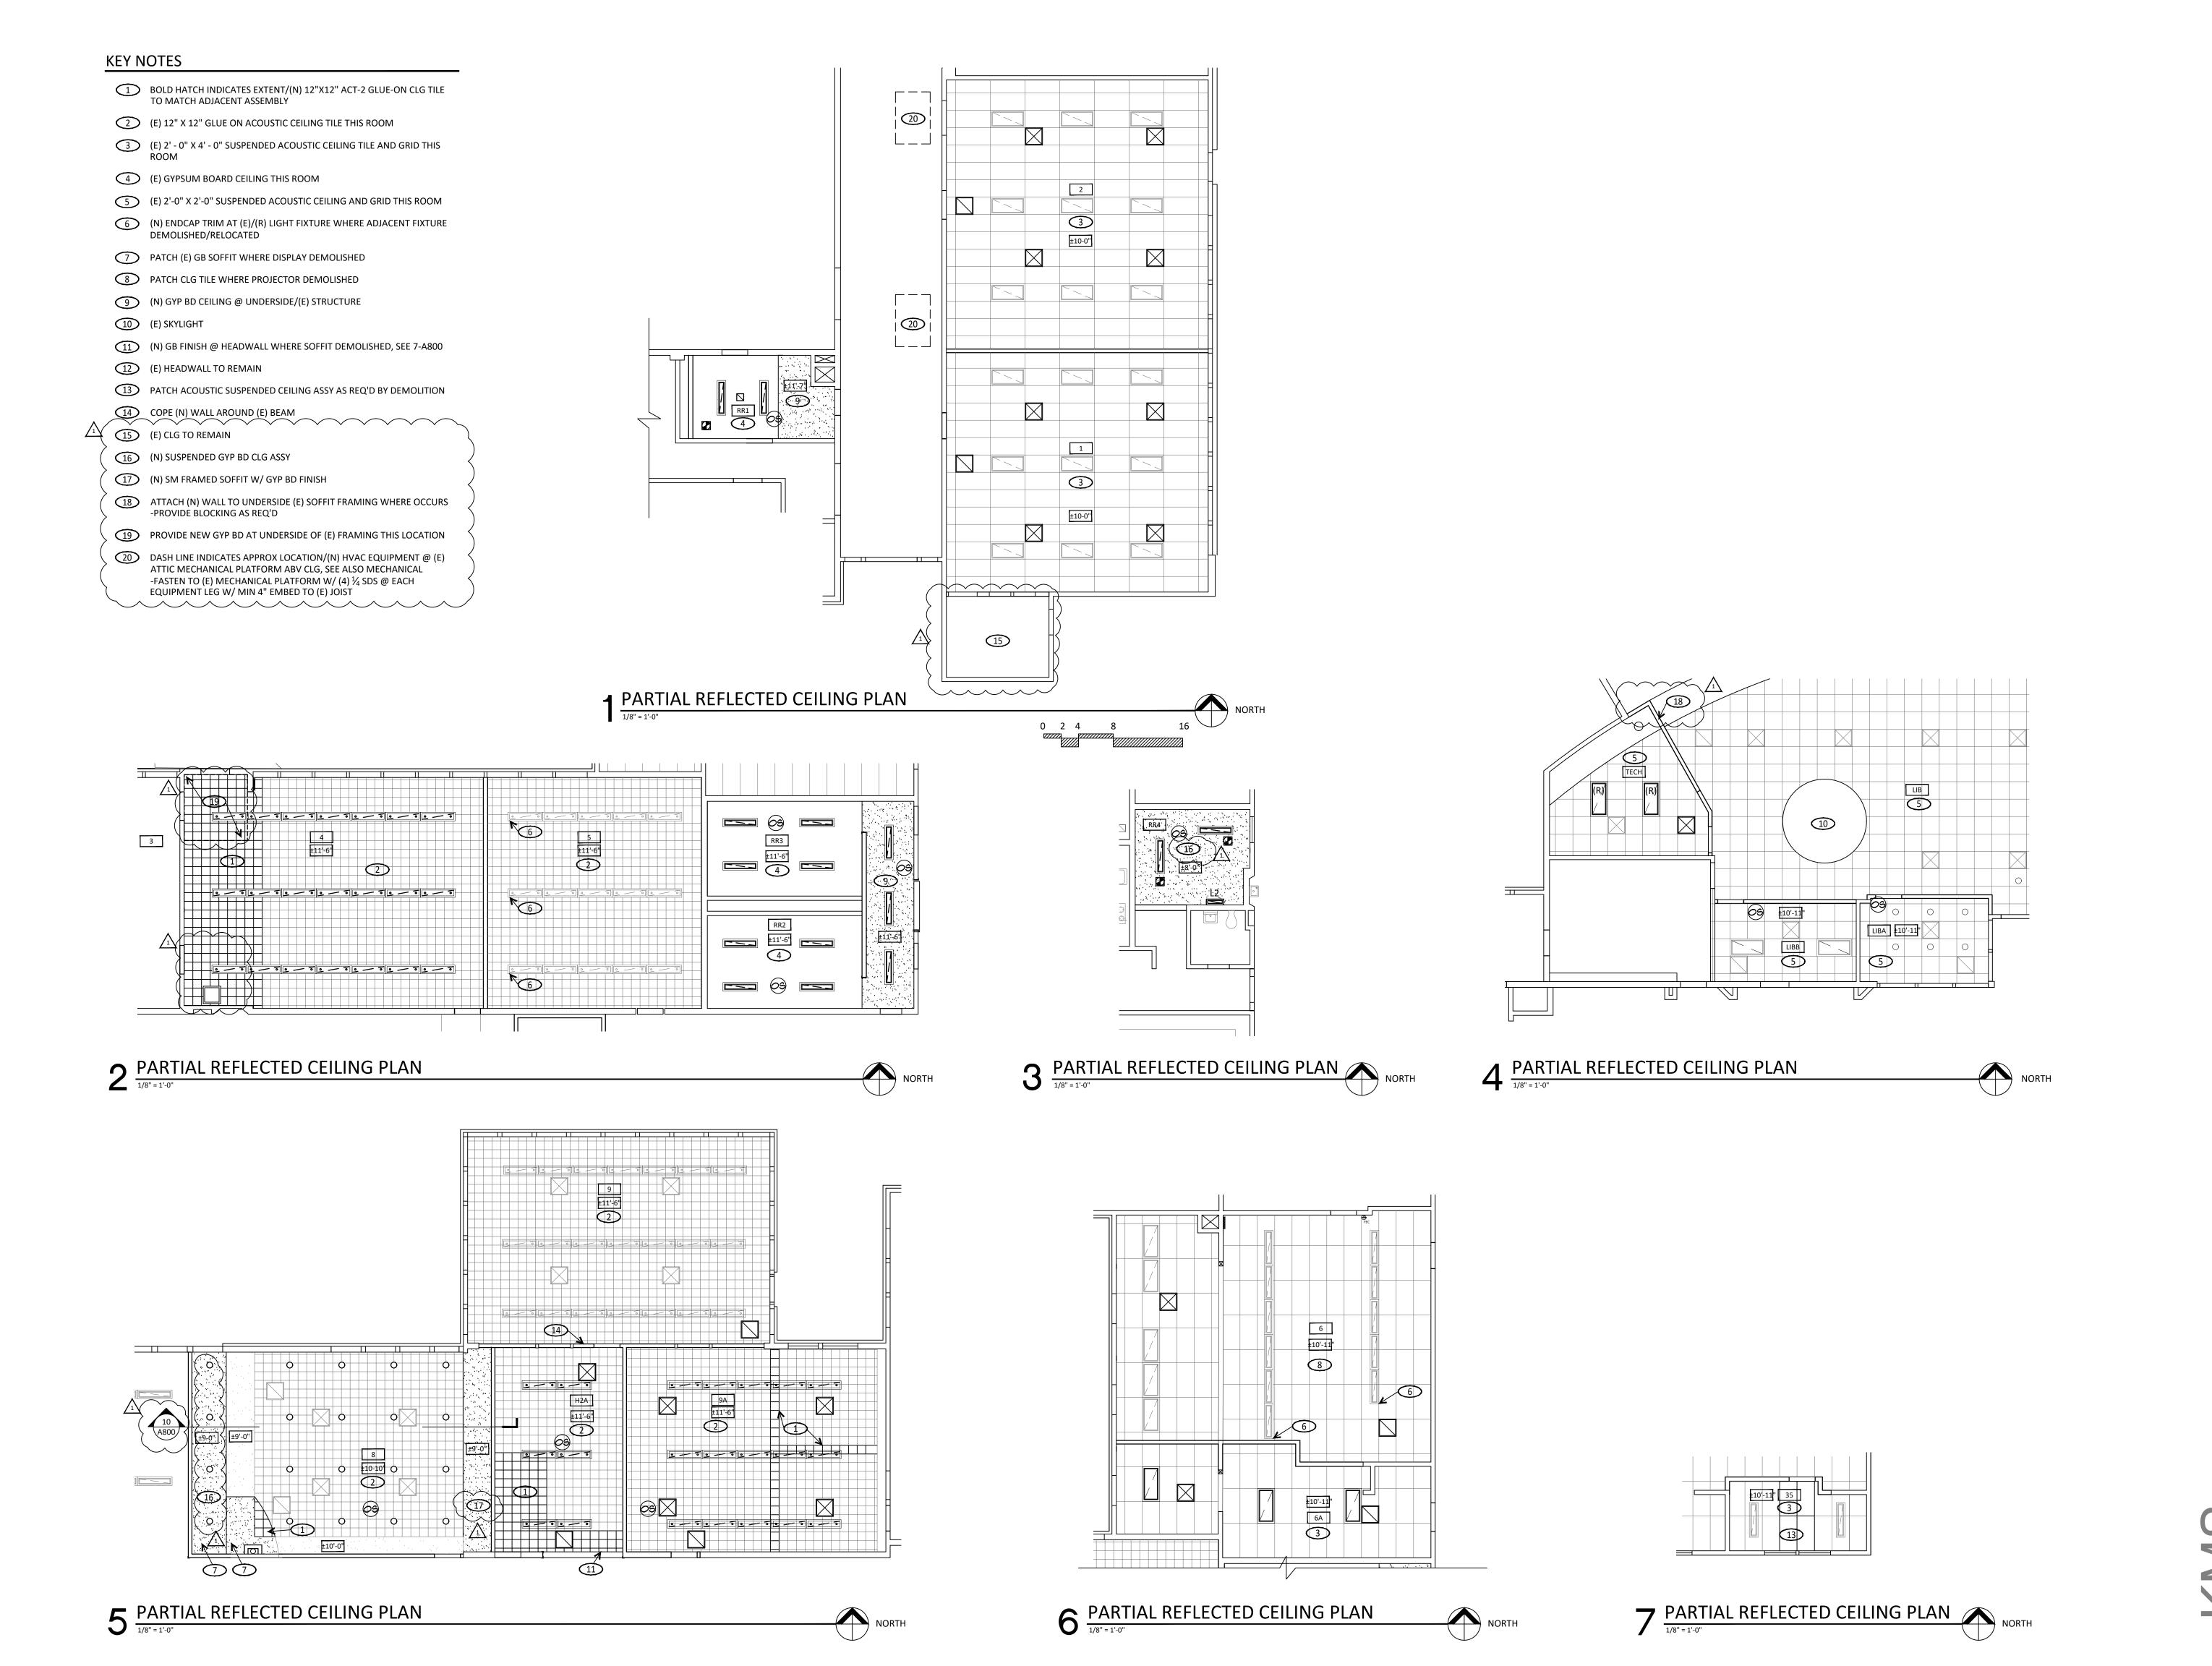

GMA ARCHITECTS
860 West Park Street / Ste 300
Eugene / Oregon / 97401
p 541.344.9157

gma-arch.com

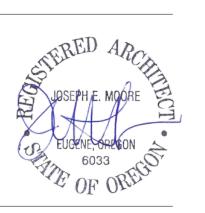

REVISIONS
3/17/2020 ADD. 1

4) KELLY MIDDLE SCHOOL IMPROVEMENT

PARTIAL REFLECTED CEILING PLAN


JOB NO:

ISSUE DATE:

850 HOWARD AVE, EUGENE OR CONSTRUCTION DOCUMENTS

3/3/2020

A221

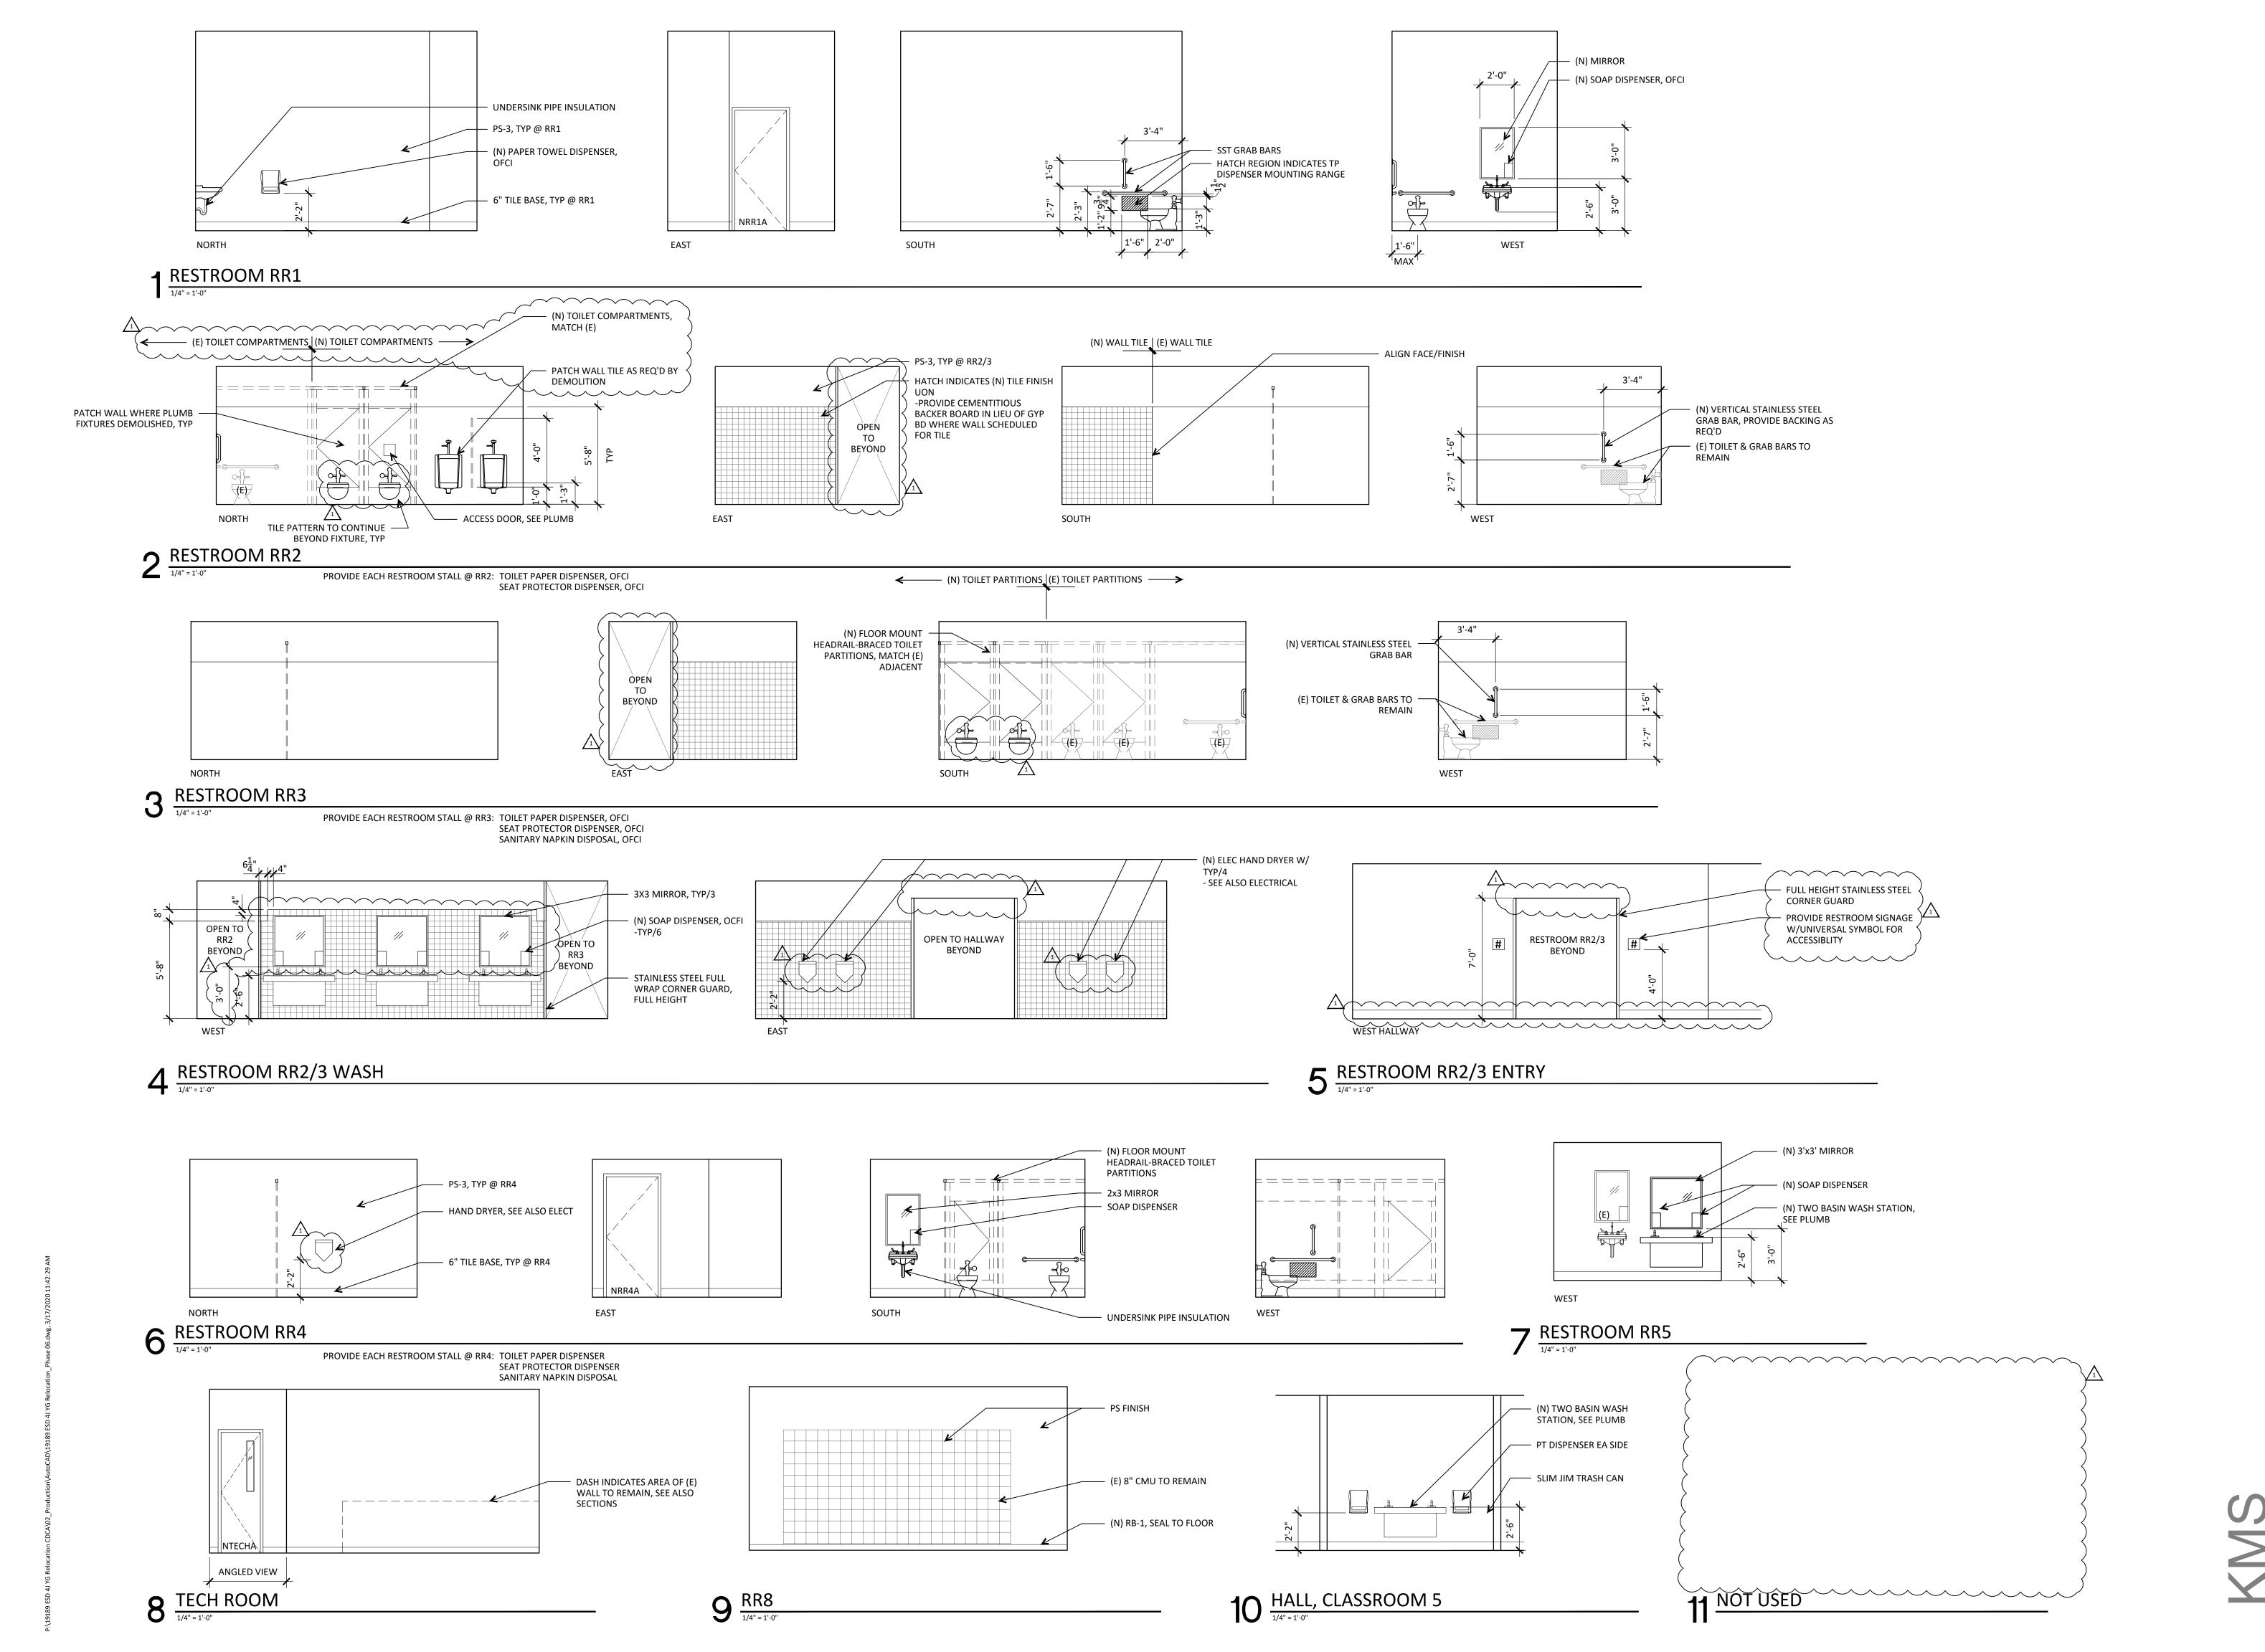

**GMA ARCHITECTS** 860 West Park Street / Ste 300 Eugene / Oregon / 97401 p 541.344.9157

gma-arch.com





REVISIONS 3/17/2020 ADD. 1

**PROVEMENTS** SCHOOL

O AVE, EUGENE OR SON DOCUMENTS 850 HOWARD AV CONSTRUCTION [ 19189

INTERIOR **ELEVATIONS** 

3/3/2020

JOB NO:

ISSUE DATE:

A310

COPYRIGHT GMA ARCHITECTS

A700

DOOR SCHEDULE





OR IS

NOTES

PATCH WALL AS REQ'D BY DEMOLITION, MATCH EXISTING TILE COLOR MIX

PATCH FLOORING, CEILING, & WALLS AS REQ'D BY DEMOLITION

PATCH ACT-1 AS REQ'D BY LIGHT FIXTURE & DIFFUSER RELOCATION

COMMENTS

SEE ELEVATIONS, MATCH EXISTING TILE COLOR MIX

PATCH FLOORING @ CLASSROOM ENTRY

PATCH CPT-2 @ (N) TECH OFFICE WALL ASSY

FINISH SCOPE @ NEW WALL ASSY

FINISH SCOPE @ NEW WALL ASSY

HM CASED OPENING. VFY DIMS

MATCH DR

FR1

FRAME TYPES

& (E) WALL

SOLID BACKING

AS REQ'D

ADD'L SCOPE

- (R) CASEWORK

B CASEWORK FURRING DETAIL

3/4" = 1'-0"

- HORIZONTAL WD FURRING

-PROVIDE @ TOP, BTM, & EVERY

36" OC MAX BTWN (R) CABINET

- FASTEN (R) CASEWORK W/ #12

MAX, 1-1/2" MIN EMBED TO

(E) RACEWAY, SEE ELECT FOR

-PROVIDE MOUNTING SUPPORT

WD SCREWS W/ WASHER 24" OC

STRIP, MIN 3/4" DEPTH

 $\sqrt{1}$  3/17/2020 ADD. 1

REVISIONS

**GMA ARCHITECTS** 860 West Park Street / Ste 300

p 541.344.9157

gma-arch.com

FINISH PS-3 Eugene / Oregon / 97401 (E) PS-2 PS-2 GB PS-2 (E) PS-2 PS-2 PS-2 (E) PS-2 PS-2 PATCH FLOORING AS REQ'D BY DEMOLITION PS-2 GB PS-2 (E) (E) PS-2 PS-2 PS-2 PS-2 (E) PS-2 GB PS-2 TBB / GB CT-1,2,3 / PS-3 (E) / TBB SEE ELEVATIONS, MATCH EXISTING TILE COLOR MIX CT-1,2,3 / PS-3 (E) PS-3 (E) (E) PS-3 PS-3

(E)

GB

GB

ACT-1

PS-3

\_

PS-2

HARDWARE SET

4A

HM PS 3

PS-3

PS-2

PS-2

PS-2

PS-3

PS-2

PS-2

PS-2

PS-2

PS-2

PS-2

PS-3

PS-2

lps |

PS

lps -

PS

lPS

(E)

(E)

(E)

(E)

GB

(E)

(E)

(E)

GB

(E)

(E)

(E)

GB

(E)

DOOR SCHEDULE

HM

Ιнм

Інм

lнм

Інм

Інм

Інм

MATERIAL

|        | ·//l |   |
|--------|------|---|
| VARIES |      | FASTEN (R) CASEN WD SCREWS W/ MAX, 1-1/2" MIN SOLID BACKING -PROVIDE MOUN AS REQ'D HORIZONTAL WD SUPPORT AS REQ MAX |
|        |      | (R) CASEWORK   |

FLUSH

**DOOR TYPES** 

TAL WD MOUNTING AS REQ'D AT 36" OC

TYPICAL (R) CASEWORK MOUNT, UON

3/4" = 1'-0"

CASEWORK W/ #12 VS W/ WASHER 24" OC " MIN EMBED TO MOUNTING SUPPORT

^^^^^^

VISION LITE HALF LITE

- NOMINAL DIMS INDICATED -STILE/RAIL CONFIG MAY VARY BY MFR, VFY W/ARCH

FR1 |HM

3'-0" 7'-0" 1-3/4" SCWD NLKR1A 7'-0" scwd NRR8A 3'-0" 1-3/4" ERR5A 

NOTES

2

4

RR2

RR3

6A

RR4

RR5

9A

10

12

13

LIB

LIBA

LIBB

TECH

19

19A

35

RR8

LKR2

4

4

4

4

CLASSROOM

CLASSROOM

CLASSROOM

CLASSROOM

RESTROOM

RESTROOM

**WORK ROOM** 

CLASSROOM

CLASSROOM

RESTROOM

RESTROOM

**CLASSROOM** 

**CLASSROOM** 

CLASSROOM

CLASSROOM

CLASSROOM

CLASSROOM

LIBRARY

CLASSROOM

CLASSROOM

CLASSROOM

RESTROOM

LOCKER ROOM

VCT-1

VCT-1

CT-4

CT-4

CT-4

CPT-1

CPT-1

CPT-1

CPT-1

CPT-1

RB-1

RB-1

CT-4

CT-4

CT-4

RB-1

RB-1

RB-2

RB-1

RB-1

RB-1

MARK

N9AA

NTECHA

NLIBAA

NLIBBA

(E)

GB

(E)

(E)

GB

(E)

(E)

(E)

GB

(E)

3'-0"

3'-0"

3'-0"

3'-0"

3'-0"

3'-0"

3'-0"

PS-3

PS-2

PS-2

PS-2

PS-3

PS-2

PS-3

PS-3

PS-2

PS-2

7'-0"

7'-0"

7'-0"

7'-0"

7'-0"

7'-0"

7'-0"

7'-0"

HEIGHT THICKNESS

1-3/4"

1-3/4"

1-3/4"

1-3/4"

1-3/4"

1-3/4"

A 8'-0" x 1'-2" x 3'4" 5'-0" x 1'-0" x 4'-0" A 8'-0" x 1'-2" x 3'-4" B 3'-3" x 2'-5" x 6'-2" C 3'-5" x 2'-9" x 2'-9" A 8'-0" x 10" x 2'-8" C | 12'-0" x 1'-0" x 3'-0" D 8'-0" x 2'-0" x 4'-4" E 8'-0" x 2'-0" x 4'-4" F 8'-0" x 2'-0" x 4'-4" G 8'-0" x 2'-0" x 4'-4" I 8'-0" x 2'-0" x 4'-4"

J 4'-0" x 2'-0" x 4'-4"

K 4'-0" x 2'-0" x 4'-4"

M 8'-0" x 1'-1" x 4'-4"

M1 8'-0" x 1'-1" x 2'-0" N 8'-0" x 1'-1" x 4'-4"

N1 | 8'-0" x 1'-1" x 2'-0" O 8'-0" x 1'-1" x 4'-4" O1 8'-0" x 1'-1" x 2'-0"

P 3'-6" x 1'-1" x 4'-4"

P1 8'-0" x 1'-1" x 2'-0"

Q 4'-1" x 1'-4" x 7'-1"

S 4'-0" x 2'-1" x 7'-3"

T |5'-1" x 1'-1" x 2'-8"

U 6'-0" x 1'-1" x 2'-8"

R SEE PLAN

Casework ID Size (LxDxH) 답 B 3'-5" x 2'-9" x 2'-9" S C 15'-11" x 1'6" x 2'-6"

|    |           |                        | <b>~~~~~</b> |
|----|-----------|------------------------|--------------|
| Ìa | sework ID | Size (LxDxH)           | NOTES        |
|    |           |                        |              |
|    |           |                        |              |
|    | Α         | 10'-3" x 1'-3" x 6'-7" |              |
|    | В         | 3'-10" x 2'-4" x 6'-8" |              |
|    |           |                        |              |
|    |           |                        |              |
|    | Α         | 3'-9" x 2'-5" x 6'-7"  |              |
|    | В         | 17'-2" x 1'-6" x 2'-3" |              |
| !  | С         | 9'-2" x 1'-6" x 2'-3"  |              |
|    | D         | 8'-0" x 1'-4" x 4'-11" |              |
|    | Е         | 6'-1" x 1'-4" x 6'-0"  |              |
|    |           |                        |              |
|    | A1        | 8'-1" x 2'-6" x 3'-0"  |              |
|    | A2        | 8'-1" x 1'-0" x 2'-8"  | 2            |
| ı  | B1        | 8'-1" x 2'-6" x 3'-0"  |              |
|    | B2        | 8'-1" x 1'-0" x 2'-8"  | 2            |
|    | С         | 17'-2" x 1'-2" x 2'-4" |              |
|    |           |                        |              |

5

4

D 9'-2" x 1'-2" x 2'-4"

E 4'-0" x 1'-0" x 4'-9"

A 3'-9" x 2'-5" x 6'-7"

B 8'-0" x 1'-0" x 3'-0"

D 2'-4" x 1'-6" x 6'-0"

A 3'-9" x 2'-5" x 6'-7"

B 7'-8" x 1'-4" x 5'-0"

C 7'-2" x 1'-4" x 3'-2"

E 17'-0" x 1'-0" x 2'-4"

F 7'-0" x 1'-0" x 4'-0"

A 7'-9" x 1'-4" x 5'-0"

B 7'-9" x 1'-4" x 3'-0" C 3'-0" x 1'-4" x 8'-0"

D 3'-0" x 1'-4" x 8'-0"

E 3'-9" x 2'-5" x 6'-7"

F 6'-0" x 1'-0" x 2'-6"

G 6'-0" x 1'-0" x 2'-6"

I 7'-10" x 2'-0" x 2'-6" J 7'-9" x 1'-4" x 5'-6"

A 3'-9" x 2'-5" x 6'-7" B 8'-0" x 1'-4" x 3'-3"

C 8'-0" x 1'-4" x 3'-3" D 8'-0" x 1'-2" x 3'-2"

E 8'-0" x 1'-2" x 3'-2"

F 2'-6" x 1'-0" x 4'-0"

H 4'-0" x 1'-4" x 6'-9"

I 8'-0" x 1'-2" x 3'-4"

J 8'-10" x 1'-0" x 2'-4"

K | 10'-0" x 1'-0" x 2'-4"

L 8'-0" x 1'-0" x 3'-4"

A 3'-9" x 2'-5" x 6'-7"

C 7'-0" x 1'-0" x 4'-0"

D 4'-0" x 1'-0" x 5'-0"

F | 12'-0" x 1'-0" x 2'-4"

G 9'-0" x 1'-0" x 2'-4"

A 3'-9" x 2'-5" x 6'-7"

B 8'-0" x 1'-4" x 3'-4"

D 8'-0" x 1'-4" x 3'-4"

E 9'-4" x 1'-0" x 2'-4"

F 8'-0" x 1'-2" x 3'-4"

A 3'-9" x 2'-5" x 6'-7"

B 4'-0" x 2'-0" x 6'-9"

C 4'-0" x 2'-0" x 6'-9"

E 10'-6" x 1'-3" x 3'-8" F 9'-4" x 1'-0" x 2'-4"

A 3'-9" x 2'-5" x 6'-7"

C 9'-4" x 1'-0" x 2'-4"

D 8'-0" x 1'-2" x 3'-4"

E1 8'-0" x 1'-4" x 6'-0"

E2 |8'-0" x 1'-4" x 2'-1"

F1 | 8'-0" x 1'-4" x 6'-0"

F2 | 8'-0" x 1'-4" x 2'-1"

1. SEE PLAN FOR CASEWORK DIMENSIONS

5. CASEWORK FURRING DETAIL B/A700

4. FURR OUT ELECTRICAL DEVICE TO BACK/CABINET

2. UPPER CABINET

NURSE BED

역 C 8'-0" x 1'-2" x 3'-4"

S E 2'-8" x 1'-0" x 5'-0"

S G 2'-6" x 1'-0" x 4'-0"

| FINISH SCHEDULE |           |       |      |          |            |          |   |          |        |          |        |          |    |
|-----------------|-----------|-------|------|----------|------------|----------|---|----------|--------|----------|--------|----------|----|
| ROOM NO.        | ROOM NAME | FLC   | OOR  |          | WALLS      |          |   |          |        |          |        | CEIL     | LI |
|                 |           |       | NO   | RTH      | E <i>A</i> | \ST      | SO   | JTH      | WI     | EST      |        |          |    |
|                 |           | FLOOR | BASE | MATERIAL | FINISH     | MATERIAL | FINISH   | MATERIAL | FINISH | MATERIAL | FINISH | MATERIAL |    |
| RR1             | RESTROOM  | CT-1  | CT-1 | GB       | PS-3       | GB       | PS-3   | GB       | PS-3   | GB       | PS-3   | GB       |    |
| 1               | CLASSROOM | ı     | -    | GB       | PS-2       | (E)      | PS-2   | (E)      | PS-2   | (E)      | PS-2   | -        |    |
|                 | · ·       |       |      |          |            |          | The state of the s |          |        | •        |        | 1        | Т  |

TBB / GB

(E)

(E)

(E)

GB

TBB/GB

(E)

(E)

CT-1,2,3 / PS-3

PS-2

PS-2

PS-2

PS-3

CT-1,2,3 / PS-3

PS-3

PS-2

PS-2

PS-2

PS-2

PS-2

PS-2

PS-2

PS-2

PS-3

PS-3

PS-2

PS-2

DOOR

DOOR TYPE

(E)

GB

GB

(E)

GB

GB

(E)

(E)

(E)

GB

(E)

(E)

(E)

MATERIAL

SCWD

PS-3

PS-2

PS-2

PS-2

PS-3

PS-2

PS-3

PS-3

PS-2

FR1

FR1

FR1

FR1

FR1


FR1

FR1

FR1

FRAME TYPE

FINISH

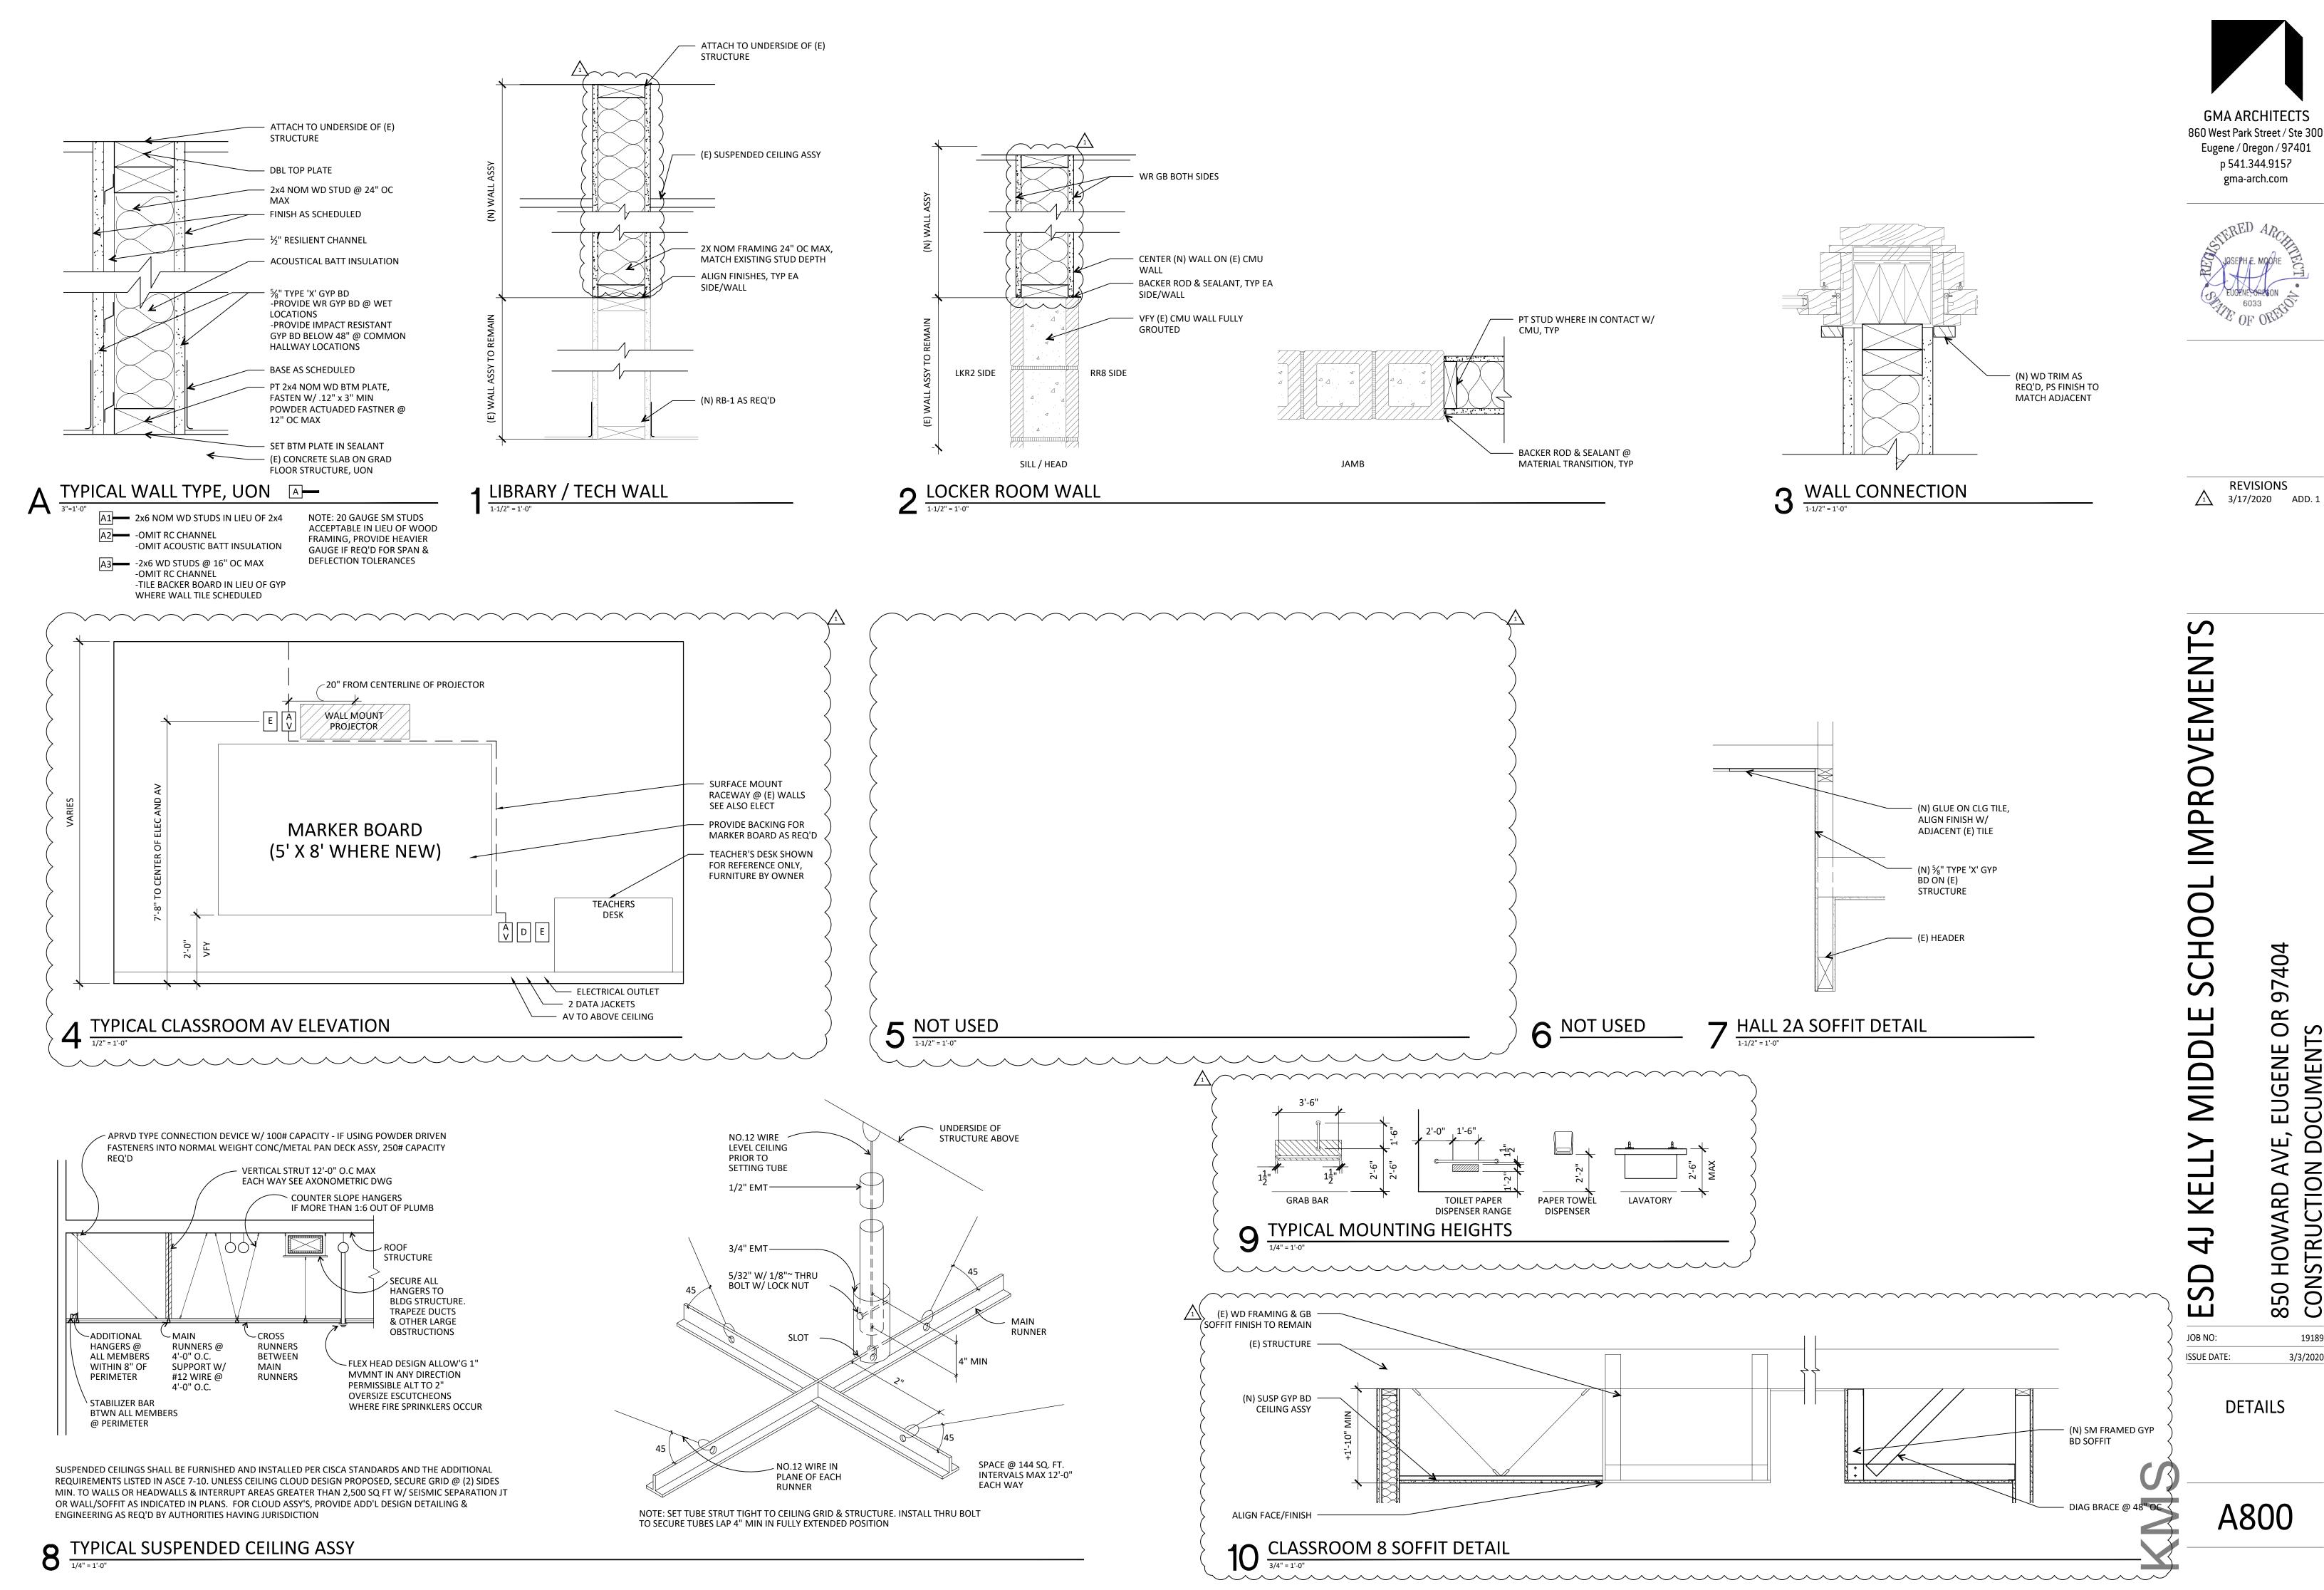



COPYRIGHT GMA ARCHITECTS

19189


3/3/2020



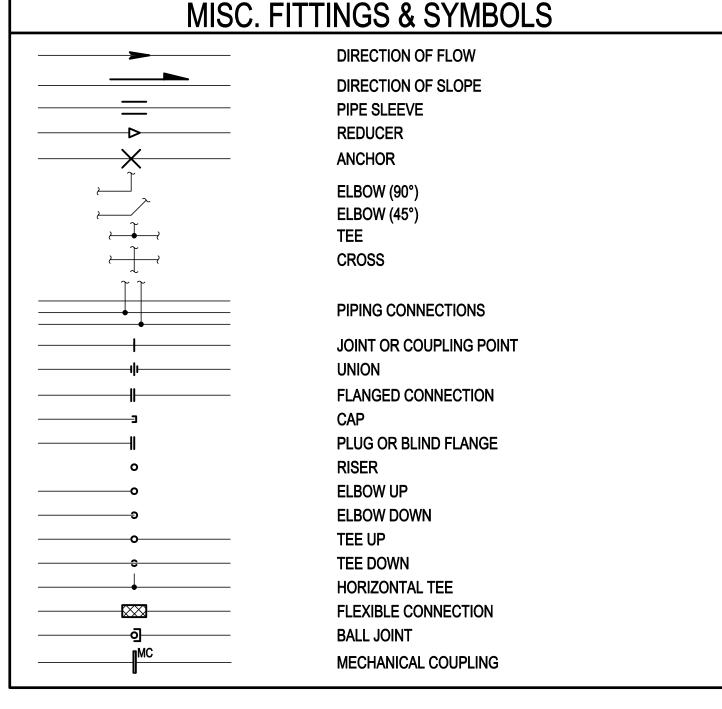

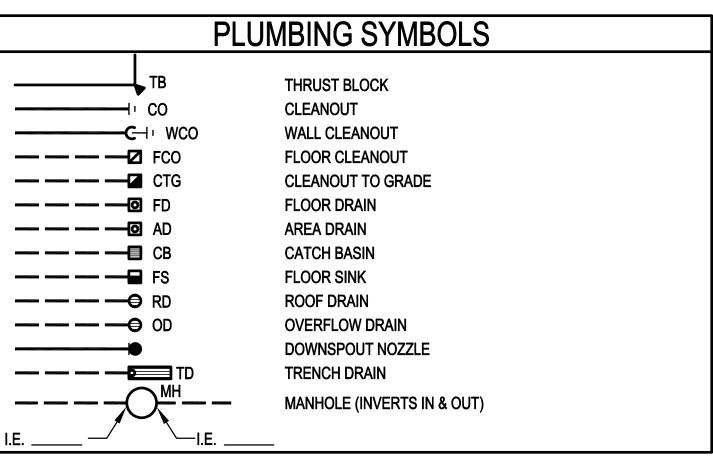



# **DEMOLITION LEGEND XXXXXXXXXXXXXX** REMOVE EXISTING PIPE

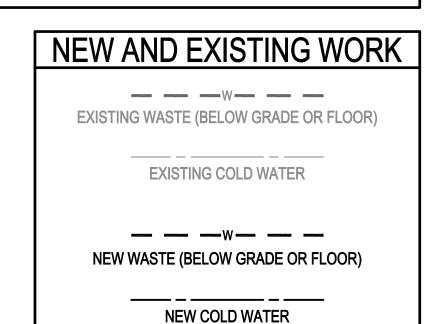

# **GENERAL NOTE**

THIS IS A STANDARD LEGEND SHEET, THEREFORE, SOME SYMBOLS MAY APPEAR ON THIS SHEET THAT DO NOT APPEAR ON THE DRAWINGS.

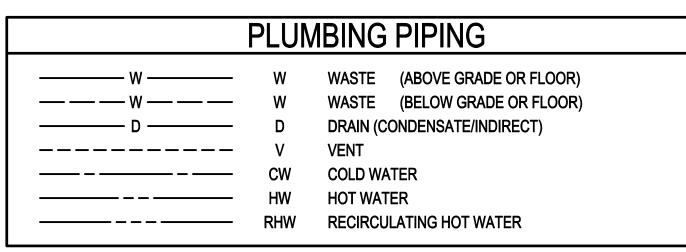

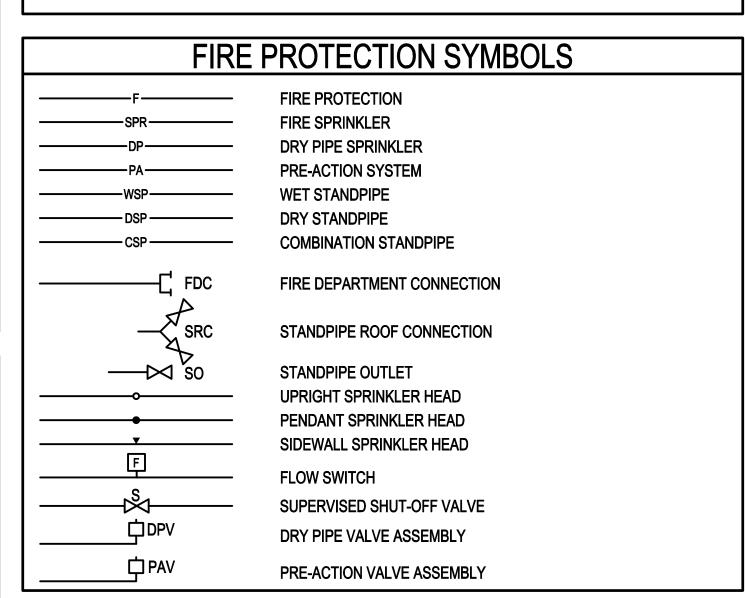


|                     |                     | SYMBOLS                        |                               |
|---------------------|---------------------|--------------------------------|-------------------------------|
| $\langle A \rangle$ | ACCESS PANEL        | $\langle \overline{K} \rangle$ | CAP EXISTING / CAP FOR FUTURE |
| $\langle B \rangle$ | BELOW GRADE / FLOOR | R                              | RELOCATE EXISTING             |
| (C)                 | CONNECT TO EXISTING | $\langle \mathbf{X} \rangle$   | REMOVE EXISTING               |
| (E)                 | EXISTING TO REMAIN  | 1                              | NOTE                          |

OVEMENT  $\mathcal{L}$ 

**GMA ARCHITECTS** 860 West Park Street / Ste 300 Eugene / Oregon / 97401 p 541.344.9157 gma-arch.com



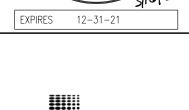

REVISIONS 3/17/2020 ADD. 1

 $\overline{\infty}$ JOB NO: **ISSUE DATE:** 

SYMBOLS, **LEGENDS AND ABBREVIATIONS -PLUMBING** 

HOWARD

OVATIONS

50 EN

3/3/2020

P0.0

**COPYRIGHT GMA ARCHITECTS** 

# FIRE PROTECTION DESIGN CRITERIA

NFPA 13 SHALL BE USED FOR THE LOCATION, SIZING, & INSTALLATION OF PIPING & SPRINKLER SYSTEMS UNLESS

LOCAL FIRE MARSHAL OR OWNER'S INSURANCE UNDERWRITER REQUIREMENTS ARE MORE STRINGENT. FIRE PROTECTION SPRINKLER DESIGN CRITERIA: (NFPA)

PROVIDE THE FOLLOWING HAZARD CLASSIFICATIONS AND DENSITIES PER CURRENT NFPA 13 STANDARDS:

- LIGHT HAZARD OCCUPANCIES: 0.10 GPM/FT2 DENSITY AT MOST REMOTE 1500 SQUARE FEET FOR PUBLIC AREAS.

DESIGN CUSHION: PROVIDE AN EXCESS OF 10 PSI ADDITIONAL PRESSURE REQUIREMENTS INCORPORATED INTO THE

DESIGN OVER SPECIFIED PRESSURE REQUIREMENTS.

REFER TO DRAWINGS FOR ZONE TYPES, CALLOUTS AND ADDITIONAL SCOPE ITEMS.

# PLUMBING DESIGN CRITERIA

DOMESTIC WATER PIPING SYSTEM:

BASIS OF DESIGN: 2017 OREGON PLUMBING SPECIALTY CODE, APPENDIX A 'RECOMMENDED RULES FOR SIZING THE

WATER SUPPLY SYSTEM'. PIPING SIZED ON 4 PSI/100 FT. DROP, VELOCITIES NOT TO EXCEED 8 FT./SEC. (COLD WATER)

AND NOT TO EXCEED 5 FT./SEC. (HOT WATER). WASTE AND VENT PIPING SYSTEM:

BASIS OF DESIGN: 2017 OREGON PLUMBING SPECIALTY CODE, CHAPTER 7, 'SANITARY DRAINAGE'.

ALL WASTE PIPING SIZED AT 1/4"/FT. SLOPE UNLESS OTHERWISE NOTED.


ROOF DRAIN/STORM DRAIN PIPING SYSTEM:

BASIS OF DESIGN: 2017 OREGON PLUMBING SPECIALTY CODE, CHAPTER 11, 'STORM DRAINAGE'.

STORM DRAIN PIPING SIZED AT 1/8"/FT. SLOPE UNLESS OTHERWISE NOTED AND A RAINFALL RATE OF 1.3"/HR.

# PLUMBING FIXTURE SCHEDULE

|        |              |   |            | _            |     |         |            |                                                 |       |   |
|--------|--------------|---|------------|--------------|-----|---------|------------|-------------------------------------------------|-------|---|
| TAG    |              |   | ROUGH-IN S | IZE (INCHES) |     |         | ELEC.      |                                                 |       |   |
| NUMBER | FIXTURE TYPE | W | V          | CW           | HW  | GPM/GPF | CONNECTION | DESCRIPTION                                     | NOTES |   |
| WC-1   | WATER CLOSET | 4 | 2          | 1-1/2        | -   | 1.28    | N          | WALL HUNG, MANUAL FLUSH VALVE                   |       |   |
| WC-2   | WATER CLOSET | 4 | 2          | 1-1/2        | -   | 1.28    | N          | WALL HUNG, MANUAL FLUSH VALVE, ADA              |       | 4 |
| U-1    | URINAL       | 2 | 1-1/2      | 1-1/4        | -   | 0.5     | N          | (WALL HUNG, MANUAL FLUSH VALVE, ADA             |       |   |
| L-1    | LAVATORY     | 2 | 1-1/2      | 1/2          | 1/2 | 0.5     | N          | WALL HUNG, 20-1/2" x 18-1/4", MANUAL FAUCET ADA |       | + |
| WS-1   | WASH STATION | 2 | 1-1/2      | 1/2          | 1/2 | 1.0     | N          | WALL HUNG, TWO STATION 0.5GPM, ADA              |       |   |

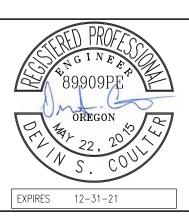

REVISIONS



JOB NO: ISSUE DATE:

OVERALL DEMOLITION PLAN - PLUMBING

PD.0

PD.0 1/32" = 1'-0"

OVERALL DEMOLITION PLAN - PLUMBING

9 PD.1

PD.1

2 PD.1

NOTES:

- A. VERIFY EXISTING CONDITIONS PRIOR TO COMMENCEMENT OF WORK. NOTIFY ARCHITECT OF ANY DISCREPANCIES BETWEEN DESIGN DOCUMENTS AND FIELD CONDITIONS.
- B. REMOVE EQUIPMENT, PIPING AND ASSOCIATED ITEMS AS SHOWN OR RELATED TO EQUIPMENT TO BE REMOVED. CAP PIPING AT NEAREST LIVE BRANCH.

1. EXTEND DOMESTIC WATER PIPING INTO EXISTING PLUMBING CHASE. JANITOR SINK DELETED, CAP WASTE PIPING IN FLOOR AND CUT VENT PIPING BACK TO MAIN IN PLUMBING CHASE

~~~~~~~~

FOR NEW TIE-IN TO WASH STATIONS.

====

X LAV 7

GMA ARCHITECTS








REVISIONS 3/17/2020 ADD. 1

PROVEMENTS

JOB NO: ISSUE DATE: PARTIAL

DEMOLITION -PLUMBING


PD.1

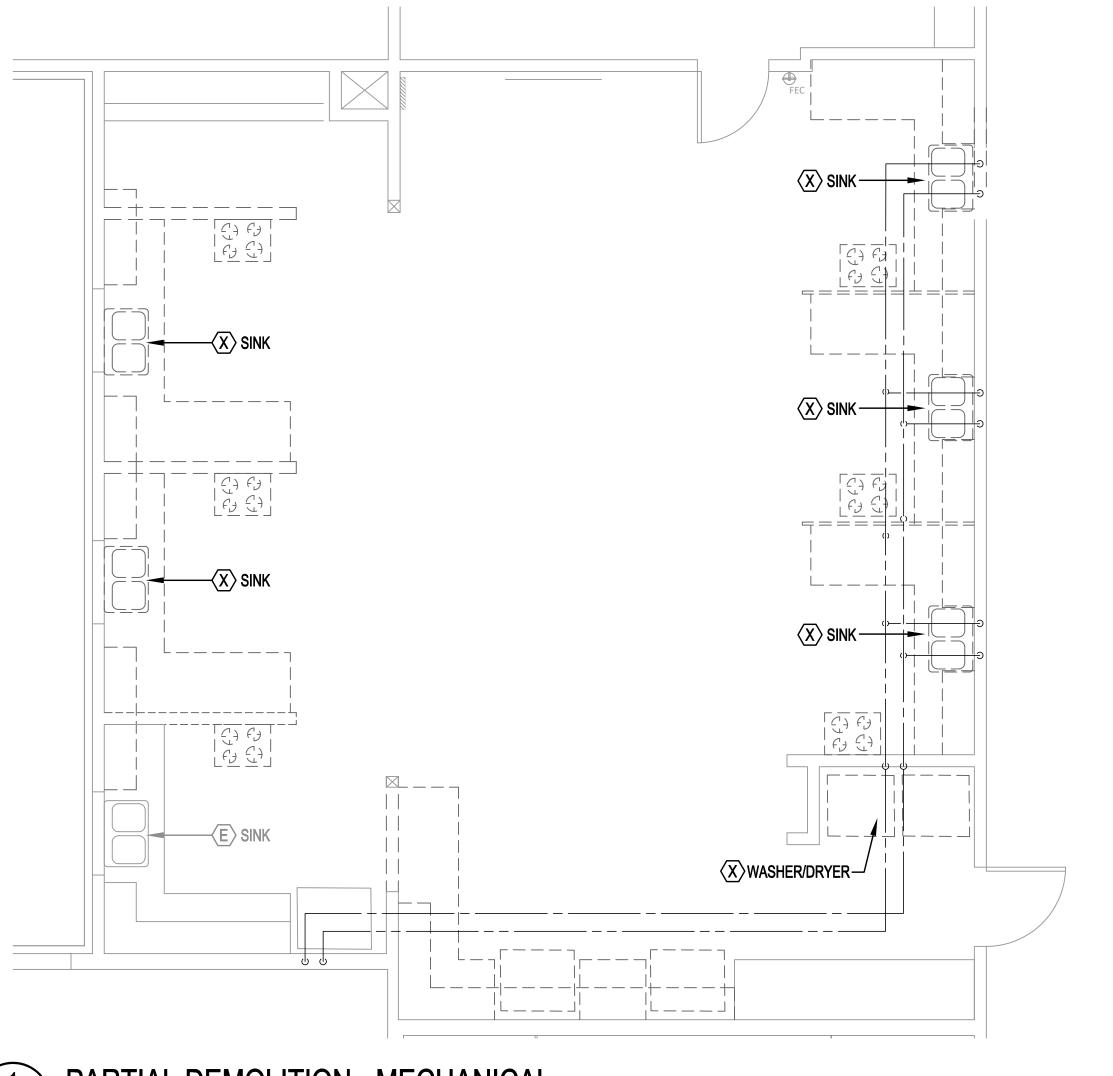

PARTIAL DEMOLITION - MECHANICAL PD.1


PARTIAL DEMOLITION - MECHANICAL

| | 0

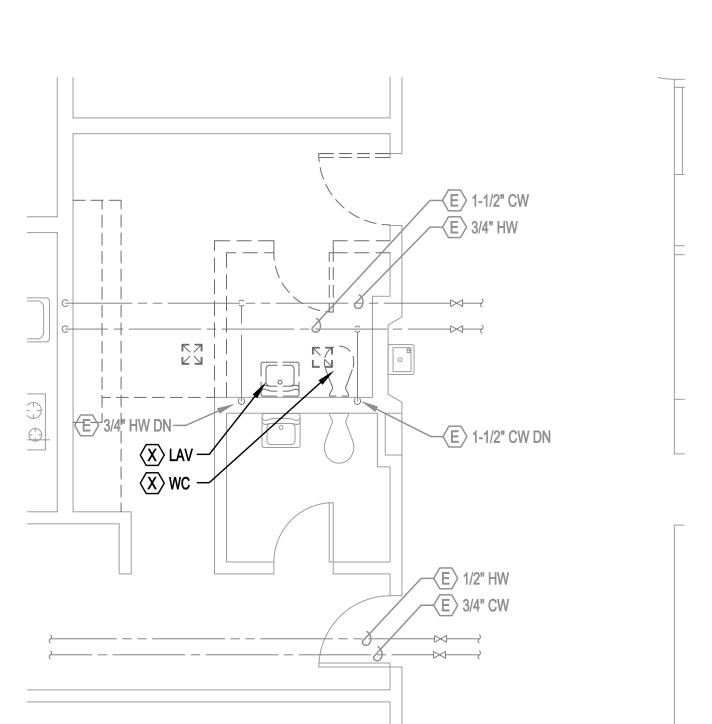

PARTIAL DEMOLITION - MECHANICAL

PD.1

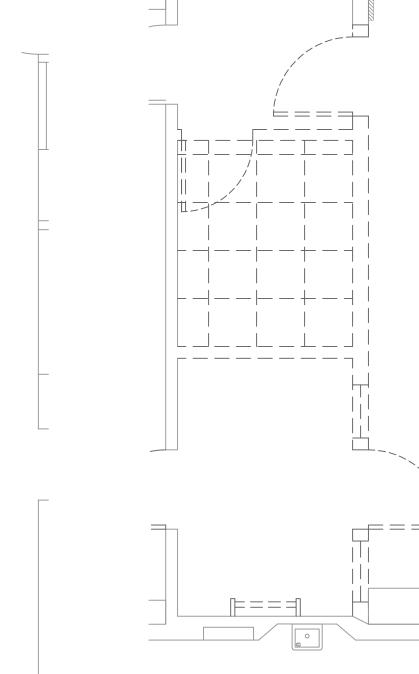

E 3/4" HW


►E 1/2" CW

PARTIAL DEMOLITION - MECHANICAL PD.1

B. MODIFY EXISTING FIRE SPRINKLER SYSTEM WITH NEW SPRINKLER HEAD COVERAGE IN ACCORDANCE WITH NFPA 13 AND OREGON FIRE CODE REQUIREMENTS. REFER TO ARCHITECTURAL DRAWINGS FOR FULL EXTENT OF CEILING REMODEL SCOPE AREAS.



GMA ARCHITECTS 860 West Park Street / Ste 300 Eugene / Oregon / 97401 p 541.344.9157 gma-arch.com

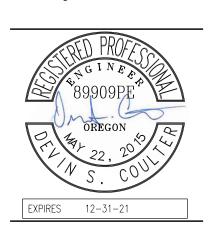


REVISIONS



PROVEMENTS

JOB NO:

OVERALL FLOOR PLAN - PLUMBING

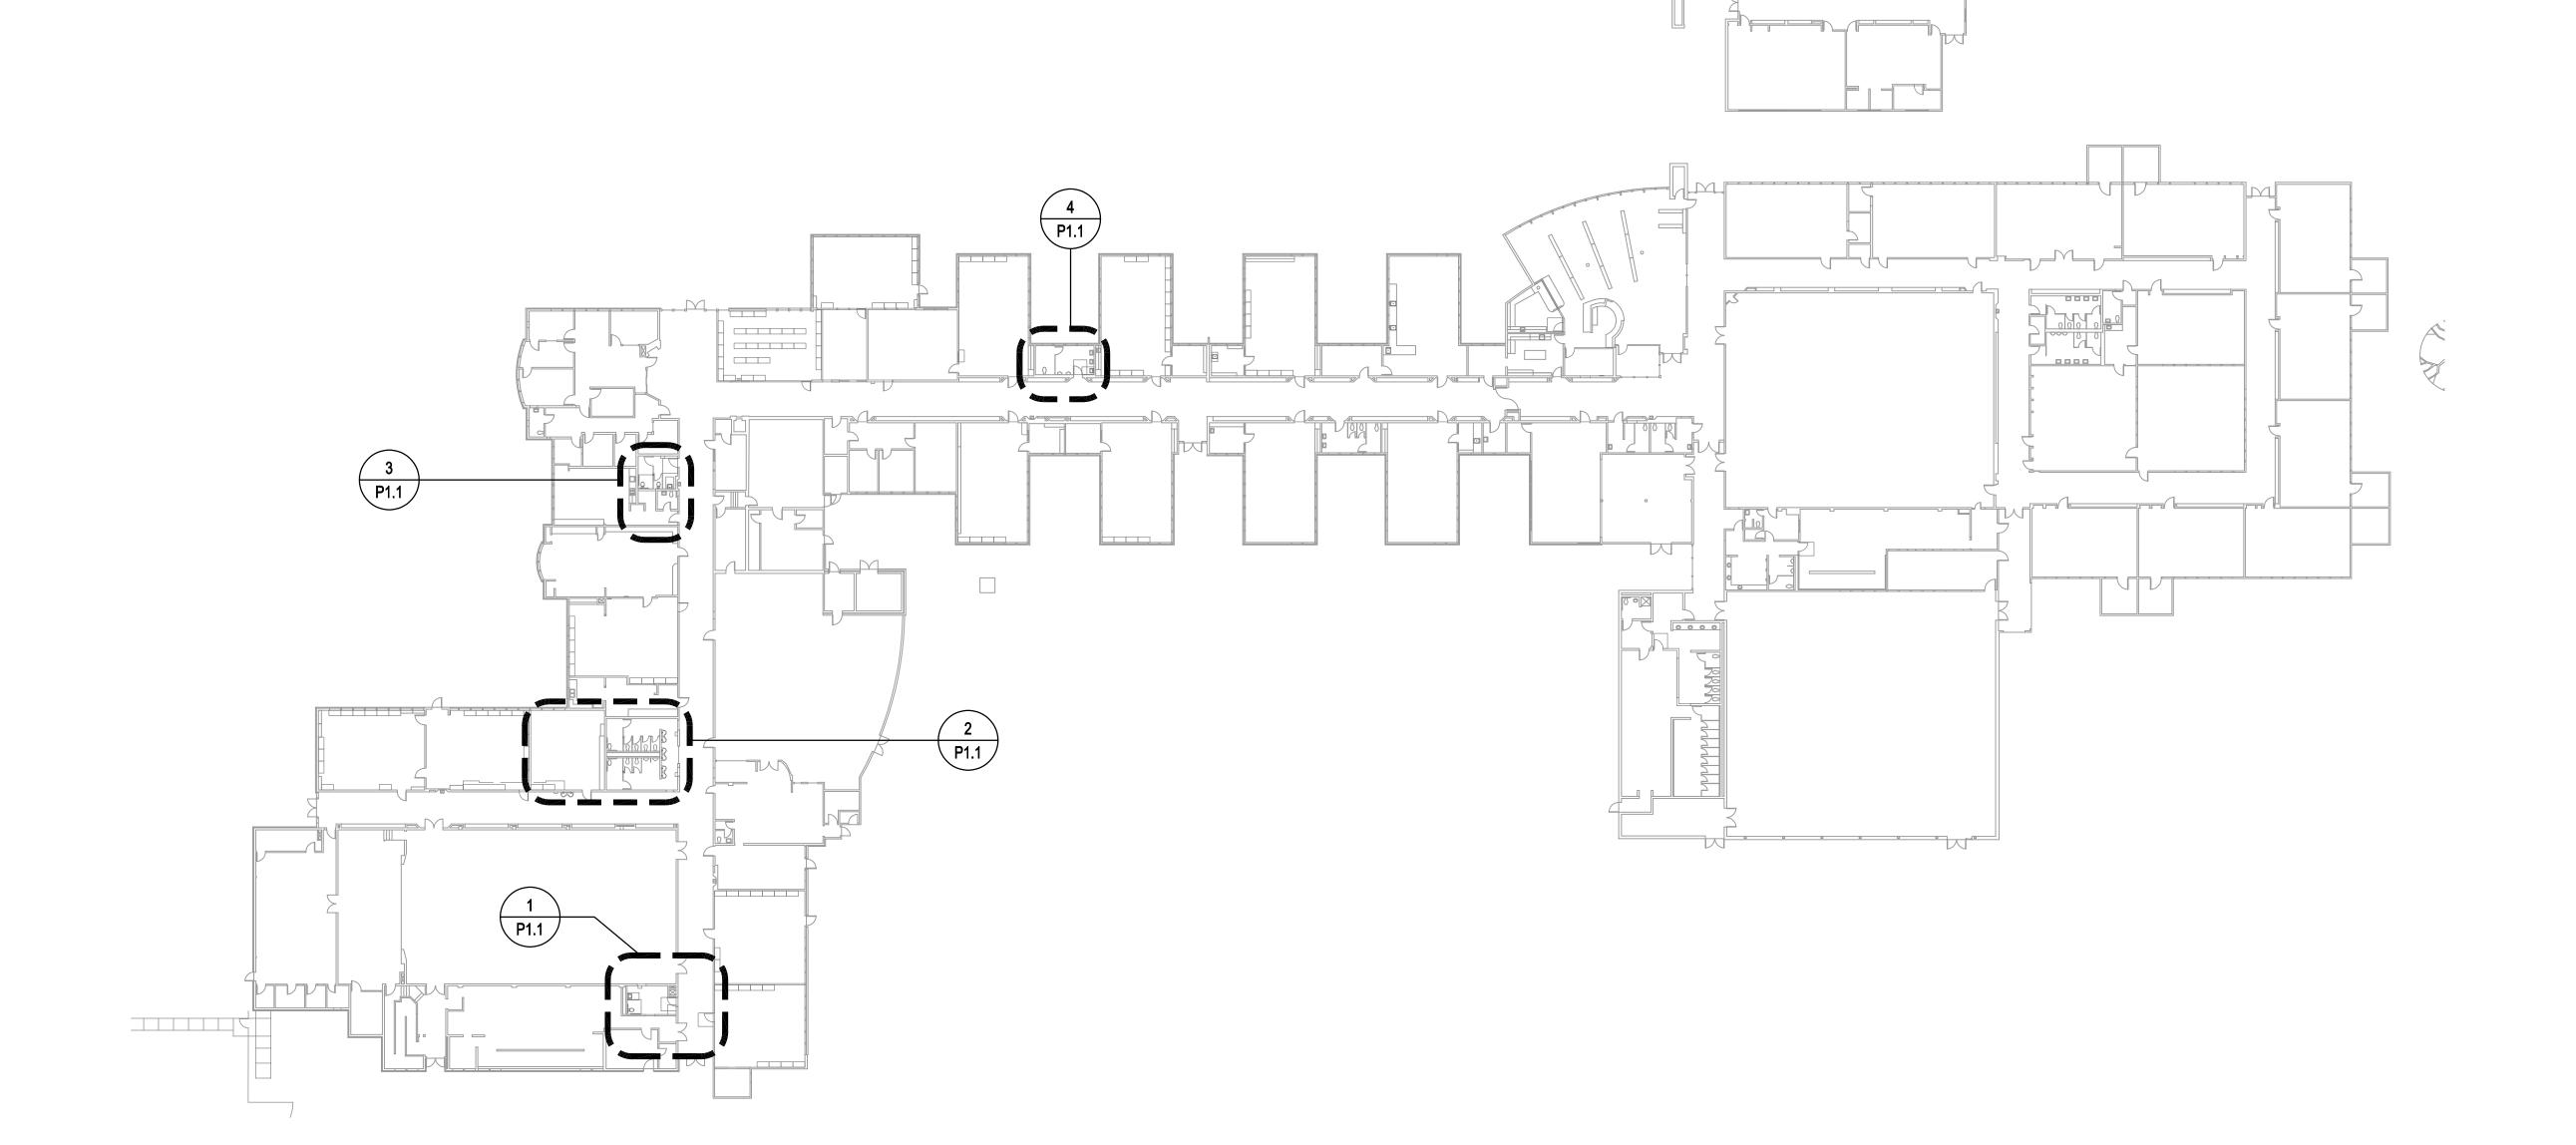

OVERALL FLOOR PLAN - PLUMBING

GENERAL NOTES:

NOTES:

NOTES:

NORTH

—⟨E⟩ 3/4" HW

- A. VERIFY EXISTING CONDITIONS PRIOR TO COMMENCEMENT OF WORK. NOTIFY ARCHITECT OF ANY DISCREPANCIES BETWEEN DESIGN DOCUMENTS AND FIELD CONDITIONS.
- B. MODIFY EXISTING FIRE SPRINKLER SYSTEM WITH NEW SPRINKLER HEAD COVERAGE IN ACCORDANCE WITH NFAP 13 AND OREGON FIRE CODE REQUIREMENTS. REFER TO ARCHITECTURAL DRAWINGS FOR FULL EXTENT OF CEILING REMODEL SCOPE.

1. PROVIDE WATER HAMMER ARRESTOR WITH ACCESS PANEL.

2. PROVIDE TIE-IN TO EXISTING WASTE PIPING CONNECTIONS

BELOW FLOOR SLAB. VERIFY WASTE PIPING LOCATION PRIOR

TO SAWCUTTING. REFER TO ARCHITECTURAL PLANS AND

SPECIFICATIONS FOR SAWCUTTING AND CONCRETE

PATCHING REQUIREMENTS.



GMA ARCHITECTS 860 West Park Street / Ste 300 Eugene / Oregon / 97401 p 541.344.9157 gma-arch.com



pae-engineers.com

REVISIONS 3/17/2020 ADD. 1

PROVEMENTS

6. ROUTE WASTE AND VENT PIPING ABOVE FLOOR IN WALL TO NEW WASH STATIONS. CONNECT TO EXISTING MAINS IN PLUMBING CHASE.

1. NEW RESTROOM PLUMBING FIXTURES TO BE INSTALLED AS INDICATED, PROVIDE TIE-IN TO EXISTING PIPING ROUGH-INS IN PLUMBING WALL. PROVIDE NEW WALL CARRIERS FOR WALL MOUNTED FIXTURES. REFER TO PLUMBING FIXTURE SCHEDULE FOR CONNECTION SIZES.

2. PROVIDE TIE-IN TO EXISTING WASTE PIPING BELOW FLOOR SLAB. VERIFY WASTE PIPING LOCATION PRIOR TO SAWCUTTING. REFER TO ARCHITECTURAL PLANS AND SPECIFICATIONS FOR SAWCUTTING AND CONCRETE PATCHING REQUIREMENTS.

3. CONNECT TO EXISTING DOMESTIC WATER, SANITARY WASTE AND VENT IN WALL.

4. PROVIDE MECHANICAL TRAP PRIMER IN WALL FOR NEW FLOOR DRAIN, PRESSURE DROP ACTIVATED, BASIS OF DESIGN SIOUX CHIEF PRIME PERFECT.

5. EXTEND EXISTING DOMESTIC WATER PIPING INTO PLUMBING CHASE WITH ISOLATION VALVES AND ACCESS PANELS. PROVIDE RUNOUTS TO FIXTURES.




JOB NO: **ISSUE DATE:**

3/3/2020

ENLARGED PARTIAL FLOOR PLAN - PLUMBING



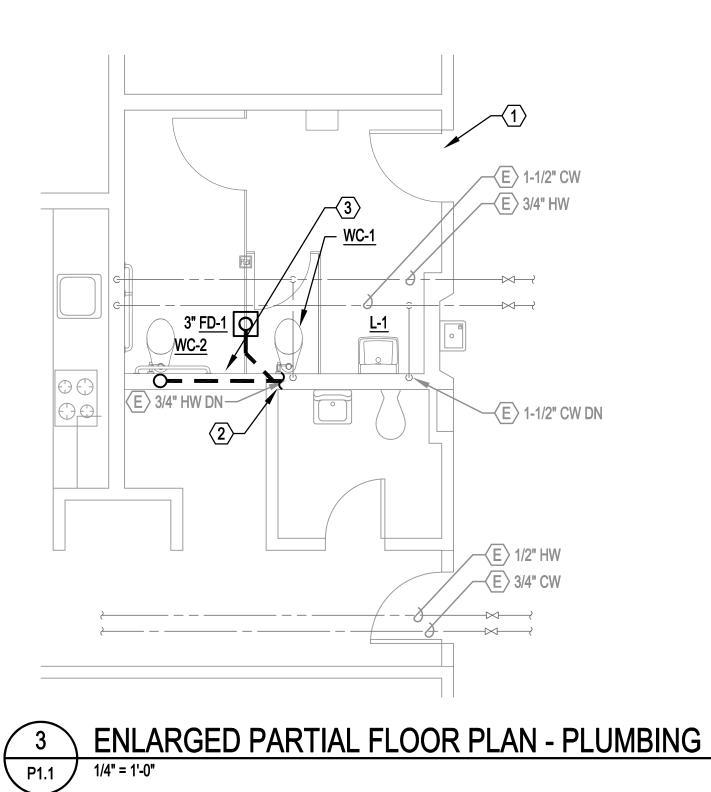


NOTES:

1. NEW RESTROOM PLUMBING FIXTURES TO BE INSTALLED AS INDICATED, PROVIDE TIE-IN TO EXISTING PIPING ROUGH-INS IN PLUMBING WALL. PROVIDE NEW WALL CARRIERS FOR WALL MOUNTED FIXTURES. REFER TO PLUMBING FIXTURE SCHEDULE FOR CONNECTION SIZES.

2. PROVIDE TIE-IN TO EXISTING WASTE PIPING BELOW FLOOR SLAB. VERIFY WASTE PIPING LOCATION PRIOR TO SAWCUTTING. REFER TO ARCHITECTURAL PLANS AND SPECIFICATIONS FOR SAWCUTTING AND CONCRETE PATCHING REQUIREMENTS.


3. PROVIDE MECHANICAL TRAP PRIMER IN WALL FOR NEW FLOOR DRAIN, PRESSURE DROP ACTIVATED, BASIS OF DESIGN SIOUX CHIEF PRIME PERFECT.

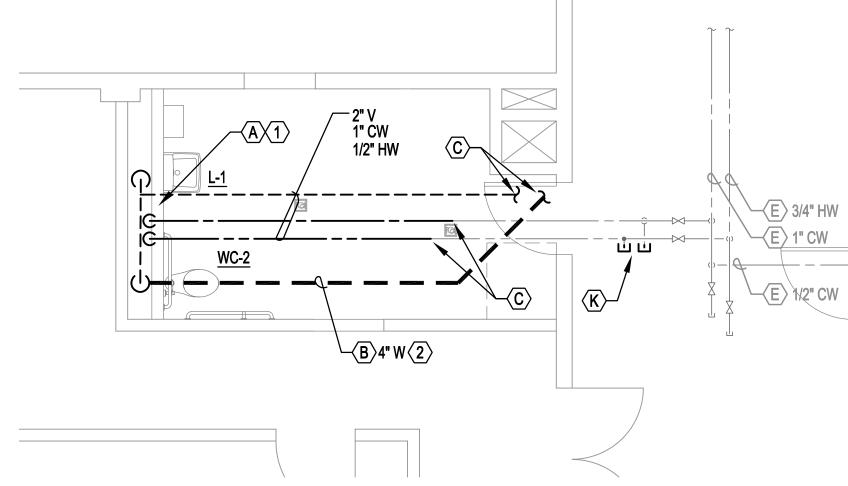

ENLARGED PARTIAL FLOOR PLAN - PLUMBING



(TYP 2)

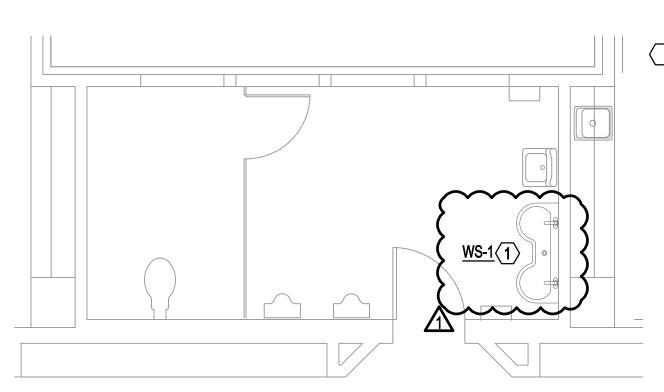

NOTES:

1. PROVIDE TIE-IN TO EXISTING PIPING ROUGH-INS IN PLUMBING WALL. PROVIDE NEW WALL CARRIERS FOR WALL MOUNTED FIXTURE. REFER TO PLUMBING FIXTURE SCHEDULE FOR CONNECTION SIZES.

NORTH

ENLARGED PARTIAL FLOOR PLAN - PLUMBING


- <u>WS-1</u> (3)


ENLARGED PARTIAL FLOOR PLAN - PLUMBING


DUCT DETAILS (LOW VELOCITY)

12x6



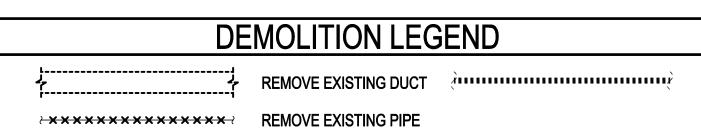

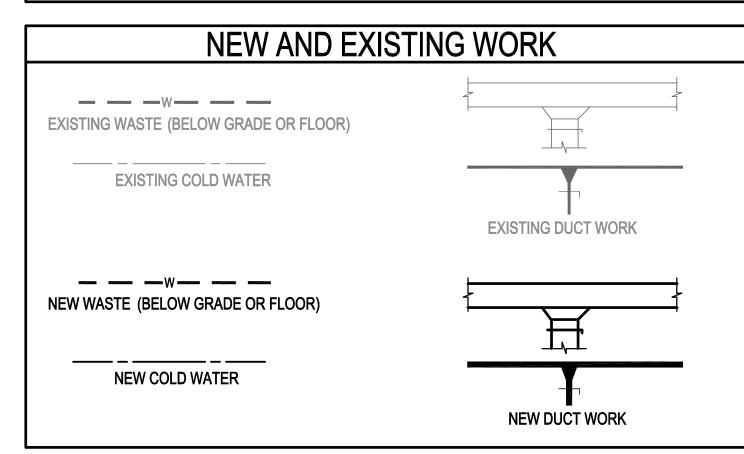

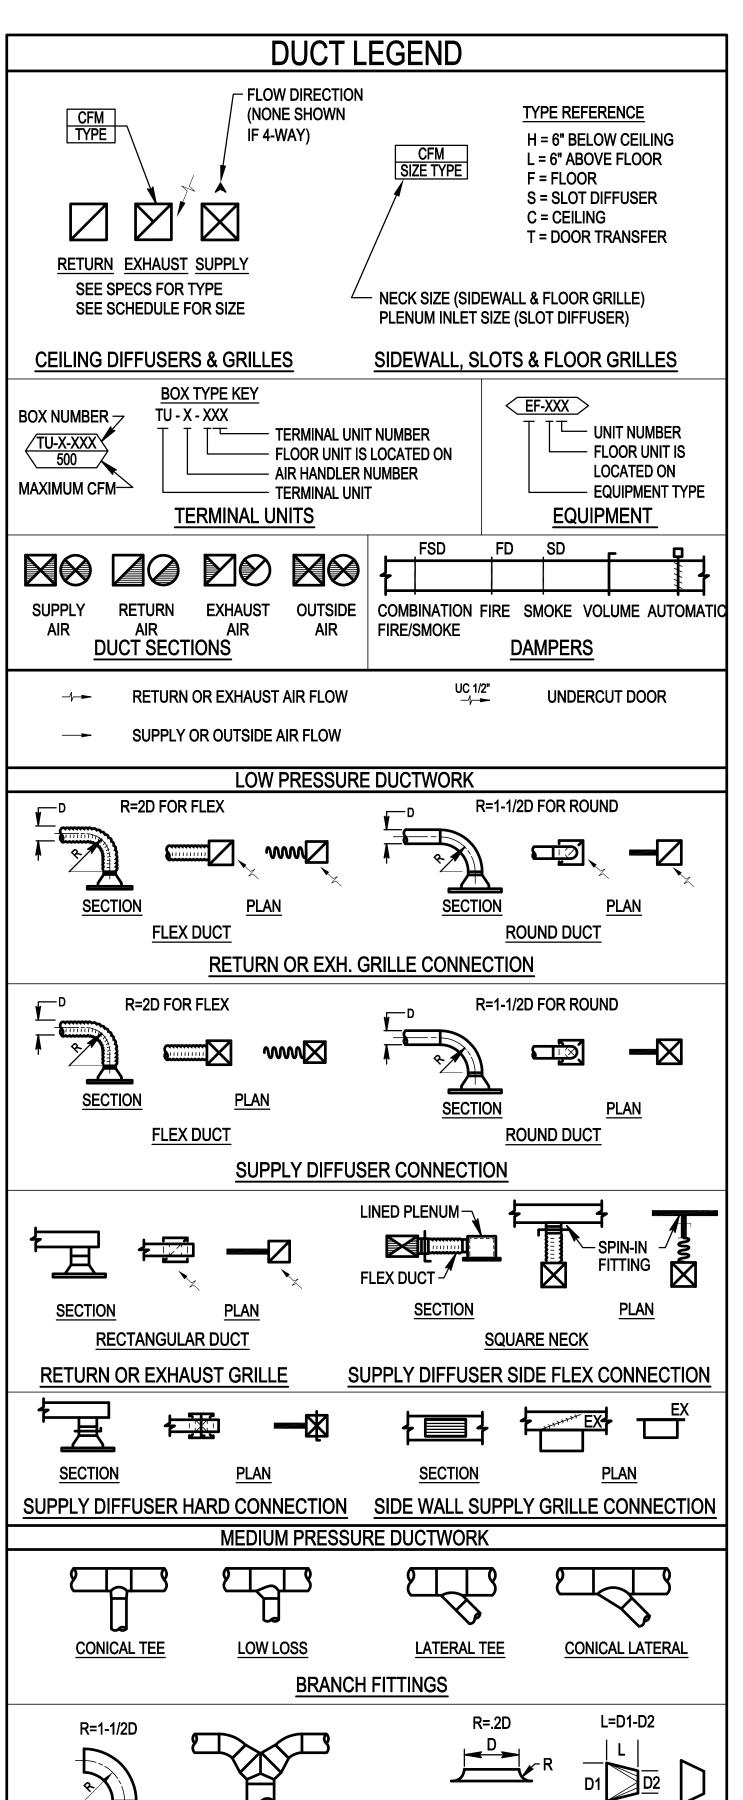


BELLMOUTH


<u>REDUCERS</u>

Y-BRANCH

GENERAL NOTE


THIS IS A STANDARD LEGEND SHEET, THEREFORE, SOME SYMBOLS MAY APPEAR ON THIS SHEET THAT DO NOT APPEAR ON THE DRAWINGS.

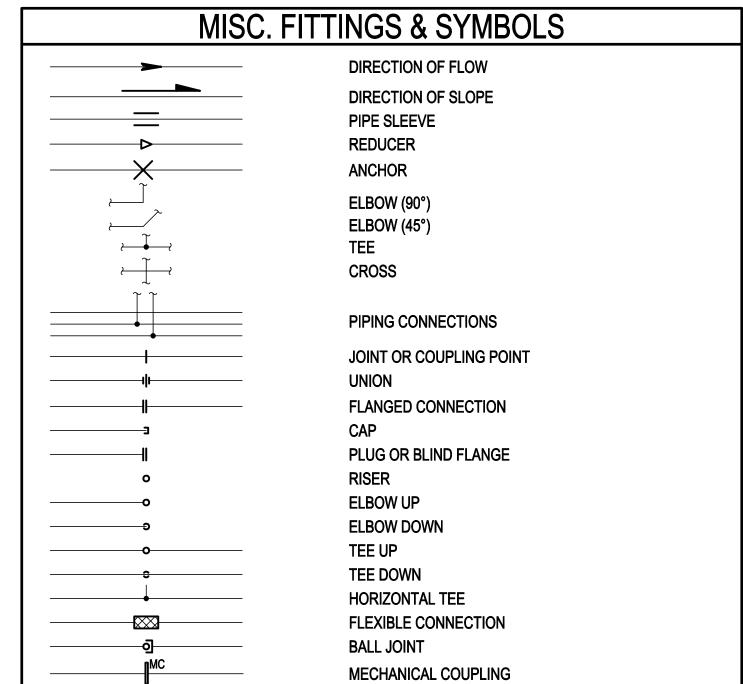

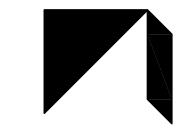

860 West Park Street / Ste 300 Eugene / Oregon / 97401 p 541.344.9157

gma-arch.com

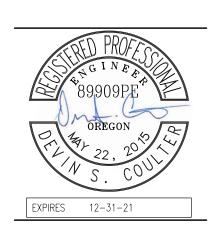

REVISIONS



PLING

SYMBOLS ACCESS PANEL CAP EXISTING / CAP FOR FUTURE BELOW GRADE / FLOOR RELOCATE EXISTING REMOVE EXISTING **CONNECT TO EXISTING** EXISTING TO REMAIN CALL OUT SYMBOLS ✓ WALL MOUNTED - PENDANT MOUNTED © CARBON MONOXIDE TEMPERATURE CARBON DIOXIDE HUMIDITY NITROGEN OXIDE PRESSURE **ROOM SENSORS**

ESD 4J KELLY MIDDLE SCHOOL IMPROVEMEI

850 HOWARD AVE, EUG RENOVATIONS

JOB NO: 19189
ISSUE DATE: 3 MARCH 2020

SYMBOLS, LEGENDS AND ABBREVIATIONS -MECHANICAL

M0.0


			D	IFFUSERS	AND GRILLI	ES				
			AIRFLO	V RANGE	INLET	FACE	E SIZE			
			MIN	MAX	SIZE	T-BAR	HARD LID	MAX	THROW	MANUFACTURER
TAG	TYPE	DESCRIPTION	(CFM)	(CFM)	(IN)	(IN)	(IN)	NC	(FT)	& MODEL
			0	125	6x6	24x24	13x13	12	2-2-5	
		PERFORATED FACE, MODULAR CORE, ADJUSTABLE 4-WAY THROW	126	220	8x8	24x24	15x15	17	2-3-6	
C-1	C-1 CEILING SUPPLY DIFFUSER		221	345	10x10	24x24	17x17	21	3-4-8	TITUS PMC
			346	500	12x12	24x24	19x19	24	3-5-9	
			501	780	16x16	24x24	23x23	28	4-6-11	
			0	340	10x10	24x24	12x12	17	-	
	OFILINO DETUDN/EVITATIOT	DEDECDATED FACE OTEF	341	780	15x15	24x24	17x17	22	-	
C-2	CEILING RETURN/ EXHAUST GRILLE	PERFORATED FACE, STEEL, ROUND DUCT CONNECTION	781	1,125	18x18	24x24	20x20	24	-	TITUS PAR
	GRILLE	KOUND DUCT CONNECTION —	1,129	1,670	22x22	24x24	24x24	26	-	
			1,671	3,500	22x46	24x48	24x48	25	-	

			AIRFLOV	V RANGE	INLET	FACE	E SIZE			
			MIN	MAX	SIZE	T-BAR	HARD LID	MAX	THROW	MANUFACTURER
TAG	TYPE	DESCRIPTION	(CFM)	(CFM)	(IN)	(IN)	(IN)	NC	(FT)	& MODEL
			0	125	6x6	24x24	13x13	12	2-2-5	
		PERFORATED FACE, MODULAR CORE, ADJUSTABLE 4-WAY THROW	126	220	8x8	24x24	15x15	17	2-3-6	
C-1	CEILING SUPPLY DIFFUSER		221	345	10x10	24x24	17x17	21	3-4-8	TITUS PMC
			346	500	12x12	24x24	19x19	24	3-5-9	
			501	780	16x16	24x24	23x23	28	4-6-11	
			0	340	10x10	24x24	12x12	17	-	
		DEDEGDATED FACE OTES	341	780	15x15	24x24	17x17	22	-	
	CEILING RETURN/ EXHAUST	PERFORATED FACE, STEEL.		4 40-						

SPACE		WINTER	SUMMER						
	TEMPERATURE	HUMIDITY	TEMPERATURE	HUMIDITY					
OUTDOOR	23.4° F DB	16.1° F DP / 12.6 HR / 26.9 ° F MCDB	91.7° F DB / 66.5° F MCWB	62.2° F DP / 84.8 HR / 74.6° F MCDE					
INDOOR	70° F ± 2° F DB	50% RH MAX, NO MINIMUM	75° F ± 2° F DB	50% RH MAX, NO MINIMUM					

			HEA		NTILATION		CHEDU	ILE						
			\						HYDRO	NIC HEA	TING COI	L		
			DESIGN (MAX	CODE MIN		₹					MIN	APPROX.	
			AIRFLOW (OSA	OSA	FILTER	YOLT/	EAT	LAT		EWT	WTD	WEIGHT	MANUFACTURER
ΓAG	LOCATION	SERVICE	(CFM)	(CFM)	(CFM)	(MERV)	PHASE	(°F)	(°F)	GPM	(°F)	(°F)	(LBS)	& MODEL
V-20	SOUTH STORAGE	NEW CLASSROOM 4A	800	800	430	11 .	208/1	45	85	1.8	180	40	150	TRANE BCHD024
V-21	SOUTH STORAGE	NEW CLASSROOM 4B	800 (800	385	11	208/1	45	85	1.8	180	40	150	TRANE BCHD024
ENERAL N	NOTES:						7							
PROVIDE	EC MOTOR ON FAN.													



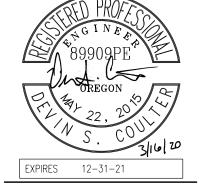



^	KEVISIONS	
1	3/17/2020	ADD. 1

3			

PROVEMENTS

SCHOOL

GREENHECK SQ-95

JOB NO: 3/3/2020 ISSUE DATE:

> **EQUIPMENT SCHEDULE** -**MECHANICAL**

> > M0.1

					AIRFLOW		THROAT	APPROX.		
					FLOW	TSP	SIZE	WEIGHT	MANUFACTURER	
TAG	LOCATION	SERVICE	TYPE	TYPE	(CFM)	(IN WG)	(IN)	(LBS)	& MODEL	NOTES
RV-1	ROOF	HV-20	GRAVITY	INTAKE	800	0.05	16	20	GREENHECK GRSI	
RV-2	ROOF	HV-21	GRAVITY	INTAKE	800	0.05	16	20	GREENHECK GRSI	
RV-3	ROOF	HV-20/21	GRAVITY	RELIEF	1,600	0.07	20	30	GREENHECK GRSR	
RV-4	ROOF	RR1	GRAVITY	RELIEF	300	0.07	8	20	GREENHECK GRSR	1
RV-5	ROOF	RR4	GRAVITY	RELIEF	350	0.05	10	20	GREENHECK GRSR	1
NOTEO.		1	1		1		1	1		1

115/1

VENTILATION SCHEDULE - MULTIPLE SPACES

0.10

1/8

ROOF VENTILATOR SCHEDULE

1. PROVIDE MOTORIZED AUTO DAMPER AT INLET TO ROOF VENTILATOR LOCATED IN ATTIO 24V CONTROL ACTUATOR PROVIDED OFOI.

DIRECT

					FAN	SCHEDULE								
						AIRFLOW			ELEC	TRICAL				
							FAN				GEN.	APPROX.		
						TSP	SPEED	VOLT/	POWER	RATING	POWER	WEIGHT	MANUFACTURER	
TAG	LOCATION	SERVICE	TYPE	DRIVE	(CFM)	(IN WG)	(RPM)	PHASE	(BHP)	(HP)	(Y/N)	(LBS)	& MODEL	NOTES
EF-7	MECH ATTIC PLATFORM	RR1	INLINE	DIRECT	300	0.5	1,550	115/1	0.10	1/8	NO	50	GREENHECK SQ-95	1

1,550

B. PROVIDE STARTER AND DISCONNECT WITH UNIT.

1. PROVIDE MOTORIZED DAMPER AT DISCHARGE THROUGH ROOF 24V CONTROL ACTUATOR PROVIDED OF OI.

MECH ATTIC PLATFORM

(FINNED TUBE RADIATOR														
	TAG NUMBER	LOCATION	SERVICE	OUTPUT BTUH	LENGTH (IN)	EWT (°F)	WTD (°F)	FLOW (GPM)	MANUFACTURER & MODEL	NOTES					
(FTR-1	LOBBY	LOBBY	12745	55	180	10	2.5	JAGA BRIZA 22 HYBRID 55						
Δ	GENERAL NOTES:							·		K					

EF-8

LOCATION	FLOOR AREA (SF)	PRIMARY AIRFLOW RATE (CFM)	OCCUPANCY CLASSIFICATION	PEOPLE OUTDOOR AIRFLOW RATE Rp (CFM/PERSON)	AREA OUTDOOR AIRFLOW RATE Ra (CFM/SF)	DEFAULT OCCUPANT DENSITY (PEOPLE/1000SF)	CODE POPULATION	DESIGN POPULATION	OUTDOOR AIRFLOW RATE Vbz (CFM)	ZONE AIR DISTRIBUTION EFFECTIVENESS Ez	OUTDOOR AIR INTAKE Voz (CFM)	NOTES
CLASSROOM 1	832	800	Classrooms (age 5-8)	10	0.12	25	20.8	20.8	307.8	0.8	385	
CLASSROOM 2	923	800	Classrooms (age 5-8)	10	0.12	25	23.1	23.1	341.5	0.8	427	
CLASSROOM 3	921	700	Classrooms (age 5-8)	10	0.12	25	23.0	23.0	340.8	0.8	426	
CLASSROOM 4	656	560	Classrooms (age 5-8)	10	0.12	25	16.4	16.4	242.7	0.8	304	
CLASSROOM 5	412	300	Classrooms (age 5-8)	10	0.12	25	10.3	10.3	152.4	0.8	191	
CLASSROOM 6	965	900	Classrooms (age 5-8)	10	0.12	25	24.1	24.1	357.1	0.8	447	
LIBRARY 7	821	920	Libraries	5	0.12	10	8.2	8.2	139.6	0.8	175	
CORRIDOR/BREAK OUT 8	346	450	Conference rooms	5	0.06	50	17.3	17.3	107.3	0.8	135	
CLASSROOM 9	701	1070	Classrooms (age 5-8)	10	0.12	25	17.5	17.5	259.4	0.8	325	
CLASSROOM 10	825	1420	Classrooms (age 5-8)	10	0.12	25	20.6	20.6	305.3	0.8	382	
LIB OFFICE 11	233	600	Office spaces	5	0.06	5	1.2	1.2	19.8	0.8	25	
LIB OFFICE 12	147	300	Office spaces	5	0.06	5	0.7	1.0	13.8	0.8	18	
LIB OFFICE 13	147	300	Office spaces	5	0.06	5	0.7	1.0	13.8	0.8	18	

GENERAL NOTES:

A. SYSTEM OUTDOOR AIR CALCULATION IS BASED ON THE SECTION 403 OF THE 2014 OREGON MECHANICAL SPECIALTY CODE.

B. REFER TO AIR HANDLING UNIT SCHEDULE FOR ACTUAL OUTDOOR AIR FLOW RATE.

INLINE

RR4

1. DESIGN OCCUPANCY REPRESENTS THE AVERAGE OCCUPANCY, WHICH IS NOT LESS THAN 1/2 THE CODE OCCUPANCY.

GENERAL NOTES:

A. NOISE CRITERIA (NC) BASED ON ROOM ABSORPTION OF 10 dB, MEASURED PER ANSI/ASHRAE STANDARD 70.


D. REFER TO SPECIFICATION 233700 FOR SIDEWALL GRILLES, SIZING AND MOUNTING HEIGHTS AS INDICATED ON FLOORPLANS

B. THROW VALUES GIVEN FOR TERMINAL VELOCITIES 150, 100, AND 50 FPM FOR ISOTHERMAL CONDITIONS.

C. ADJUST THROW DIRECTION AND QUANTITY PRIOR TO AIR BALANCING.

 Λ A. EAT = 65°F. 22" HEIGHT.



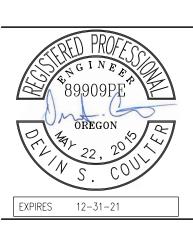



JOB NO:

OVERALL DEMOLITION PLAN -MECHANICAL

OVERALL DEMOLITION PLAN - MECHANICAL


MD.0 1/32" = 1'-0"


<u>MD.1</u>

MD.3

MD.1

MD.2

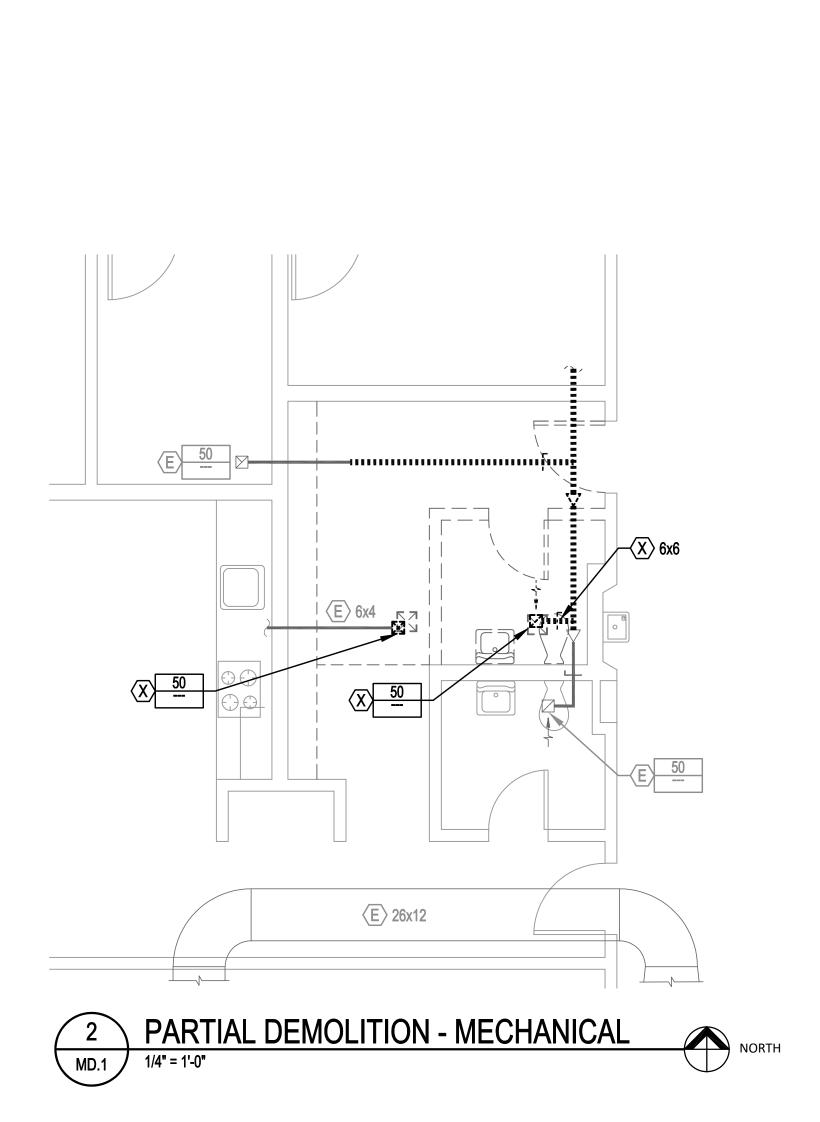

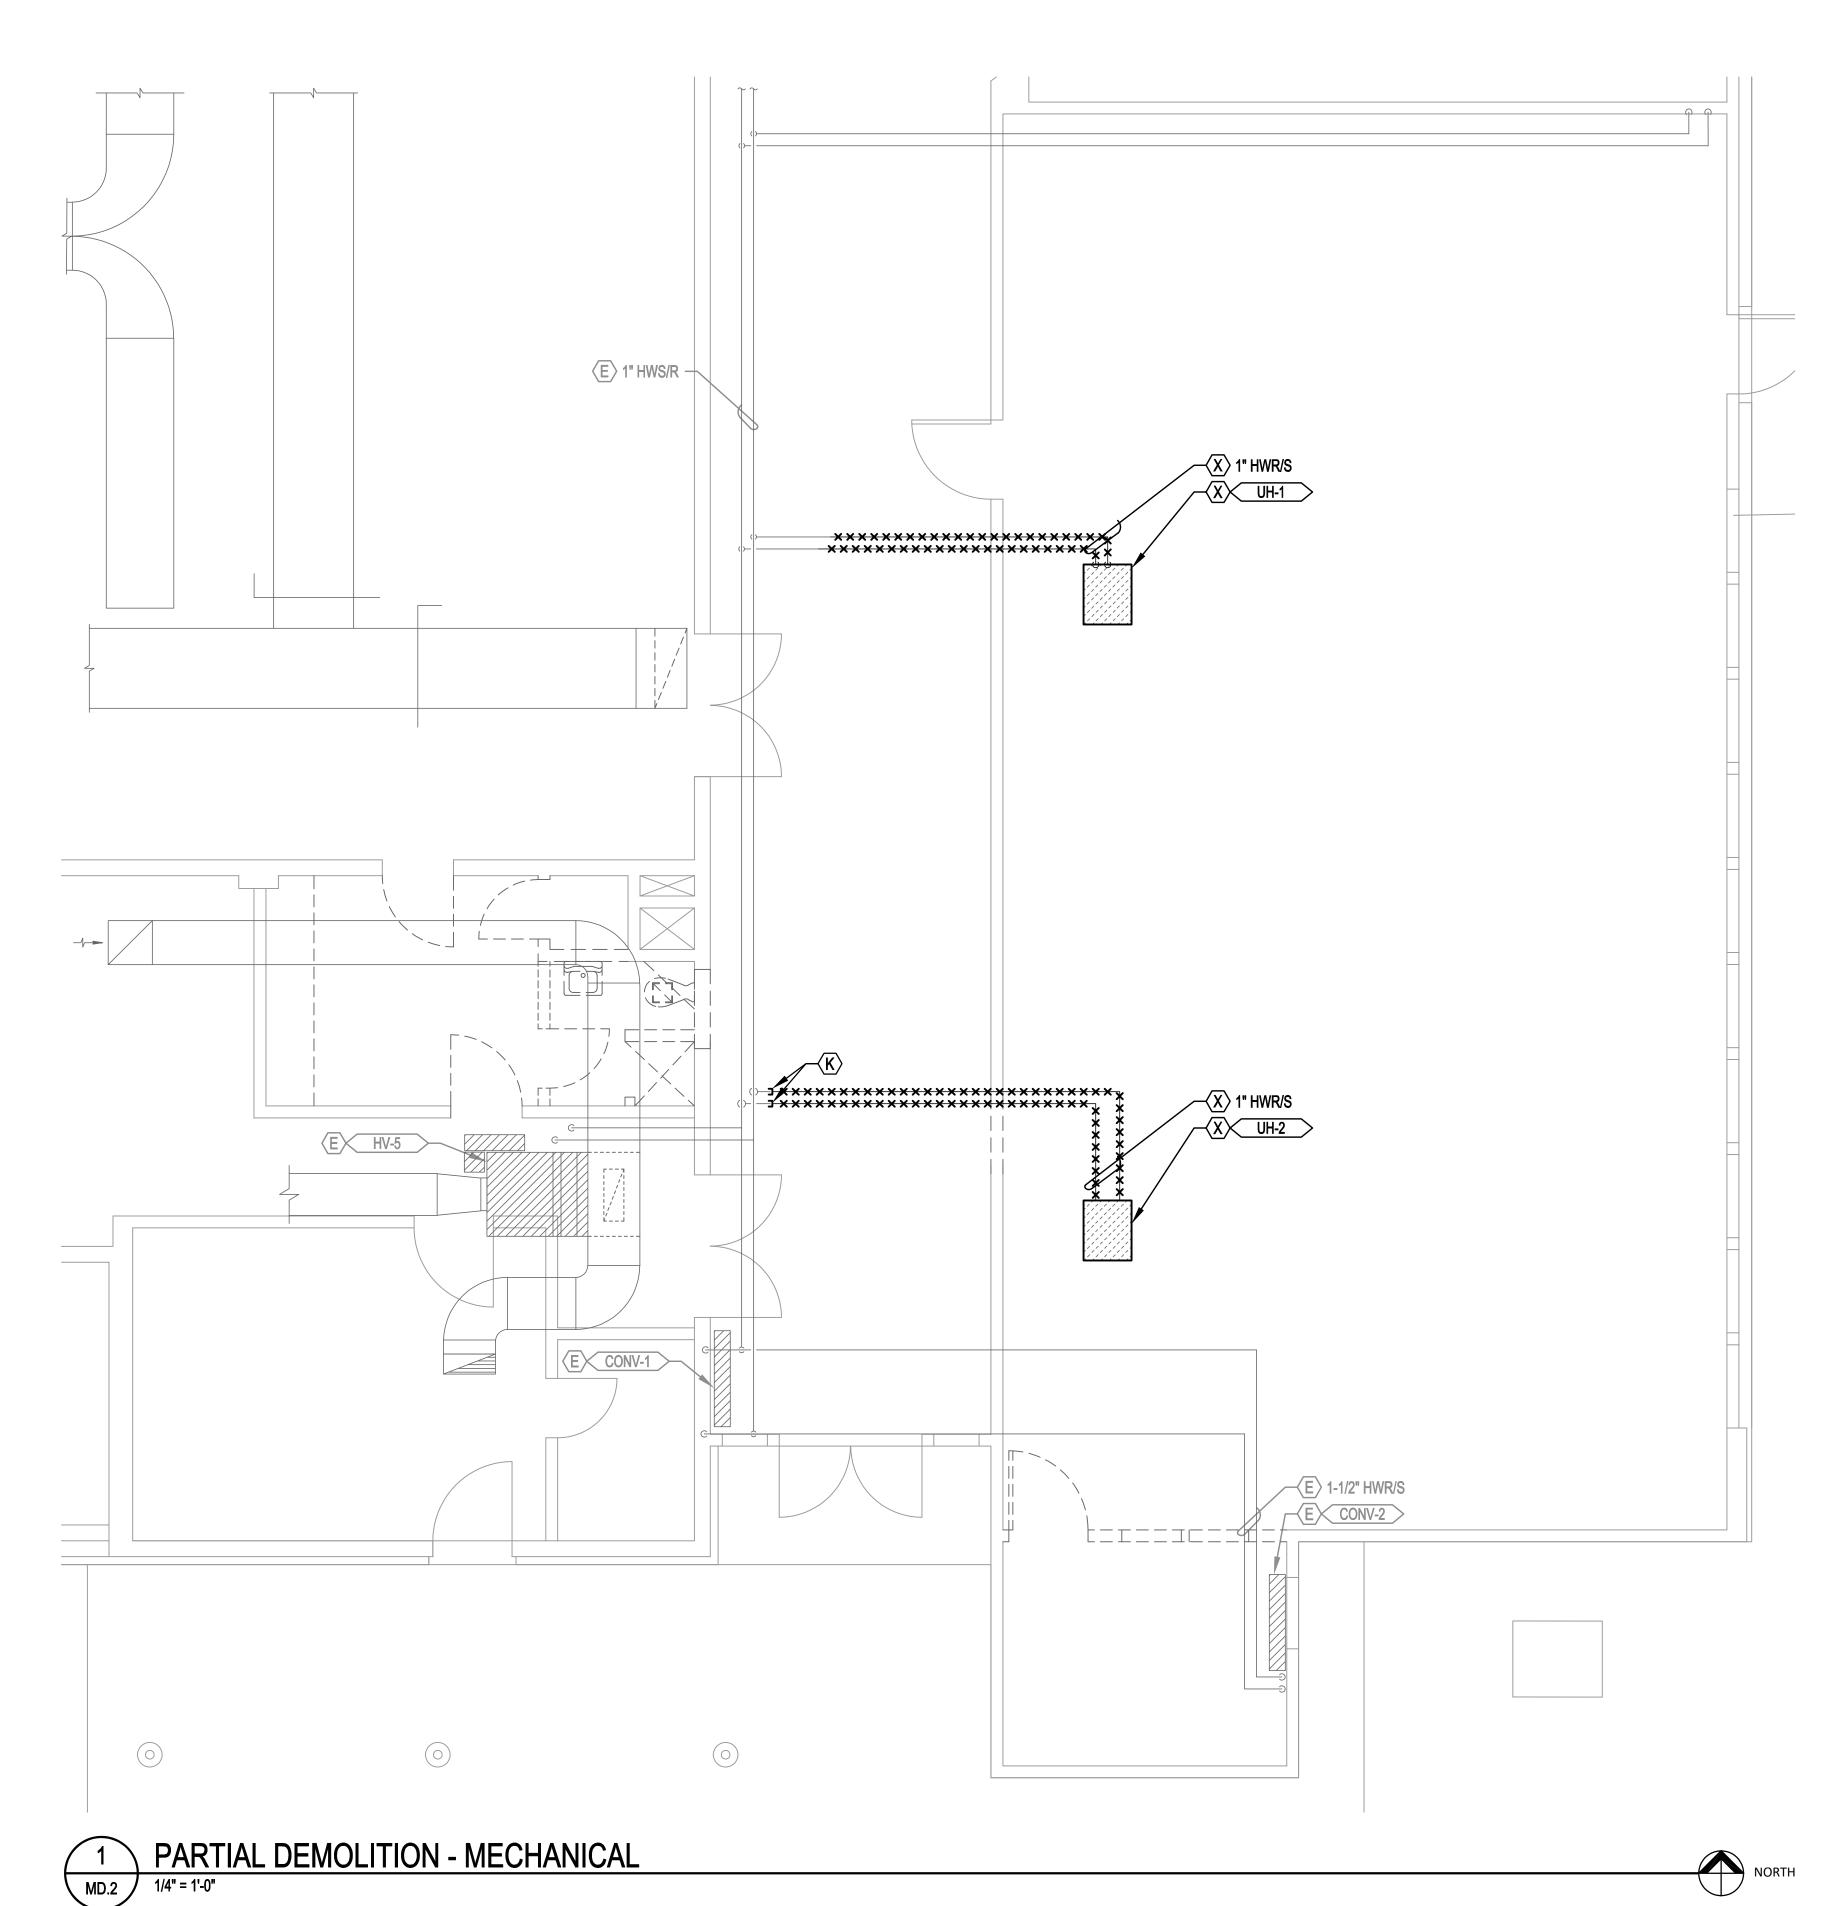

GENERAL NOTES:

A. ALL EXISTING CONDITIONS TO BE FIELD VERIFIED BY THE CONTRACTOR.

B. PATCH AND REPAIR ALL OPENINGS MADE BY REMOVALS.

C. DEMOLITION WORK SHALL INCLUDE BUT NOT BE LIMITED TO THE FOLLOWING: REMOVAL OF EQUIPMENT, SUPPORTS, ANCHORS, PIPING, DUCTWORK AND ALL APPURTENANCES WHERE INDICATED ON PLANS.

D. DEMO MECHANICAL EQUIPMENT, DUCTS AND ASSOCIATED ITEMS AS SHOWN OR RELATED TO EQUIPMENT TO BE REMOVED. CAP DUCTWORK AND PIPING AT NEAREST LIVE BRANCH. PROVIDE SHUTOFF VALVE AND CAP AT TERMINATION.




GMA ARCHITECTS

860 West Park Street / Ste 300

Eugene / Oregon / 97401

p 541.344.9157

gma-arch.com

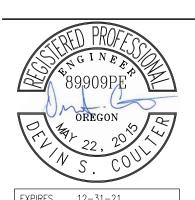

REVISIONS



pae-engineers.com

O 4J KELLY MIDDLE SCHOOL IMPROVEMENTS


JOB NO: 191
ISSUE DATE: 3 MARCH 20

PARTIAL
DEMOLITION -

MECHANICAL

MD.1

MD.2 1/4" = 1'-0"

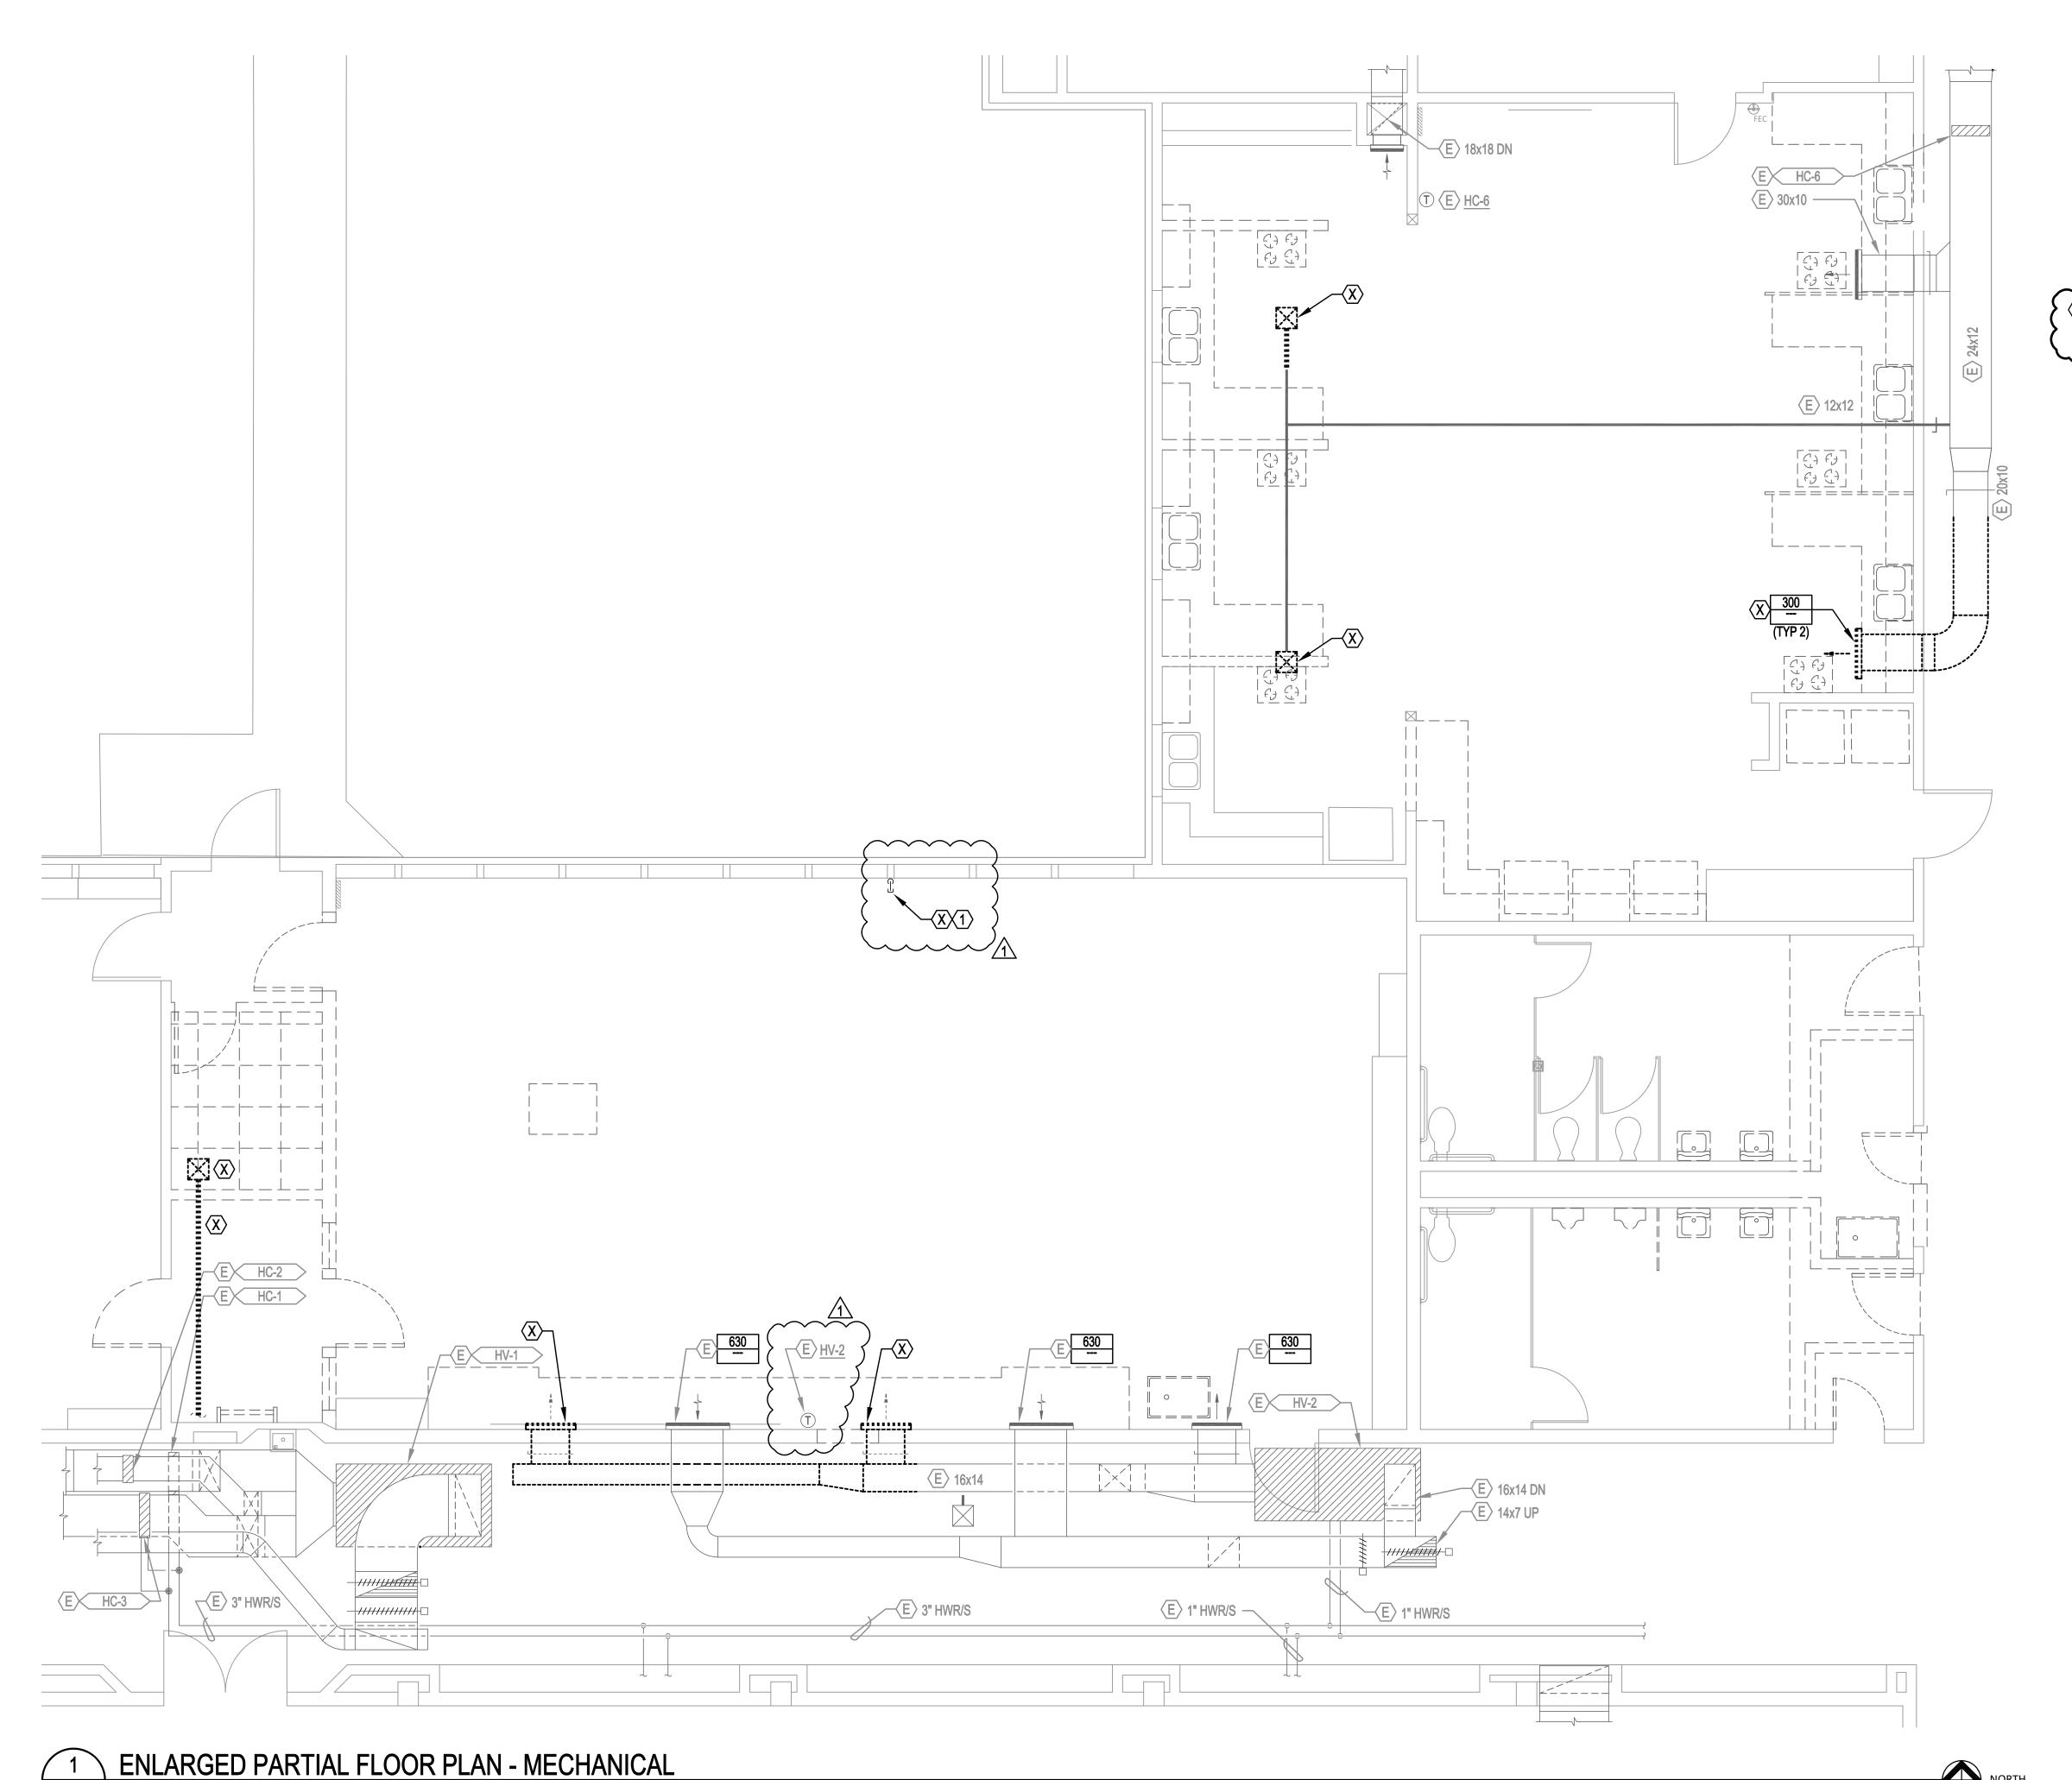

GENERAL NOTES:

A. ALL EXISTING CONDITIONS TO BE FIELD VERIFIED BY THE CONTRACTOR.

B. PATCH AND REPAIR ALL OPENINGS MADE BY REMOVALS.

C. DEMOLITION WORK SHALL INCLUDE BUT NOT BE LIMITED TO THE FOLLOWING: REMOVAL OF EQUIPMENT, SUPPORTS, ANCHORS, PIPING, DUCTWORK AND ALL APPURTENANCES WHERE INDICATED ON PLANS.

D. DEMO MECHANICAL EQUIPMENT, DUCTS AND ASSOCIATED ITEMS AS SHOWN OR RELATED TO EQUIPMENT TO BE REMOVED. CAP DUCTWORK AT NEAREST LIVE BRANCH.


NOTES:

1. DEMO GAS PIPE AND CAP ABOVE CEILING.

GMA ARCHITECT

GMA ARCHITECTS

860 West Park Street / Ste 300
Eugene / Oregon / 97401
p 541.344.9157
gma-arch.com

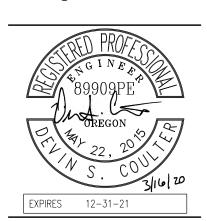



pae-engineers.com

REVISIONS

3/17/2020 ADD. 1

D 4J KELLY MIDDLE SCHOOL IMPROVEMENTS

ESD 4J KELLY P 850 HOWARD AVE, E

PARTIAL DEMOLITION -MECHANICAL



ISSUE DATE:


A. ALL EXISTING CONDITIONS TO BE FIELD VERIFIED BY THE CONTRACTOR.

B. PATCH AND REPAIR ALL OPENINGS MADE BY REMOVALS.

C. DEMOLITION WORK SHALL INCLUDE BUT NOT BE LIMITED TO THE FOLLOWING: REMOVAL OF EQUIPMENT, SUPPORTS, ANCHORS, PIPING, DUCTWORK AND ALL APPURTENANCES WHERE INDICATED ON PLANS.

D. DEMO MECHANICAL EQUIPMENT, DUCTS AND ASSOCIATED ITEMS AS SHOWN OR RELATED TO EQUIPMENT TO BE REMOVED. CAP DUCTWORK AT NEAREST LIVE BRANCH.



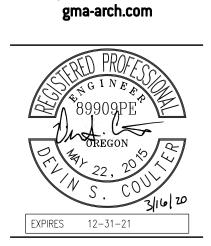



pae-engineers.com

REVISIONS

3/17/2020 ADD. 1


KELLY MIDDLE SCHOOL IMPROVEMENTS


850 HOWARD AVE, EUG

JOB NO:
ISSUE DATE: 3

PARTIAL DEMOLITION -MECHANICAL

<u>MD.3</u>

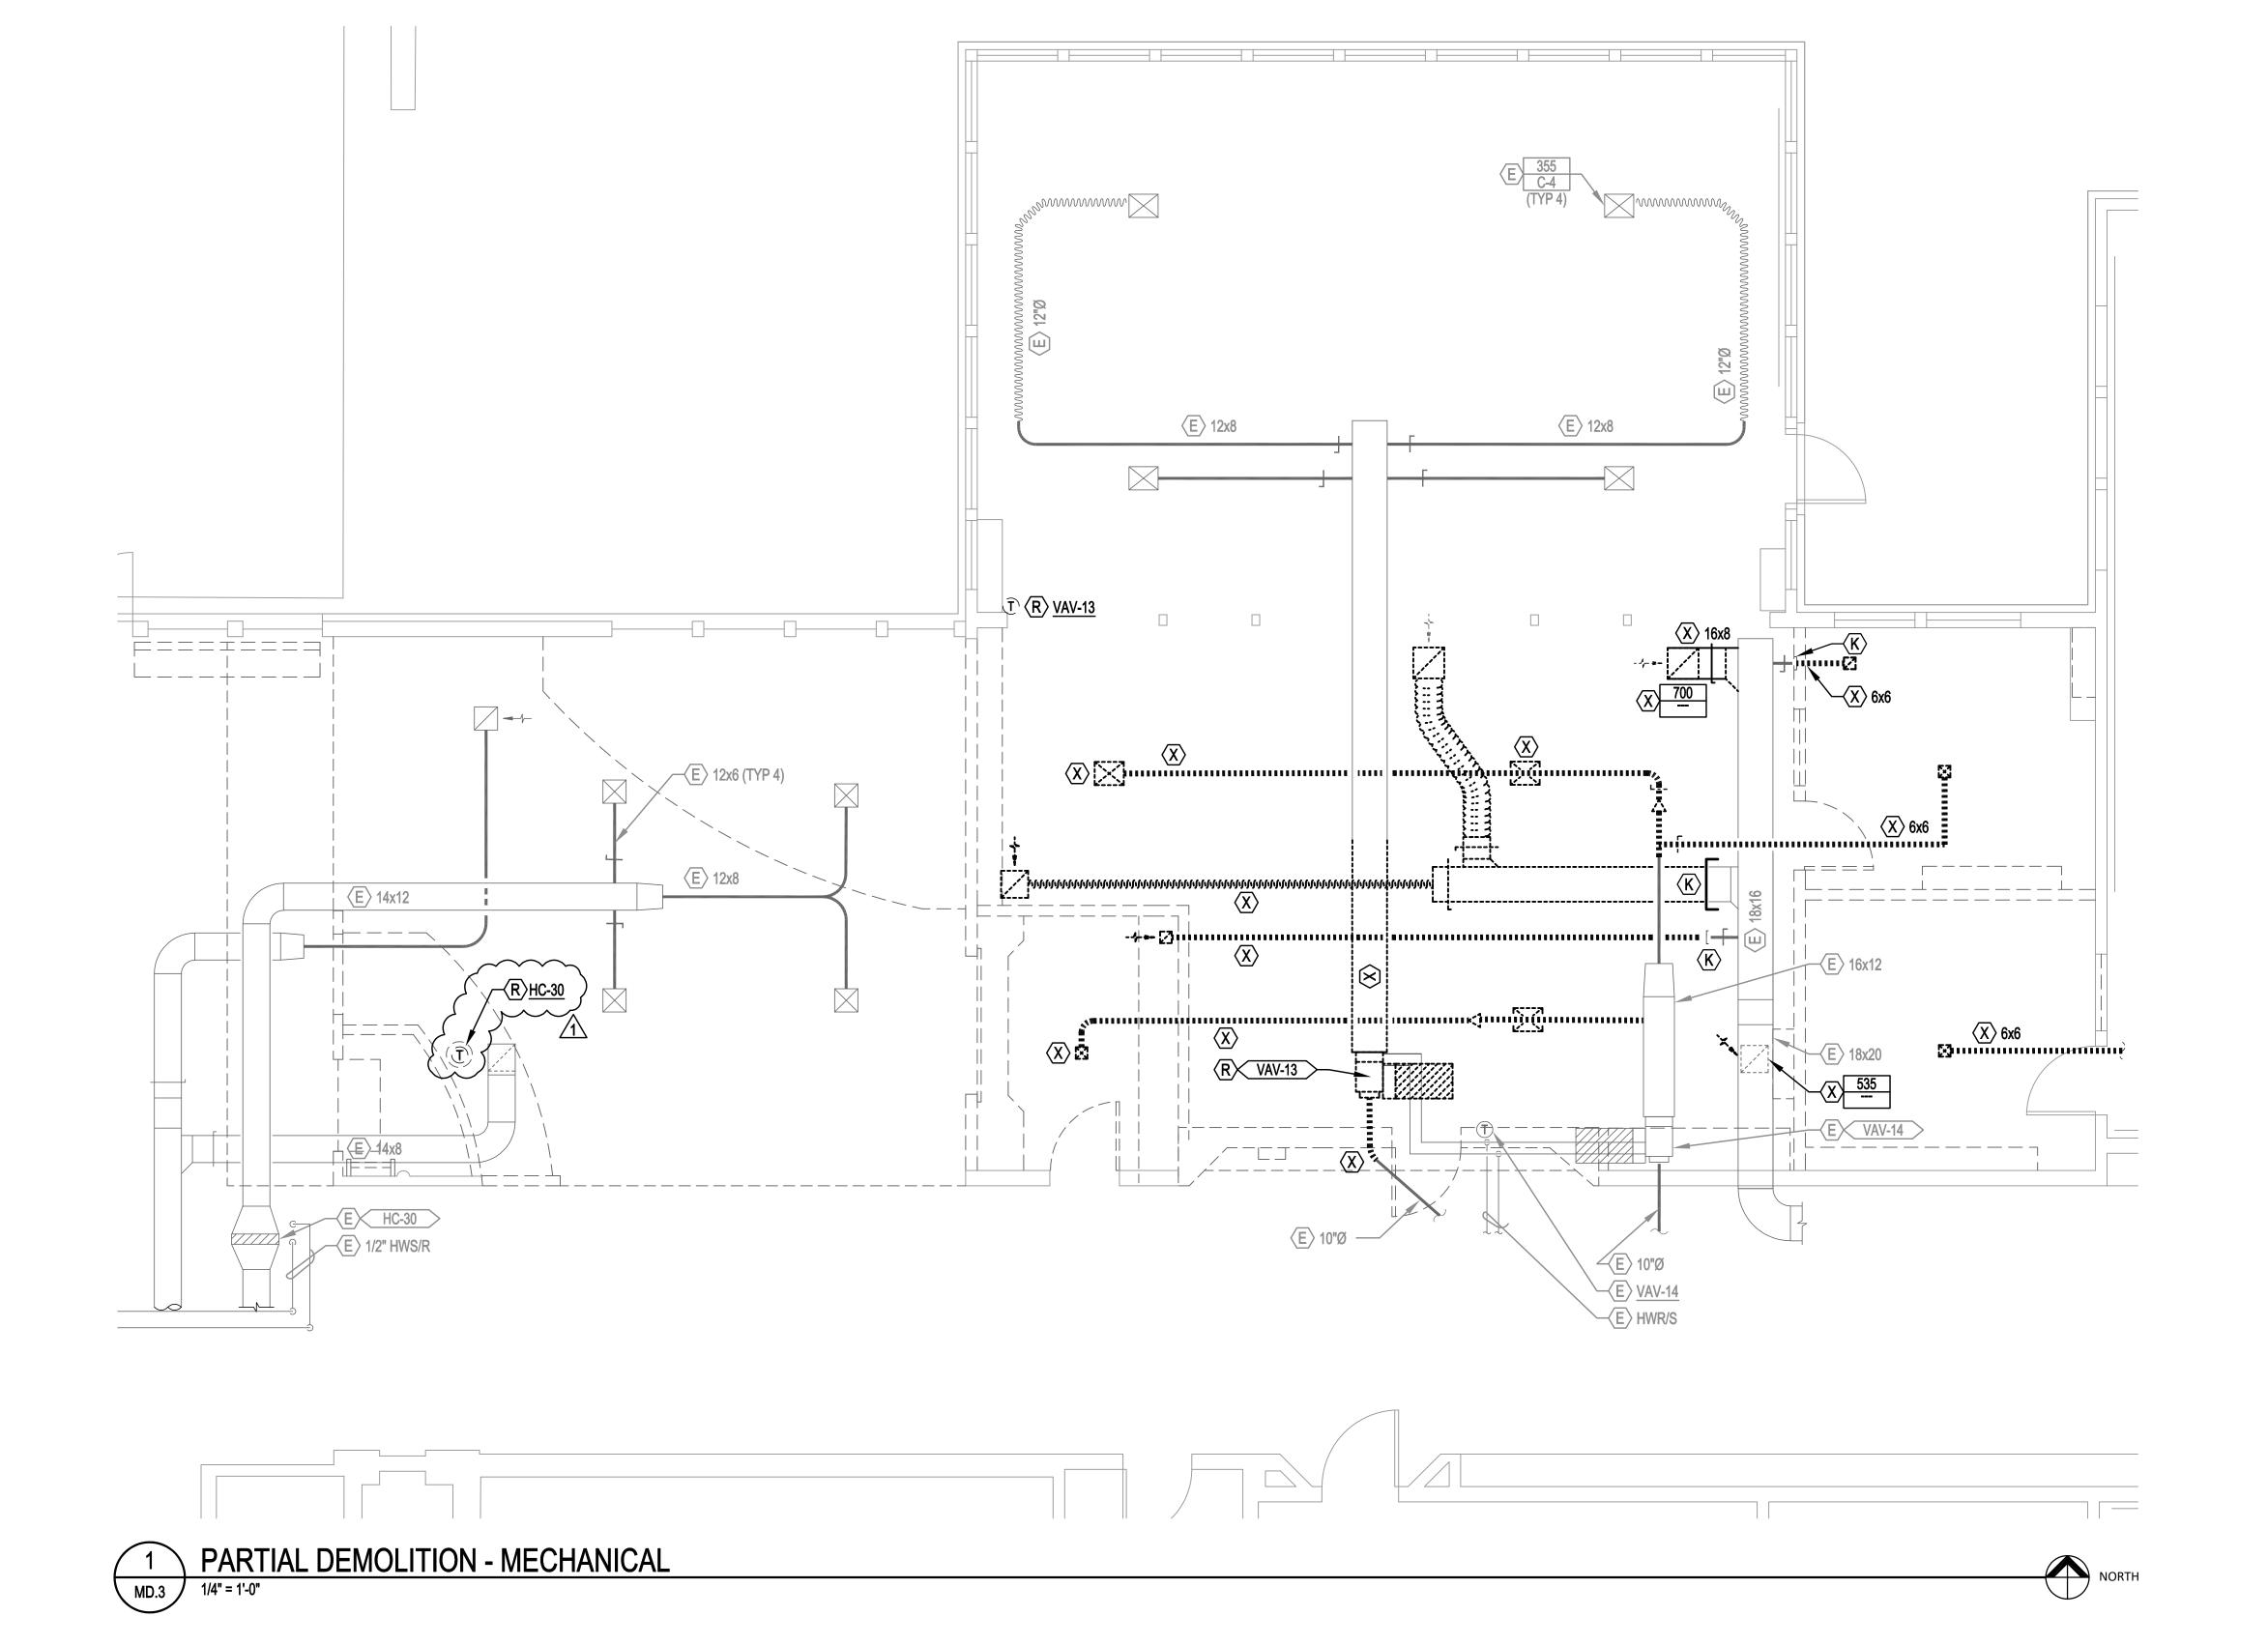

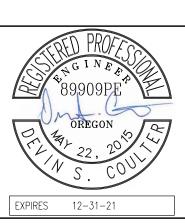

JOB NO:

M1.4

1 M1.5

M1.3

1 M1.1

1 M1.2

ISSUE DATE: OVERALL FLOOR PLAN - HVAC

NORTH S ______

OVERALL FLOOR PLAN - HVAC


M1.0

1/32" = 1'-0"

<u>M1.1</u>





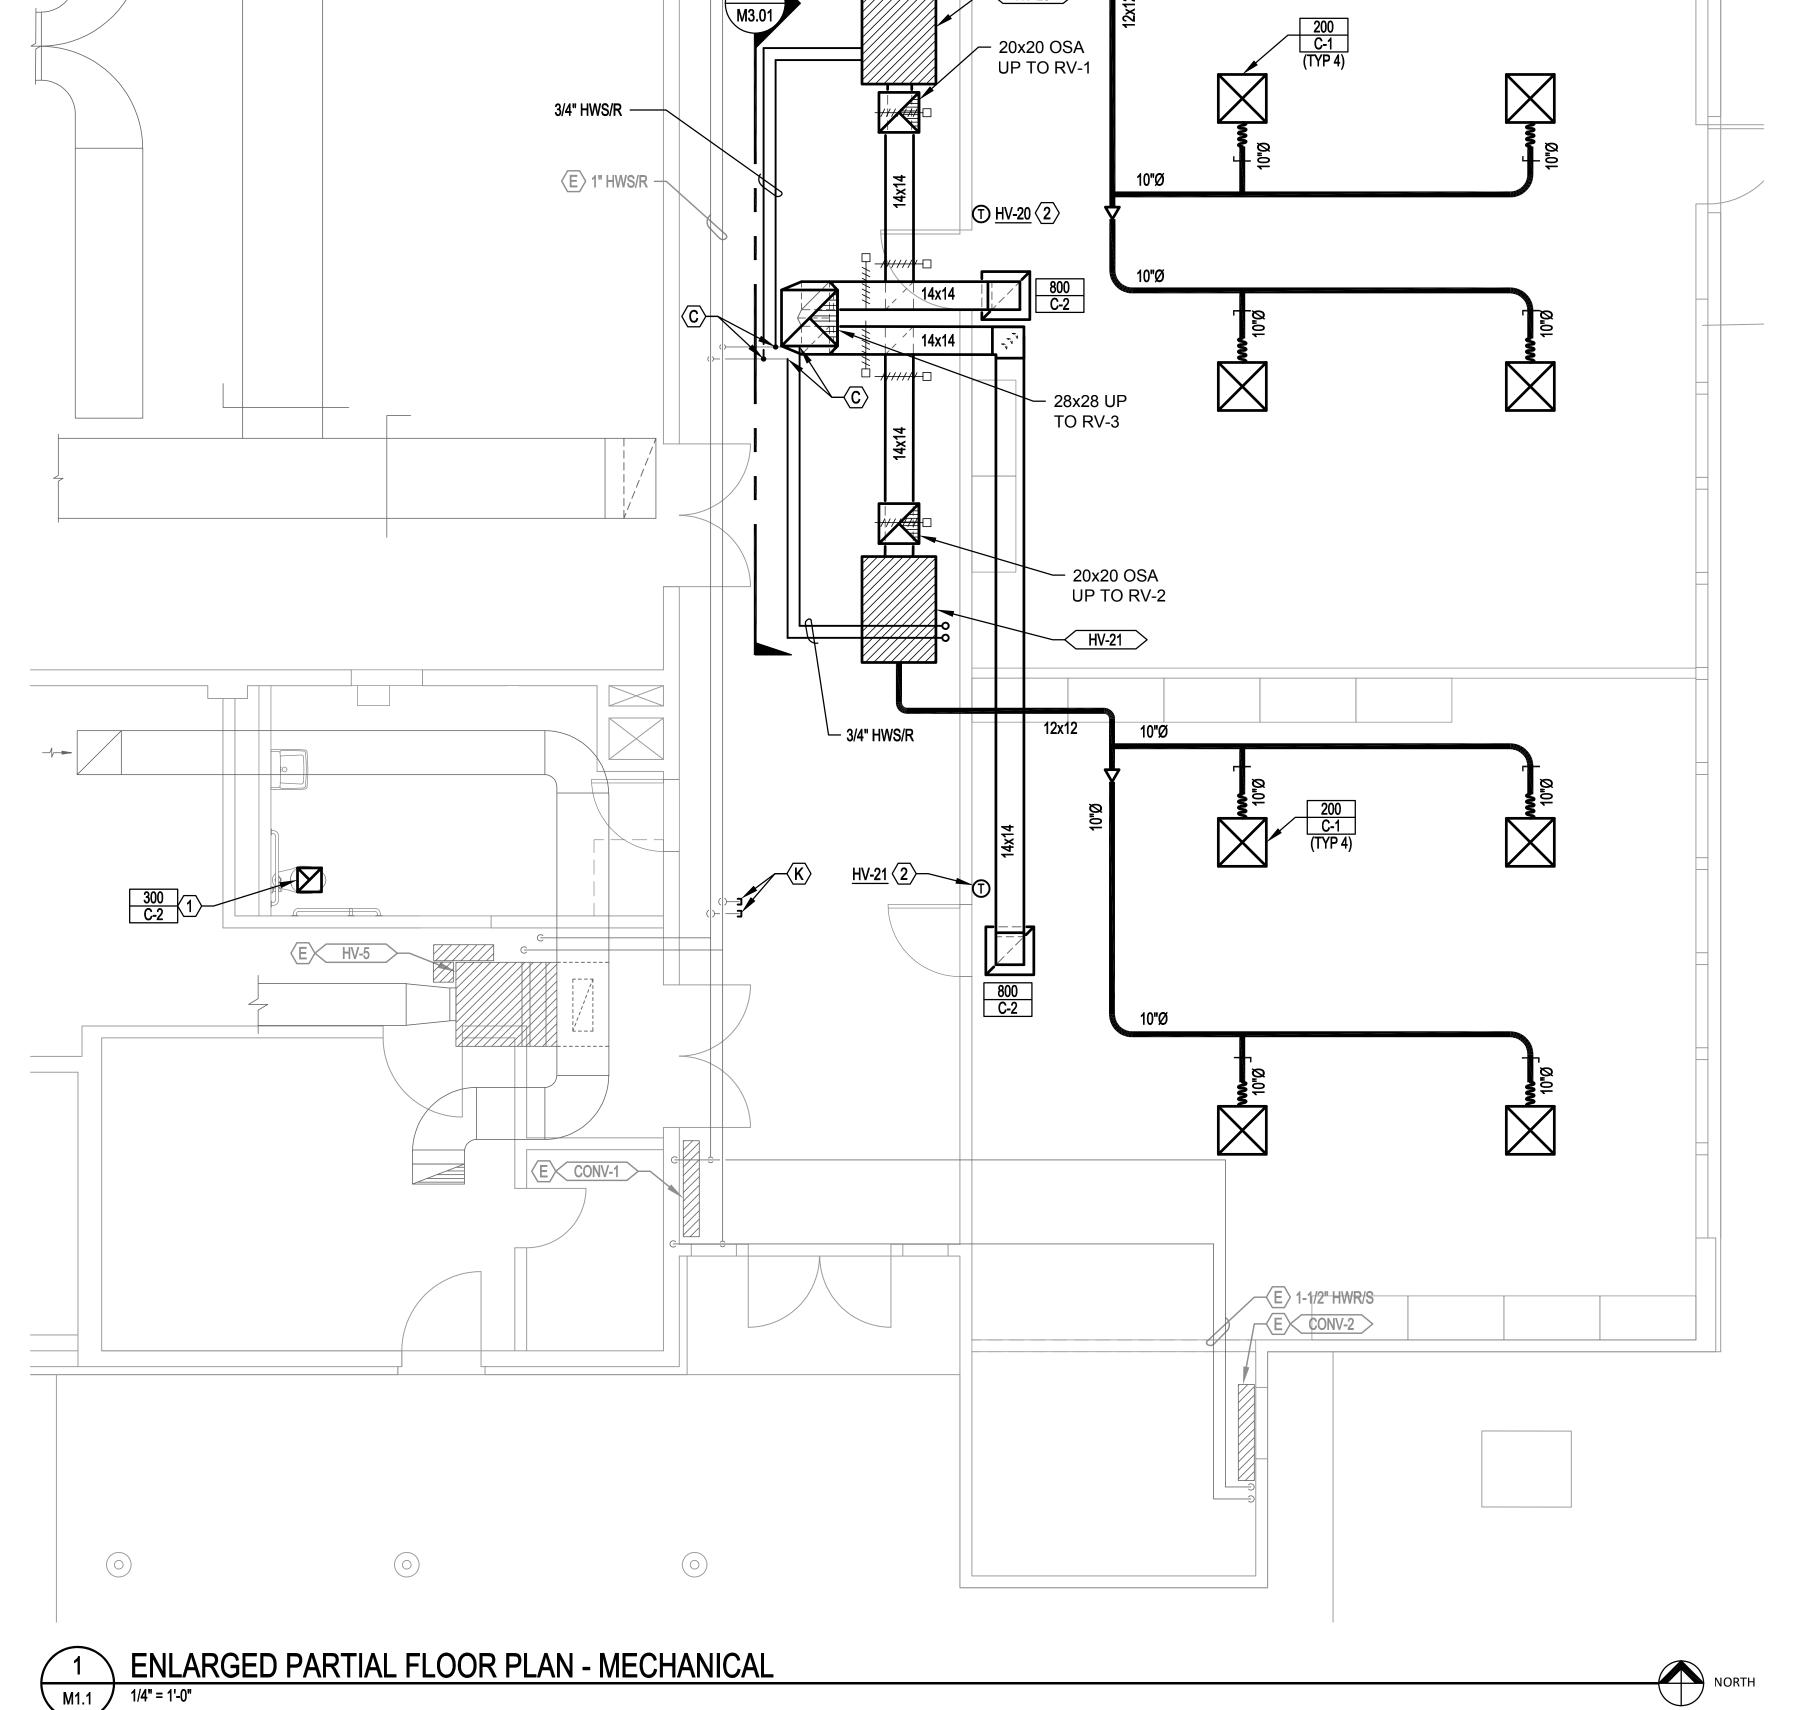

HV-20

GENERAL NOTES:

A. INSTALL DUCTS CONCEALED, UNLESS SPECIFIED OTHERWISE, AND CLEAR OF CEILING INSERTS. ALL DUCTWORK TO BE INSTALLED AS CLOSE AS POSSIBLE TO WALL AND UNDERSIDE OF BEAMS AND JOISTS.

B. COORDINATE WORK WITH ALL TRADES INVOLVED. OFFSETS IN DUCTS AND TRANSITIONS AROUND OBSTRUCTIONS SHALL BE PROVIDED AT NO ADDITIONAL COST TO THE OWNER.

C. VERIFY ALL EQUIPMENT CONNECTIONS WITH MANUFACTURER'S CERTIFIED DRAWINGS. VERIFY AND PROVIDE DUCT TRANSITIONS TO FURNISHED EQUIPMENT. FIELD VERIFY AND COORDINATE ALL DIMENSIONS PRIOR TO FABRICATION.

D. REFER TO ARCHITECTURAL REFLECTED CEILING PLANS FOR EXACT LOCATIONS OF AIR DEVICES.

E. THERMOSTATS ARE SHOWN FOR REFERENCE LOCATION ONLY, TO BE OF/OI.

NOTES:

1. 10x10 EXH UP TO EF-7 IN MECH PLATFORM. COORDINATE FAN LOCATION AROUND EXISTING HV SYSTEM TO MAINTAIN SERVICE CLEARANCE. EF-7 DISCHARGE EXH TO TERMINATE AT NEW RV-4 IN ROOF. RV-4 EXHAUST VENTILATOR TO BE LOCATED ON ROOF TO MAINTAIN MINIMUM 10'-0" FROM OSA INTAKES ON ROOF.

2. PROVIDE CONDUIT AND WALL BOX FOR DDC SPACE SENSOR. PROVIDE CONDUIT BACK TO EXISTING DDC CONTROLLER LOCATION AT FAN. COORDINATE FINAL LOCATION OF WALL BOX WITH OWNER.

GMA ARCHITECTS 860 West Park Street / Ste 300 Eugene / Oregon / 97401 p 541.344.9157 gma-arch.com



REVISIONS



pae-engineers.com

S **PROVEMENT**

JOB NO:


ENLARGED PARTIAL FLOOR PLAN -

M1.1

MECHANICAL

ENLARGED PARTIAL FLOOR PLAN - MECHANICAL

M1.2

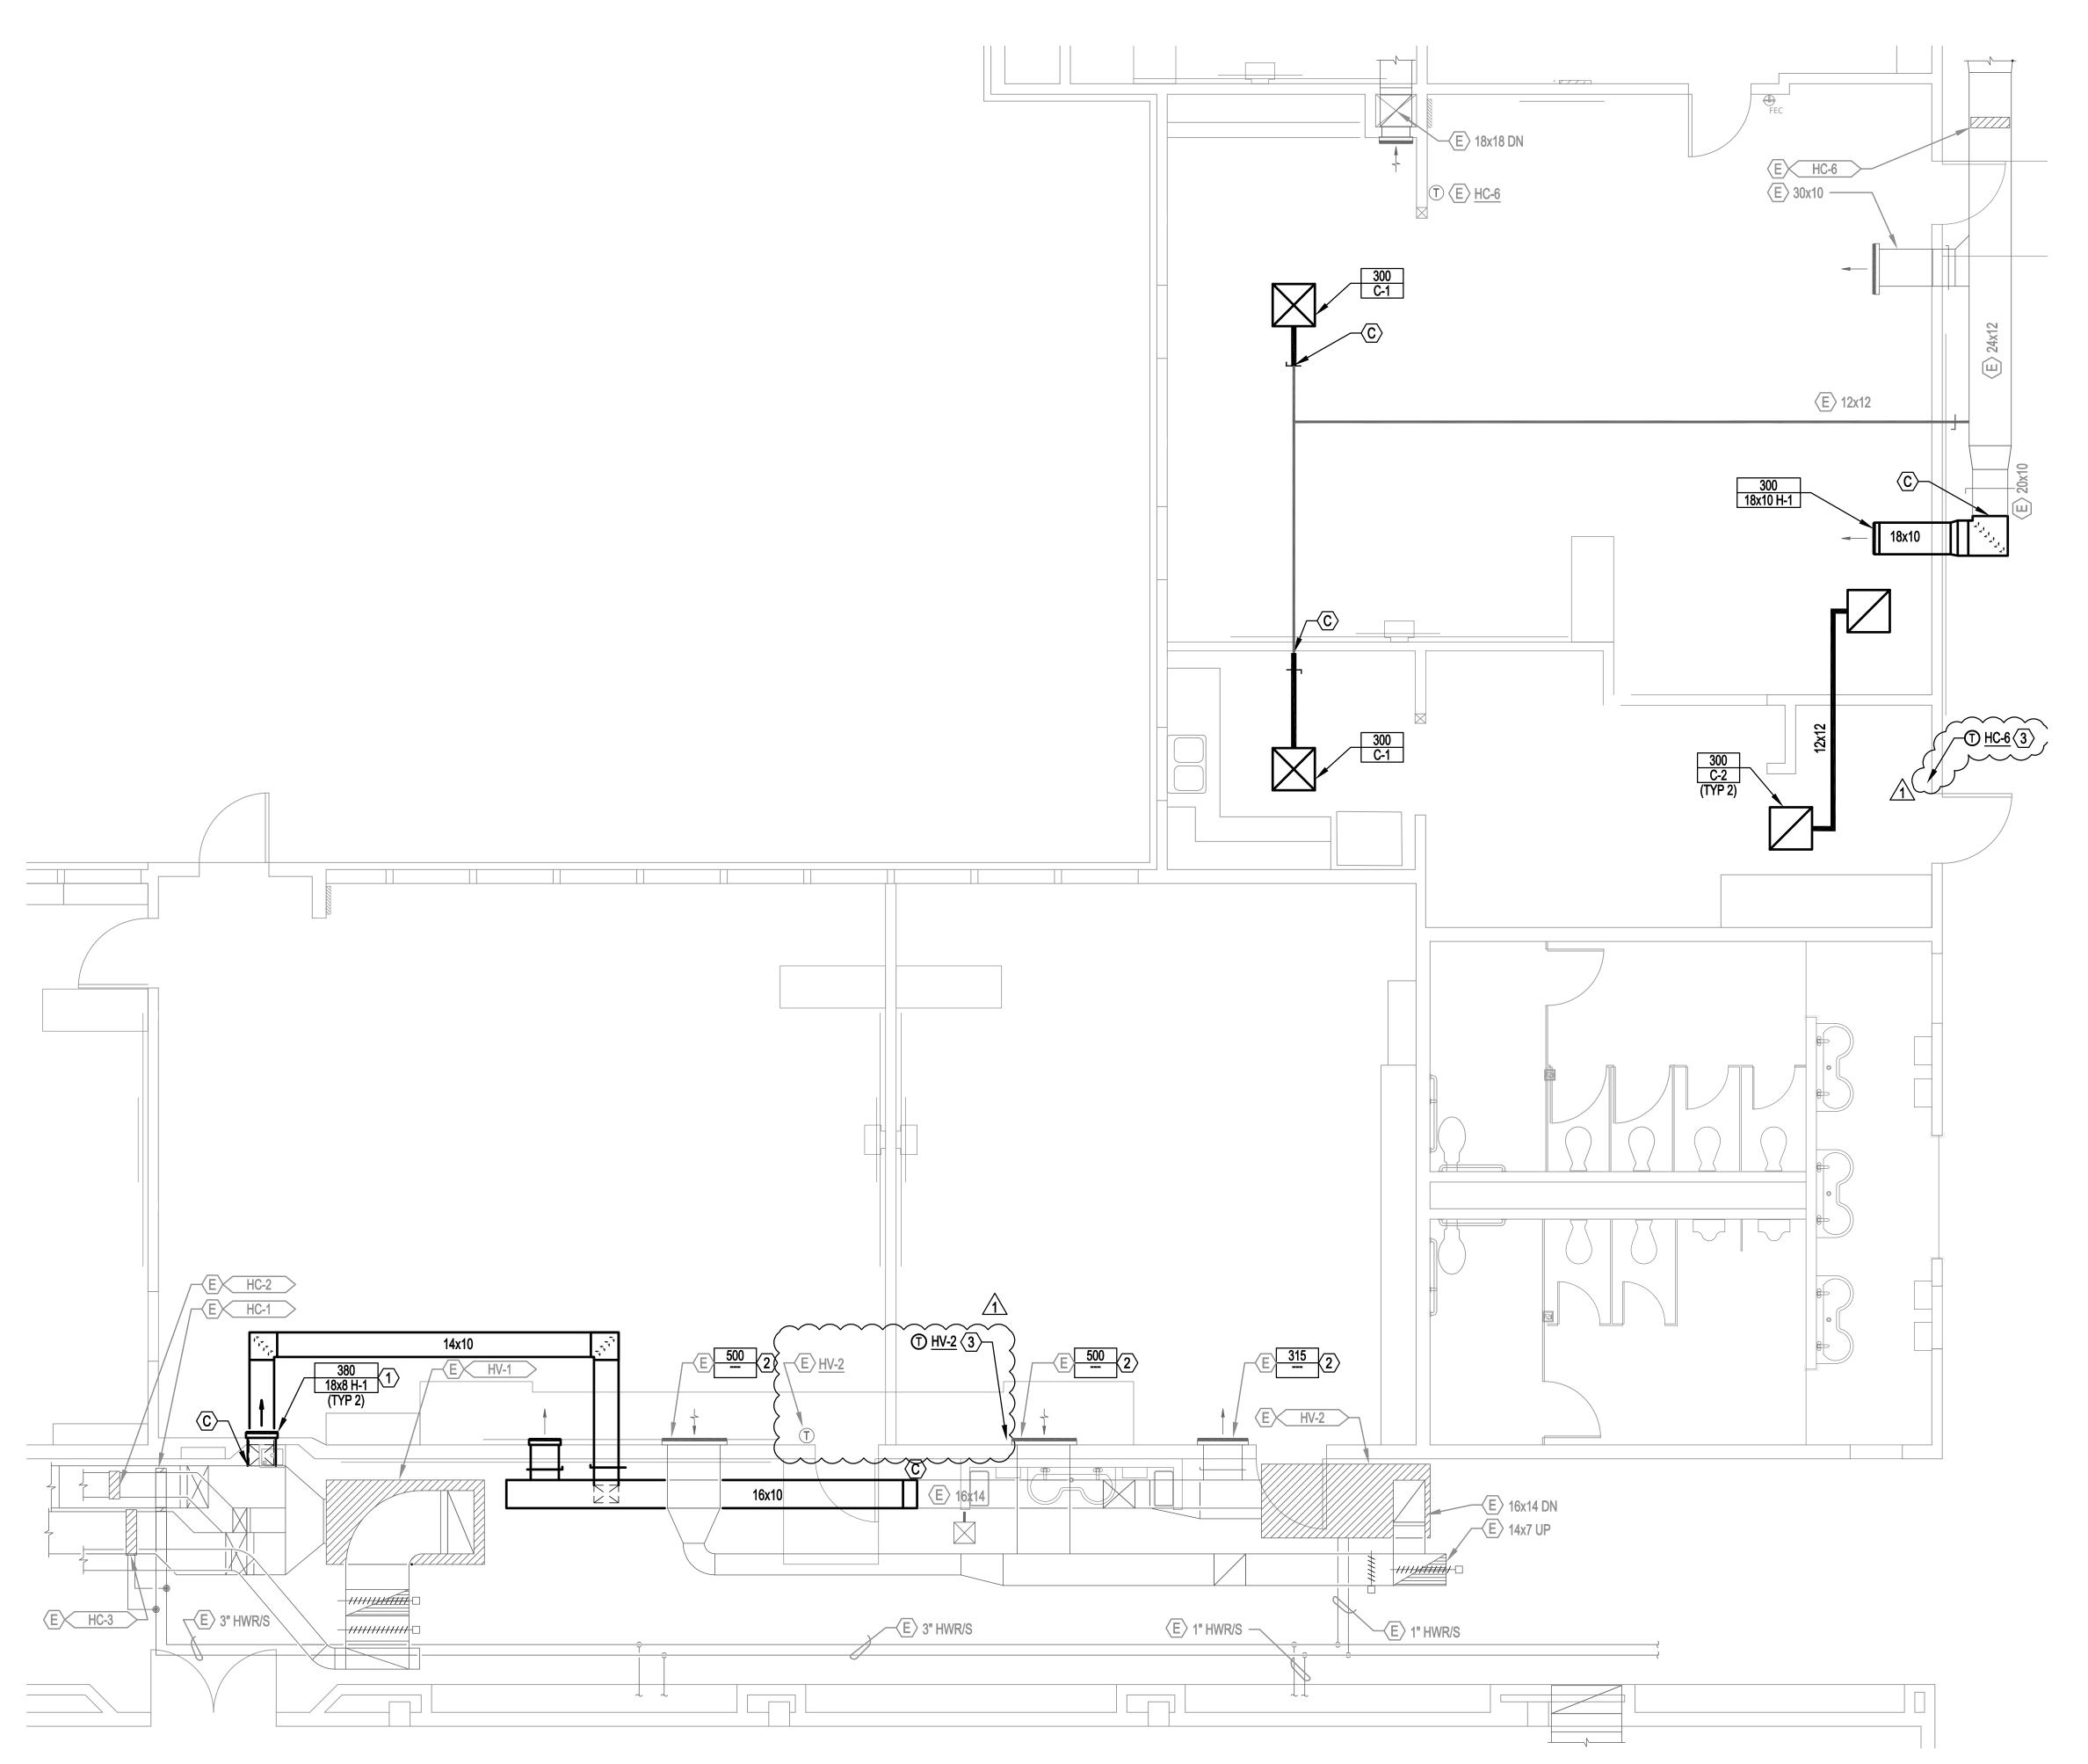

GENERAL NOTES:

A. INSTALL DUCTS CONCEALED, UNLESS SPECIFIED OTHERWISE, AND CLEAR OF CEILING INSERTS. ALL DUCTWORK TO BE INSTALLED AS CLOSE AS POSSIBLE TO WALL AND UNDERSIDE OF BEAMS AND JOISTS.

B. COORDINATE WORK WITH ALL TRADES INVOLVED. OFFSETS IN DUCTS AND TRANSITIONS AROUND OBSTRUCTIONS SHALL BE PROVIDED AT NO ADDITIONAL COST TO THE OWNER.

C. VERIFY ALL EQUIPMENT CONNECTIONS WITH MANUFACTURER'S CERTIFIED DRAWINGS. VERIFY AND PROVIDE DUCT TRANSITIONS TO FURNISHED EQUIPMENT. FIELD VERIFY AND COORDINATE ALL DIMENSIONS PRIOR TO FABRICATION.

D. REFER TO ARCHITECTURAL REFLECTED CEILING PLANS FOR EXACT LOCATIONS OF AIR DEVICES.

E. THERMOSTATS ARE SHOWN FOR REFERENCE LOCATION ONLY, TO BE OF/OI.

NOTES:


1. SIDEWALL GRILLE MOUNTING HEIGHT TO MATCH EXISTING SIDEWALL GRILLES IN SPACE.

2. REBALANCE GRILLE TO AIRFLOW AS INDICATED.

3. PROVIDE CONDUIT AND WALL BOX FOR DDC SPACE SENSOR. PROVIDE CONDUIT BACK TO EXISTING DDC CONTROLLER LOCATION AT FAN. COORDINATE FINAL LOCATION OF WALL BOX WITH OWNER.

CMA APCHITEC

GMA ARCHITECTS
860 West Park Street / Ste 300
Eugene / Oregon / 97401
p 541.344.9157
gma-arch.com

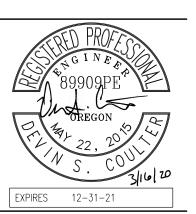



REVISIONS

REVISIONS

3/17/2020 ADD. 1

3 4J KELLY MIDDLE SCHOOL IMPROVEMENTS

850 HOW


JOB NO:
ISSUE DATE:

FNI ARGFI

ENLARGED
PARTIAL FLOOR
PLAN MECHANICAL

M1.2

M1.3 1/4" = 1'-0"

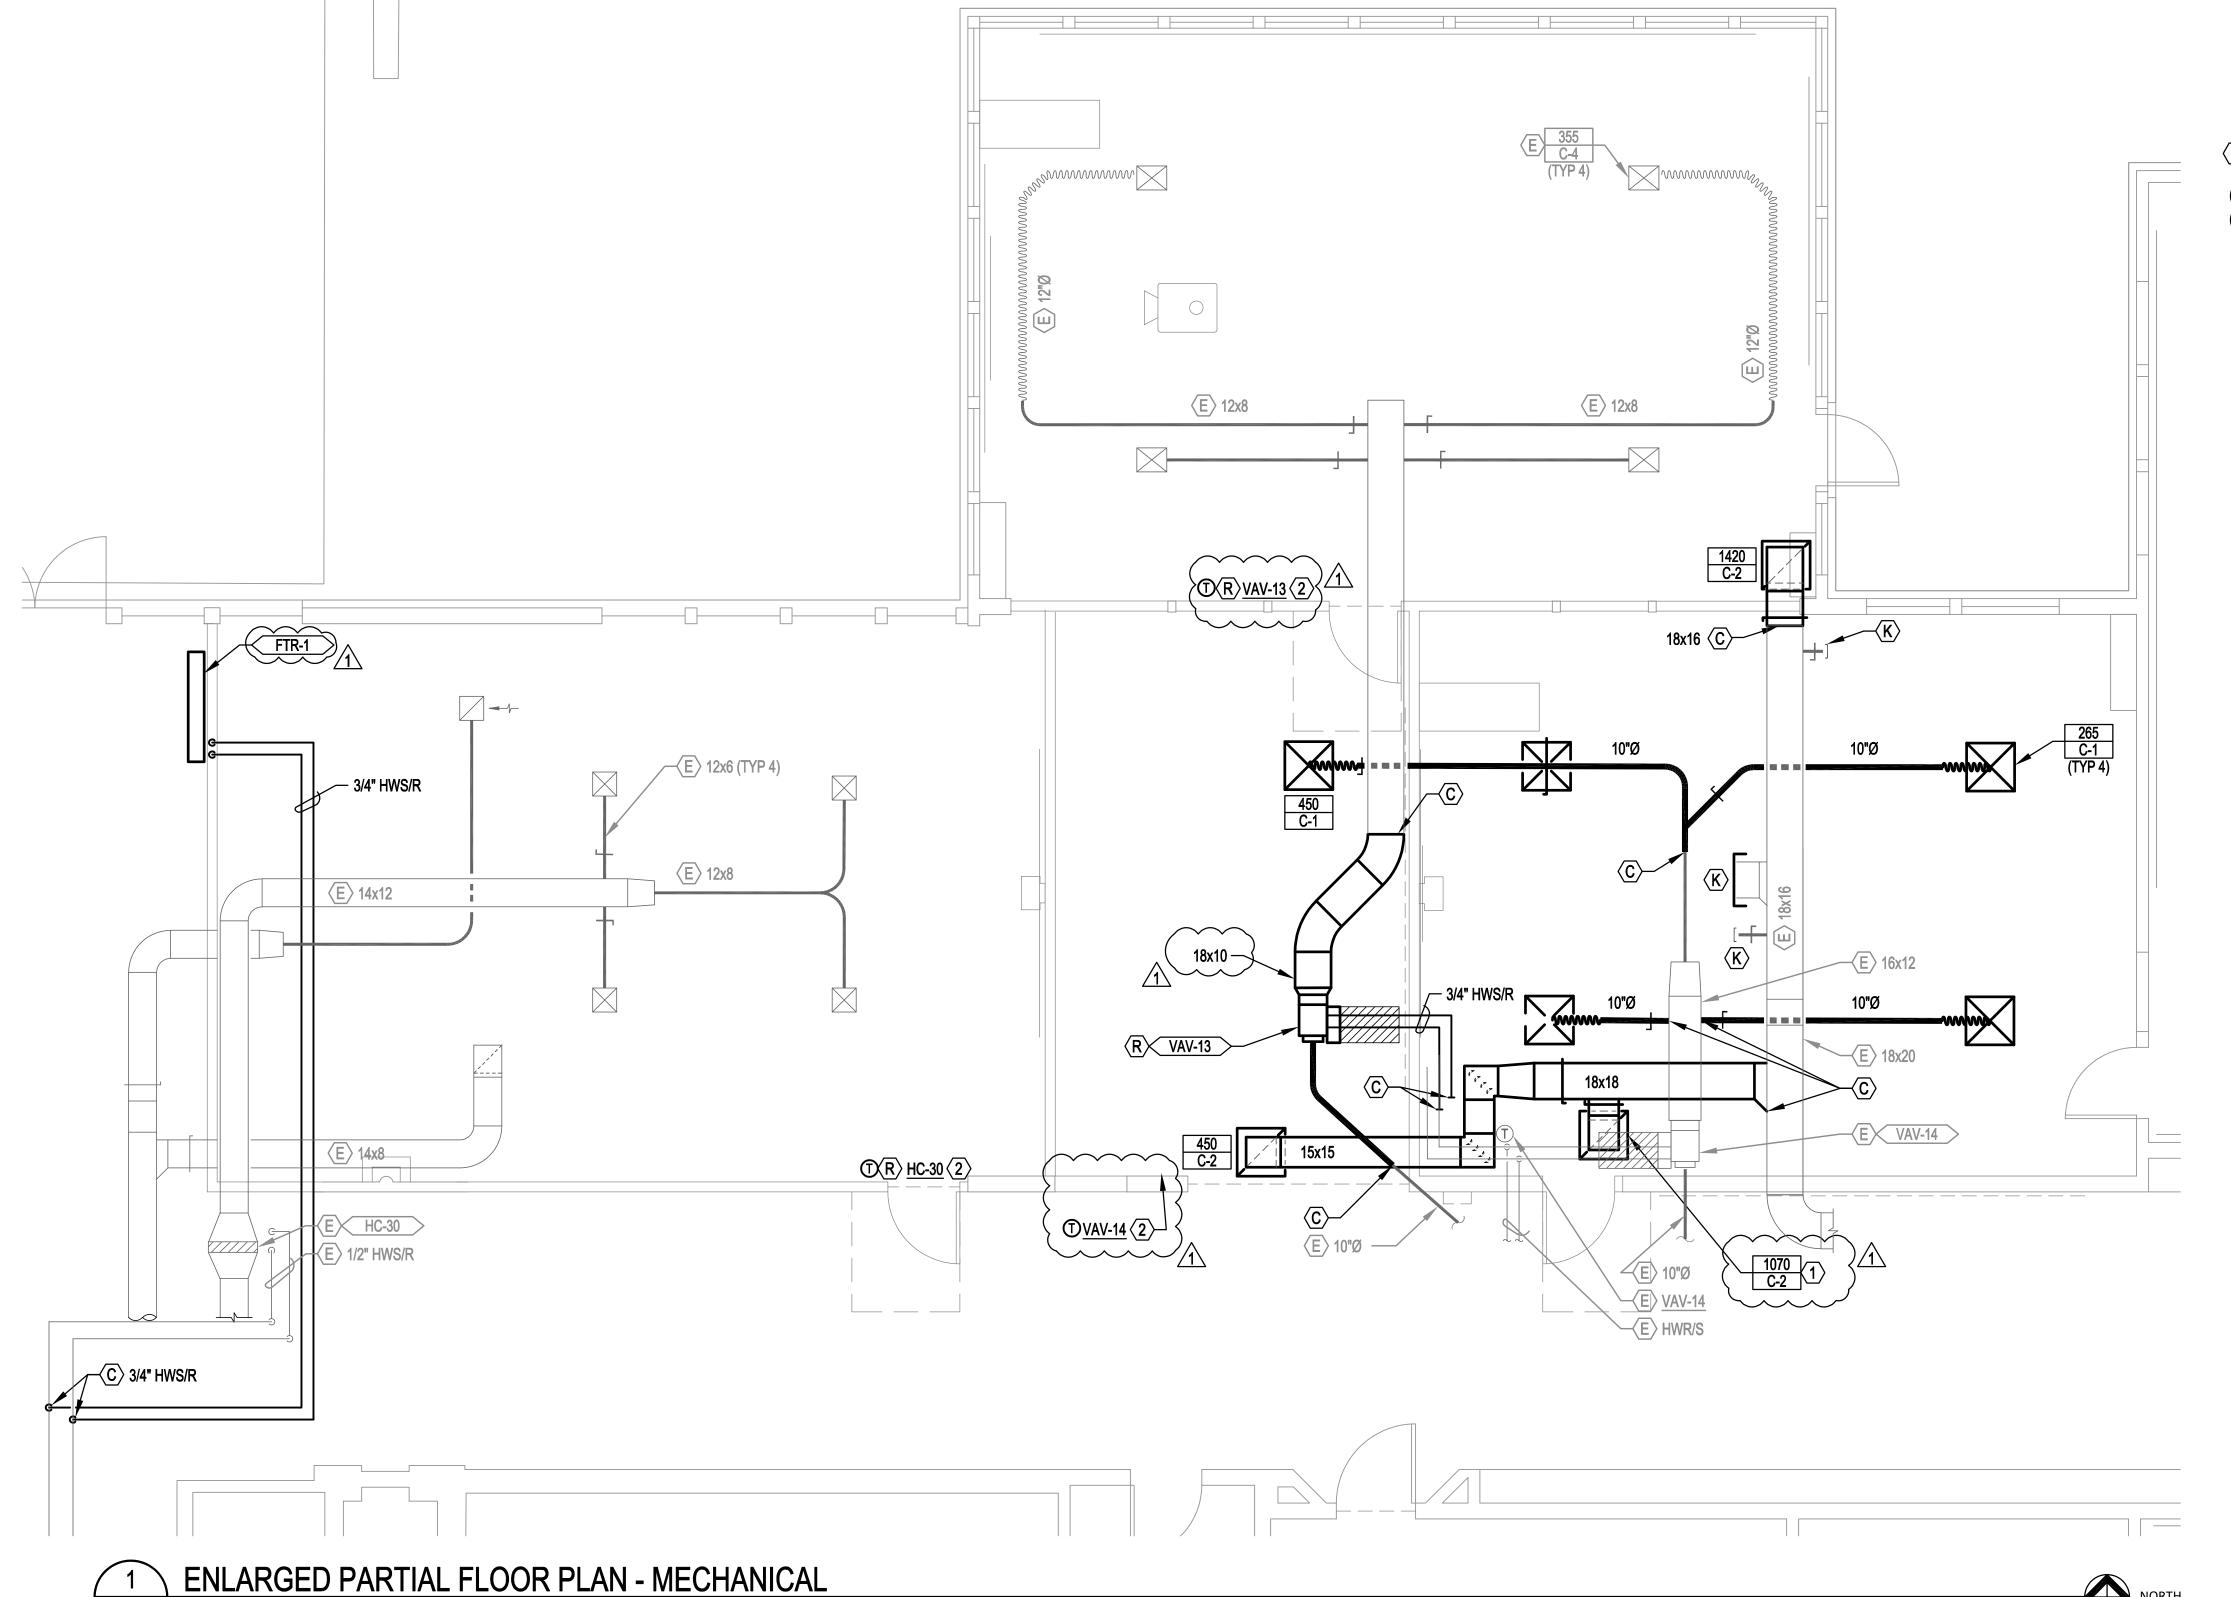

GENERAL NOTES:

A. INSTALL DUCTS CONCEALED, UNLESS SPECIFIED OTHERWISE, AND CLEAR OF CEILING INSERTS. ALL DUCTWORK TO BE INSTALLED AS CLOSE AS POSSIBLE TO WALL AND UNDERSIDE OF BEAMS AND JOISTS.

B. COORDINATE WORK WITH ALL TRADES INVOLVED. OFFSETS IN DUCTS AND TRANSITIONS AROUND OBSTRUCTIONS SHALL BE PROVIDED AT NO ADDITIONAL COST TO THE OWNER.

C. VERIFY ALL EQUIPMENT CONNECTIONS WITH MANUFACTURER'S CERTIFIED DRAWINGS. VERIFY AND PROVIDE DUCT TRANSITIONS TO FURNISHED EQUIPMENT. FIELD VERIFY AND COORDINATE ALL DIMENSIONS PRIOR TO FABRICATION.

D. REFER TO ARCHITECTURAL REFLECTED CEILING PLANS FOR EXACT LOCATIONS OF AIR DEVICES.

E. THERMOSTATS ARE SHOWN FOR REFERENCE LOCATION ONLY, TO BE OF/OI.



EXPIRES 12-31-21

pae-engineers.com

GMA ARCHITECTS
860 West Park Street / Ste 300

Eugene / Oregon / 97401

p 541.344.9157

gma-arch.com

REVISIONS

3/17/2020 ADD. 1

NOTES:

1. LOCATE RA GRILLE IN CEILING SUCH THAT
MINIMUM 3'-0" SERVICE CLEARANCE TO NEARBY
TERMINAL UNIT IS MAINTAINED.

2. PROVIDE CONDUIT AND WALL BOX FOR DDC SPACE SENSOR. PROVIDE CONDUIT BACK TO EXISTING DDC CONTROLLER LOCATION AT FAN. COORDINATE FINAL LOCATION OF WALL BOX WITH OWNER.

ESD 4J KELLY MIDDLE SCHOOL IMPROVEMENTS

850 HOWARD AV


JOB NO: ISSUE DATE:

> ENLARGED PARTIAL FLOOR PLAN -MECHANICAL

> > M1.3

M1.4

1/4" = 1'-0"

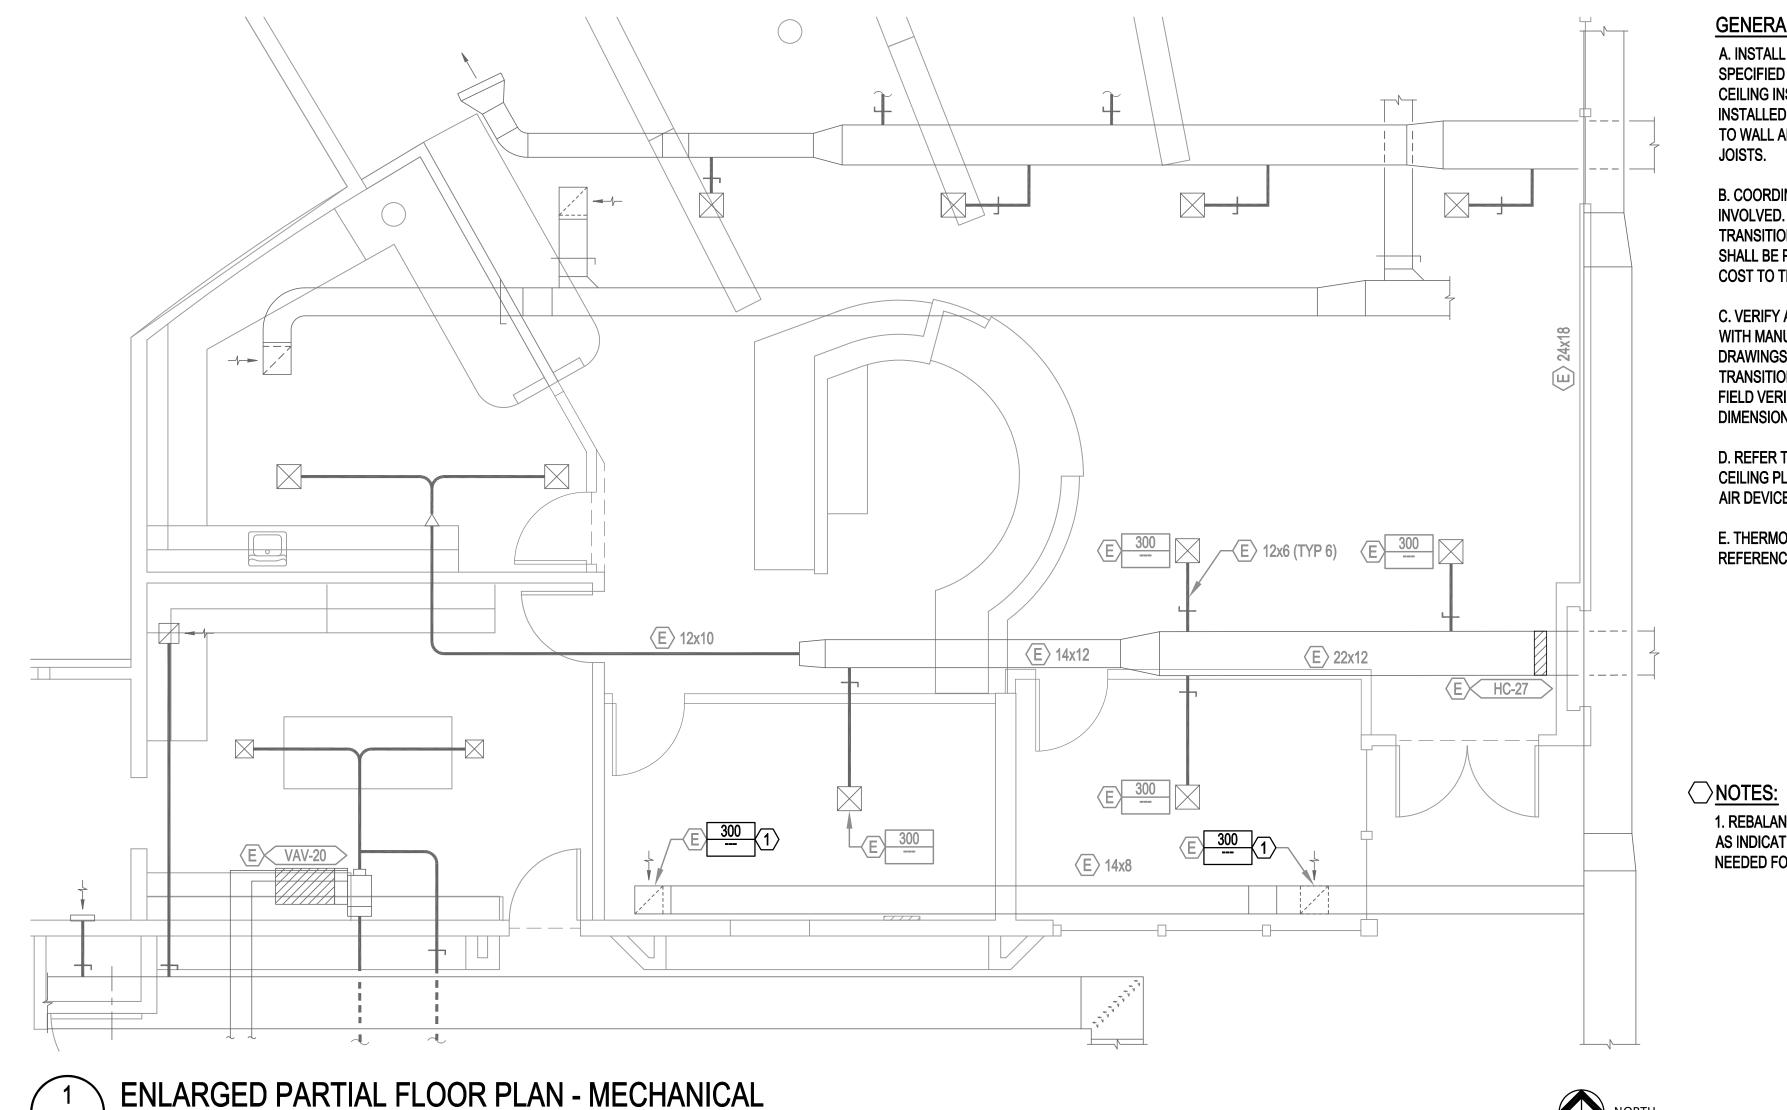

GENERAL NOTES:

A. INSTALL DUCTS CONCEALED, UNLESS SPECIFIED OTHERWISE, AND CLEAR OF CEILING INSERTS. ALL DUCTWORK TO BE INSTALLED AS CLOSE AS POSSIBLE TO WALL AND UNDERSIDE OF BEAMS AND

B. COORDINATE WORK WITH ALL TRADES INVOLVED. OFFSETS IN DUCTS AND TRANSITIONS AROUND OBSTRUCTIONS SHALL BE PROVIDED AT NO ADDITIONAL COST TO THE OWNER.

C. VERIFY ALL EQUIPMENT CONNECTIONS WITH MANUFACTURER'S CERTIFIED DRAWINGS. VERIFY AND PROVIDE DUCT TRANSITIONS TO FURNISHED EQUIPMENT. FIELD VERIFY AND COORDINATE ALL DIMENSIONS PRIOR TO FABRICATION.

D. REFER TO ARCHITECTURAL REFLECTED CEILING PLANS FOR EXACT LOCATIONS OF AIR DEVICES.

E. THERMOSTATS ARE SHOWN FOR REFERENCE LOCATION ONLY, TO BE OF/OI.

REVISIONS

EXPIRES 12-31-21

GMA ARCHITECTS 860 West Park Street / Ste 300

Eugene / Oregon / 97401

p 541.344.9157

gma-arch.com



1. REBALANCE EXISTING GRILLE TO AIR FLOW AS INDICATED, PROVIDE VOLUME DAMPER AS NEEDED FOR BALANCING.

PARTIAL DEMOLITION - MECHANICAL

NOTES:


1. REPLACE CEILING RETURN AIR GRILLE TO MATCH EXISTING GRILLE SIZE.

PROVEMENTS

JOB NO: ISSUE DATE:

ENLARGED PARTIAL FLOOR PLAN -**MECHANICAL**

M1.4

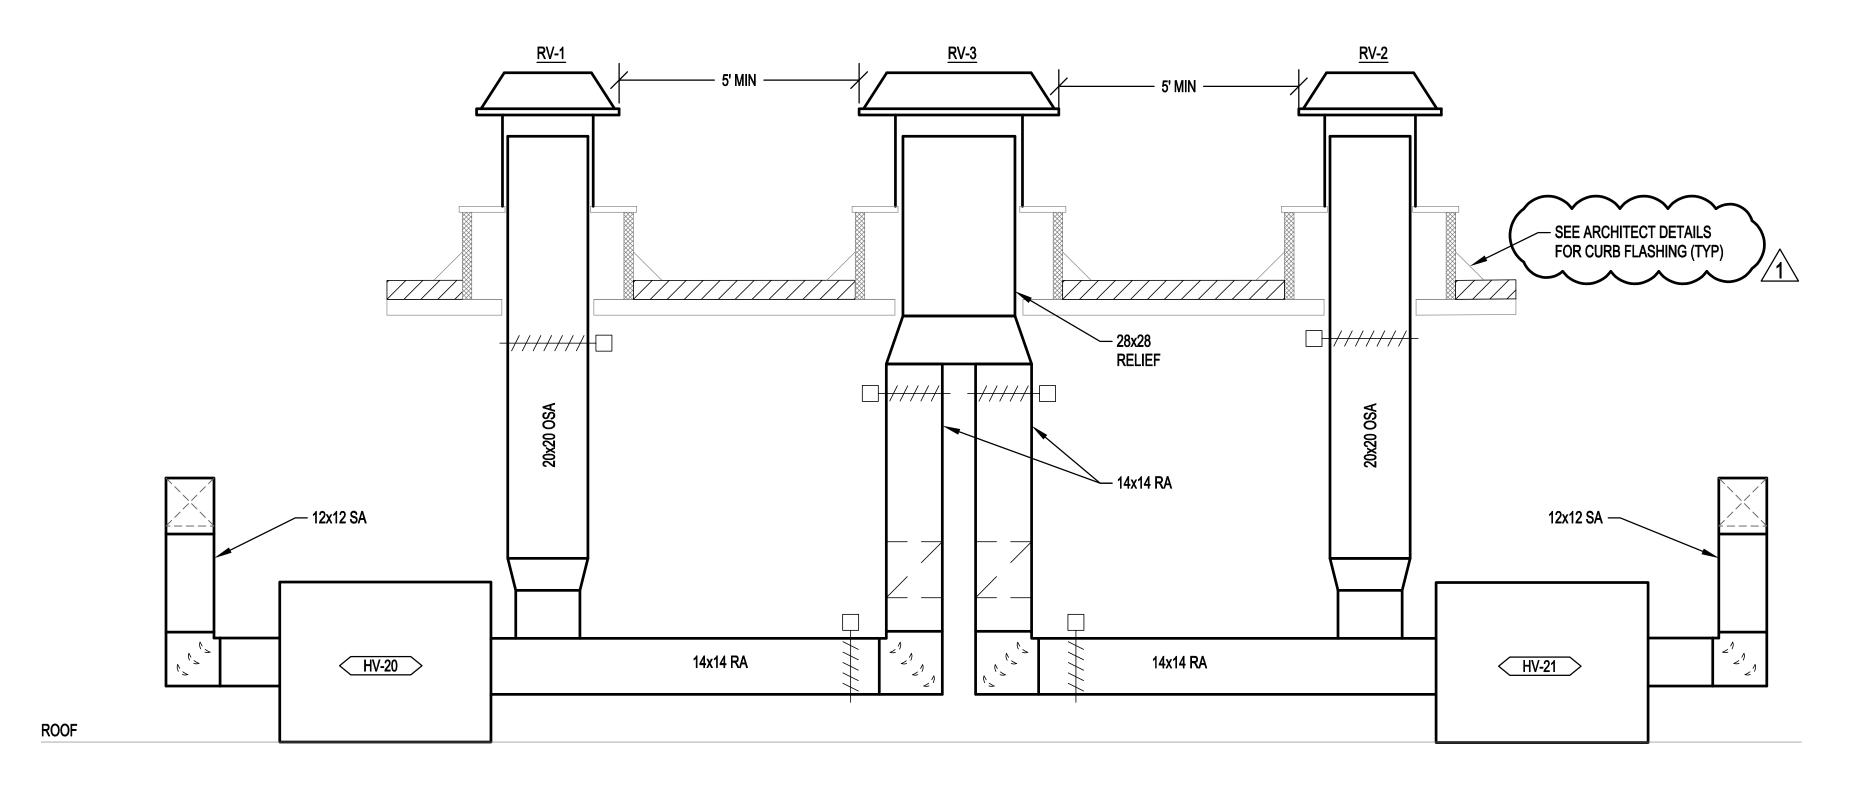

GENERAL NOTES:

A. FEILD INSTALLED ECONOMIZER VIA DUCTED MOTORIZED DAMPERS. DAMPERS BY DIV 23, ACTUATORS AND CONTROL WIRING OFOI.


B. LOCATE OSA INTAKES TO MAINTAIN MINIMUM 10FT FROM ANY EXISTING EXHAUST OR ROOF VENTS.




HV-20/21 SECTION

M3.01 SCALE: NONE



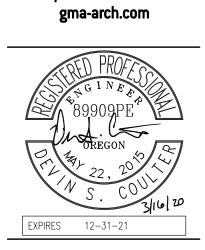

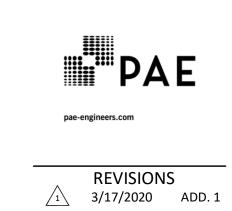





ESD 4J KELLY MIDDLE SCHOO




SET HOWARD AVE, EUGENE, OR 97404

SECTIONS -MECHANICAL

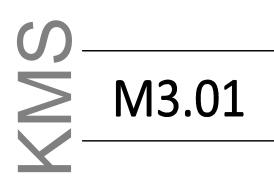

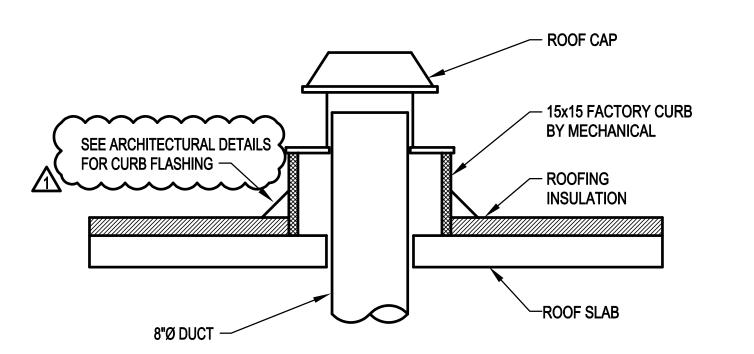


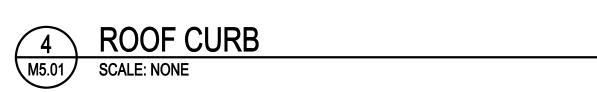

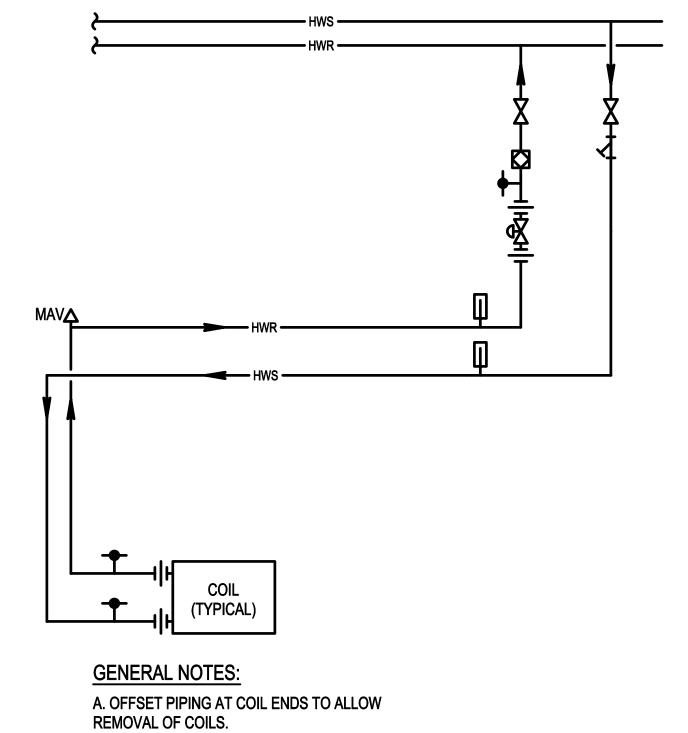

HEATING COIL PIPING DETAIL


SCALE: NONE

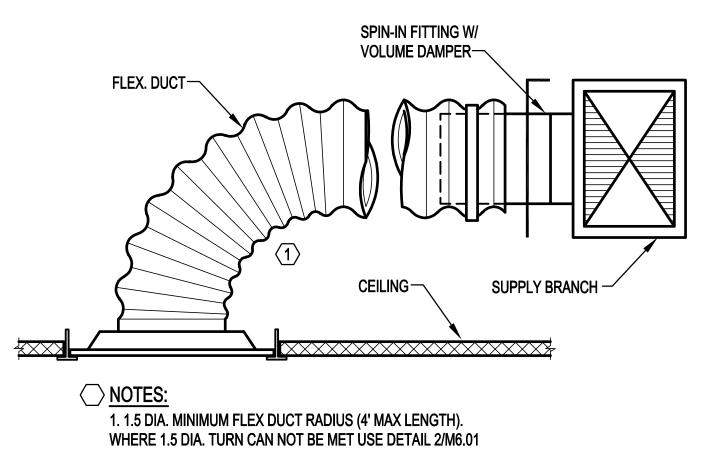


TYPICAL ROUND

NECK T-BAR DIFFUSER

M5.01 SCALE: NONE

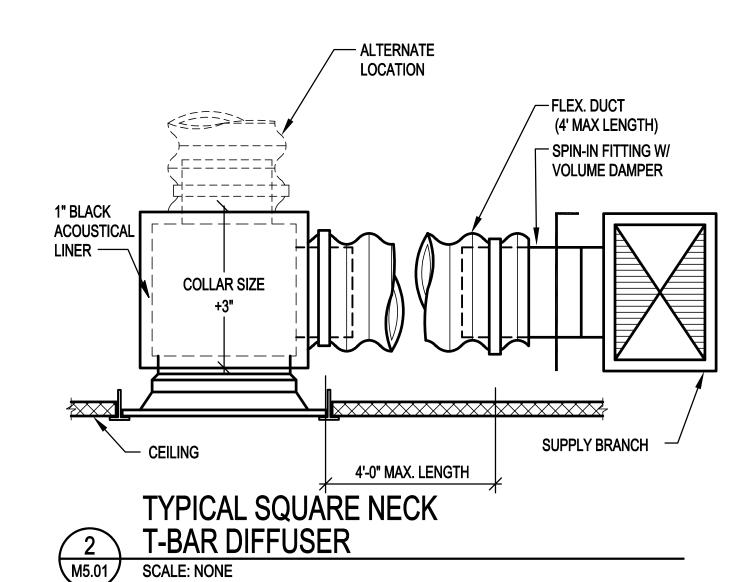

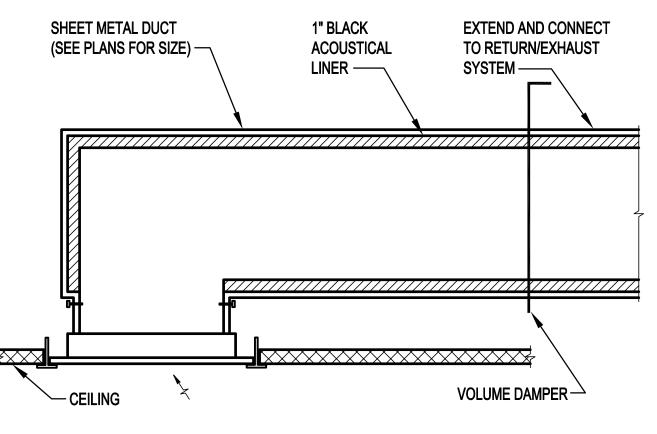

DUCTED RETURN/EXHAUST GRILLE

SCALE: NONE







REVISIONS

3/17/2020 ADD. 1

IPROVEMENTS

0 HOWARD AVE, EUGENE, OR 97404

JOB NO: 19189


ISSUE DATE: 3/3/2020

DETAILS -


MECHANICAL


S ______
M5.01



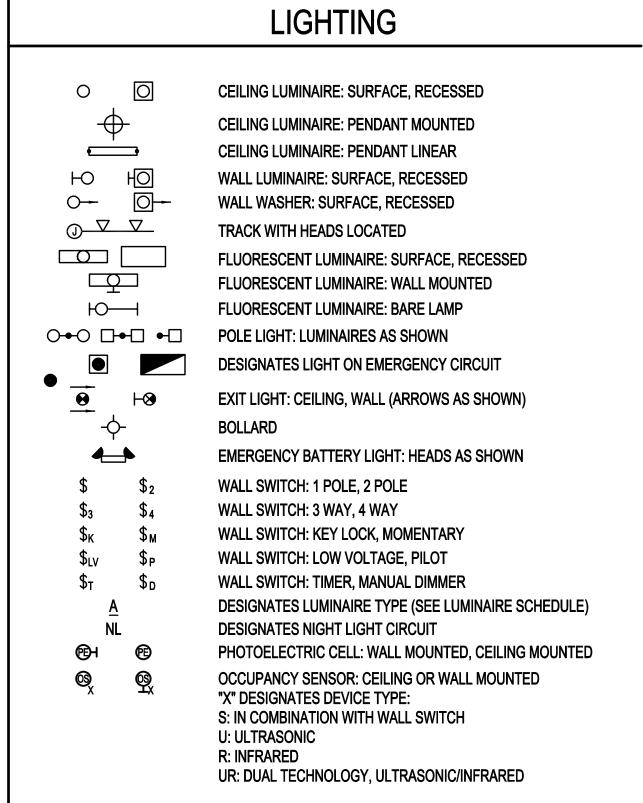



DESIGNATION SYMBOLS 123 EQUIPMENT DESIGNATOR SEE SCHEDULE. DARK LINE WEIGHT INDICATES NEW WORK DARK AND DASHED LINE WEIGHT INDICATES DEMO WORK LIGHT LINE WEIGHT INDICATES EXISTING TO REMAIN $\langle 1 \rangle$ NOTE

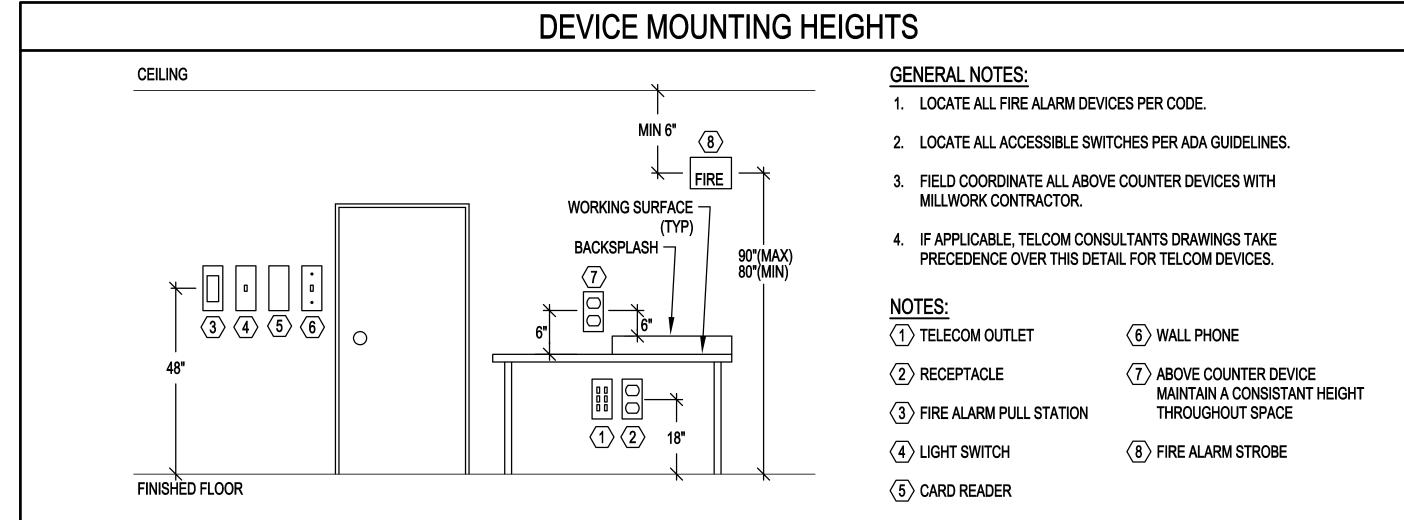

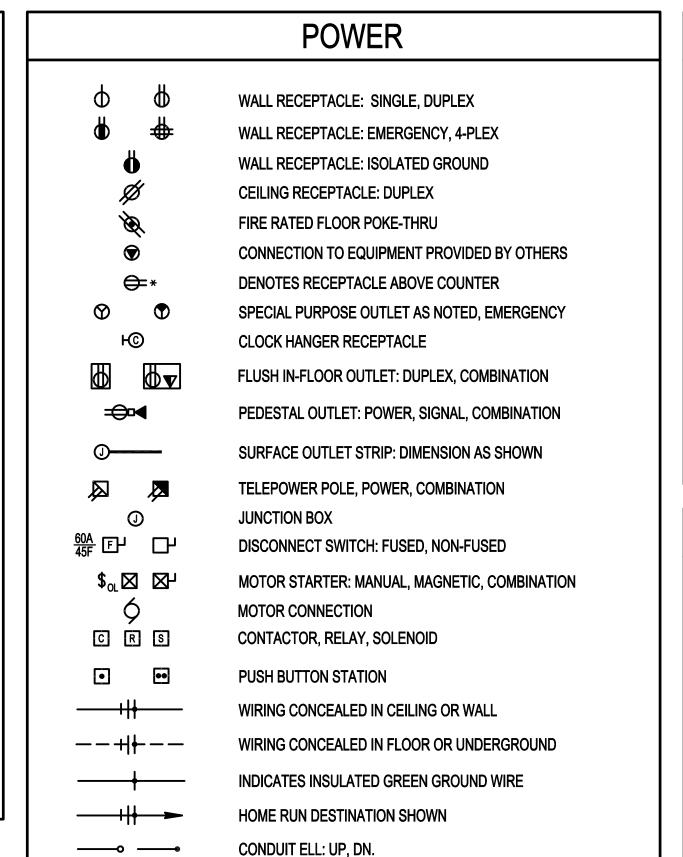


TELECOMMUNICATIONS ALTERNATE

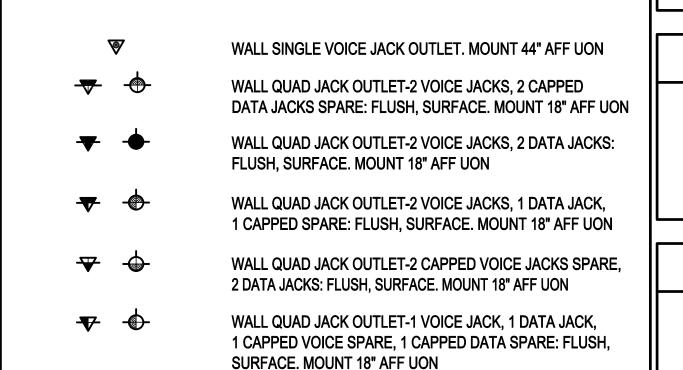

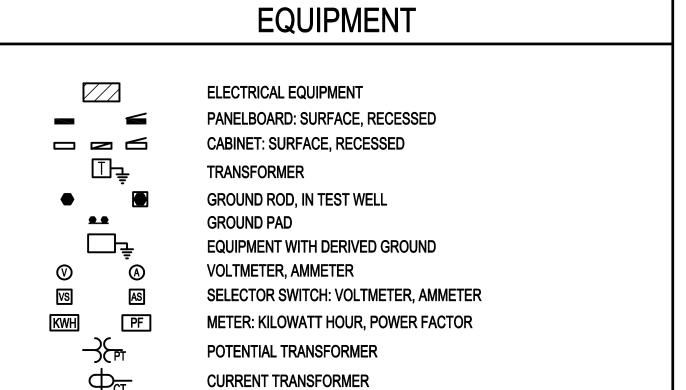


CABLE TRAY: CENTER SUPPORT, OUTER SUPPORTS

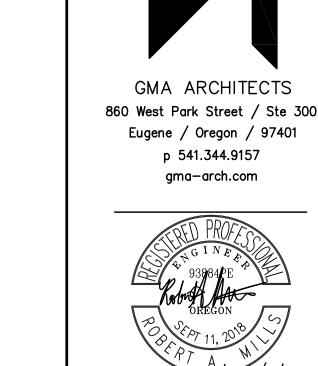

EXPIRES 12-31-2020

REVISIONS

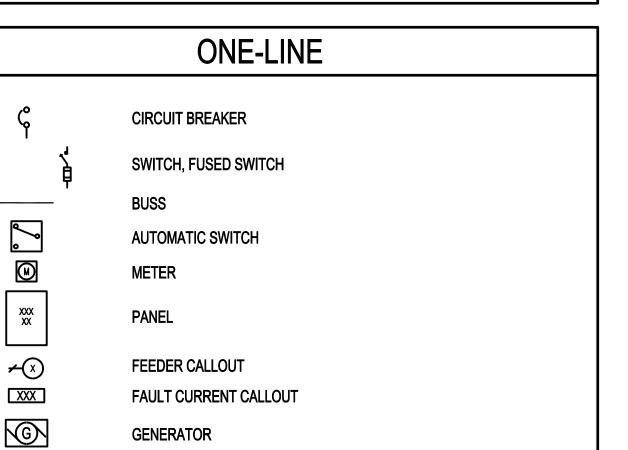

NOTE

THIS IS A STANDARD LEGEND SHEET, THEREFORE, SOME SYMBOLS MAY APPEAR ON THIS SHEET THAT DO NOT APPEAR ON THE DRAWINGS.

SHEET LIST

SYMBOLS, LEGENDS AND ABBREVIATIONS - ELECTRICAL LUMINAIRE AND MECHANICAL EQUIPMENT SCHEDULE

ED.0 OVERALL DEMOLITION PLAN

ED.1 PARTIAL DEMOLITION PLANS

ENLARGED PARTIAL ELECTRICAL FLOOR PLAN - A

ENLARGED PARTIAL ELECTRICAL FLOOR PLAN - B

ENLARGED PARTIAL ELECTRICAL FLOOR PLAN - C

ENLARGED PARTIAL ELECTRICAL FLOOR PLAN - D

E2.1 ENLARGED PARTIAL LIGHTING REFLECTED CEILING PLAN - A

ENLARGED PARTIAL LIGHTING REFLECTED CEILING PLAN - B

E2.3 ENLARGED PARTIAL LIGHTING REFLECTED CEILING PLAN - C

ENLARGED PARTIAL LIGHTING REFLECTED CEILING PLAN - D

E2.5 ENLARGED PARTIAL LIGHTING REFLECTED CEILING PLAN - F

E7.01

DIAGRAMS - ELECTRICAL E8.01 PANEL SCHEDULES

 \propto Δ CHOOL 4

ш

 \geq

Ш

OR SENOVATIONS <u>∞</u> ~

JOB NO: **ISSUE DATE:** 3 MARCH 2020

SYMBOLS, LEGENDS AND **ABBREVIATIONS -ELECTRICAL**

E0.01

LUMINAIRE SCHEDULE

FIXTURE TYPE	PRODUCT DESCRIPTION	BASIS OF DESIGN MANUFACTURER	SIZE	INPUT WATTS	LAMP SOURCE	DRIVER / BALLAST	INPUT VOLTAGE	FINISH	MOUNTING	NOTES
L1	SUSPENDED LED	LITHONIA - GRAD LINEAR	4'	25	LED, 4000K 3401 LM	INTEGRAL ELECTRONIC 0-10V	120	PER ARCHITECT	SUSPENDED 3' FROM CEILING	
L2	LINEAR VANITY	HE WILLIAMS - SLF	2'	10.1	LED, 4000K 1338 LM	INTEGRAL ELECTRONIC 0-10V	120	PER ARCHITECT	SURFACE MOUNTED ABOVE MIRROR	
L3	LED RECESSED DOWNLIGHT	EATON PORTFOLIO	8"D	10	LED, 4000K 1000 LM	INTEGRAL ELECTRONIC 0-10V DIM	120	PER ARCHITECT	CEILING RECESSED	
L4	SURFACE LINEAR	LITHONIA - SB	4'	25	LED, 4000K 3236 LM/LF	INTEGRAL ELECTRONIC 0-10V DIM	120	PER ARCHITECT	CEILING SURFACE	
L5	LED RECESSED FLAT PANEL	TCP	2' X 4'	36	LED, 4000K 3600LM	INTEGRAL ELECTRONIC 0-10V DM	120	PER ARCHITECT	CEILING RECESSED	

			IVIEC	νΠΑΙΝΙ	CALI		IVIEINI	COM	INEC		HEDULE						
		ELECT	TRICAL CI	HARACTER	ISTICS			CONNECTIO	N CHARACTER	RISTICS	FEE	DER CHARACTERI	STICS	PANEL INFORMATION	NOTES		
TAG	DESCRIPTION	LOCATION	KW	HP	FLA	MOCP	VOLTS	PHASE	VFD	1-POINT CONNECT	STARTER DIVISION	DISCONNECT DIVISION	CONDUIT DIA (INCH)	PHASE CONDUCTORS	GROUND CONDUCTOR	PANEL NAME	
HV-20	NEW CLASSROOM 4A	MECH PLATFORM		1/2			208	1	NO	YES	23	26	3/4"	12 AWG	12 AWG	M	
HV-21	NEWCLASSROOM 4B	MECH PLATFORM		1/2			208	1	NO	YES	23	26	3/4"	12 AWG	12 AWG	M	
EF-7	GREENHECK SQ-95	TOILET G1.5 EXPANSION		1/8			120	1	NO	YES	23	26	3/4"	12 AWG	12 AWG	M	
EF-8	GREENHECK SQ-95	MAILROOM->TOILET 8.1/8.2	——————————————————————————————————————	1/8	~~~	~~~	120	~ 1 ~	NO	YES	23	26	3/4"	12 AWG	12 AWG	EXISTING	~~~
FTR-1	WALL CONVECTOR	LOBBY	0.04				120	1	NO	YES	-	26	3/4"	12 AWG	12 AWG	F	









KELLY MIDDLE SCHOOL IMPROVEMENTS

850 HOWARD AVE, EUGENE, OR RENOVATIONS

JOB NO:

LUMINAIRE AND MECHANICAL EQUIPMENT

E0.02

SCHEDULE





pae-engineers.com

REVISIONS

3/17/2020 ADD. 1

HOOL IMPROVEMENTS

OWARD AVE FUGENE OR 97404

JOB NO:

JOB NO:
ISSUE DATE: 3

OVERALL
DEMOLITION
PLAN ELECTRICAL

ED.0

1 OVERALL DEMOLITION PLAN - ELECTRICAL

1/32" = 1'-0"

3 ED.1

4 ED.1


ED.1

7 ED.1

6 ED.1

9 ED.1 ED.2

NORTH

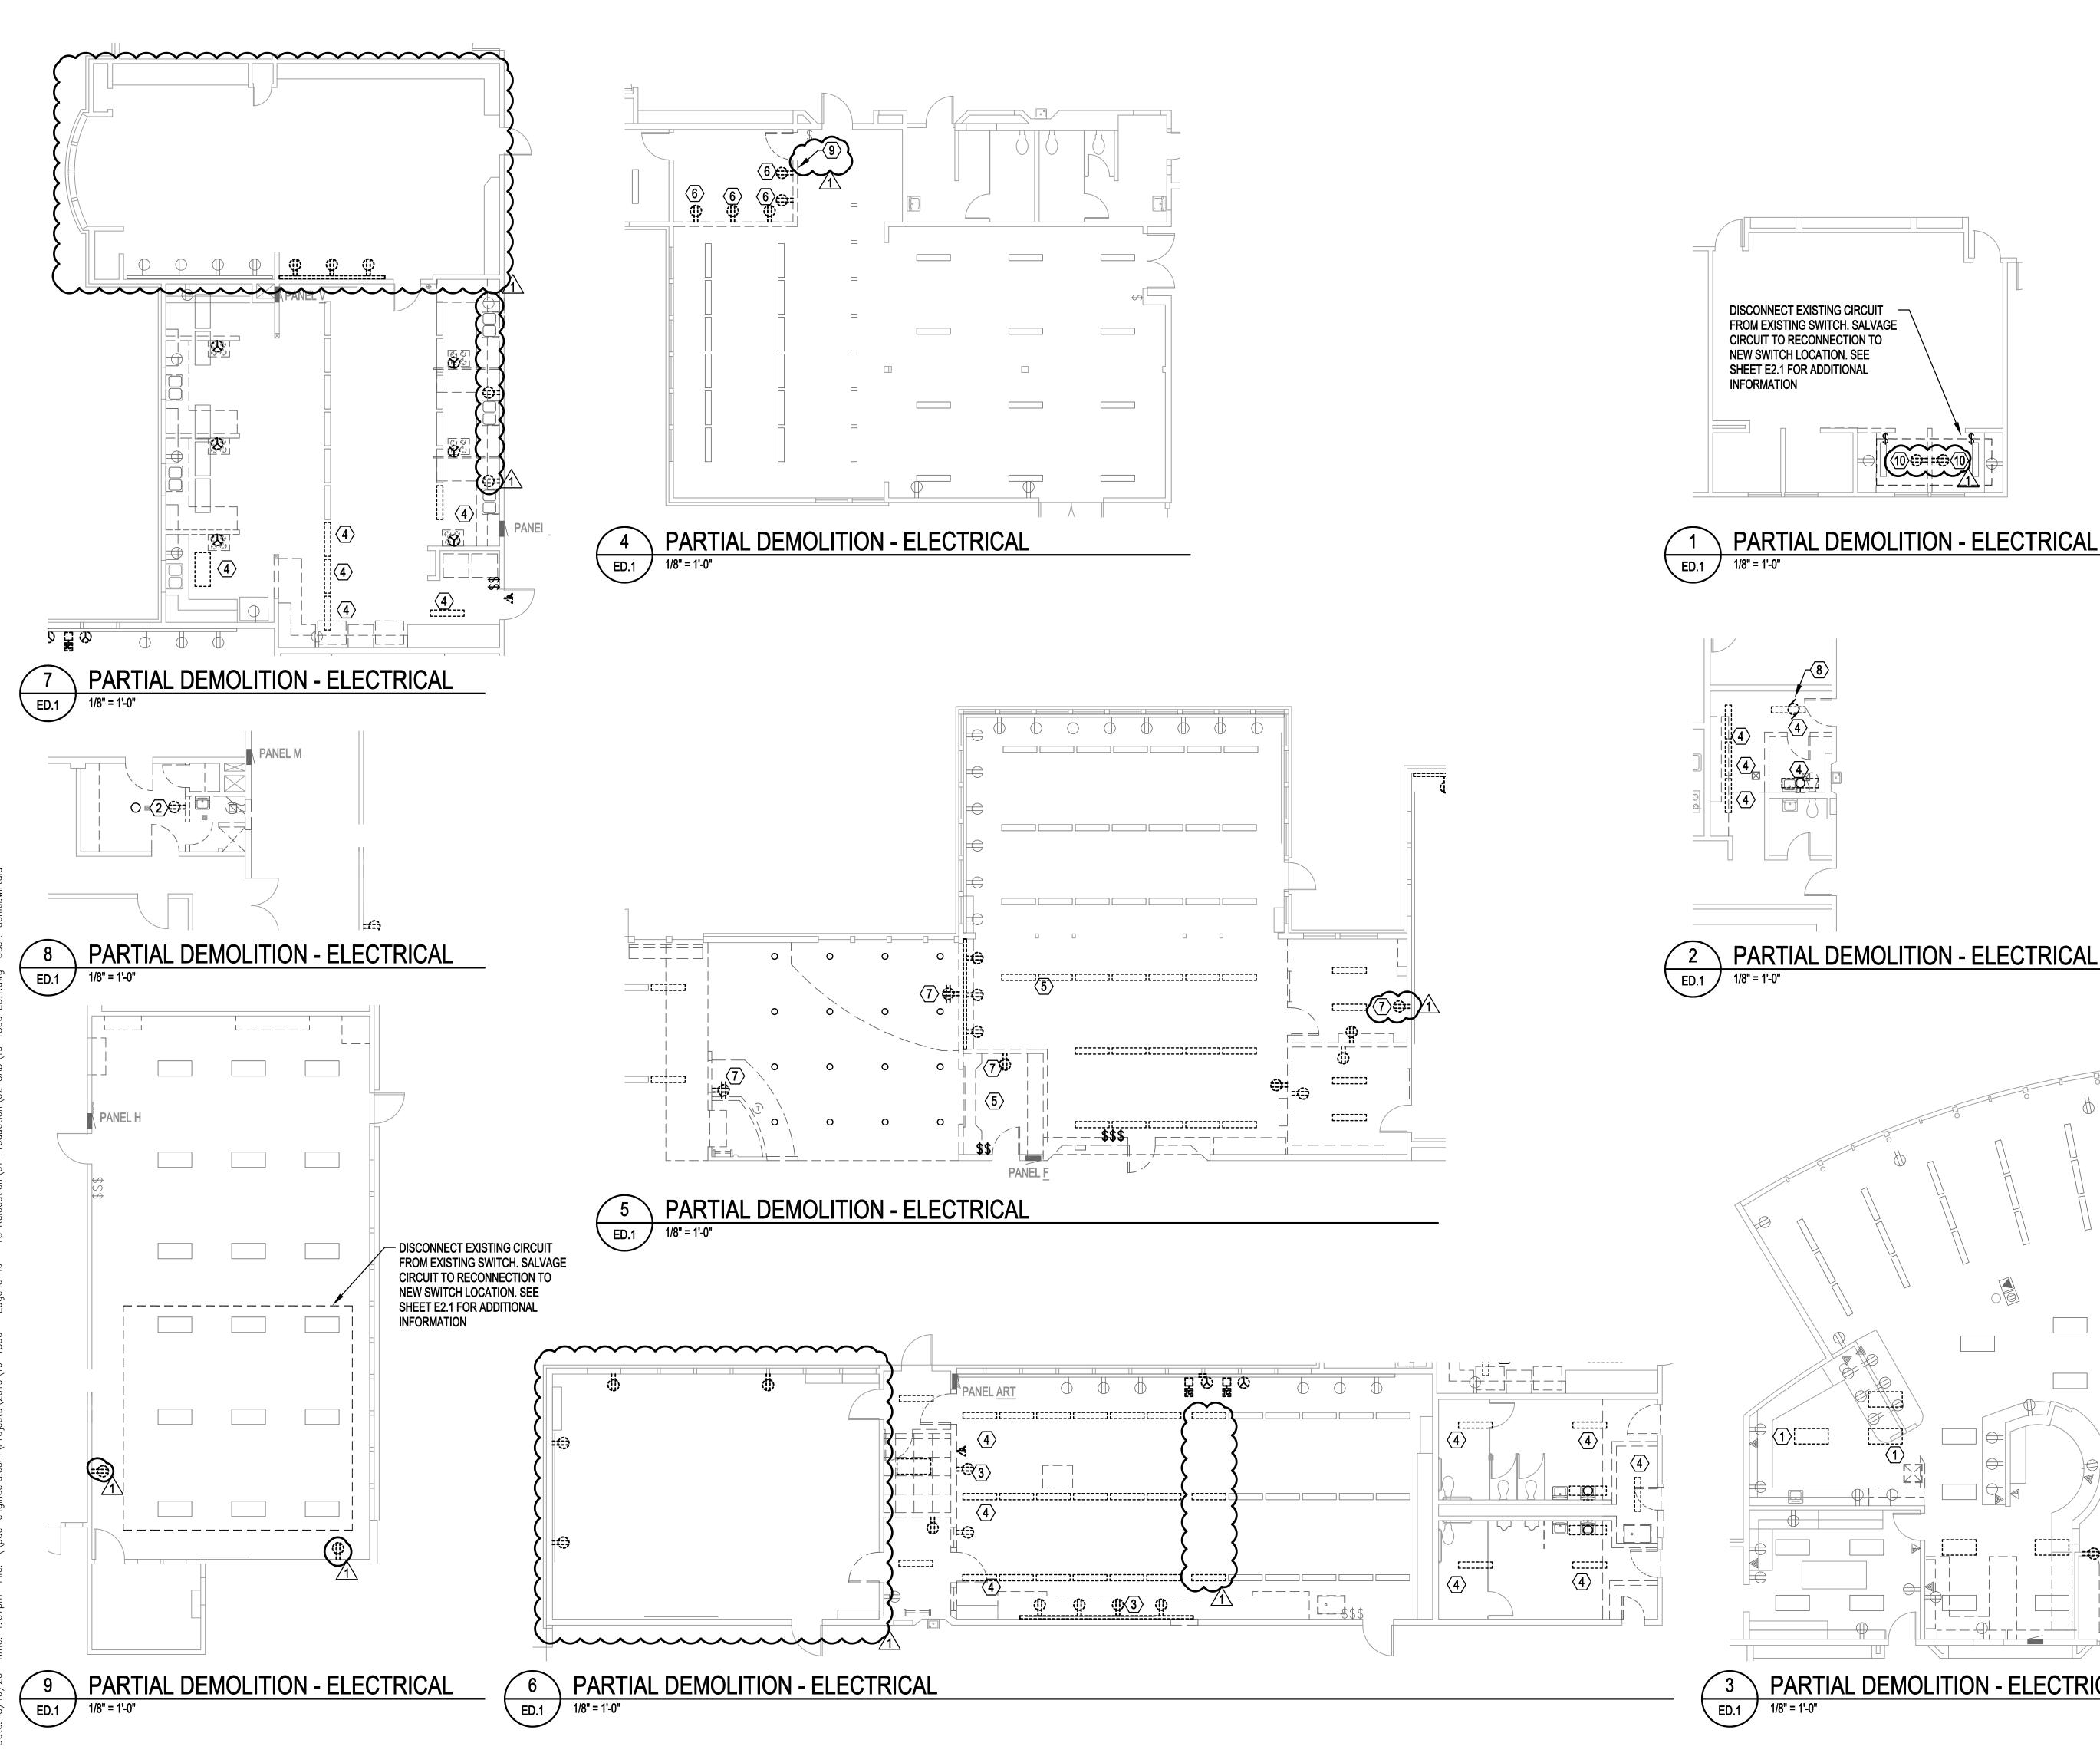

GENERAL NOTES:

A. CAREFULLY REMOVE AND OFFER TO THE OWNER ALL ELECTRICAL EQUIPMENT THAT IS TO BE REMOVED AND IN GOOD WORKING ORDER. REMOVE FROM PROJECT SITE AND PROPERLY DISPOSE ALL EQUIPMENT REJECTED BY THE

B. THE LOCATIONS OF ALL EQUIPMENT AND DEVICES MAY NOT BE SHOWN AND THESE PLANS DO NOT SHOW ALL OF THE DEMOLITION CONDITIONS. DEMOLITION INCLUDES THE REMOVAL OF ALL RACEWAY, CONDUCTORS, COMMUNICATION CABLING, LIGHT FIXTURES, DEVICES, ELECTRICAL EQUIPMENT, FIRE ALARM DEVICES, CABLES, HANGERS, AND SUPPORTS THAT ARE MADE OBSOLETE BY THE NEW WORK OR ARE ABANDONED AND NO LONGER IN USE.

NOTES:

1. SALVAGE FIXTURE AND CIRCUIT FOR RELOCATION DURING NEW CONSTRUCTION PHASE. LOCATE PER E2.4.

2. SALVAGE CIRCUIT AND EXTEND TO NEW RECEPTACLE LOCATION. SEE SHEET E1.1 FOR ADDITIONAL INFORMATION.

3.SALVAGE CIRCUIT AND EXTEND TO NEW RECEPTACLE LOCATION. SEE SHEET E1.2 FOR ADDITIONAL INFORMATION.

4. SALVAGE CIRCUIT AND EXTEND TO NEW FIXTURE LOCATION. SEE SHEET E2.X SERIES FOR ADDITIONAL INFORMATION.

5. SALVAGE FIXTURE AND CIRCUIT FOR RELOCATION DURING NEW CONSTRUCTION PHASE. LOCATE PER E2.3.

6. SALVAGE CIRCUIT AND EXTEND TO NEW RECEPTACLE LOCATION. SEE SHEET E1.4 FOR ADDITIONAL INFORMATION.

RECEPTACLE LOCATION. SEE SHEET E1.3 FOR ADDITIONAL INFORMATION.

7. SALVAGE CIRCUIT AND EXTEND TO NEW

8. SALVAGE CIRCUIT AND EXTEND TO NEW EXHAUST FAN LOCATION. SEE SHEET E1.4 FOR ADDITIONAL INFORMATION.

9. WALL DEMOLISHED BY ABATEMENT

CONTRACTOR. CONTRACTOR TO COORDINATE EXISTING CIRCUITS TERMINATION LOCATION WITH ABATEMENT CONTRACTOR.

10. SALVAGE CIRCUIT AND EXTEND TO NEW RECEPTACLE LOCATION. SEE SHEET E1.5 FOR ADDITIONAL INFORMATION.


PARTIAL DEMOLITION - ELECTRICAL

ED.1 / 1/8" = 1'-0"

Eugene / Oregon / 97401

p 541.344.9157

GMA ARCHITECTS 860 West Park Street / Ste 300

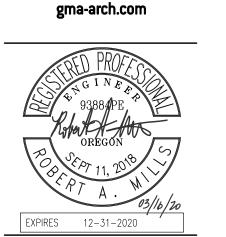



pae-engineers.com

REVISIONS 3/17/2020 ADD. 1

ш ш Δ

JOB NO: ISSUE DATE: **PARTIAL**

DEMOLITION PLANS -**ELECTRICAL**

ED.1

PARTIAL DEMOLITION - ELECTRICAL

ED.2

GENERAL NOTES:


A. CXXXFULLY REMOVE AND OFFER TO THE OWNER ALL ELECTRICAL EQUIPMENT THAT IS TO BE REMOVED AND IN GOOD WORKING ORDER. REMOVE FROM PROJECT SITE AND PROPERLY DISPOSE ALL EQUIPMENT REJECTED BY THE OWNER.

B. THE LOCATIONS OF ALL EQUIPMENT AND DEVICES MAY NOT BE SHOWN AND THESE PLANS DO NOT SHOW ALL OF THE DEMOLITION CONDITIONS. DEMOLITION INCLUDES THE REMOVAL OF ALL RACEWAY, CONDUCTORS, COMMUNICATION CABLING, LIGHT FIXTURES, DEVICES, ELECTRICAL EQUIPMENT, FIRE ALARM DEVICES, CABLES, HANGERS, AND SUPPORTS THAT ARE MADE OBSOLETE BY THE NEW WORK OR ARE ABANDONED AND NO LONGER IN USE.

NOTES:

1. NO DEMOLITION SCOPE IN THIS AREA.

2. DEMOLISH RECEPTACLE AND BACKBOX AND REMOVE CONDUIT AND CONDUCTORS TO ABOVE ACCESSIBLE CEILING. SALVAGE CIRCUIT FOR EXTENSION TO EXISTING TO REMAINING RACEWAY. SEE SHEET E1.3 FOR ADDITIONAL INFORMATION

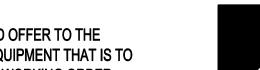

GMA ARCHITECTS
860 West Park Street / Ste 300
Eugene / Oregon / 97401
p 541.344.9157
gma-arch.com





engineers.com

REVISIONS

3/17/2020 ADD. 1

1PROVEMENTS

HOWARD AVE, EUGENE, OR 97404

JOB NO:

ISSUE DATE:

PARTIAL DEMOLITION PLANS -ELECTRICAL



A. ALL MECHANICAL AND PLUMBING EQUIPMENT SHOWN IS FOR REFERENCE ONLY. REFER TO MECHANICAL AND PLUMBING SHEETS FOR EXACT LOCATIONS OF ALL EQUIPMENT. SEE MECHANICAL EQUIPMENT CONNECTION SCHEDULE ON E0.02 FOR CIRCUITING INFORMATION.

B. REFERENCE M0.01 FOR MECHANICAL SYMBOLS AND M0.02 FOR MECHANICAL SCHEDULES.

C. ALL INTERIOR RACEWAY TO BE CONCEALED WHEN LOCATED WITHIN FINISHED SPACES UNLESS OTHERWISE NOTED.

D. REFER TO ARCHITECTURAL CEILING PLANS, ELEVATIONS, AND FLOOR PLANS FOR ACTUAL LOCATIONS OF ALL CEILING, WALL, AND FLOOR MOUNTED DEVICES AND EQUIPMENT. WHERE INTERIOR ELEVATIONS DIFFER BETWEEN ARCHITECTURAL AND ENGINEERING DRAWINGS, CONTRACTOR TO NOTIFY ENGINEER.

E. TELECOM SCOPE SHALL INCLUDE BACK BOX, CONDUIT AND RACEWAY. PROVIDE BACKBOX ROUGH-IN AT DATA DEVICE LOCATION AND 1-1/4" CONDUIT ROUTED TO TELECOM CLOSET. DATA DEVICE, CABLING AND CONNECTION TO TELECOMMUNICATIONS SYSTEM SHALL BE BY OWNER'S TELECOMMUNICATIONS CONTRACTOR.

F. THE FIRE ALARM SYSTEM IS SHOWN FOR GUIDANCE AND IS INTENDED TO BE USED TO PROVIDE INFORMATION FOR A FIRE ALARM DESIGN-BUILD SYSTEM. EQUIPMENT AND DEVICE ARRANGEMENT SHOWN IS TO AID IN $^{\prime}$ ESTABLISHING A BASIS OF DESIGN. CONTRACTOR $_{ullet}$ SHALL BE RESPONSIBLE FOR CREATION OF SHOP DRAWINGS, AND TO PROVIDE FULL DESIGN, PERMITTING, INSTALLATION, TESTING, AND COORDINATION WITH OTHER TRADES. PROVIDE A COMPLETE SYSTEM THAT MEETS CURRENT CODE AND FUNCTIONALITY REQUIREMENTS.

NOTES:

1. CONNECT SALVAGED CIRCUIT TO NEW RECEPTACLE.


2. MOTOR CONNECTIONS LOCATED IN ATTIC.

3. PROVIDE BACKBOX AND RACEWAY FOR WIRELESS ACCESS POINT.

4. COORDINATE ELEVATION WITH ARCHITECT/OWNER PRIOR TO ROUGH-IN. 5. PROVIDE BACK-BOX AND CONDUIT PATHWAY

FOR PROJECTOR AV CONNECTION.

GMA ARCHITECTS 860 West Park Street / Ste 300 Eugene / Oregon / 97401 p 541.344.9157 gma-arch.com

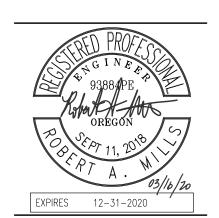



REVISIONS

<u>1</u> 3/17/2020 ADD. 1

PROVEMENT

JOB NO:

ENLARGED PARTIAL **ELECTRICAL** FLOOR PLAN - A

ENLARGED PARTIAL ELECTRICAL FLOOR PLAN - A E1.1

PANEL H /4 PROJECTOR

MATCH LINE - SEE E1.2

MATCH LINE - SEE E1.1

PROVIDE CONNECTION FOR SIGNAGE COORDINATE

TO ROUGH-IN —

LOCATION AND REQUIREMENTS WITH OWNER/ARCHITECT PRIOR

ISSUE DATE:

KEY PLAN- NTS

A. ALL MECHANICAL AND PLUMBING EQUIPMENT SHOWN IS FOR REFERENCE ONLY. REFER TO MECHANICAL AND PLUMBING SHEETS FOR EXACT LOCATIONS OF ALL EQUIPMENT. SEE MECHANICAL EQUIPMENT CONNECTION SCHEDULE ON E0.02 FOR CIRCUITING INFORMATION.

B. REFERENCE M0.01 FOR MECHANICAL SYMBOLS AND M0.02 FOR MECHANICAL SCHEDULES.

C. ALL INTERIOR RACEWAY TO BE CONCEALED WHEN LOCATED WITHIN FINISHED SPACES UNLESS OTHERWISE NOTED.

D. REFER TO ARCHITECTURAL CEILING PLANS, ELEVATIONS, AND FLOOR PLANS FOR ACTUAL LOCATIONS OF ALL CEILING, WALL, AND FLOOR MOUNTED DEVICES AND EQUIPMENT. WHERE INTERIOR ELEVATIONS DIFFER BETWEEN ARCHITECTURAL AND ENGINEERING DRAWINGS, CONTRACTOR TO NOTIFY ENGINEER.

E. TELECOM SCOPE SHALL INCLUDE BACK BOX, CONDUIT AND RACEWAY. PROVIDE BACKBOX ROUGH-IN AT DATA DEVICE LOCATION AND 1-1/4" CONDUIT ROUTED TO TELECOM CLOSET. DATA DEVICE, CABLING AND CONNECTION TO TELECOMMUNICATIONS SYSTEM SHALL BE BY OWNER'S TELECOMMUNICATIONS CONTRACTOR.

F. THE FIRE ALARM SYSTEM IS SHOWN FOR GUIDANCE AND IS INTENDED TO BE USED TO PROVIDE INFORMATION FOR A FIRE ALARM DESIGN-BUILD SYSTEM. EQUIPMENT AND DEVICE ARRANGEMENT SHOWN IS TO AID IN SHALL BE RESPONSIBLE FOR CREATION OF > SHOP DRAWINGS, AND TO PROVIDE FULL DESIGN, , PERMITTING, INSTALLATION, TESTING, AND COORDINATION WITH OTHER TRADES. PROVIDE A AND FUNCTIONALITY REQUIREMENTS.


NOTES:

1. CONNECT SALVAGED CIRCUIT TO NEW RECEPTACLE.

2. COORDINATE ELEVATION WITH

ARCHITECT/OWNER PRIOR TO ROUGH-IN. FOR PROJECTOR AV CONNECTION.




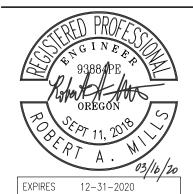



PROVEMENTS

REVISIONS /1\ 3/17/2020 ADD. 1

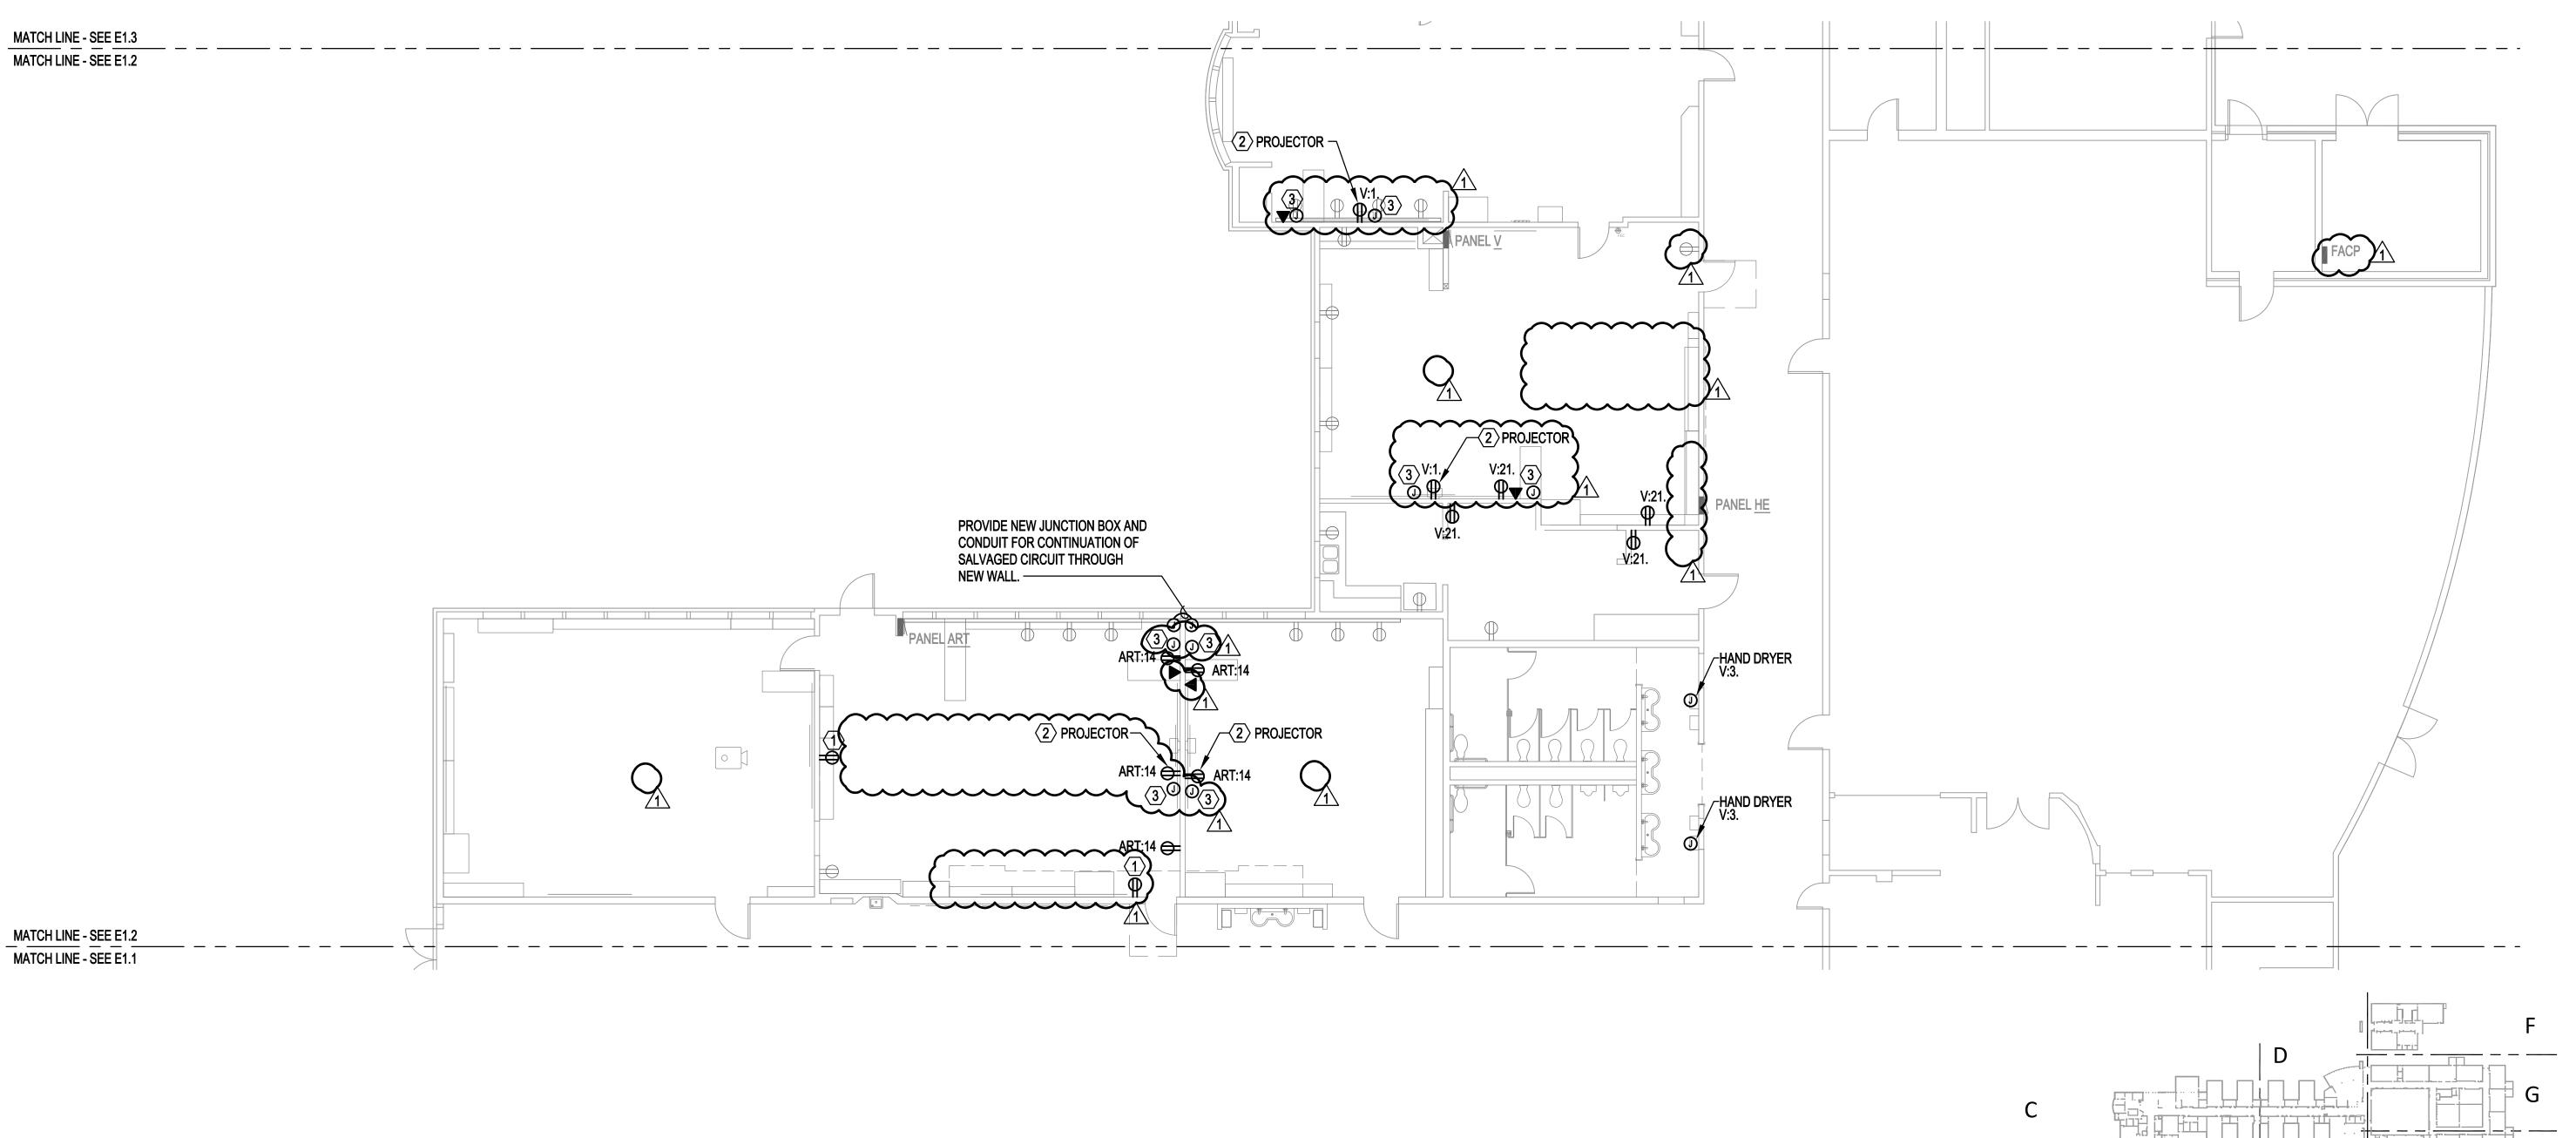

ELECTRICAL FLOOR PLAN - B

JOB NO: ISSUE DATE:

E1.2

E1.2

ENLARGED PARTIAL ELECTRICAL FLOOR PLAN - B

KEY PLAN- NTS

ESTABLISHING A BASIS OF DESIGN. CONTRACTOR COMPLETE SYSTEM THAT MEETS CURRENT CODE

3. PROVIDE BACK-BOX AND CONDUIT PATHWAY

GMA ARCHITECTS 860 West Park Street / Ste 300 Eugene / Oregon / 97401 p 541.344.9157 gma-arch.com

COPYRIGHT GMA ARCHITECTS

ENLARGED

PARTIAL

GENERAL NOTES:

A. ALL MECHANICAL AND PLUMBING EQUIPMENT SHOWN IS FOR REFERENCE ONLY. REFER TO MECHANICAL AND PLUMBING SHEETS FOR EXACT LOCATIONS OF ALL EQUIPMENT. SEE MECHANICAL EQUIPMENT CONNECTION SCHEDULE ON E0.02 FOR CIRCUITING INFORMATION.

B. REFERENCE M0.01 FOR MECHANICAL SYMBOLS AND M0.02 FOR MECHANICAL SCHEDULES.

C. ALL INTERIOR RACEWAY TO BE CONCEALED WHEN LOCATED WITHIN FINISHED SPACES UNLESS OTHERWISE NOTED.

D. REFER TO ARCHITECTURAL CEILING PLANS, ELEVATIONS, AND FLOOR PLANS FOR ACTUAL LOCATIONS OF ALL CEILING, WALL, AND FLOOR MOUNTED DEVICES AND EQUIPMENT. WHERE INTERIOR ELEVATIONS DIFFER BETWEEN ARCHITECTURAL AND ENGINEERING DRAWINGS, CONTRACTOR TO NOTIFY ENGINEER.

E. TELECOM SCOPE SHALL INCLUDE BACK BOX, CONDUIT AND RACEWAY. PROVIDE BACKBOX ROUGH-IN AT DATA DEVICE LOCATION AND 1-1/4" CONDUIT ROUTED TO TELECOM CLOSET. DATA DEVICE, CABLING AND CONNECTION TO TELECOMMUNICATIONS SYSTEM SHALL BE BY OWNER'S TELECOMMUNICATIONS CONTRACTOR.

F. THE FIRE ALARM SYSTEM IS SHOWN FOR GUIDANCE AND IS INTENDED TO BE USED TO PROVIDE INFORMATION FOR A FIRE ALARM DESIGN-BUILD SYSTEM. EQUIPMENT AND DEVICE ARRANGEMENT SHOWN IS TO AID IN ESTABLISHING A BASIS OF DESIGN. CONTRACTOR SHALL BE RESPONSIBLE FOR CREATION OF SHOP DRAWINGS, AND TO PROVIDE FULL DESIGN, , PERMITTING, INSTALLATION, TESTING, AND COORDINATION WITH OTHER TRADES. PROVIDE A COMPLETE SYSTEM THAT MEETS CURRENT CODE AND FUNCTIONALITY REQUIREMENTS.

NOTES:

1. CONNECT SALVAGED CIRCUIT TO NEW RECEPTACLE.

2. COORDINATE ELEVATION WITH ARCHITECT/OWNER PRIOR TO ROUGH-IN.


3. CONNECT SALVAGED CIRCUIT TO NEW EXHAUST FAN.

~~~~~~ 4. PROVIDE BACK-BOX AND CONDUIT PATHWAY FOR PROJECTOR AV CONNECTION.

5. PROVIDE SURFACE MOUNTED CONDUIT TO > EXTEND SALVAGED CIRCUIT TO NEW JUNTION BOX FOR RECONNECTION OF EXISTING SURFACE MOUNTED RACEWAY. 



**GMA ARCHITECTS** 860 West Park Street / Ste 300 Eugene / Oregon / 97401 p 541.344.9157 gma-arch.com

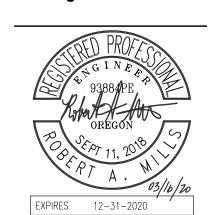



REVISIONS

<u>1</u> 3/17/2020 ADD. 1


JOB NO: ISSUE DATE:

**ENLARGED** PARTIAL

**ELECTRICAL** FLOOR PLAN - C

E1.3

KEY PLAN- NTS

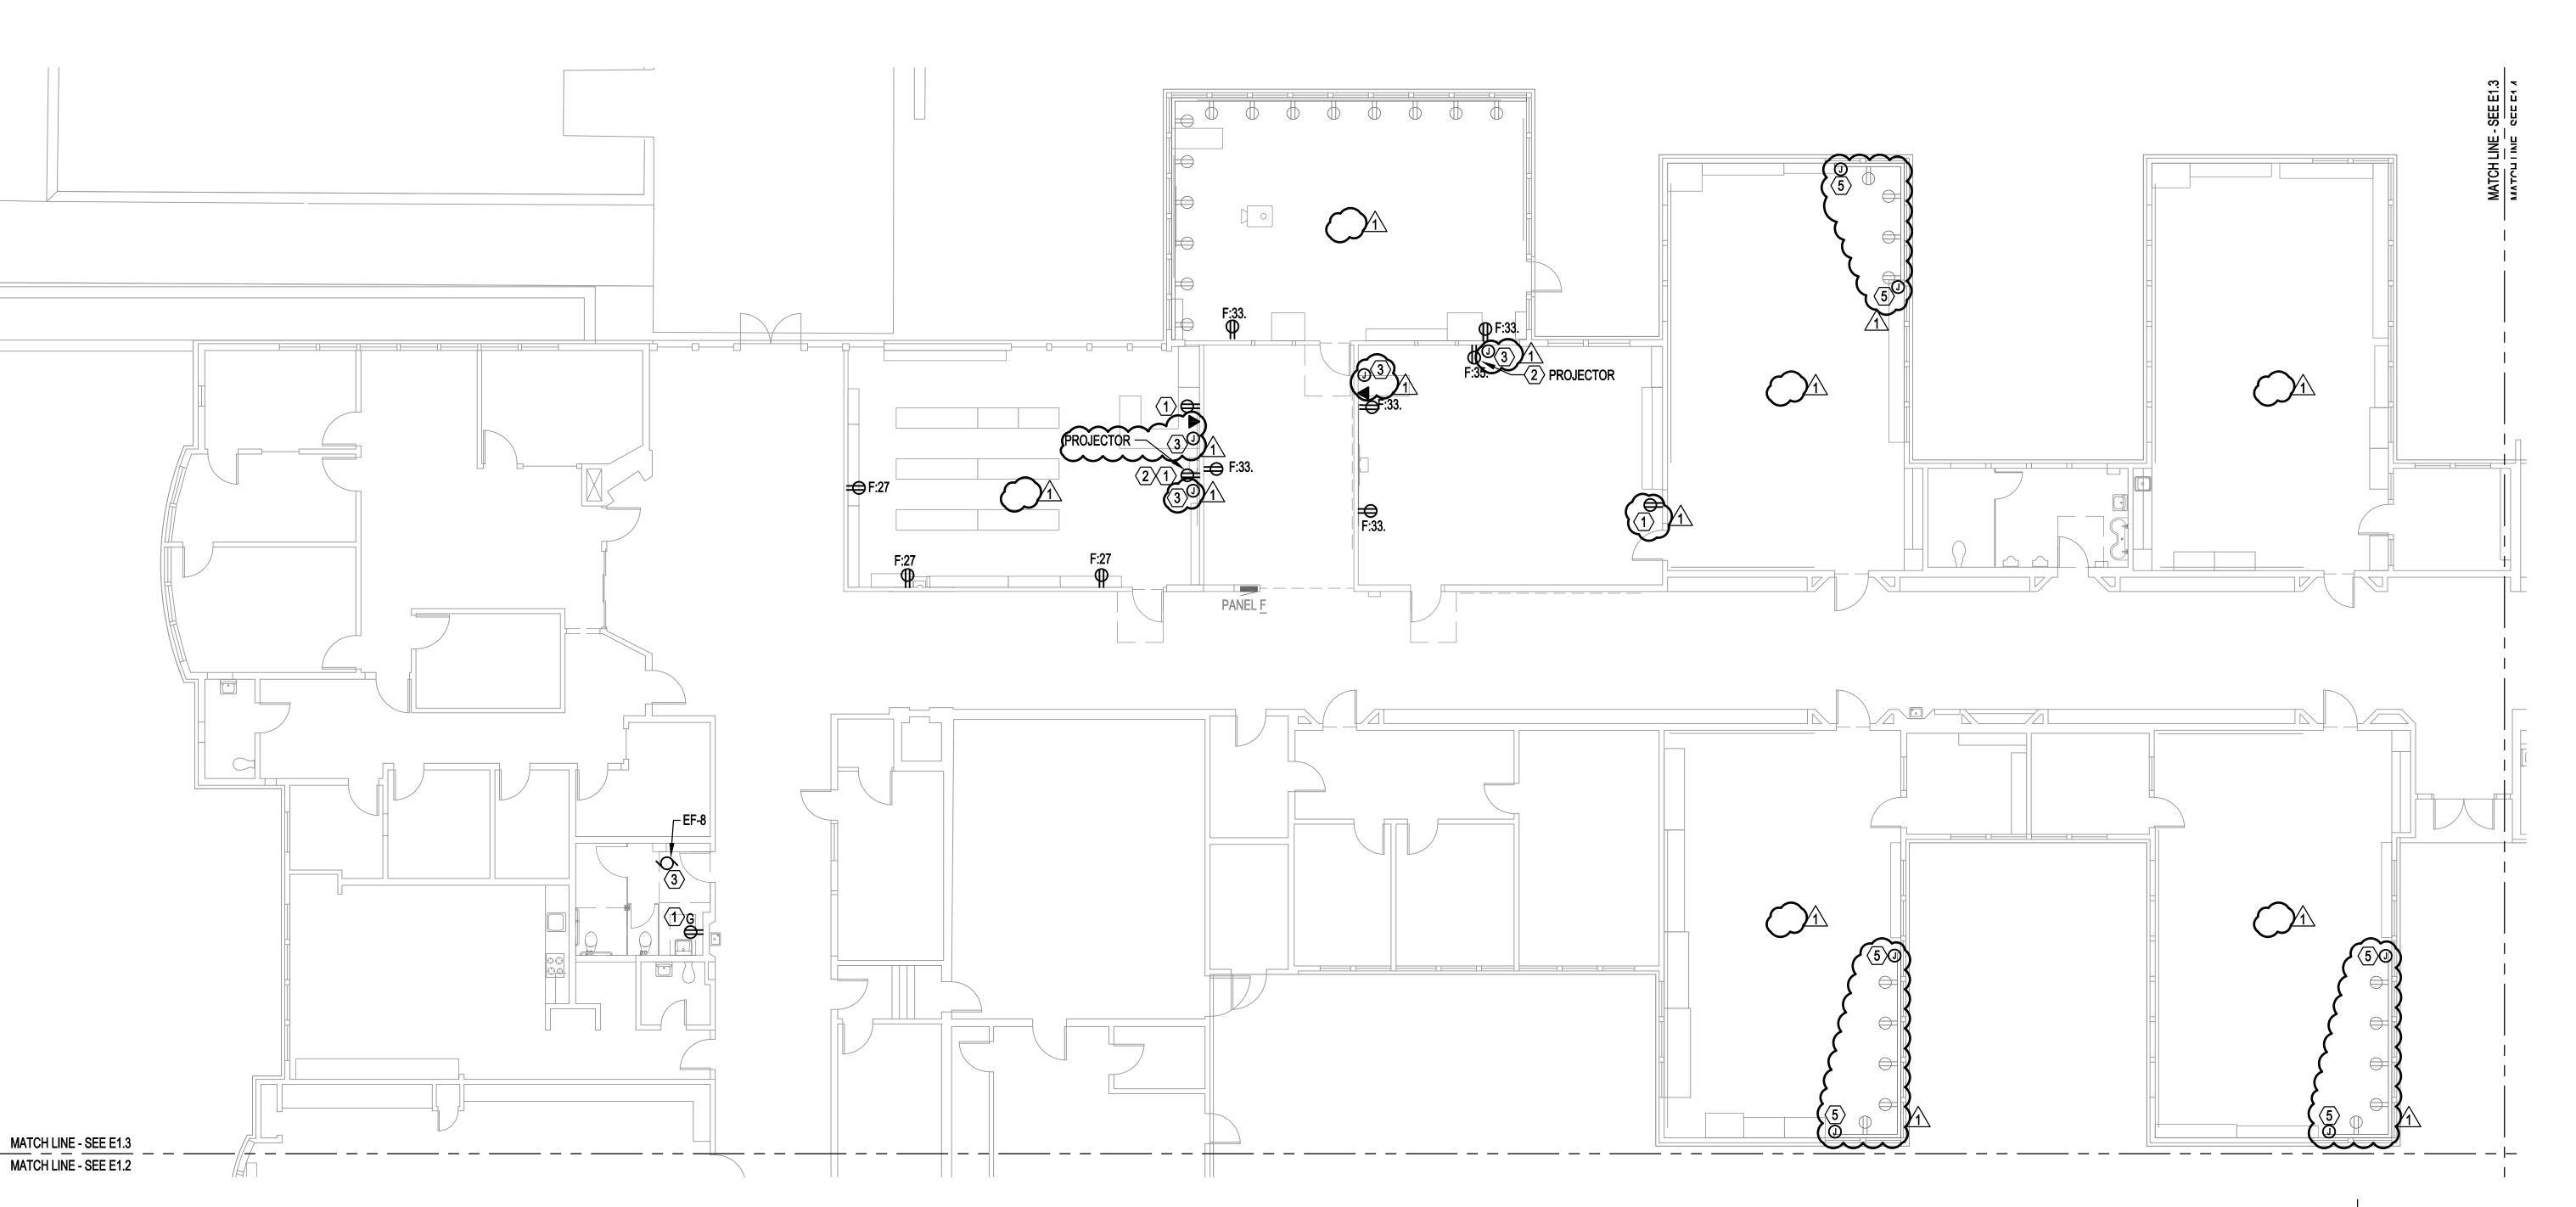

ENLARGED PARTIAL ELECTRICAL FLOOR PLAN - C E1.3 1/8" = 1'-0"

A. ALL MECHANICAL AND PLUMBING EQUIPMENT SHOWN IS FOR REFERENCE ONLY. REFER TO MECHANICAL AND PLUMBING SHEETS FOR EXACT LOCATIONS OF ALL EQUIPMENT. SEE MECHANICAL EQUIPMENT CONNECTION SCHEDULE ON E0.02 FOR CIRCUITING

D. REFER TO ARCHITECTURAL CEILING PLANS, ELEVATIONS, AND FLOOR PLANS FOR ACTUAL LOCATIONS OF ALL CEILING, WALL, AND FLOOR MOUNTED DEVICES AND EQUIPMENT. WHERE INTERIOR ELEVATIONS DIFFER BETWEEN ARCHITECTURAL AND ENGINEERING DRAWINGS, CONTRACTOR TO NOTIFY ENGINEER.

F. THE FIRE ALARM SYSTEM IS SHOWN FOR GUIDANCE AND IS INTENDED TO BE USED TO PROVIDE INFORMATION FOR A FIRE ALARM DESIGN-BUILD SYSTEM. EQUIPMENT AND DEVICE ARRANGEMENT SHOWN IS TO AID IN ESTABLISHING A BASIS OF DESIGN. CONTRACTOR SHALL BE RESPONSIBLE FOR CREATION OF PERMITTING, INSTALLATION, TESTING, AND


 NOTES: 1. CONNECT SALVAGED CIRCUIT TO NEW RECEPTACLE.

2. COORDINATE ELEVATION WITH ARCHITECT/OWNER PRIOR TO ROUGH-IN.

3. PROVIDE BACK-BOX AND CONDUIT PATHWAY



**GMA ARCHITECTS** 860 West Park Street / Ste 300 Eugene / Oregon / 97401 p 541.344.9157 gma-arch.com

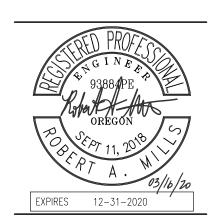




REVISIONS √1 3/17/2020 ADD. 1

JOB NO:

**ENLARGED** PARTIAL **ELECTRICAL** FLOOR PLAN - D

COPYRIGHT GMA ARCHITECTS

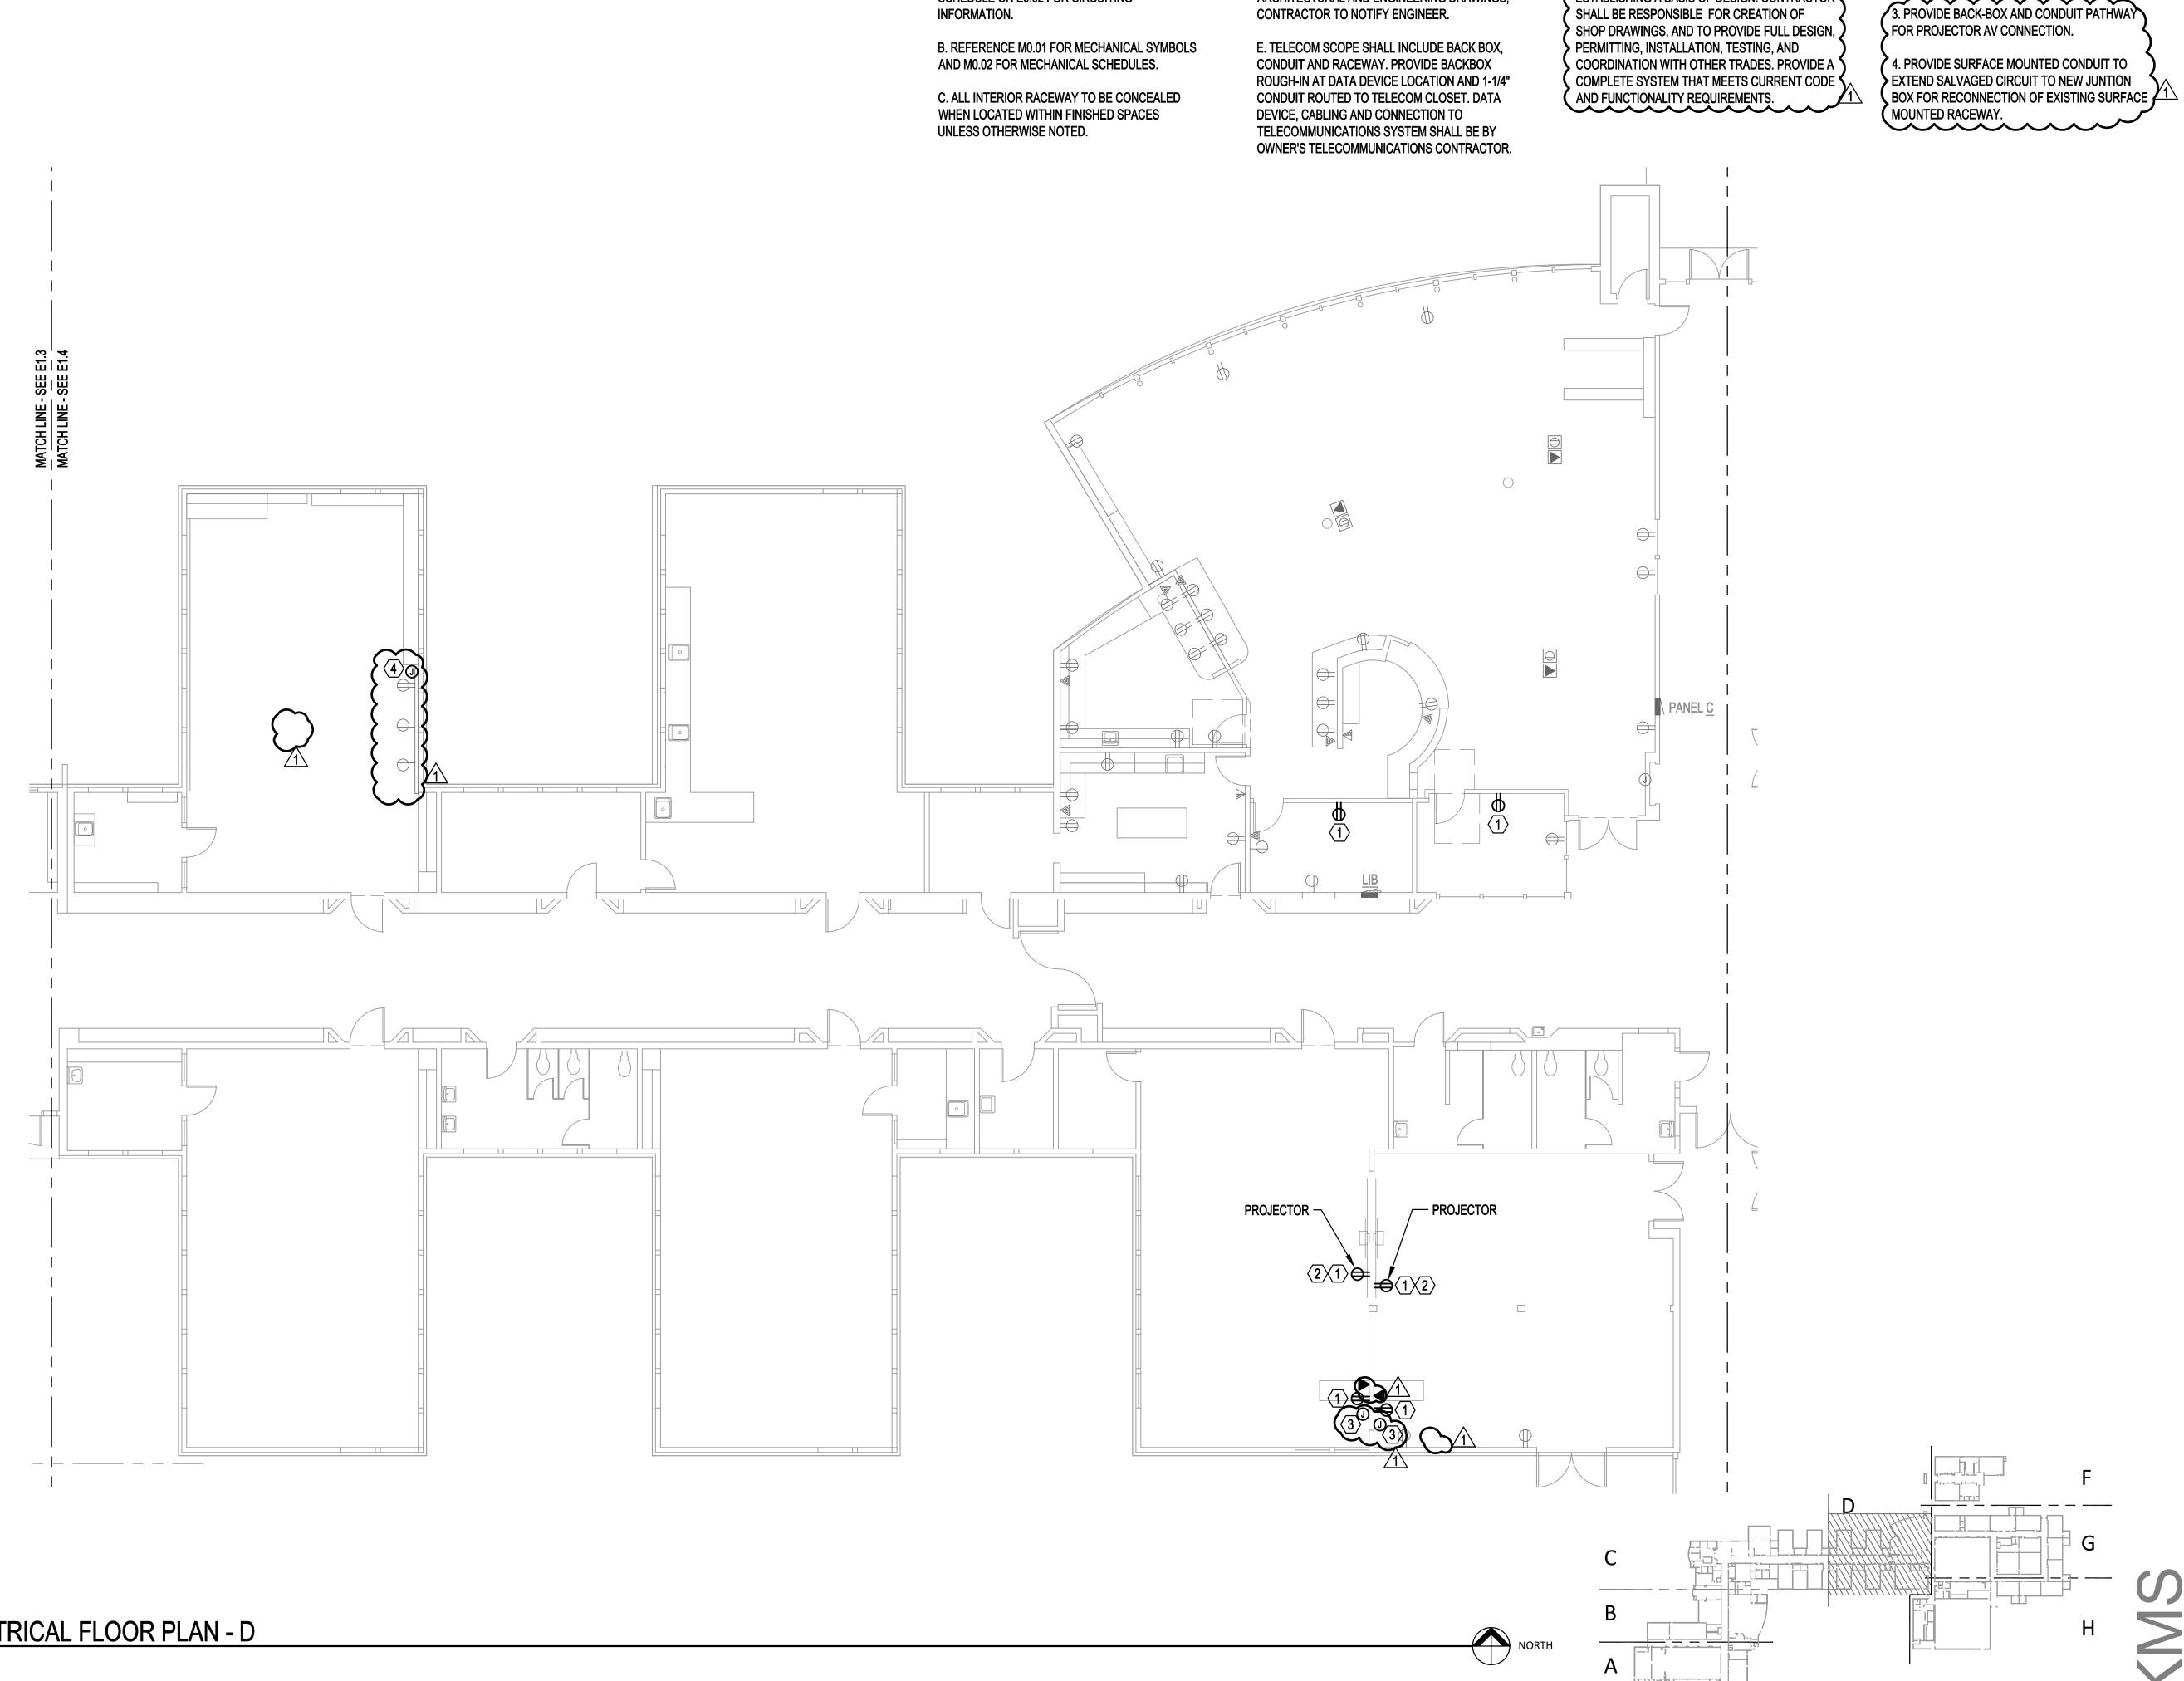

ENLARGED PARTIAL ELECTRICAL FLOOR PLAN - D E1.4 1/8" = 1'-0"

KEY PLAN- NTS

A. ALL MECHANICAL AND PLUMBING EQUIPMENT SHOWN IS FOR REFERENCE ONLY. REFER TO MECHANICAL AND PLUMBING SHEETS FOR EXACT LOCATIONS OF ALL EQUIPMENT. SEE MECHANICAL EQUIPMENT CONNECTION SCHEDULE ON E0.02 FOR CIRCUITING INFORMATION.

B. REFERENCE M0.01 FOR MECHANICAL SYMBOLS AND M0.02 FOR MECHANICAL SCHEDULES.

C. ALL INTERIOR RACEWAY TO BE CONCEALED WHEN LOCATED WITHIN FINISHED SPACES UNLESS OTHERWISE NOTED.

D. REFER TO ARCHITECTURAL CEILING PLANS, ELEVATIONS, AND FLOOR PLANS FOR ACTUAL LOCATIONS OF ALL CEILING, WALL, AND FLOOR MOUNTED DEVICES AND EQUIPMENT. WHERE INTERIOR ELEVATIONS DIFFER BETWEEN ARCHITECTURAL AND ENGINEERING DRAWINGS, CONTRACTOR TO NOTIFY ENGINEER.

E. TELECOM SCOPE SHALL INCLUDE BACK BOX, CONDUIT AND RACEWAY. PROVIDE BACKBOX ROUGH-IN AT DATA DEVICE LOCATION AND 1-1/4" CONDUIT ROUTED TO TELECOM CLOSET. DATA DEVICE, CABLING AND CONNECTION TO TELECOMMUNICATIONS SYSTEM SHALL BE BY OWNER'S TELECOMMUNICATIONS CONTRACTOR.

F. THE FIRE ALARM SYSTEM IS SHOWN FOR GUIDANCE AND IS INTENDED TO BE USED TO , PROVIDE INFORMATION FOR A FIRE ALARM DESIGN-BUILD SYSTEM. EQUIPMENT AND DEVICE ARRANGEMENT SHOWN IS TO AID IN ' ESTABLISHING A BASIS OF DESIGN. CONTRACTOR SHALL BE RESPONSIBLE FOR CREATION OF SHOP DRAWINGS, AND TO PROVIDE FULL DESIGN, , PERMITTING, INSTALLATION, TESTING, AND COORDINATION WITH OTHER TRADES. PROVIDE A COMPLETE SYSTEM THAT MEETS CURRENT CODE AND FUNCTIONALITY REQUIREMENTS. 

NOTES:

1. CONNECT SALVAGED CIRCUIT TO NEW RECEPTACLE.

2. PROVIDE BACK-BOX AND CONDUIT PATHWAY FOR PROJECTOR AV CONNECTION.



**GMA ARCHITECTS** 860 West Park Street / Ste 300 Eugene / Oregon / 97401 p 541.344.9157 gma-arch.com





REVISIONS /1\ 3/17/2020 ADD. 1

**PROVEMENT** 

JOB NO: ISSUE DATE:

**ENLARGED** PARTIAL **ELECTRICAL** FLOOR PLAN - F

KEY PLAN- NTS

ENLARGED PARTIAL ELECTRICAL FLOOR PLAN - F E1.4

MATCH LINE - SEE E1.5

A. PROVIDE #10 AWG CONDUCTORS TO 120V BRANCH CIRCUITS OVER 100FT FROM BRANCH Panel.

B. COORDINATE ROUTING OF CONDUIT WITH ALL OTHER TRADES. WHERE POSSIBLE, ROUTE CONDUIT TIGHT TO DECK STRUCTURE. CONDUIT SHALL BE ROUTED SO AS NOT TO OBSTRUCT ACCESS TO VALVES, DAMPERS, CONTROL PANELS, ACCESS PANELS AND EQUIPMENT COMPONENTS.

C. LUMINAIRE LOCATIONS SHOWN ARE APPROXIMATE AND DIAGRAMMATIC. REFER TO ARCHITECTURAL REFLECTED CEILING PLANS AND ELEVATIONS FOR EXACT LUMINAIRE/CONTROLS LOCATIONS AND MOUNTING HEIGHTS.

 $\bigcirc$  NOTES:

1. CONNECT SALVAGED CIRCUIT TO NEW FIXTURE LOCATIONS.

2. CONNECT SALVALED CIRCUIT TO NEW SWITCH LOCATION.

GMA ARCHITECTS 860 West Park Street / Ste 300


Eugene / Oregon / 97401

p 541.344.9157

gma-arch.com



REVISIONS

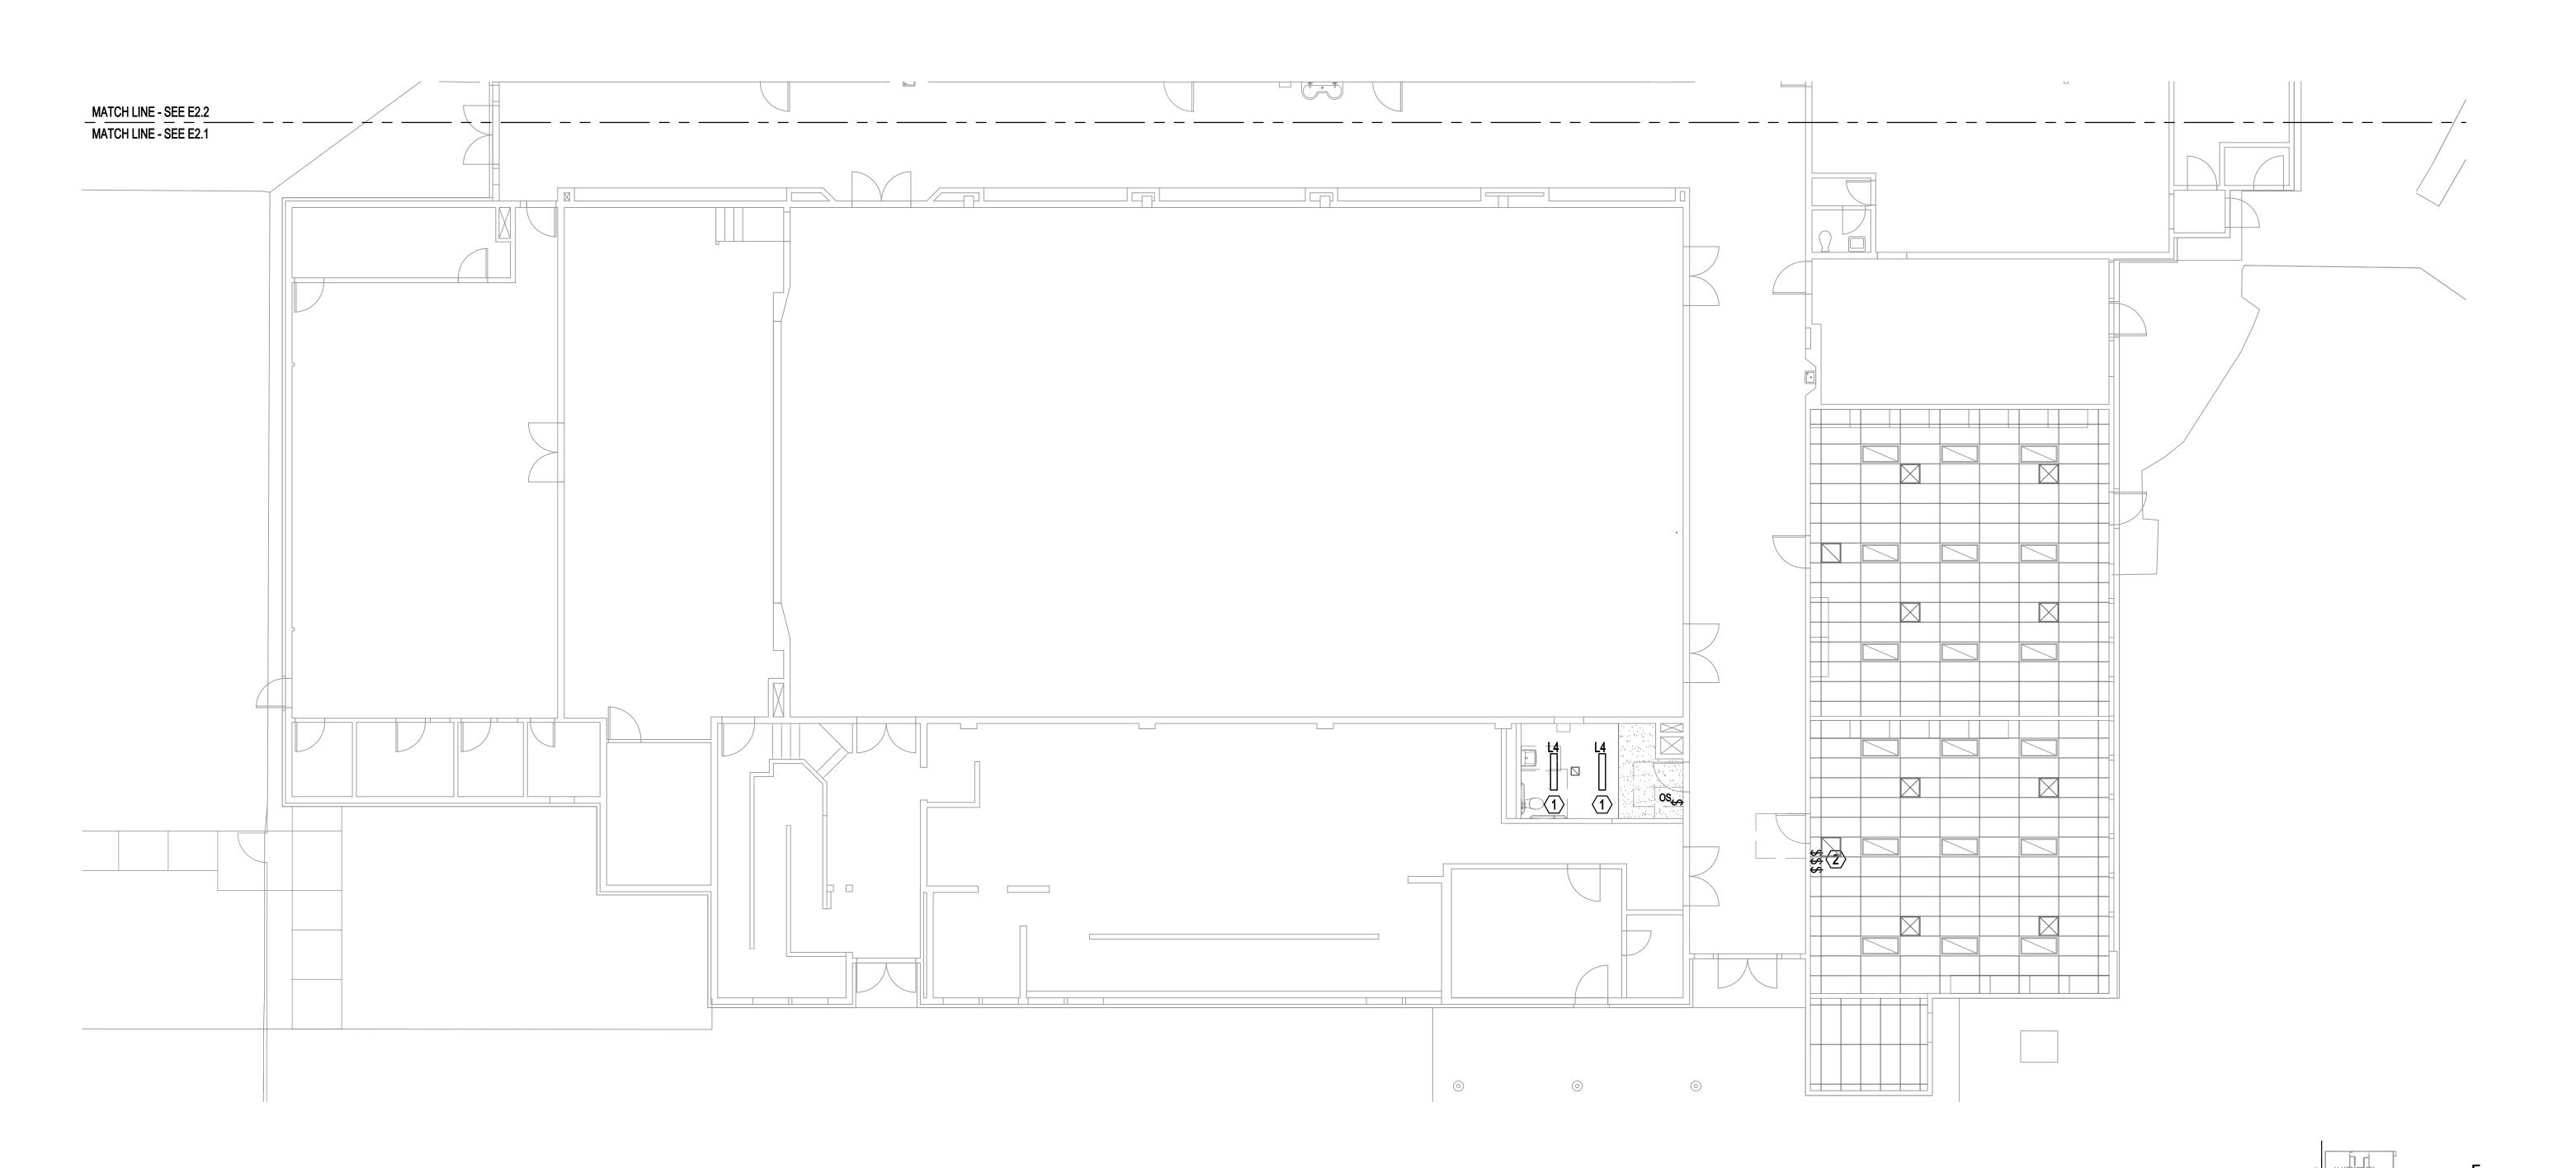

**PROVEMENTS** 

JOB NO:

**ENLARGED** PARTIAL LIGHTING REFLECTED CEILING PLAN - A

E2.1

ENLARGED PARTIAL LIGHTING REFLECTED CEILING PLAN - A E2.1 1/8" = 1'-0"

KEY PLAN- NTS

CONTROL STATION SCHEDULE

| CONTROL<br>STATION ID | ZONES | DIMMING |
|-----------------------|-------|---------|
| CS1                   | 1     | YES     |
| CS2                   | 2     | YES     |
| CS3                   | 3     | YES     |
|                       |       |         |

A. PROVIVE ALL ON/OFF AND INDIVIDUAL ON/OFF AND DIMMING CONTROL PER ZONE.

**GENERAL NOTES:** 

A. PROVIDE #10 AWG CONDUCTORS TO 120V BRANCH CIRCUITS OVER 100FT FROM BRANCH Panel.

B. COORDINATE ROUTING OF CONDUIT WITH ALL OTHER TRADES. WHERE POSSIBLE, ROUTE CONDUIT TIGHT TO DECK STRUCTURE. CONDUIT SHALL BE ROUTED SO AS NOT TO OBSTRUCT ACCESS TO VALVES, DAMPERS, CONTROL PANELS, ACCESS PANELS AND EQUIPMENT COMPONENTS.

C. LUMINAIRE LOCATIONS SHOWN ARE APPROXIMATE AND DIAGRAMMATIC. REFER TO ARCHITECTURAL REFLECTED CEILING PLANS AND ELEVATIONS FOR EXACT LUMINAIRE/CONTROLS LOCATIONS AND MOUNTING HEIGHTS.

NOTES:

1. CONNECT SALVAGED CIRCUIT TO NEW FIXTURE LOCATIONS.


2. PROVIDE NEW SWITCH TO CONTROL EXISTING FIXTURES.



Eugene / Oregon / 97401

p 541.344.9157

gma-arch.com

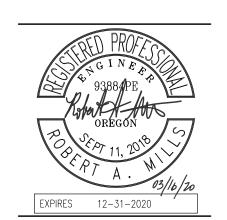




**REVISIONS** 

3/17/2020 ADD. 1

**PROVEMENTS** 

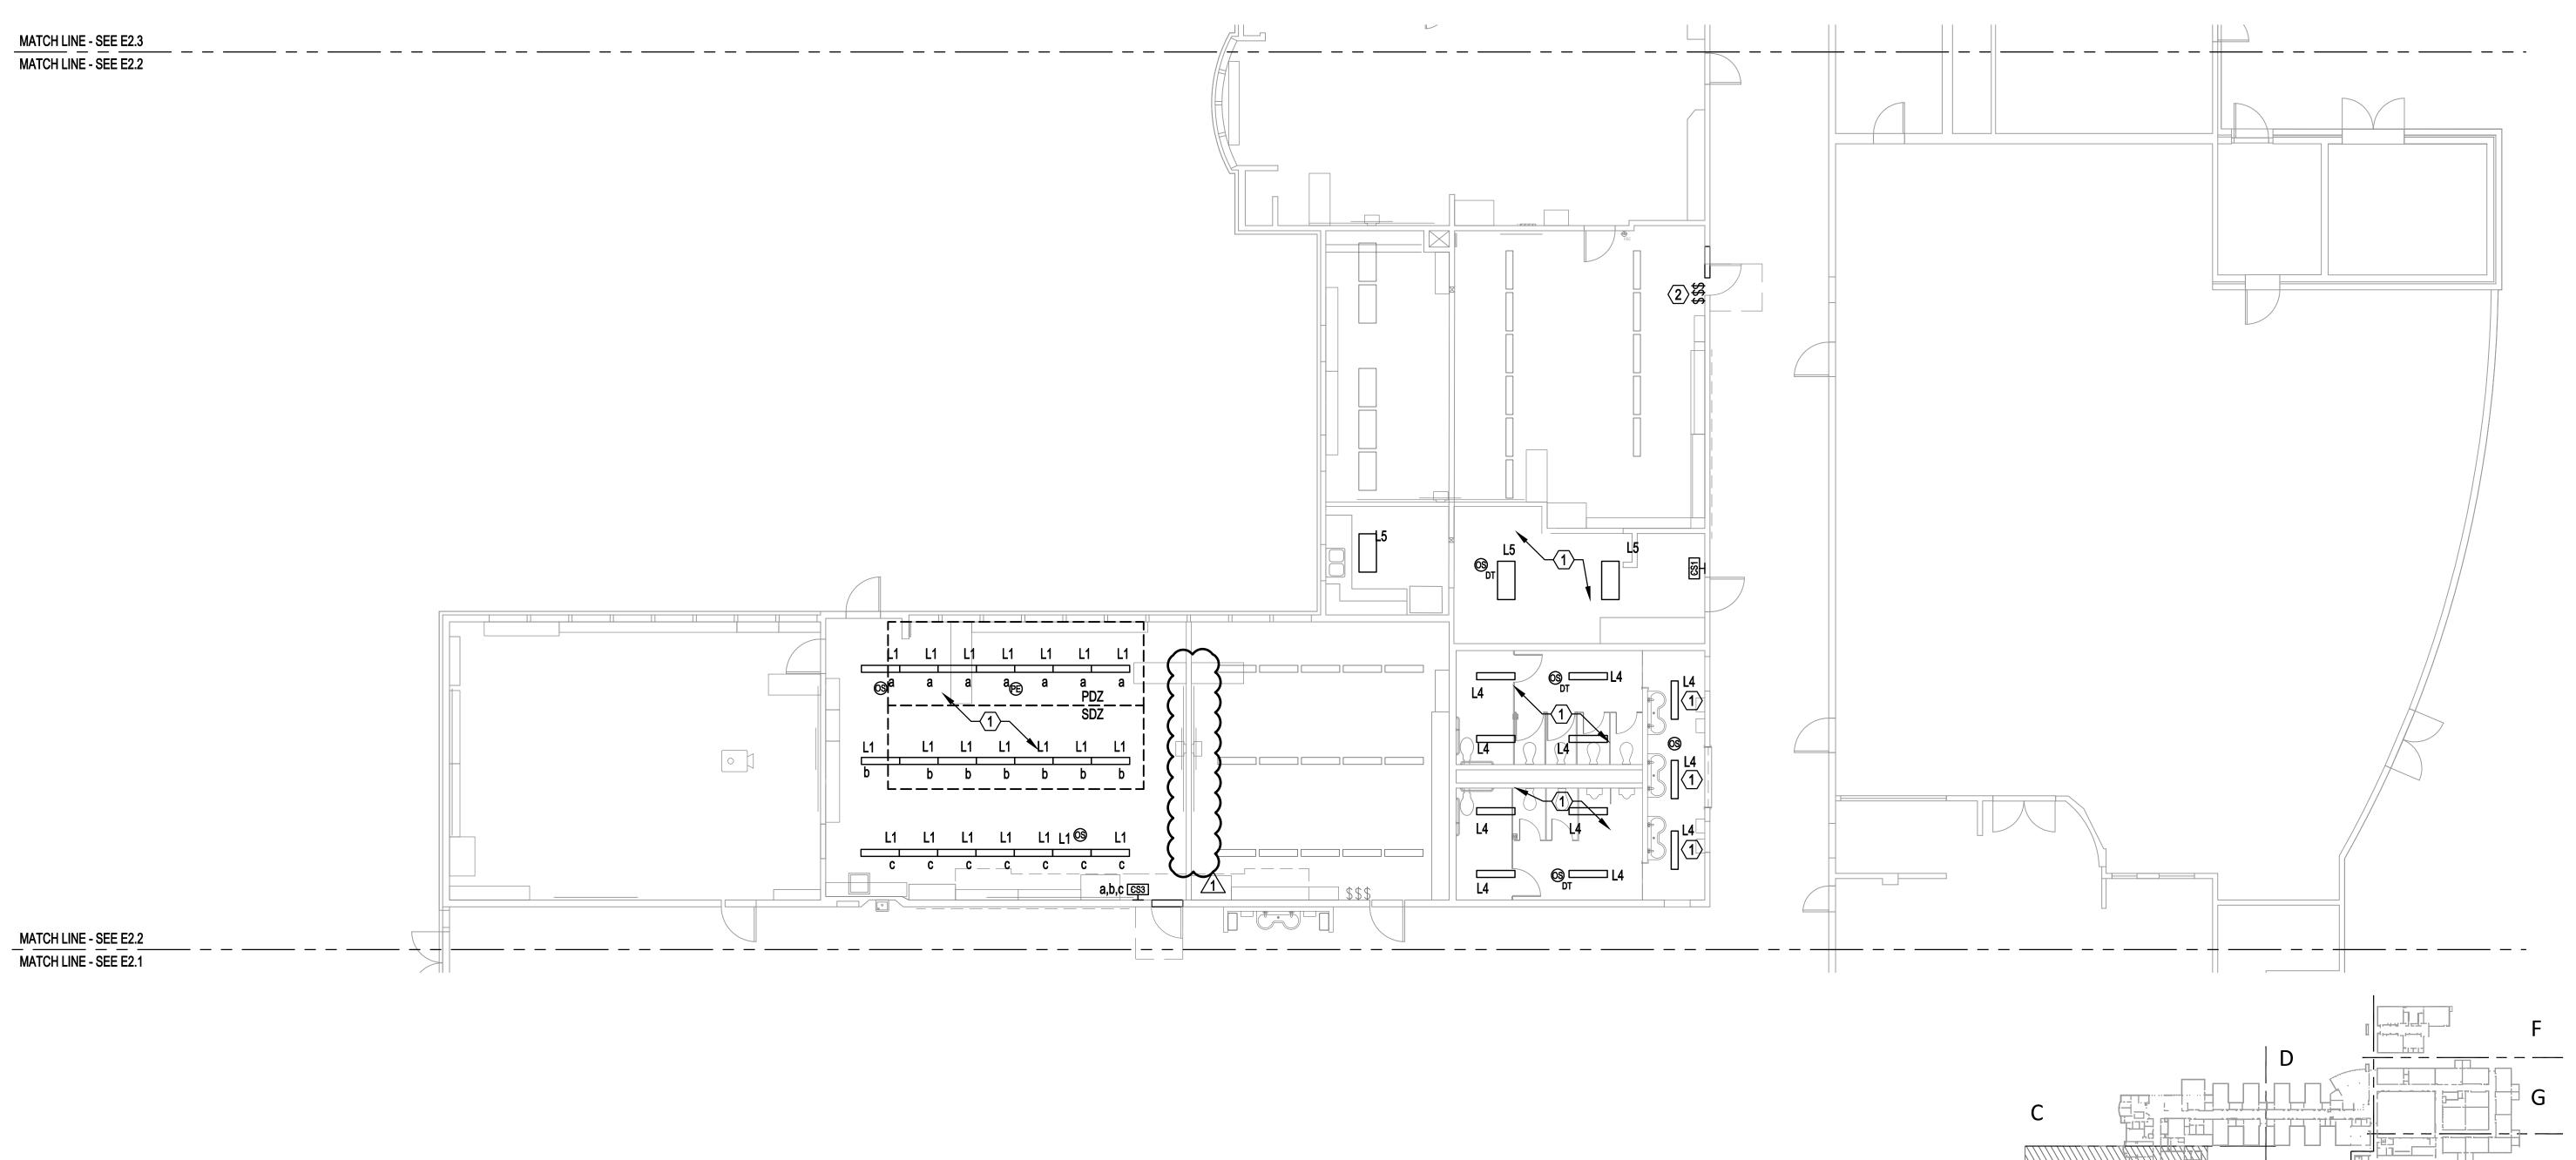

ENLARGED PARTIAL LIGHTING REFLECTED CEILING PLAN - B E2.2 1/8" = 1'-0"

KEY PLAN- NTS

E2.2

**ENLARGED** 

PARTIAL LIGHTING

REFLECTED

CEILING PLAN - B

JOB NO:

ISSUE DATE:

CONTROL STATION SCHEDULE

| CONTROL<br>STATION ID | ZONES | DIMMING |
|-----------------------|-------|---------|
| CS1                   | 1     | YES     |
| CS2                   | 2     | YES     |
| CS3                   | 3     | YES     |
|                       |       |         |

A. PROVIVE ALL ON/OFF AND INDIVIDUAL ON/OFF AND DIMMING CONTROL PER ZONE.

**GENERAL NOTES:** 

A. PROVIDE #10 AWG CONDUCTORS TO 120V BRANCH CIRCUITS OVER 100FT FROM BRANCH Panel.

B. COORDINATE ROUTING OF CONDUIT WITH ALL OTHER TRADES. WHERE POSSIBLE, ROUTE CONDUIT TIGHT TO DECK STRUCTURE. CONDUIT SHALL BE ROUTED SO AS NOT TO OBSTRUCT ACCESS TO VALVES, DAMPERS, CONTROL PANELS, ACCESS PANELS AND EQUIPMENT COMPONENTS.

C. LUMINAIRE LOCATIONS SHOWN ARE APPROXIMATE AND DIAGRAMMATIC. REFER TO ARCHITECTURAL REFLECTED CEILING PLANS AND ELEVATIONS FOR EXACT LUMINAIRE/CONTROLS LOCATIONS AND MOUNTING HEIGHTS.

NOTES:

1. CONNECT SALVAGED CIRCUIT TO NEW FIXTURE LOCATIONS.


2. LOCATED NEW FIXTURES IN EXISTING FIXTURE LOCATION.

GMA ARCHITECTS

860 West Park Street / Ste 300

Eugene / Oregon / 97401 p 541.344.9157 gma-arch.com



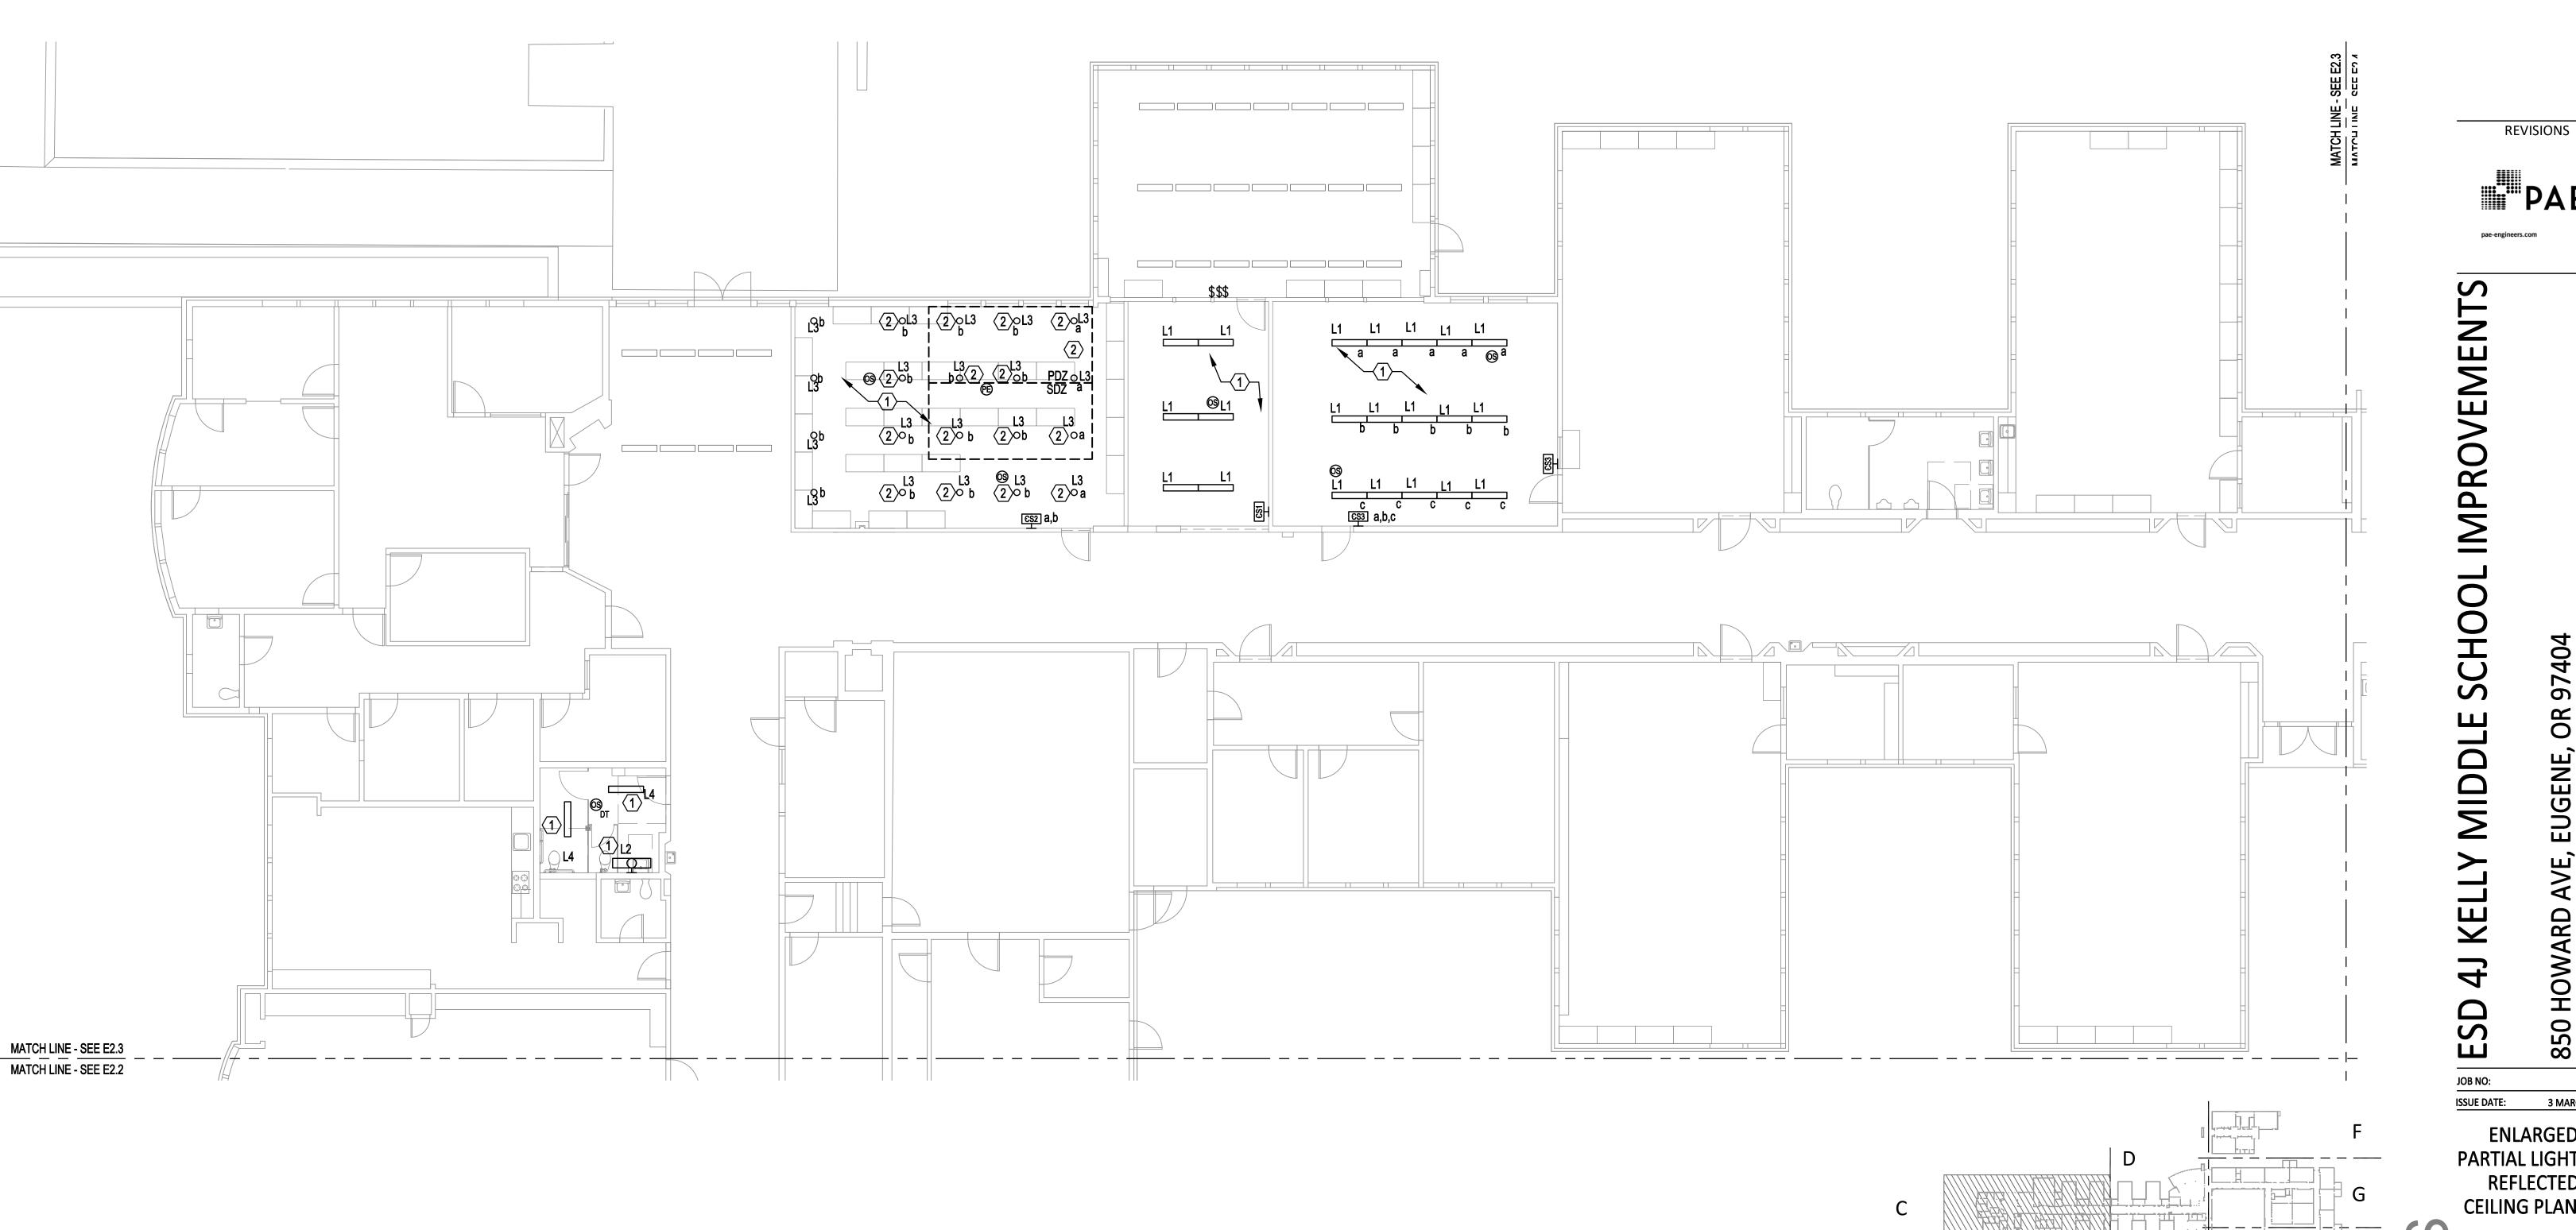

**ENLARGED** PARTIAL LIGHTING REFLECTED CEILING PLAN - C

E2.3

KEY PLAN- NTS

E2.3 1/8" = 1'-0"

ENLARGED PARTIAL LIGHTING REFLECTED CEILING PLAN - C

ENLARGED PARTIAL LIGHTING REFLECTED CEILING PLAN - D E2.4 1/8" = 1'-0"

**GENERAL NOTES:** 

A. PROVIDE #10 AWG CONDUCTORS TO 120V BRANCH CIRCUITS OVER 100FT FROM BRANCH PANEL.

B. COORDINATE ROUTING OF CONDUIT WITH ALL OTHER TRADES. WHERE POSSIBLE, ROUTE CONDUIT TIGHT TO DECK STRUCTURE. CONDUIT SHALL BE ROUTED SO AS NOT TO OBSTRUCT ACCESS TO VALVES, DAMPERS, CONTROL PANELS, ACCESS PANELS AND EQUIPMENT COMPONENTS.

C. LUMINAIRE LOCATIONS SHOWN ARE APPROXIMATE AND DIAGRAMMATIC. REFER TO ARCHITECTURAL REFLECTED CEILING PLANS AND ELEVATIONS FOR EXACT LUMINAIRE/CONTROLS LOCATIONS AND MOUNTING HEIGHTS.

NOTES:

1. CONNECT SALVAGED CIRCUIT TO NEW FIXTURE LOCATIONS.


2. PROVIDE NEW SWITCH TO CONTROL EXISTING FIXTURES.

3. RELOCATE EXISTING FIXTURE TO NEW LOCATION.

4. REWIRE FIXTURES IN THIS SPACE SUCH THAT THE EXISTING SWITCH CONTROLS ONLY THE EXISTING FIXTURES LOCAL TO THE NEW CLASSROOM.



GMA ARCHITECTS 860 West Park Street / Ste 300 Eugene / Oregon / 97401 p 541.344.9157 gma-arch.com

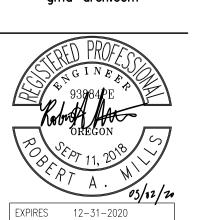

**REVISIONS** 




**PROVEMENTS** 

JOB NO:

**ENLARGED** PARTIAL LIGHTING REFLECTED CEILING PLAN - D

E2.4

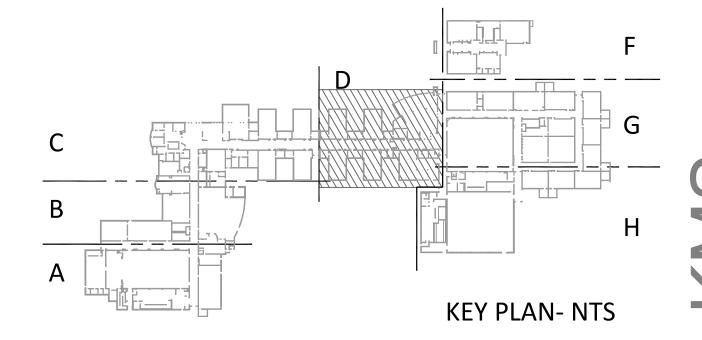

ENLARGED PARTIAL LIGHTING REFLECTED CEILING PLAN - F E2.4 1/8" = 1'-0"

**GENERAL NOTES:** 


A. PROVIDE #10 AWG CONDUCTORS TO 120V BRANCH CIRCUITS OVER 100FT FROM BRANCH Panel.

B. COORDINATE ROUTING OF CONDUIT WITH ALL OTHER TRADES. WHERE POSSIBLE, ROUTE CONDUIT TIGHT TO DECK STRUCTURE. CONDUIT SHALL BE ROUTED SO AS NOT TO OBSTRUCT ACCESS TO VALVES, DAMPERS, CONTROL PANELS, ACCESS PANELS AND EQUIPMENT COMPONENTS.

C. LUMINAIRE LOCATIONS SHOWN ARE APPROXIMATE AND DIAGRAMMATIC. REFER TO ARCHITECTURAL REFLECTED CEILING PLANS AND ELEVATIONS FOR EXACT LUMINAIRE/CONTROLS LOCATIONS AND MOUNTING HEIGHTS.

 NOTES: 1. RECONNECT SALVAGED CIRCUIT TO NEW SWITCH LOCATION.



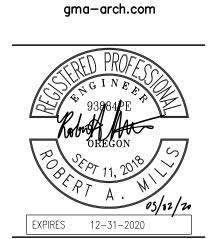

p 541.344.9157

**REVISIONS** 




JOB NO:

**ENLARGED** PARTIAL LIGHTING REFLECTED CEILING PLAN - F

E2.5

KEY PLAN- NTS

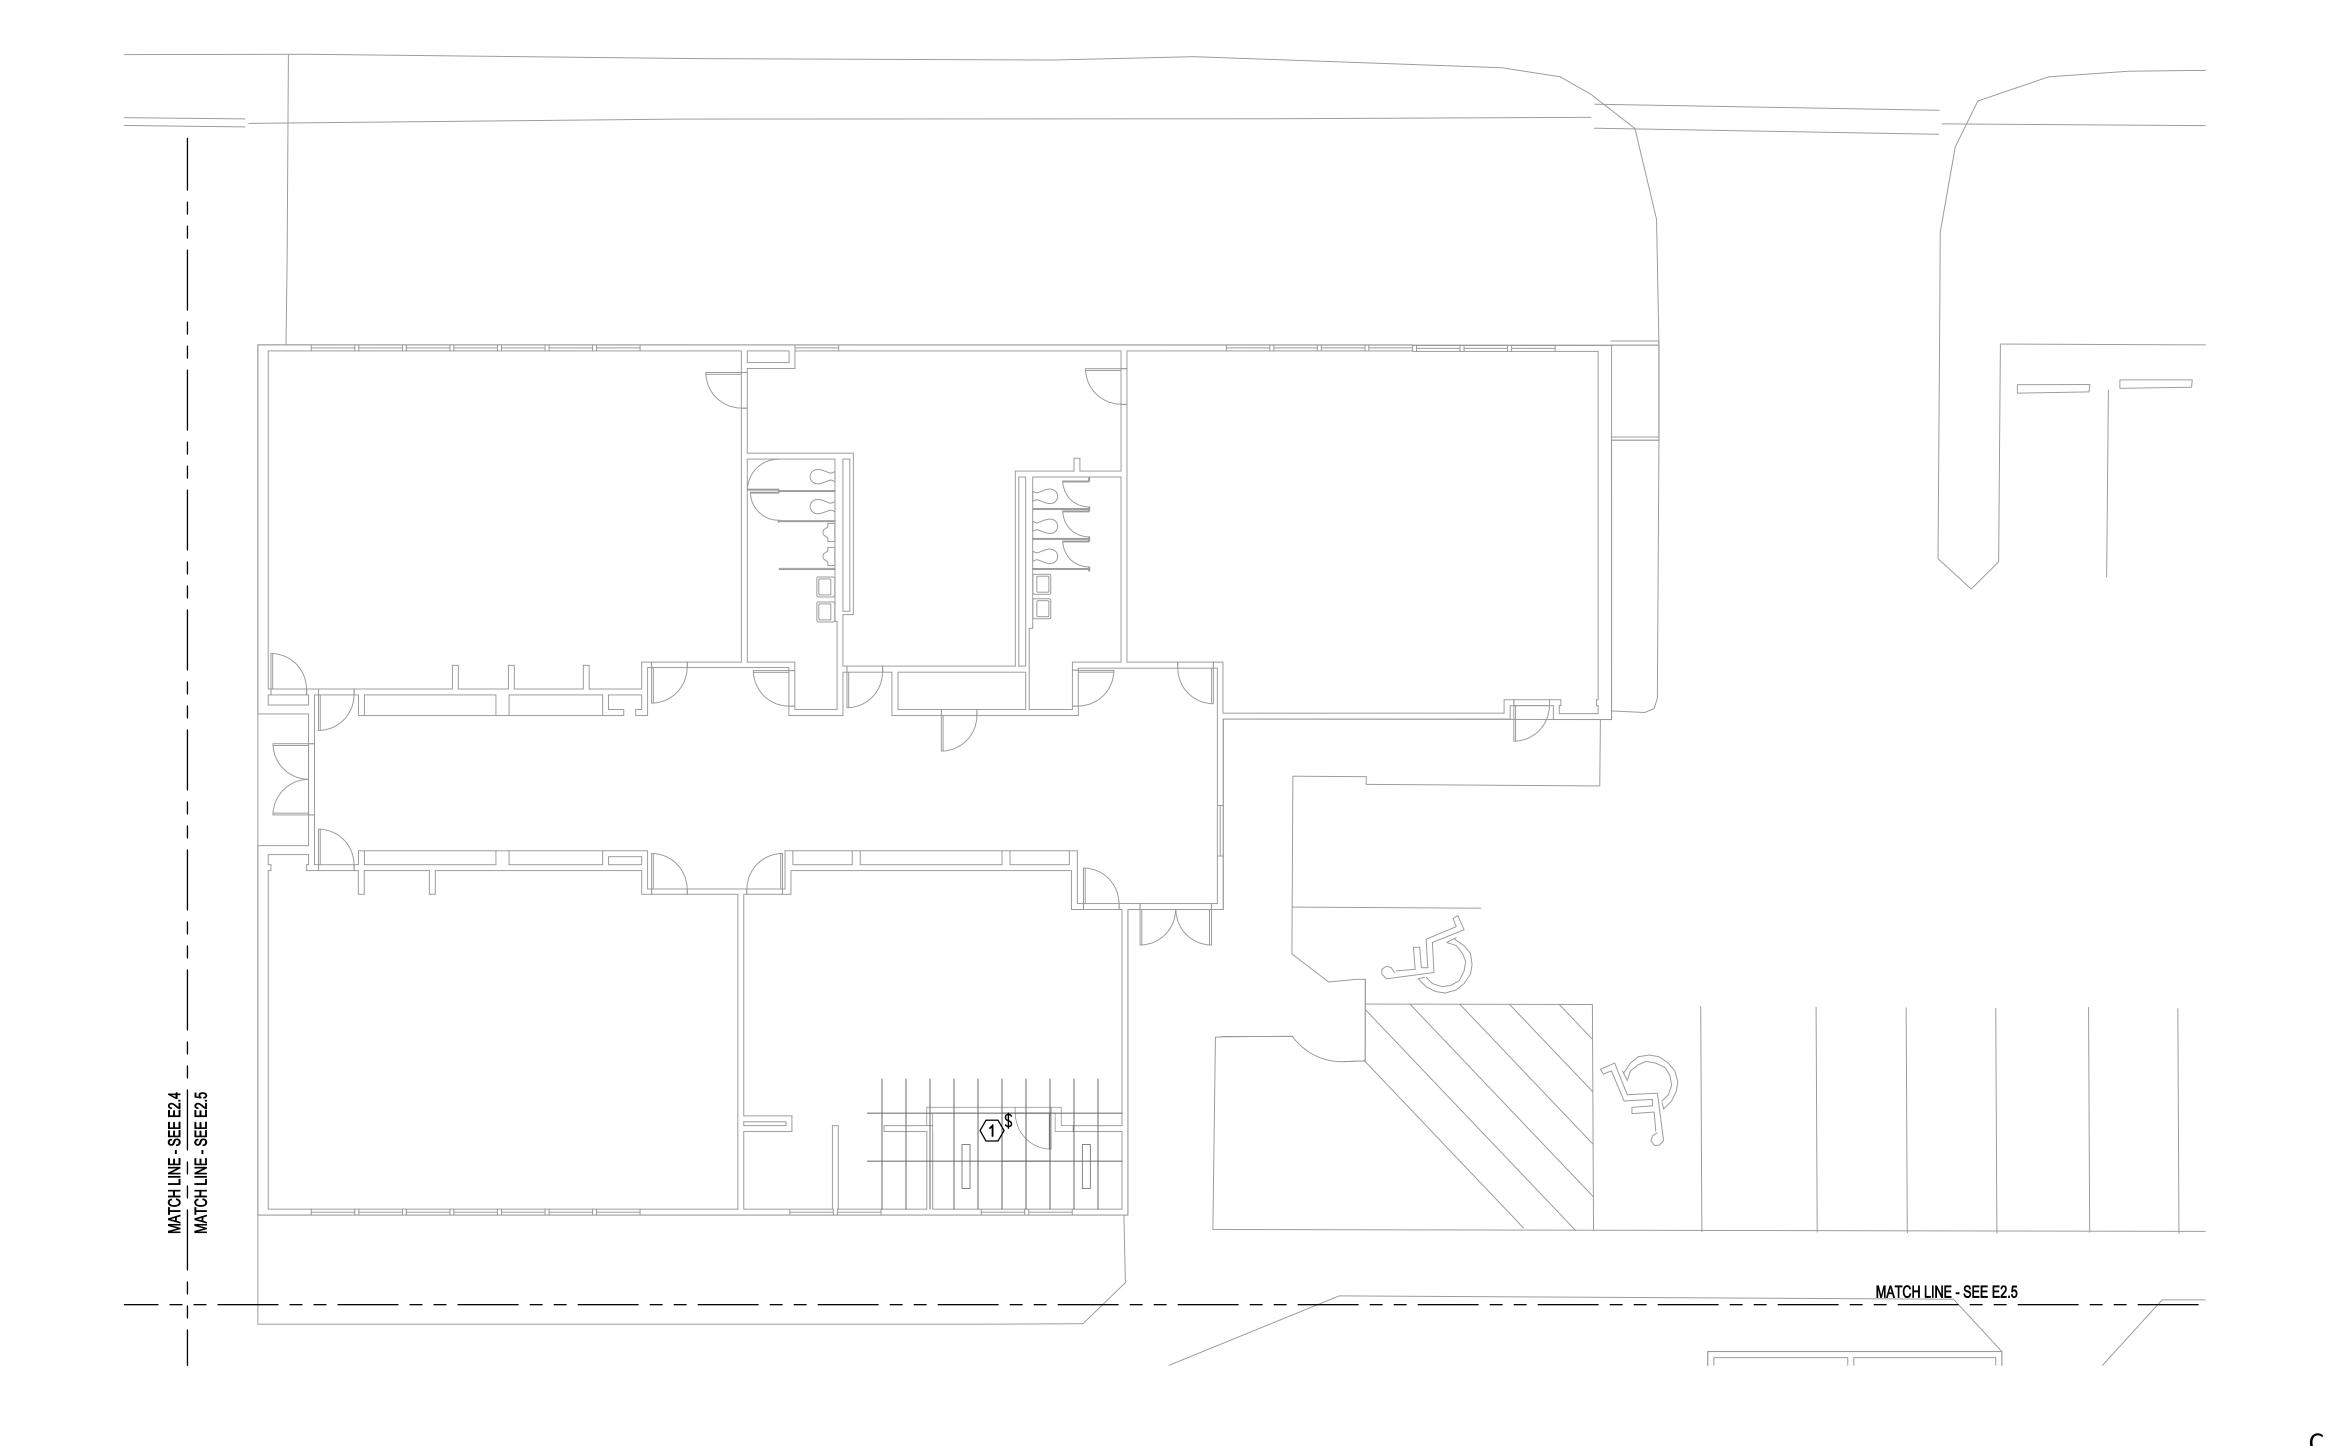

— PANEL AFFECTED BY

SCOPE OF WORK

-4-#2 \$

1-48 GND

IN 2" CONDUIT

PANEL

- 4-12 4 1-18 GND

IN 11/2"

CONDUIT


1. SCOPE OF WORK RESULTS IN A NET REDUCTION IN LOAD ON PANEL.

PANEL


- 4-#2 THHN 4


1-48 THHN GND



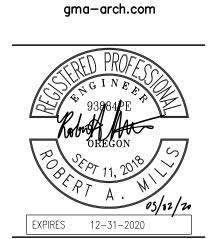



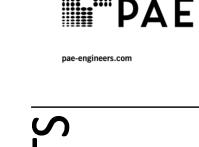

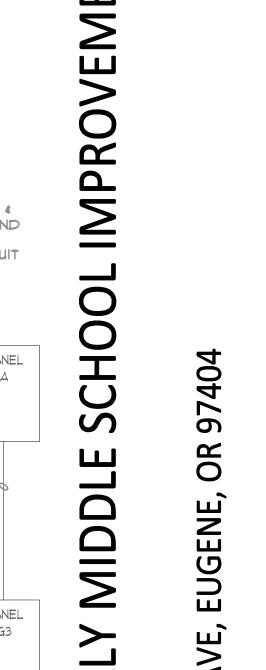




19189 **ISSUE DATE:** 3 MARCH 2020

> DIAGRAMS -**ELECTRICAL**

COPYRIGHT GMA ARCHITECTS

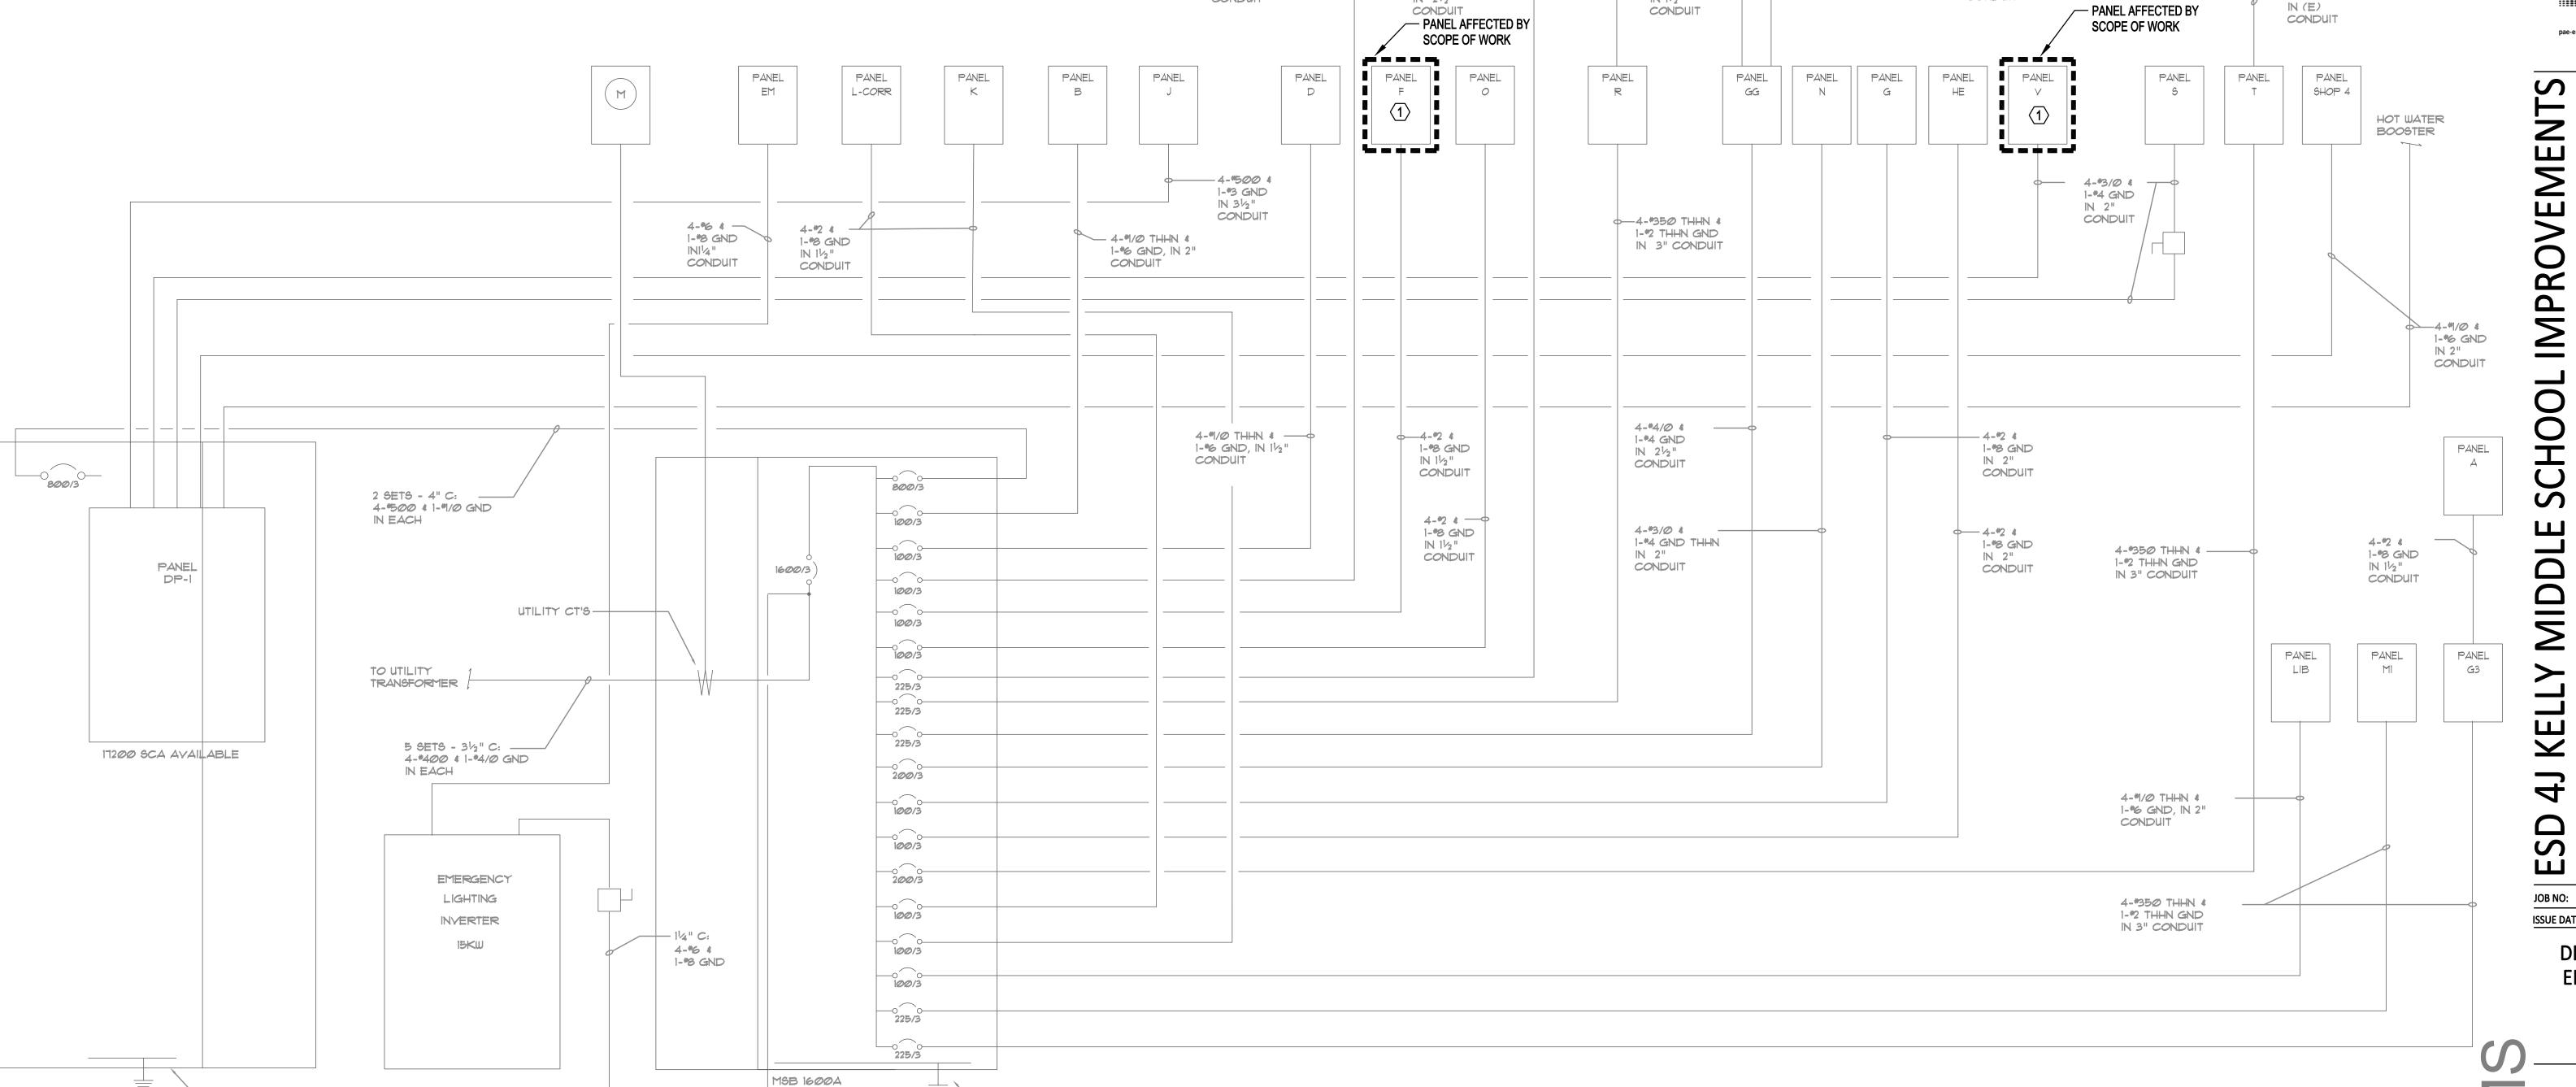

- 2"C -4 #1 # 1 #6 GND

PANEL

ART

4-41/0 THHN 4 ---

1-16 GND, IN 2"

CONDUIT

4-\*3 # 1-\*10 GND

CONDUIT

PANEL PANEL

R-EXT

PANEL

GD

4-#4/0 \$ 1-#4 GND

IN 21/2"

— PANEL AFFECTED BY

1-#8 GND

IN 11/2"

PANEL

SCOPE OF WORK

PANEL M LOAD ANALYSIS

PANEL GG LOAD ANALYSIS

MAIN BOARD LOAD ANALYSIS

220

225

517

24

571 1600

120Y/208Y

- SWITCHBOARD

24750 SCA AVAILABLE

SERVICE GROUNDING

129

PEAK DEMAND BASED ON LOAD CALCULATIONS

PEAK DEMAND BASED ON LOAD CALCULATIONS

PEAK DEMAND BASED ON 1 YEAR OF UTILITY DATA

NEC 220.87 125% OF PEAK DEMAND

NEC 220.87 125% OF PEAK DEMAND

NEC 220.87 125% OF PEAK DEMAND

DEMOLISHED LOAD ADDED LOAD NET LOAD BOARD AMPACITY SPARE AMPACITY

DEMOLISHED LOAD ADDED LOAD NET LOAD

BOARD AMPACITY

SPARE AMPACITY

DEMOLISHED LOAD ADDED LOAD

BOARD AMPACITY

SPARE AMPACITY


NET LOAD


|                        |                 |                  |              |          | F     | PAN    | IEL S    | СН     | EDU      | LE    |         |         |                   |                                     |  |  |  |
|------------------------|-----------------|------------------|--------------|----------|-------|--------|----------|--------|----------|-------|---------|---------|-------------------|-------------------------------------|--|--|--|
|                        |                 |                  |              |          |       |        |          |        |          |       |         |         |                   |                                     |  |  |  |
| PANEL: M               | LOCATION        | N: MAIN ELECTRIC | AL ROOM      | Л        |       |        | VOLT     | AGE:   | 208      | Y/    | 120     | P: 3    |                   | W: 4 AIC RATING:                    |  |  |  |
| AMP: 225 MLC           | X MCB           |                  |              |          |       |        |          |        |          |       |         |         |                   | MOUNTING: SURFACE X FLUSH           |  |  |  |
| TYPE: EXISTING         | S X NEW         | STYLE:           |              |          |       |        | NEUT     | ΓRAL:  | 100%     | 00%   |         |         |                   | FED FROM: PANEL GG                  |  |  |  |
| OIDO                   | JIT DESCRIPTION | 1                | LC           | AD       | CKT P |        | CIR      | Р      | CIR      | Р     | CKT     | L       | DAD               | CIDCUIT DESCRIPTION                 |  |  |  |
| CIRCI                  | JII DESCRIPTION | N                | TYPE KVA BKR |          |       |        |          | Н      | #        |       | BKR     | KVA     | TYPE              | CIRCUIT DESCRIPTION                 |  |  |  |
| (E) EXISTING LOAD      |                 |                  | MISC         | 1.92     | 20    | 1      | 1        | Α      | 2        | 1     | 20      |         |                   | (E) SPARE                           |  |  |  |
| (E) EXISTING LOAD      |                 |                  | MISC         | 1.92     | 20    | 1      | 3        | В      | 4        | 1     | 20      |         |                   | (E) SPARE                           |  |  |  |
| (E) EXISTING LOAD      |                 |                  | MISC         | 1.92     | 20    | 1      | 5        | С      | 6        | 1     | 20      | 1.92    | MISC              | (E) EXISTING LOAD                   |  |  |  |
| (E) EXISTING LOAD      |                 |                  | MISC         | 1.92     | 20    | 1      | 7        | Α      | 8        | 1     | 20      | 1.92    | MISC              | (E) EXISTING LOAD                   |  |  |  |
| (E) EXISTING LOAD      |                 | MISC             | 1.92         | 20       | 1     | 9      | В        | 10     | 1        | 20    | 1.92    | MISC    | (E) EXISTING LOAD |                                     |  |  |  |
| (E) EXISTING LOAD      |                 | MISC             | 1.92         | 20       | 1     | 11     | С        | 12     | 1        | 20    | 1.92    | MISC    | (E) EXISTING LOAD |                                     |  |  |  |
| (E) EXISTING LOAD      |                 |                  | MISC         | 1.92     | 20    | 1      | 13       | Α      | 14       | 1     | 20      | 1.92    | MISC              | (E) EXISTING LOAD                   |  |  |  |
| (E) EXISTING LOAD      |                 |                  | MISC         | 1.92     | 20    | 1      | 15       | В      | 16       | 1     | 20      |         |                   | (E) SPARE                           |  |  |  |
| (N) HV-20              |                 |                  | MISC         | 0.44     | 15    | 2      | 17       | С      | 18       | 1     | 20      |         |                   | (E) SPARE                           |  |  |  |
| <u> </u>               |                 | MISC             | 0.44         | -        | -     | 19     | Α        | 20     | 1        | 20    |         |         | (E) SPARE         |                                     |  |  |  |
| (N) HV-21              |                 | MISC             | 0.44         | 15       | 2     | 21     | В        | 22     | 1        | 20    |         |         | (E) SPARE         |                                     |  |  |  |
|                        |                 | MISC             | 0.44         | -        | -     | 23     | С        | 24     | 1        | 20    |         |         | (E) SPARE         |                                     |  |  |  |
| (E) SPACE              |                 |                  |              |          |       |        | 25       | Α      | 26       | 3     | 15      |         |                   | (E) EXISTING LOAD                   |  |  |  |
| (N) RECEPTACLES RO     |                 |                  | REC          | 0.72     | 20    | 1      | 27       | В      | 28       | -     | -       |         |                   |                                     |  |  |  |
| (N) SMART BOARD RO     |                 | REC              | 0.36         | 20       | 1     | 29     | С        | 30     | -        | -     |         |         | (5) 004.05        |                                     |  |  |  |
| (N) EF-7               |                 |                  | MTR          | 0.04     | 20    | 1      | 31       | A      | 32       | 1     | 20      |         |                   | (E) SPARE                           |  |  |  |
| (E) SPARE              |                 |                  |              |          | 20    | 1      | 33       | В      | 34       | 1     | 20      |         |                   | (E) SPARE                           |  |  |  |
| (E) SPARE              |                 |                  |              |          | 20    | 1      | 35<br>37 | C      | 36<br>38 | 3     | 20      |         |                   | (E) SPARE                           |  |  |  |
| (E) SPACE<br>(E) SPACE |                 |                  |              |          |       |        | 39       | A<br>B | 40       | -     | - 20    |         |                   | (E) SPARE                           |  |  |  |
| (E) SPACE              |                 |                  |              |          |       |        | 41       | С      | 42       | _     | -       |         |                   |                                     |  |  |  |
| (L) OI NOL             |                 |                  |              |          |       |        |          | Ť      | 72       |       |         |         |                   |                                     |  |  |  |
| ESTIMATED MAXIMUM      | DEMAND (EMD)    | CALCULATIONS     |              |          |       |        |          |        |          |       |         |         |                   |                                     |  |  |  |
| LOAD SUMMARY:          | LOAD TYPE       | CONNECTED        | NEC DE       | MAND     |       |        |          |        |          |       |         |         |                   |                                     |  |  |  |
| LIGHTING               | LTG             | 0.0 KVA          | 0.0          | KVA (12  | 5%)   |        |          |        |          |       |         |         | CONNE             | CTED PHASE LOADING                  |  |  |  |
| RESIDENT LTG/REC       | RES             | 0.0 KVA          |              | KVA ( 10 | ,     | %)     |          |        |          |       |         |         | PHASE             |                                     |  |  |  |
| SMALL APPLIANCE        | RES             | 0.0 KVA          |              | KVA ( 10 |       | •      |          |        |          |       |         |         | PHASE             |                                     |  |  |  |
| LARGEST MOTOR          | MTR             | KVA              |              | KVA (12  |       | -,     |          |        |          |       |         |         | PHASE             |                                     |  |  |  |
| REMAINING MOTORS       | MTR             | 0.0 KVA          |              | KVA (12  | ,     |        |          |        |          |       |         |         |                   | O. 0.00 KVA                         |  |  |  |
|                        |                 |                  |              | ,        | ,     | 0 /A \ |          |        |          |       |         |         |                   |                                     |  |  |  |
| GEN PURPOSE REC        | REC             | 1.1 KVA          |              | KVA ( 50 |       | (VA)   |          |        |          |       |         |         |                   |                                     |  |  |  |
| COMPUTER REC           | MISC            | 0.0 KVA          |              | KVA (10  | ,     |        |          |        |          |       |         |         |                   |                                     |  |  |  |
| EQUIP/OTHER            | MISC            | 26.7 KVA         | 26.7         | KVA (10  | 0%)   |        |          |        | NOTES    | :     |         |         |                   |                                     |  |  |  |
| HEATING                | MISC            | 0.0 KVA          | 0.0          | KVA (10  | 0%)   |        |          |        | 1. LIGH  | T LIN | EWEIGHT | r PREFA | CED WIT           | H (E) INDICATES EXISTING TO REMIAN. |  |  |  |
| ELEVATOR               | ELEV            | 0.0 KVA          | 0.0          | KVA (10  | 0%)   |        |          |        | 2. BOL   | D LIN | EWEIGH1 | Γ PREFA | CED WIT           | H (N) INDICATES NEW                 |  |  |  |
| KITCHEN EQPT           | KITCH           | 0.0 KVA          | 0.0          | KVA (.65 | i)    |        |          |        |          |       |         |         |                   |                                     |  |  |  |
| TOTALS:                |                 | 27.9 KVA         | 27.9         | KVA      |       |        |          | 1      |          |       |         |         |                   |                                     |  |  |  |
| -                      |                 | 77.3 AMP         |              | AMP      |       |        |          |        |          |       |         |         |                   |                                     |  |  |  |
|                        |                 | - /              |              |          |       |        |          | 1      | 1        |       |         |         |                   |                                     |  |  |  |

|                                     |                  |           |        |                     | F       | PAN   | IEL S    | CH     | EDU      | LE     |         |         |         |                                      |
|-------------------------------------|------------------|-----------|--------|---------------------|---------|-------|----------|--------|----------|--------|---------|---------|---------|--------------------------------------|
|                                     |                  |           |        |                     |         |       |          |        |          |        |         |         |         |                                      |
| PANEL: L                            | LOCATION: S      | TAGE      |        |                     |         |       | VOLT     | AGE:   | 208      | Y/     | 120     | P:      | 3       | W: 4 AIC RATING:                     |
| AMP: 225 MLC                        | X MCB            |           |        |                     |         |       |          |        |          |        |         |         |         | MOUNTING: SURFACE X FLUSH            |
| TYPE: EXISTING                      | S X NEW          | STYLE:    |        |                     |         |       | NEU      | ΓRΔI · | 100%     |        |         |         |         | FED FROM: PANEL GG                   |
| TITE: EXIOTING                      | , A NEW          | OTTEE.    |        |                     |         |       |          |        |          |        | 1       |         |         | TED TROW. TARLE GO                   |
| CIRCU                               | JIT DESCRIPTION  |           |        | AD                  | CKT     | Р     | CIR      | Р      | CIR      | Р      | CKT     |         | OAD     | CIRCUIT DESCRIPTION                  |
|                                     |                  |           | TYPE   | KVA                 | BKR     |       | #        | Н      | #        |        | BKR     | KVA     | TYPE    |                                      |
| (E) EXISTING LOAD                   |                  |           | MISC   | 1.92                | 20      | 1     | 1        | A      | 2        | 1      | 20      | 1.92    |         | (E) EXISTING LOAD                    |
| (E) EXISTING LOAD (E) EXISTING LOAD |                  |           | MISC   | 1.92<br><b>1.92</b> | 20      | 1     | 3<br>5   | В      | 6        | 1      | 20      |         |         | (E) SPARE                            |
| (E) EXISTING LOAD                   |                  |           | MISC   | 1.92                | 20      | 1     | 7        | A      | 8        | 1      | 20      |         |         | (E) SPARE                            |
| (E) SPARE                           |                  |           | WIIGO  | 1.32                | 20      | 1     | 9        | В      | 10       | 1      | 20      |         |         | (E) SPARE                            |
| (E) EXISTING LOAD                   |                  |           | MISC   | 1.92                | 20      | 1     | 11       | C      | 12       | 1      | 20      |         |         | (E) SPARE                            |
| (E) EXISTING LOAD                   |                  |           | MISC   | 1.92                | 20      | 1     | 13       | A      | 14       | 3      | 20      | 0.80    | MISC    | (E) EXISTING LOAD                    |
| (E) SPARE                           |                  |           |        |                     | 20      | 1     | 15       | В      | 16       | -      | -       | 0.80    | MISC    | -                                    |
| (E) SPARE                           |                  |           |        |                     | 20      | 1     | 17       | С      | 18       | -      | -       | 0.80    | MISC    | -                                    |
| (E) SPARE                           |                  |           |        |                     | 20      | 1     | 19       | Α      | 20       | 1      | 20      |         |         | (E) SPARE                            |
| (E) SPARE                           |                  |           |        |                     | 20      | 1     | 21       | В      | 22       | 1      | 20      |         |         | (E) SPARE                            |
| (E) SPARE                           |                  |           |        |                     | 20      | 1     | 23       | С      | 24       | 1      | 20      |         |         | (E) SPARE                            |
| (E) SPARE                           |                  |           |        |                     | 20      | 2     | 25       | Α      | 26       | 1      | 20      |         |         | (E) SPARE                            |
| (E) SPARE                           |                  |           |        |                     | 20      | 1     | 27       | В      | 28       | 1      | 20      |         |         | (E) SPARE                            |
| (E) SPARE                           |                  |           |        |                     | 20      | 2     | 29       | С      | 30       |        |         |         |         | (E) SPACE                            |
| (E) SPARE                           |                  |           |        |                     | 20      | 1     | 31       | A      | 32       |        |         |         |         | (E) SPACE                            |
| (E) SPARE                           |                  |           |        |                     | 20      | 2     | 33       | В      | 34       |        |         |         |         | (E) SPACE                            |
| (E) SPACE                           |                  |           |        |                     | 20      | 1     | 35<br>37 | C      | 36<br>38 |        |         |         |         | (E) SPACE                            |
| (E) SPACE<br>(E) SPACE              |                  |           |        |                     |         |       | 39       | В      | 40       |        |         |         |         | (E) SPACE                            |
| (E) SPACE                           |                  |           |        |                     |         |       | 41       | С      | 42       |        |         |         |         | (E) SPACE                            |
| (=) -: : : =                        |                  |           |        |                     |         |       |          |        |          |        |         |         |         |                                      |
| ESTIMATED MAXIMUM                   | DEMAND (EMD) CAL | CULATIONS |        |                     |         |       |          |        |          |        |         | •       |         |                                      |
| LOAD SUMMARY:                       | LOAD TYPE        | CONNECTED | NEC DE | MAND                |         |       |          |        |          |        |         |         |         |                                      |
| LIGHTING                            | LTG              | 0.0 KVA   | 0.0    | KVA (12             | 5%)     |       |          |        |          |        |         |         | CONNE   | CTED PHASE LOADING                   |
| RESIDENT LTG/REC                    | RES              | 0.0 KVA   |        | KVA ( 10            |         | %)    |          |        |          |        |         |         | PHASE   |                                      |
| SMALL APPLIANCE                     | RES              | 0.0 KVA   | 0.0    | KVA ( 10            | 0/35/25 | %)    |          |        |          |        |         |         | PHASE   | B: 2.72 KVA                          |
| LARGEST MOTOR                       | MTR              | KVA       | 0.0    | KVA (12             | 5%)     | ,     |          |        |          |        |         |         | PHASE   | C: 4.64 KVA                          |
| REMAINING MOTORS                    | MTR              | 0.0 KVA   |        | KVA (10             | ,       |       |          |        |          |        |         |         |         | o                                    |
| GEN PURPOSE REC                     | REC              | 0.0 KVA   |        | KVA ( 50            | ,       | ۸/۸۱  |          |        |          |        |         |         |         |                                      |
| COMPUTER REC                        | MISC             |           |        | KVA (10             |         | ( ( ) |          |        |          |        |         |         |         |                                      |
|                                     |                  | 0.0 KVA   |        | •                   | ,       |       |          |        | NOTEO    |        |         |         |         |                                      |
| EQUIP/OTHER                         | MISC             | 15.8 KVA  |        | KVA (10             |         |       |          |        | NOTES    |        |         |         |         |                                      |
| HEATING                             | MISC             | 0.0 KVA   |        | KVA (10             |         |       |          |        |          |        |         |         |         | TH (E) INDICATES EXISTING TO REMIAN. |
| ELEVATOR                            | ELEV             | 0.0 KVA   |        | KVA (10             | ,       |       |          |        | 2. BOLE  | ) LINE | EWEIGH1 | Γ PREFA | CED WIT | H (N) INDICATES NEW                  |
| KITCHEN EQPT                        | KITCH            | 0.0 KVA   | 0.0    | KVA (.65            | 5)      |       |          | 4      |          |        |         |         |         |                                      |
| TOTALS:                             |                  | 15.8 KVA  | 15.8   | KVA                 |         |       |          |        |          |        |         |         |         |                                      |
|                                     |                  | 44.0 AMP  | 44.0   | AMP                 |         |       |          |        |          |        |         |         |         |                                      |
|                                     |                  |           |        |                     |         |       |          |        |          |        |         |         |         |                                      |


| PANEL: GG        |                 | N: MAIN ELECTRIC | CAL ROOM     | 1            |          |       | VOLT             | ΓAGE: | 208      | Y/     | 120     | P:           | 3       | W: 4 AIC RATING:                    |
|------------------|-----------------|------------------|--------------|--------------|----------|-------|------------------|-------|----------|--------|---------|--------------|---------|-------------------------------------|
| AMP: 225 MLC     | X MCB           |                  |              |              |          |       |                  |       |          |        |         |              |         | MOUNTING: SURFACE X FLUS            |
| TYPE: EXISTING   | X NEW           | STYLE:           |              |              |          |       | NEU <sup>-</sup> | TRAL: | 100%     |        |         |              |         | FED FROM: MSB                       |
| CIDCI            | UIT DESCRIPTION |                  | LC           | AD           | CKT P    |       | CIR              | Р     | CIR      | Р      | CKT     | LOAD         |         | CIRCUIT DESCRIPTION                 |
| CIRCI            | JIT DESCRIPTIO  | N                | TYPE         | KVA          | BKR      |       | #                | Н     | #        |        | BKR     | KVA          | TYPE    | CIRCUIT DESCRIPTION                 |
| E) SPARE         |                 |                  |              |              | 20       | 1     | 1                | Α     | 2        | 1      | 20      | 1.92         |         | (E) EXISTING LOAD                   |
| E) EXISTING LOAD |                 |                  | MISC         | 1.92         | 20       | 1     | 3                | В     | 4        | 1      | 20      | 1.92         | MISC    | (E) EXISTING LOAD                   |
| E) EXISTING LOAD |                 |                  | MISC         | 1.92         | 20       | 1     | 5                | С     | 6        | 1      | 20      | 1.92         | MISC    | (E) EXISTING LOAD                   |
| E) SPARE         |                 |                  |              |              | 20       | 1     | 7                | Α     | 8        | 1      | 20      | 1.92         | MISC    | (E) EXISTING LOAD                   |
| E) EXISTING LOAD |                 |                  | MISC         | 1.92         | 20       | 1     | 9                | В     | 10       | 1      | 20      |              |         | (E) SPARE                           |
| E) SPARE         |                 |                  |              |              | 20       | 1     | 11               | С     | 12       | 1      | 20      | 1.92         | MISC    | (E) EXISTING LOAD                   |
| E) SPARE         |                 |                  |              |              | 20       | 1     | 13               | Α     | 14       | 1      | 20      |              |         | (E) SPARE                           |
| E) SPARE         |                 |                  |              |              | 20       | 1     | 15               | В     | 16       | 1      | 20      |              |         | (E) SPARE                           |
| E) SPARE         |                 |                  |              |              | 20       | 1     | 17               | С     | 18       | 1      | 20      |              |         | (E) SPARE                           |
| E) SPARE         |                 |                  |              |              | 20       | 1     | 19               | A     | 20       | 3      | 20      | 0.80         | MISC    | (E) EXISTING LOAD                   |
| E) SPARE         |                 |                  | 14100        | 0.00         | 20       | 1     | 21               | В     | 22       | -      | -       | 0.80         | MISC    | -                                   |
| E) EXISTING LOAD |                 |                  | MISC         | 0.80         | 20       | 3     | 23               | C     | 24       | 3      | 100     | 0.80         | MISC    | - DANIEL M                          |
|                  |                 |                  | MISC         | 0.80         | -        | -     | 25<br>27         | В     | 26       | ى<br>- | 100     | 10.08        | COMB    | PANEL M                             |
| PANEL L          |                 |                  | MISC<br>COMB | 0.80<br>8.48 | 100      | 3     | 29               | С     | 28<br>30 | -      | -       | 8.84<br>8.93 | COMB    | -                                   |
| ANLLL            |                 |                  | COMB         | 2.72         | -        | -     | 31               | A     | 32       |        | _       | 0.93         | COMB    | (E) SPACE                           |
|                  |                 |                  | COMB         | 4.64         |          |       | 33               | В     | 34       |        |         |              |         | (E) SPACE                           |
| E) SPACE         |                 |                  | CONID        | 7.07         |          |       | 35               | C     | 36       |        |         |              |         | (E) SPACE                           |
| E) SPACE         |                 |                  |              |              |          |       | 37               | A     | 38       |        |         |              |         | (E) SPACE                           |
| E) SPACE         |                 |                  |              |              |          |       | 39               | В     | 40       |        |         |              |         | (E) SPACE                           |
| E) SPACE         |                 |                  |              |              |          |       | 41               | С     | 42       |        |         |              |         | (E) SPACE                           |
|                  |                 |                  |              |              |          |       |                  |       |          |        |         |              |         |                                     |
| STIMATED MAXIMUM | DEMAND (EMD)    | CALCULATIONS     |              |              |          |       |                  |       |          |        |         |              |         |                                     |
| OAD SUMMARY:     | LOAD TYPE       | CONNECTED        | NEC DE       | MAND         |          |       |                  |       |          |        |         |              |         |                                     |
| IGHTING          | LTG             | 0.0 KVA          | 0.0          | KVA (12      | 5%)      |       |                  |       |          |        |         |              | CONNE   | CTED PHASE LOADING                  |
| RESIDENT LTG/REC | RES             | 0.0 KVA          | 0.0          | KVA ( 10     | 00/35/25 | %)    |                  |       |          |        |         |              | PHASE A | A: 18.25 KVA                        |
| SMALL APPLIANCE  | RES             | 0.0 KVA          | 0.0          | KVA ( 10     | 00/35/25 | %)    |                  |       |          |        |         |              | PHASE   | B: 20.85 KVA                        |
| ARGEST MOTOR     | MTR             | KVA              | 0.0          | KVA (12      | 5%)      |       |                  |       |          |        |         |              | PHASE   | C: 24.77 KVA                        |
| REMAINING MOTORS | MTR             | 0.0 KVA          |              | KVA (10      |          |       |                  |       |          |        |         |              |         |                                     |
| SEN PURPOSE REC  | REC             | 1.1 KVA          |              | KVA ( 50     | ,        | (\/A) |                  |       |          |        |         |              |         |                                     |
| COMPUTER REC     | MISC            | 0.0 KVA          |              | ,            |          | wry   |                  |       |          |        |         |              |         |                                     |
|                  |                 |                  |              | KVA (10      |          |       |                  |       | NOTES    |        |         |              |         |                                     |
| QUIP/OTHER       | MISC            | 62.7 KVA         |              | KVA (10      |          |       |                  |       | NOTES    |        |         |              |         |                                     |
| IEATING          | MISC            | 0.0 KVA          |              | KVA (10      | ,        |       |                  |       |          |        |         |              |         | H (E) INDICATES EXISTING TO REMIAN. |
| ELEVATOR         | ELEV            | 0.0 KVA          | 0.0          | KVA (10      | 0%)      |       |                  |       | 2. BOL   | D LINE | EWEIGHT | PREFA        | CED WIT | TH (N) INDICATES NEW                |
| (ITCHEN EQPT     | KITCH           | 0.0 KVA          | 0.0          | KVA (.65     | 5)       |       |                  |       |          |        |         |              |         |                                     |
| TOTALS:          |                 | 63.9 KVA         | 63.9         | KVA          |          |       |                  |       |          |        |         |              |         |                                     |

|                                   |                 |              |          |             | F       | PAN    | IEL S | СН            | EDU      | ILE   |        |          |                  |                     |                    |       |     |
|-----------------------------------|-----------------|--------------|----------|-------------|---------|--------|-------|---------------|----------|-------|--------|----------|------------------|---------------------|--------------------|-------|-----|
| PANEL: ART                        | LOCATION        | CAL ROOM     | И        |             |         | VOL    | TAGE: | AGE: 208 Y/ 1 |          |       | P: 3   |          | W: 4 AIC RATING: |                     |                    |       |     |
| AMP: 225 MLC                      | X MCB           |              |          |             |         |        |       |               |          |       |        |          |                  | MOUNTING:           | X SURFACE          |       | FLU |
| TYPE: EXISTING                    | X NEW           | STYLE:       |          |             |         |        | NEU   | TRAL:         | 100%     |       |        |          |                  | FED FROM:           | PANEL P            |       | 7   |
|                                   |                 |              | LC       | LOAD        |         | Р      | CIR   | Р             | CIR      | Р     | CKT    | L        | DAD              |                     |                    |       |     |
| CIRCI                             | JIT DESCRIPTION | N            | TYPE KVA |             | BKR     |        | #     | Н             | #        |       | BKR    | KVA TYPE |                  | CIRCUIT DESCRIPTION |                    |       |     |
| (E) SPACE                         | RE<br>SPACE     |              |          |             |         |        | 1     | A             | 2        |       | +      | 2        |                  | (E) SPACE           |                    |       |     |
| SPARE                             |                 |              |          |             | 50      | 1      | 3     | В             | 4        | 1     | 50     |          |                  | (E) SPARE           |                    |       |     |
|                                   |                 |              |          |             | -       | -      | 5     | С             | 6        | -     | -      |          |                  |                     |                    |       |     |
| (E) SPACE                         |                 |              |          |             |         |        | 7     | Α             | 8        |       |        |          |                  | (E) SPACE           |                    |       |     |
| (E) EXISTING LOAD                 |                 |              |          |             | 20      | 1      | 9     | В             | 10       | 1     | 20     |          |                  | (E) EXISTING        |                    |       |     |
| (E) EXISTING LOAD                 |                 |              |          |             | 20      | 1      | 11    | С             | 12       | 1     | 20     |          |                  | (E) EXISTING        | LOAD               |       |     |
| (E) EXISTING LOAD                 |                 |              |          |             | 20      | 1      | 13    | A             | 14       |       |        |          |                  | (E) SPACE           |                    |       |     |
| (E) SPACE                         |                 |              |          |             | 20      |        | 15    | В             | 16       | 1     | 20     |          |                  | (E) EXISTING        | LOAD               |       |     |
| (E) EXISTING LOAD                 | 10.445 — —      |              | -050-    | 0-20        | 20      | 1      | 17    | C             | 18       |       |        |          |                  | (E) SPACE           |                    |       |     |
| (N) RECEPTABLES RM<br>(N) SIGNAGE |                 | $\sim$       | MISC     | 0.50        | 20      |        | 21    | В             | 20<br>22 |       |        |          |                  | (E) SPACE           |                    |       |     |
| (E) OF AGE                        |                 |              | IVIISC   | <b>U.30</b> | ڑ       |        |       | C             | 24       |       |        |          |                  | (E) SPACE           |                    |       |     |
| (E) SPACE                         |                 |              |          |             |         |        | 25    | A             | 26       |       |        |          |                  | (E) SPACE           |                    |       |     |
| (E) SPACE                         |                 |              |          |             |         |        | 27    | В             | 28       |       |        |          |                  | (E) SPACE           |                    |       |     |
| (E) SPACE                         |                 |              |          |             |         |        | 29    | С             | 30       |       |        |          |                  | (E) SPACE           |                    |       |     |
| (E) SPACE                         |                 |              |          |             |         |        | 31    | Α             | 32       |       |        |          |                  | (E) SPACE           |                    |       |     |
| (E) SPACE                         |                 |              |          |             |         |        | 33    | В             | 34       |       |        |          |                  | (E) SPACE           |                    |       |     |
| (E) SPACE                         |                 |              |          |             |         |        | 35    | С             | 36       |       |        |          |                  | (E) SPACE           |                    |       |     |
| (E) SPACE                         |                 |              |          |             |         |        | 37    | Α             | 38       |       |        |          |                  | (E) SPACE           |                    |       |     |
| (E) SPACE                         |                 |              |          |             |         |        | 39    | В             | 40       |       |        |          |                  | (E) SPACE           |                    |       |     |
| (E) SPACE                         |                 |              |          |             |         |        | 41    | С             | 42       |       |        |          |                  | (E) SPACE           |                    |       |     |
| ESTIMATED MAXIMUM                 | DEMAND (EMD)    | CALCULATIONS |          |             |         |        |       |               |          |       |        |          |                  |                     |                    |       |     |
| LOAD SUMMARY:                     | LOAD TYPE       | CONNECTED    | NEC DE   | EMAND       |         |        |       |               |          |       |        |          |                  |                     |                    |       |     |
| LIGHTING                          | LTG             | 0.0 KVA      | 0.0      | KVA (12     | 5%)     |        |       |               |          |       |        |          | CONNE            | CTED PHASE I        | OADING             |       |     |
| RESIDENT LTG/REC                  | RES             | 0.0 KVA      | 0.0      | KVA ( 10    | 0/35/25 | %)     |       |               |          |       |        |          | PHASE            |                     | KVA                |       |     |
| SMALL APPLIANCE                   | RES             | 0.0 KVA      |          | KVA ( 10    |         |        |       |               |          |       |        |          | PHASE I          | B: 0.50             | KVA                |       |     |
| LARGEST MOTOR                     | MTR             | KVA          |          | KVA (12     |         | -,     |       |               |          |       |        |          | PHASE            |                     | KVA                |       |     |
| REMAINING MOTORS                  | MTR             | 0.0 KVA      |          | KVA (10     |         |        |       |               |          |       |        |          |                  | 0.00                |                    |       |     |
| GEN PURPOSE REC                   | REC             | 0.7 KVA      |          | KVA (10     | ,       | (Δ\/Δ) |       |               |          |       |        |          |                  |                     |                    |       |     |
|                                   |                 |              |          |             |         | (VA)   |       |               |          |       |        |          |                  |                     |                    |       |     |
| COMPUTER REC                      | MISC            | 0.0 KVA      |          | KVA (10     |         |        |       |               | NOTES    |       |        |          |                  |                     |                    |       |     |
| EQUIP/OTHER                       | MISC            | 0.5 KVA      |          | KVA (10     | •       |        |       |               | NOTES    |       | E.A.E  |          | oeb              |                     | =0 EVIOTRIO =0 === |       |     |
| HEATING                           | MISC            | 0.0 KVA      |          | KVA (10     |         |        |       |               |          |       |        |          |                  | ` ,                 | ES EXISTING TO REI | WIAN. |     |
| ELEVATOR                          | ELEV            | 0.0 KVA      |          | KVA (10     |         |        |       |               | 2. BOL   | D LIN | EWEIGH | PREFA    | CED WIT          | H (N) INDICAT       | ES NEW             |       |     |
| KITCHEN EQPT                      | KITCH           | 0.0 KVA      | 0.0      | KVA (.65    | 5)      |        |       | _             |          |       |        |          |                  |                     |                    |       |     |
| TOTALS:                           |                 | 1.2 KVA      | 1.2      | KVA         |         |        |       |               |          |       |        |          |                  |                     |                    |       |     |
|                                   |                 | 3.4 AMP      | 3.4      | AMP         |         |        |       |               |          |       |        |          |                  |                     |                    |       |     |

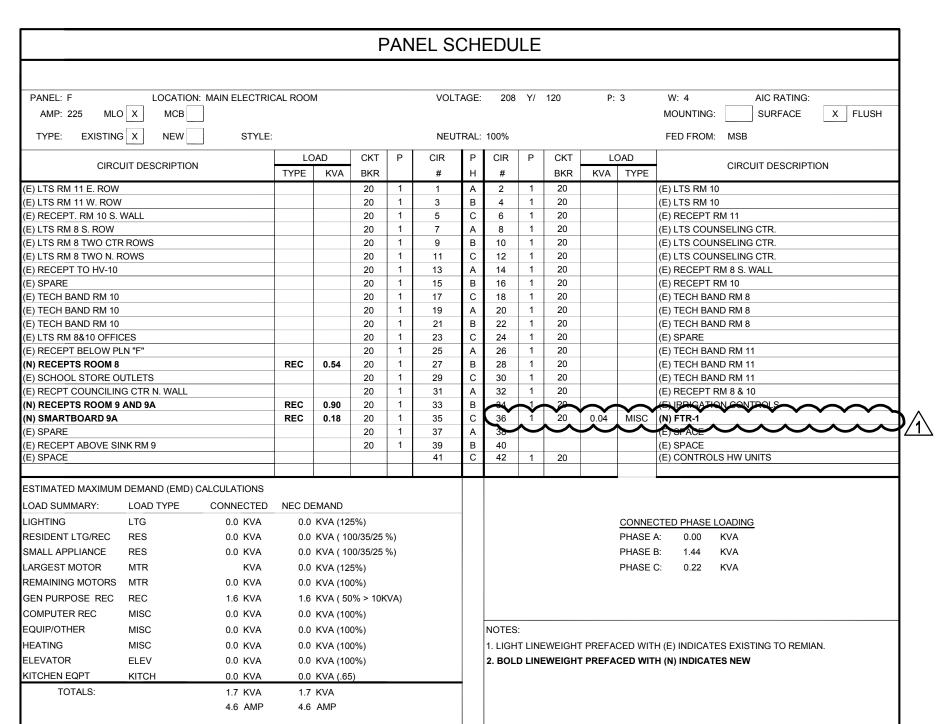

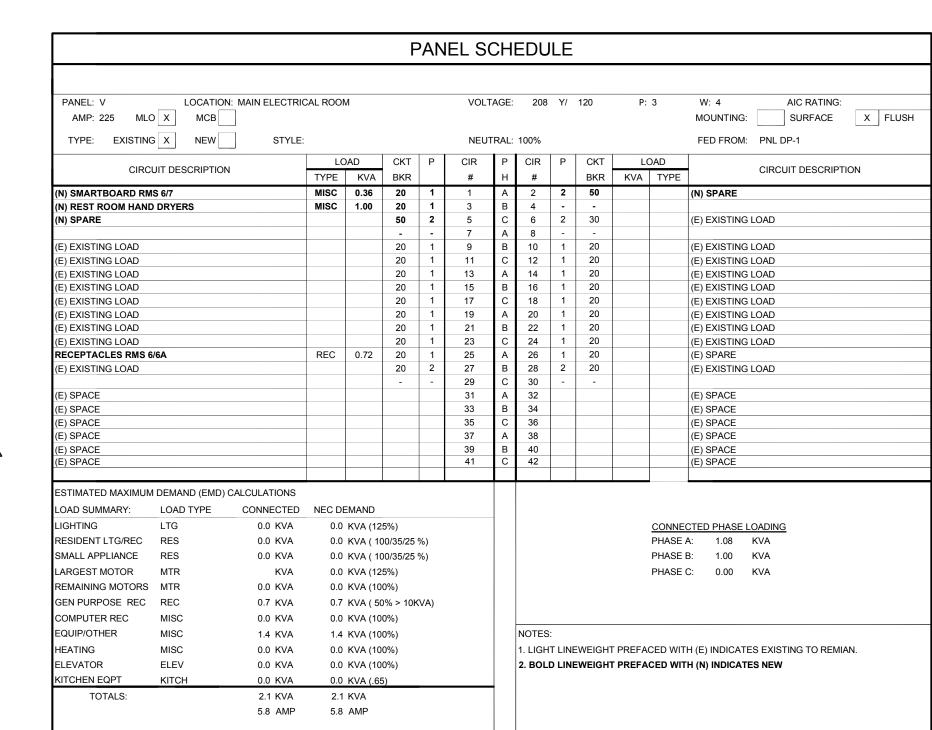



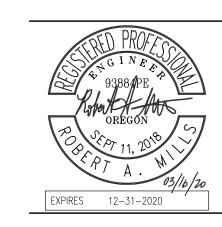





# **PROVEMENTS** MIDDLE

HOWARD A 850 REN

JOB NO: **ISSUE DATE:** 3/3/2020


19189

4

**PANEL SCHEDULES** 

# EUGENE SCHOOL DISTRICT 4J

# NORTH EUGENE HIGH SCHOOL IMPROVEMENTS

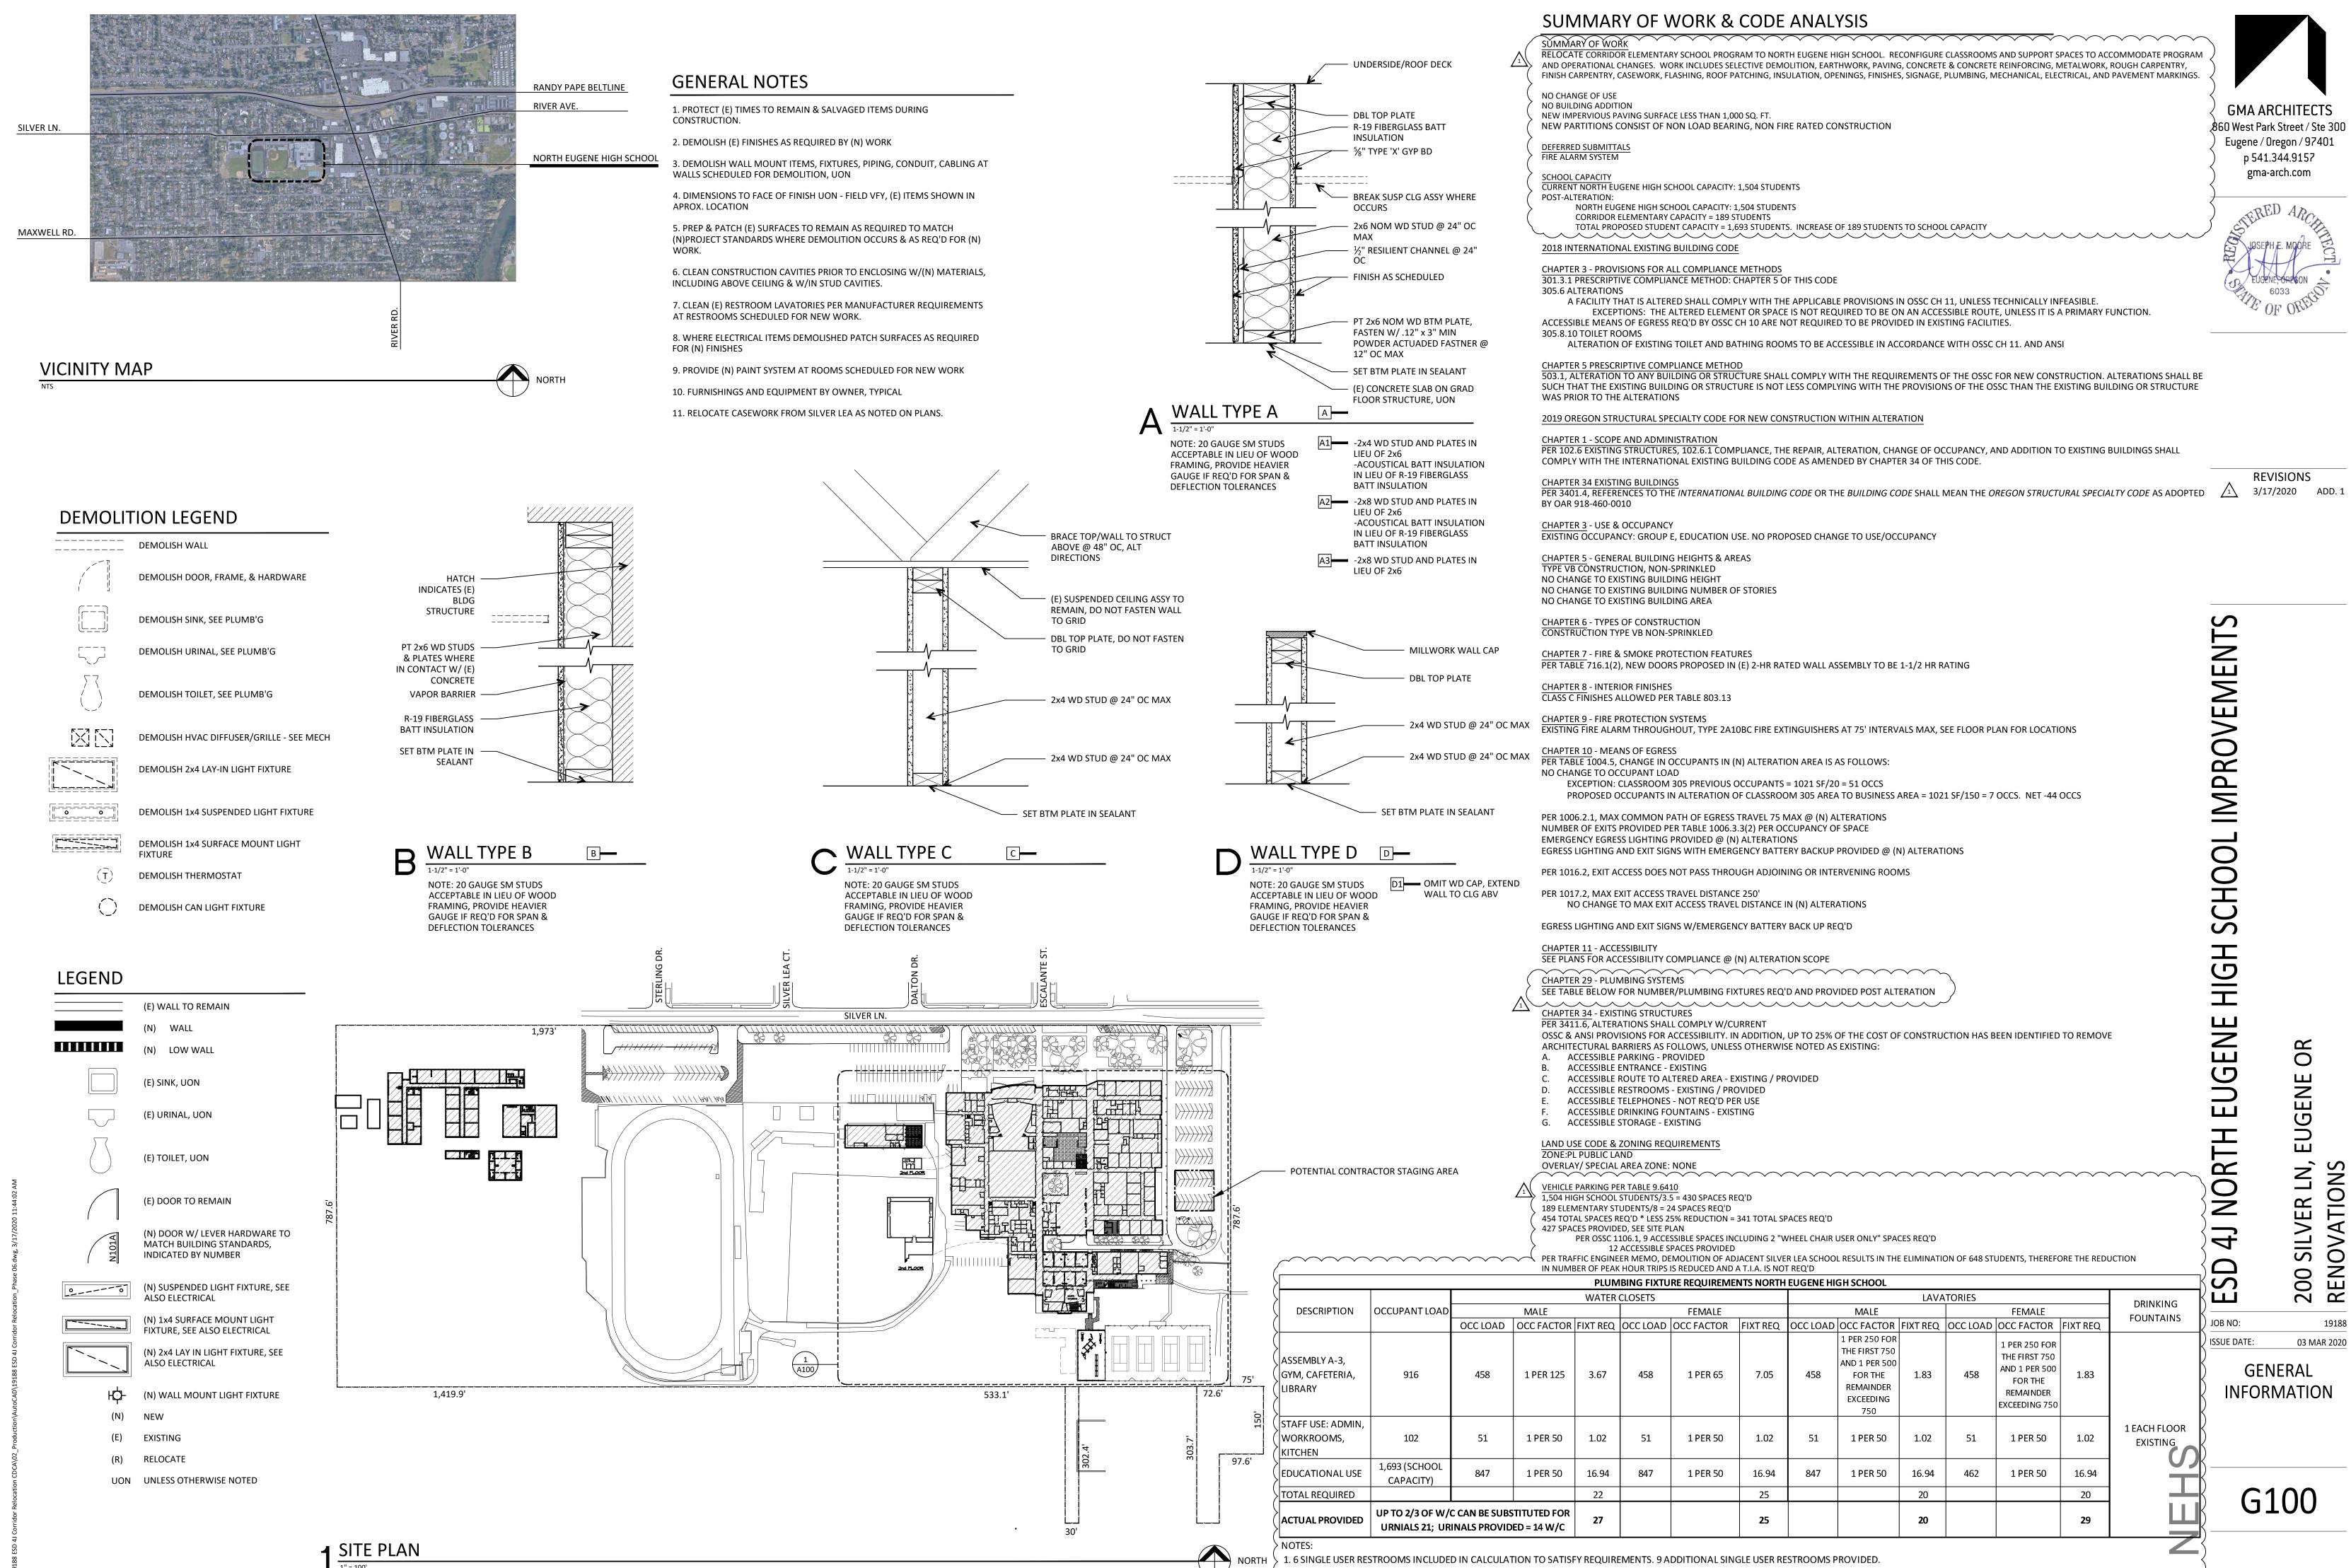

2. NO CHANGE TO AUDITORIUM OR AUDITORIUM CAPACITY. AUDITORIUM RESTROOMS NOT INCLUDED IN THIS CALCULATION

^^^^^

1

- 2. CONSTRUCTION LAYOUT (ALL ACTUAL LINES AND GRADES) SHALL BE STAKED BY A PROFESSIONAL SURVEYOR, REGISTERED IN THE STATE OF OREGON, BASED ON COORDINATES, DIMENSIONS, BEARINGS, AND ELEVATIONS, AS SHOWN, ON THE PLANS.
- 3. PROJECT CONTROL SHALL BE FIELD VERIFIED AND CHECKED FOR RELATIVE VERTICAL POSITION BASED ON THE BENCHMARK STATED HEREON, PRIOR TO BEGINNING CONSTRUCTION LAYOUT.
- 4. WHEN DIMENSIONS AND COORDINATE LOCATIONS ARE REPRESENTED DIMENSIONS SHALL HOLD OVER COORDINATE LOCATION. NOTIFY THE CIVIL ENGINEER OF RECORD IMMEDIATELY UPON DISCOVERY OF ANY DISCREPANCIES.
- 5. BUILDING SETBACK DIMENSIONS FROM PROPERTY LINES SHALL HOLD OVER ALL OTHER CALLOUTS. PROPERTY LINES AND ASSOCIATED BUILDING SETBACKS SHALL BE VERIFIED PRIOR TO CONSTRUCTION LAYOUT.
- 6. CONTRACTOR SHALL PRESERVE AND PROTECT FROM DAMAGE ALL EXISTING MONUMENTATION DURING CONSTRUCTION. THE CONTRACTOR IS RESPONSIBLE FOR COORDINATING AND PAYING FOR THE REPLACEMENT OF ANY MONUMENTS DAMAGED OR REMOVED DURING CONSTRUCTION. NEW MONUMENTS SHALL BE REESTABLISHED BY A LICENSED SURVEYOR.
- 7. SOME SITE DEMOLITION AND UTILITY RELOCATION HAS BEEN PERFORMED. SURVEY MAY NOT BE COMPLETE OR ACCURATE. CONTRACTOR TO VERIFY EXISTING SITE CONDITIONS PRIOR TO CONSTRUCTION. CONTRACTOR SHALL BRING ANY DISCREPANCIES TO THE ATTENTION OF THE ENGINEER PRIOR TO BEGINNING CONSTRUCTION.
- 8. CONTRACTOR TO REFERENCE SOILS REPORT BY FOUNDATION ENGINEERING, INC. DATED DECEMBER 9, 2019 FOR THE SITE SOILS CONDITIONS.
- 9. ALL CONSTRUCTION AND MATERIALS SHALL CONFORM TO THESE PLANS, THE PROJECT SPECIFICATIONS AND THE APPLICABLE REQUIREMENTS OF THE 2018 OREGON STANDARD SPECIFICATIONS FOR CONSTRUCTION, THE 2017 OREGON PLUMBING SPECIALTY CODE AND REQUIREMENTS OF THE CITY OF EUGENE.
- 10. THE COMPLETED INSTALLATION SHALL CONFORM TO ALL APPLICABLE FEDERAL, STATE, AND LOCAL CODES, ORDINANCES AND REGULATIONS. ALL PERMITS, LICENSES AND INSPECTIONS REQUIRED BY THE GOVERNING AUTHORITIES FOR THE EXECUTION AND COMPLETION OF WORK SHALL BE SECURED BY THE CONTRACTOR PRIOR TO COMMENCING CONSTRUCTION.
- 11. ATTENTION: OREGON LAW REQUIRES YOU TO FOLLOW RULES ADOPTED BY THE OREGON UTILITY NOTIFICATION CENTER. THOSE RULES ARE SET FORTH IN OAR 952-001-0010 THROUGH OAR 952-001-0090. YOU MAY OBTAIN COPIES OF THE RULES BY CALLING THE CENTER. (NOTE: THE TELEPHONE NUMBER FOR THE OREGON UTILITY NOTIFICATION CENTER IS (503) 232-1987). EXCAVATORS MUST NOTIFY ALL PERTINENT COMPANIES OR AGENCIES WITH UNDERGROUND UTILITIES IN THE PROJECT AREA AT LEAST 48 BUSINESS-DAY HOURS, BUT NOT MORE THAN 10 BUSINESS DAYS PRIOR TO COMMENCING AN EXCAVATION, SO UTILITIES MAY BE ACCURATELY LOCATED.
- 12. THE LOCATION OF EXISTING UNDERGROUND UTILITIES SHOWN ON THE PLANS ARE FOR INFORMATION ONLY AND ARE NOT GUARANTEED TO BE COMPLETE OR ACCURATE. CONTRACTOR SHALL VERIFY ELEVATIONS, PIPE SIZE, AND MATERIAL TYPES OF ALL UNDERGROUND UTILITIES PRIOR TO COMMENCING WITH CONSTRUCTION AND SHALL BRING ANY DISCREPANCIES TO THE ATTENTION OF KPFF CONSULTING ENGINEERS, 72 HOURS PRIOR TO START OF CONSTRUCTION TO PREVENT GRADE AND ALIGNMENT CONFLICTS.
- 13. THE ENGINEER OR OWNER IS NOT RESPONSIBLE FOR THE SAFETY OF THE CONTRACTOR OR HIS CREW. ALL O.S.H.A. REGULATIONS SHALL BE STRICTLY ADHERED TO IN THE PERFORMANCE OF THE WORK.
- 14. TEMPORARY AND PERMANENT EROSION CONTROL MEASURES SHALL BE IMPLEMENTED. THE CONTRACTOR SHALL ADHERE TO CITY OF EUGENE FOR MINIMUM EROSION CONTROL MEASURES. THE ESC FACILITIES SHOWN IN THESE PLANS ARE THE MINIMUM REQUIREMENTS FOR ANTICIPATED SITE CONDITIONS. DURING THE CONSTRUCTION PERIOD, ESC FACILITIES SHALL BE UPGRADED AS NEEDED FOR UNEXPECTED STORM EVENTS AND TO ENSURE THAT SEDIMENT AND SEDIMENT LADEN WATER DO NOT LEAVE THE SITE.
- 15. THE CONTRACTOR IS RESPONSIBLE FOR MAINTAINING ALL ROADWAYS, KEEPING THEM CLEAN AND FREE OF CONSTRUCTION MATERIALS AND DEBRIS, AND PROVIDING DUST CONTROL AS REQUIRED.
- 16. CONTRACTOR SHALL MAINTAIN ALL UTILITIES TO EXISTING BUILDING AT ALL TIMES DURING CONSTRUCTION.

17. THE CONTRACTOR SHALL BE RESPONSIBLE FOR COORDINATING AND SCHEDULING ALL WORK WITH THE

# CONSTRUCTION NOTES

### GENERAL

- 1. SUBGRADE AND TRENCH BACKFILL SHALL BE COMPACTED TO AT LEAST 95% OF THE MAXIMUM DRY DENSITY AS DETERMINED BY ASTM D-698. FLOODING OR JETTING THE BACKFILLED TRENCHES WITH WATER IS NOT PERMITTED.
- 2. SPECIAL INSPECTION REQUIRED FOR ALL COMPACTION TESTING.

### DEMOLITION

- 1. THE CONTRACTOR SHALL BE RESPONSIBLE FOR DEMOLITION AND DISPOSAL OF EXISTING AC, CURBS, SIDEWALKS AND OTHER SITE ELEMENTS WITHIN THE SITE AREA IDENTIFIED IN THE PLANS.
- 2. EXCEPT FOR MATERIALS INDICATED TO BE STOCKPILED OR TO REMAIN ON OWNER'S PROPERTY, CLEARED MATERIALS SHALL BECOME CONTRACTOR'S PROPERTY, REMOVED FROM THE SITE, AND DISPOSED OF PROPERLY.
- 3. ITEMS INDICATED TO BE SALVAGED SHALL BE CAREFULLY REMOVED AND DELIVERED STORED AT THE PROJECT SITE AS DIRECTED BY THE OWNER.
- 4. ALL LANDSCAPING, PAVEMENT, CURBS AND SIDEWALKS, BEYOND THE IDENTIFIED SITE AREA, DAMAGED DURING THE CONSTRUCTION SHALL BE REPLACED TO THEIR ORIGINAL CONDITION OR BETTER.
- 5. CONCRETE SIDEWALKS SHOWN FOR DEMOLITION SHALL BE REMOVED TO THE NEAREST EXISTING CONSTRUCTION
- )  $m{6}$ . SAWCUT STRAIGHT MATCHLINES TO CREATE A BUTT JOINT BETWEEN THE EXISTING AND NEW PAVEMENT.

### UTILITIE

- 1. ADJUST ALL INCIDENTAL STRUCTURES, MANHOLES, VALVE BOXES, CATCH BASINS, FRAMES AND COVERS, ETC. TO FINISHED GRADE.
- CONTRACTOR SHALL ADJUST ALL EXISTING AND/OR NEW FLEXIBLE UTILITIES (WATER, TV, TELEPHONE, ELEC., ETC.) TO CLEAR ANY EXISTING OR NEW GRAVITY DRAIN UTILITIES (STORM DRAIN, SANITARY SEWER, ETC.) IF CONFLICT OCCURS.
- 3. CONTRACTOR SHALL COORDINATE WITH PRIVATE UTILITY COMPANIES FOR THE INSTALLATION OF OR ADJUSTMENT TO GAS, ELECTRICAL, POWER AND TELEPHONE SERVICE.
- 4. BEFORE BACKFILLING ANY SUBGRADE UTILITY IMPROVEMENTS CONTRACTOR SHALL SURVEY AND RECORD MEASUREMENTS OF EXACT LOCATION AND DEPTH AND SUBMIT TO ENGINEER AND OWNER.
- 5. ALL WORK TO CONFORM TO THE 2017 OREGON PLUMBING SPECIALTY CODE

# **EARTHWORKS**

- 1. CONTRACTOR SHALL PREVENT SEDIMENTS AND SEDIMENT LADEN WATER FROM ENTERING THE STORM DRAINAGE
- TRENCH BEDDING AND BACKFILL SHALL BE AS SHOWN ON THE PIPE BEDDING AND BACKFILL DETAIL, THE PROJECT
   SPECIFICATIONS AND AS REQUIRED IN THE SOILS REPORT. FLOODING OR JETTING THE BACKFILLED TRENCHES
   WITH WATER WILL NOT BE PERMITTED.

# ABBREVIATIONS

| AC                   | ASPHALT CONCRETE           | OVH/OH | OVERHEAD                      |
|----------------------|----------------------------|--------|-------------------------------|
| AD                   | AREA DRAIN                 | P/L    | PROPERTY LINE                 |
| APPROX               | APPROXIMATE                | PC     | POINT OF CURVATURE            |
| В                    | BOLLARD                    | PCC    | POINT OF COMPOUND CURVATUR    |
| BLDG                 | BUILDING                   | PCR    | POINT OF CURB RETURN          |
| BOW                  | BACK OF WALK               | PED    | PEDESTRIAN                    |
| BS                   | BOTTOM OF SWALE            | PIV    | POST INDICATOR VALVE          |
|                      | BOTTOM OF STAIR            | PM     | PARKING METER                 |
| BW                   | BOTTOM OF WALL             | POC    | POINT ON CURVE                |
| CB                   | CATCH BASIN                | PP     | POWER POLE                    |
| CL                   | CENTERLINE                 | PRC    | POINT OF REVERSE CURVATURE    |
| CMP                  | CORRUGATED METAL PIPE      | PT     | POINT OF TANGENT              |
| CMU                  | CONCRETE MASONRY UNIT      | P.U.E  | PUBLIC UTILITY EASEMENT       |
| CO                   | CLEANOUT                   | PVC    | POLYVINYL CHLORIDE            |
|                      | DNCRETE                    | PVMT   | PAVEMENT                      |
| COTG                 | CLEANOUT TO GRADE          | PVT    | PRIVATE                       |
| CP                   | CONTROL POINT              | R      | RIM                           |
| Δ                    | DELTA                      | RD     | ROOF DRAIN                    |
| D/W                  | DRIVEWAY                   | R.O.W  | RIGHT-OF-WAY                  |
| DIA.,Ø               | DIAMETER                   | S      | SLOPE (FT/FT)                 |
| DIA.,©<br>DIP        | DUCTILE IRON PIPE          | SD     | STORM DRAIN                   |
| 511<br>E             | EASTING                    | SDMH   | STORM DRAIN MANHOLE           |
| EXIST./EX            | EXISTING                   | SHT    | SHEET                         |
| FDC                  | FIRE DEPARTMENT CONNECTION | SS     | SANITARY SEWER                |
| FF                   | FINISH FLOOR ELEVATION     | SSMH   | SANITARY SEWER MANHOLE        |
| -G                   | FINISH GRADE               | ST     | STREET                        |
| -G<br><del>-</del> H | FIRE HYDRANT               | STA    | STATION                       |
| -11<br>=L            | FLOWLINE                   | STD    | STANDARD                      |
| -L<br>=ND            | FOUNDATION                 | S/W    | SIDEWALK                      |
| G                    | GUTTER                     | TC     |                               |
| GB                   |                            | TD     | TOP OF CURB<br>TRENCH DRAIN   |
|                      | GRADE BREAK<br>GAS LINE    | TG     | TOP OF GROUND                 |
| GL<br>GV             | GAS LINE<br>GATE VALVE     | TP     | TOP OF GROUND TOP OF PAVEMENT |
|                      |                            | TRANS. |                               |
| H                    | HEIGHT                     |        | TRANSFORMER                   |
| HCP                  | HANDICAP PARKING SPACE     | TS     | TOP OF STAIR                  |
| HP                   | HIGH POINT                 | TW     | TOP OF WALL                   |
| D                    | INSIDE DIAMETER            | TVD    | TOP OF WALK                   |
| E<br>NV              | INVERT ELEVATION           | TYP    | TYPICAL                       |
| NV                   | INVERT                     | UG     | UNDERGROUND                   |
| RR.                  | IRRIGATION                 | UGE    | UNDERGROUND ELECTRIC          |
| _P                   | LIGHT POLE                 | W      | WATER                         |
| ΛΗ                   | MANHOLE                    | W/     | WITH                          |
| MIN                  | MINIMUM                    | WCR    | WHEEL CHAIR RAMP              |
| N D                  | NORTHING                   | WM     | WATER METER                   |
| O.D                  | OUTSIDE DIAMETER           | WV     | WATER VALVE                   |
| OF                   | OUTFALL                    |        |                               |

NOTICE TO EXCAVATORS:
ATTENTION: OREGON LAW REQUIRES YOU TO FOLLOW RULES ADOPTED BY THE OREGON UTILITY NOTIFICATION CENTER. THOSE RULES ARE SET FORTH IN OAR 952-001-0010 THROUGH OAR 952-001-0090. YOU MAY OBTAIN COPIES OF THE RULES BY CALLING THE CENTER.
(NOTE: THE TELEPHONE NUMBER FOR THE OREGON UTILITY NOTIFICATION CENTER IS (503)-232-1987).

POTENTIAL UNDERGROUND FACILITY OWNERS

Dig Safely.

Call the Oregon One-Call Center 1-800-332-2344

# SHEET INDEX

|   | SHEET INDEX    |                             |  |  |  |  |  |
|---|----------------|-----------------------------|--|--|--|--|--|
| _ |                |                             |  |  |  |  |  |
|   | Sheet<br>Title | Sheet Description           |  |  |  |  |  |
|   | C1.0           | CIVIL NOTES & ABBREVIATIONS |  |  |  |  |  |
|   | C1.1           | SITE DEMOLITION PLAN        |  |  |  |  |  |
|   | C2.0           | SITE & GRADING PLAN         |  |  |  |  |  |
|   | C2.1           | SITE & GRADING PLAN DETAIL  |  |  |  |  |  |
|   | C3.0           | CIVIL DETAILS               |  |  |  |  |  |
|   | C3.1           | CIVIL DETAILS               |  |  |  |  |  |

GMA ARCHITECTS

860 West Park Street / Ste 300

Eugene / Oregon / 97401

p 541.344.9157

gma-arch.com



REVISIONS

17 MARCH 2020

www.kpff.com

EUGENE HIGH

IORTH EUGEN MPROVEMEN<sup>7</sup> 30 SILVER LN, EUGEN


ISSUE DATE: 03/13/20

CIVIL NOTES & ABBREVIATIONS

<u>Г</u> С1.

JOB NO:

100% CD

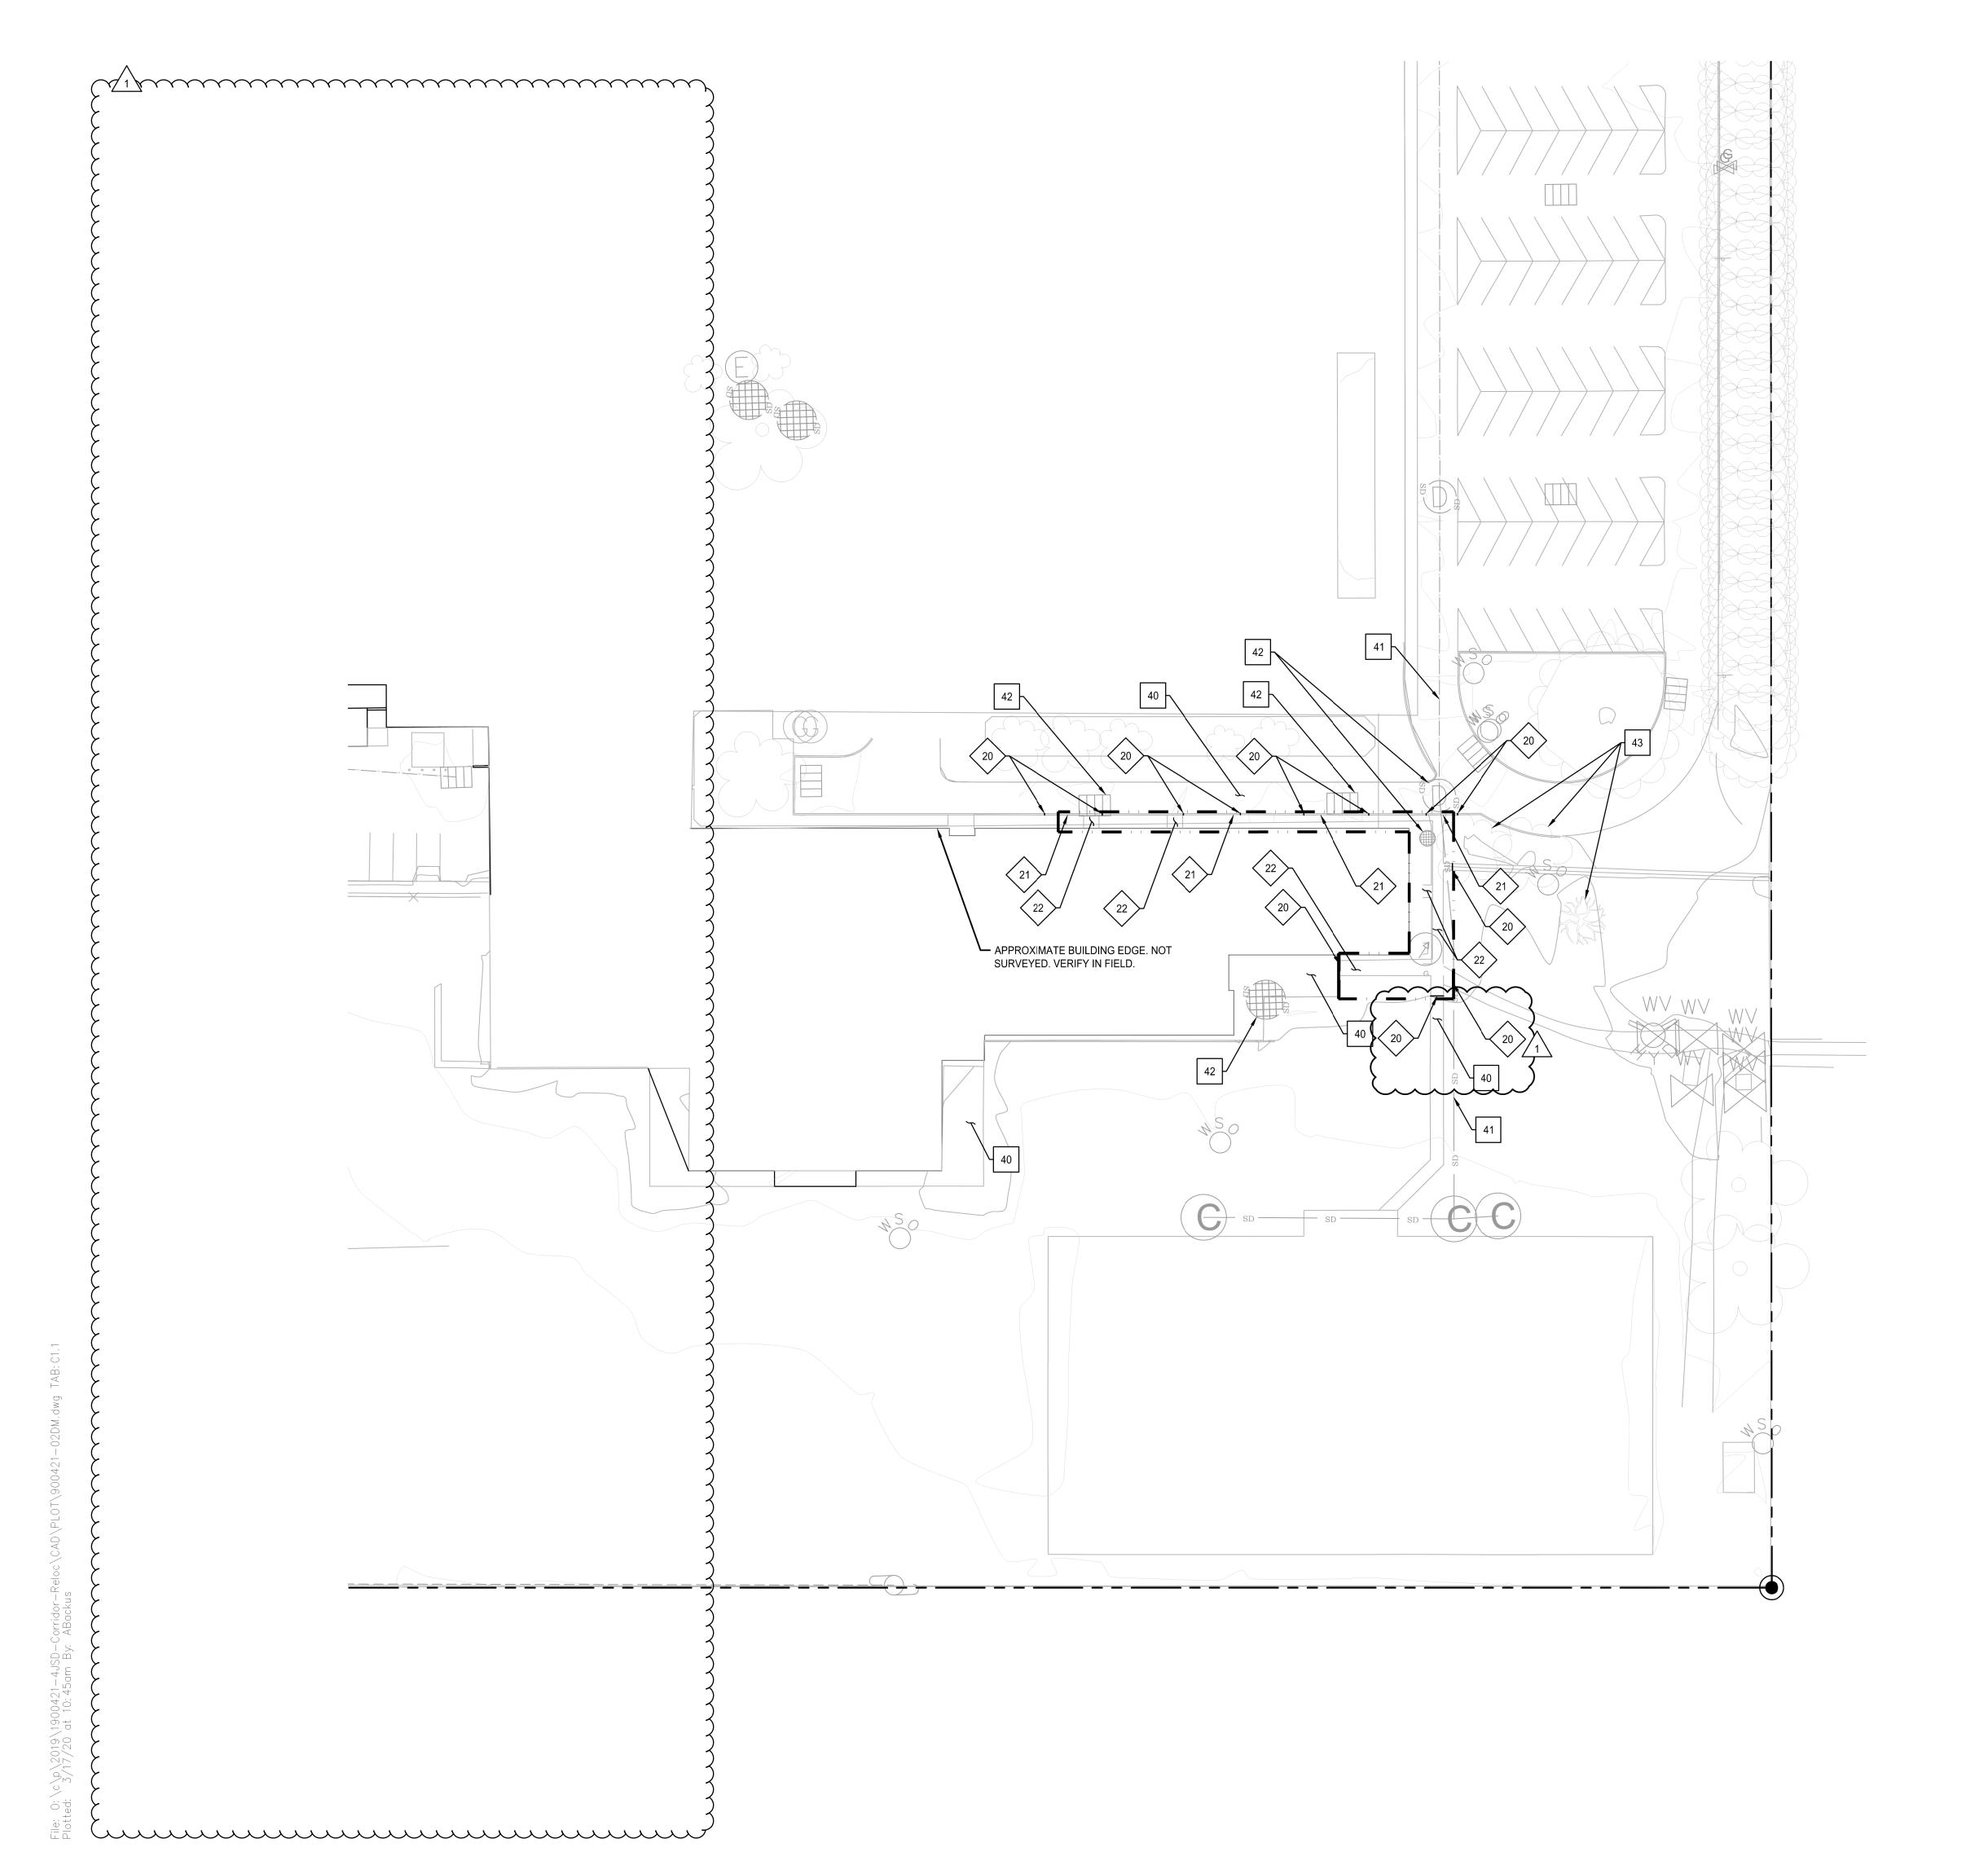

# SHEET NOTES

- 1. CONTRACTOR MAY STAGE WITHIN LIMITS OF DEMOLITION.
- REMOVE ALL SITE COMPONENTS AND RECYCLE COMPONENTS AS REQUIRED IN THE SPECIFICATIONS.
- 3. GENERAL DEMOLITION PERMIT SHALL BE SECURED BY THE CONTRACTOR.
- 4. ALL TRADE LICENSES AND PERMITS NECESSARY FOR THE PROCUREMENT AND COMPLETION OF THE WORK SHALL BE SECURED BY THE CONTRACTOR PRIOR TO COMMENCING DEMOLITION.
- THE CONTRACTOR SHALL PRESERVE AND PROTECT FROM DAMAGE ALL EXISTING RIGHT-OF-WAY SURVEY MONUMENTATION DURING DEMOLITION. THE CONTRACTOR IS RESPONSIBLE FOR COORDINATING AND PAYING FOR THE REPLACEMENT BY A LICENSED SURVEYOR OF ANY DAMAGED OR REMOVED MONUMENTS.
- PROTECT ALL ITEMS ON ADJACENT PROPERTIES AND IN THE RIGHT OF WAY INCLUDING BUT NOT LIMITED TO SIGNAL EQUIPMENT, PARKING METERS, SIDEWALKS, STREET TREES, STREET LIGHTS, CURBS, PAVEMENT AND SIGNS. CONTRACTOR SHALL BE RESPONSIBLE FOR RESTORING ANY DAMAGED ITEMS TO ORIGINAL CONDITION.
- 7. PROTECT STRUCTURES, UTILITIES, SIDEWALKS, AND OTHER FACILITIES IMMEDIATELY ADJACENT TO EXCAVATIONS FROM DAMAGES CAUSED BY SETTLEMENT, LATERAL MOVEMENT, UNDERMINING, WASHOUT AND OTHER HAZARDS.
- 8. SAWCUT STRAIGHT LINES IN SIDEWALK, AS NECESSARY.
- CONTRACTOR IS RESPONSIBLE TO CONTROL DUST AND MUD DURING THE DEMOLITION PERIOD, AND DURING TRANSPORTATION OF DEMOLITION DEBRIS. ALL STREET SURFACES OUTSIDE THE CONSTRUCTION ZONE MUST BE KEPT CLEAN.
- 10. ALL EXPOSED PORTIONS OF UNDERGROUND UTILITIES TO BE ABANDONED SHALL BE PLUGGED WITH A MECHANICAL PLUG AND CAPPED WITH CONCRETE.



# V DEMOLITION KEY NOTES

- 20 SAWCUT LINE. SEE SHEETS C2.0 & C2.1 FOR LOCATION INFORMATION.
- 21 REMOVE CONCRETE CURB.
- 22 REMOVE CONCRETE SIDEWALK.

# PROTECTION KEY NOTES

- 40 PROTECT CURB AND SIDEWALK.
- 41 PROTECT UNDERGROUND UTILITIES.
- 42 PROTECT UTILITY STRUCTURE.
- 43 PROTECT TREE.

# SHEET LEGEND

**—** — PROPERTY LINE

SAWCUT LINE

LIMITS OF DEMOLITION, SHOWN OFFSET

FOR CLARITY. REMOVE ALL PAVEMENT WITHIN DEMOLITION LIMITS. 



**GMA ARCHITECTS** 860 West Park Street / Ste 300 Eugene / Oregon / 97401 p 541.344.9157

gma-arch.com





F: 541.684.4909 www.kpff.com REVISIONS

17 MARCH 2020

HIGH SCHOO

JOB NO: ISSUE DATE:

03/13/20

SITE **DEMOLITION** PLAN



# SHEET NOTES

- 1. ALL DIMENSIONS ARE TO FACE OF CURB OR FACE OF WALL.
- 2. ALL SIDEWALK PAVEMENT JOINTS SHALL BE CONSTRUCTED PER DETAIL 1/C3.0.
- 3. BUILDING OUTLINE AND DOORS NOT SURVEYED. FIELD VERIFY ALL POINTS OF CONNECTION TO BUILDING.

# × KEY NOTES

# <u>DESCRIPTION</u>

DETAIL

REF.

SAWCUT LINE, MATCH EXISTING

STANDARD CURB. SLOPE WITH SIDEWALK ELEVATION. INSTALL LANDING AT DOOR. DO NOT EXCEED 1.8% IN EITHER DIRECTION. DOOR LOCATION NOT SURVEYED.

LOCATE LANDING BASED ON DOORWAY LOCATION PER DIMENSIONS ON PLAN. CONTRACTOR TO VERIFY GRADES AND EXACT LOCATIONS PRIOR TO CONSTRUCTION AND REPORT TO KPFF.

INSTALL SIDEWALK AT 7.8% MAX. LONGITUDINAL SLOPE FROM DOOR ELEVATION TO EXISTING PAVEMENT ELEVATION. CROSS SLOPE TO BE 1.5%. SEE ARCHITECTURAL FOR HANDRAILS. CONTRACTOR TO VERIFY GRADES AND DOOR LOCATIONS PRIOR TO

DEMOLITION AND REPORT TO KPFF. INSTALL LANDING AT END OF SIDEWALK WITH FLUSH CURB. DO NOT EXCEED 1.8% IN EITHER DIRECTION. MATCH EXISTING PAVEMENT ELEVATION.

ADA PARKING STALLS, STRIPING, AND SIGNAGE 1/C3.1 1/C3.1 'NO PARKING" ZONE STRIPING 1/C3.1 4" WIDE WHITE STRIPE. REPAINT EXISTING STRIPING


1/C3.1 WHEEL STOP 1/C3.1 ADA PARKING SIGN

4' WIDE, 4' TALL CHAIN LINK GATE 6/C3.0 4' WIDE, 8' TALL CHAIN LINK GATE. INSTALL IN EXISTING 8' TENNIS COURT FENCE

CONCRETE STAIRS WITH (4) RISERS OF EQUAL HEIGHT "PAUSE PARKING ONLY" SIGNS ON EXISTING STEEL 10 MOW STRIP

# SHEET LEGEND

4' CHAIN LINK FENCE

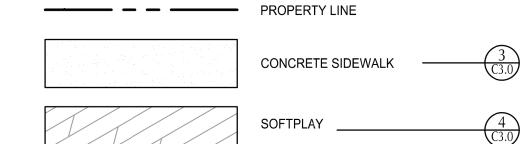

# GRADING CALLOUT LEGEND

CALLOUT DESCRIPTION X.X% GRADING SLOPE AND DIRECTION (DOWNHILL) - SPOT ELEVATION, SHOWN IN () INDICATES EX. ELEV. TO MATCH DESCRIPTION LISTED BELOW. -NO DESCRIPTION MEANS TP OR TG ΓXX.XX XX BOTTOM OF STEP BOTTOM OF WALL EXISTING GRADE GRADE BREAK HIGH POINT LOW POINT RIM OF STRUCTURE TOP OF CURB
TOP OF GROUND
TOP OF PAVEMENT

TOP OF STEP

TOP WALL



**GMA ARCHITECTS** 860 West Park Street / Ste 300 Eugene / Oregon / 97401 p 541.344.9157 gma-arch.com





**REVISIONS** 17 MARCH 2020

HIGH SCHOOL

03/13/20 ISSUE DATE: SITE & GRADING PLAN


19126

JOB NO:



COPYRIGHT GMA ARCHITECTS

100% CD

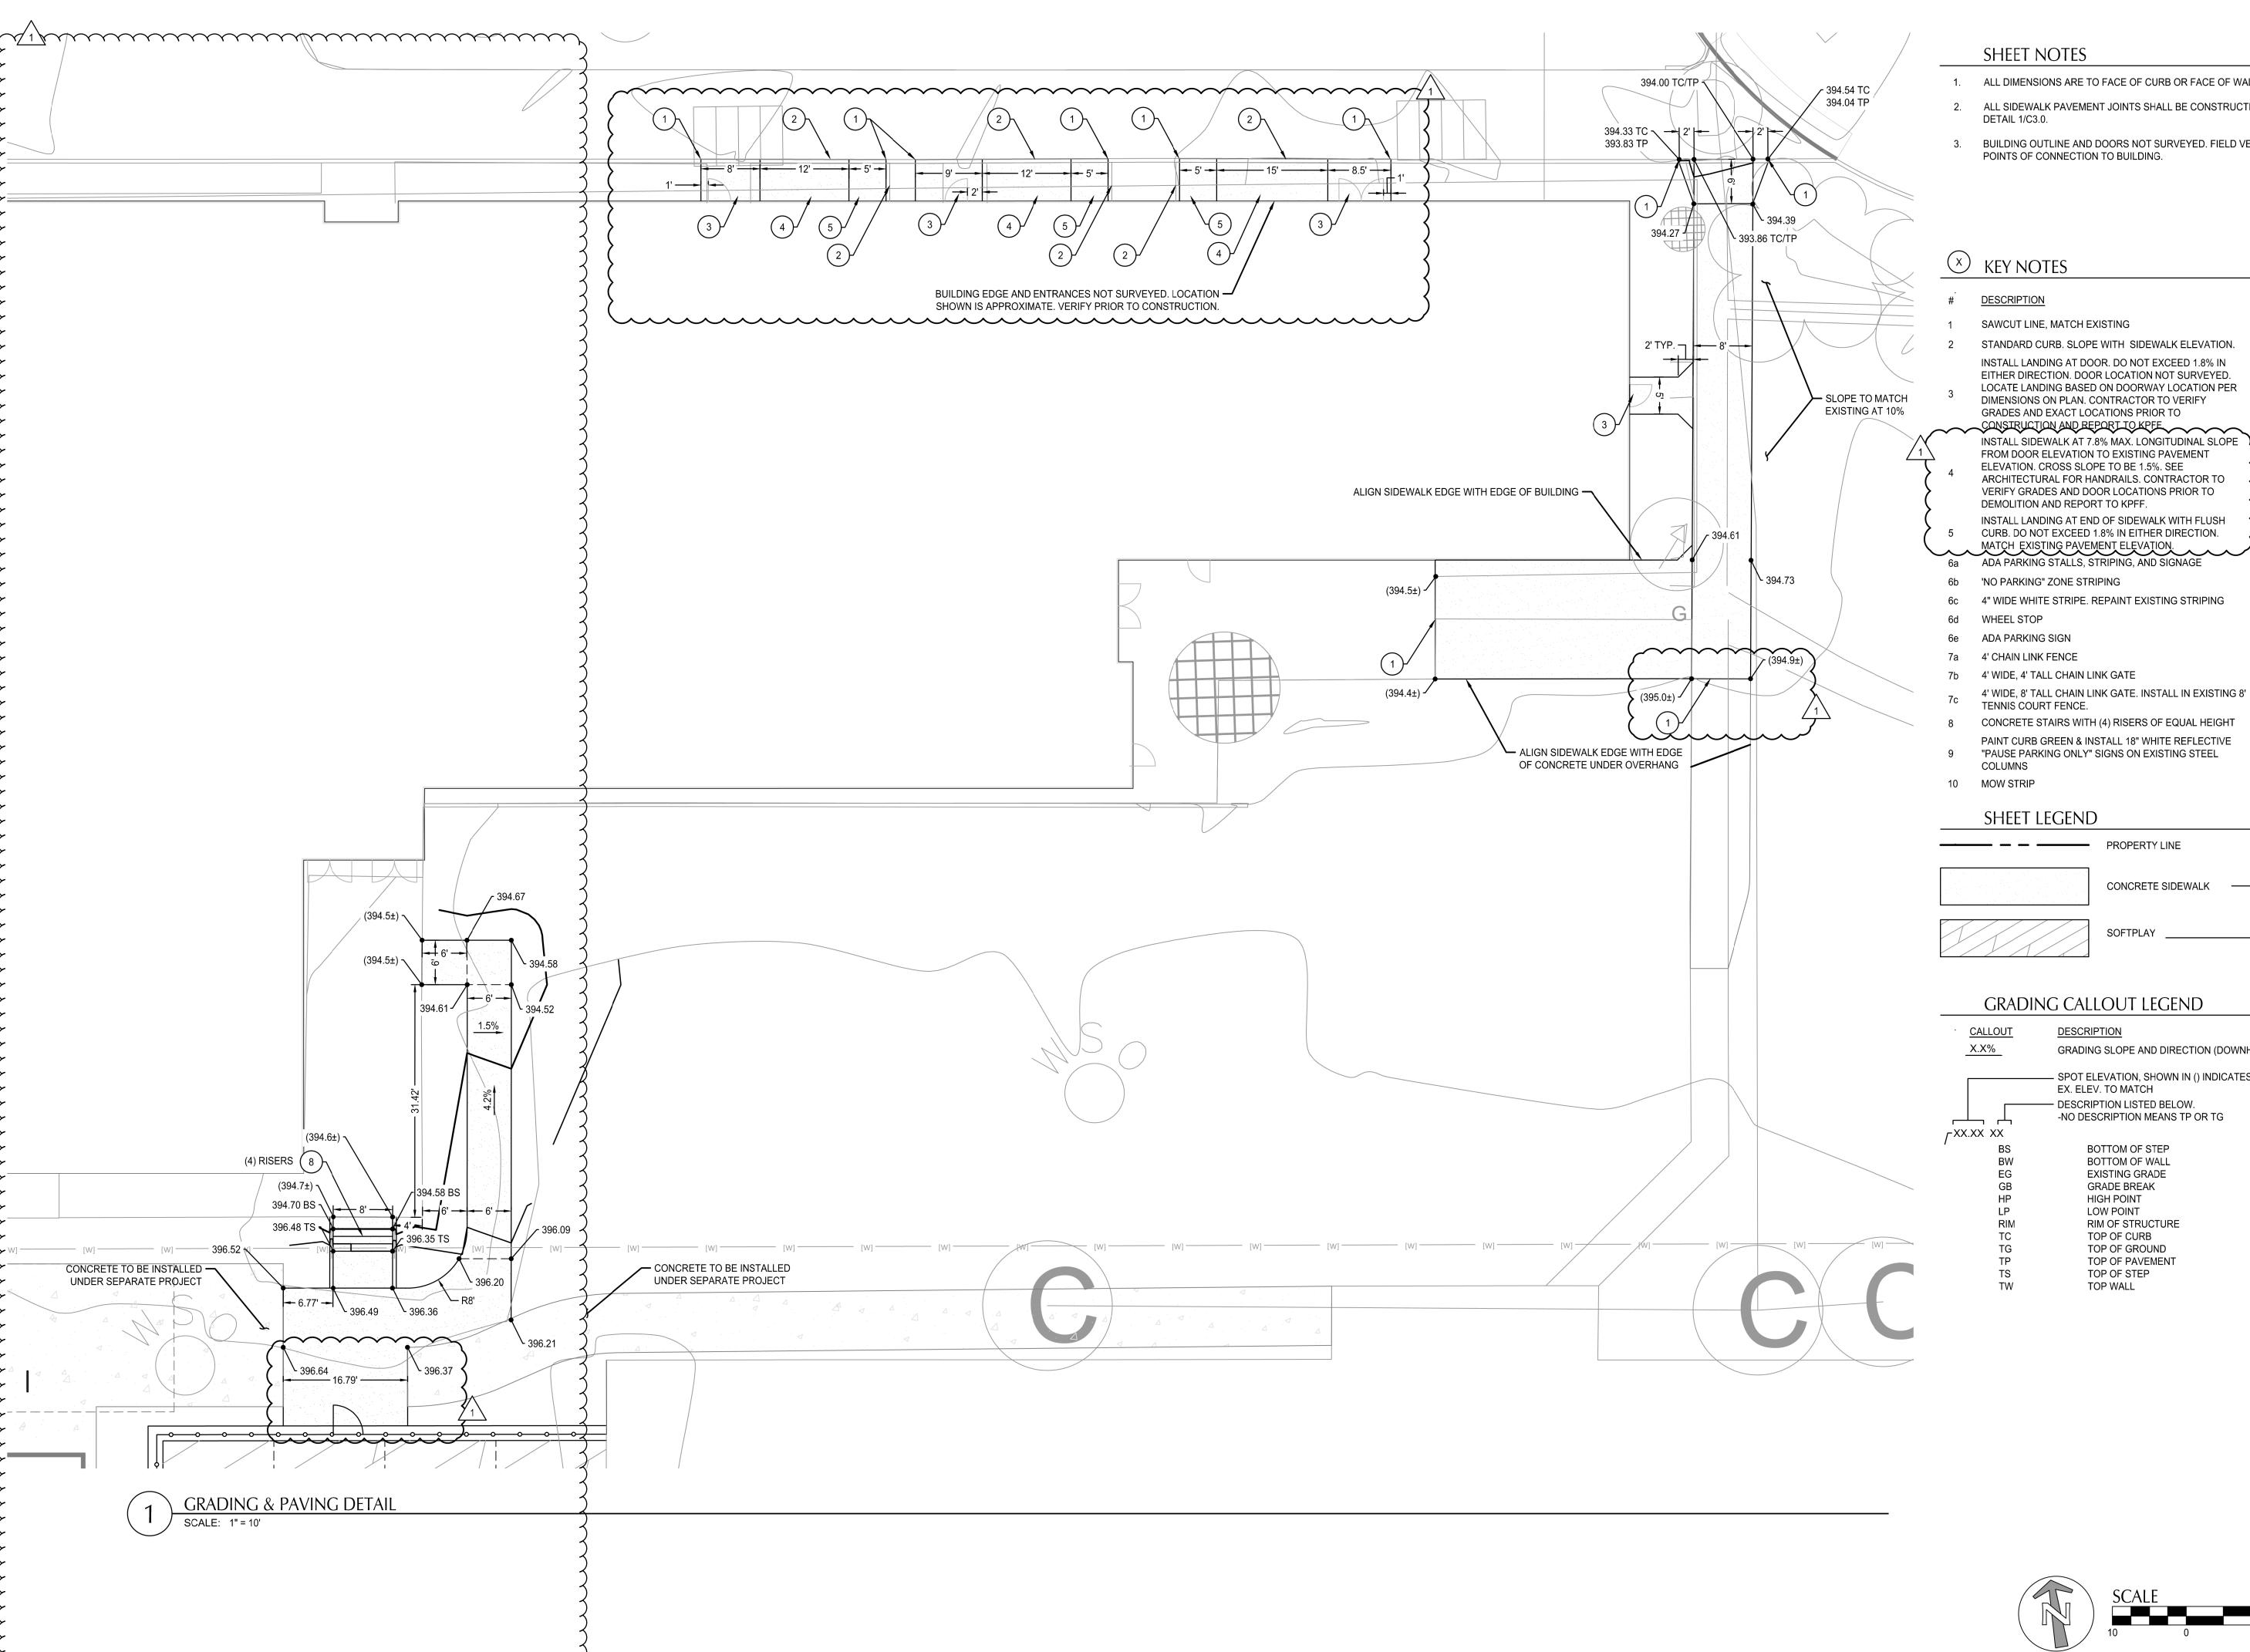

- 1. ALL DIMENSIONS ARE TO FACE OF CURB OR FACE OF WALL.
- 2. ALL SIDEWALK PAVEMENT JOINTS SHALL BE CONSTRUCTED PER
- 3. BUILDING OUTLINE AND DOORS NOT SURVEYED. FIELD VERIFY ALL

| # | DESCRIPTION                                    | DETAI<br><u>REF.</u> |
|---|------------------------------------------------|----------------------|
| 1 | SAWCUT LINE, MATCH EXISTING                    |                      |
| 2 | STANDARD CURB. SLOPE WITH SIDEWALK ELEVATION.  | 2/C3.0               |
|   | INSTALL LANDING AT DOOR. DO NOT EXCEED 1.8% IN |                      |

EITHER DIRECTION. DOOR LOCATION NOT SURVEYED. LOCATE LANDING BASED ON DOORWAY LOCATION PER DIMENSIONS ON PLAN. CONTRACTOR TO VERIFY CONSTRUCTION AND REPORT TO KPFE INSTALL SIDEWALK AT 7.8% MAX. LONGITUDINAL SLOPE

FROM DOOR ELEVATION TO EXISTING PAVEMENT ARCHITECTURAL FOR HANDRAILS. CONTRACTOR TO VERIFY GRADES AND DOOR LOCATIONS PRIOR TO INSTALL LANDING AT END OF SIDEWALK WITH FLUSH

5 CURB. DO NOT EXCEED 1.8% IN EITHER DIRECTION. MATCH EXISTING PAVEMENT ELEVATION.


6a ADA PARKING STALLS, STRIPING, AND SIGNAGE

1/C3.1 1/C3.1 1/C3.1 1/C3.1 6/C3.0 6/C3.0

1/C3.1

7/C3.0

CONCRETE STAIRS WITH (4) RISERS OF EQUAL HEIGHT 5/C3.0 PAINT CURB GREEN & INSTALL 18" WHITE REFLECTIVE

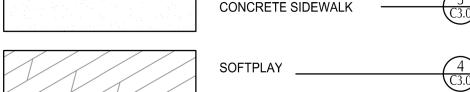

GRADING SLOPE AND DIRECTION (DOWNHILL) - SPOT ELEVATION, SHOWN IN () INDICATES -NO DESCRIPTION MEANS TP OR TG

SCHOOL HIGH

JOB NO:

**GMA ARCHITECTS** 

860 West Park Street / Ste 300

Eugene / Oregon / 97401

p 541.344.9157 gma-arch.com

800 Willamette Street, Suite 400

Eugene, OR 97401 O: 541.684.4902

F: 541.684.4909 www.kpff.com

REVISIONS

17 MARCH 2020


SITE & GRADING PLAN DETAIL


03/13/20




**ISSUE DATE:** 


100% CD

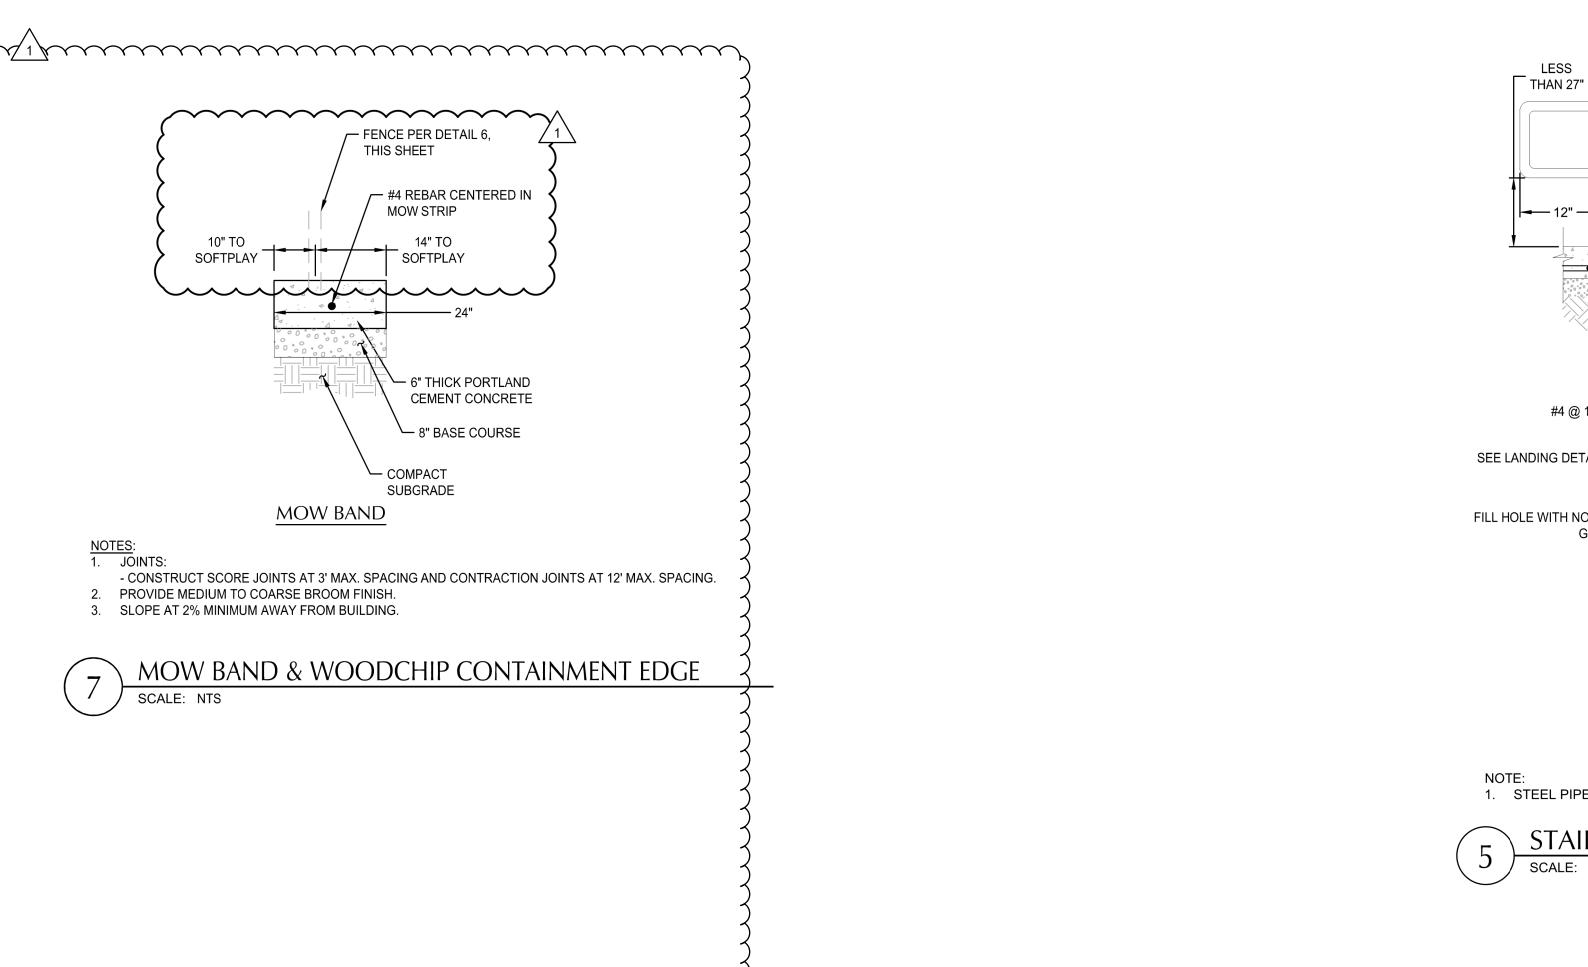


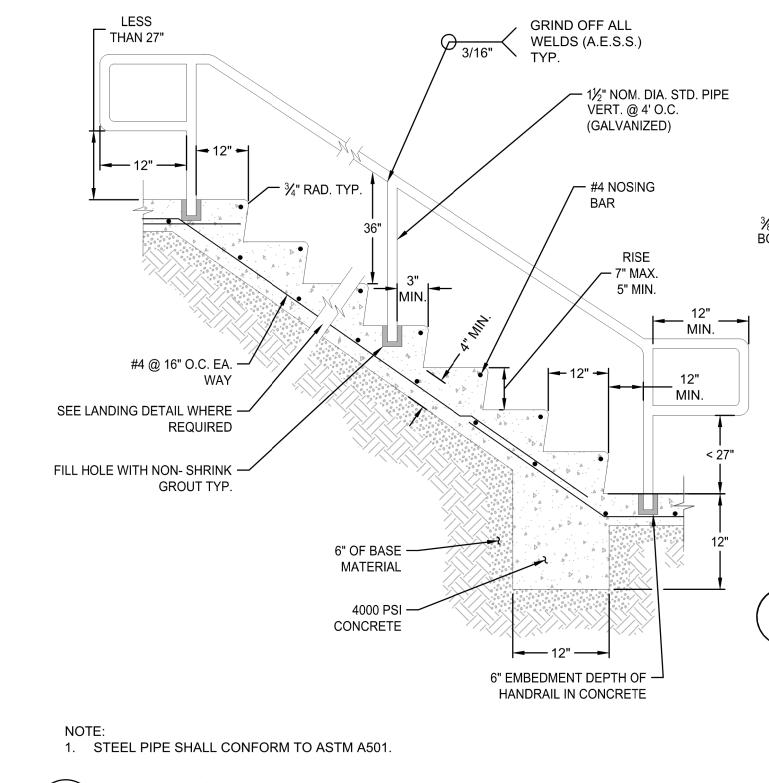


STAIR AND HANDRAIL SCALE: NTS

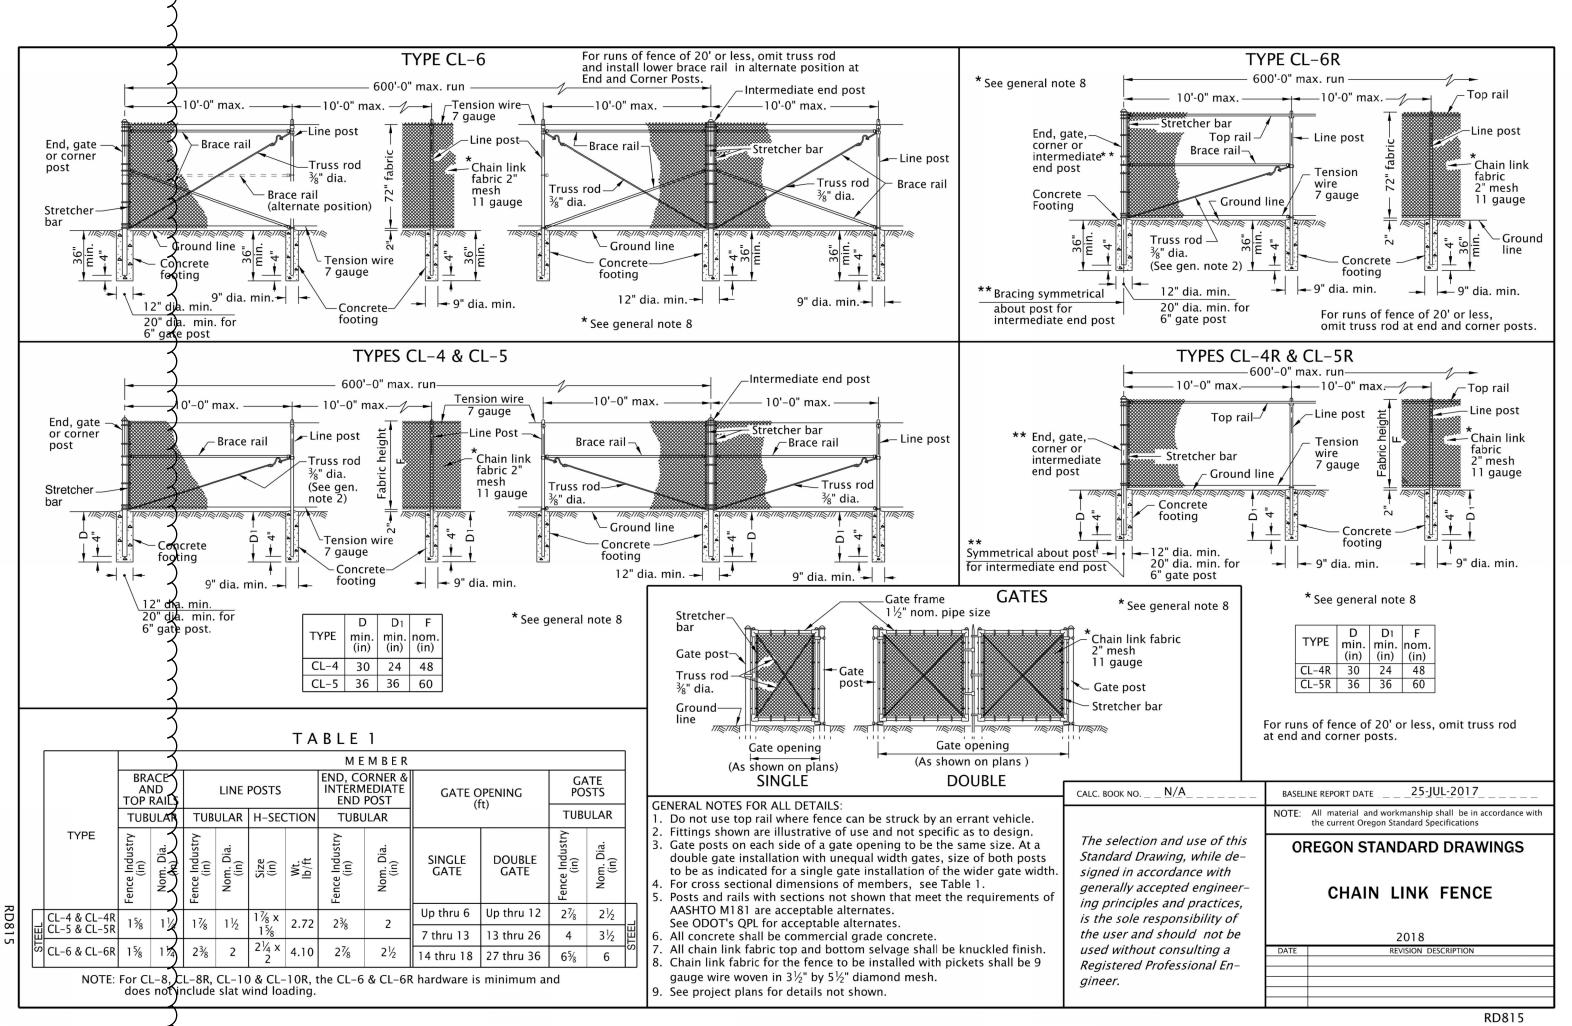

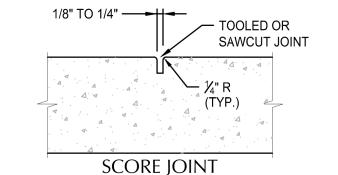

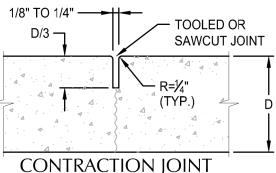

CONTRACTION JOINT

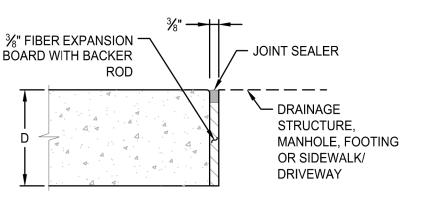

**EXPANSION / ISOLATION JOINT** 

| JOIN | nt inter' | VALS TABLE |
|------|-----------|------------|
| TYPE | SPACING   | OR AT      |

| TYPE                    | SPACING  | OR AT                                                                           |  |
|-------------------------|----------|---------------------------------------------------------------------------------|--|
| SCORE                   | 5' TYP.  | LOCATIONS SHOWN ON PLANS                                                        |  |
| CONTRACTI<br>ON         | 15' MAX. | END OF RAMPS AND DRIVEWAYS                                                      |  |
| EXPANSION/<br>ISOLATION | 200' *   | POINTS OF TANGENCY<br>AND AT ENDS OF EACH<br>DRIVEWAY OR OTHER<br>FIXED OBJECTS |  |


\* MONOLITHIC CURB AND SIDEWALK SHALL BE 45' MAX.

CONTRACTION JOINTS MAY BE USED IN PLACE OF SCORE JOINTS.

- CONSTRUCTION COLD JOINTS MAY BE USED IN PLACE OF CONTRACTION JOINTS.
- PROVIDE MEDIUM BROOM FINISH WITH NO TOOL MARKS.


SIDEWALK JOINTS

SCALE: NTS

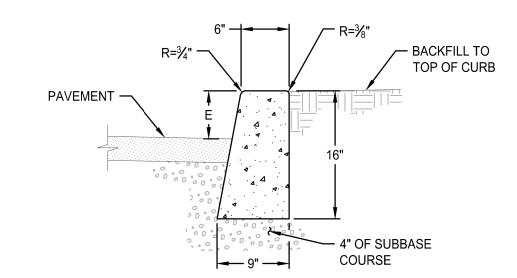

- 1. CURB EXPOSURE 'E' = 6", TYP. VARY AS SHOWN ON PLANS OR AS DIRECTED.
- 2. CONSTRUCT CONTRACTION JOINTS AT 15' MAX. SPACING AND AT RAMPS. CONSTRUCT EXPANSION JOINTS AT 200' MAX SPACING AT POINTS OF TANGENCY AND AT ENDS OF EACH DRIVEWAY.
- 3. TOPS OF ALL CURBS SHALL SLOPE TOWARD THE ROADWAY AT 2% UNLESS OTHERWISE SHOWN OR AS DIRECTED.
- 4. DIMENSIONS ARE NOMINAL AND MAY VARY TO CONFORM WITH CURB MACHINE AS APPROVED BY THE



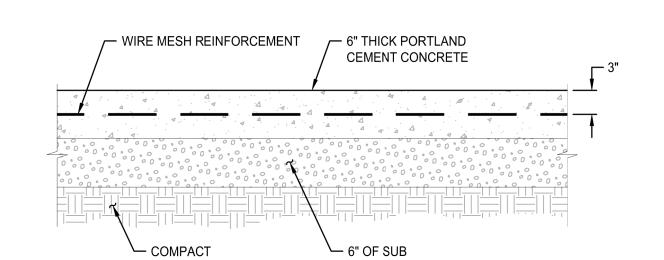

- CONSTRUCT CONTRACTION JOINTS AT 15' MAX. SPACING AND AT RAMPS. - CONSTRUCT EXPANSION JOINTS AT 200' MAX. SPACING AT POINTS OF ENDS OF EACH DRIVEWAY.


BASE COURSE

TANGENCY AND AT

# 2. PROVIDE MEDIUM TO COARSE BROOM FINISH.



SUBGRADE

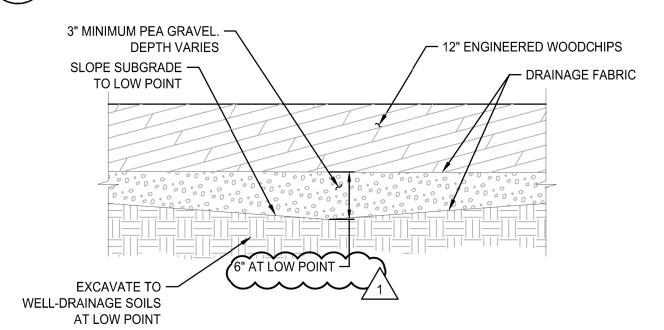

**SOFTPLAY** SCALE: NTS

SCHOO HIGH **Q** 

**GMA ARCHITECTS** 

860 West Park Street / Ste 300

Eugene / Oregon / 97401

p 541.344.9157

gma-arch.com

800 Willamette Street, Suite 400

Eugene, OR 97401 O: 541.684.4902

F: 541.684.4909 www.kpff.com

**REVISIONS** 

17 MARCH 2020


JOB NO: 19126 03/13/20 ISSUE DATE:

CIVIL DETAILS

100% CD

COPYRIGHT GMA ARCHITECTS

**FENCE** SCALE: NTS

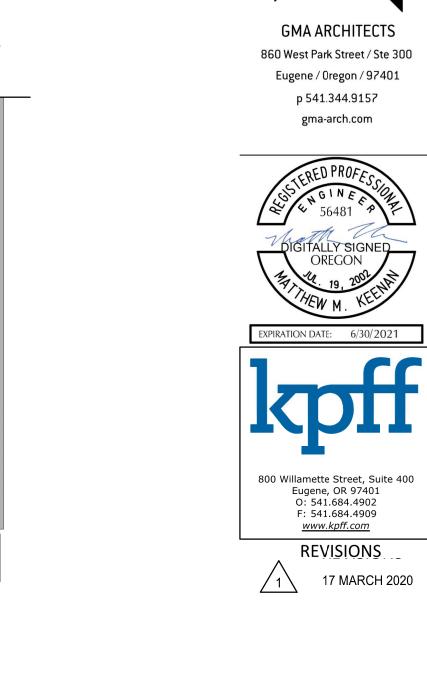

ADA PARKING LAYOUT

**EUGENE HIGH SCHOOL** JOB NO:

03/13/20

CIVIL DETAILS

COPYRIGHT GMA ARCHITECTS

 $\sqrt{1}$ 



0 10 20 40

1 PAINT (E) CURB W/ PAVEMENT MARKING PAINT SYSTEM, SEE CIVIL

2 SOFTBALL FIELD, EQUIPMENT BLDG, AND DASHED PATHWAY BY OTHERS - SHOWN FOR REFERENCE

(R) 'CORRIDOR' BUILDING SIGN, SEE 5:A201 - VFY LOCATION W/ ARCH PRIOR TO WORK

4 POTENTIAL CONTRACTOR STAGING AREA, VFY W/ OWNER

(N) DROP OFF PARKING SIGN @ (E) COLUMN, SEE CIVIL

6 (N) CONCRETE WALKWAY, SEE CIVIL -45° CHAMFER @ INSIDE CORNERS


(N) CONCRETE PATHWAY ACCESS RAMP, MAX SLOPE 1:12, SEE CIVIL

(N) CONCRETE PATHWAY ACCESS RAMP, MAX SLOPE 1:12, SEE C

CMA ARCHITECTS

GMA ARCHITECTS

860 West Park Street / Ste 300
Eugene / Oregon / 97401
p 541.344.9157
gma-arch.com

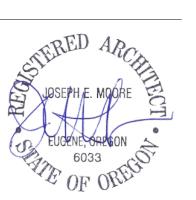

REVISIONS
3/17/2020 ADD. 1

ESD 4J NORTH EUGENE HIGH SCHOOL IMPROVEMENTS


200 SILVER LN, EUGENE OR

 JOB NO:
 19188

 ISSUE DATE:
 03 MAR 2020

SITE PLAN

<u>Х</u> А10

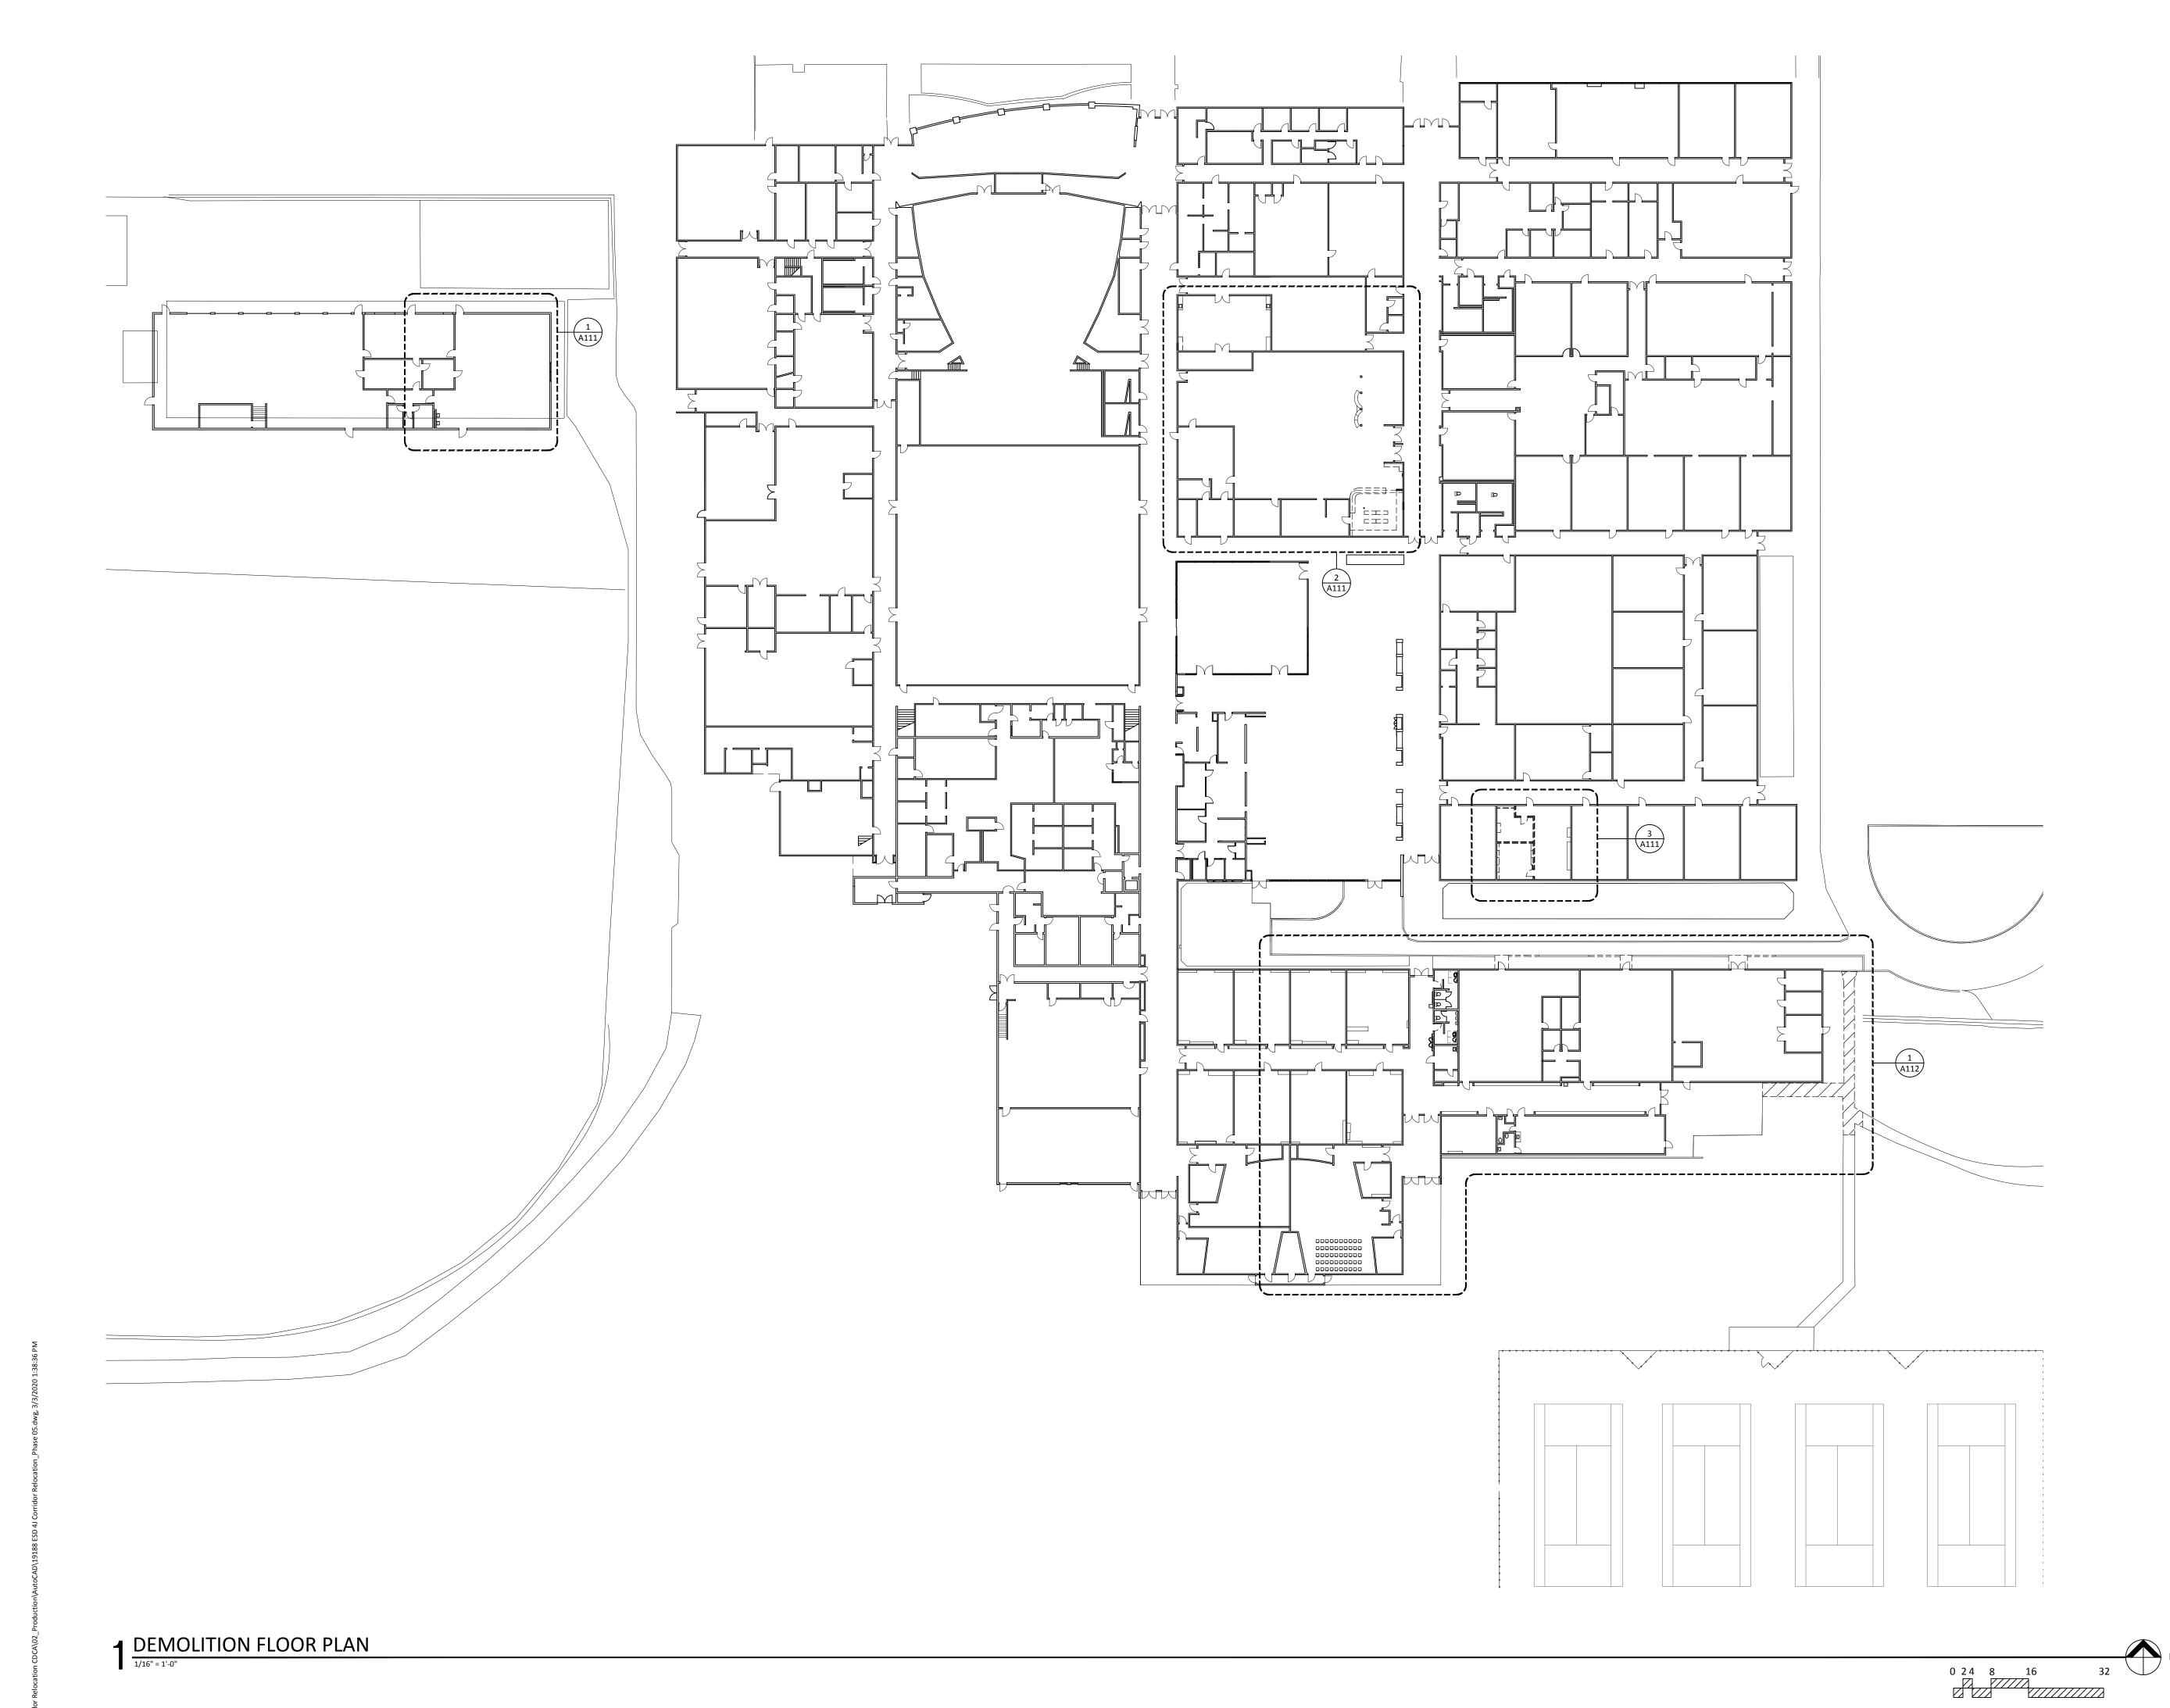





REVISIONS

ESD 4J NORTH EUGENE HIGH SCHOOL IMPROVEMENTS

200 SILVER LN, EUGENE

JOB NO: 19188
ISSUE DATE: 03 MAR 2020

OVERALL DEMOLITION

SHU HHZ


A110



DANCE TEAM

TYP/@ (N) CLASSROOMS, THIS AREA



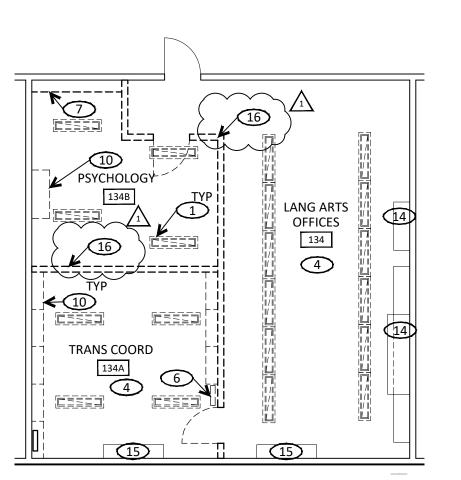


3 ROOM 134 DEMOLITION PLAN

1/8" = 1'-0"

NORTH

SHOP

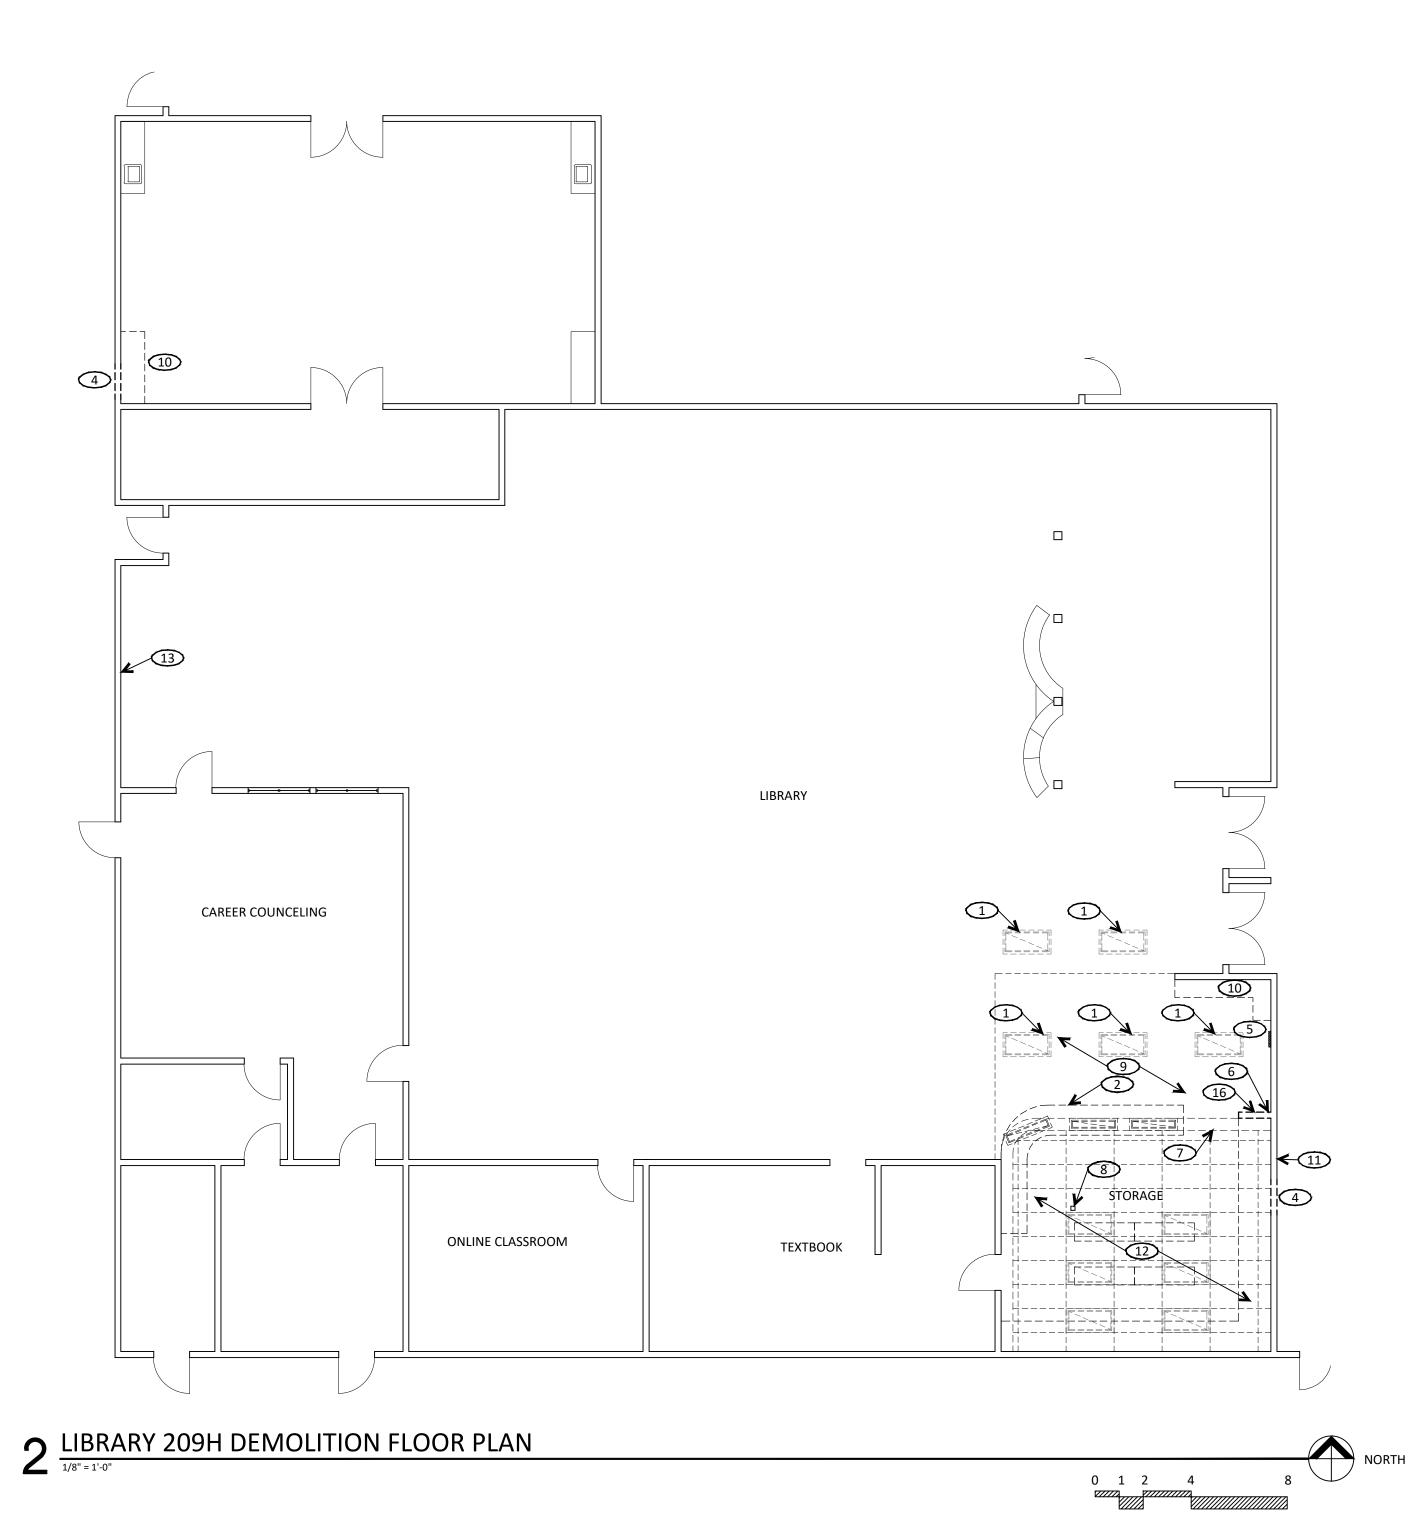

**KEY NOTES** 

1 DEMOLISH LIGHT FIXTURE

2 CIRCULATION DESK CASEWORK, LOW WALL DEMOLITION BY OTHERS

(E) SINK TO REMAIN

DEMOLISH WALL FRAMING AS REQUIRED FOR (N) DOOR
-WALL FINISH DEMOLITION BY OTHERS

5 EXISTING ELECTRICAL PANEL TO REMAIN

6 LIGHTING CONTROLS & WALL FINSIH DEMOLISHED BY OTHERS

(7) GB SOFFIT DEMOLISHED BY OTHERS

8 (E) STEEL PIPE COLUMN

9 DEMOLISH CEILING GRID

10 DEMOLISH CASEWORK

11) DEMOLISH BOOK RETURN

12 CEILING, FLOOR, CASEWORK, LIGHTING DEMOLITION BY OTHERS

(E) PROJECTOR SCREEN

(E) CASEWORK TO REMAIN

(E) FLOOR MOUNT HVAC TO REMAIN

16 WALL DEMOLITION BY OTHERS
-COORD W/ OWNER

GMA ARCHITECTS
860 West Park Street / Ste 300
Eugene / Oregon / 97401
p 541.344.9157
gma-arch.com



REVISIONS
3/17/2020 ADD. 1

ESD 4J NORTH EUGENE HIGH SCHOOL IMPROVEMENTS

200 SILVER LN, EUGENE ( RENOVATIONS

19188


ISSUE DATE: 03 MAR 20

PARTIAL

DEMOLITION

SE A111


JOB NO:

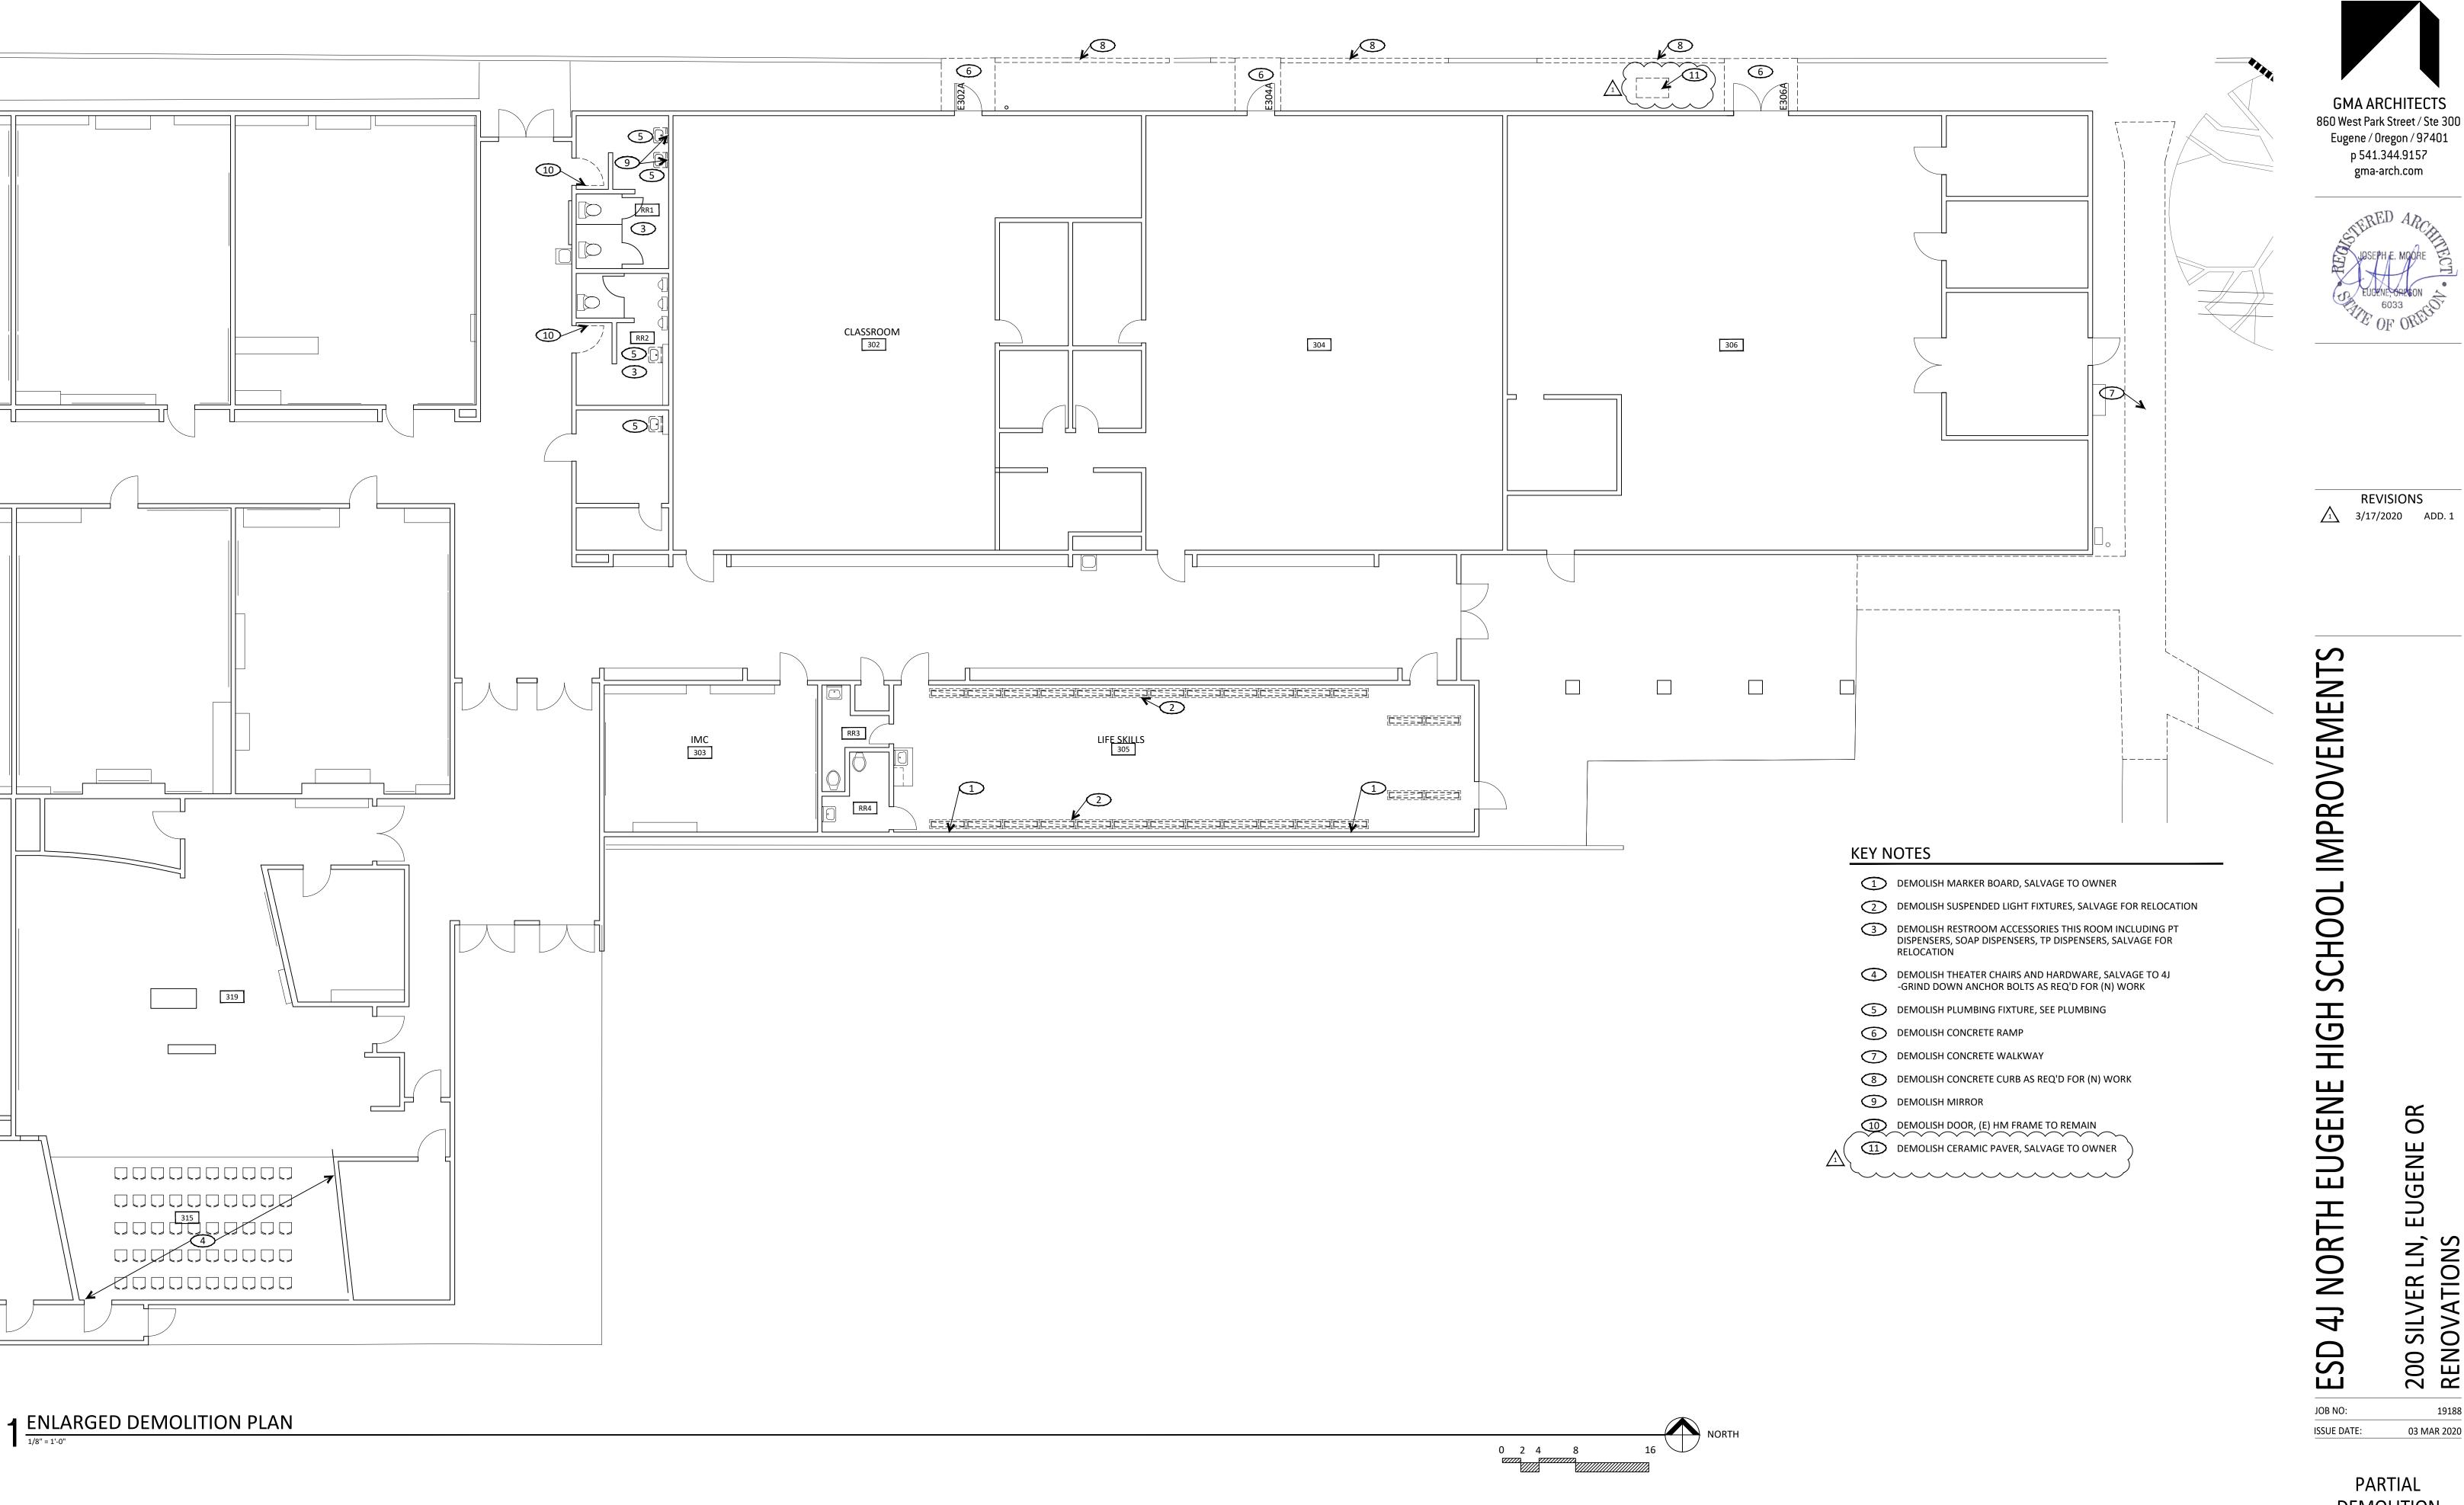



19188 03 MAR 2020

DEMOLITION

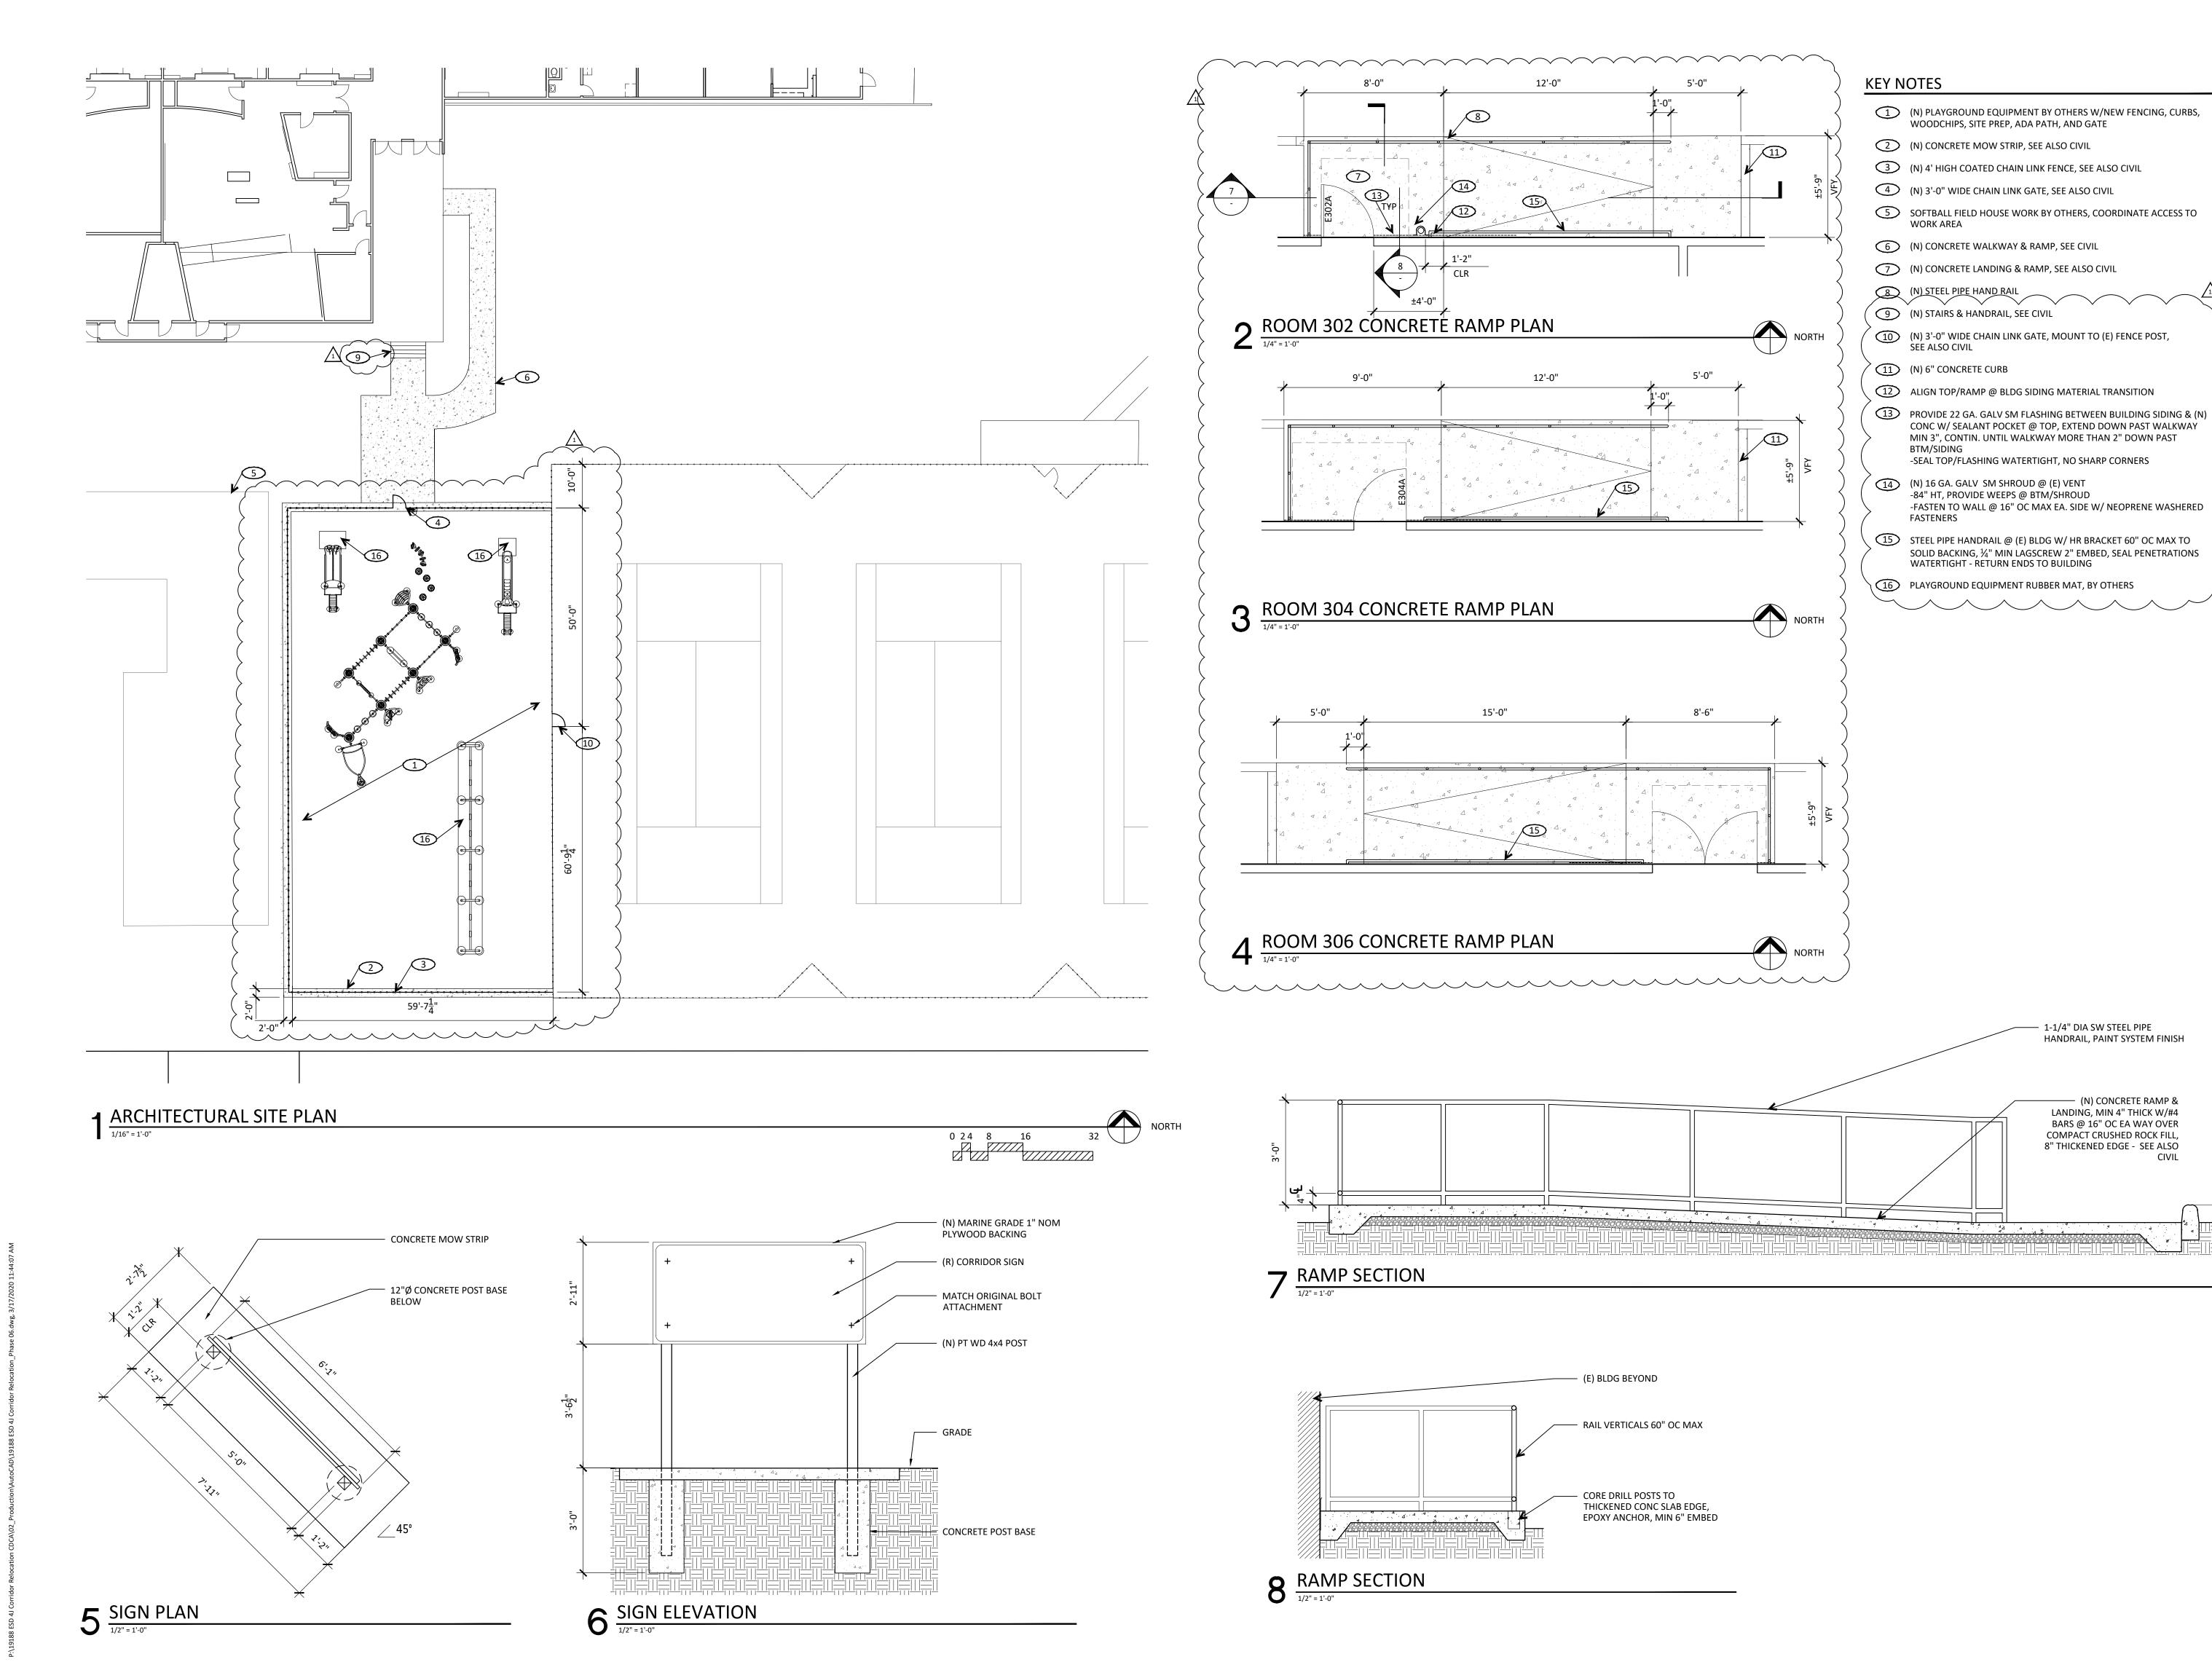

abs.

GMA ARCHITECTS

860 West Park Street / Ste 300
Eugene / Oregon / 97401
p 541.344.9157

gma-arch.com



REVISIONS

3/17/2020 ADD. 1

ESD 4J NORTH EUGENE HIGH SCHOOL IMPROVEMENTS

NO: 19188 E DATE: 03 MAR 2020

ENLARGED SITE PLAN

A202




COPYRIGHT GMA ARCHITECTS 2019

19188

03 MAR 2020

p 541.344.9157 gma-arch.com

**REVISIONS** 

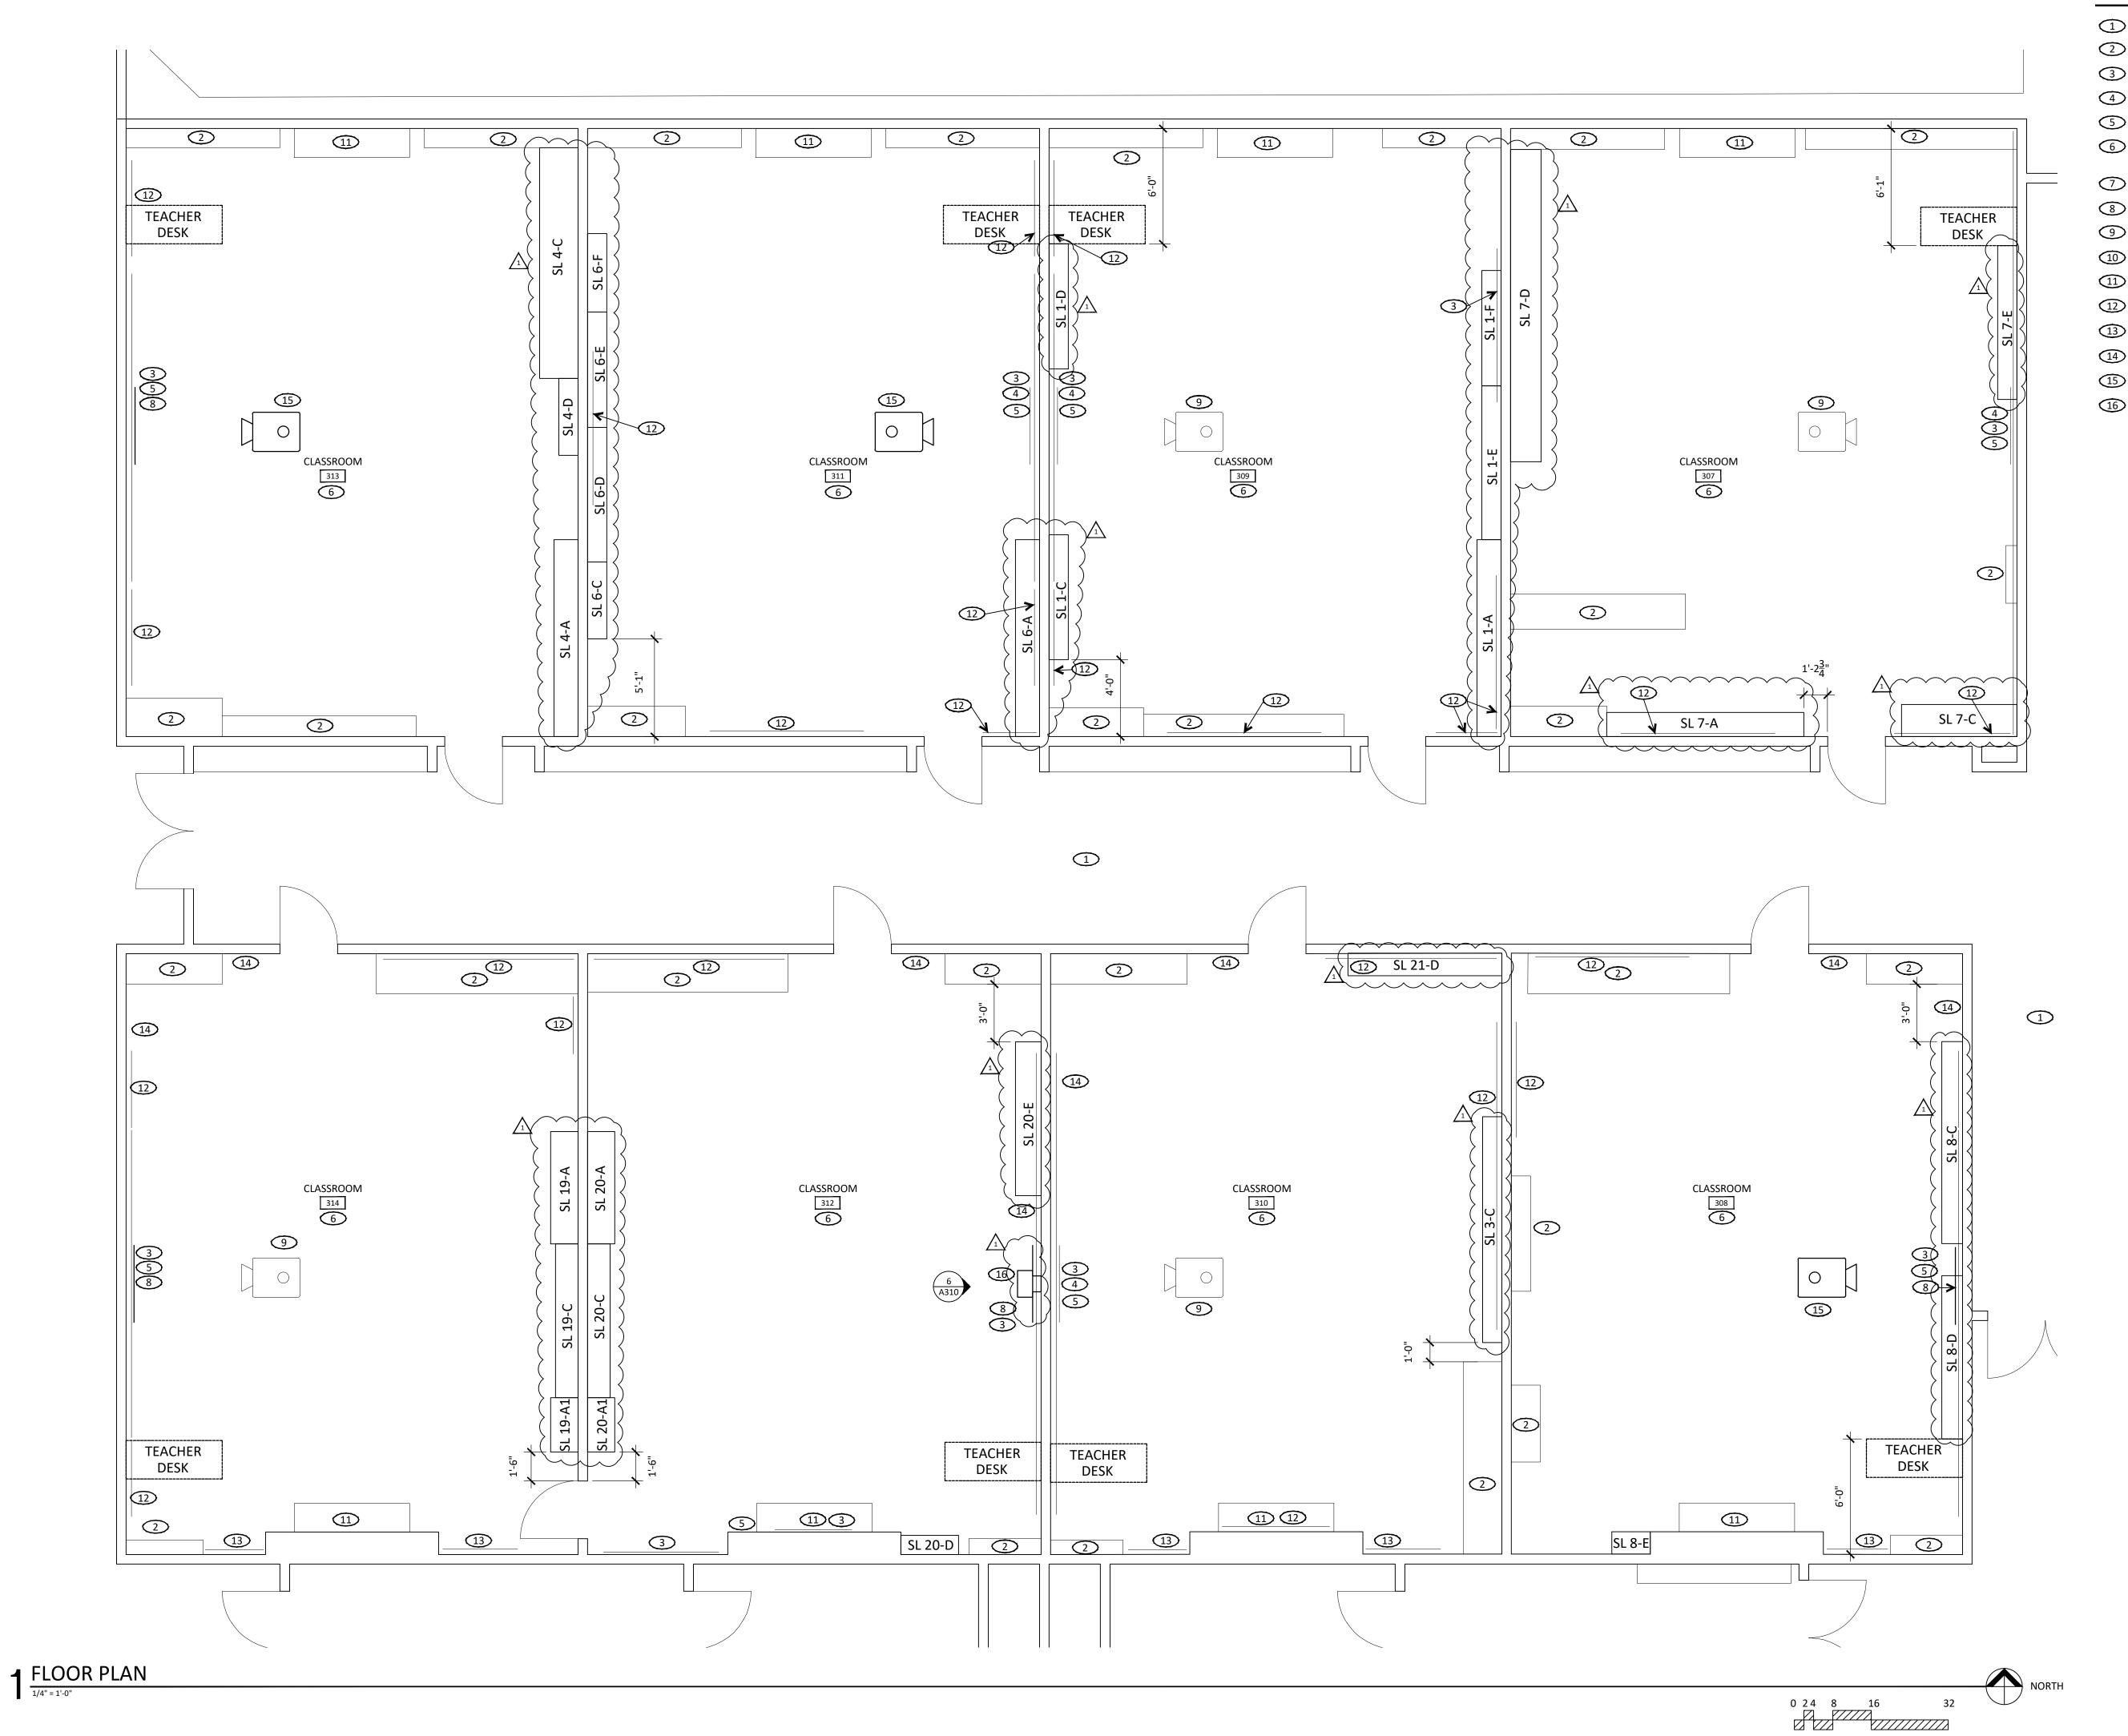

# **KEY NOTES**

- 1 NO WORK AT EXISTING HALL
- 2 EXISTING CASEWORK
- 3 EXISTING MARKER BOARD
- 4 EXISTING SMART BOARD
- 5 EXISTING PROJECTOR SCREEN
- 6 PROVIDE (N) PAINT SYSTEM @ WALLS & BEAMS THIS ROOM, SEE ALSO FINISH SCHEDULE
- 7 NOT USED
- 8 (N) SMART BOARD
- (E) CLG MOUNT PROJECTOR TO REMAIN
- (N) CEILING MOUNTED PROJECTOR
- (E) FLR MNT HVAC UNIT
- (E) TACK BOARD
- (E) PEG BOARD, (N) PAINT SYSTEM FINISH

  (E) WAINSCOT TO REMAIN, NO PAINT SCOPE
- (N) CLG MOUNT PROJECTOR @ (E) POLE MOUNT
- (N) WALL MOUNT SHORT THROW PROJECTOR

GMA ARCHITECTS 860 West Park Street / Ste 300

Eugene / Oregon / 97401

p 541.344.9157 gma-arch.com

JOSEPH E. MOORE
EUGENE, OFFICION
6033
OFF OFFICIAL

REVISIONS


3/17/2020 ADD. 1


4) NORTH EUGENE HIGH SCHOOL IMPROVEMENTS

OO SILVER LN, EUGENE OR

JOB NO: 19188
ISSUE DATE: 03 MAR 2020

PARTIAL FLOOR PLAN

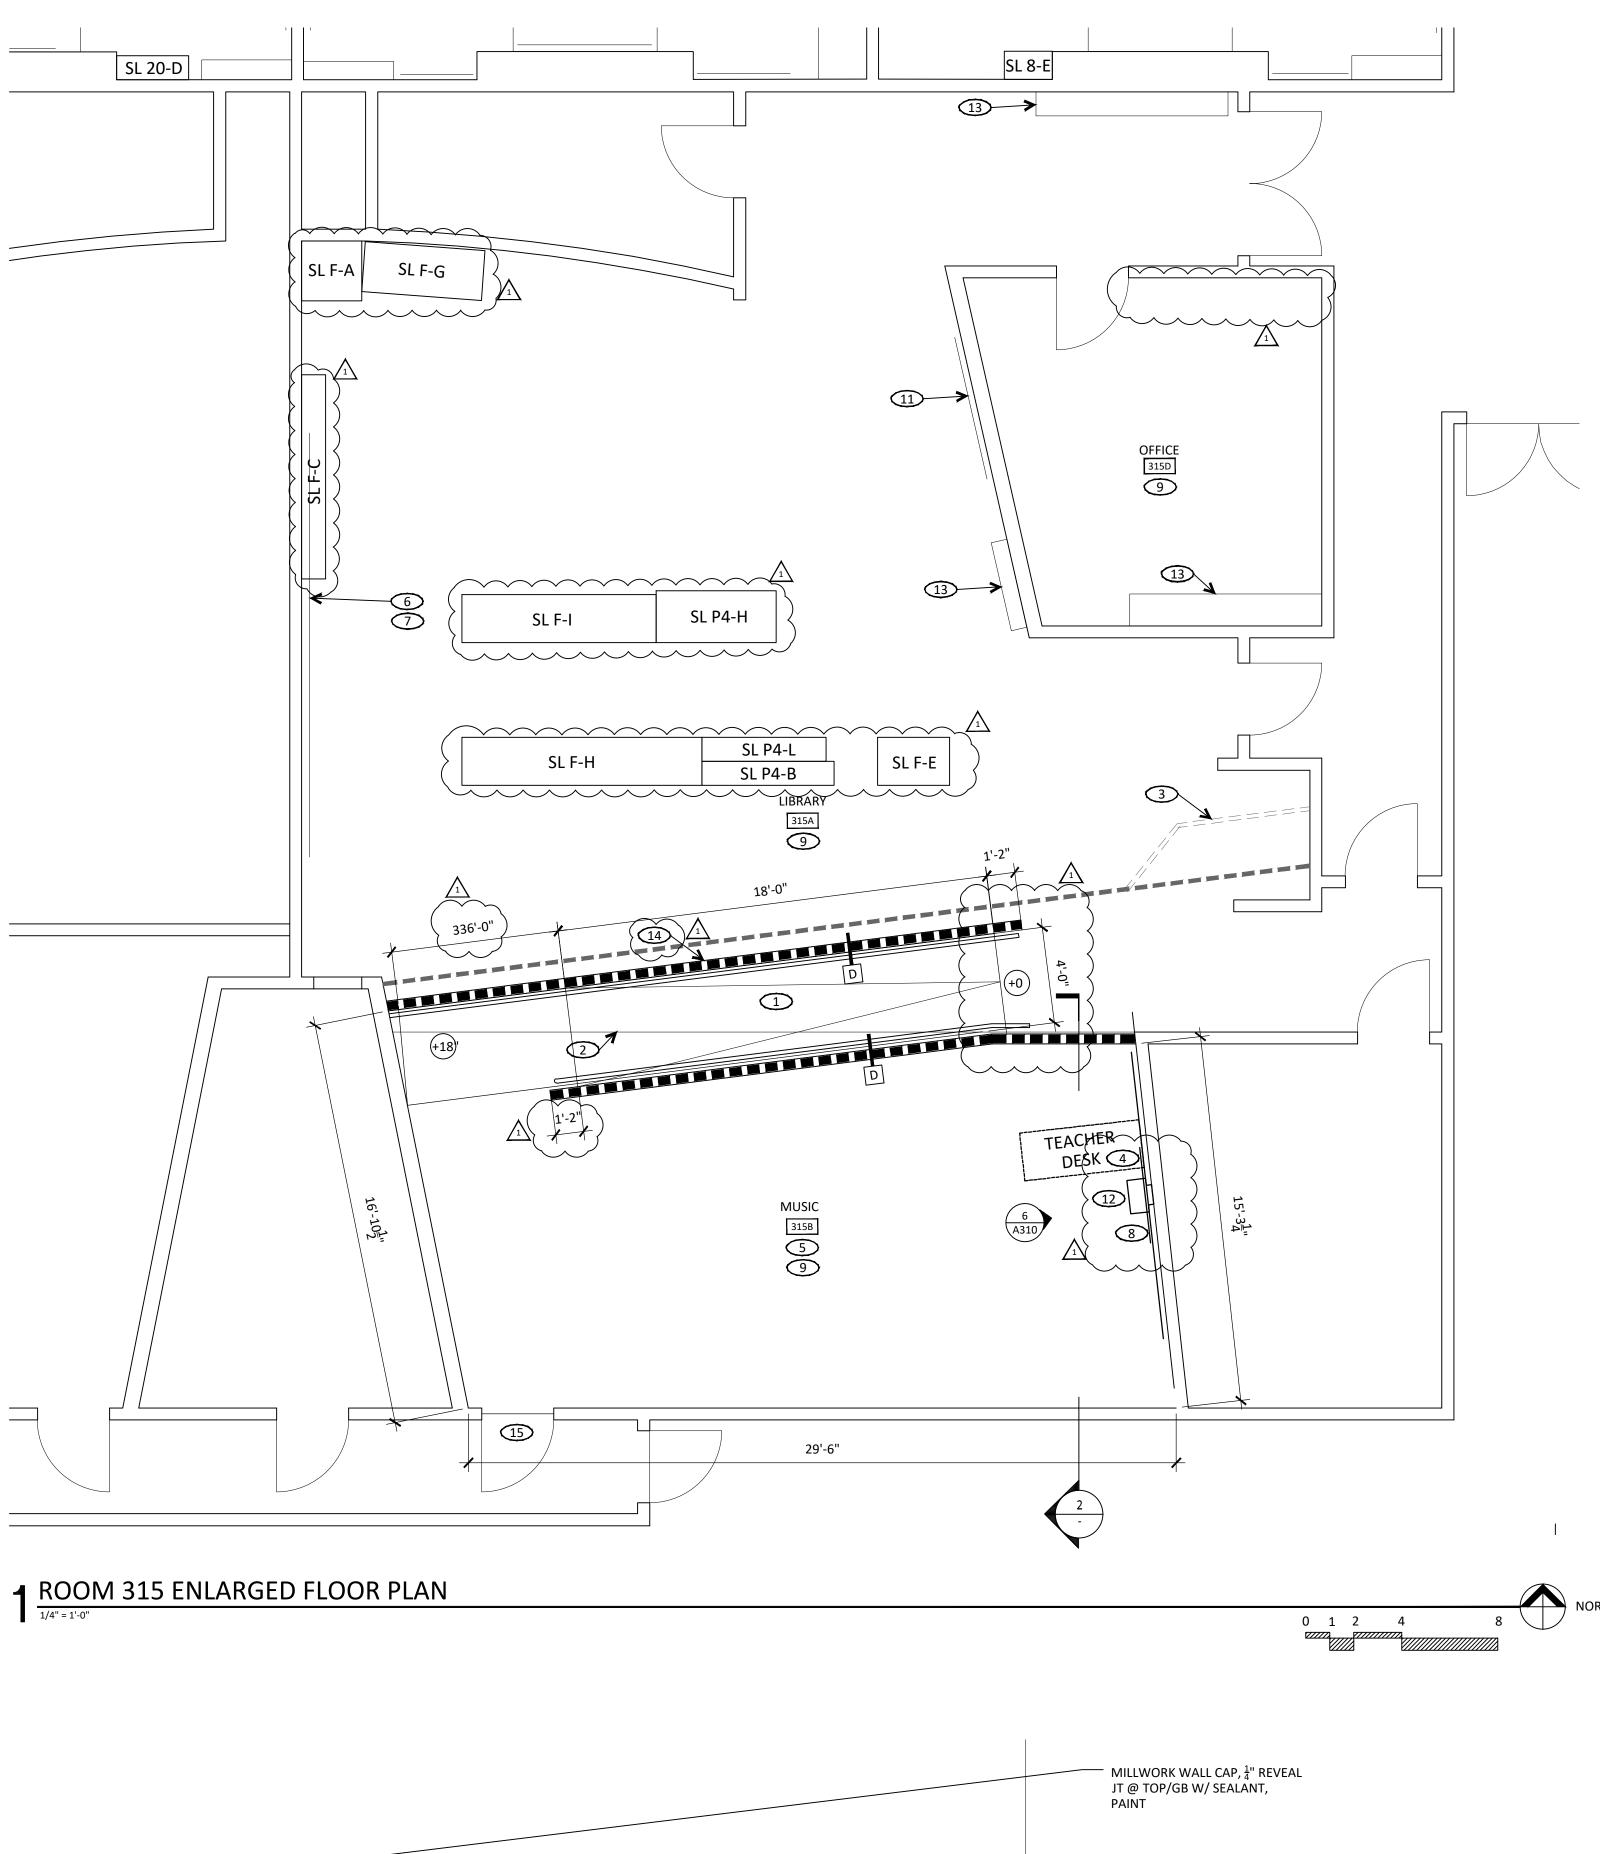

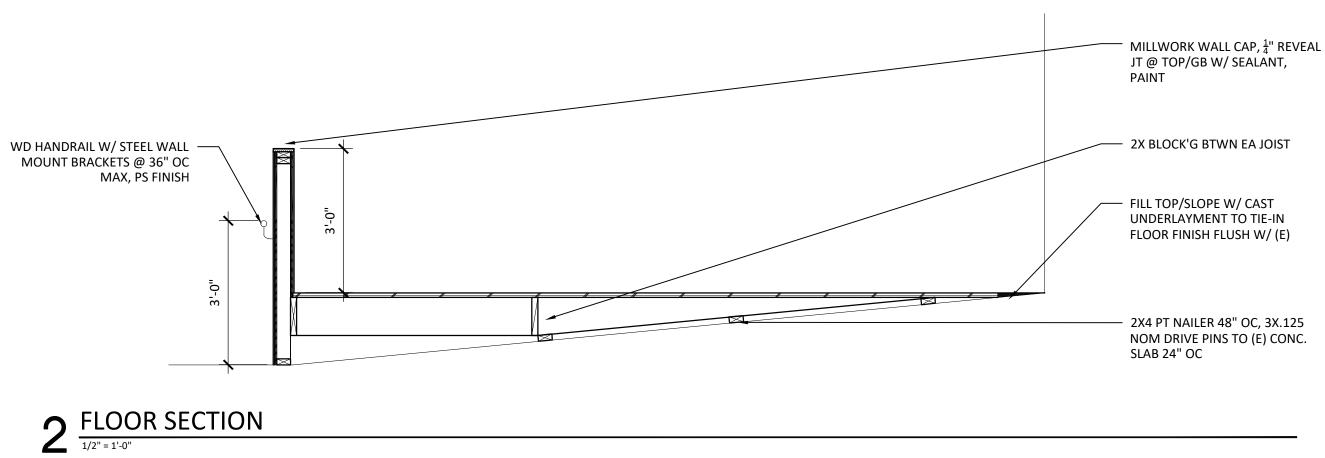

**KEY NOTES** 

(N) WOOD FRAMED RAMP AND PLATFORM OVER EXISTING SLOPED

2 DASH INDICATES EDGE OF SLOPED SLAB BELOW

(E) OPERABLE PARTITION TRACK ABOVE

4 (N) MARKER BOARD

(N) OVERFRAMING ABOVE SLOPED FLOOR SLAB, 2X10 16" OC W/1-1/8" PLYWD T&G DECKING

6 (E) MARKER BOARD

7 (E) PROJECTOR SCREEN

8 (N) SMART BOARD

9 PROVIDE (N) PAINT SYSTEM THIS ROOM, SEE ALSO FINISH SCHEDULE

10 NEW STEEL PIPE HANDRAIL @ 36" AFF W/HANDRAIL BRACKETS 60" OC, 12" EXTENSIONS TOP & BOTTOM W/RETURN TO WALL

(E) TACK BOARD

(N) WALL MOUNT SHORT THROW PROJECTOR

(E) CASEWORK

(N) SCAFCO OR SIM PONY WALL SUPPORT @ 60" OC & @ END/WALL, ANCHOR TO (E) CONC SLAB PER MFR RECOMMENDATIONS

15 FLUSH TRANSITION @ (E) FLR




p 541.344.9157 gma-arch.com



REVISIONS

3/17/2020 ADD. 1

# ESD 4J NORTH EUGENE HIGH SCHOOL IMPROVEMENTS


B NO: 19188
UE DATE: 03 MAR 2020

ENLARGED

FLOOR PLAN

SH H

A212

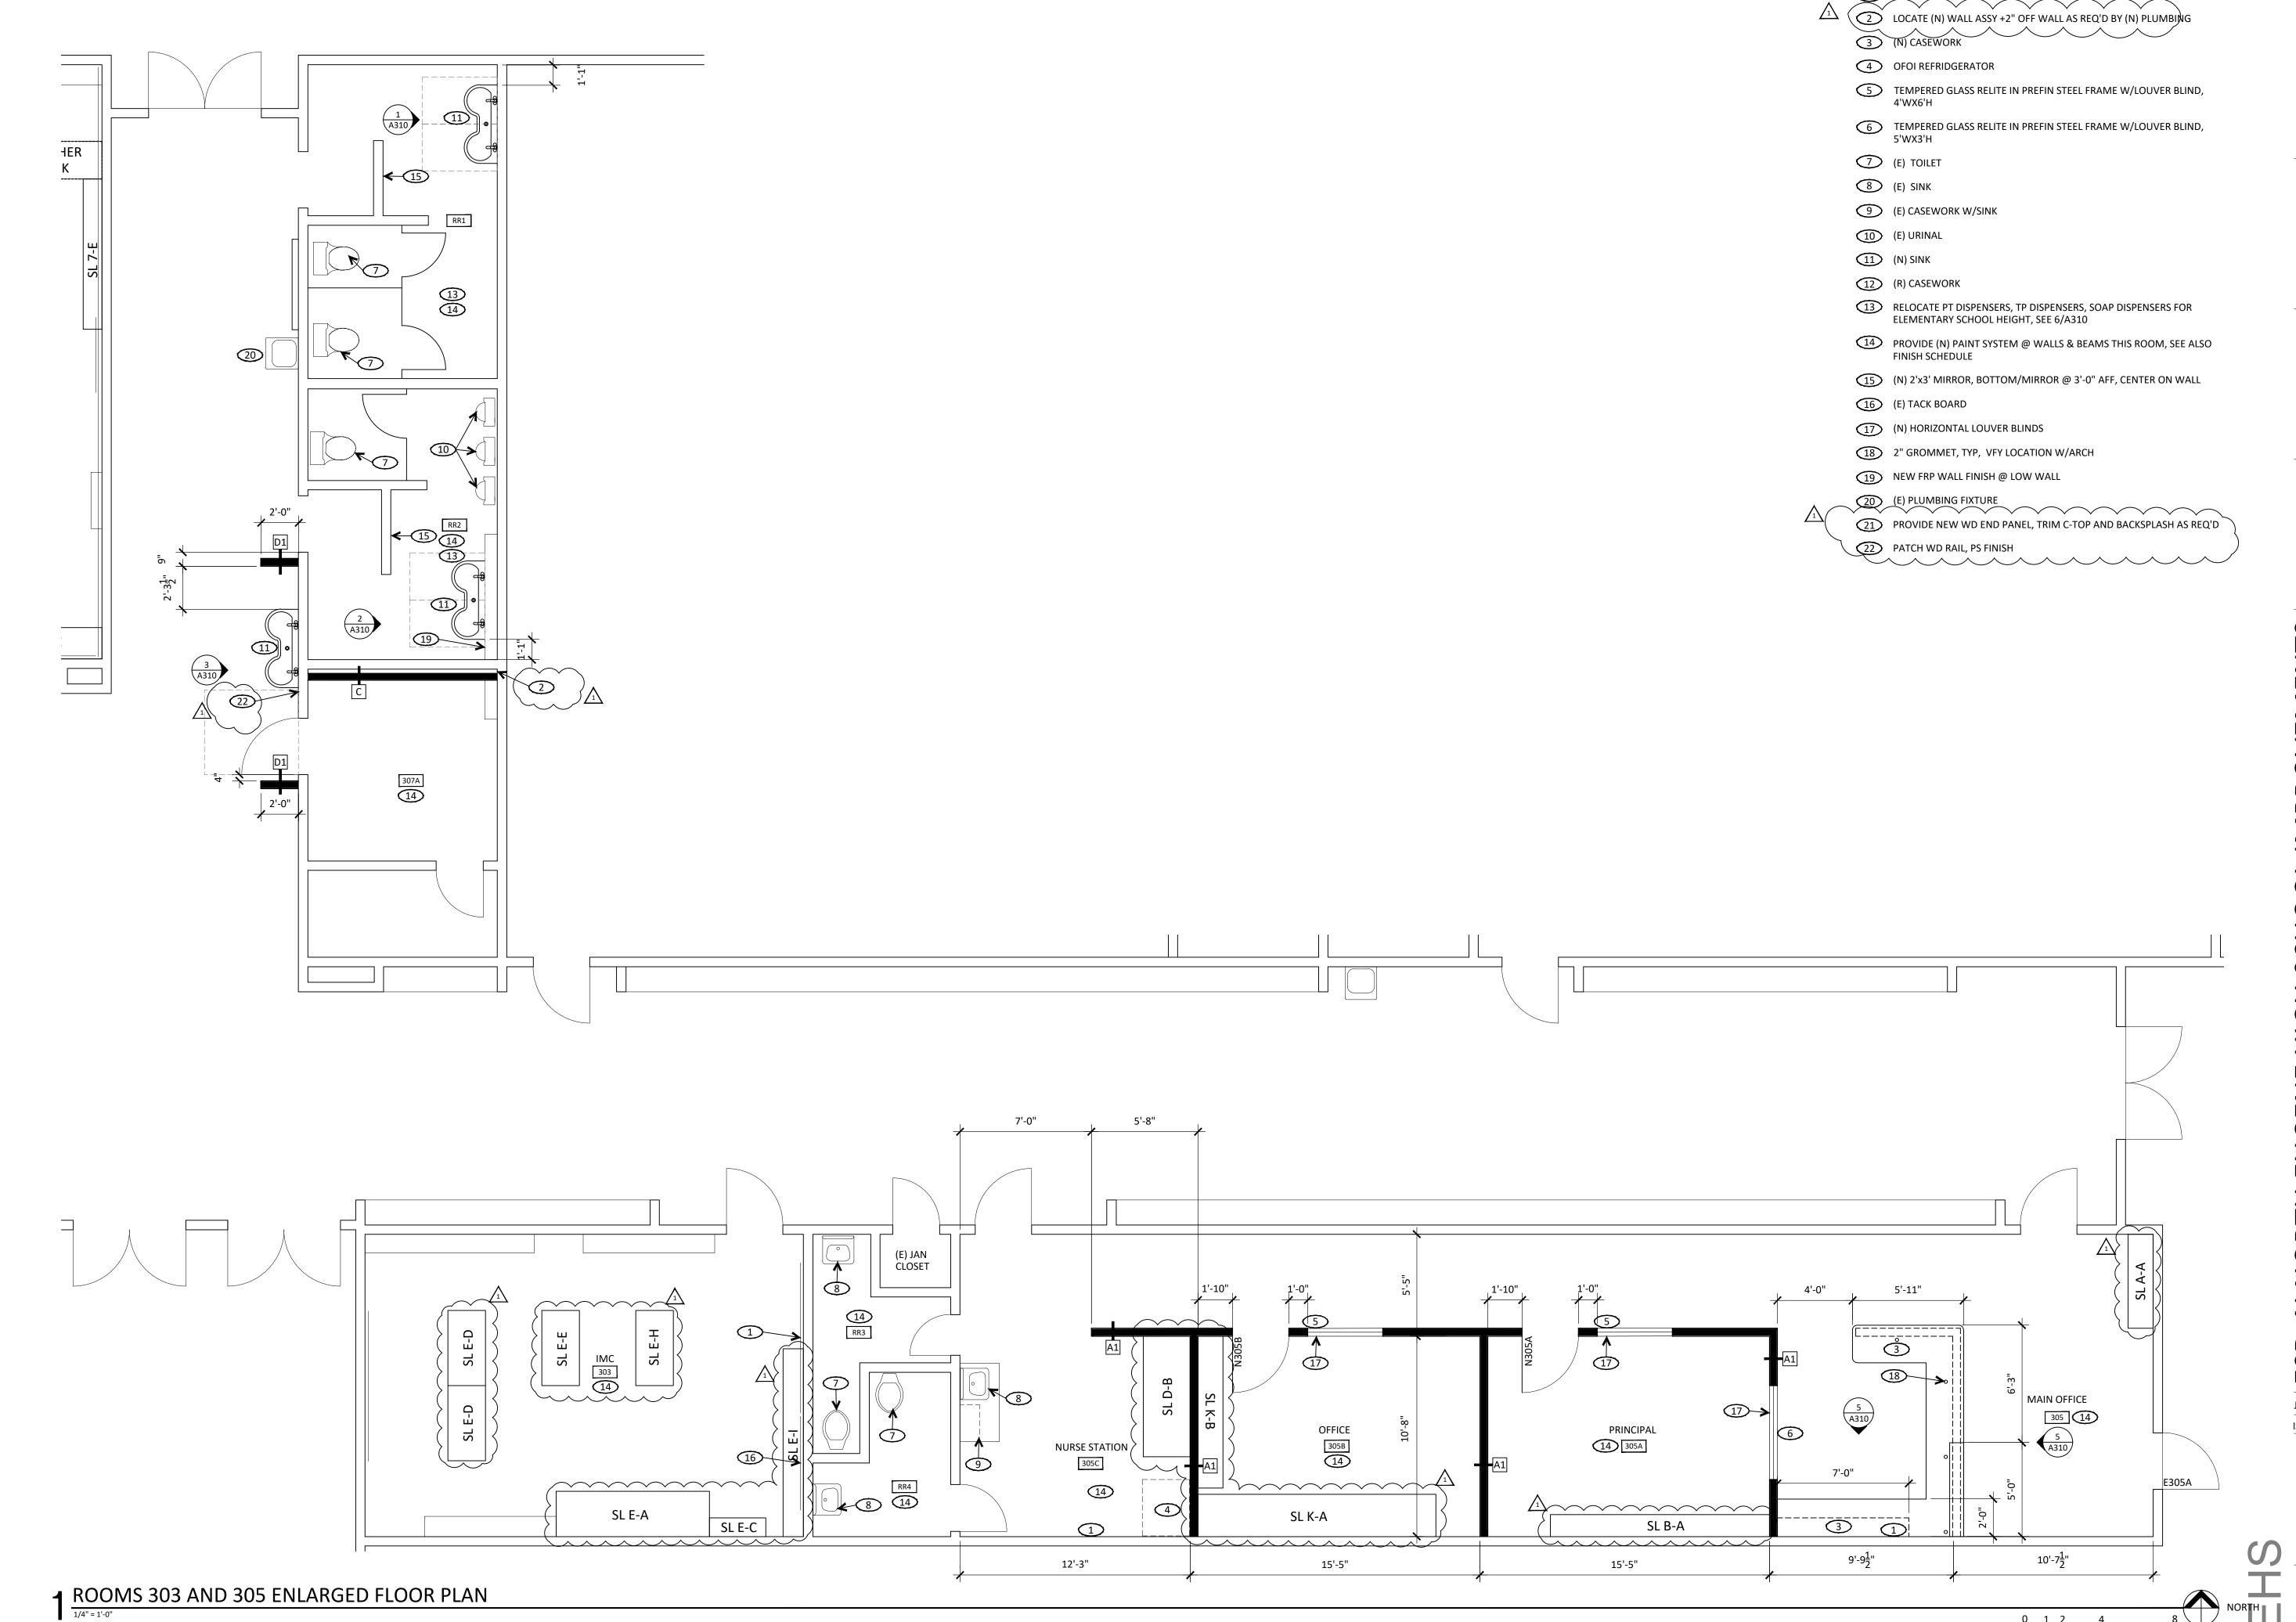

CMA ARCHITECTS

FLOOR PLAN KEY NOTES

GMA ARCHITECTS
860 West Park Street / Ste 300
Eugene / Oregon / 97401
p 541.344.9157
gma-arch.com



REVISIONS

3/17/2020 ADD. 1


**ESD 4J NORTH EUGENE HIGH SCHOOL IMPROVEMENTS** 


200 SILVER LN, EUGENE OR

JOB NO: 19188
ISSUE DATE: 03 MAR 2020

PARTIAL FLOOR PLAN

A213

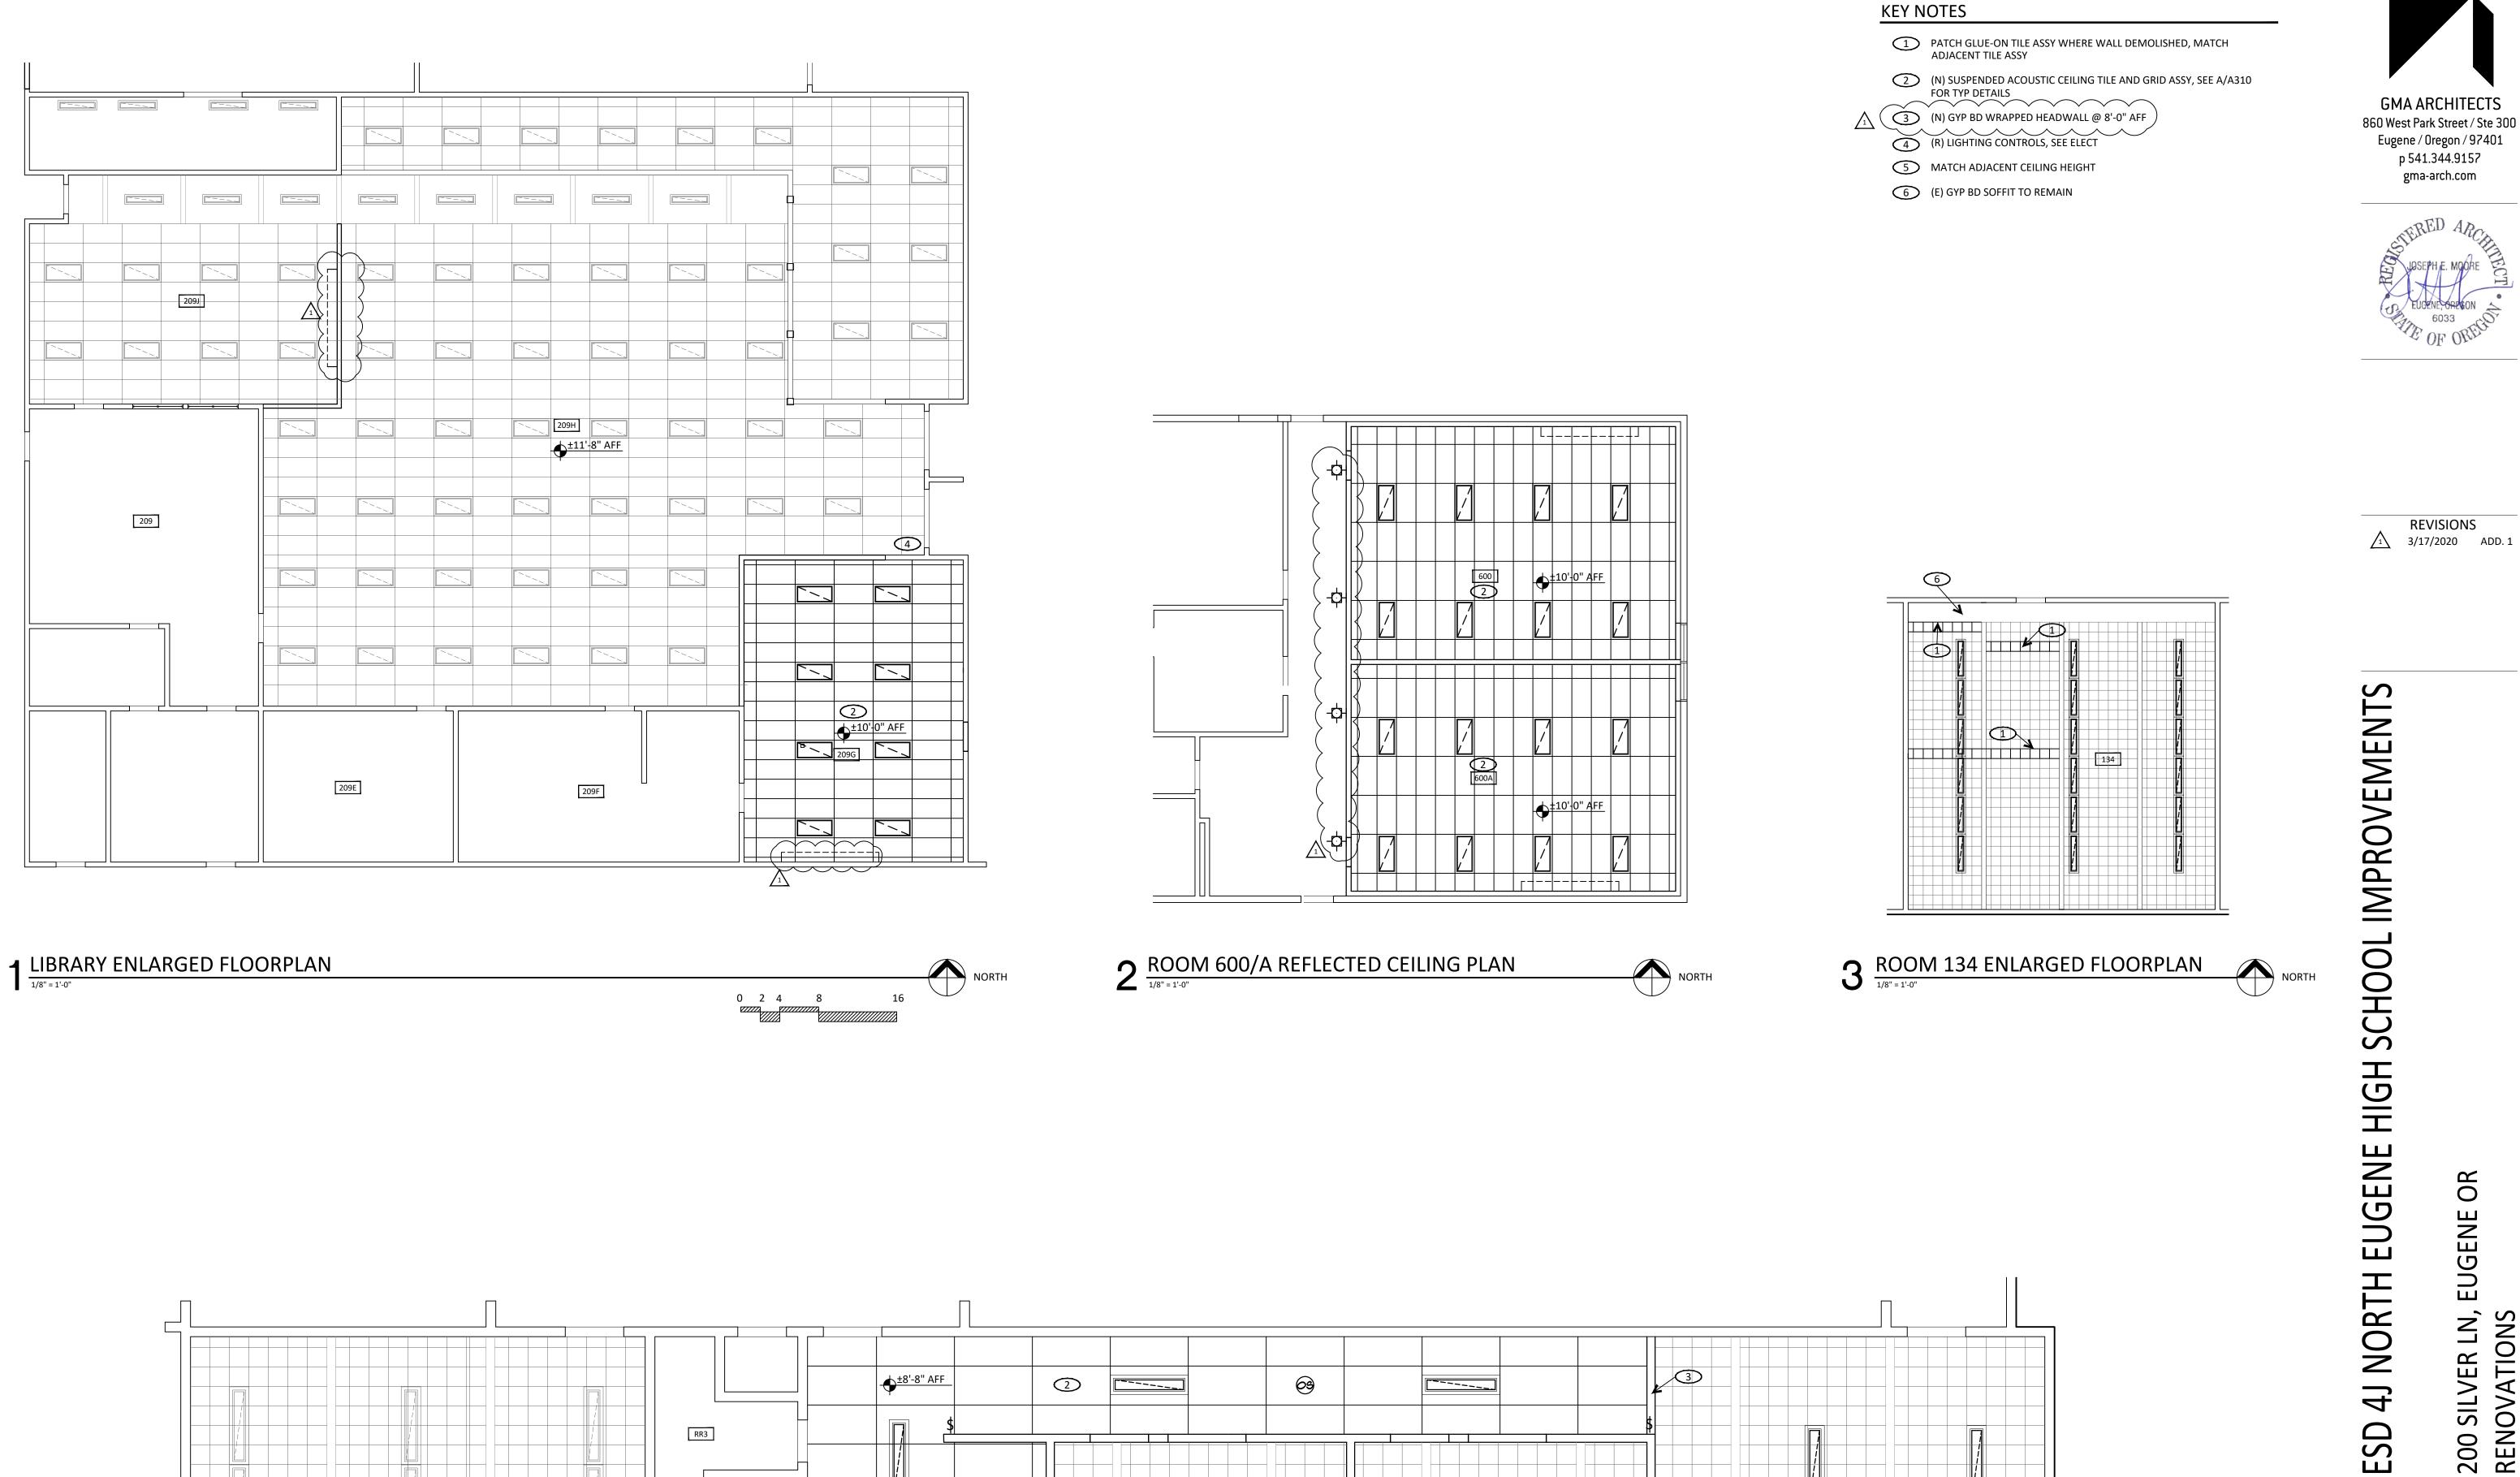

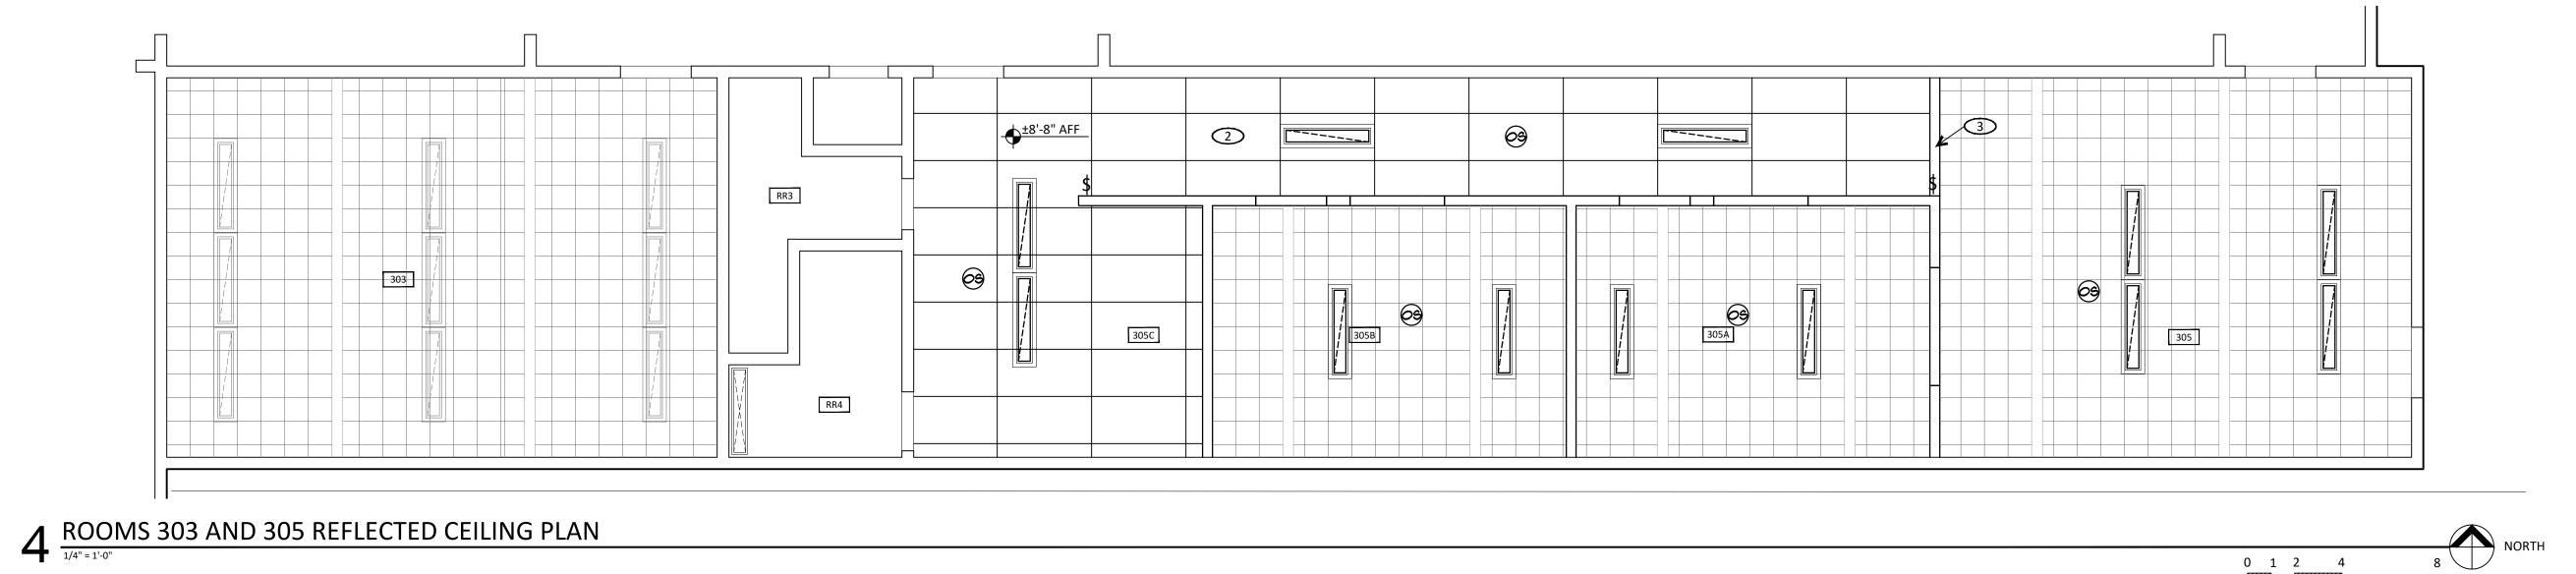

ISSUE DATE: NEHS

JOB NO:

COPYRIGHT GMA ARCHITECTS 2019

PARTIAL

REFLECTED

CEILING

A220


03 MAR 2020


**GMA ARCHITECTS** 


Eugene / Oregon / 97401 p 541.344.9157


gma-arch.com


REVISIONS 3/17/2020 ADD. 1

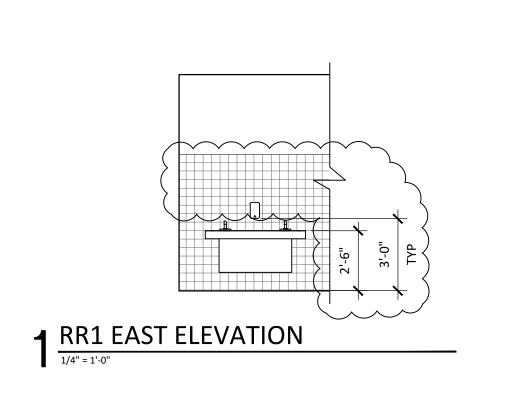

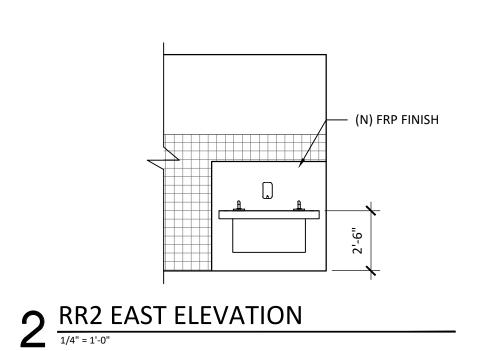

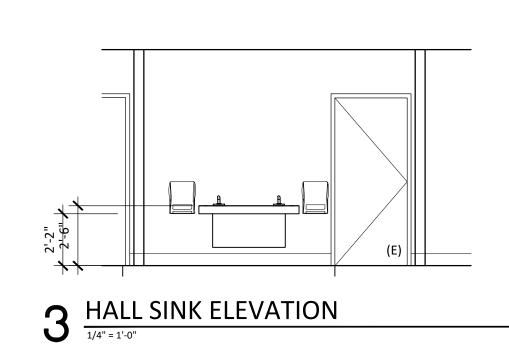

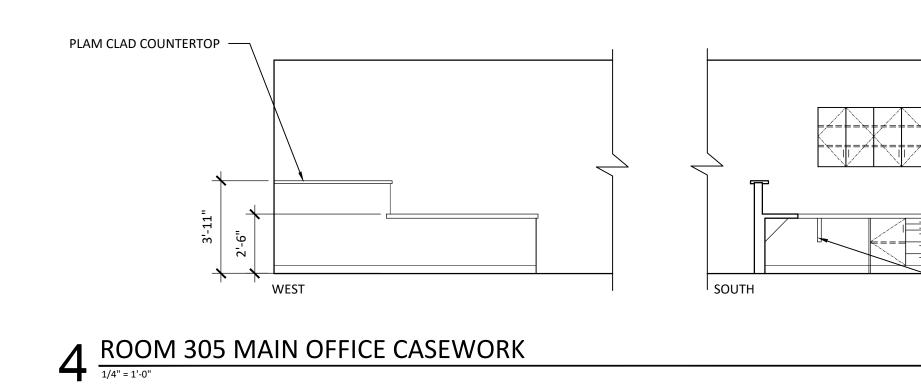

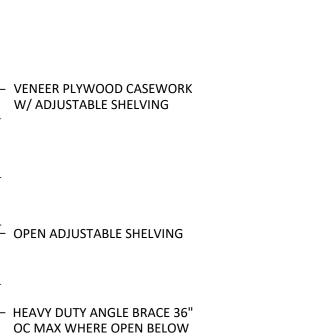

**GMA ARCHITECTS** 

860 West Park Street / Ste 300 Eugene / Oregon / 97401 p 541.344.9157

gma-arch.com

**REVISIONS** 

3/17/2020 ADD. 1

MPROVEMENTS

SCHOOL

**EUGENE HIGH** 

NORTH

ESD


JOB NO:

ISSUE DATE:


200 S

03 MAR 2020


19188

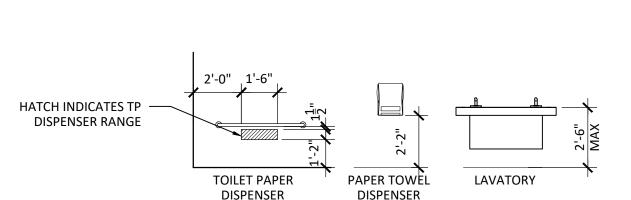




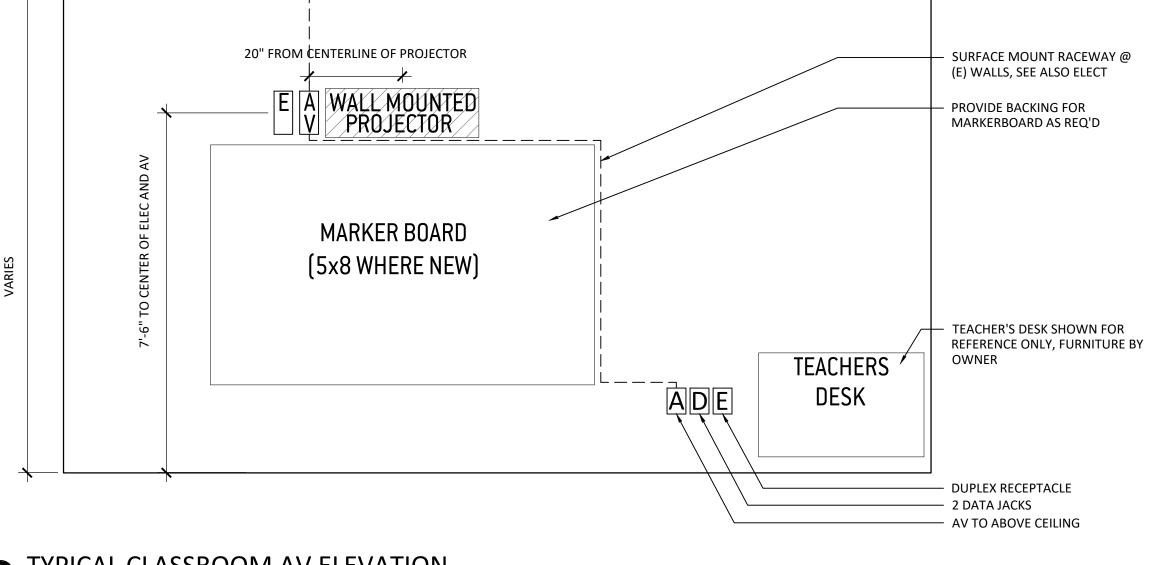



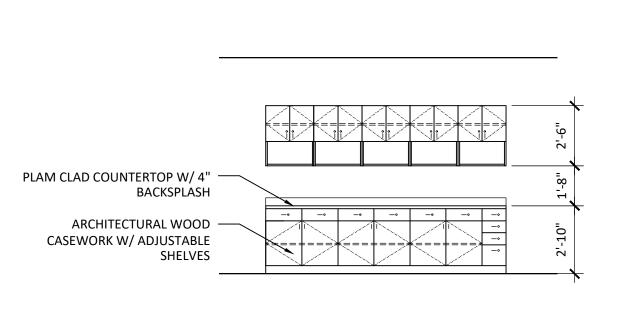


7 TYPICAL (N) CASEWORK ELEVATION  $\frac{1}{4" = 1' \cdot 0"}$ 

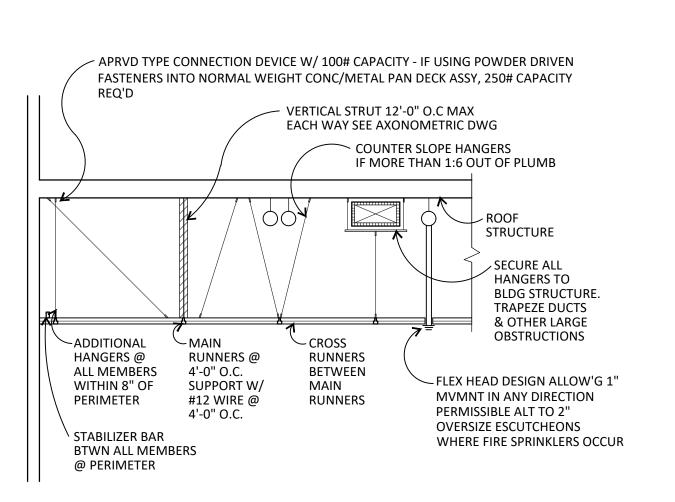


SUSPENDED CEILINGS SHALL BE FURNISHED AND INSTALLED PER CISCA STANDARDS AND THE ADDITIONAL REQUIREMENTS LISTED IN ASCE 7-10. UNLESS CEILING CLOUD DESIGN PROPOSED, SECURE GRID @ (2) SIDES MIN. TO WALLS OR HEADWALLS & INTERRUPT AREAS GREATER THAN 2,500 SQ FT W/ SEISMIC SEPARATION JT OR WALL/SOFFIT AS INDICATED IN PLANS. FOR CLOUD ASSY'S, PROVIDE ADD'L DESIGN DETAILING & ENGINEERING AS REQ'D BY AUTHORITIES HAVING JURISDICTION

SECTION SUSPENDED CEILING GRID DETAILS

NOT TO SCALE

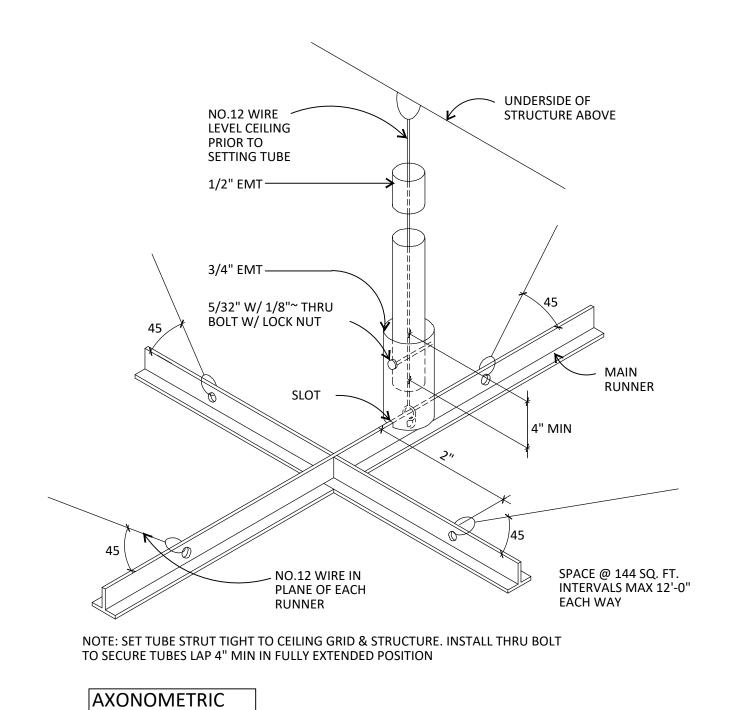

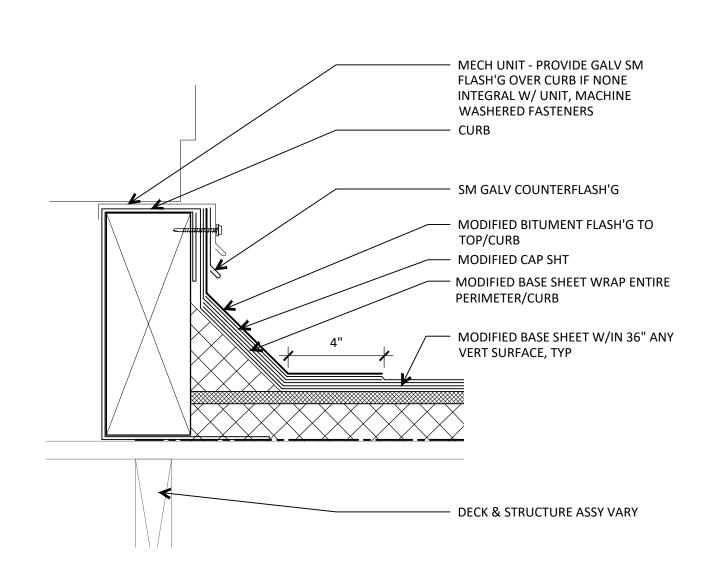

11 ROOF TOP MECHANICAL UNIT CURB, TYPICAL

1-1/2" = 1'-0"

INTERIOR

**ELEVATIONS &** 

**SECTIONS** 


| Cas        | ework ID      | Size (LxDxH)                                    | Notes    |
|------------|---------------|-------------------------------------------------|----------|
|            | A             | 10'-3" x 1'-3" x 6'-7"                          | 5        |
| -          | B             | 3'-9" x 2'-5" x 6'-7"                           | 4        |
| -          | C             | 6'-6" x 1'-0" x 2'-3"                           | 5        |
| \rac{1}{2} | D             | 6'-6" x 1'-0" x 2'-3"                           | 5        |
| F          | E             | 8'-0" x 1'-0" x 2'-3"                           | 5        |
| F          | <u>-</u><br>F | 6'-0" x 1'-0" x 2'-2"                           | 5        |
|            | •             | O O XI O XI I                                   |          |
| SL3        | С             | 11'-9" x 1'-0" x 2'-6"                          | 5        |
|            | Α             | 10'-3" x 1'-3" x 6'-7"                          | 5        |
| 4          | В             | 3'-10" x 2'-4" x 6'-9"                          |          |
| S L4       |               | 12'-0" x 2'-0" x 4'-6"                          | 5        |
|            | D             | 4'-0" x 1'-0" x 5'-0"                           | 5        |
|            |               |                                                 |          |
|            | A             | 10'-3" x 1'-3" x 6'-7"                          | 5        |
|            | В             | 3'-10" x 2'-3" x 6'-7"                          | 4        |
| 9          | С             | 4'-0" x 1'-0" x 2'-2"                           | 5        |
| S          | D             | 7'-0" x 1'-0" x 2'-2"                           | 5        |
|            | E             | 6'-0" x 1'-0" x 2'-2"                           | 5        |
|            | F             | 4'-1" x 1'-0" x 2'-2"                           | 5        |
| -          |               | 401.011.41.011.61.71                            |          |
|            | A             | 10'-3" x 1'-3" x 6'-7"                          | 5        |
| <u>-</u>   | B             | 3'-10" x 2'-4" x 6'-9"                          |          |
| 2  -       | C             | 6'-0" x 1'-8" x 6'-8"                           | 5        |
| -          | D<br>         | 16'-3" x 1'-7" x 2'-4"<br>8'-0" x 1'-0" x 2'-4" | 5 5      |
| +          | Ė             | 0-U X1-U X2-4"                                  | 5        |
|            | В             | 3'-9" x 2'-5" x 6'-7"                           |          |
| ∞          | C             | 10'-6" x 1'-1" x 2'-3"                          | 5        |
| Z [        | D             | 8'-6" x 1'-1" x 2'-3"                           | 5        |
|            | Е             | 2'-0" x 1'-2" x 3'-11"                          | 5        |
|            |               |                                                 |          |
| 19         | A1            | 2'-10" x 1'-5" x 6'-0"                          | 5        |
| SL 1       | Α             | 5'-10" x 1'-5" x 5'-9"                          | 5        |
| _          | С             | 8'-0" x 1'-2" x 3'-4"                           | 5        |
|            | A 1           | 21 10" v 11 5" v Cl 0"                          | -        |
| -          | A1<br>^       | 2'-10" x 1'-5" x 6'-0"                          | 5        |
| ٥ŀ         | A<br>C        | 5'-10" x 1'-5" x 5'-9"<br>8'-0" x 1'-2" x 3'-4" | 5        |
| SL 20      | D             | 3'-0" x 1'-0" x 5'-6"                           | 5        |
| °'  -      | <u>Б</u>      | 8'-0" x 1'-4" x 3'-0"                           | 5        |
| -          | <u>_</u>      | 4'-0" x 1'-0" x 6'-7"                           | 5        |
|            | •             |                                                 |          |
| SL 21      |               |                                                 | _        |
| S          | D             | 8'-0" x 1'-0" x 2'-4"                           | 5        |
| SL A       |               |                                                 |          |
| īs         | Α             | 5'-0" x 1'4" x 7'-0"                            |          |
|            |               |                                                 |          |
| SL B       | Α             | 11'-8" x 1'-2" - 2'-5"                          | 4        |
| S          |               |                                                 |          |
| +          | Α             | 4'-8" x 1'-4" x 2'-0"                           | 2        |
|            | B             | 6'-5" x 2'-6" x 1'-11"                          | 3        |
| s          | C             | 9'-2" x 1'-4" x 2'-7"                           | 2        |
|            |               |                                                 |          |
|            | Α             | 8'-2" x 2'-5" x 3'-4"                           | 5        |
|            | С             | 3'-0" x 1'-0" x 6'-6"                           | 5        |
|            | D             | (2X) 4'-0" x 2'-0" x 6'-6"                      |          |
| ա ├        | Е             | (2X) 4'-0" x 2'-0" x 6'-6"                      |          |
| <u> </u>   | F             | (2X) 4'-0" x 2'-0" x 6'-6"                      |          |
| L          | G             | 7'-6" x 2'-7" x 5'-7"                           |          |
|            | <u>H</u>      | 4'-0" x 2'-0" x 6'-6"                           | _        |
|            | 1             | 10'-0" x 1'-1" x 2'-4"                          | 2        |
| +          | J             | 4'-8" x 1'-5" x 2'-0"                           | 2        |
| $\dashv$   | A             | 2'-6" x 2'-6" x 6'-8"                           | 5        |
|            | B             | 27'-0" x 1'-0" x 4'-6"                          |          |
|            | C             | 8'-6" x 1'-0" x 2'-5"                           | 5        |
|            | D             | 16'-7" x 1'-0" x 2'-5"                          | <u> </u> |
| SLF        | E             | 3'-0" x 2'-0" x 3'-6"                           |          |
| ~,         | <br>F         | 16'-0" x 1'-0" x 4'-6"                          |          |
|            | G             | 5'-0" x 2'-1" x 6'-8"                           |          |
|            | Н             | 10'-0" x 2'-0" x 4'-7"                          |          |
|            |               | 8'-1" x 2'-0" x 4'-6"                           |          |
| 上          | 1             | 8-1 12-0 14-0                                   |          |
|            | ı             | 8-1 72-0 74-0                                   |          |
| НОР        | <u> </u>      |                                                 |          |
| SL K SHOP  | A             | 15'-8" x 2'-3" x 2'7"                           | 4        |

| NOTES:                                      |
|---------------------------------------------|
| 1. SEE PLAN FOR CASEWORK DIMENSIONS         |
| 2. UPPER CABINET                            |
| 3. NURSE BED                                |
| 4. FURR OUT ELECTRICAL DEVICE TO BACK/CABIN |
| 5. CASEWORK FURRING DETAIL B/A700           |
|                                             |


4

B 8'-1" x 1'-4" x 6'-3"

|            |         |             |                               |           |           |          |        | DOOR       | SCHEDULE |        |             |              |                                      |
|------------|---------|-------------|-------------------------------|-----------|-----------|----------|--------|------------|----------|--------|-------------|--------------|--------------------------------------|
|            |         | DOOR        |                               |           |           |          |        |            | FRAME    |        |             |              |                                      |
|            |         |             | SIZE                          |           |           |          |        |            |          |        | 1           |              |                                      |
|            | MARK    | WIDTH       | HEIGHT                        | THICKNESS | DOOR TYPE | MATERIAL | FINISH | FRAME TYPE | MATERIAL | FINISH | FIRE RATING | HARDWARE SET | COMMENTS                             |
|            | N206A   | 3'-0"       | 7'-0"                         | 1-3/4"    | В         | SCWD     | FF     | FR1        | НМ       | PS     | 1-1/2 HR    | 2            |                                      |
|            | M209GA~ | <b>₹</b> ₽~ | 7 <sup>1</sup> -0"~~          | 1-3/4"    | B~~~~     | \$6WD\   |        | FR1        | HM ~~~   | PS     | 1-1/2 HR    | ~~2~~        |                                      |
| <u> </u>   | E302A   | E           | E                             | Е         | Е         | E        | Е      | E          | E        | E      |             | 5            | Prep exterior side/door for new trim |
| (          | E304A   | Е           | E                             | Е         | E         | E        | Е      | E          | E        | E      |             | 6            |                                      |
| $\bigcirc$ | E305A   | E           | $\left. ight\}_{\mathrm{LL}}$ | È         | E \       | E        |        | E          | E^       | E^     |             | 4            |                                      |
|            | N305A   | 3'-0"       | 7'-0"                         | 1-3/4"    | С         | SCWD     | FF     | FR1        | НМ       | PS     |             | 3            |                                      |
|            | N305B   | 3'-0"       | 7'-0"                         | 1-3/4"    | С         | SCWD     | FF     | FR1        | нм       | PS     |             | 3            |                                      |
|            | N600A   | 3'-0"       | 7'-0"                         | 1-3/4"    | С         | SCWD     | FF     | FR1        | НМ       | PS     |             | 1            | 1/4" tempered glazing, insulated     |
|            | N600AA  | 3'-0"       | 7'-0"                         | 1-3/4"    | С         | SCWD     | FF     | FR1        | НМ       | PS     |             | 1            | 1/4" tempered glazing, insulated     |

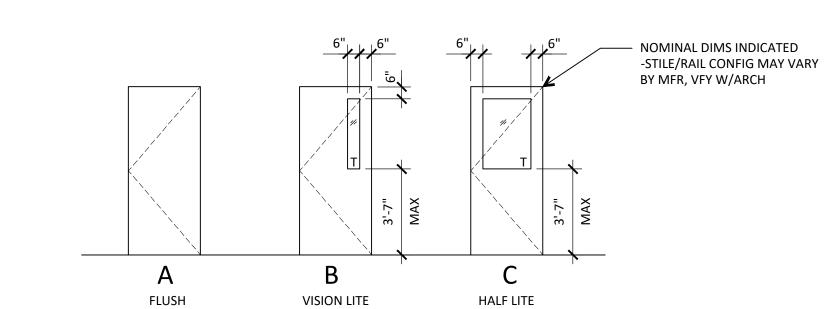

# DOOR TYPES 1/4" = 1'-0"

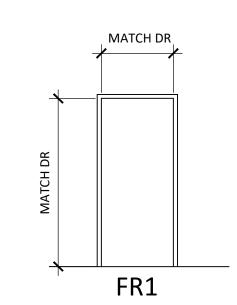


# FRAME TYPES 1/4" = 1'-0"

|                    |                                                  |       |              |          |        |          | 1/4" = 1' | -0"      |        |          |        |          |        |                                                  |
|--------------------|--------------------------------------------------|-------|--------------|----------|--------|----------|-----------|----------|--------|----------|--------|----------|--------|--------------------------------------------------|
| FINISH<br>SCHEDULE |                                                  |       |              |          |        |          |           |          |        |          |        |          |        |                                                  |
| ROOM NO.           | ROOM NAME                                        | FLC   | OOR          |          | WALLS  |          |           |          |        |          |        | CEILING  |        | NOTES                                            |
|                    | <del>                                     </del> | T     |              | NORTH    |        | EAST     |           | +        | UTH    |          | EST    |          |        |                                                  |
| 404                | 0,4000,004                                       | FLOOR | BASE         | MATERIAL | FINISH | MATERIAL | FINISH    | MATERIAL | FINISH | MATERIAL | FINISH | MATERIAL | FINISH |                                                  |
| 134                | CLASSROOM                                        | -     | -            | -        | PS-2   | -        | PS-2      | -        | PS-2   | -        | PS-2   | ACT-3    | -      | 1.                                               |
| 206A               | CLASSROOM                                        | -     | -            | -        | -      | GB       | PS-2      | GB       | PS-2   | -        | -      | -        | -      |                                                  |
| 209G               | CLASSROOM                                        | _     | -            | GB       | PS-2   | -        | -         | -        | -      | GB       | PS-2   | ACT-1    | -      | <b> </b>                                         |
| 209H               | LIBRARY                                          | _     | -            | -        | -      | -        | <u>-</u>  | -        | -      | -        | -      | -        | -      | <b> </b>                                         |
| RR1                | RESTROOM                                         | _     | -            | -        | PS-3   | -        | PS-3      | -        | PS-3   | -        | PS-3   | -        | -      |                                                  |
| RR2                | RESTROOM                                         |       | -            | -        | PS-3   | -        | PS-3      | -        | PS-3   | -        | PS-3   | -        | -      |                                                  |
| 303                | IMC                                              | -     | -            | -        | PS-2   | -        | PS-2      | -        | PS-2   | -        | PS-2   | -        | -      |                                                  |
| RR3                | RESTROOM                                         | -     | -            | -        | PS-3   | -        | PS-3      | -        | PS-3   | -        | PS-3   | -        | -      |                                                  |
| RR4                | RESTROOM                                         | -     | -            | -        | PS-3   | -        | PS-3      | -        | PS-3   | -        | PS-3   | -        | -      |                                                  |
| 305                | MAIN OFFICE                                      | -     | -            | -        | PS-2   | -        | PS-2      | -        | PS-2   | GB       | PS-2   | -        | -      |                                                  |
| 305A               | PRINCIPAL                                        | _     | -            | GB       | PS-2   | GB       | PS-2      | -        | PS-2   | GB       | PS-2   | -        | -      |                                                  |
| 305B               | OFFICE                                           | _     | -            | GB       | PS-2   | GB       | PS-2      | -        | PS-2   | GB       | PS-2   | -        | -      |                                                  |
| 305C               | NURSE STATION                                    | _     | -            | GB       | PS-2   | GB       | PS-2      | -        | PS-2   | -        | PS-2   | ACT-1    | -      |                                                  |
| 307A               | SPEECH                                           | -     | -            | GB       | PS-2   | -        | PS-2      | -        | PS-2   | -        | PS-2   | -        | -      |                                                  |
| 307                | CLASSROOM                                        | -     | -            | -        | PS-2   | -        | PS-2      | -        | PS-2   | -        | PS-2   | -        | -      |                                                  |
| 308                | CLASSROOM                                        | -     | -            | -        | PS-2   | -        | PS-2      | -        | PS-2   | -        | PS-2   | -        | -      |                                                  |
| 309                | CLASSROOM                                        | -     | -            | -        | PS-2   | -        | PS-2      | -        | PS-2   | -        | PS-2   | -        | -      |                                                  |
| 310                | CLASSROOM                                        | -     | -            | -        | PS-2   | -        | PS-2      | -        | PS-2   | -        | PS-2   | -        | -      |                                                  |
| 311                | CLASSROOM                                        | -     | -            | -        | PS-2   | -        | PS-2      | -        | PS-2   | -        | PS-2   | -        | -      |                                                  |
| 312                | CLASSROOM                                        | -     | -            | -        | PS-2   | -        | PS-2      | -        | PS-2   | -        | PS-2   | -        | -      |                                                  |
| 313                | CLASSROOM                                        | -     | -            | -        | PS-2   | -        | PS-2      | -        | PS-2   | -        | PS-2   | -        | -      |                                                  |
| 314                | CLASSROOM                                        | -     | -            | -        | PS-2   | -        | PS-2      | -        | PS-2   | -        | PS-2   | -        | -      |                                                  |
| 315A               | LIBRARY                                          | -     | -            | -        | PS-2   | -        | PS-2      | GB       | PS-2   | -        | PS-2   | -        | -      |                                                  |
| 315B               | MUSIC                                            | CONC  | RB-1         | GB       | PS-2   | -        | PS-2      | -        | PS-2   | -        | PS-2   | -        | -      |                                                  |
| 315D               | OFFICE                                           | -     | -            | -        | PS-2   | -        | PS-2      | -        | PS-2   | -        | PS-2   | -        | -      |                                                  |
| 600                | CLASSROOM                                        | -     | -            | GB       | PS-2   | GB       | PS-2      | GB       | PS-2   | GB       | PS-2   | ACT-1    | -      |                                                  |
| 600A               | CLASSROOM                                        | -     | -            | GB       | PS-2   | GB       | PS-2      | GB       | PS-2   | GB       | PS-2   | ACT-1    | -      |                                                  |
|                    | 1                                                |       | <del> </del> |          |        |          |           | 1        |        | 1        | +      | 1        | +      | <del>                                     </del> |

NOTES:

1. PATCH CLG TILE ASSY WHERE DEMOLITION OCCURS

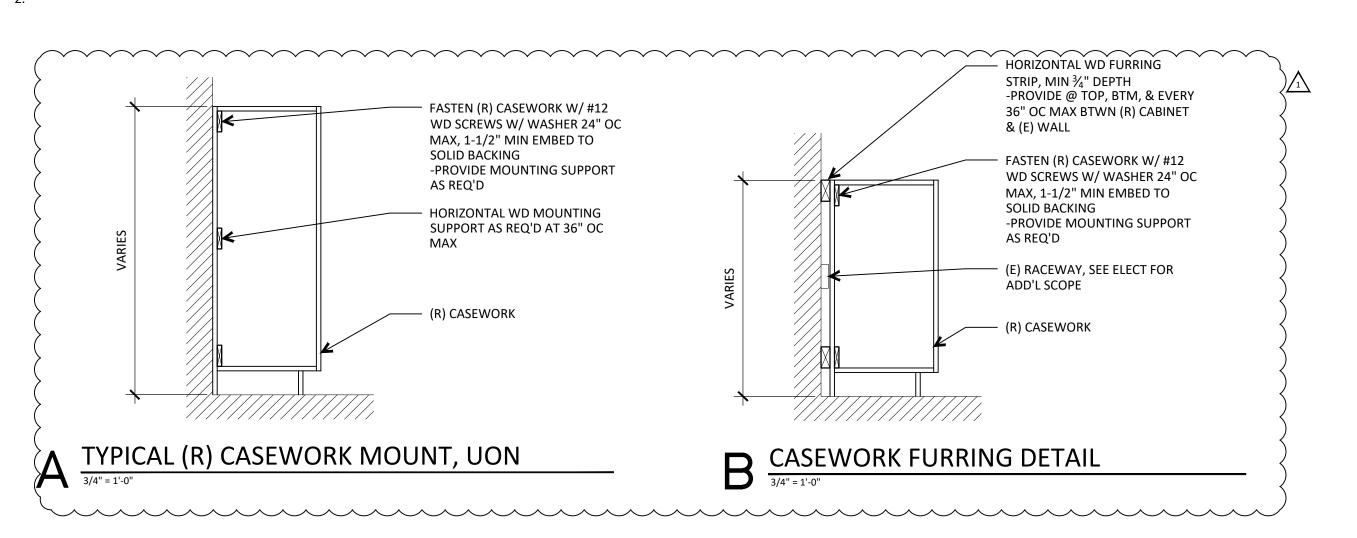

GMA ARCHITECTS

GMA ARCHITECTS

860 West Park Street / Ste 300

Eugene / Oregon / 97401

p 541.344.9157

gma-arch.com



REVISIONS
3/17/2020 ADD. 1

ESD 4J NORTH EUGENE HIGH SCHOOL IMPROVEMENTS

200 SILVER LN, EUGENE RENOVATIONS

03 MAR 2020


DOOR & FINISH SCHEDULE

JOB NO:

ISSUE DATE:

A700




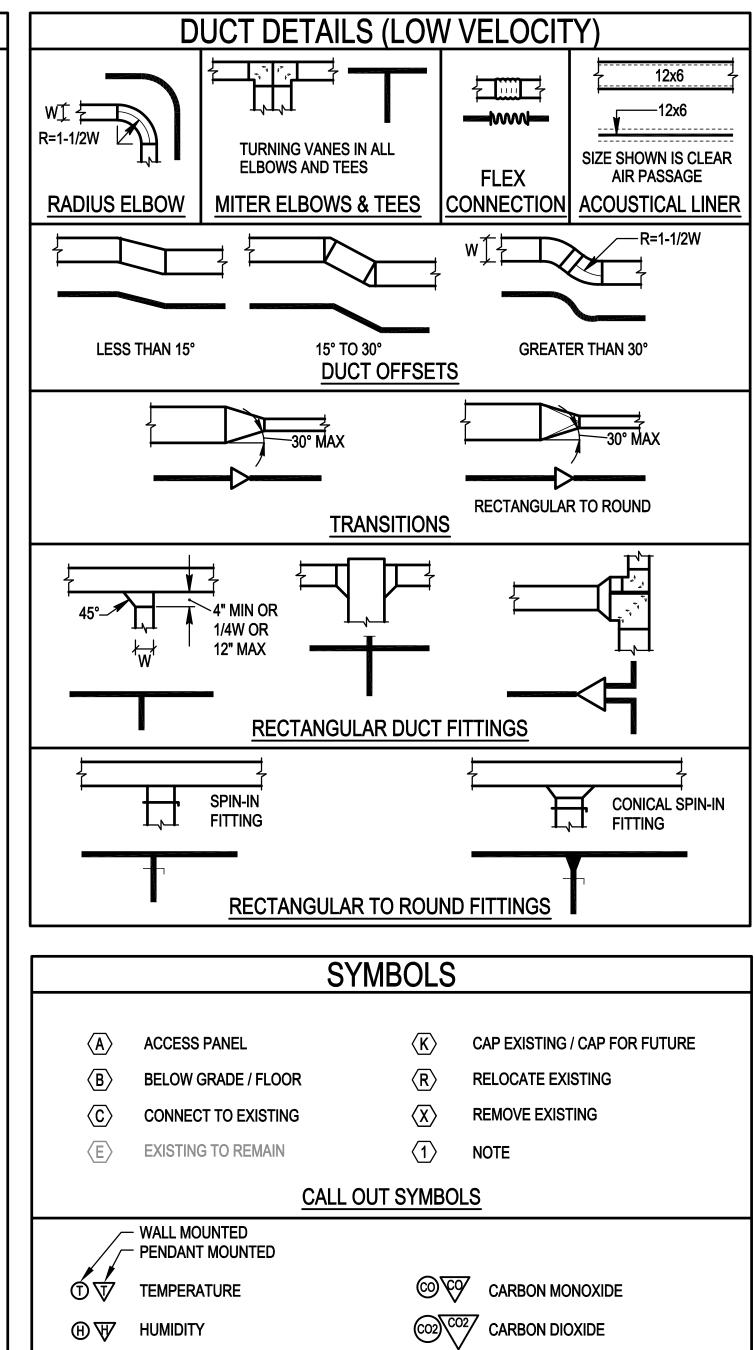



NOX NITROGEN OXIDE

**ROOM SENSORS** 

PRESSURE

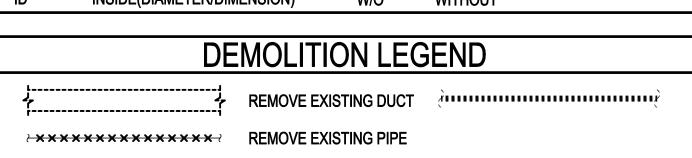

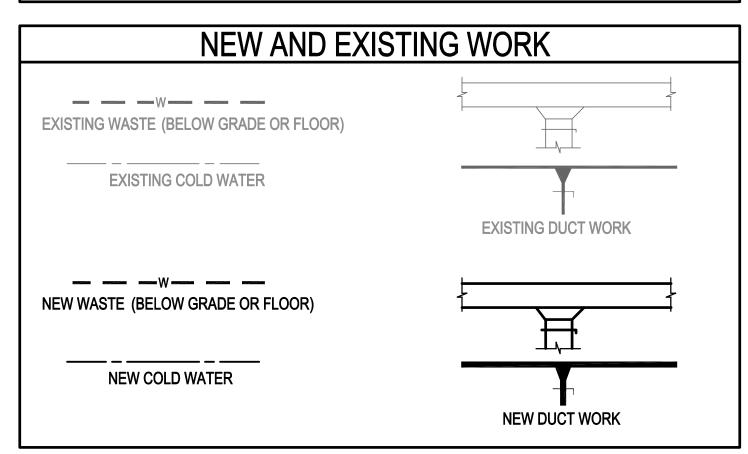

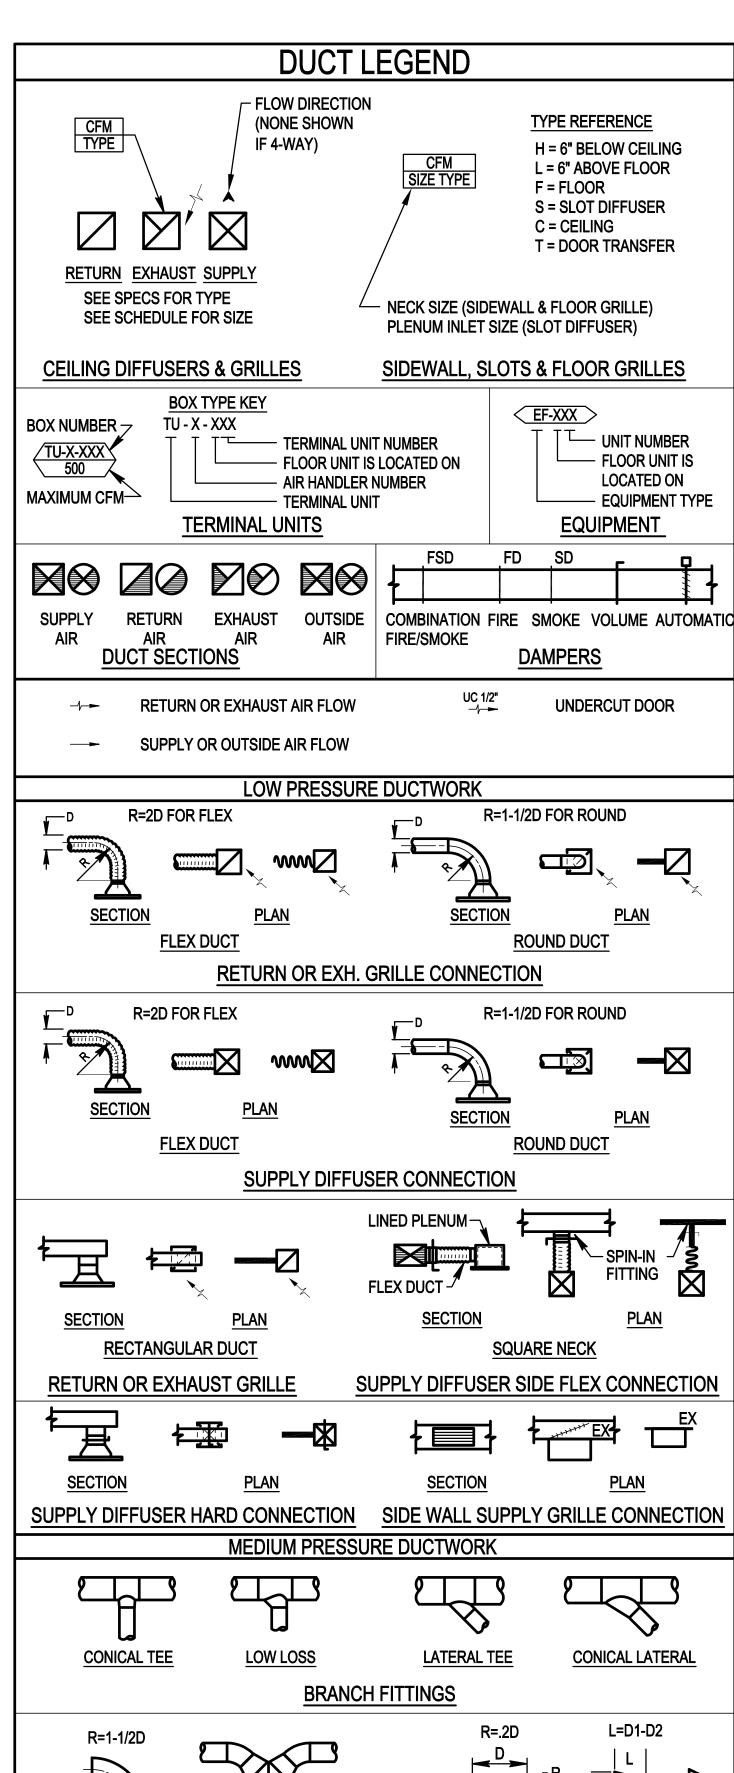

<u>D2</u>


<u>REDUCERS</u>


BELLMOUTH

Y-BRANCH

# **GENERAL NOTE**

THIS IS A STANDARD LEGEND SHEET, THEREFORE, SOME SYMBOLS MAY APPEAR ON THIS SHEET THAT DO NOT APPEAR ON THE DRAWINGS.

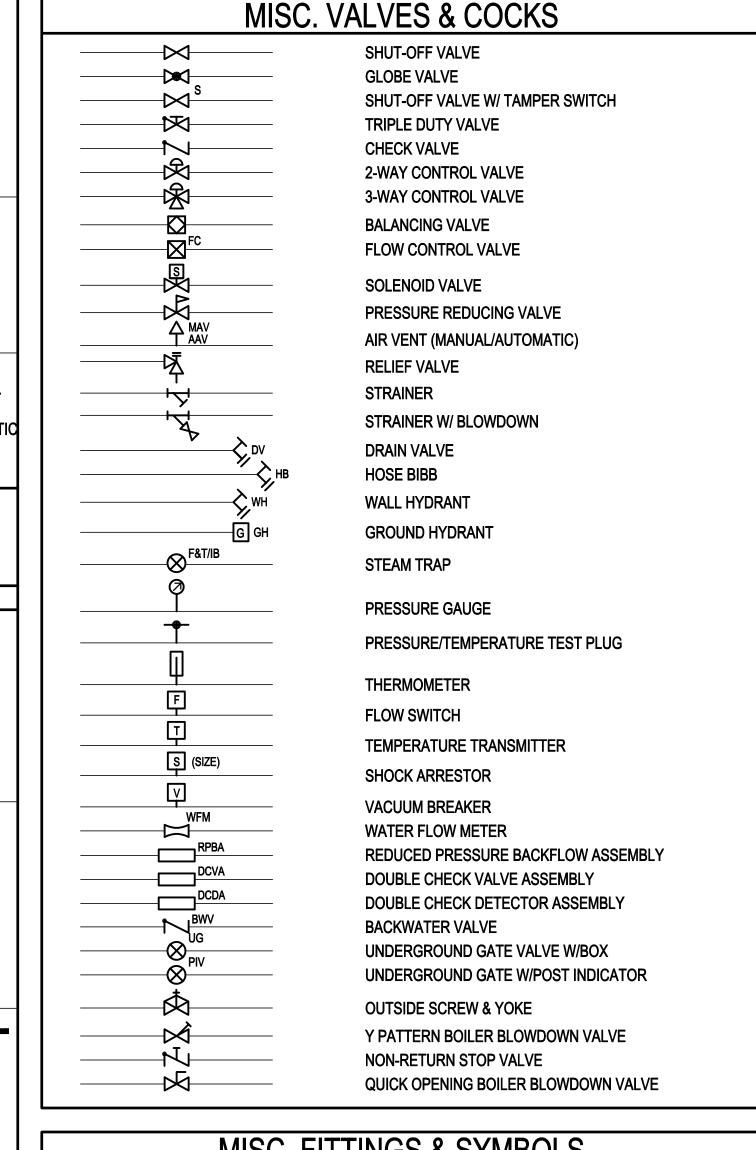


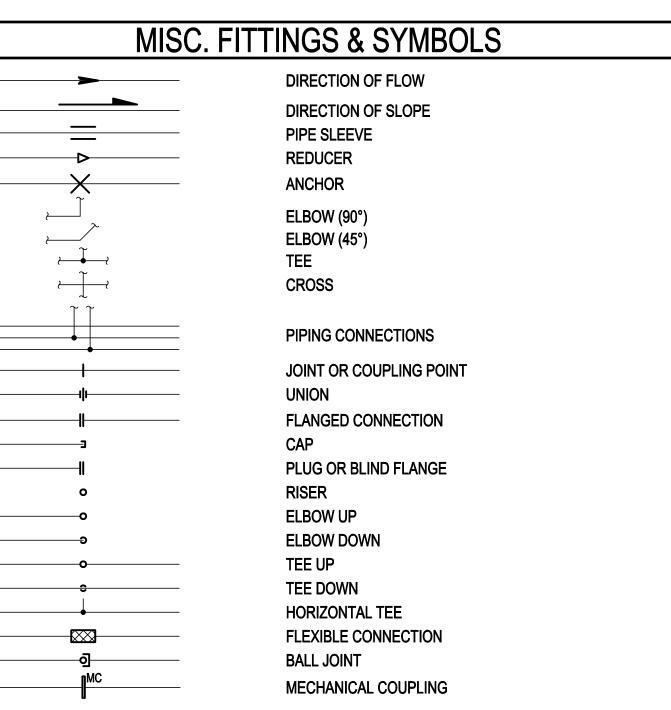



GMA ARCHITECTS

860 West Park Street / Ste 300
Eugene / Oregon / 97401
p 541.344.9157
gma-arch.com

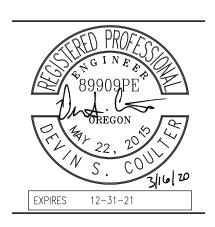



ne-engineers.com

REVISIONS

NORTH EUGENE HIGH SCHOOL IMPROVEMENTS

4

SD

ш

200 SILVER LN, EUGENE, OR 974 RENOVATIONS

JOB NO: 19188

ISSUE DATE: 3 MAR 2020

SYMBOLS,

SYMBOLS, LEGENDS AND ABBREVIATIONS -MECHANICAL

M0.0

# PLUMBING DESIGN CRITERIA

DOMESTIC WATER PIPING SYSTEM:

BASIS OF DESIGN: 2017 OREGON PLUMBING SPECIALTY CODE, APPENDIX A 'RECOMMENDED RULES FOR SIZING THE

WATER SUPPLY SYSTEM'. PIPING SIZED ON 4 PSI/100 FT. DROP, VELOCITIES NOT TO EXCEED 8 FT./SEC. (COLD WATER)

AND NOT TO EXCEED 5 FT./SEC. (HOT WATER). WASTE AND VENT PIPING SYSTEM:

BASIS OF DESIGN: 2017 OREGON PLUMBING SPECIALTY CODE, CHAPTER 7, 'SANITARY DRAINAGE'.

ALL WASTE PIPING SIZED AT 1/4"/FT. SLOPE UNLESS OTHERWISE NOTED.

| SPACE   |                 | WINTER                               | SUMMER                    |                                     |  |
|---------|-----------------|--------------------------------------|---------------------------|-------------------------------------|--|
|         | TEMPERATURE     | HUMIDITY                             | TEMPERATURE               | HUMIDITY                            |  |
| OUTDOOR | 23.4° F DB      | 16.1° F DP / 12.6 HR / 26.9 ° F MCDB | 91.7° F DB / 66.5° F MCWB | 62.2° F DP / 84.8 HR / 74.6° F MCDB |  |
| INDOOR  | 70° F ± 2° F DB | 50% RH MAX, NO MINIMUM               | 75° F ± 2° F DB           | 50% RH MAX, NO MINIMUM              |  |





| Or LAN  | FD PROP<br>GINE<br>89909P<br>OREGON<br>5. C | 3/10/20 |
|---------|---------------------------------------------|---------|
| EXPIRES | 12-31-21                                    |         |
|         |                                             |         |

| pae-engineers.com |  |
|-------------------|--|
|                   |  |
|                   |  |
|                   |  |

| REVISIONS | _ |
|-----------|---|
|           |   |

|             |          |                |       |          |         |         |             |         |        |            |               |       | ROOF     | TOP UN      | NITS |         |     |            |          |           |               |         |              |             |       |           |      |        |         |            |
|-------------|----------|----------------|-------|----------|---------|---------|-------------|---------|--------|------------|---------------|-------|----------|-------------|------|---------|-----|------------|----------|-----------|---------------|---------|--------------|-------------|-------|-----------|------|--------|---------|------------|
|             |          |                | MIXIN | IG BOX   | FILTERS |         | SUPPLY      | FAN     |        | AIR COOLED | CONDENSER FAN |       | GAS      | FIRED FURNA | ACE  |         |     |            | REFRIGEF | RANT COIL |               |         | AUXILIARY EI | LECTIC HEAT | El    | LECTRICAL | 1    |        |         |            |
|             |          |                | MAX   | CODE MIN |         |         |             |         |        |            |               |       | CAPA     | CITY        |      |         |     | DX COOLING |          | HE        | EAT PUMP HEAT | ING     |              |             |       |           |      |        | APPROX. |            |
|             |          |                | OSA   | OSA      |         | AIRFLOW | FAN         | ESP     | RATING | FAN        | MOTOR         | INPUT | MIN AFUE | EAT         | LAT  |         |     | EAT        | LAT      |           | EAT           | LAT     | CAPACITY     |             | VOLT/ | MCA       | MOCP |        | WEIGHT  | MANF.      |
| TAG         | LOCATION | SERVICE        | (CFM) | (CFM)    | (MERV)  | (CFM)   | TYPE        | (IN WG) | (HP)   | TYPE       | HP            | (MBH) | (%)      | (°F)        | (°F) | CONTROL | MBH | (°F DB/WB) | (°F DB)  | MBH       | (°F DB)       | (°F DB) | (KW)         | CONTROL     | PHASE | (A)       | (A)  | (S)EER | (LBS)   | & MODEL    |
| RTU-600     | ROOF     | CLASSROOM 600  | 1,220 | 450      | 11      | 1,220   | CENTRIFUGAL | 0.5     | 0.5    | PROP       | 1/6           | 56    | 80       | 45          | 90   | 2-STAGE | 36  | 82/64      | 55       | -         | -             | -       | -            | -           | 208/3 | 19        | 30   | 16.6   | 372     | TRANE-4YCZ |
| RTU-600A    | ROOF     | CLASSROOM 600A | 1,520 | 490      | 11      | 1,520   | CENTRIFUGAL | 0.5     | 0.5    | PROP       | 1/6           | 60    | 80       | 45          | 90   | 2-STAGE | 48  | 80/64      | 55       | -         | -             | -       | -            | -           | 208/3 | 25        | 35   | 16.0   | 394     | TRANE-4YCZ |
| RTU-305     | ROOF     | OFFICES        | 1,000 | 90       | 11      | 1,000   | CENTRIFUGAL | 0.5     | 0.5    | PROP       | 1/6           | -     | -        | -           | -    | -       | 24  | 76/62      | 55       | 20.2      | 63            | 90      | 3.75         | 1-STAGE     | 208/1 | 46        | 50   | 16.0   | 531     | TRANE-4WCZ |
| GENERAL NOT | ES:      |                |       

A. UNITS MOUNTED ON ROOF CURB.

B. MINIMUM OSA CALCULATED BASED ON OMSC-2019 AND ASHRAE STANDARD 62.1

C. ARRANGE UNIT FOR SINGLE POINT POWER CONNECTION.

D. PROVIDE FLEXIBLE CONNECTORS AT DUCT CONNECTIONS

|     |                                   |                                               |         | DIFFUS  | SERS AND ( | GRILLES |          |     |        |              |       |
|-----|-----------------------------------|-----------------------------------------------|---------|---------|------------|---------|----------|-----|--------|--------------|-------|
|     |                                   |                                               | AIRFLOV | V RANGE | INLET      | FAC     | E SIZE   |     |        |              |       |
|     |                                   |                                               | MIN     | MAX     | SIZE       | T-BAR   | HARD LID | MAX | THROW  | MANUFACTURER |       |
| TAG | TYPE                              | DESCRIPTION                                   | (CFM)   | (CFM)   | (IN)       | (IN)    | (IN)     | NC  | (FT)   | & MODEL      | NOTES |
|     |                                   |                                               | 0       | 125     | 6x6        | 24x24   | 13x13    | 12  | 2-2-5  |              |       |
|     | OFILING OURRLY                    | PERFORATED FACE, MODULAR                      | 126     | 220     | 8x8        | 24x24   | 15x15    | 17  | 2-3-6  |              |       |
| C-1 | CEILING SUPPLY<br>DIFFUSER        | CORE, ADJUSTABLE 4-WAY                        | 221     | 345     | 10x10      | 24x24   | 17x17    | 21  | 3-4-8  | TITUS PMC    |       |
|     | DII I OOLIK                       | THROW                                         | 346     | 500     | 12x12      | 24x24   | 19x19    | 24  | 3-5-9  |              |       |
|     |                                   |                                               | 501     | 780     | 16x16      | 24x24   | 23x23    | 28  | 4-6-11 |              |       |
|     |                                   |                                               | 0       | 340     | 10x10      | 24x24   | 12x12    | 17  | -      |              |       |
|     | OF II IN O DETI IDNI              |                                               | 341     | 780     | 15x15      | 24x24   | 17x17    | 22  | -      |              |       |
| C-2 | CEILING RETURN/<br>EXHAUST GRILLE | PERFORATED FACE, STEEL, ROUND DUCT CONNECTION | 781     | 1,220   | 18x18      | 24x24   | 20x20    | 26  | -      | TITUS PAR    |       |
|     | LAI IAOOT GIVILLE                 | MODIAL DOOL COMMEDITION                       | 1,221   | 1,670   | 22x22      | 24x24   | 24x24    | 26  | -      |              |       |
|     |                                   |                                               | 1,671   | 3,500   | 22x46      | 24x48   | 24x48    | 25  | -      |              |       |

# **GENERAL NOTES:**

A. NOISE CRITERIA (NC) BASED ON ROOM ABSORPTION OF 10 dB, MEASURED PER ANSI/ASHRAE STANDARD 70.

B. THROW VALUES GIVEN FOR TERMINAL VELOCITIES 150, 100, AND 50 FPM FOR ISOTHERMAL CONDITIONS.

C. ADJUST THROW DIRECTION AND QUANTITY PRIOR TO AIR BALANCING.

|        |              |   |            | PLU          | MBING | FIXTURE | SCHEDUL    | .E                                 |       |
|--------|--------------|---|------------|--------------|-------|---------|------------|------------------------------------|-------|
| TAG    |              |   | ROUGH-IN S | IZE (INCHES) |       |         | ELEC.      |                                    |       |
| NUMBER | FIXTURE TYPE | W | V          | CW           | HW    | GPM/GPF | CONNECTION | DESCRIPTION                        | NOTES |
| WS-1   | WASH STATION | 2 | 1-1/2      | 1/2          | 1/2   | 1.0     | N          | WALL HUNG, TWO STATION 0.5GPM, ADA |       |

# FIRE PROTECTION DESIGN CRITERIA

NFPA 13 SHALL BE USED FOR THE LOCATION, SIZING, & INSTALLATION OF PIPING & SPRINKLER SYSTEMS UNLESS

LOCAL FIRE MARSHAL OR OWNER'S INSURANCE UNDERWRITER REQUIREMENTS ARE MORE STRINGENT.

FIRE PROTECTION SPRINKLER DESIGN CRITERIA: (NFPA)

PROVIDE THE FOLLOWING HAZARD CLASSIFICATIONS AND DENSITIES PER CURRENT NFPA 13 STANDARDS:

- LIGHT HAZARD OCCUPANCIES: 0.10 GPM/FT2 DENSITY AT MOST REMOTE 1500 SQUARE FEET FOR PUBLIC AREAS.

DESIGN CUSHION: PROVIDE AN EXCESS OF 10 PSI ADDITIONAL PRESSURE REQUIREMENTS INCORPORATED INTO THE

DESIGN OVER SPECIFIED PRESSURE REQUIREMENTS.


REFER TO DRAWINGS FOR ZONE TYPES, CALLOUTS AND ADDITIONAL SCOPE ITEMS.

**PROVEMENTS** SCHOOL EUGENE NORTH

> JOB NO: **ISSUE DATE:** 3 MAR 2020

> > **EQUIPMENT SCHEDULE** -**MECHANICAL**



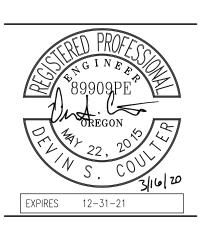



REVISIONS

**ESD 4J NORTH EUGENE HIGH SCHOOL IMPROVEMENTS** 

JOB NO: ISSUE DATE:


**OVERALL DEMOLITION** PLAN -**MECHANICAL** 

MD.0 1/32" = 1'-0"

OVERALL DEMOLITION PLAN - MECHANICAL


1. DEMOLISH WALL GRILLE, CAP DUCT, AND PATCH WALL TO MATCH. ABANDON DUCT IN

2. EXISTING FLOOR REGISTER TO REMAIN.

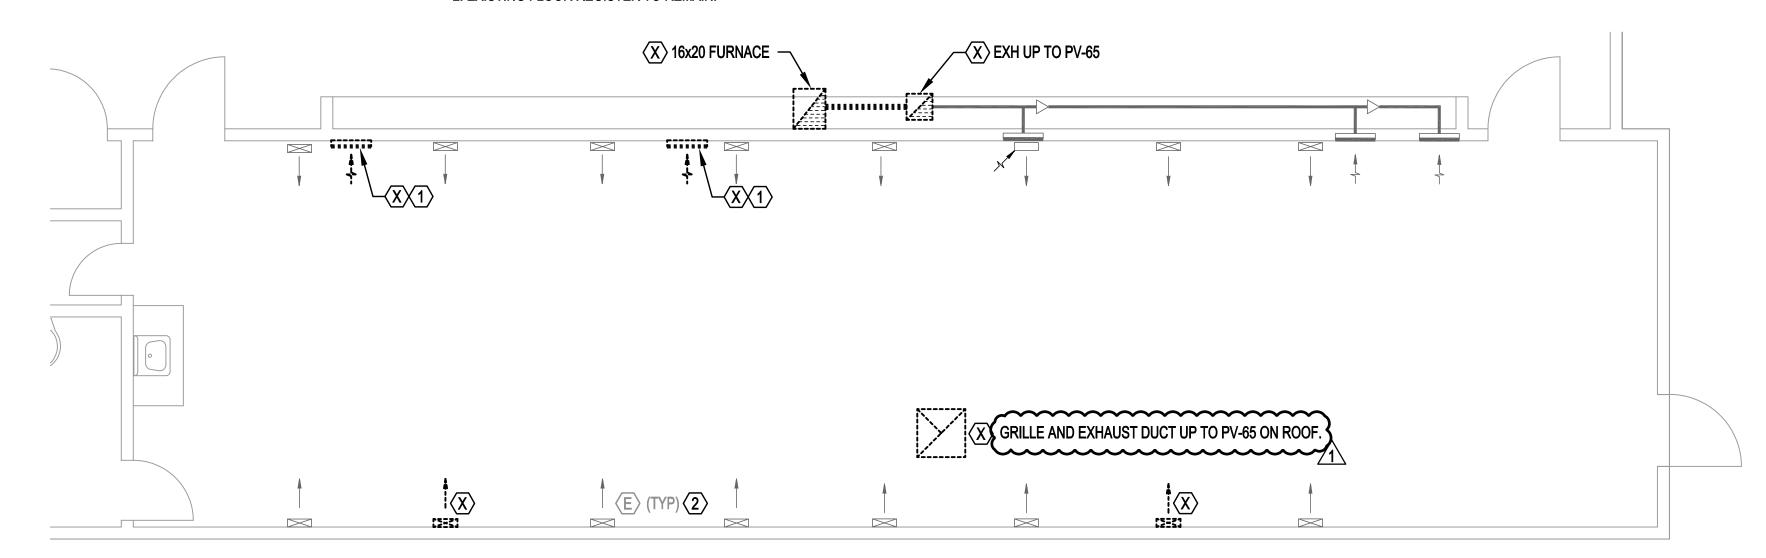

PARTIAL DEMOLITION - MECHANICAL

MD.1 1/4" = 1'-0"

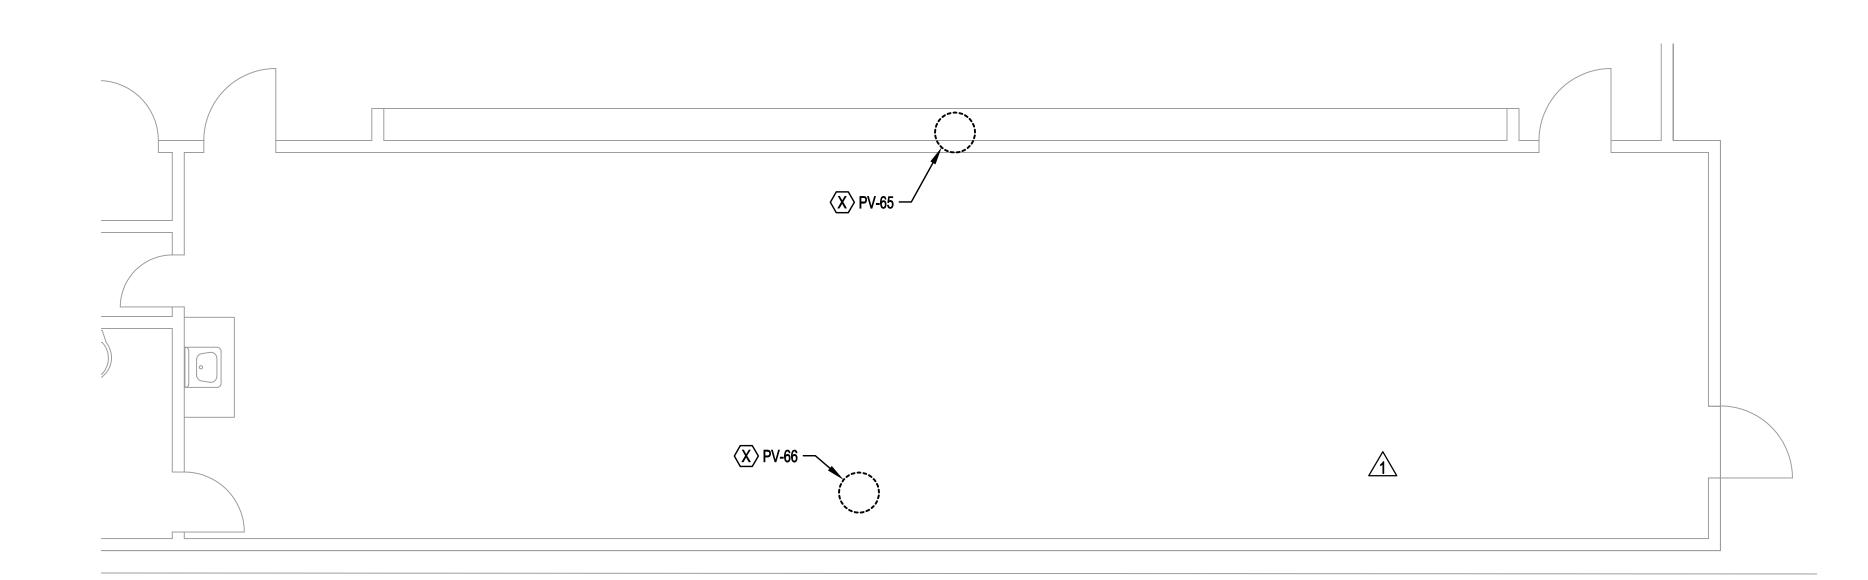

3 PARTIAL DEMOLITION ROOF PLAN - MECHANICAL

MD.1 1/4" = 1'-0"


**GENERAL NOTES:** 

A. ALL EXISTING CONDITIONS TO BE FIELD VERIFIED BY THE CONTRACTOR.


B. PATCH AND REPAIR ALL OPENINGS MADE BY REMOVALS.

C. DEMOLITION WORK SHALL INCLUDE BUT NOT BE LIMITED TO THE FOLLOWING: REMOVAL OF EQUIPMENT, SUPPORTS, ANCHORS, PIPING, DUCTWORK AND ALL APPURTENANCES WHERE INDICATED ON THE PLANS.

D. DEMO MECHANICAL EQUIPMENT, DUCTS AND ASSOCIATED ITEMS AS SHOWN OR RELATED TO EQUIPMENT TO BE REMOVED. CAP DUCTWORK AT NEAREST LIVE BRANCH.

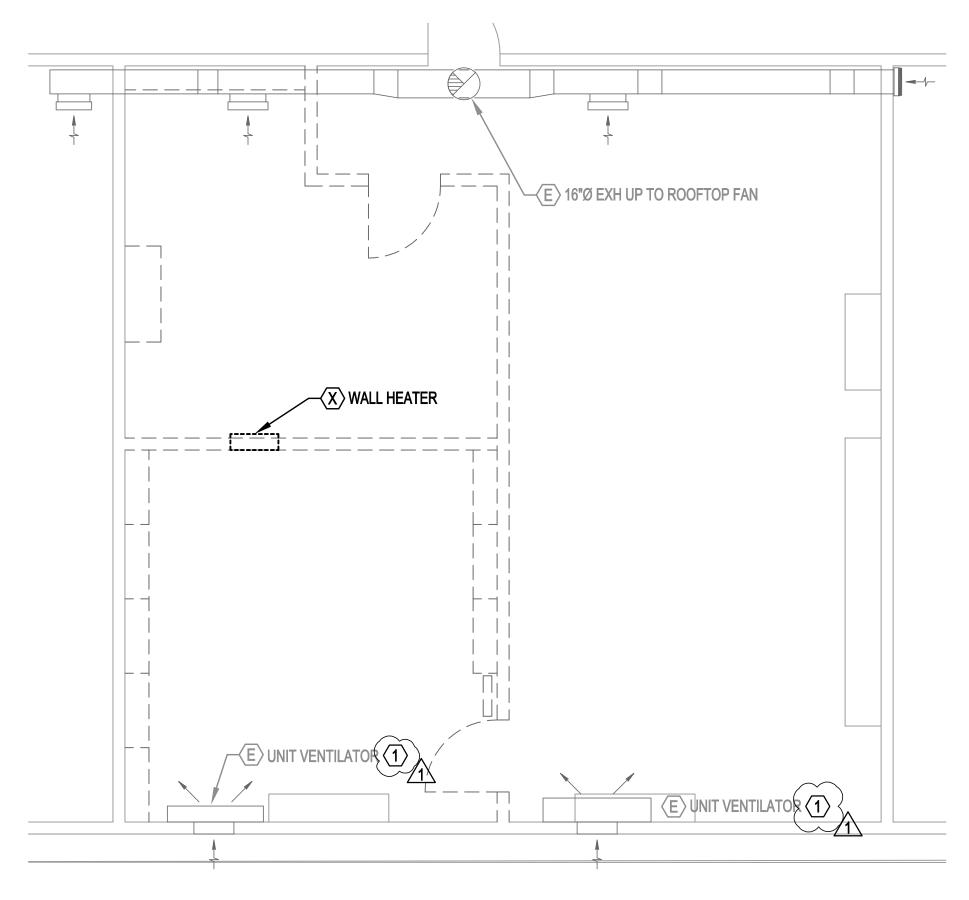




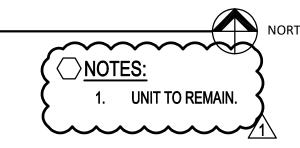

GMA ARCHITECTS

GMA ARCHITECTS
860 West Park Street / Ste 300
Eugene / Oregon / 97401
p 541.344.9157
gma-arch.com

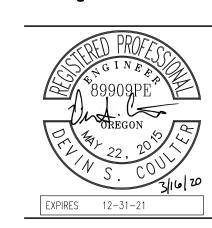



oae-engineers.com

REVISIONS

3/17/2020 ADD. 1

4) NORTH EUGENE HIGH SCHOOL IMPROVEMENTS

200 SILVER LN, EUGENE, OR 9740

PARTIAL

JOB NO:

PARTIAL DEMOLITION -MECHANICAL

**GENERAL NOTES:** 


A. ALL EXISTING CONDTIIONS TO BE FIELD VERIFIED BY THE CONTRACTOR.

B. PATCH AND REPAIR ALL OPENINGS MADE BY REMOVALS.

C. DEMOLITION WORK SHALL INCLUDE BUT NOT BE LIMITED TO THE FOLLOWING: REMOVAL OF EQUIPMENT, SUPPORTS, ANCHORS, PIPING, DUCTWORK AND ALL APPURTENANCES WHERE INDICATED ON THE PLANS.

D. DEMO MECHANICAL EQUIPMENT, DUCTS AND ASSOCIATED ITEMS AS SHOWN OR RELATED TO EQUIPMENT TO BE REMOVED. CAP DUCTWORK AT NEAREST LIVE BRANCH.



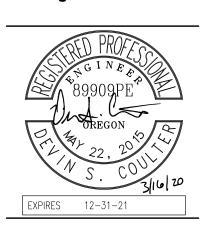





**REVISIONS** √1 3/17/2020 ADD. 1

**MPROVEMENTS** ESD 4J NORTH EUGENE HIGH SCHOOL IN


JOB NO: ISSUE DATE:

> PARTIAL **DEMOLITION -MECHANICAL**

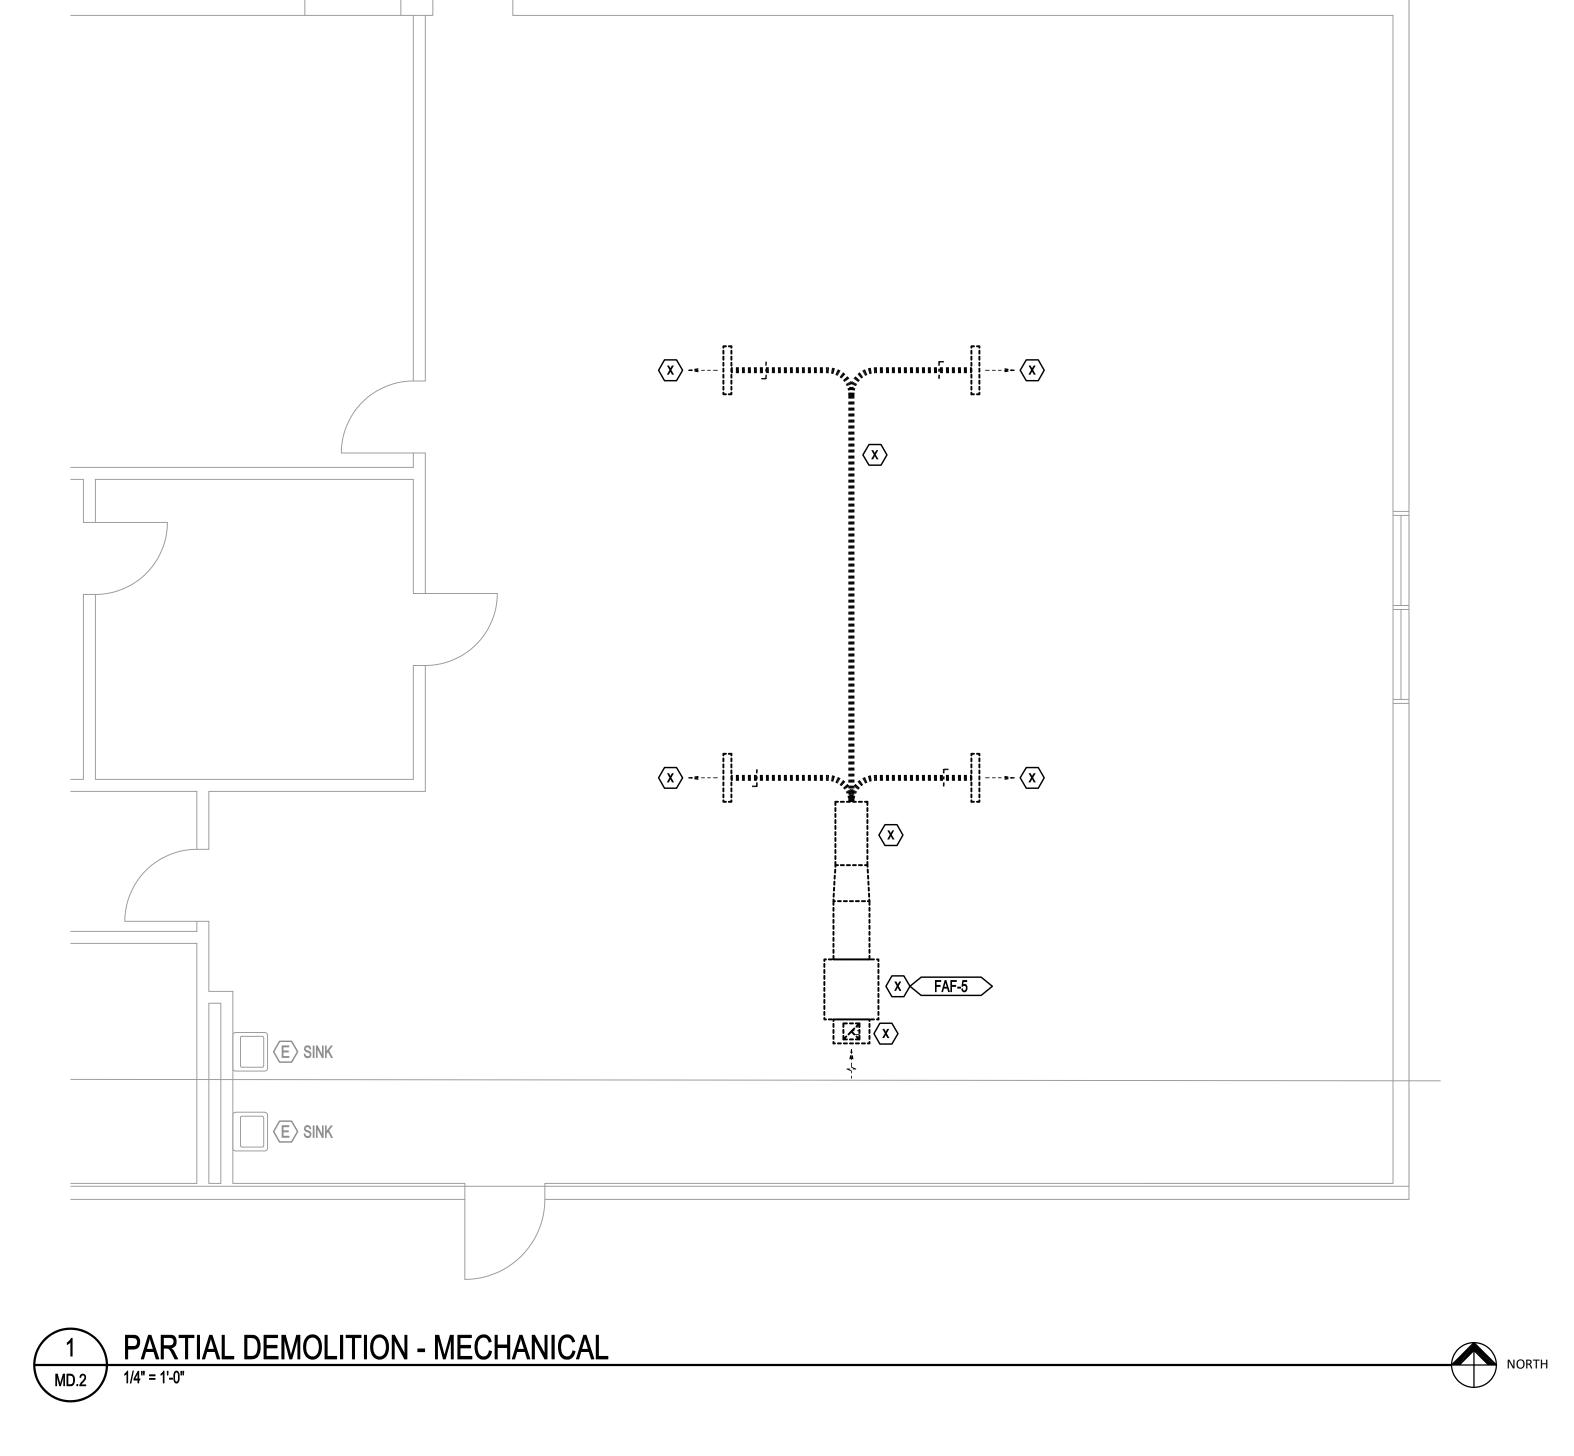

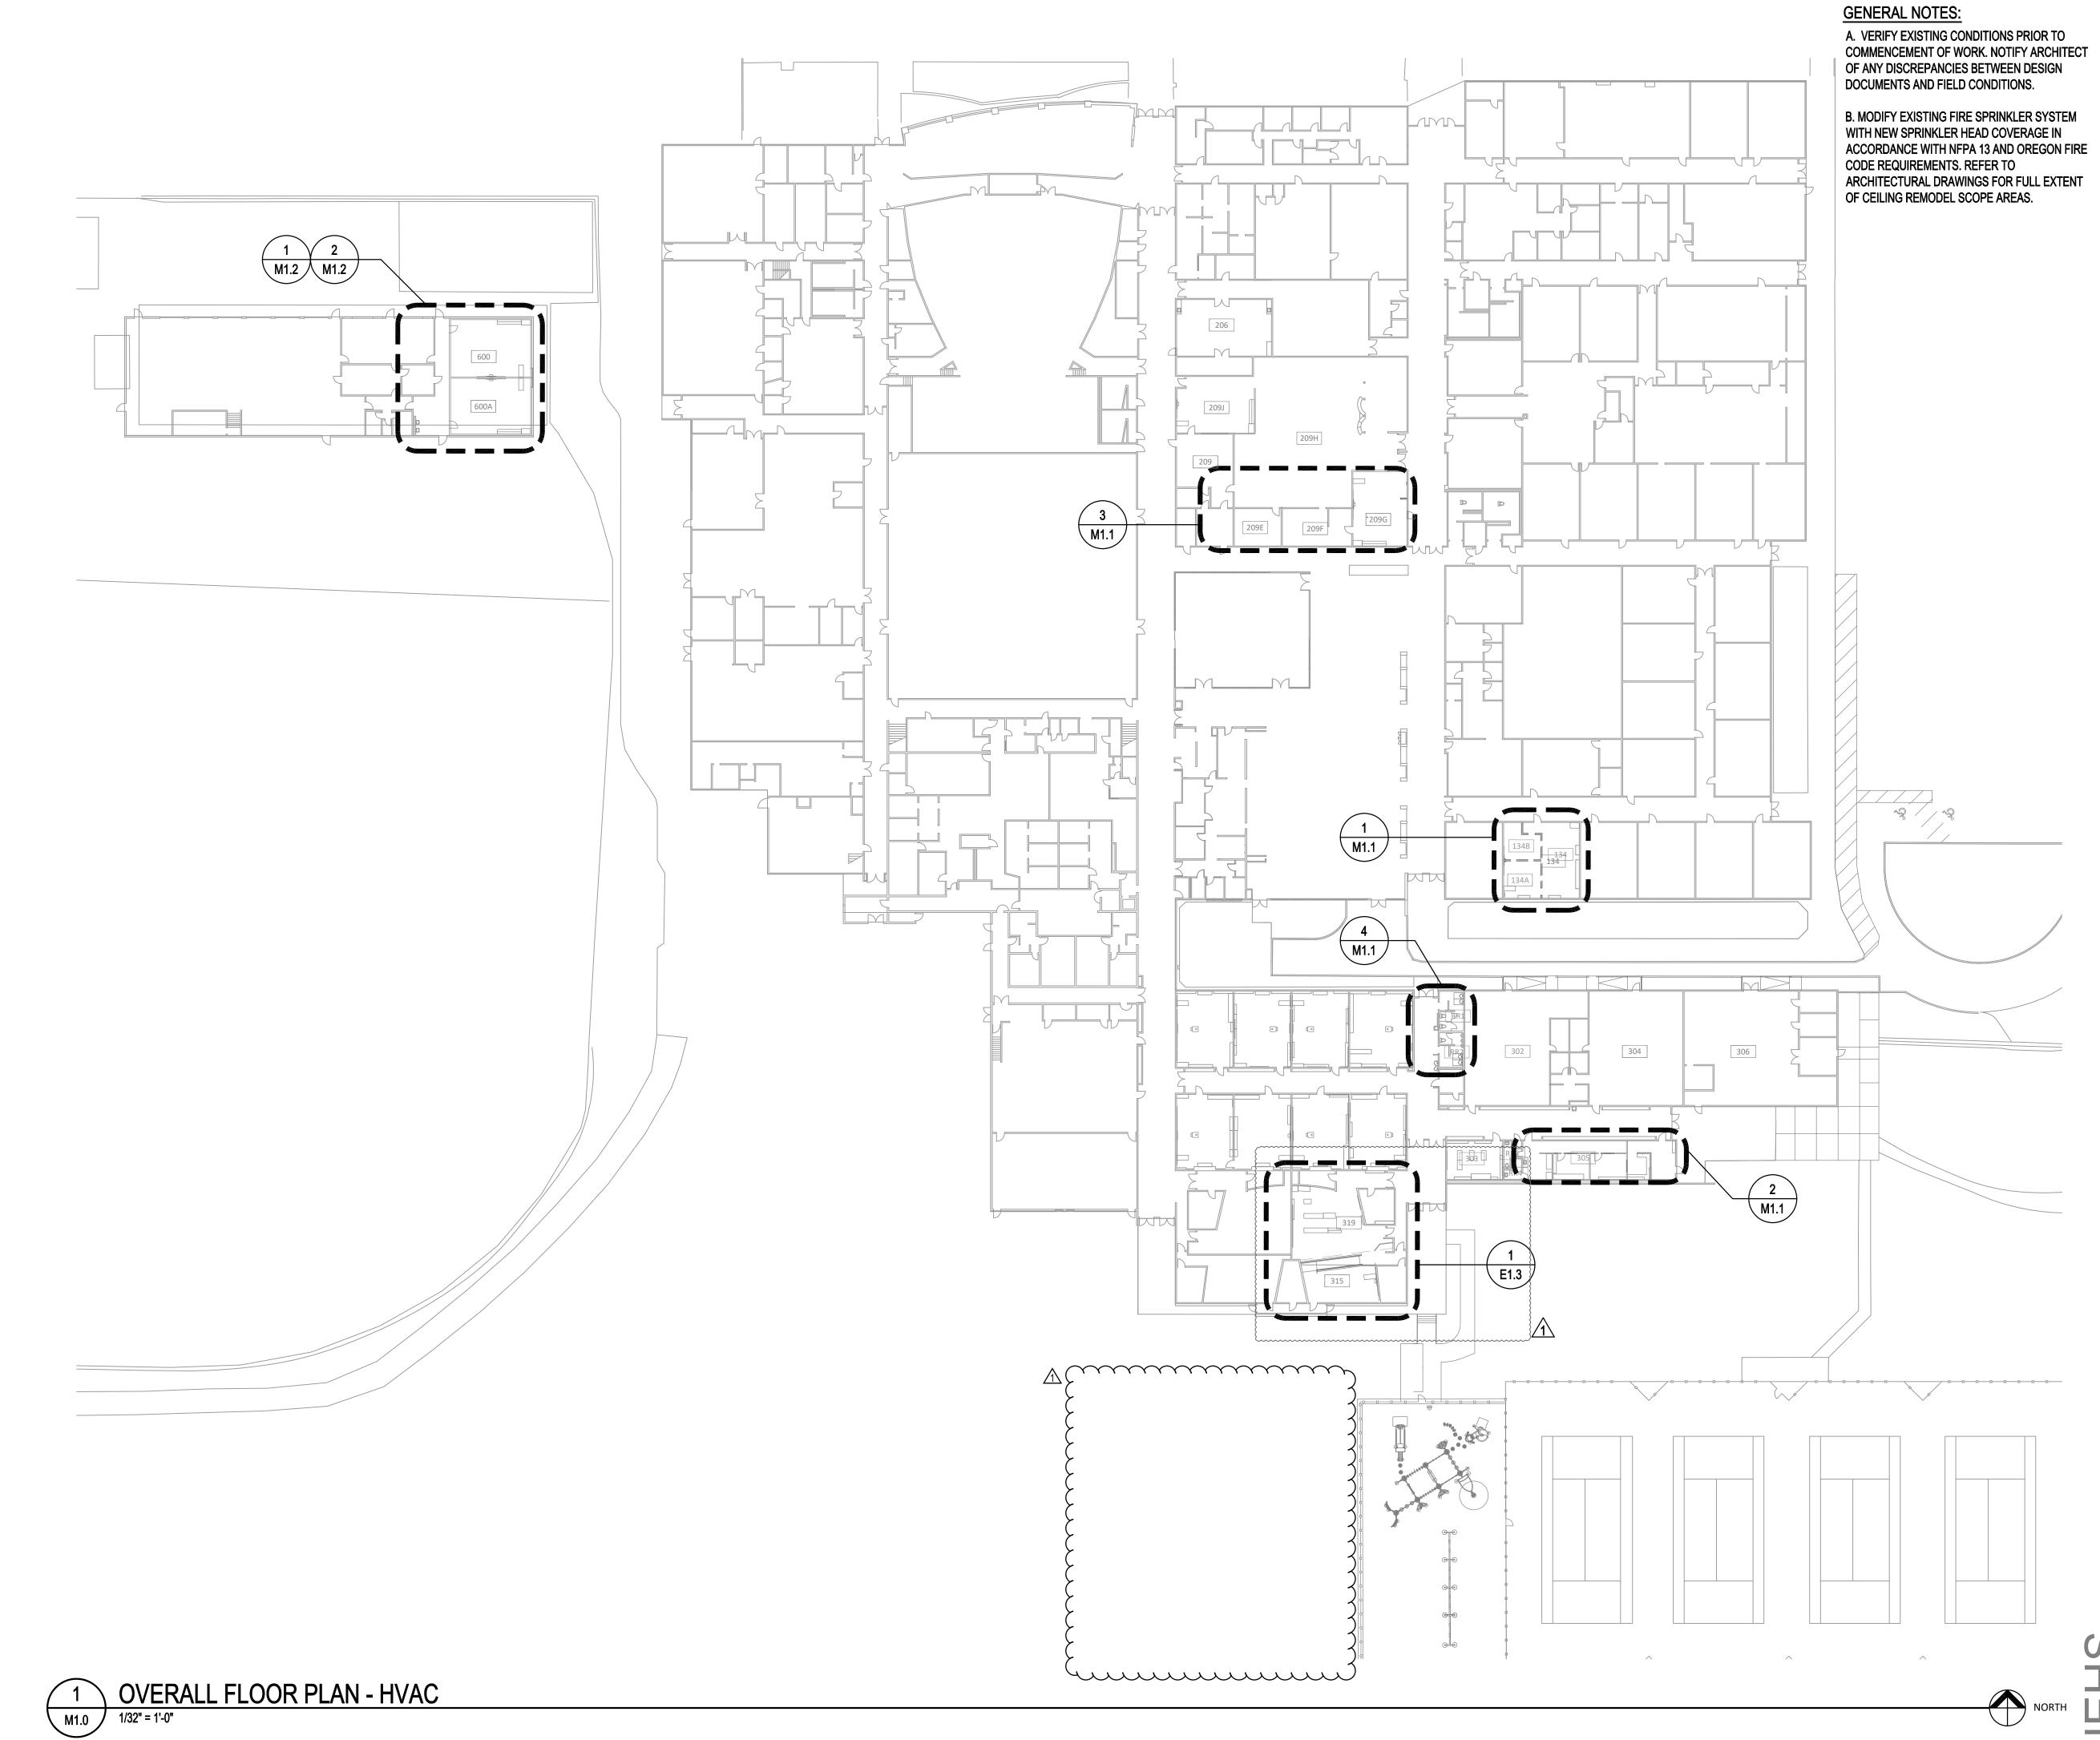

**GMA ARCHITECTS** 860 West Park Street / Ste 300 Eugene / Oregon / 97401 p 541.344.9157 gma-arch.com

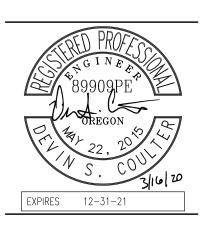




REVISIONS 1 3/17/2020 ADD. 1

**MPROVEMENTS** ESD 4J NORTH EUGENE HIGH SCHOOL II

JOB NO: ISSUE DATE:

OVERALL FLOOR PLAN - HVAC

M1.0

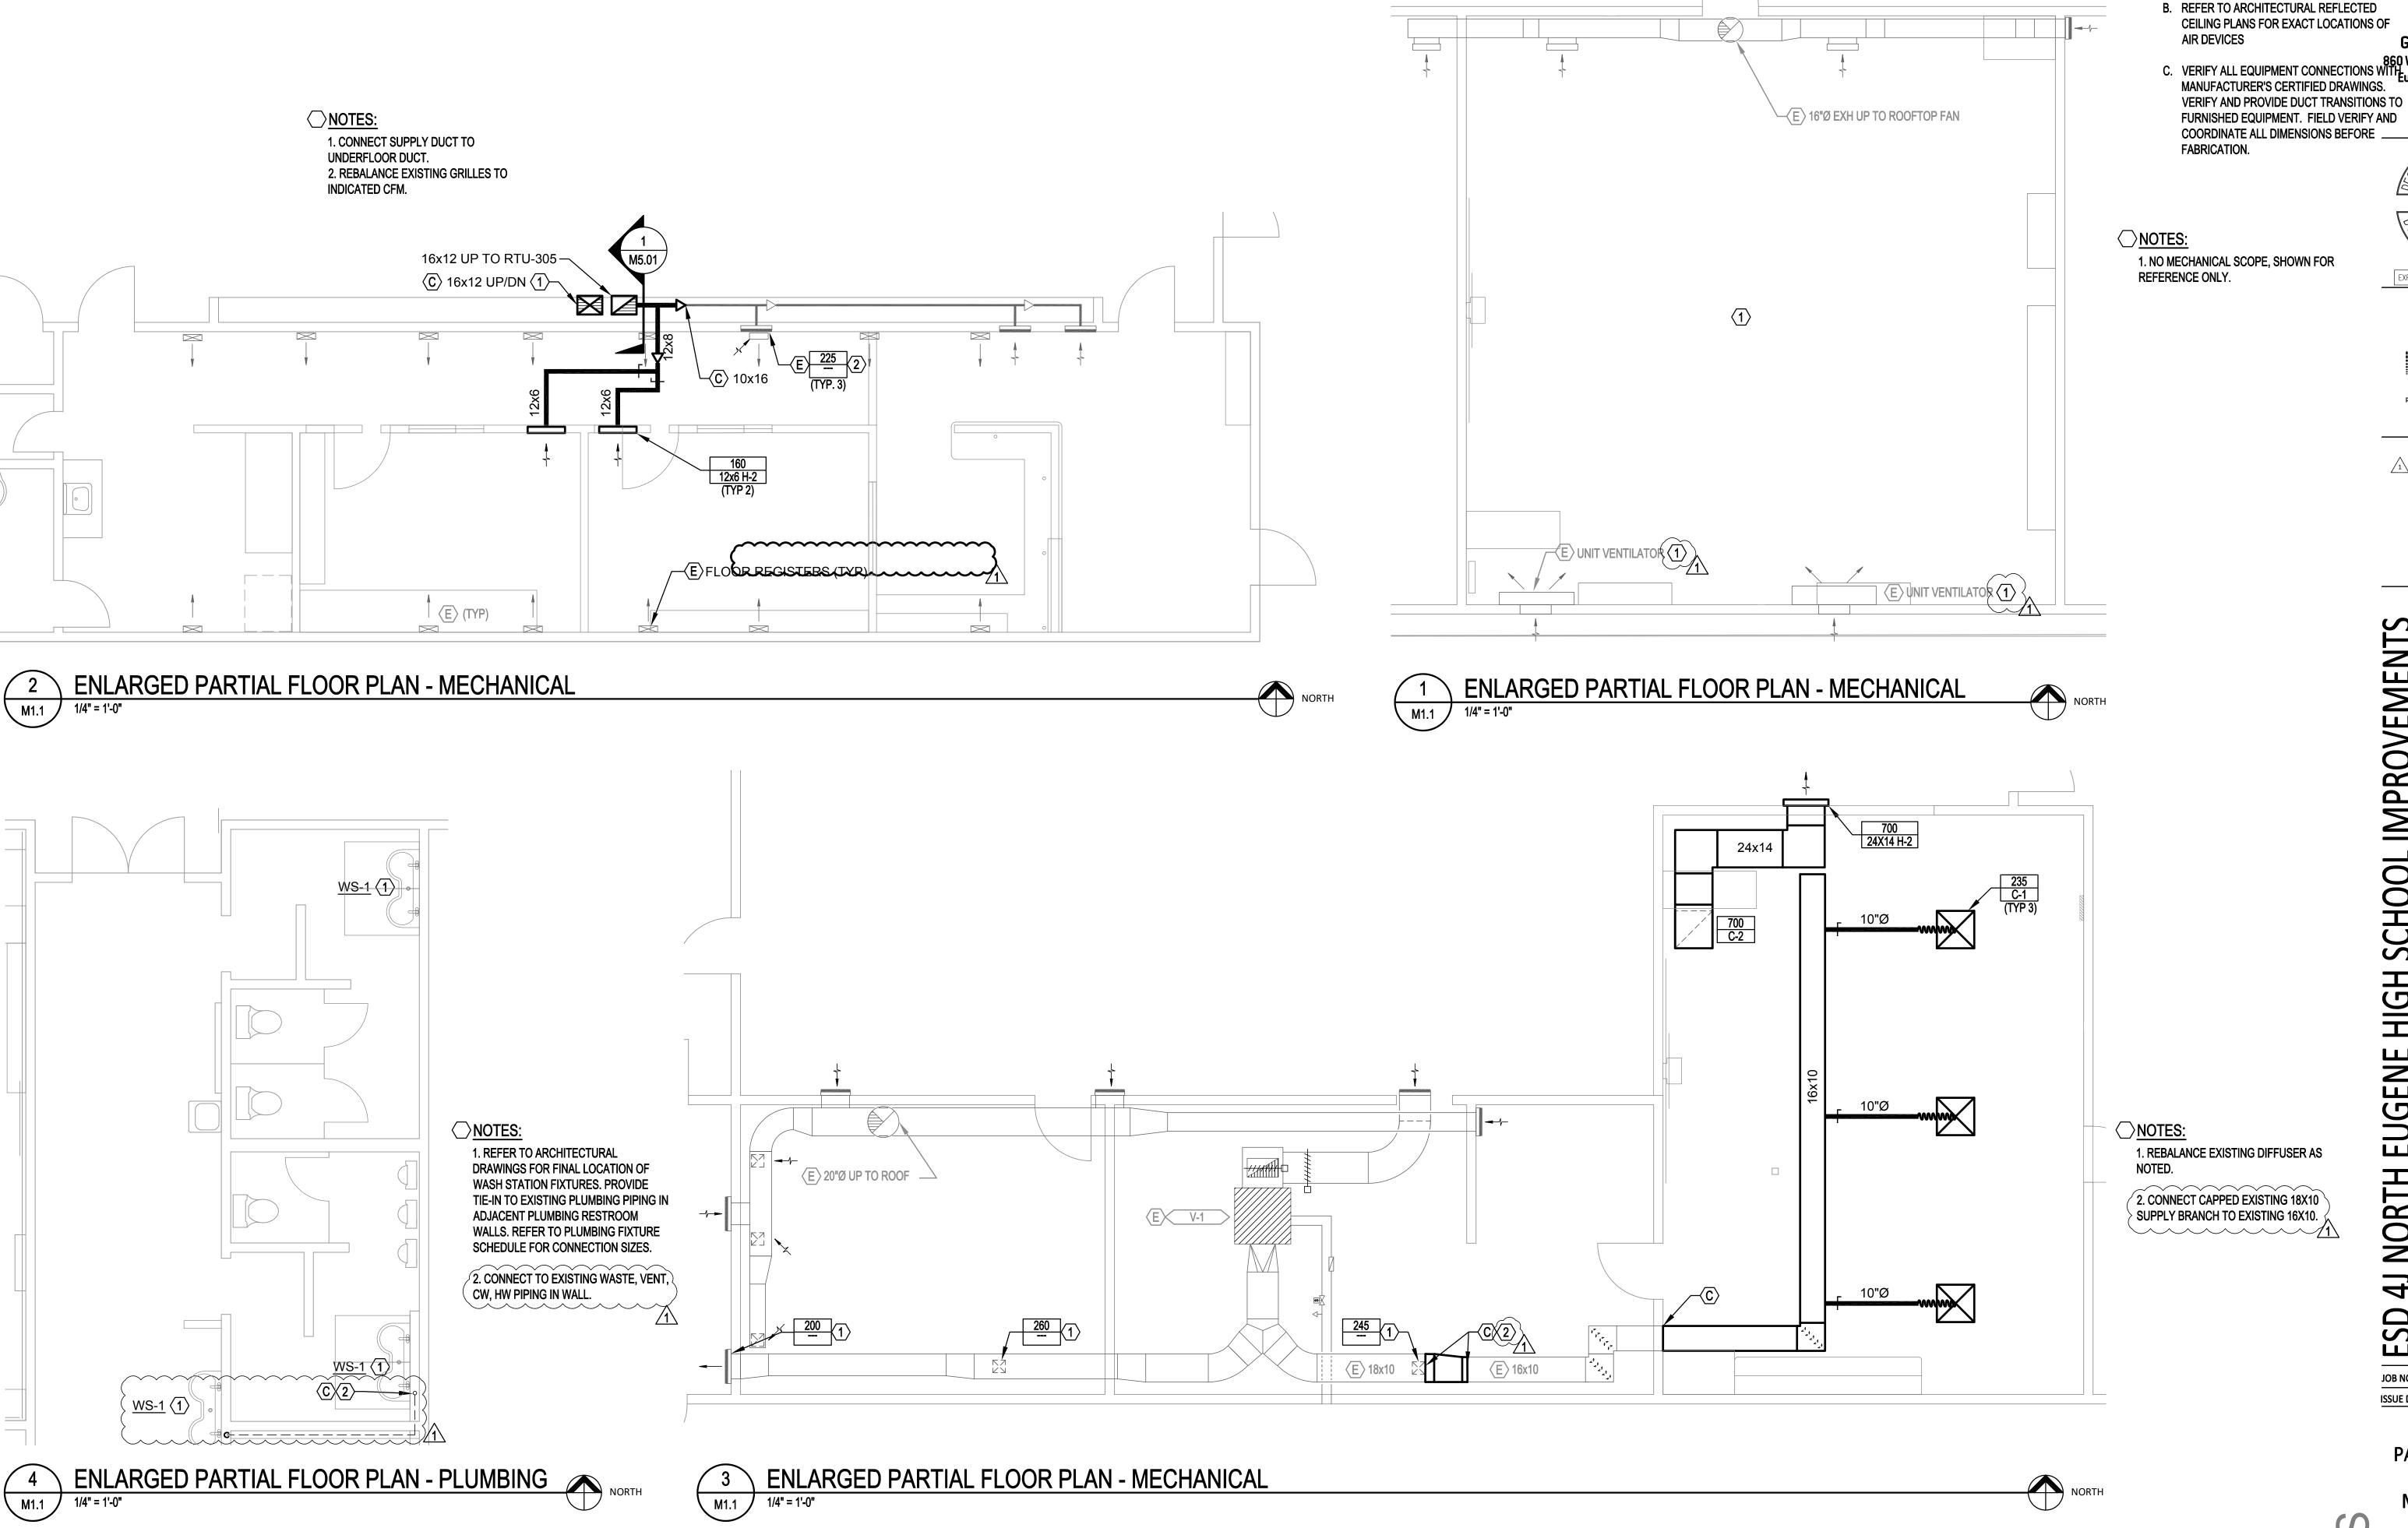

**GENERAL NOTES:** 

A. CONTROL WIRING AND THERMOSTATS

OWNER FURNISHED AND OWNER INSTALLED B. REFER TO ARCHITECTURAL REFLECTED

**GMA ARCHITECTS** 

860 West Park Street / Ste 300 p 541.344.9157

1. NO MECHANICAL SCOPE, SHOWN FOR

EXPIRES 12-31-21

**REVISIONS** 

3/17/2020 ADD. 1

**MPROVEMENTS** 

**EUGENE HIGH SCHOOL** NORTH

3 MAR 2020 ISSUE DATE:

**ENLARGED PARTIAL FLOOR** 

PLAN -**MECHANICAL** 

JOB NO:

M1.1

# **GENERAL NOTES:**


A. CONTROL WIRING AND THERMOSTATS
OWNER FURNISHED AND OWNER INSTALLED

B. PROVIDE CURB AND FLASH FOR ROOF MOUNTED UNITS

C. PROVIDE PIPE SUPPORTS FOR GAS PIPING ON ROOF.

D. REFER TO ARCHITECTURAL REFLECTED CEILING PLANS FOR EXACT LOCATIONS OF AIR DEVICES

F. VERIFY ALL EQUIPMENT CONNECTIONS WITH MANUFACTURER'S CERTIFIED DRAWINGS.
VERIFY AND PROVIDE DUCT TRANSITIONS TO FURNISHED EQUIPMENT. FIELD VERIFY AND COORDINATE ALL DIMENSIONS BEFORE FABRICATION.

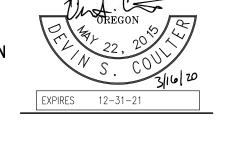



**REVISIONS** 


AND pae-engineers.com


**MPROVEMENTS** 

ESD 4J NORTH EUGENE HIGH SCHOOL IN

JOB NO:

ISSUE DATE:

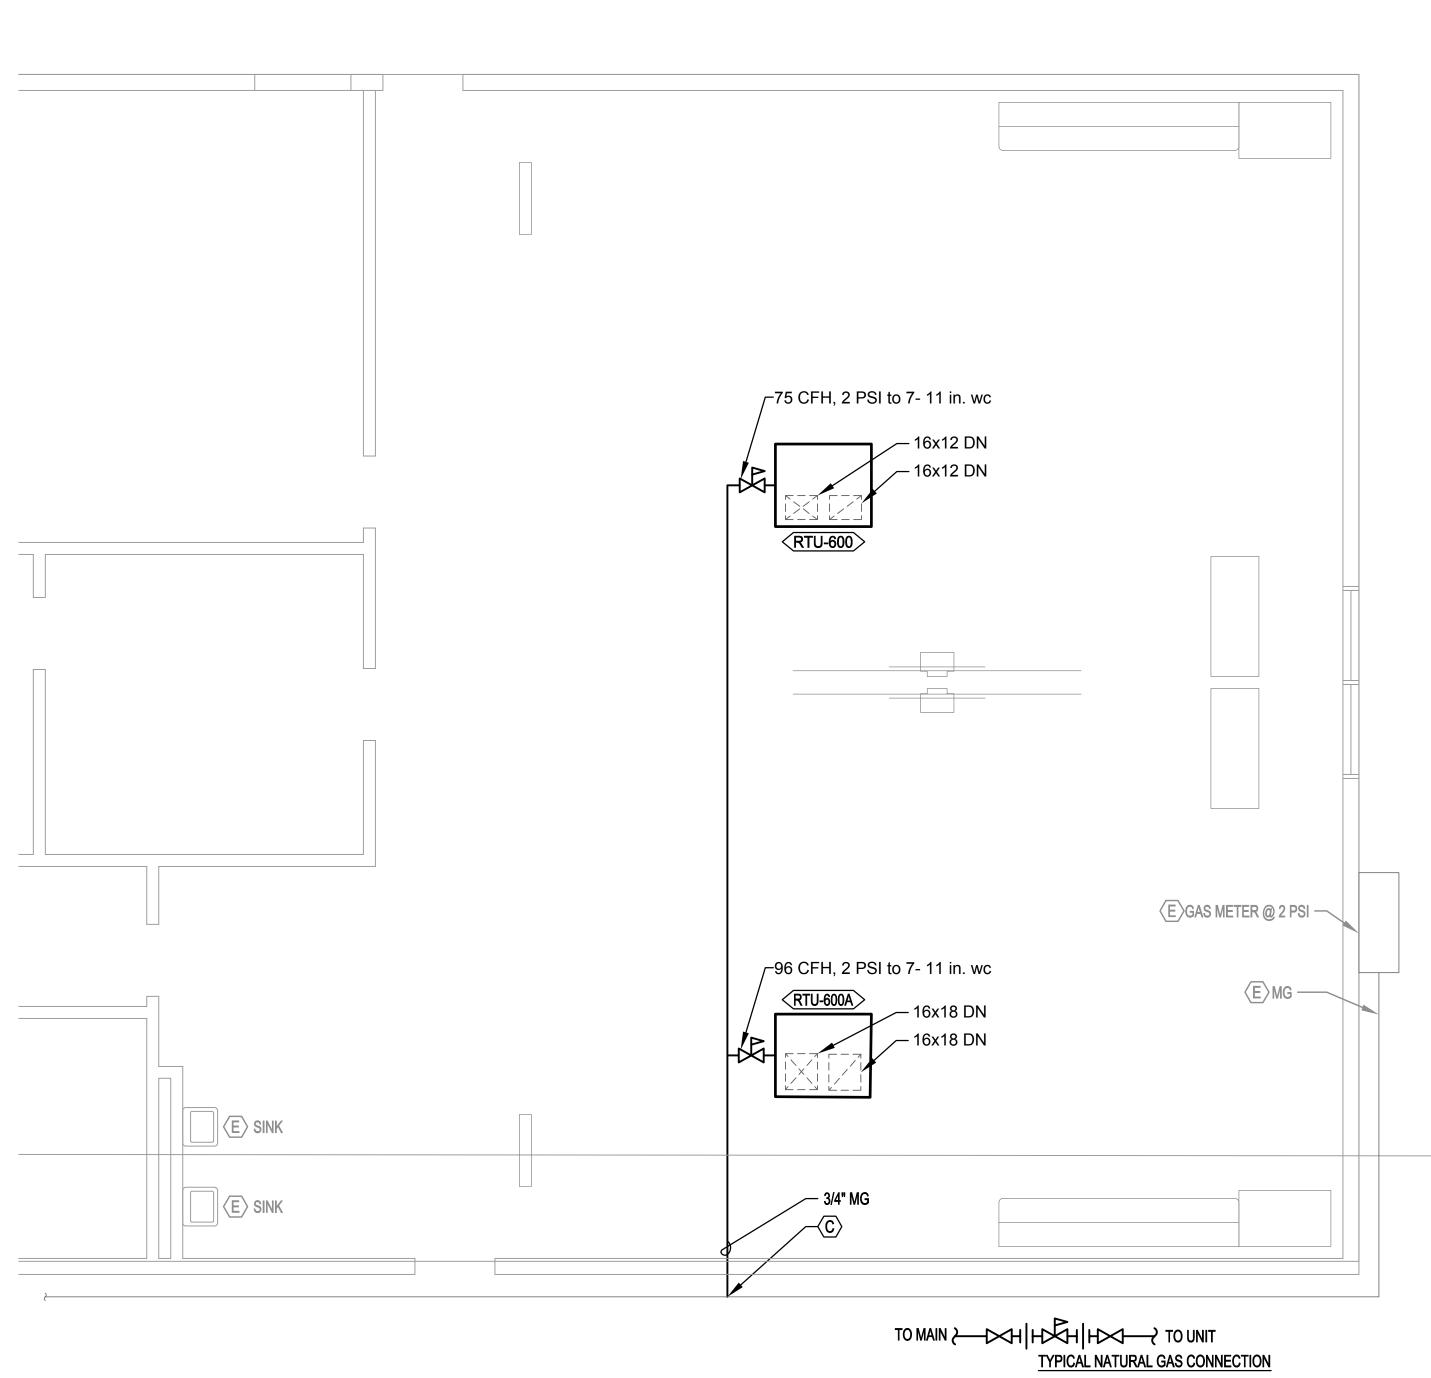

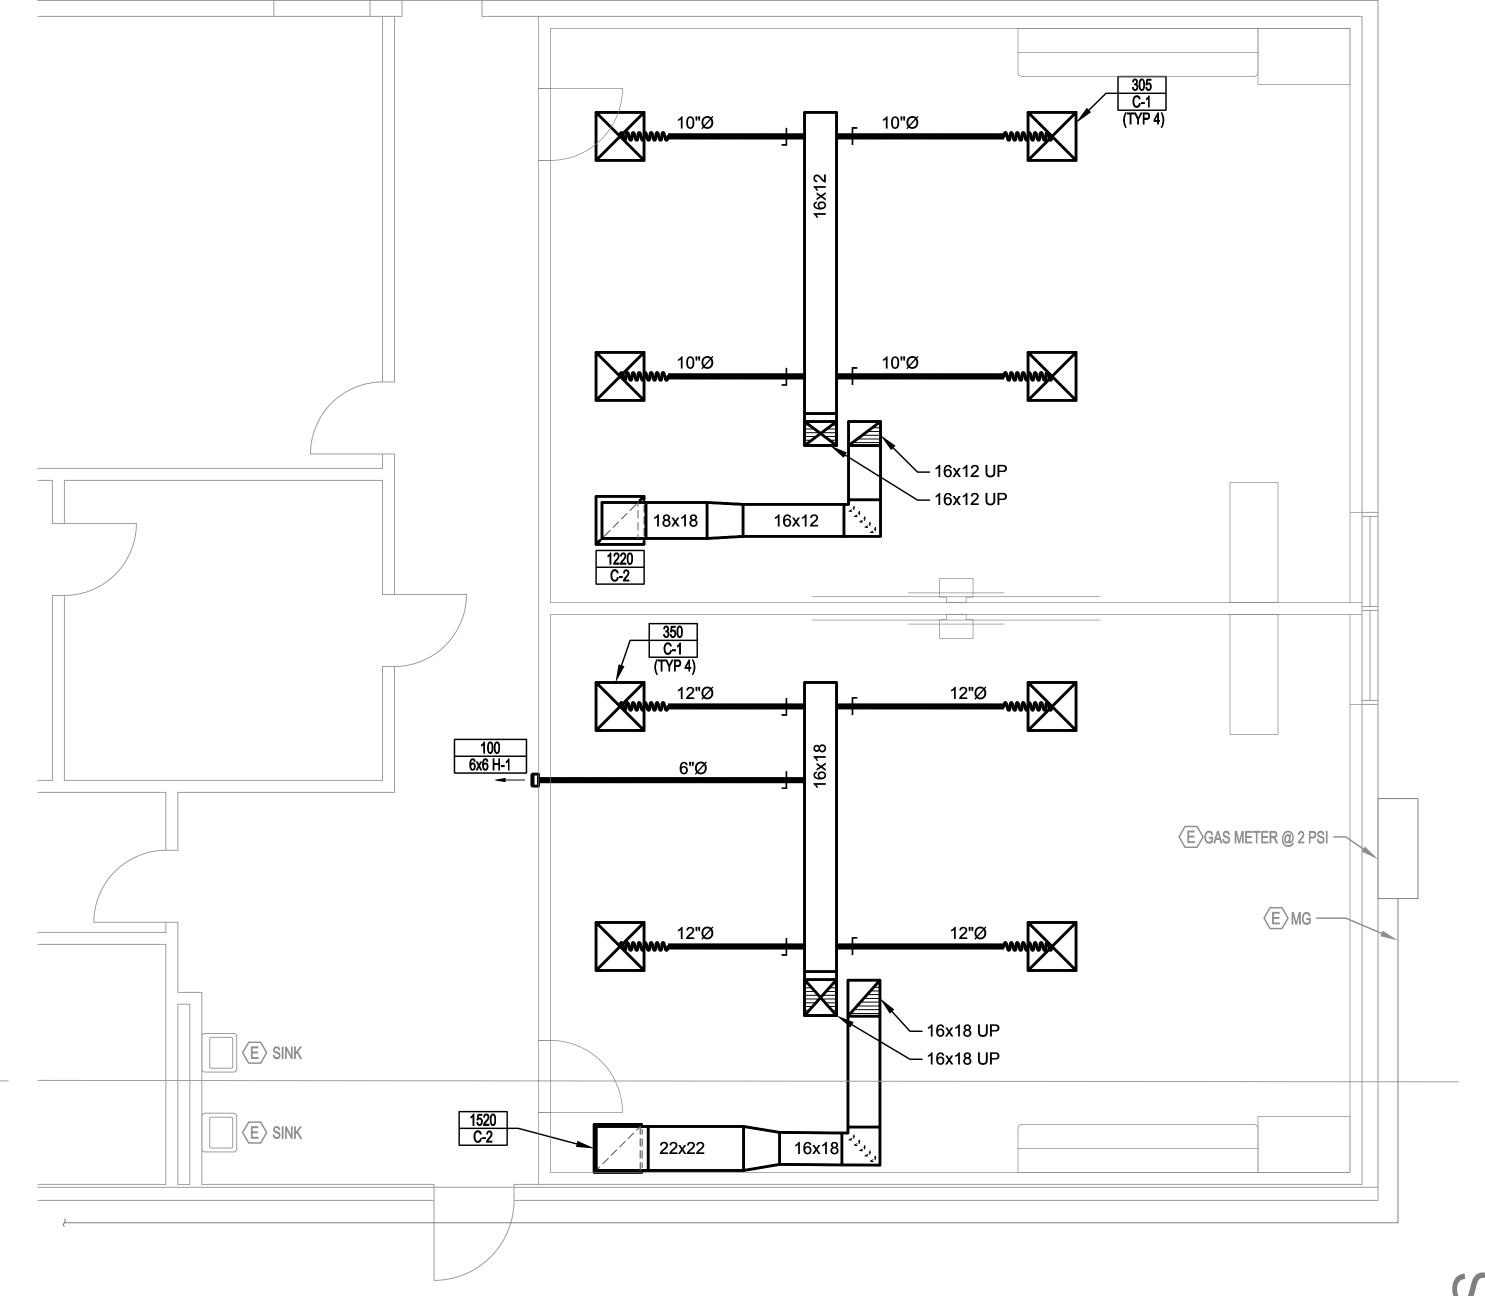

2 ENLARGED PARTIAL ROOF PLAN - MECHANICAL

1/4" = 1'-0"

NORTH

1 ENLARGED PARTIAL FLOOR PLAN - MECHANICAL

M1.2 1/4" = 1'-0"


PLAN -MECHANICAL

**ENLARGED** 

PARTIAL FLOOR


M1.2

3 MAR 2020

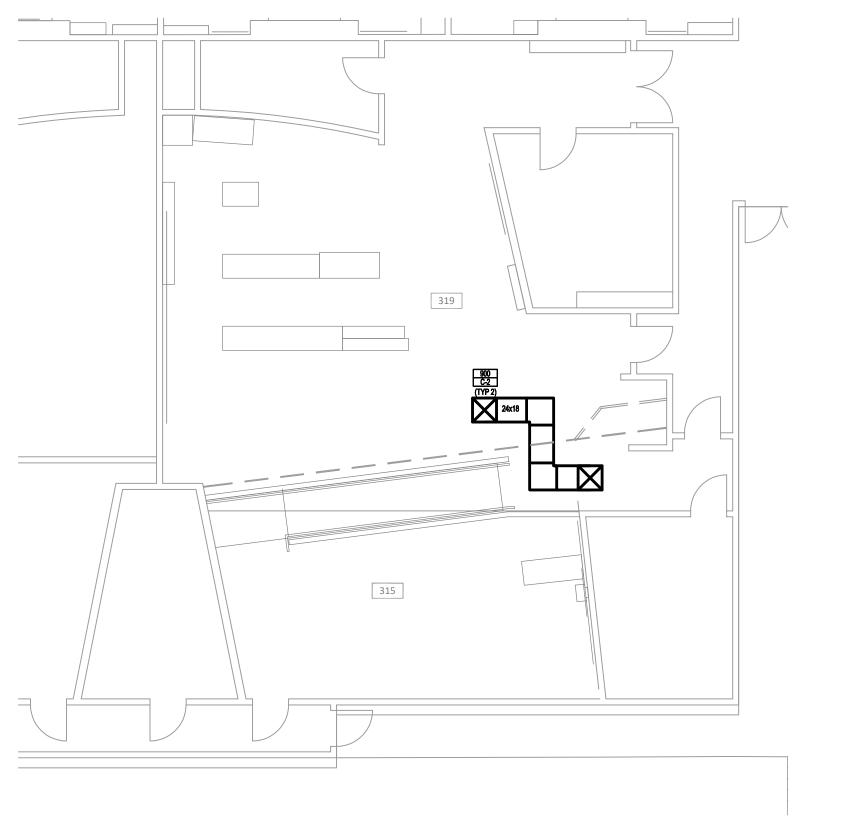





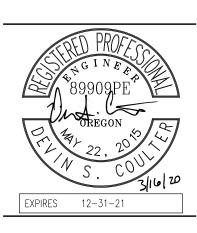



REVISIONS

3/17/2020 ADD. 1


ESD 4J NORTH EUGENE HIGH SCHOOL IMPROVEMENTS

200 SILVER LN, EUGENE, OR 9 RENOVATIONS

JOB NO:
ISSUE DATE:


ENLARGED PARTIAL FLOOR PLAN -MECHANICAL



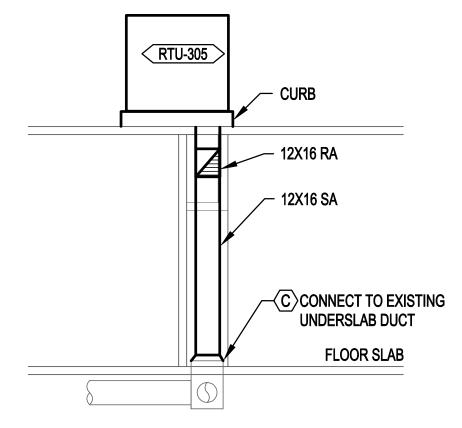


1 RTU-305 SECTION

SCALE: NONE

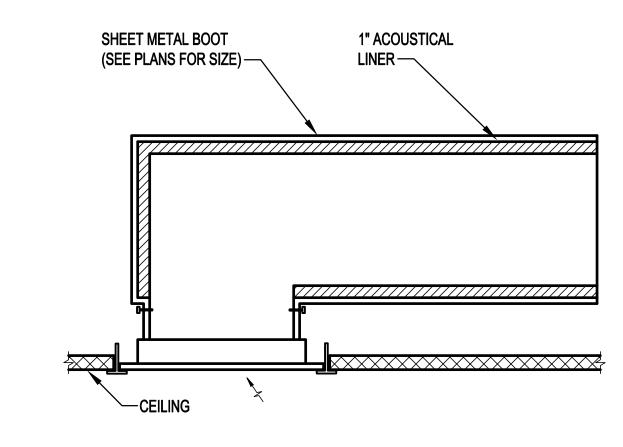

RETURN AIR BOOT
SCALE: NONE

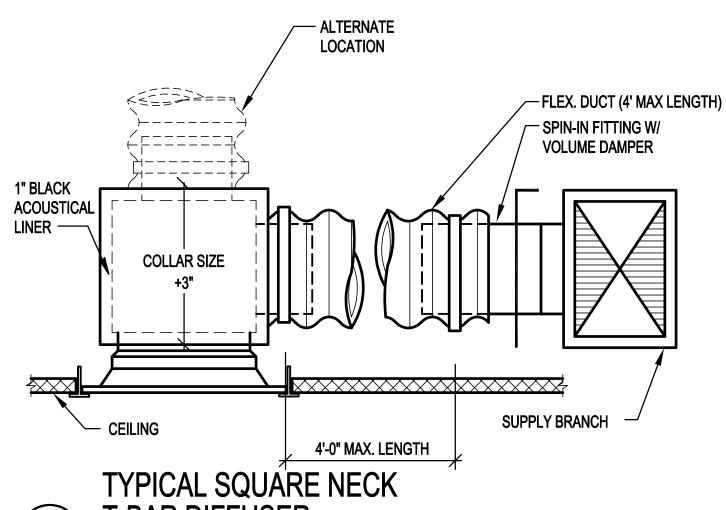

TYPICAL SQUARE NECK
T-BAR DIFFUSER

M501 SCALE: NONE

ESD 4J NORTH EUGENE HIGH SCHOOL II

308 801

200 SILVER LN, EUGENE, OR 97404

RENOVATIONS

**GMA ARCHITECTS** 

860 West Park Street / Ste 300 Eugene / Oregon / 97401 p 541.344.9157 gma-arch.com


pae-engineers.com


**MPROVEMENTS** 


REVISIONS


DETAILS -MECHANICAL


<u>М</u>5.0

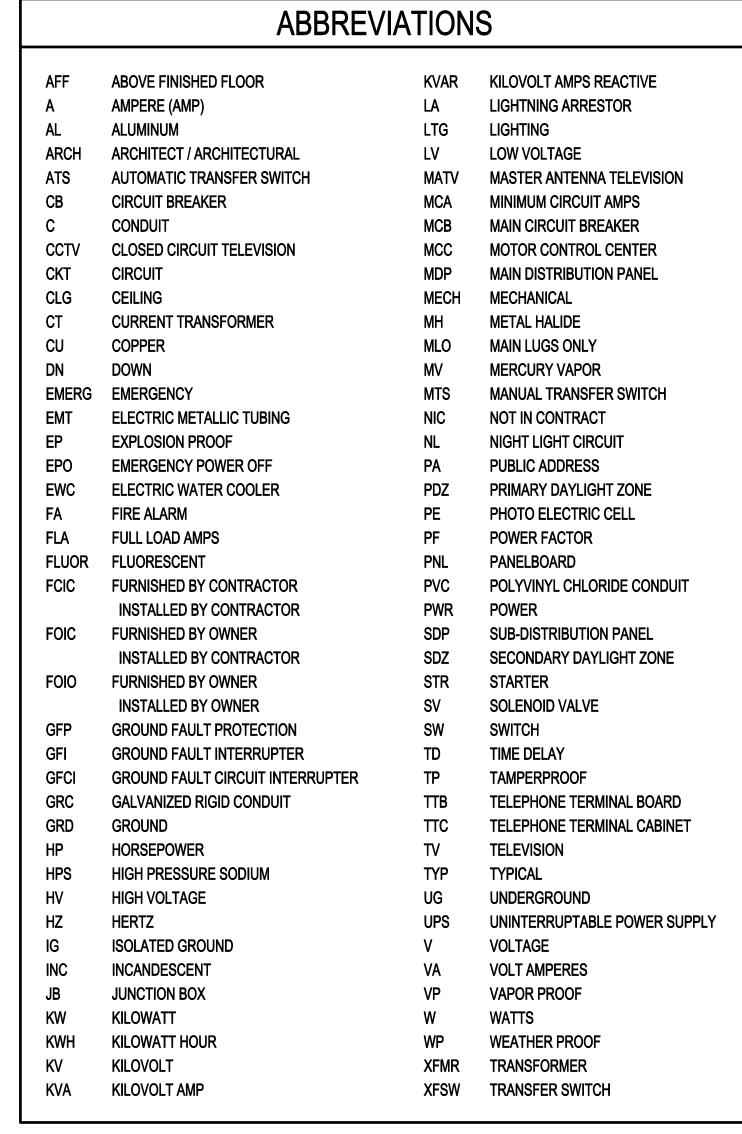

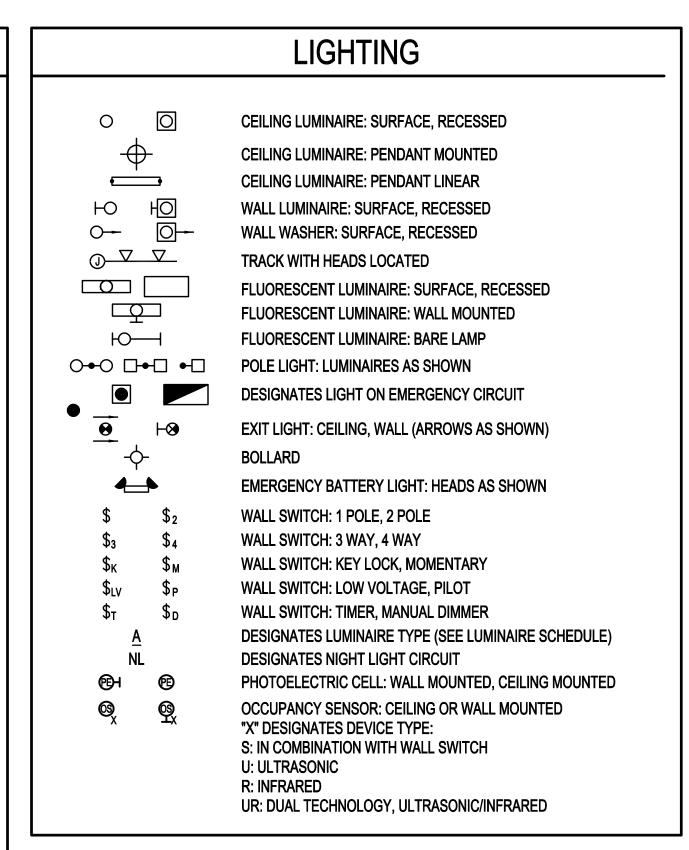

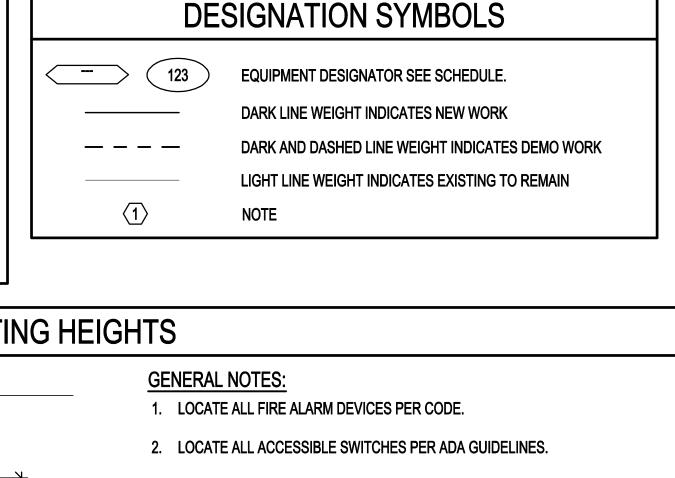


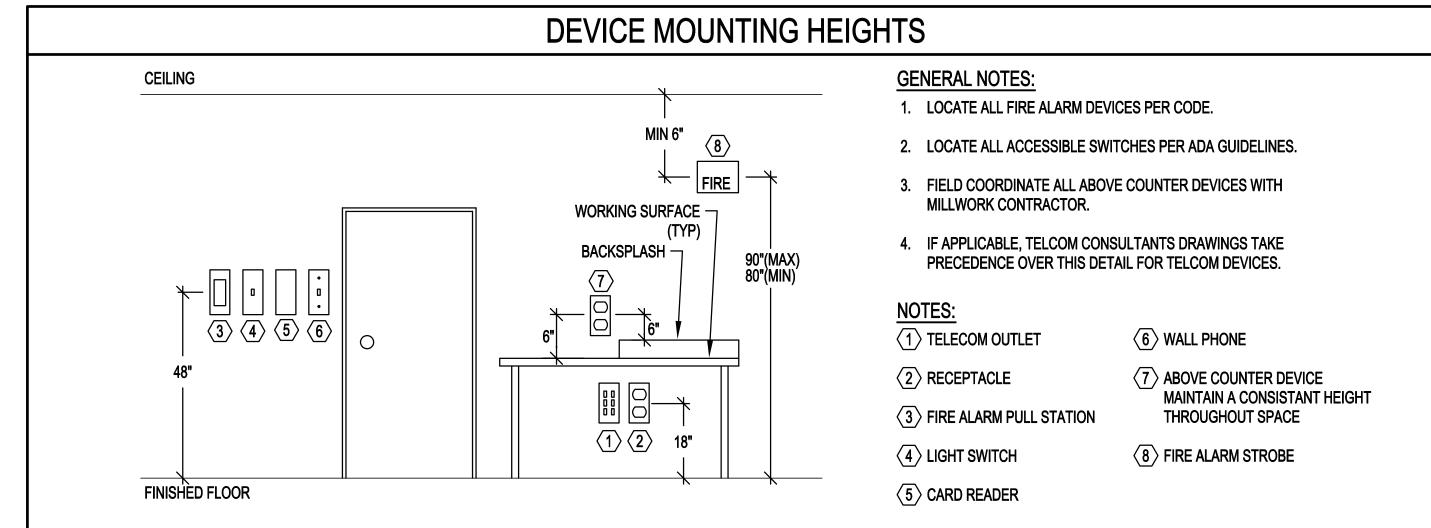

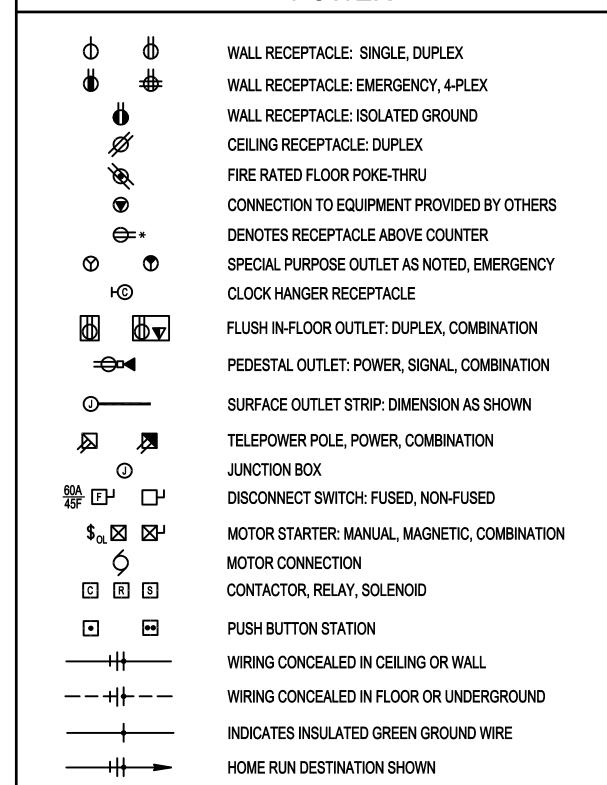

CONDUIT ELL: UP, DN.

**POWER** 

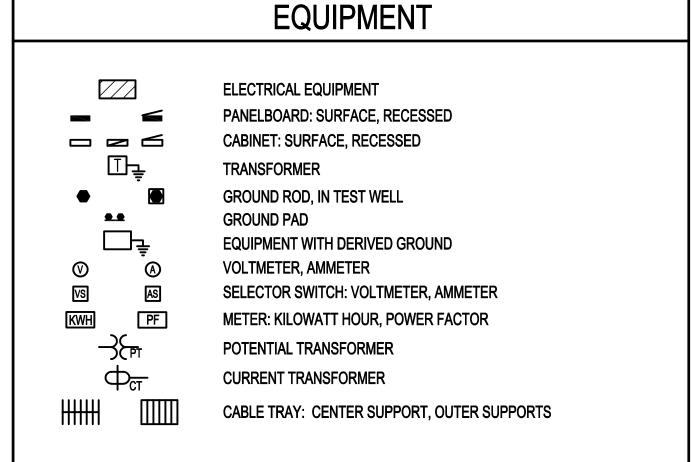

**ONE-LINE** 

**CIRCUIT BREAKER** 

BUSS

METER

PANEL

W

XXX

**∠**(X)

XXX

**©** 


SWITCH, FUSED SWITCH


**AUTOMATIC SWITCH** 


FEEDER CALLOUT

**GENERATOR** 

**FAULT CURRENT CALLOUT** 

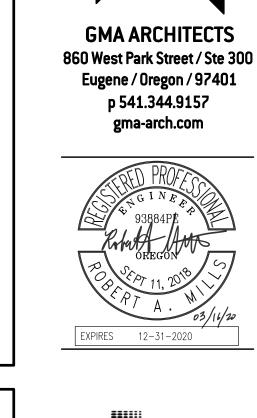

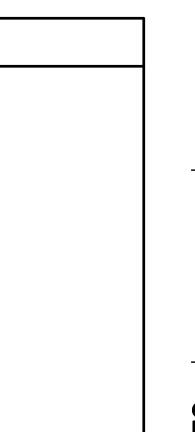

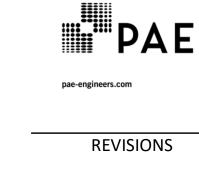

# NOTE

THIS IS A STANDARD LEGEND SHEET, THEREFORE, SOME SYMBOLS MAY APPEAR ON THIS SHEET THAT DO NOT APPEAR ON THE DRAWINGS.

ESD 4J NORTH EUGENE HIGH SCHOOL IMPROVEMENTS

200 SILVER LN, EUGENE, OR 97 RENOVATIONS

OB NO:

SYMBOLS,
LEGENDS AND

**ABBREVIATIONS -**

**ELECTRICAL** 

E0.01

|                                   |                                                                      |   | EQI   | UIPM   | 1ENT   | CONN   | IECTIC   | N SC   | CHEDUL   | E   |   |   |   |   |   |             |
|-----------------------------------|----------------------------------------------------------------------|---|---|---|---|---|---|---|---|---|---|---|---|---|---|-------------|
| EQUIPMENT DESCRIPTIONS            |                                                                      |   | ELECTRI   | ICAL CH   | IARACTER   | ISTICS   |   |   | CONNECTIO   | N CHARACTER   | ISTICS   | FE   | EDER CHARACTER   | RISTICS PANE   | L INFORM   | TION NOTES  |
| DESCRIPTION                       | LOCATION                                                             | KW   | HP   | FLA   | MOCP   | VOLTS   | PHASE   | VFD   | 1-POINT<br>CONNECT   | STARTER<br>DIVISION   | DISCONNECT<br>DIVISION   | CONDUIT<br>DIA (INCH)   | PHASE<br>CONDUCTORS   | GROUND<br>CONDUCTOR   | PANEL<br>NAME   |             |
|                                   |                                                                      |   |   |   |   |   |   |   |   |   |   |   |   |   |   |             |
|                                   |                                                                      |   |   |   |   |   |   |   |   |   |   |   |   |   |   |             |
|                                   |                                                                      |   |   |   |   |   |   |   |   |   |   | $\sim$ 1   |   |   |   |             |
| PACKAGED ROOFTOP UNIT W/GAS       | 600 CLASSROOM ROOF                                                   |   |   | 16.40   | 30   | 208   | 3   | NO   | YES   | -   | 26   | 3/4"   | 10AWG   | 10 AWG   | В   |             |
| PACKAGED ROOFTOP UNIT W/GAS       | 600A CLASSROOM ROOF                                                  |   |   | 21.70   | 35   | 208   | 3   | NO   | YES   | -   | 26   | 3/4"   | 10AWG   | 10 AWG 🟒   | 1 B   |             |
| PACKAGED ROOFTOP UNIT W/HEAT PUMP | 305 MAIN OFFICE ROOF                                                 |   |   | 34.54   | 50   | 208   | 1   | NO   | YES   | -   | 26   | 3/4"   | 6 AWG   | 10 AWG   | ( DD2   |             |
|                                   |                                                                      |   |   |   |   |   |   |   |   |   |   |   |   | •   |   |             |


### GENERAL NOTES: (SOME MAY NOT BE USED ON THIS SHEET)

- A. REFER TO ONE-LINE DIAGRAM OR PANEL SCHEDULES FOR OVERCURRENT PROTECTION CHARACTERISTICS AND CIRCUIT NUMBERS.
- B. COORDINATE ALL EQUIPMENT CONNECTION REQUIREMENTS WITH INSTALLING CONTRACTOR PRIOR TO THE INSTALLATION OF ANY ELECTRICAL WORK.
- C. VFD'S ARE FURNISHED BY DIVISION 23. INSTALL VFD AND PROVIDE PROVIDE LINE AND LOAD SIDE FEEDERS IN ELECTRICAL WORK.
- D. COMBINATION STARTER/DISCONNECTS AND DISCONNECT SWITCHES SHALL BE LOCATED WITHIN SIGHT OF AND ADJACENT TO EQUIPMENT SERVED. COORDINATE DISCONNECT INSTALLATION AND LOCATION WITH EQUIPMENT INSTALLER.
- E. NOT ALL EQUIPMENT IDENTIFIED HERE IS SHOWN ON FLOOR PLANS. REFER TO DRAWINGS IN OTHER DISCIPLINES FOR EQUIPMENT LOCATIONS.

|             |                        |                                 |         | LUMINA      | IRE SCHED             | ULE                                 |                  |                  |                              |                              |
|-------------|------------------------|---------------------------------|---------|-------------|-----------------------|-------------------------------------|------------------|------------------|------------------------------|------------------------------|
| TURE<br>YPE | PRODUCT DESCRIPTION    | BASIS OF DESIGN<br>MANUFACTURER | SIZE    | INPUT WATTS | LAMP SOURCE           | DRIVER / BALLAST                    | INPUT<br>VOLTAGE | FINISH           | MOUNTING                     | NOTES                        |
| L1          | SUSPENDED LED          | LITHONIA - GRAD LINEAR          | 4'      | 25          | LED, 4000K<br>3401 LM | INTEGRAL<br>ELECTRONIC<br>0-10V     | 120              | PER<br>ARCHITECT | SUSPENDED 3'<br>FROM CEILING |                              |
| L5          | LED RECESSED FLATPANEL | TCP                             | 2' X 4' | 36          | LED, 4000K<br>3600 LM | INTEGRAL ELECTRONIC 0-10V DIM       | 120              | PER<br>ARCHITECT | CEILING RECESSEI             |                              |
| L6          | LED SURFACE MOUNT      | LA LIGHTING<br>COR200 SERIES    | 2' X 4' | 32          | LED, 4000K<br>2900 LM | INTEGRAL<br>ELECTRONIC<br>0-10V DIM | 120              | PER<br>ARCHITECT | WALL<br>MOUNTED              | TLED READY<br>MOUNTED AT 10' |







**REVISIONS** √1 3/17/2020 ADD. 1

NORTH EUGENE HIGH SCHOOL

JOB NO: ISSUE DATE:

**LUMINAIRE AND MECHANICAL EQUIPMENT SCHEDULE** 



REVISIONS

1 3/17/2020 ADD. 1

**ESD 4J NORTH EUGENE HIGH SCHOOL IMPROVEMENTS** JOB NO: ISSUE DATE:

**OVERALL DEMOLITION** 

PLAN


COPYRIGHT GMA ARCHITECTS 2019

ED.0 1/32" = 1'-0"

OVERALL DEMOLITION PLAN

PARTIAL DEMOLITION PLAN ED.1 1/8" = 1'-0"

NORTH

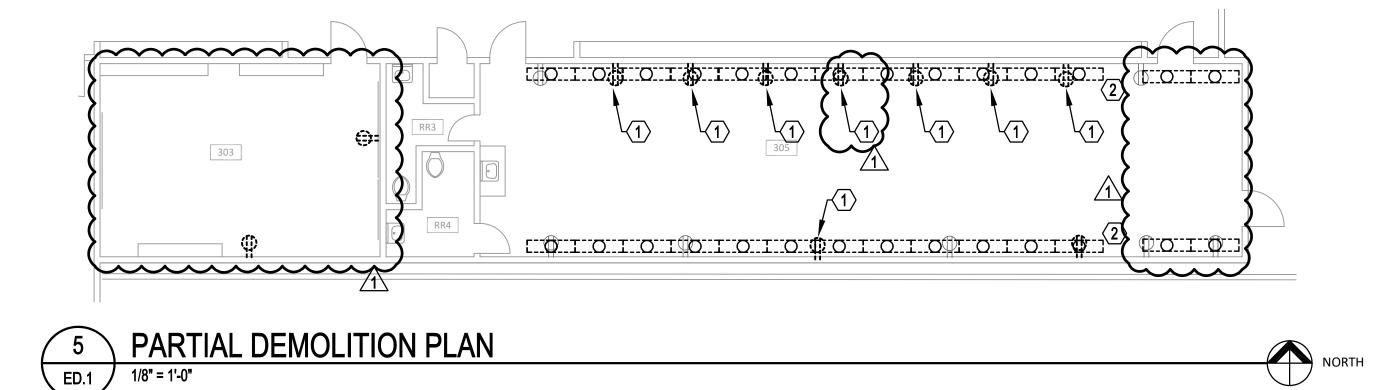



NORTH

A. CAREFULLY REMOVE AND OFFER TO THE OWNER ALL ELECTRICAL EQUIPMENT THAT IS TO BE REMOVED AND IN GOOD WORKING ORDER. REMOVE FROM PROJECT SITE AND PROPERLY DISPOSE ALL EQUIPMENT REJECTED BY THE

**GENERAL NOTES:** 

B. THE LOCATIONS OF ALL EQUIPMENT AND DEVICES MAY NOT BE SHOWN AND THESE PLANS DO NOT SHOW ALL OF THE DEMOLITION CONDITIONS. DEMOLITION INCLUDES THE REMOVAL OF ALL RACEWAY, CONDUCTORS, COMMUNICATION CABLING, LIGHT FIXTURES, DEVICES, ELECTRICAL EQUIPMENT, FIRE ALARM DEVICES, CABLES, HANGERS, AND SUPPORTS THAT ARE MADE OBSOLETE BY THE NEW WORK OR ARE ABANDONED AND NO LONGER IN USE.



Eugene / Oregon / 97401

p 541.344.9157 gma-arch.com



pae-engineers.com

**APROVEMENTS** 

NORTH EUGENE HIGH SCHOOL IN

ESD

JOB NO:

ISSUE DATE:

**REVISIONS** 3/17/2020 ADD. 1

2. DEMOLISH FIXTURE AND REMOVE CONDUIT AND

3. DEMOLISH SWITCHES AND BACKBOX AND REMOVE INFORMATION.

AREA.


# NOTES:

1. DEMOLISH RECEPTACLE AND BACKBOX AND REMOVE CONDUIT AND CONDUCTORS TO ABOVE ACCESSIBLE CEILING. SALVAGE CIRCUIT FOR EXTENSION TO NEW RECEPTACLE LOCATION. SEE SHEET E1.1 FOR ADDITIONAL INFORMATION.

CONDUCTORS TO JUNCTION BOX. SALVAGE CIRCUIT FOR EXTENSION TO NEW FIXTURE LOCATION. SEE SHEET E2.1 FOR ADDITIONAL INFORMATION.

CONDUIT AND CONDUCTORS TO ABOVE ACCESSIBLE CEILING. SALVAGE CIRCUIT FOR EXTENSION TO NEW SWITCH LOCATION. SEE SHEET E2.1 FOR ADDITIONAL

4. NO ELECTRICAL DEMOLITION SCOPE IN THIS

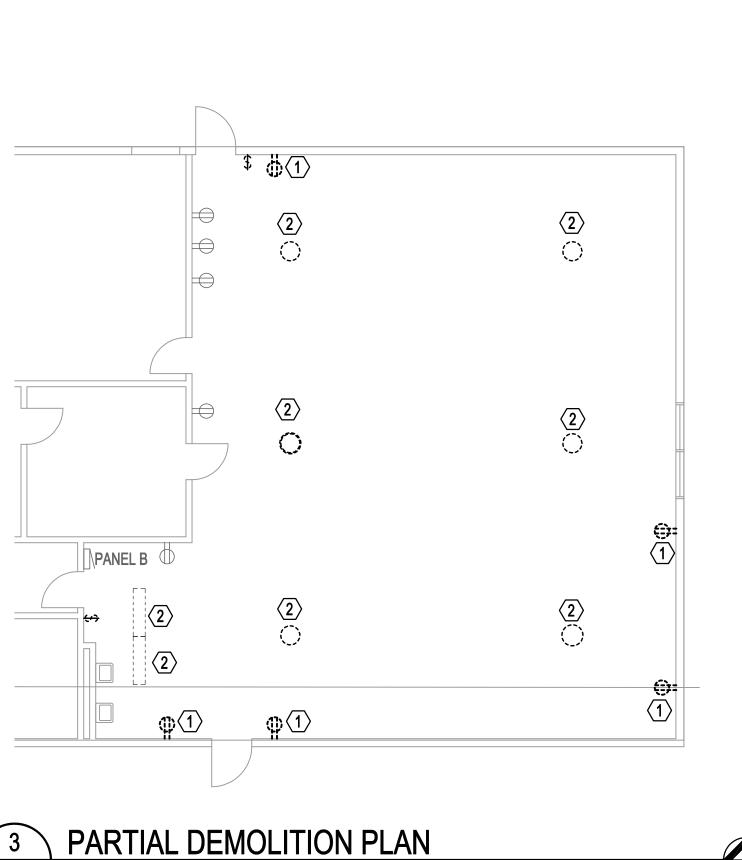

2 (2)

2 [ 2

2 - [ - ] 2

PARTIAL DEMOLITION PLAN

ED.1

ED.1


ED.1

PARTIAL DEMOLITION PLAN


**PARTIAL DEMOLITION PLANS** 

3 MAR 2020

ED.1

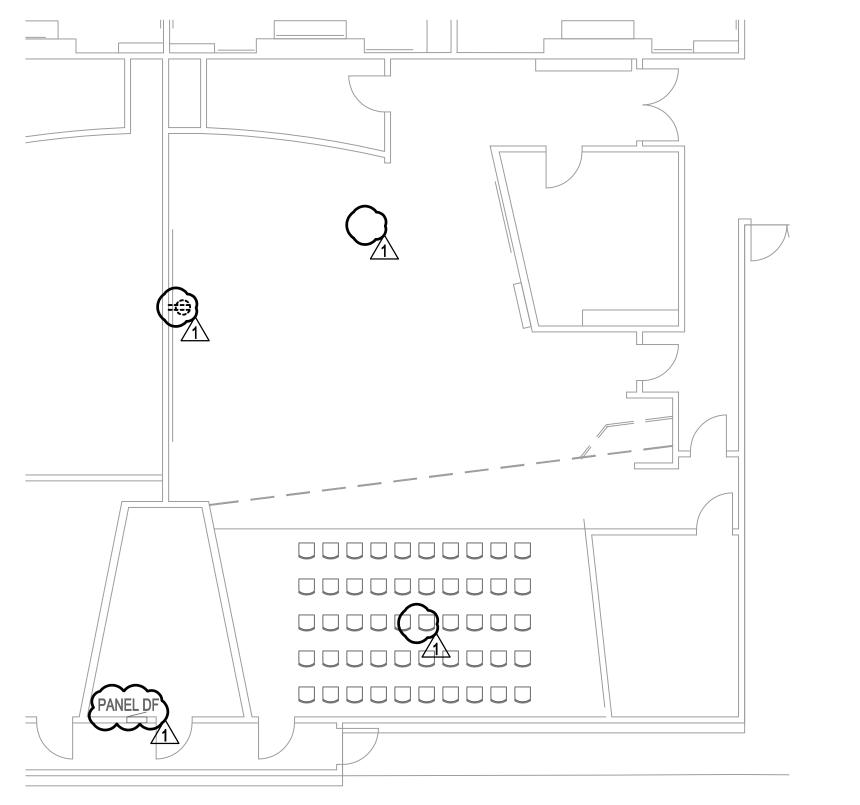

# PARTIAL DEMOLITION PLAN NORTH

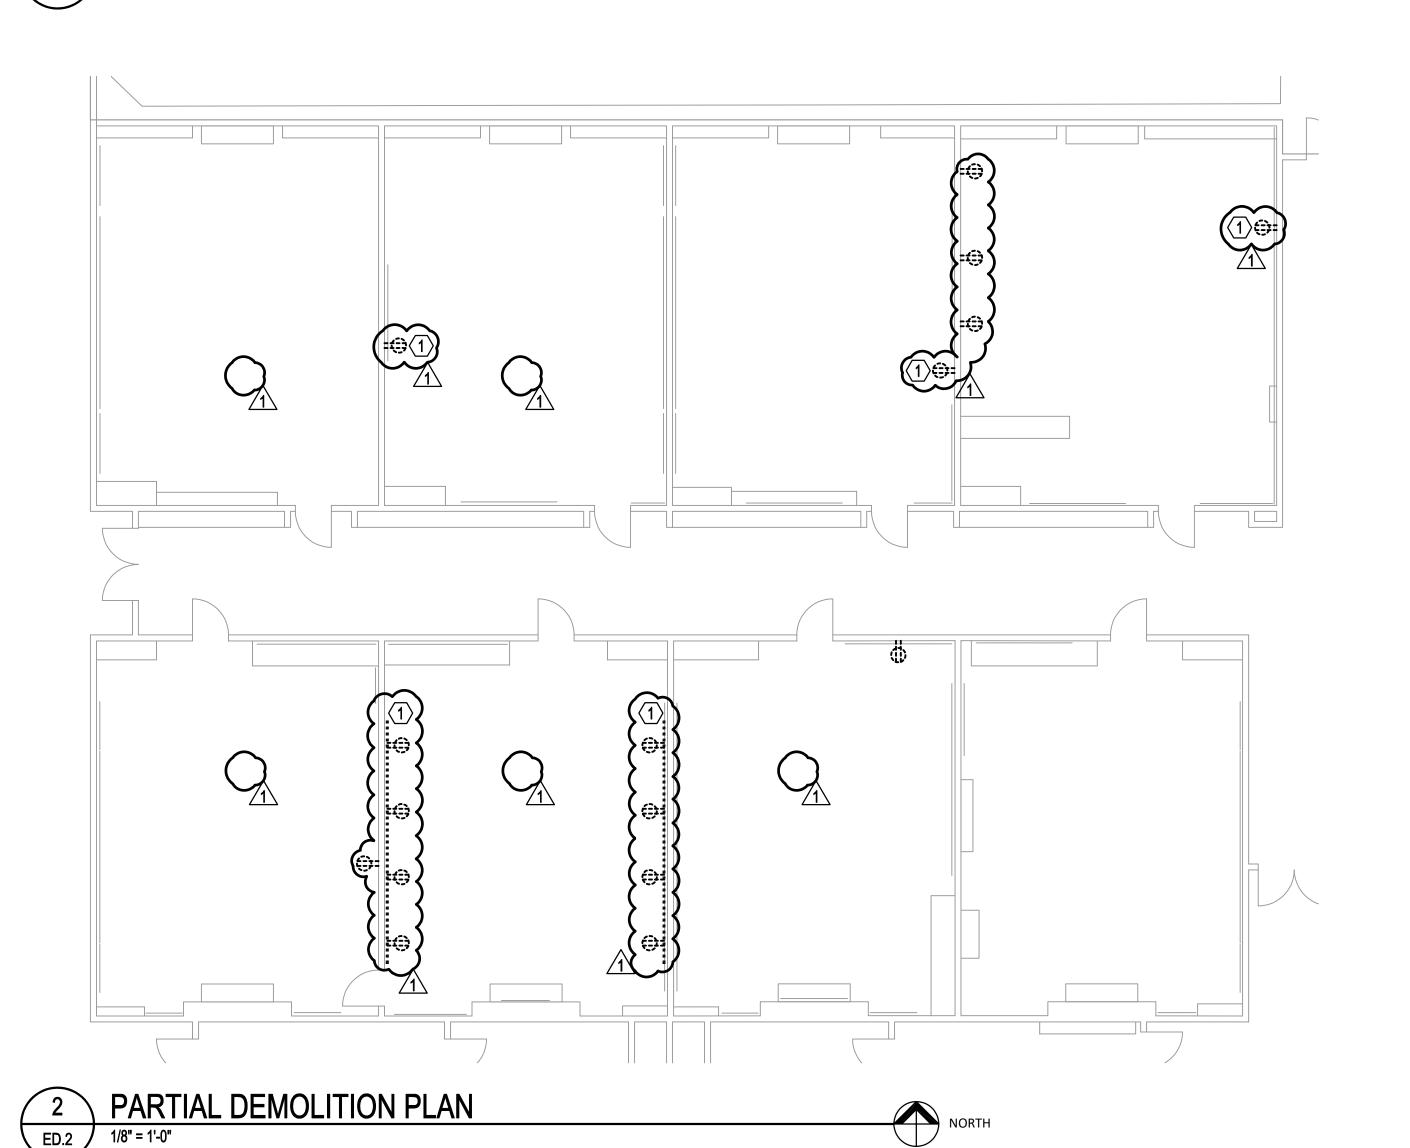

# **GENERAL NOTES:**

A. CAREFULLY REMOVE AND OFFER TO THE OWNER ALL ELECTRICAL EQUIPMENT THAT IS TO BE REMOVED AND IN GOOD WORKING ORDER. REMOVE FROM PROJECT SITE AND PROPERLY DISPOSE ALL EQUIPMENT REJECTED BY THE OWNER.


B. THE LOCATIONS OF ALL EQUIPMENT AND DEVICES MAY NOT BE SHOWN AND THESE PLANS DO NOT SHOW ALL OF THE DEMOLITION CONDITIONS. DEMOLITION INCLUDES THE REMOVAL OF ALL RACEWAY, CONDUCTORS, COMMUNICATION CABLING, LIGHT FIXTURES, DEVICES, ELECTRICAL EQUIPMENT, FIRE ALARM DEVICES, CABLES, HANGERS, AND SUPPORTS THAT ARE MADE OBSOLETE BY THE NEW WORK OR ARE ABANDONED AND NO LONGER IN USE.

1. DEMOLISH RECEPTACLE AND BACKBOX AND REMOVE CONDUIT AND CONDUCTORS TO ABOVE ACCESSIBLE CEILING. SALVAGE CIRCUIT FOR EXTENSION TO NEW RECEPTACLE LOCATION. SEE SHEET E1.1 FOR ADDITIONAL INFORMATION.

NOTES:



**GMA ARCHITECTS** 860 West Park Street / Ste 300 Eugene / Oregon / 97401 p 541.344.9157 gma-arch.com

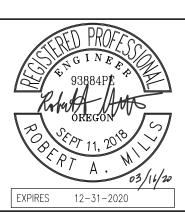



pae-engineers.com

REVISIONS

3/17/2020 ADD. 1

**MPROVEMENTS** 

**ESD 4J NORTH EUGENE HIGH SCHOOL** JOB NO:

ISSUE DATE:

PARTIAL **DEMOLITION PLANS** 

ED.2





pae-engineers.com

REVISIONS

3/17/2020 ADD. 1

ESD 4J NORTH EUGENE HIGH SCHOOL IMPROVEMENTS

200 SILVER LN, EUGENE, OR 97

OVERALL ELECTRICAL PLAN

왕 - E1.0


JOB NO:

COPYRIGHT GMA ARCHITECTS 2019

1 OVERALL ELECTRICAL PLAN

1/32" = 1'-0"




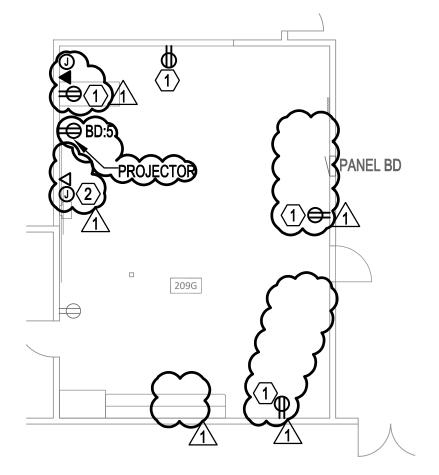


ENLARGED PARTIAL ELECTRICAL FLOOR PLAN






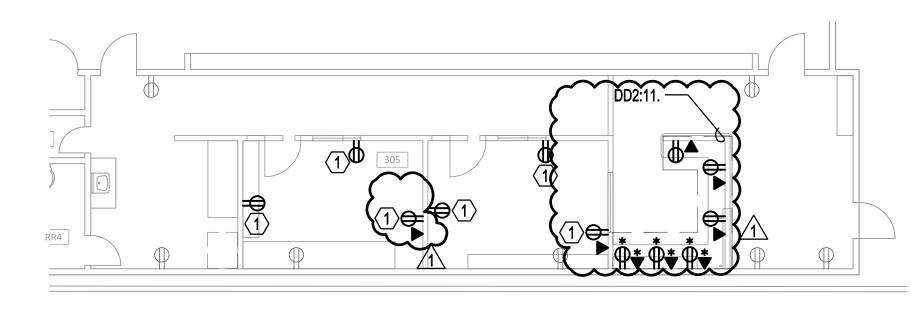

ENLARGED PARTIAL ELECTRICAL FLOOR PLAN

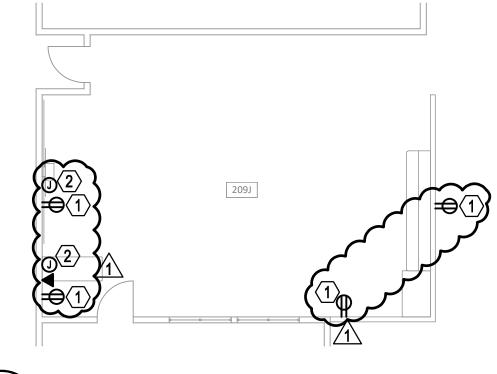

ENLARGED PARTIAL ELECTRICAL FLOOR PLAN NORTH

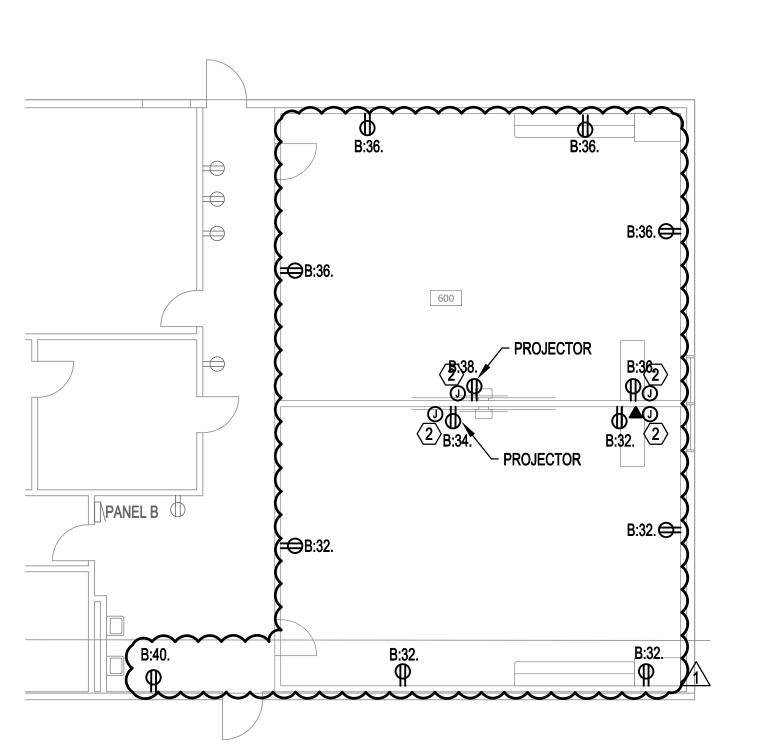

ENLARGED PARTIAL ELECTRICAL FLOOR PLAN

**GENERAL NOTES:** 

- A. TELECOM SCOPE SHALL INCLUDE BACKBOX CONDUIT AND RACEWAY. PROVIDE BACKBOX ROUGH-IN AT DATA DEVICE LOCATION AND 1-1/4" CONDUIT ROUTED TO THE TELECOM CLOSET. DATA DEVICE, CABLING AND CONNECTION TO TELECOMMUNICATIONS SYSTEM SHALL BE BY OWNERS TELECOMMUNICATIONS CONTRACTOR.
- B. THE FIRE ALARM SYSTEM IS SHOWN FOR GUIDANCE AND IS INTENDED TO BE USED TO PROVIDE INFORMATION FOR A FIRE ALARM DESIGN-BUILD SYSTEM. EQUIPMENT AND DEVICE ARRANGEMENT SHOWN IS TO AID IN ESTABLISHING A BASIS OF DESIGN. CONTRACTOR SHALL BE RESPONSIBLE FOR CREATION OF SHOP DRAWINGS, AND TO PROVIDE FULL DESIGN, PERMITTING, INSTALLATION, TESTING, AND COORDINATION WITH OTHER TRADES. PROVIDE A COMPLETE SYSTEM THAT MEETS CURRENT CODE AND FUNCTIONALITY REQUIREMENTS.




1. CONNECT SALVAGED CIRCUIT TO NEW RECEPTACLE.

2. PROVIDE BACK-BOX AND CONDUIT PATHWAY FOR PROJECTOR AV CONNECTION. 



**GMA ARCHITECTS** 860 West Park Street / Ste 300 Eugene / Oregon / 97401 p 541.344.9157 gma-arch.com

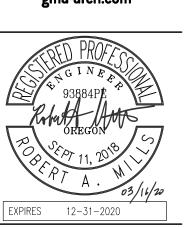




**REVISIONS** 3/17/2020 ADD. 1

**MPROVEMENTS** NORTH EUGENE HIGH SCHOOL

JOB NO:

**ENLARGED** PARTIAL **ELECTRICAL FLOOR PLAN** 

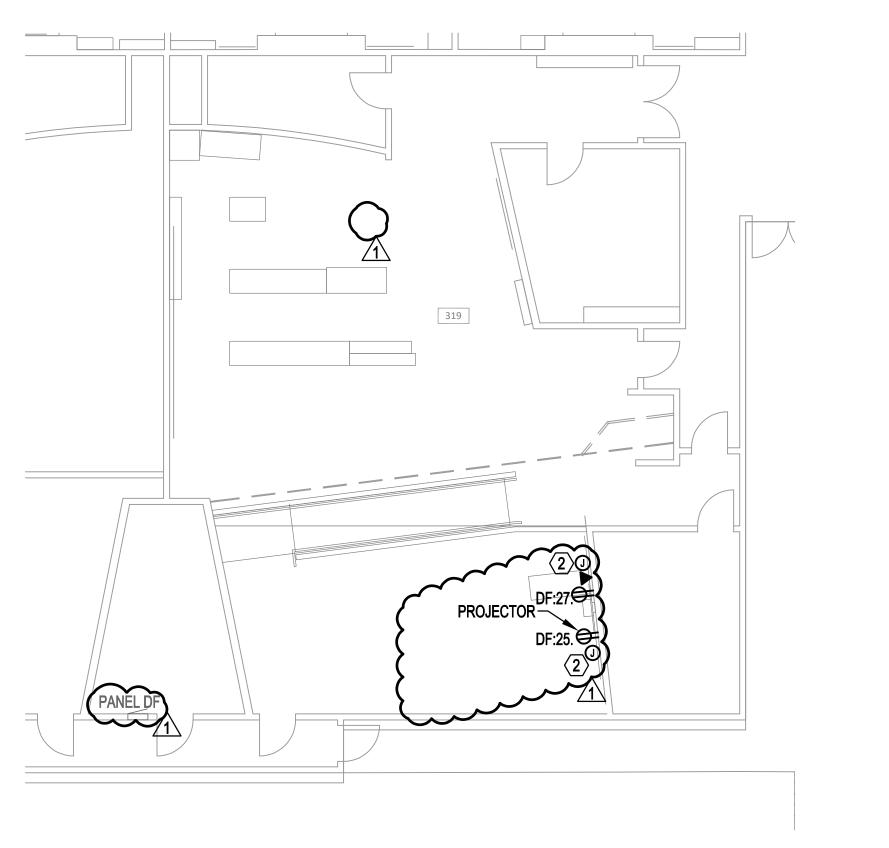

ENLARGED PARTIAL ELECTRICAL FLOOR PLAN

# **GENERAL NOTES:**

- A. TELECOM SCOPE SHALL INCLUDE BACKBOX
  CONDUIT AND RACEWAY. PROVIDE BACKBOX
  ROUGH-IN AT DATA DEVICE LOCATION AND
  1-1/4" CONDUIT ROUTED TO THE TELECOM
  CLOSET. DATA DEVICE, CABLING AND
  CONNECTION TO TELECOMMUNICATIONS
  SYSTEM SHALL BE BY OWNERS
  TELECOMMUNICATIONS CONTRACTOR.
- B. THE FIRE ALARM SYSTEM IS SHOWN FOR GUIDANCE AND IS INTENDED TO BE USED TO PROVIDE INFORMATION FOR A FIRE ALARM DESIGN-BUILD SYSTEM. EQUIPMENT AND DEVICE ARRANGEMENT SHOWN IS TO AID IN ESTABLISHING A BASIS OF DESIGN.

  CONTRACTOR SHALL BE RESPONSIBLE FOR CREATION OF SHOP DRAWINGS, AND TO PROVIDE FULL DESIGN, PERMITTING, INSTALLATION, TESTING, AND COORDINATION WITH OTHER TRADES. PROVIDE A COMPLETE SYSTEM THAT MEETS CURRENT CODE AND FUNCTIONALITY REQUIREMENTS.




2. PROVIDE BACK-BOX AND CONDUIT PATHWAY FOR PROJECTOR AV CONNECTION.



GMA ARCHITECTS

860 West Park Street / Ste 300
Eugene / Oregon / 97401
p 541.344.9157
gma-arch.com

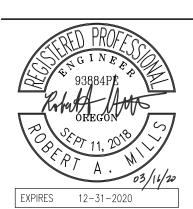

**IIII** PAE

pae-engineers.com

REVISIONS

3/17/2020 ADD. 1

NORTH



2 ENLARGED PARTIAL ELECTRICAL FLOOR PLAN
1/8" = 1'-0"

NORTH


ESD 4J NORTH EUGENE HIGH SCHOOL IMPROVEMENTS

JOB NO: 19188
ISSUE DATE: 3 MAR 2020

ENLARGED PARTIAL ELECTRICAL

**FLOOR PLAN** 

2 — 7 E1.

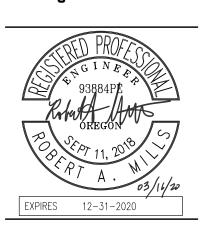

IIII PAE

REVISIONS

3/17/2020 ADD. 1

ESD 4J NORTH EUGENE HIGH SCHOOL IMPROVEMENTS

JOB NO: 19188
ISSUE DATE: 3 MAR 2020

OVERALL
LIGHTING PLAN

SH E2.


COPYRIGHT GMA ARCHITECTS 2019

-

1 OVERALL LIGHTING PLAN
E2.0 1/32" = 1'-0"


ENLARGED PARTIAL LIGHTING REFLECTED CEILING PLAN

NORTH

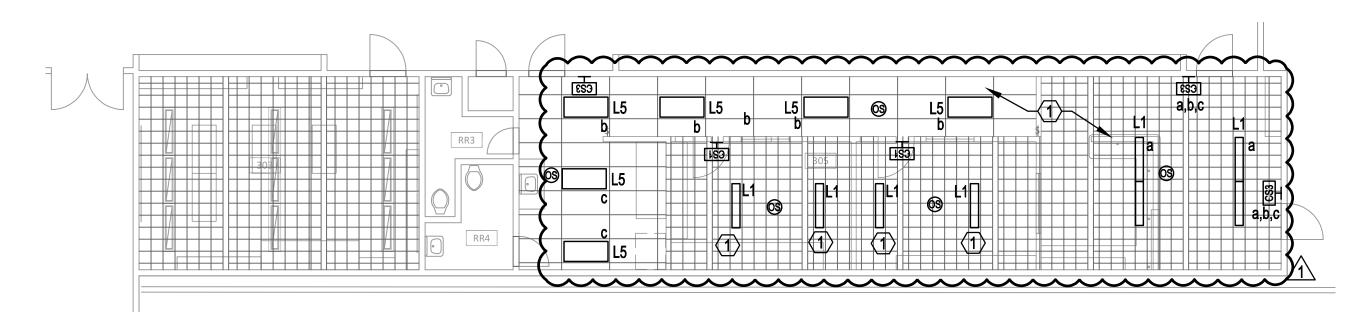

ENLARGED PARTIAL LIGHTING REFLECTED CEILING PLAN E2.1



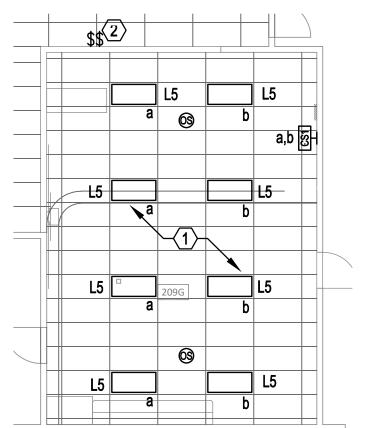

| CONT                  | ROL STATION SC | HEDULE  |
|-----------------------|----------------|---------|
| CONTROL<br>STATION ID | ZONES          | DIMMING |
| CS1                   | 1              | YES     |
| CS2                   | 2              | YES     |
| CS3                   | 3              | YES     |
| NOTE:                 |                | I .     |

ENLARGED PARTIAL LIGHTING REFLECTED CEILING PLAN NORTH


A. PROVIVE ALL ON/OFF AND INDIVIDUAL ON/OFF AND DIMMING CONTROL PER ZONE.

# **GENERAL NOTES:**

A. PROVIDE #10 AWG CONDUCTORS TO 120V BRANCH CIRCUITS OVER 100FT FROM BRANCH

B. COORDINATE ROUTING OF CONDUIT WITH ALL OTHER TRADES. WHERE POSSIBLE, ROUTE CONDUIT TIGHT TO DECK STRUCTURE. CONDUIT SHALL BE ROUTED SO AS NOT TO OBSTRUCT ACCESS TO VALVES, DAMPERS, CONTROL PANELS, ACCESS PANELS AND EQUIPMENT COMPONENTS.

C. LUMINAIRE LOCATIONS SHOWN ARE APPROXIMATE AND DIAGRAMMATIC. REFER TO ARCHITECTURAL REFLECTED CEILING PLANS AND ELEVATIONS FOR EXACT LUMINAIRE/CONTROLS LOCATIONS AND MOUNTING HEIGHTS.

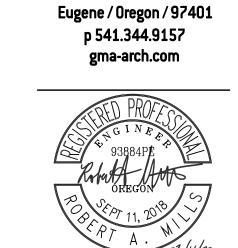

**GMA ARCHITECTS** 

860 West Park Street / Ste 300

**REVISIONS** 

3/17/2020 ADD. 1

2. CONNECT SALVAGED SWITCHES AND


NOTES:

CIRCUIT TO NEW SWITCH LOCATION.


3. NO LIGHTING SCOPE IN THIS AREA.

1. CONNECT SALVAGED CIRCUIT TO NEW

FIXTURE LOCATIONS.

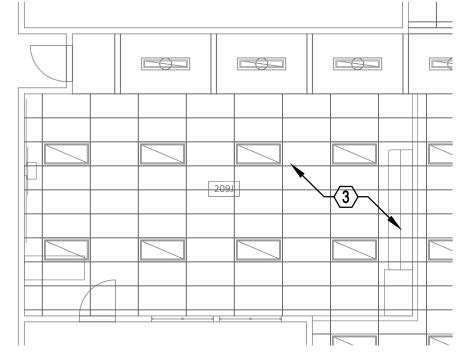

ENLARGED PARTIAL LIGHTING REFLECTED CEILING PLAN NORTH E2.1

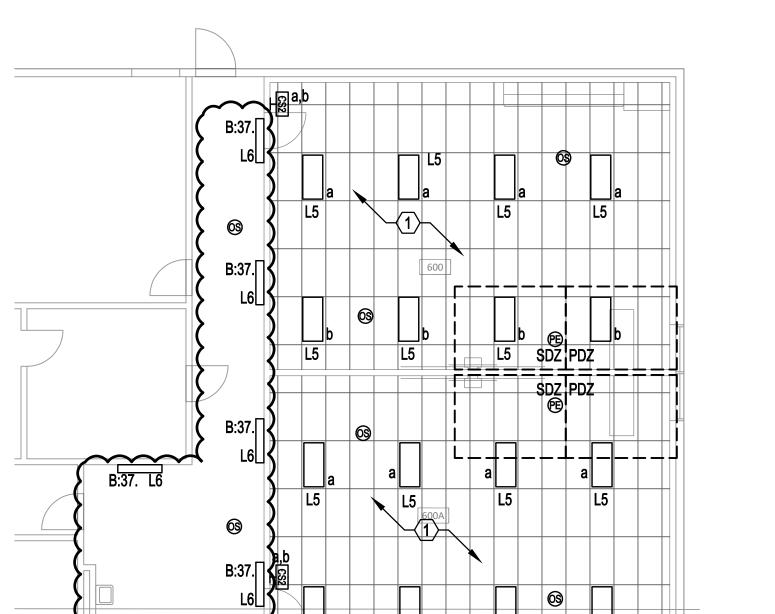

ENLARGED PARTIAL LIGHTING REFLECTED CEILING PLAN

1/8" = 1'-0"

NORTH E2.1




**MPROVEMENTS** NORTH EUGENE HIGH SCHOOL

JOB NO:

**ENLARGED** PARTIAL LIGHTING REFLECTED **CEILING PLAN** 



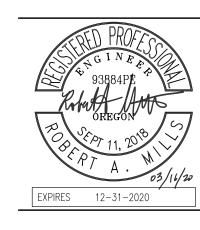



REVISIONS

3/17/2020 ADD. 1

ESD 4J NORTH EUGENE HIGH SCHOOL IMPROVEMENTS

ESD 41 NORT


200 SILVER LN, F
RENOVATIONS

18181

18182

200 SILVER LN, F
RENOVATIONS

DIAGRAMS - ELECTRICAL

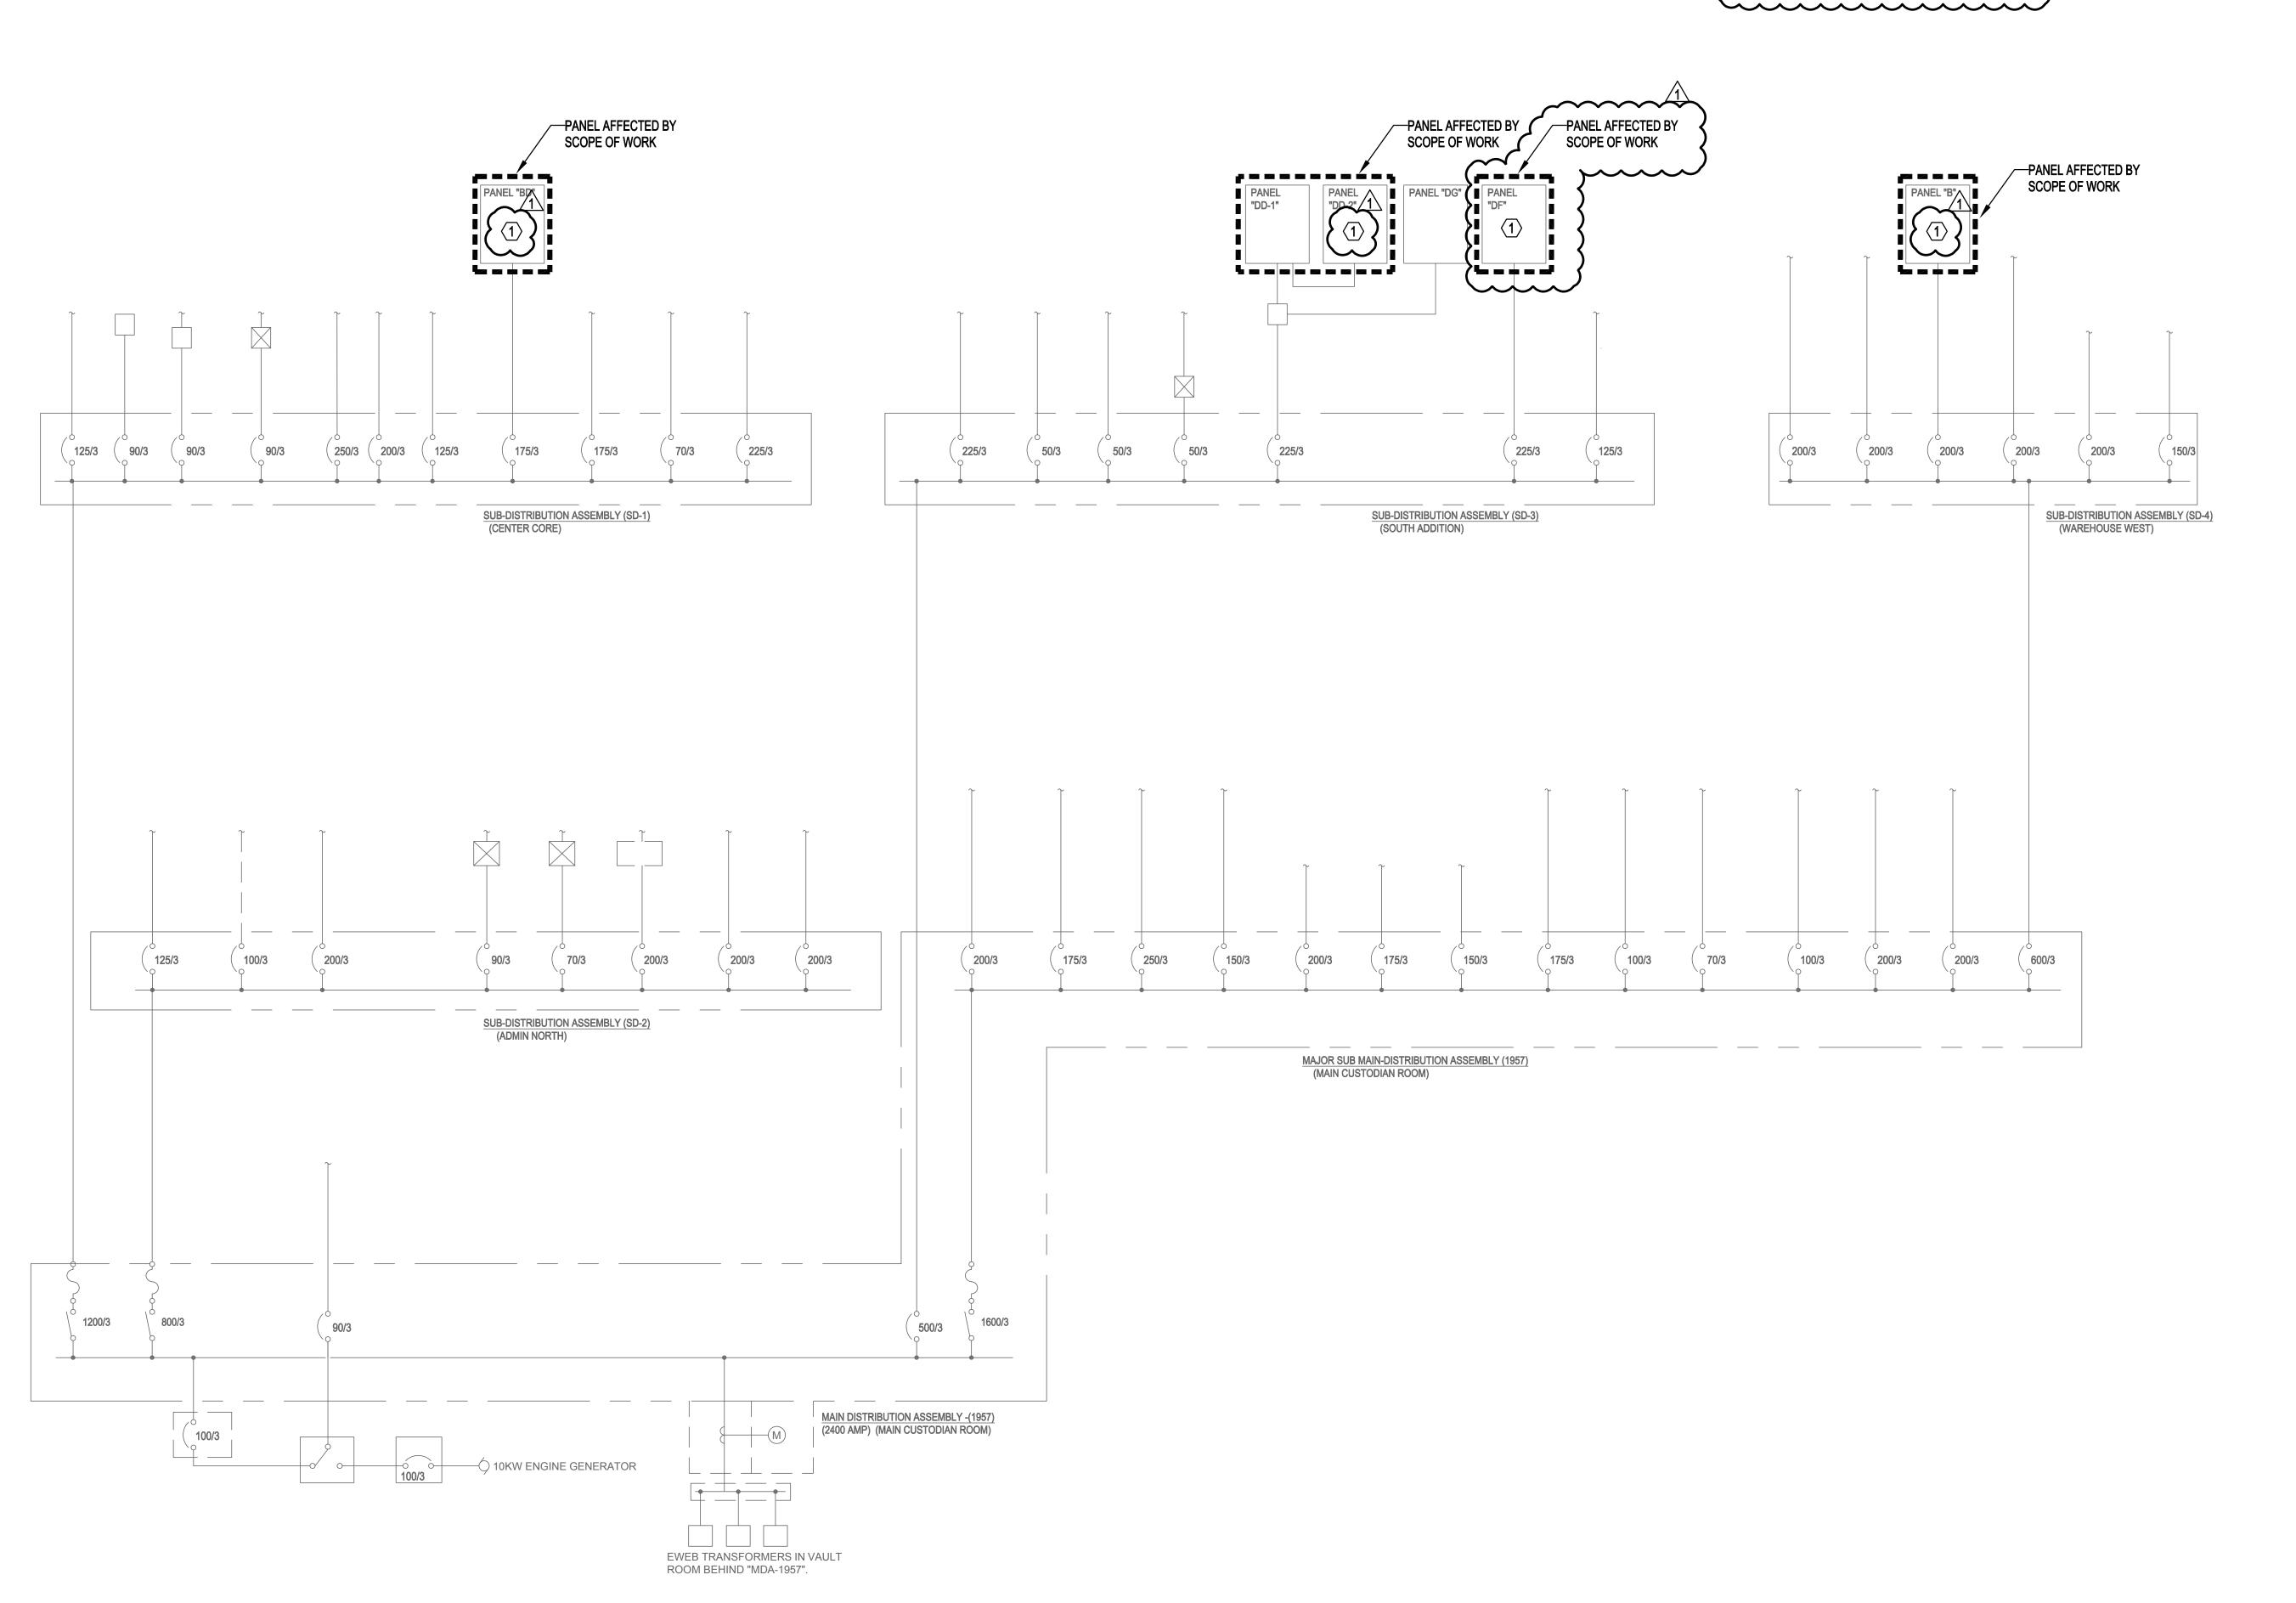

|                                |                 |                  |          |          | F        | PAN           | IEL S    | СН    | EDU      | JLE    |        |       |           |   |
|--------------------------------|-----------------|------------------|----------|----------|----------|---------------|----------|-------|----------|--------|--------|-------|-----------|---|
|                                |                 |                  |          |          |          |               |          |       |          |        |        |       |           |   |
| PANEL: BD                      | LOCATIO         | N: MAIN ELECTRIC | CAL ROOM | Л        |          |               | VOLT     | AGE:  | 208      | Υ/     | 120    | P:    | 3         | W: 4 AIC RATING:   |
| AMP: 225 MLO                   | X MCB           |                  |          |          |          |               |          |       |          |        |        |       |           | MOUNTING: SURFACE X FLUSH   |
|                                |                 |                  |          |          |          |               |          |       |          |        |        |       |           |   |
| TYPE: EXISTING                 | S X NEW         | STYLE:           |          |          |          |               | NEU      | IRAL: | 100%     |        |        |       |           | FED FROM: PNL DP-1   |
| OIDOI                          | UT DECODIDATION | \1               | LC       | AD       | CKT      | Р             | CIR      | Р     | CIR      | Р      | СКТ    | LC    | DAD       | OIDOUIT DECODIDATION   |
| CIRCU                          | JIT DESCRIPTIO  | N                | TYPE     | KVA      | BKR      |               | #        | Н     | #        |        | BKR    | KVA   | TYPE      | CIRCUIT DESCRIPTION   |
| (E) EXISTING LOAD              |                 |                  |          |          | 20       | 1             | 1        | Α     | 2        | 20     | 1      |       |           | (E) SPACE   |
| (E) EXISTING LOAD              |                 |                  |          |          | 20       | 1             | 3        | В     | 4        | 20     | 1      |       |           | (E) EXISTING LOAD   |
| (N) CLASSROOM 209G             | - PROJECTOR     |                  | MISC     | 0.90     | 20       | 1             | 5        | С     | 6        | 20     | 1      |       |           | (E) EXISTING LOAD   |
| (E) EXISTING LOAD              |                 |                  |          |          | 20       | 1             | 7        | Α     | 8        | 20     | 1      |       |           | (E) EXISTING LOAD   |
| (E) EXISTING LOAD              |                 |                  |          |          | 20       | 1             | 9        | В     | 10       | 20     | 1      |       |           | (E) EXISTING LOAD   |
| (E) EXISTING LOAD              |                 |                  |          |          | 20       | 1             | 11       | С     | 12       | 20     | 1      |       |           | (E) SPACE   |
| (E) SPACE                      |                 |                  |          |          | 20       | 1             | 13       | A     | 14       | 20     | 1      |       |           | (E) SPACE   |
| (E) EXISTING LOAD<br>(E) SPACE |                 |                  |          |          | 20<br>20 | 1             | 15<br>17 | B     | 16<br>18 | 20     | 1      |       |           | (E) SPACE   |
| (E) EXISTING LOAD              |                 |                  |          |          | 20       | 1             | 17       | A     | 20       | 20     | 1      |       |           | (E) SPACE   |
| (E) EXISTING LOAD              |                 |                  | 1        |          | 20       | 1             | 21       | В     | 22       | 20     | 1      |       |           | (E) EXISTING LOAD   |
| (E) EXISTING LOAD              |                 |                  |          |          | 20       | 1             | 23       | С     | 24       | 20     | 1      |       |           | (E) EXISTING LOAD   |
| (E) EXISTING LOAD              |                 |                  |          |          | 20       | 1             | 25       | A     | 26       | 20     | 1      |       |           | (E) EXISTING LOAD   |
| (E) EXISTING LOAD              |                 |                  |          |          | 20       | 1             | 27       | В     | 28       | 20     | 1      |       |           | (E) EXISTING LOAD   |
| (E) EXISTING LOAD              |                 |                  |          |          | 20       | 1             | 29       | С     | 30       | 20     | 1      |       |           | (E) SPACE   |
| (E) EXISTING LOAD              |                 |                  |          |          | 20       | 1             | 31       | Α     | 32       | 20     | 1      |       |           | (E) SPACE   |
| (E) EXISTING LOAD              |                 |                  |          |          | 20       | 1             | 33       | В     | 34       | 20     | 1      |       |           | (E) SPACE   |
| (E) SPACE                      |                 |                  |          |          | 20       | 1             | 35       | С     | 36       | 20     | 1      |       |           | (E) SPACE   |
| (E) SPACE                      |                 |                  |          |          | 20       | 1             | 37       | Α     | 38       | 20     | 1      |       |           | (E) SPACE   |
| (E) SPACE                      |                 |                  |          |          | 20       | 1             | 39       | В     | 40<br>42 |        |        |       |           | (E) SPACE   |
| (E) SPACE                      |                 |                  |          |          |          |               | 41       | С     | 42       |        |        |       |           | (E) SPACE   |
| ESTIMATED MAXIMUM              | DEMAND (EMD)    | CALCULATIONS     |          |          |          |               |          |       |          |        |        |       |           |   |
| LOAD SUMMARY:                  | LOAD TYPE       | CONNECTED        | NEC DE   | EMAND    |          |               |          |       |          |        |        |       |           |   |
| LIGHTING                       | LTG             | 0.0 KVA          | 0.0      | KVA (12  | 5%)      |               |          |       |          |        |        |       | CONNE     | CTED PHASE LOADING   |
| RESIDENT LTG/REC               | RES             | 0.0 KVA          | 0.0      | KVA ( 10 | 00/35/25 | %)            |          |       |          |        |        |       | PHASE     | A: 0.00 KVA   |
| SMALL APPLIANCE                | RES             | 0.0 KVA          | 0.0      | KVA ( 10 | 00/35/25 | %)            |          |       |          |        |        |       | PHASE     | B: 0.00 KVA   |
| LARGEST MOTOR                  | MTR             | KVA              | 0.0      | KVA (12  | 5%)      |               |          |       |          |        |        |       | PHASE     | C: 0.90 KVA   |
| REMAINING MOTORS               | MTR             | 0.0 KVA          |          | KVA (10  |          |               |          |       |          |        |        |       |           |   |
| GEN PURPOSE REC                | REC             | 0.0 KVA          |          | KVA ( 50 |          | <b>\/</b> \/\ |          |       |          |        |        |       |           |   |
| COMPUTER REC                   | MISC            | 0.0 KVA          |          | KVA (10  |          | . • / • /     |          |       |          |        |        |       |           |   |
| EQUIP/OTHER                    |                 |                  |          |          |          |               |          |       | NOTES    | ·.     |        |       |           |   |
|                                | MISC            | 0.9 KVA          |          | KVA (10  |          |               |          |       |          |        |        |       | 0ED 14/17 | THE STATE OF THE TOP OF THE STATE OF THE STA |
| HEATING                        | MISC            | 0.0 KVA          |          | KVA (10  | ,        |               |          |       | 1        |        |        |       |           | H (E) INDICATES EXISTING TO REMIAN.   |
| ELEVATOR                       | ELEV            | 0.0 KVA          |          | KVA (10  |          |               |          |       | 2. BOL   | D LINI | =WEIGH | PREFA | CED WII   | TH (N) INDICATES NEW   |
| KITCHEN EQPT                   | KITCH           | 0.0 KVA          |          | KVA (.65 | 5)       |               |          | 4     |          |        |        |       |           |   |
| TOTALS:                        |                 | 0.9 KVA          |          | KVA      |          |               |          |       |          |        |        |       |           |   |
|                                |                 | 2.5 AMP          | 2.5      | AMP      |          |               |          |       |          |        |        |       |           |   |
|                                |                 |                  |          |          |          |               |          | 1     | 1        |        |        |       |           |   |

|                                            |                 |               |            |           | F        | PAN  | IEL S            | CH     | EDU      | LE   |            |         |             |                                             |
|--------------------------------------------|-----------------|---------------|------------|-----------|----------|------|------------------|--------|----------|------|------------|---------|-------------|---------------------------------------------|
|                                            |                 |               |            |           |          |      |                  |        |          |      |            |         |             |                                             |
| PANEL: DD2<br>AMP: 100 MLC                 |                 | MAIN ELECTRIC | CAL ROOM   | И         |          |      | VOLT             | TAGE:  | 208      | Y/   | 120        | P:      | 3           | W: 4 AIC RATING:  MOUNTING: SURFACE X FLUSH |
| TYPE: EXISTING                             | S X NEW         | STYLE:        |            |           |          |      | NEU <sup>-</sup> | TRAL:  | 100%     |      |            |         |             | FED FROM: MSB                               |
| CIRCL                                      | JIT DESCRIPTION |               | LC<br>TYPE | AD<br>KVA | CKT      | Р    | CIR<br>#         | P<br>H | CIR<br># | Р    | CKT<br>BKR | KVA     | DAD<br>TYPE | CIRCUIT DESCRIPTION                         |
| E) ROOM 302 POWER                          | POLE            |               |            |           | 20       | 1    | 1                | Α      | 2        | 1    | 20         |         |             | (E) SPARE                                   |
| E) ROOM 302 POWER                          |                 |               |            |           | 20       | 1    | 3                | В      | 4        | 1    | 20         |         |             | (E) SPARE                                   |
| E) ALARM - TRANSLAT                        |                 |               |            |           | 20       | 1    | 5                | С      | 6        | 1    | 20         |         |             | (E) SPARE                                   |
| E) OS LIGHTS - NORTI                       |                 |               |            |           | 20       | 1    | 7                | Α      | 8        | 1    | 20         |         |             | (E) SPARE                                   |
| E) RM 302 GALLERY T                        | RACK LIGHTS     |               |            |           | 20       | 1    | 9                | В      | 10       | 1    | 20         |         |             | (E) SPARE                                   |
| N) RECEPTION - REC                         |                 |               | REC        | 1.08      | 20       | 1    | 11               | С      | 12       | 1    | 20         |         |             | (E) SPARE                                   |
| N) CLASSROOM 312 -                         | PROJECTOR       |               | MISC       | 0.90      | 20       | 1    | 13               | Α      | 14       | 1    | 20         |         |             | (E) SPARE                                   |
| N) CLASSROOM 312 -                         | REC             |               | REC        | 0.18      | 20       | 1    | 15               | В      | 16       | 1    | 20         |         |             | (E) SPARE                                   |
| E) SPARE                                   |                 |               |            |           | 20       | 1    | 17               | С      | 18       | 1    | 20         |         |             | (E) SPARE                                   |
| E) SPARE                                   |                 |               |            |           | 20       | 1    | 19               | Α      | 20       | 2    | 20         |         |             | (E) HEAT RM 301                             |
| E) POWER POLE                              |                 |               |            |           | 20       | 2    | 21               | В      | 22       | -    | -          |         |             | (E) HEAT RM 301                             |
| E) PROJECTOR OUTLI                         | ETS             |               |            |           |          |      | 23               | С      | 24       | 2    | 20         |         |             | (E) SPK RM 302 IN BOX ON CEILING            |
| E) SPARE                                   |                 |               |            |           | 20       | 2    | 25               | Α      | 26       |      |            |         |             | (E) SPK RM 302 IN BOX ON CEILING            |
| E) SPARE                                   |                 |               |            |           | -        | -    | 27               | В      | 28       | 1    | 20         |         |             | (E) SPARE                                   |
| E) SPARE                                   |                 |               |            |           | 30       | 2    | 29               | С      | 30       | 3    | 50         | 4.14    | MISC        | (N) RTU 305                                 |
| E) SPARE                                   |                 |               |            |           | -        | -    | 31               | Α      | 32       | -    | -          | 4.14    | MISC        | -                                           |
| E) WATER HEATER                            |                 |               |            |           | 20       | 1    | 33               | В      | 34       | -    | -          | 4.14    | MISC        | -                                           |
| E) WATER HEATER                            |                 |               |            |           | 20       | 1    | 35               | C      | 36       | 1    | 20         |         |             | (E) SPACE                                   |
| E) EXISTING LOAD                           |                 |               |            |           | 20       | 1    | 37               | A      | 38       | 1    | 20         |         |             | (E) SPACE                                   |
| E) BASEBOARD HEATI<br>E) OFFICE AT EAST EI |                 |               |            |           | 20       | 2    | 39<br>41         | B      | 40<br>42 | 1    | 20         |         |             | (E) SPACE<br>(E) SPARE                      |
| L) OFFICE AT EAST E                        | NUTILATEN       |               |            |           |          | _    | 71               | Ľ      | 72       | '    | 20         |         |             | (L) SPARL                                   |
| ESTIMATED MAXIMUM                          | ` ,             |               |            |           |          |      |                  |        |          |      |            |         |             |                                             |
| OAD SUMMARY:                               | LOAD TYPE       | CONNECTED     | NEC DE     |           |          |      |                  | -      |          |      |            |         |             |                                             |
| LIGHTING                                   | LTG             | 0.0 KVA       |            | KVA (12   | ,        |      |                  |        |          |      |            |         |             | CTED PHASE LOADING                          |
| RESIDENT LTG/REC                           | RES             | 0.0 KVA       |            | KVA ( 10  |          |      |                  |        |          |      |            |         | PHASE A     |                                             |
| SMALL APPLIANCE                            | RES             | 0.0 KVA       | 0.0        | KVA ( 10  | 00/35/25 | %)   |                  |        |          |      |            |         | PHASE I     | 3: 4.32 KVA                                 |
| ARGEST MOTOR                               | MTR             | KVA           | 0.0        | KVA (12   | 5%)      |      |                  |        |          |      |            |         | PHASE (     | C: 5.22 KVA                                 |
| REMAINING MOTORS                           | MTR             | 0.0 KVA       | 0.0        | KVA (10   | 0%)      |      |                  |        |          |      |            |         |             |                                             |
| GEN PURPOSE REC                            | REC             | 1.3 KVA       | 1.3        | KVA ( 50  | )% > 10K | (VA) |                  |        |          |      |            |         |             |                                             |
| COMPUTER REC                               | MISC            | 0.0 KVA       | 0.0        | KVA (10   | 0%)      |      |                  |        |          |      |            |         |             |                                             |
| EQUIP/OTHER                                | MISC            | 0.9 KVA       |            | KVA (10   |          |      |                  |        | NOTES    | :    |            |         |             |                                             |
| HEATING                                    | MISC            | 12.4 KVA      |            | KVA (10   |          |      |                  |        |          |      | -WEICH     | T PREEN | CED WIT     | H (E) INDICATES EXISTING TO REMIAN.         |
|                                            |                 |               |            |           |          |      |                  |        |          |      |            |         |             |                                             |
| ELEVATOR                                   | ELEV            | 0.0 KVA       |            | KVA (10   |          |      |                  |        | Z. BULI  | LINE | _vvciGH    | I FREFA | CED MII     | H (N) INDICATES NEW                         |
| (ITCHEN EQPT                               | KITCH           | 0.0 KVA       |            | KVA (.65  | )        | _    |                  | 4      |          |      |            |         |             |                                             |
| TOTALS:                                    |                 | 14.6 KVA      | 14.6       | KVA       |          |      |                  | 1      |          |      |            |         |             |                                             |

|                                   |                 |                  |         |          |          | , u.v | EL S             | <u> </u> |          |        |          |         |         |                                             |
|-----------------------------------|-----------------|------------------|---------|----------|----------|-------|------------------|----------|----------|--------|----------|---------|---------|---------------------------------------------|
| PANEL: B AMP: 225 MLO             |                 | N: MAIN ELECTRIC | CAL ROO | Л        |          |       | VOL              | TAGE:    | 208      | Υ/     | 120      | P:      | 3       | W: 4 AIC RATING:  MOUNTING: SURFACE X FLUSH |
| TYPE: EXISTING                    | X NEW           | STYLE:           |         |          |          |       | NEU <sup>-</sup> | TRAL:    | 100%     |        |          |         |         | FED FROM: MSB                               |
| CIDCI                             | JIT DESCRIPTIO  | AI               | LC      | AD       | CKT      | Р     | CIR              | Р        | CIR      | Р      | CKT      | L       | OAD     | CIRCUIT DESCRIPTION                         |
| CIRCU                             | JII DESCRIPTIOI | V                | TYPE    | KVA      | BKR      |       | #                | Н        | #        |        | BKR      | KVA     | TYPE    | CIRCUIT DESCRIPTION                         |
| E) EXISTING LOAD                  |                 |                  |         |          | 20       | 1     | 1                | Α        | 2        | 1      | 20       |         |         | (E) EXISTING LOAD                           |
| E) EXISTING LOAD                  |                 |                  |         |          | 20       | 1     | 3                | В        | 4        | 1      | 20       |         |         | (E) EXISTING LOAD                           |
| E) EXISTING LOAD                  |                 |                  |         |          | 20       | 1     | 5                | C        | 6        | 1      | 20       |         |         | (E) EXISTING LOAD                           |
| E) EXISTING LOAD                  |                 |                  |         |          | 20       | 1     | 7                | A        | 8        | 1      | 20       |         |         | (E) EXISTING LOAD                           |
| E) EXISTING LOAD                  |                 |                  |         |          | 20       | 1     | 9                | В        | 10       | 1      | 20<br>20 |         |         | (E) EXISTING LOAD                           |
| E) EXISTING LOAD E) EXISTING LOAD |                 |                  |         |          | 20<br>20 | 1     | 11<br>13         | C        | 12<br>14 | 1      | 20       |         |         | (E) EXISTING LOAD (E) EXISTING LOAD         |
| E) EXISTING LOAD                  |                 |                  |         |          | 20       | 1     | 15               | B        | 16       | 1      | 20       |         |         | (E) EXISTING LOAD                           |
| E) EXISTING LOAD                  |                 |                  |         |          | 20       | 1     | 17               | C        | 18       | 1      | 20       |         |         | (E) EXISTING LOAD                           |
| E) EXISTING LOAD                  |                 |                  |         |          | 20       | 1     | 17               | A        | 20       | 3      | 20       |         |         | (E) EXISTING LOAD                           |
| E) EXISTING LOAD                  |                 |                  |         |          | 20       | 1     | 21               | В        | 22       |        |          |         |         | (2) 2001110 2010                            |
| E) EXISTING LOAD                  |                 |                  |         |          | 20       | 1     | 23               | C        | 24       |        |          |         |         |                                             |
| N) RTU - 600                      |                 |                  | MTR     | 1.13     | 30       | 3     | 25               | Α        | 26       | 3      | 50       |         |         | (E) EXISTING LOAD                           |
| ,                                 |                 |                  | MTR     | 1.13     |          |       | 27               | В        | 28       |        |          |         |         |                                             |
|                                   |                 |                  | MTR     | 1.13     |          |       | 29               | С        | 30       |        |          |         |         |                                             |
| N) RTU - 600A                     |                 |                  | MTR     | 1.50     | 35       | 3     | 31               | Α        | 32       | 1      | 20       | 0.90    | REC     | (N) CLASSROOM 600A - REC                    |
|                                   |                 |                  | MTR     | 1.50     |          |       | 33               | В        | 34       | 1      | 20       | 0.90    | MISC    | (N) CLASSROOM 600A - PROJECTOR              |
|                                   |                 |                  | MTR     | 1.50     |          |       | 35               | С        | 36       | 1      | 20       | 0.90    | REC     | (N) CLASSROOM 600 - REC                     |
| N) CORRIDOR - LIGHT               | S               |                  | LTG     | 0.19     | 20       | 1     | 37               | Α        | 38       | 1      | 20       | 0.90    | MISC    | (N) CLASSROOM 600 - REC                     |
| (E) SPACE                         |                 |                  |         |          |          |       | 39               | В        | 40       | 1      | 20       | 0.18    | REC     | (N) HALLWAY - REC                           |
| (E) SPACE                         |                 |                  |         |          |          |       | 41               | С        | 42       |        |          |         |         | (E) SPACE                                   |
|                                   |                 |                  |         |          |          |       |                  | 1        |          |        |          |         |         |                                             |
| STIMATED MAXIMUM                  | DEMAND (EMD)    | CALCULATIONS     |         |          |          |       |                  |          |          |        |          |         |         |                                             |
| OAD SUMMARY:                      | LOAD TYPE       | CONNECTED        | NEC DE  | MAND     |          |       |                  |          |          |        |          |         |         |                                             |
| IGHTING                           | LTG             | 0.2 KVA          | 0.2     | KVA (12  | 5%)      |       |                  |          |          |        |          |         | CONNE   | CTED PHASE LOADING                          |
| RESIDENT LTG/REC                  | RES             | 0.0 KVA          | 0.0     | KVA ( 10 | 00/35/25 | %)    |                  |          |          |        |          |         | PHASE   | A: 4.62 KVA                                 |
| MALL APPLIANCE                    | RES             | 0.0 KVA          | 0.0     | KVA ( 10 | 00/35/25 | %)    |                  |          |          |        |          |         | PHASE   | B: 3.71 KVA                                 |
| ARGEST MOTOR                      | MTR             | KVA              |         | KVA (12  |          | ,     |                  |          |          |        |          |         | PHASE   |                                             |
| REMAINING MOTORS                  | MTR             | 7.9 KVA          |         | KVA (10  | ,        |       |                  |          |          |        |          |         |         |                                             |
| SEN PURPOSE REC                   |                 |                  |         |          |          | ۱۸۱   |                  |          |          |        |          |         |         |                                             |
|                                   | REC             | 2.0 KVA          |         | KVA (50  |          | vA)   |                  |          |          |        |          |         |         |                                             |
| OMPUTER REC                       | MISC            | 0.0 KVA          |         | KVA (10  |          |       |                  |          |          |        |          |         |         |                                             |
| QUIP/OTHER                        | MISC            | 1.8 KVA          |         | KVA (10  |          |       |                  |          | NOTES    |        |          |         |         |                                             |
| IEATING                           | MISC            | 0.0 KVA          | 0.0     | KVA (10  | 0%)      |       |                  |          | 1. LIGH  | T LINE | WEIGH    | ΓPREFA  | CED WIT | H (E) INDICATES EXISTING TO REMIAN.         |
| ELEVATOR                          | ELEV            | 0.0 KVA          | 0.0     | KVA (10  | 0%)      |       |                  |          | 2. BOL   | D LINE | WEIGH    | T PREFA | CED WIT | H (N) INDICATES NEW                         |
| ITCHEN EQPT                       | KITCH           | 0.0 KVA          | 0.0     | KVA (.65 | 5)       |       |                  | ⅃        |          |        |          |         |         |                                             |
| TOTALS:                           |                 | 11.9 KVA         |         | KVA      |          |       |                  | 1        |          |        |          |         |         |                                             |
|                                   |                 | 32.9 AMP         |         | AMP      |          |       |                  |          |          |        |          |         |         |                                             |
|                                   |                 |                  |         |          |          |       |                  |          |          |        |          |         |         |                                             |
|                                   |                 |                  |         |          | F        | PAN   | EL S             | СН       | EDU      | ILE    |          |         |         |                                             |
|                                   |                 |                  |         |          |          | ,     |                  |          |          |        |          |         |         |                                             |
|                                   |                 |                  |         |          |          |       |                  |          |          |        |          |         |         |                                             |

|                                     |                 |                               |         |            | F          | 'ΑΝ | IEL S            | СНІ          | EDU      | LE     |            |           |             |                                             |
|-------------------------------------|-----------------|-------------------------------|---------|------------|------------|-----|------------------|--------------|----------|--------|------------|-----------|-------------|---------------------------------------------|
|                                     |                 |                               |         |            |            |     |                  |              |          |        |            |           |             |                                             |
| PANEL: DF<br>AMP: 100 MLO           |                 | : MAIN ELECTRIC               | CAL ROO | M          |            |     | VOLT             | AGE:         | 208      | Υ/     | 120        | P:        | 3           | W: 4 AIC RATING:  MOUNTING: SURFACE X FLUSH |
| TYPE: EXISTING                      | S X NEW         | STYLE:                        |         |            |            |     | NEU <sup>-</sup> | ΓRAL:        | 100%     |        |            |           |             | FED FROM: MSB                               |
| CIRCL                               | JIT DESCRIPTION |                               | TYPE    | )AD<br>KVA | CKT<br>BKR | Р   | CIR<br>#         | P<br>H       | CIR<br># | Р      | CKT<br>BKR | LC<br>KVA | DAD<br>TYPE | CIRCUIT DESCRIPTION                         |
| (E) EXISTING LOAD                   |                 |                               |         |            | 20         | 1   | 1                | Α            | 2        | 3      | 20         |           |             | (E) EXISTING LOAD                           |
| E) EXISTING LOAD                    |                 |                               |         |            | 20         | 1   | 3                | В            | 4        |        |            |           |             | (E) EXISTING LOAD                           |
| E) EXISTING LOAD                    |                 |                               |         |            | 20         | 1   | 5                | С            | 6        |        |            |           |             | (E) EXISTING LOAD                           |
| E) EXISTING LOAD                    |                 |                               |         |            | 20         | 1   | 7                | A            | 8        | 1      | 20         |           |             | (E) EXISTING LOAD                           |
| E) EXISTING LOAD                    |                 |                               |         |            | 20         | 1   | 9                | В            | 10       | 1      | 20         |           |             | (E) EXISTING LOAD                           |
| E) EXISTING LOAD  E) EXISTING LOAD  |                 |                               |         |            | 20         | 1   | 11               | С            | 12       | 1      | 20         |           |             | (E) EXISTING LOAD                           |
| E) EXISTING LOAD                    |                 |                               |         |            | 20         | 1   | 13               | A            | 14       | 1      | 20         |           |             | (E) EXISTING LOAD                           |
| E) EXISTING LOAD                    |                 |                               |         |            | 20         | 1   | 15               | В            | 16       | 1      | 20         |           |             | (E) SPACE                                   |
| E) EXISTING LOAD                    |                 |                               |         |            | 20         | 1   | 17               | С            | 18       | 1      | 20         |           |             | (E) SPACE                                   |
| E) EXISTING LOAD                    |                 |                               |         |            | 20         | 1   | 19               | A            | 20       | 3      | 20         |           |             | (E) EXISTING LOAD                           |
| E) EXISTING LOAD                    |                 |                               |         |            | 20         | 1   | 21               | В            | 22       | _      | -          |           |             | (E) EXISTING LOAD                           |
| E) EXISTING LOAD                    |                 |                               |         |            | 20         | 1   | 23               | С            | 24       |        |            |           |             | (E) EXISTING LOAD                           |
| N) RM 315 - PROJECTO                | OR              |                               | MISC    | 0.90       | 20         | 1   | 25               | A            | 26       | 3      | 20         |           |             | (E) EXISTING LOAD                           |
| N) RM 315 - REC                     |                 |                               | REC     | 0.30       | 20         | 1   | 27               | В            | 28       |        |            |           |             | (E) EXISTING LOAD                           |
| E) SPACE                            |                 |                               |         | 30         | 20         | 1   | 29               | С            | 30       |        |            |           |             | (E) EXISTING LOAD                           |
| E) SPACE                            |                 |                               |         |            | 20         | 1   | 31               | A            | 32       | 2      | 20         |           |             | (E) EXISTING LOAD                           |
| E) SPACE                            |                 |                               |         |            | 20         | 1   | 33               | В            | 34       | -      | -          |           |             | (E) EXISTING LOAD                           |
| E) SPACE                            |                 |                               |         |            | 20         | 1   | 35               | С            | 36       |        |            |           |             | (E) SPACE                                   |
| E) SPACE                            |                 |                               |         |            | 20         | 1   | 37               | A            | 38       |        |            |           |             | (E) SPACE                                   |
| E) SPACE                            |                 |                               |         |            | 20         | 2   | 39               | В            | 40       |        |            |           |             | (E) SPACE                                   |
| E) SPACE                            |                 |                               |         |            | -          | -   | 41               | С            | 42       |        |            |           |             | (E) SPACE                                   |
| ESTIMATED MAXIMUM                   | DEMAND (EMD) (  | CALCULATIONS                  | I       | ı          |            |     |                  |              |          |        |            |           |             |                                             |
| _OAD SUMMARY:                       | LOAD TYPE       | CONNECTED                     | NEC D   | EMAND      |            |     |                  |              |          |        |            |           |             |                                             |
| IGHTING                             | LTG             | 0.0 KVA                       | 0.0     | KVA (12    | 5%)        |     |                  |              |          |        |            |           | CONNEC      | CTED PHASE LOADING                          |
| ESIDENT LTG/REC                     | RES             | 0.0 KVA                       |         | KVA (10    | ,          | %)  |                  |              |          |        |            |           | PHASE A     |                                             |
| MALL APPLIANCE                      | RES             | 0.0 KVA                       |         | KVA (10    |            |     |                  |              |          |        |            |           | PHASE E     |                                             |
|                                     |                 |                               |         |            |            | ,0) |                  |              |          |        |            |           |             |                                             |
| ARGEST MOTOR                        | MTR             | KVA                           |         | KVA (12    |            |     |                  |              |          |        |            |           | PHASE (     | C: 0.00 KVA                                 |
| EMAINING MOTORS                     | MTR             | 0.0 KVA                       |         | KVA (10    |            |     |                  |              |          |        |            |           |             |                                             |
| SEN PURPOSE REC                     | REC             | 0.2 KVA                       | 0.2     | KVA ( 50   | % > 10K    | VA) |                  |              |          |        |            |           |             |                                             |
| COMPUTER REC                        | MISC            | 0.0 KVA                       | 0.0     | KVA (10    | 0%)        |     |                  |              |          |        |            |           |             |                                             |
| QUIP/OTHER                          | MISC            | 0.9 KVA                       | 0.9     | KVA (10    | 0%)        |     |                  |              | NOTES    | :      |            |           |             |                                             |
| IEATING                             | MISC            | 0.0 KVA                       |         | KVA (10    |            |     |                  |              | 1. LIGH  | T LINF | WEIGHT     | PREFAC    | CED WITI    | H (E) INDICATES EXISTING TO REMIAN.         |
|                                     | ELEV            | 0.0 KVA                       |         | KVA (10    |            |     |                  |              |          |        |            |           |             | H (N) INDICATES NEW                         |
|                                     | KITCH           |                               |         | K V A I Kh | )          |     |                  | 1            | 1        |        |            |           |             |                                             |
| KITCHEN EQPT                        | KITCH           | 0.0 KVA                       |         |            | /          |     |                  | <del> </del> |          |        |            |           |             |                                             |
| ELEVATOR<br>KITCHEN EQPT<br>TOTALS: | KITCH           | 0.0 KVA<br>1.1 KVA<br>3.0 AMP | 1.1     | KVA (.00   | ,          |     |                  |              |          |        |            |           |             |                                             |







REVISIONS <u>1</u> 3/17/2020 ADD. 1

# **ESD 4J NORTH EUGENE HIGH SCHOOL IMPROVEMENTS**

JOB NO: **PANEL** 

**SCHEDULES**